

YOST ROAD

RIGHT-OF-WAY LINE
CENTERLINE
RIGHT-OF-WAY LINE

EXISTING LEASE PARCEL PER
M.D.L. DOCUMENT NO. 762854

EXISTING 20' WIDE
INGRESS/EGRESS
EASEMENT PER M.D.L.
DOCUMENT NO. 762854

ASPHALT DRIVE

NORTH LINE OF GOVERNMENT LOT 7

FOX RIVER

I, Craig A. Keach, hereby certify that none of the
property described hereon is within a flood plain
as defined by FEMA.

SURVEYOR'S CERTIFICATE


I, Craig A. Keach, Wisconsin Registered Land Surveyor
of Meridian Surveying, LLC, certify that I have surveyed the
described property and that the map shown is a true and accurate
representation thereof to the best of my knowledge and belief.

Dated this 7th day of MARCH, 2013.

Craig A. Keach
WISCONSIN REGISTERED LAND SURVEYOR
Craig A. Keach, S.2333



11" x 17" - 1" = 100'
22" x 34" - 1" = 50'

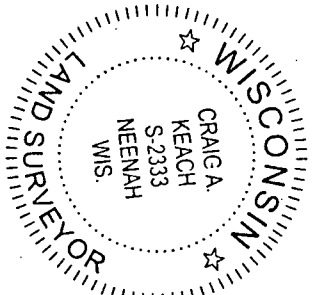

- LEGEND—
- = COUNTY MONUMENT FOUND
 - ⊙ = GAS METER
 - ⊙ = METAL POST
 - ⊙ = GROUNDING PORT
 - ⊙ = TELEPHONE PEDESTAL
 - ⊙ = EXISTING POWER POLE
 - ⊙ = OVERHEAD ELECTRIC
 - ⊙ = BURIED ELEC. & TELE.
 - ⊙ = BURIED TELEPHONE
 - ⊙ = BURIED ELECTRIC
 - ⊙ = PROPERTY LINE
 - ⊙ = EXISTING TREE

PROJECT— OMRO #776301

SURVEYED FOR:
EDGE CONSULTING ENGINEERS, INC.
624 WATER STREET
PRAIRIE DU SAC, WI 53578

AND

SURVEYED FOR:
US CELLULAR
8410 BRYN MAWR AVENUE
CHICAGO, IL 60631

PROPERTY OWNER:
BARRY & BARBARA HORNE
6421 YOST ROAD
OMRO, WI 54963

TOWER OWNER:
US CELLULAR
8410 BRYN MAWR AVENUE
CHICAGO, IL 60631

PARCEL NO.: 0160134

ZONED: A-2, GENERAL AG.

DEED: DOCUMENT NO. 769537

M.O.L.: DOCUMENT NO. 762854

BEARINGS REFERENCED TO THE WINNEBAGO
COUNTY COORDINATE SYSTEM AND THE NORTH
LINE OF GOVERNMENT LOT 7, SECTION 4,
T.18N., R.15E., WHICH BEARS: N89°-10'-15"E


SURVEY NOTES:

—THE LOCATION OF THE EXISTING UTILITIES, AS SHOWN
ON THIS PLAN, ARE APPROXIMATE ONLY. IT SHALL BE
THE RESPONSIBILITY OF THE CONTRACTOR TO VERIFY
ACTUAL LOCATION AND DEPTH OF ALL EXISTING UTILITIES.
THE OWNER AND THE SURVEYOR SHALL NOT BE
RESPONSIBLE FOR ANY OMISSION OR VARIATION FROM
THE LOCATION SHOWN.

—NO TITLE SEARCH FOR PARCEL OWNERSHIP OR
EXISTENCE OR NONEXISTENCE OF RECORDED OR
UNRECORDED EASEMENTS HAS BEEN COMPLETED AS
PART OF THIS SURVEY.

—THIS IS NOT A BOUNDARY SURVEY OF THE PARENT
PARCEL. THIS SURVEY REPRESENTS THE LEASE AREA
AND EASEMENTS ONLY.

—VICINITY MAP—

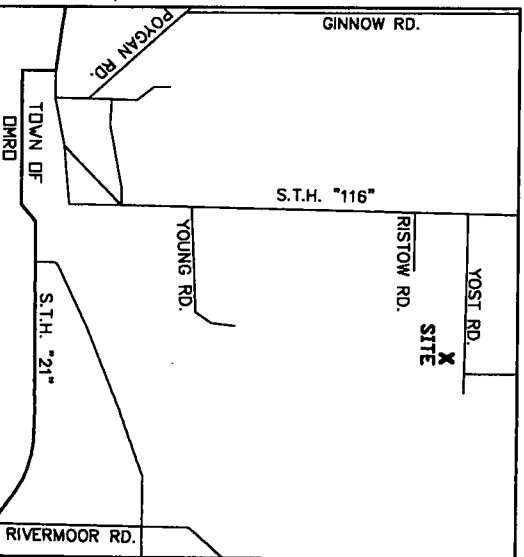

SITE NAME: OMRO	SITE ADDRESS: 6421 YOST ROAD OMRO, WI 54963
SITE NUMBER: 776301	
MERIDIAN SURVEYING, LLC	
N8774 Fireline 1 Office: 920-993-0881 Menasha, WI 54952 Fax: 920-273-6037	

AS-BUILT SURVEY
FOR
US CELLULAR

BEING A PART OF GOVERNMENT LOT 7,
SECTION 4, T.18N., R.15E., TOWN OF
OMRO, WINNEGAGO COUNTY, WISCONSIN

NO.	DATE	DESCRIPTION	BY
1	10/22/12	Preliminary Survey	J.D.
DRAWN BY:	J.D.	FIELD WORK	10-19-12
CHECKED BY:	C.A.K.	FIELD BOOK	M-25, PG. 64
JOB NO.:	7015-B1233	SHEET	1 OF 2