


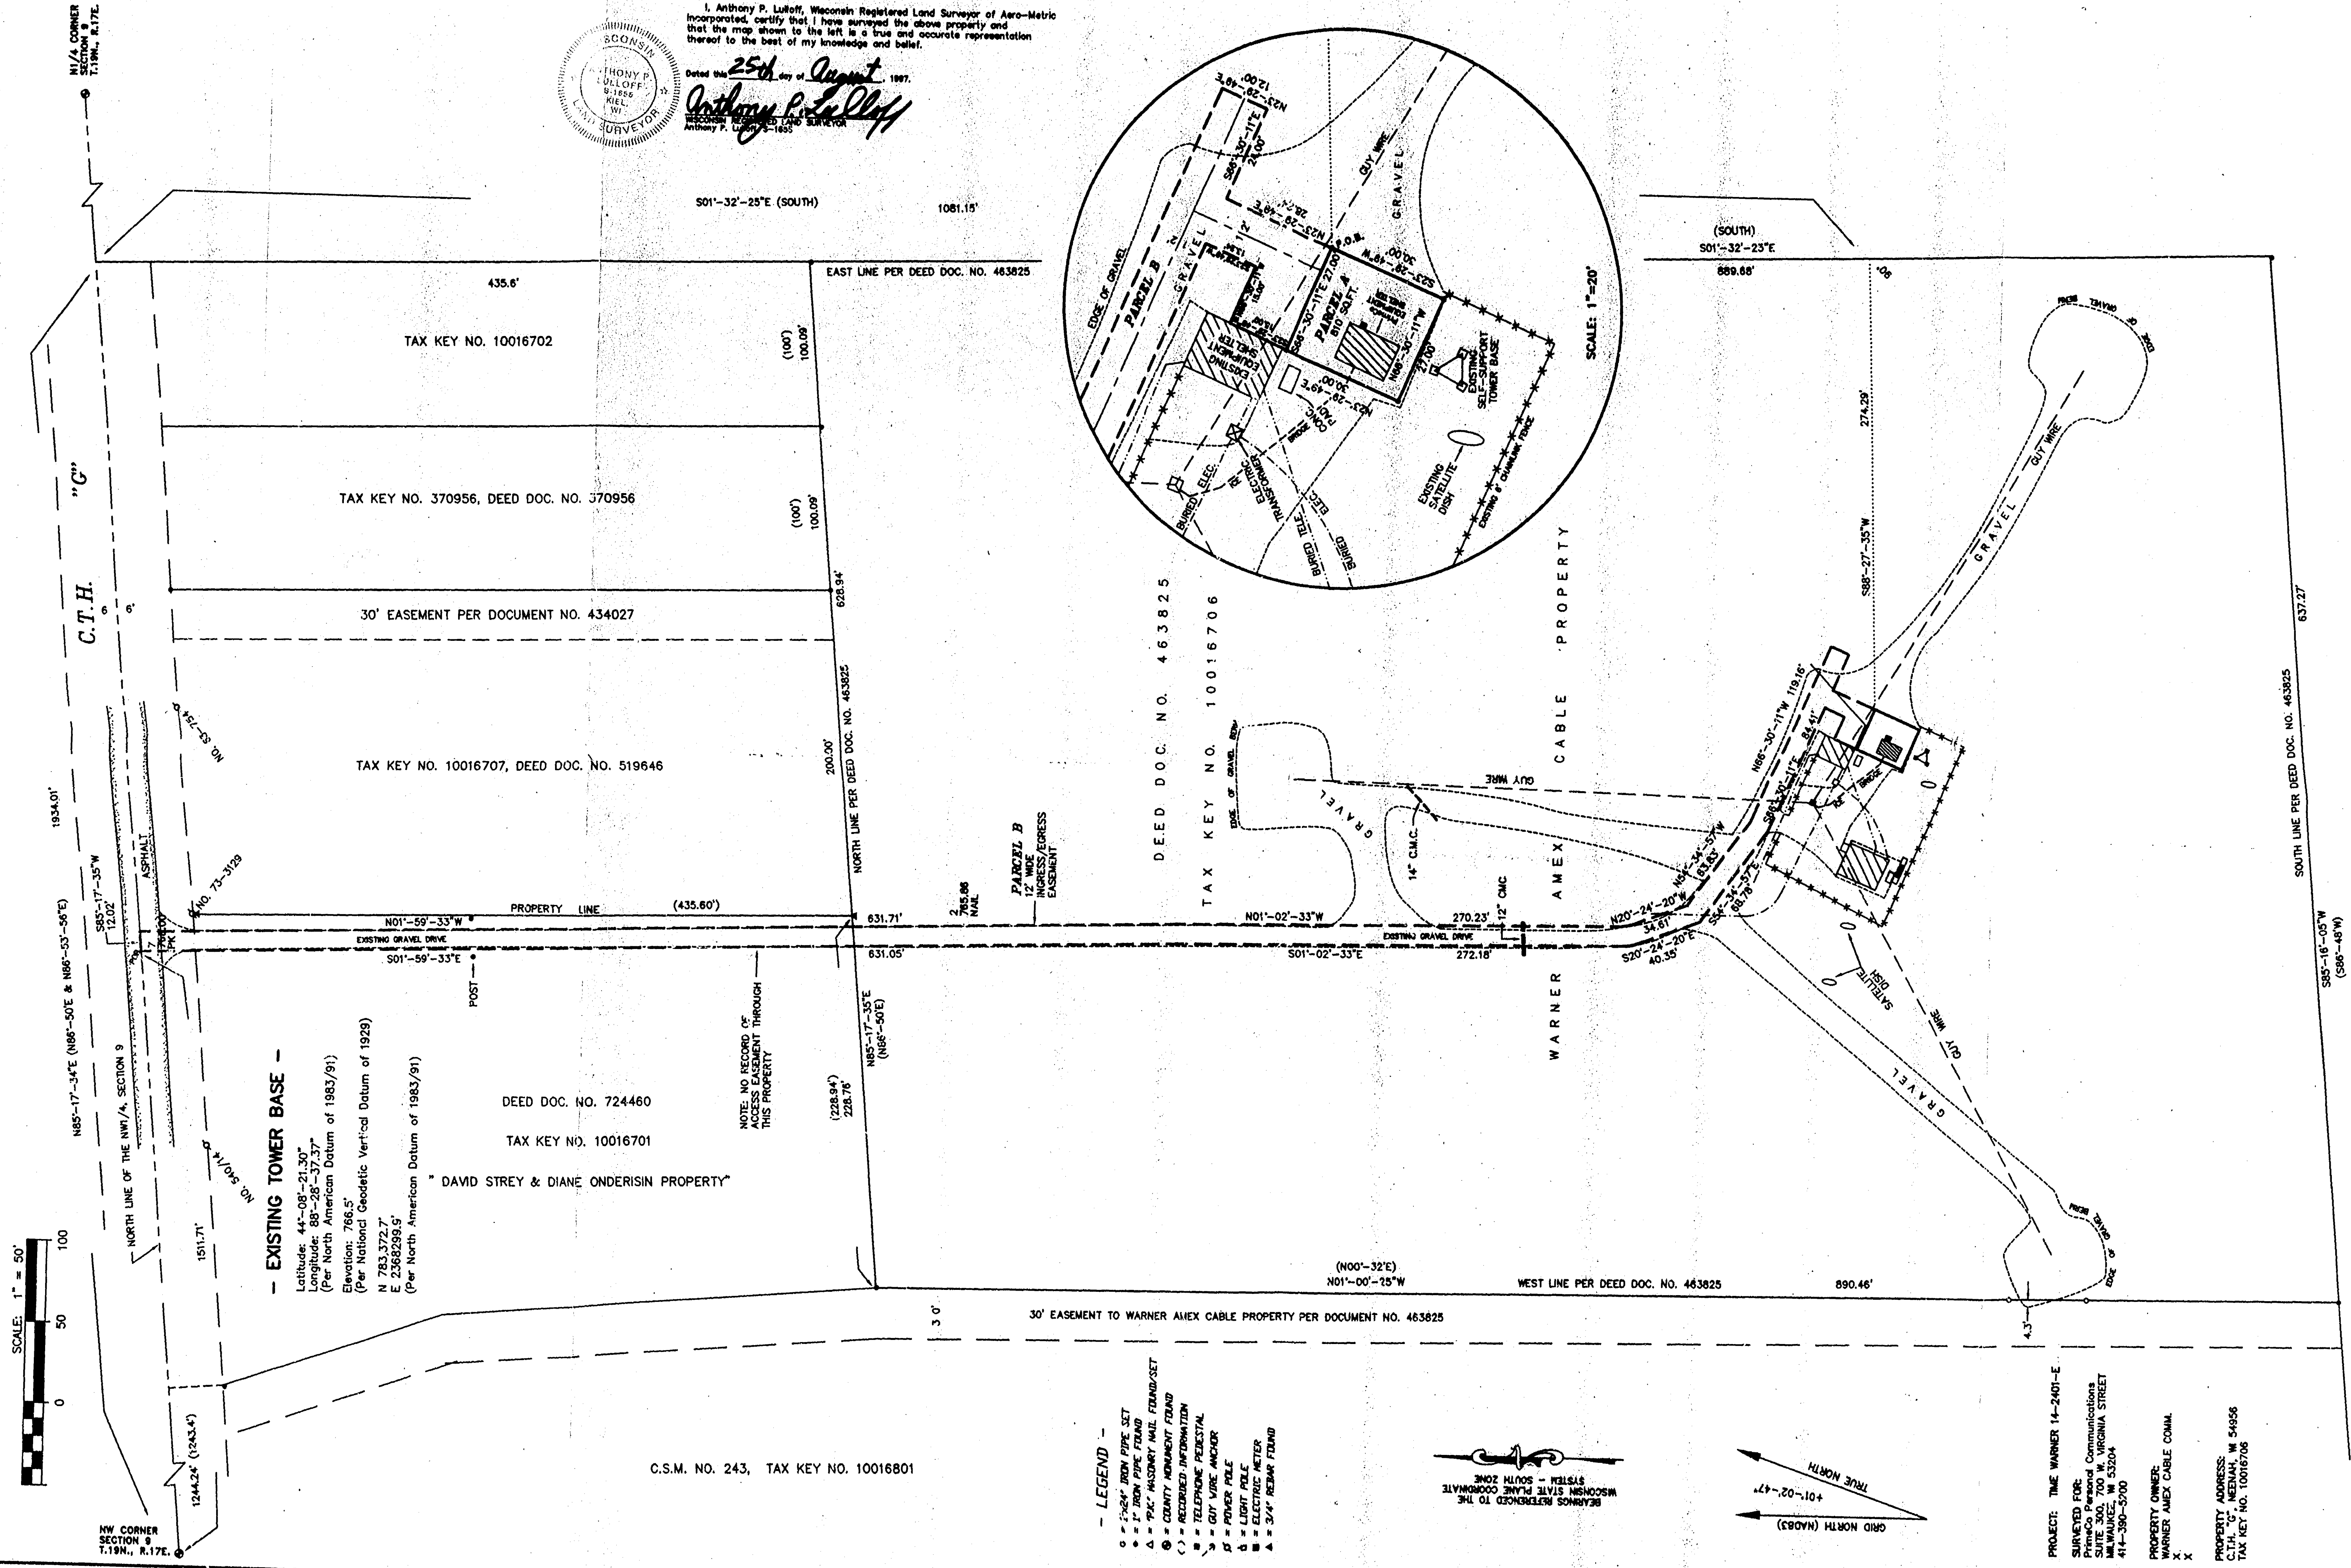

SURVEYOR'S CERTIFICATE

I, Anthony P. Lulloff, Wisconsin Registered Land Surveyor of Aero-Metric Incorporated, certify that I have surveyed the above property and that the map shown on the left is a true and accurate representation thereof to the best of my knowledge and belief.

Dated this 25th day of August, 1997.

Anthony P. Lulloff
WISCONSIN REGISTERED LAND SURVEYOR
Anthony P. Lulloff
S-1605



 PRIMECO [®] PERSONAL COMMUNICATIONS	AS-BUILT SURVEY FOR PrimeCo Personal Communications A PART OF THE NWC/ SECTION 9, T.19N., R.17E., TOWN OF NEENAH, WINNEBAGO COUNTY, WISCONSIN		 AERO-METRIC Aero-Metric, Incorporated Land Planning & Design Division 4144-7708 800-472-3243 FAX 0449-7799 539 NORTH HAUSSON STREET OULSON, WISCONSIN 53044	DATE : 03-19-97 SCALE : 1"=50' REVISIONS : 04-28-97 DRAWN BY : S.F.S. CHECKED BY : A.P.L. DWG. FILE : PCS-TIME PROJECT NO. : 2970307 NOTEBOOK : 42 PAGE : 20-21
	SHEET NO. 1 OF 1	FILE NO. K-577		PrimeCo PROJECT NO. 14-2401-E