


4-20-17

AS BUILT SITE PLAN

LOT 18
PRAIRIE CREEK
TOWN OF MENASHA
WINNEBAGO COUNTY WISCONSIN

FOR:
SWEETWOOD BUILDERS

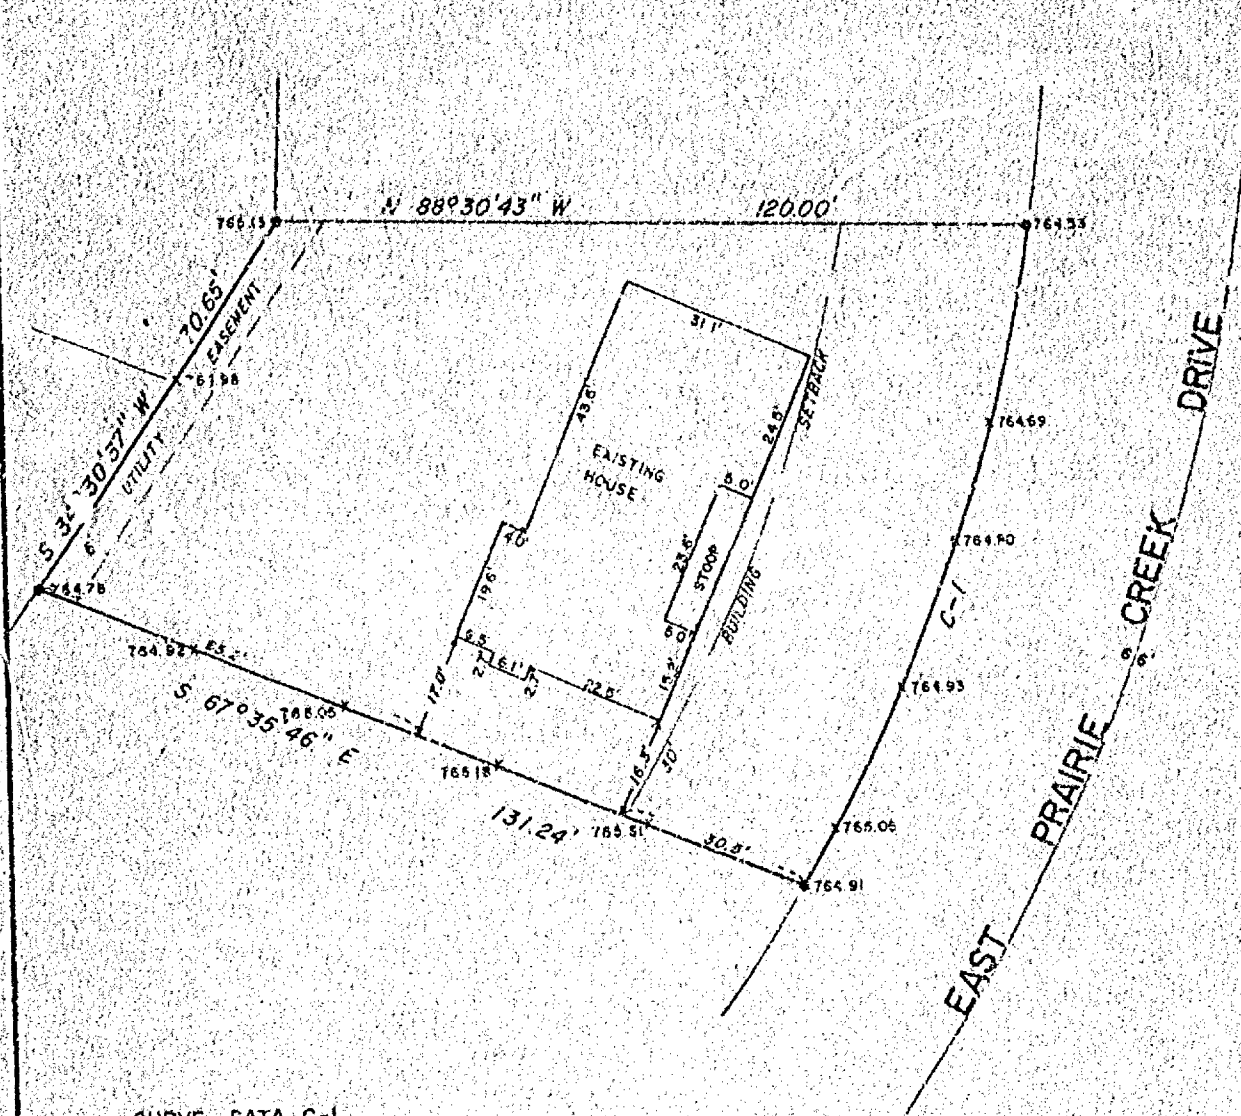

SCALE 1"=30'

Bearings are oriented to match
PRAIRIE CREEK plat bearings.


LEGEND

- 3/4" REBAR SET
- 1 1/4" REBAR SET
- 3/4" REBAR FOUND
- 1 1/4" REBAR FOUND
- x WOOD NUB SET AT ELEVATION INDICATED

SURVEYOR'S CERTIFICATE

I, hereby certify that I have surveyed this property as shown and described according to official records and this map is a true representation thereof and shows the size and location of the property, its exterior boundaries, the location and dimensions of all visible structures thereon, and that the information contained thereon is, to the best of my knowledge and belief a true and accurate representation thereof.

OCT 16, 1995 *James E. Smith*
DATE Registered Land Surveyor

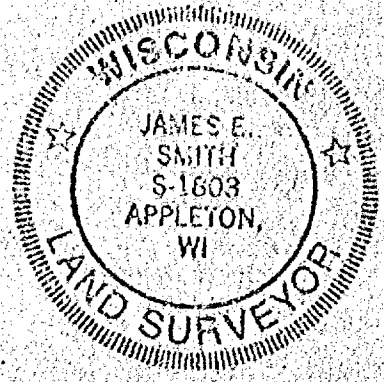

M&E Martenson & Eisele, Inc.
CONSULTING ENGINEERING & LAND SURVEYING
1919 AMERICAN COURT
NEENAH WIS. 54956
PHONE - 731-0381

FIELD BOOK 83 PROJECT NO. 378-220
PAGE 53
THIS INSTRUMENT WAS DRAFTED BY M.A.S.