

4-20-17


AS BUILT SITE PLAN

LOT 72
PRAIRIE CREEK
TOWN OF MENASHA
WINNEBAGO COUNTY WISCONSIN

FOR:
SUNRISE BUILDERS

CURVE DATA				
CURVE NO.	RADIUS	CHORD BRG.	CHORD	CENTRAL ANG.
C-1	355.67'	N 82°33'24" E	40.02'	6°29'18"
C-2	676.00'	N 06°31'07" W	65.99'	5°35'42"

SCALE 1"=30'

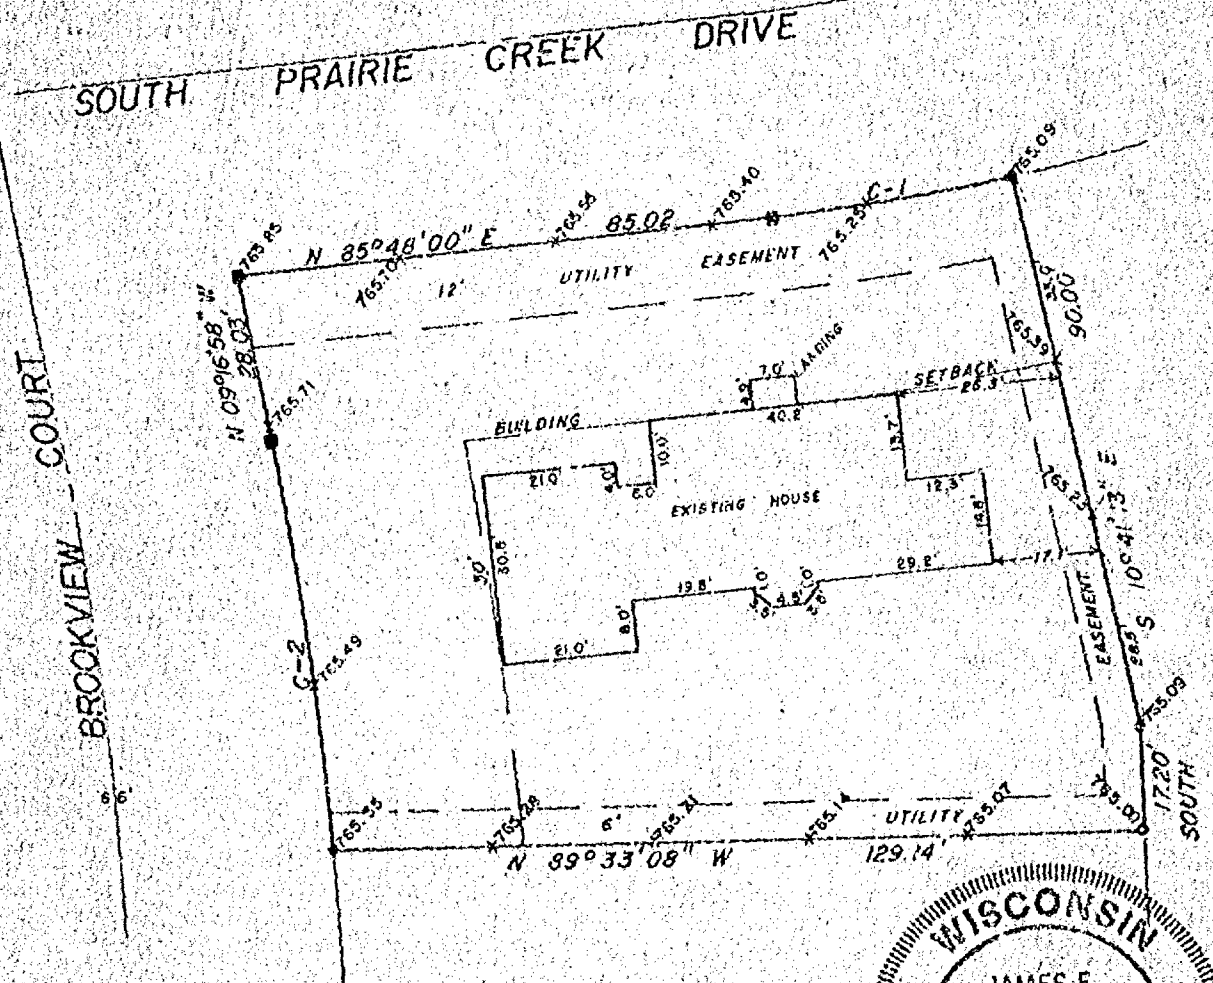

Bearings are oriented to match
PRAIRIE CREEK plat bearings


LEGEND

- 3/4" REBAR SET
- 1 1/4" REBAR SET
- 3/4" REBAR FOUND
- 1 1/4" REBAR FOUND
- x WOOD NAIL SET, ALL ELEVATION INDICATED

SURVEYOR'S CERTIFICATE:

I, hereby certify that I have surveyed this property, as shown and described according to official records and this map is a true representation thereof and shows the size and location of the property, its exterior boundaries, the location and dimensions of all visible structures thereon, and that the information contained thereon is, to the best of my knowledge and belief a true and accurate representation thereof.

DATE OCT 16, 1989 James E. Smith
Registered Land Surveyor

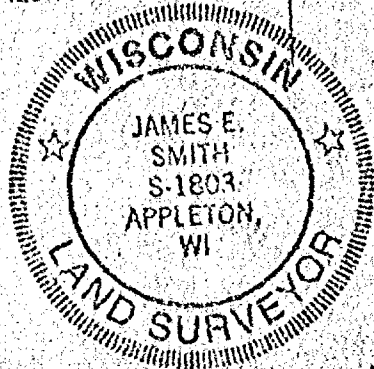

 **Martenson & Eisele, Inc.**
CONSULTING ENGINEERING & LAND SURVEYING
1919 AMERICAN COURT
NEENAH WIS. 54956
PHONE - 731-0381

FIELD BOOK 83 PROJECT NO. 378-218c
PAGE 50

THIS INSTRUMENT WAS DRAFTED BY M.A.S.