


AS-BUILT TOPOGRAPHIC SURVEY

LOT 39, BAYVIEW ESTATES, CITY OF NEENAH,
WINNEBAGO COUNTY, WISCONSIN

Survey for:
ERA Acre Realty

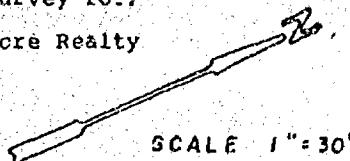


Benchmark: "x" on top flange of hydrant, northwest
corner of Heather & Evergreen
Elev. 759.13

Base Flood Elevation = 749.9

All elevation referenced to U.S.G.S. Datum

EVERGREEN LANE

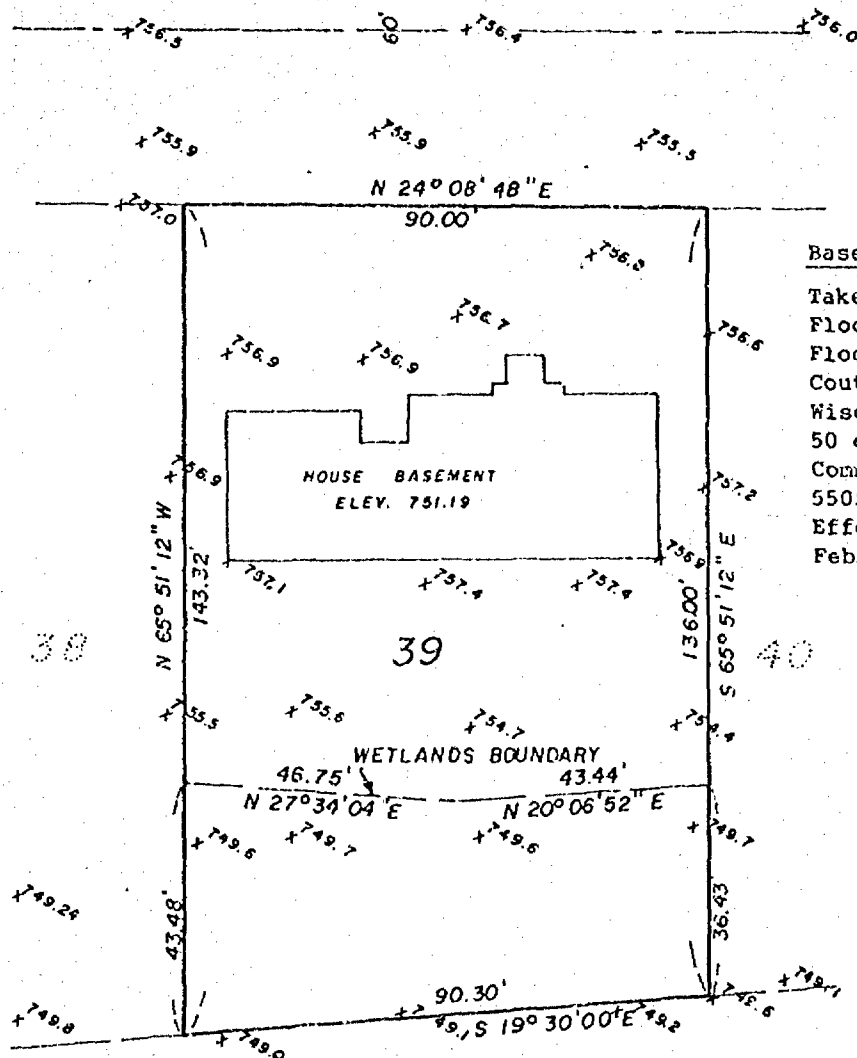


Base Flood information

Taken from Floodway,
Flood Boundary and
Floodway Map 11
County of Winnebago,
Wisconsin, Parcel No.
50 of 150
Community-Panel Number
550537-0050B
Effective Date:
February 4, 1981.

SURVEYOR'S CERTIFICATE:

I hereby certify that I have surveyed the property as
shown and that the plat above drawn is an accurate and
correct representation of said survey, to the best of
my knowledge and belief.

8-15-89 James E. Smith
Date Registered Land Surveyor

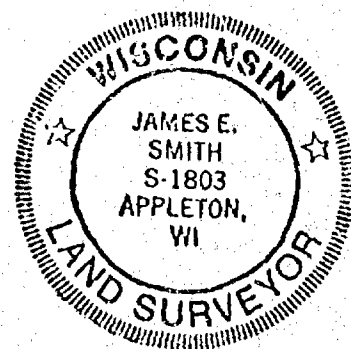

M.E. Martenson & Eisele, Inc.
CONSULTING ENGINEERING & LAND SURVEYING
1919 AMERICAN COURT
NEENAH WIS. 54956
PHONE - 731-0381

FIELD BOOK _____ PROJECT NO. 350-104
PAGE _____

THIS INSTRUMENT WAS DRAFTED BY: DOE