


AS-BUILT TOPOGRAPHIC SURVEY

LOT 38, BAYVIEW ESTATES, CITY OF NEENAH,
WINNEBAGO COUNTY, WISCONSIN

Survey for:


ERA Acre Realty

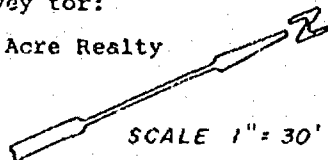


Benchmark: "x" on top flange of hydrant,
Northwest corner of Heather &
Evergreen Elev. 759.13

Base Flood Elevation = 749.9

All elevation referenced to U.S.G.S. Datum

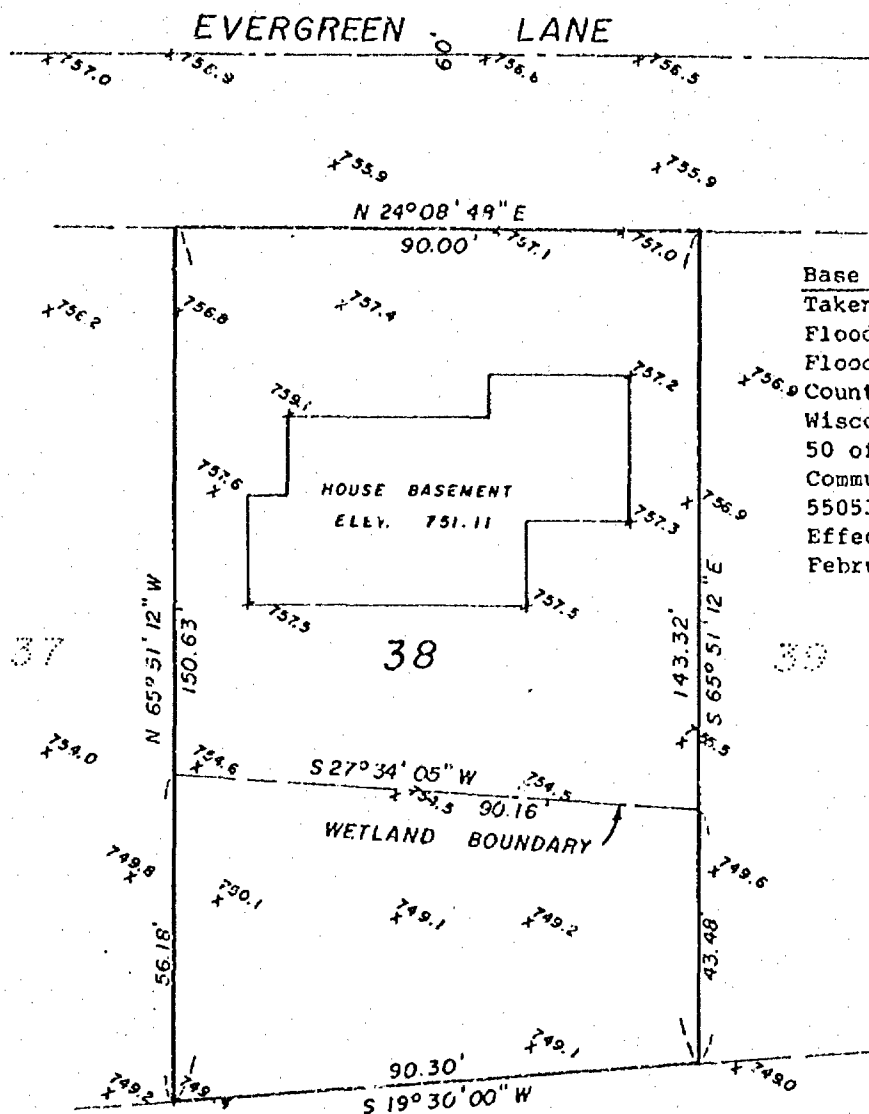

Base Flood Information
Taken from Floodway,
Flood Boundary and
Floodway Map 11
County of Winnebago,
Wisconsin, Parcel No.
50 of 150
Community-Panel Number
550537-0050B
Effective date:
February 4, 1981.

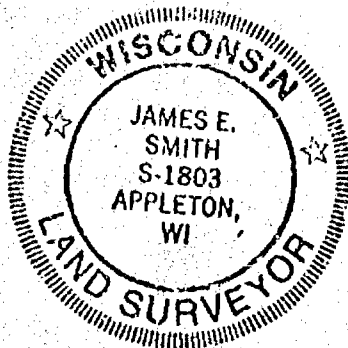

SURVEYOR'S CERTIFICATE:

I hereby certify that I have surveyed the property
as shown and that the plat above drawn is an ac-
curate and correct representation of said survey,
to the best of my knowledge and belief.

8.1589 *James E. Smith*
Date Registered Land Surveyor

M.E. Martenson & Eisele, Inc.
CONSULTING ENGINEERING & LAND SURVEYING
1919 AMERICAN COURT
NEENAH WIS. 54956
PHONE - 731-0381

FIELD BOOK _____ PROJECT NO. 350-103
PAGE _____

THIS INSTRUMENT WAS DRAFTED BY: POC