

FIRST ADDITION TO  
RUSCH AND KIENAST  
PLAT

KIENAST N.00° 29' 27"E  
AVENUE 41.55'  
KIENAST AVENUE  
N.00° 29' 27"E  
552'

FIRST ADDITION TO

RUSCH AND KIENAST

PLAT


PLAT

KIENAST

AND

RUSCH

PLAT OF THE

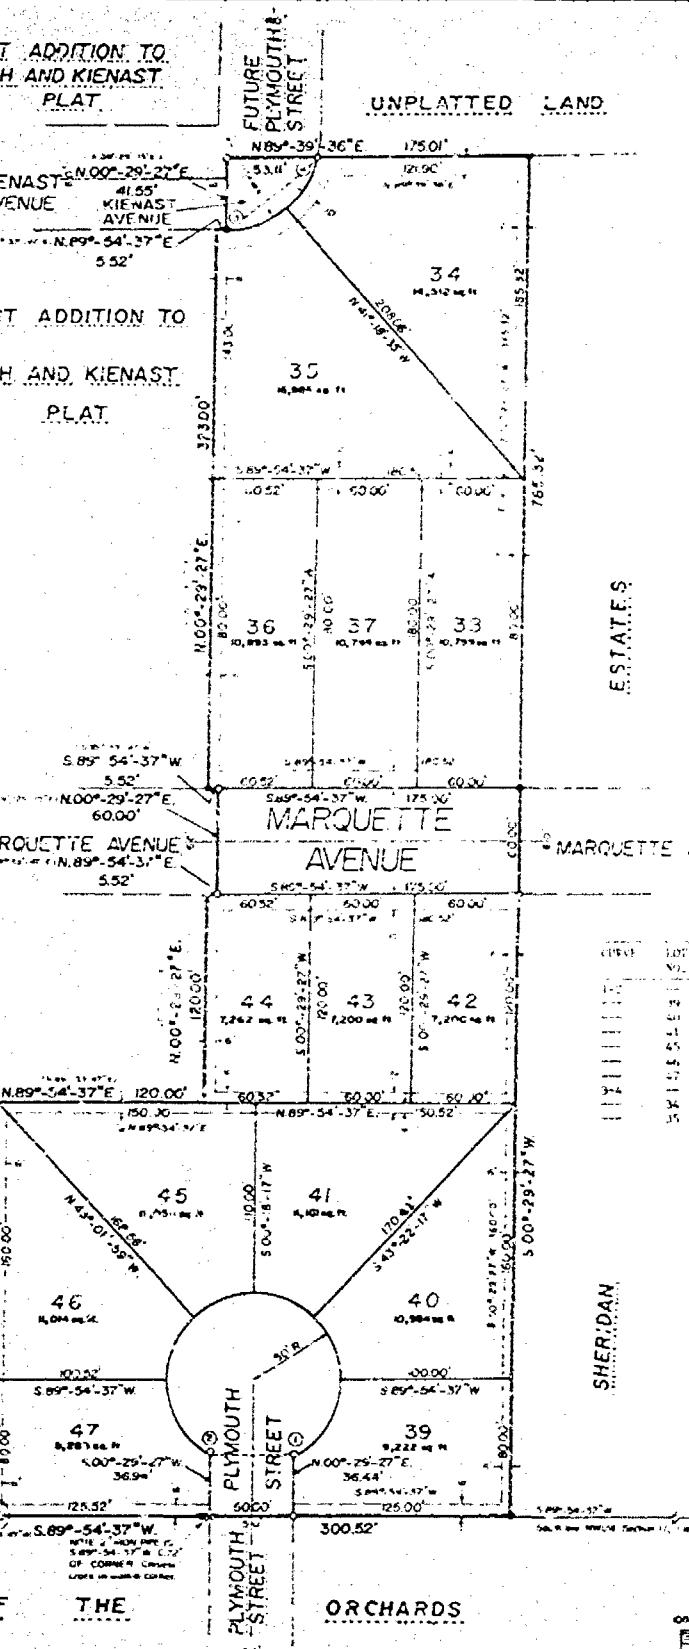

# FIRST ADDITION TO KAITLYNN

BEING ALL OF OUTLOTS 1, 2 AND 3 IN RUSCH AND KIENAST PLAT AND OUTLOT 4 OF THE FIRST ADDITION TO RUSCH AND KIENAST PLAT AND A PART OF THE SW 1/4 OF THE NW 1/4 OF SECTION II, T.18N, R.16E, 12TH WARD, CITY OF OSHKOSH, WINNEBAGO COUNTY, WISCONSIN.

NOTIFICATION CERTIFICATE

I, Steven T. Chronis, Wisconsin Registered Land Surveyor of Aero-Metric Engineering, Inc., hereby certify:

That I have surveyed, divided and mapped the FIRST ADDITION TO KAITLYNN being all of Outlots 1, 2, and 3 in Rusch & Kienast Plat and Outlot 4 of the First Addition to Rusch & Kienast Plat and a part of the Southwest Quarter (NW 1/4) of the Northeast Quarter (NE 1/4) of Section Eleven (11), Township Eighteen (T18), Range Sixteen (R16), Town of Oshkosh, Winnebago County, Wisconsin containing 3.200 Acres of land.

That I have made such survey, Land division and Plat by the direction of Kurt A. Kappeler, an owner of said land and being described as:

Comprising of the West Quarter (NW 1/4) corner of said section 11, being Section N.00° 29' 27"E, 120.00' feet, along the South line of the NW 1/4 of said Section 11 to the true point of beginning, running South N.00° 29' 27"E, 240.00' feet, thence South N.00° 29' 27"E, 120.00' feet, thence N.00° 29' 27"E, 120.00' feet to the true point of beginning.

That such Plat is a correct representation of all exterior boundaries of the land surveyed and the subdivision thereof.

That I have fully complied with the provisions of chapter 29 of the Wisconsin Statutes and the Subdivision Regulations of the City of Oshkosh in surveying, dividing and mapping the same.

Dated this 14<sup>th</sup> day of January, 1990.

Steven T. Chronis  
Wisconsin Registered Land Surveyor No. 9941  
Steven T. Chronis



STURMATION FOR STORM DRAINS - WINNEBAGO COUNTY

Pursuant to Section 30-64(N) of the Winnebago County Land Division Ordinance upon final grading, the developer and/or owner shall comply with the surface water drainage plan as approved by the Winnebago County Land and Water Conservation and Planning and Zoning Departments.

DISCLAIMER


Pursuant to Section 30-64(N) of the City of Oshkosh Subdivision Ordinance upon final grading, the developer and/or owner shall comply with the approved storm drainage and grading plan as submitted to the Department of Public Works.

PARKS DEDICATION AGREEMENT

Pursuant to Section 30-64(N) (a) Proportionate Payment in Lieu of Dedication of the City of Oshkosh Subdivision Ordinance, a \$100.00 per unit fee shall be paid by the Owner/Agent prior to issuance of a Building Permit. The fee shall be used for neighborhood Park and Recreation Area purposes.

LOCATION MAP

W-2 SECTION II, T.18N, R.16E

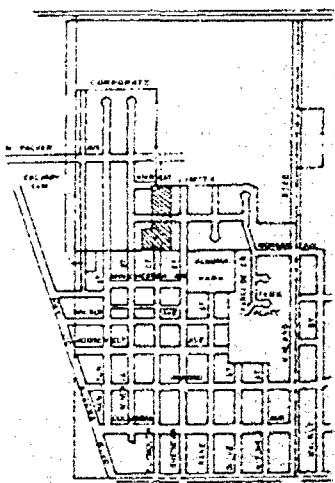

CURE	ID#	RADIIUS	CHORD LENGTH	CHORD BEARING	CHORD DATA			TANGENT LENGTH	TANGENT BEARING
					CENTRAL ANGLE	ARC LENGTH			
34	39	20.00'	50.00'	N.00° 29' 27"E	50.00°	50.00'	261.80"	S.00° 29' 27"E	N.00° 29' 27"E
	40	50.00'	50.00'	S.23° 27'E	50.00°	50.00'	50.00"	S.00° 29' 27"E	S.00° 29' 27"E
	41	50.00'	50.00'	S.23° 27'E	50.00°	50.00'	49.37"	S.00° 29' 27"E	S.00° 29' 27"E
	45	50.00'	50.00'	S.23° 27'E	50.00°	50.00'	49.37"	S.00° 29' 27"E	S.00° 29' 27"E
	46	50.00'	50.00'	S.23° 27'E	50.00°	50.00'	49.37"	S.00° 29' 27"E	S.00° 29' 27"E
34	47	50.00'	50.00'	S.23° 27'E	50.00°	50.00'	49.37"	S.00° 29' 27"E	S.00° 29' 27"E
	34	50.00'	50.00'	S.23° 27'E	50.00°	50.00'	49.37"	S.00° 29' 27"E	S.00° 29' 27"E
	35	50.00'	50.00'	S.23° 27'E	50.00°	50.00'	49.37"	S.00° 29' 27"E	S.00° 29' 27"E

--LEGEND--

— 2" X 30" Iron Pipe weighing 3.65 lbs./lineal foot set

— 2" Iron Pipe found


◆ Winnebago County Historical Monument

● 3" Diameter Iron Fence Pole found

All other lot corners marked with 2" X 24" Iron Pipe weighing 1.66 lbs. per lineal foot

All linear measurements have been made to the nearest one-hundredth of a foot, all angular measurements have been made to the nearest second and computed to half seconds.

Public utility easement to Wisconsin Public Service Corp. and Wisconsin Telephone Co., with the right to trim and keep trimmed all trees within 5' of all conductors.

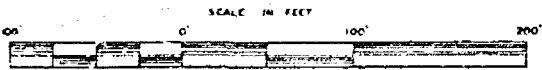

# FIRST ADDITION TO KAITLYNN

12th WARD, CITY OF OSHKOSH, WINNEBAGO COUNTY, WISCONSIN.

## OWNER'S CERTIFICATE OF DEDICATION

An Owner(s), we hereby certify that we caused the land described on this Plat to be surveyed, divided, mapped and dedicated as represented on the Plat. We also certify that this Plat is required by s.296.10 or s.296.12 to be submitted to the following for approval or objection: City of Oshkosh, Department of Agriculture, Trade and Consumer Protection, and the Winnebago County Planning and Zoning Committee.

WITNESS the hand and seal of said owners this \_\_\_\_\_ day of \_\_\_\_\_, 1991.

In the presence of:

Kurt A. Koeppler

Thomas N. Runch

La Vern Klement

STATE OF WISCONSIN )  
WINNEBAGO COUNTY ) ss

Personally came before me this \_\_\_\_\_ day of \_\_\_\_\_, 1991, the above named Kurt A. Koeppler, Thomas N. Runch, and La Vern Klement, to me known to be the persons who executed the foregoing instrument and acknowledged the same.

Notary Public \_\_\_\_\_, Wisconsin

My Commission Expires \_\_\_\_\_

## CONSENT OF CORPORATE MORTGAGEE

Valley Bank of Oshkosh, a corporation duly organized and existing under and by virtue of the laws of the State of Wisconsin, mortgagee of the above described land, does hereby consent to the surveying, dividing, mapping and dedication of the land described on this Plat, and does hereby consent to the above certificate of Kurt A. Koeppler, Thomas N. Runch, and La Vern Klement, owners.

IN WITNESS WHEREOF, the said Valley Bank of Oshkosh has caused these presents to be signed by Joe E. McCrae, its President, and countersigned by Peter J. Prickett, its Senior Vice-President at Oshkosh, Wisconsin, and its corporate seal to be hereunto affixed this \_\_\_\_\_ day of \_\_\_\_\_, 1991.

In the presence of:

VALLY BANK OF OSHKOSH

Joe E. McCrae, President

Peter J. Prickett, Senior Vice President

STATE OF WISCONSIN )  
WINNEBAGO COUNTY ) ss

Personally came before me this \_\_\_\_\_ day of \_\_\_\_\_, 1991, Joe E. McCrae, President, and Peter J. Prickett, Senior Vice-President of the above named corporation, to be known to be the persons who executed the foregoing instrument, and to me known to be such President and Senior Vice-President of said corporation, and acknowledged that they executed the foregoing instrument as such officers as the said of said corporation, by its authority.

(Notary Seal)

Notary Public \_\_\_\_\_, Wisconsin

My Commission Expires \_\_\_\_\_

## COUNTY TREASURER'S CERTIFICATE

STATE OF WISCONSIN )  
WINNEBAGO COUNTY ) ss

I, Kirk H. Bradley, being the duly elected, qualified and acting Treasurer of the County of Winnebago, do hereby certify that the records in my office show no unrecorded tax sales and no unpaid taxes or special assessments as of \_\_\_\_\_, 1991, affecting the land included in the FIRST ADDITION TO KAITLYNN.

Date:

County Treasurer - Kirk H. Bradley

## CERTIFICATE OF CITY TREASURY

STATE OF WISCONSIN )  
WINNEBAGO COUNTY ) ss

I, Ed Soles, being the duly appointed, qualified, and acting City Finance Director of the City of Oshkosh, do hereby certify that, in accordance with the records in my office, there are no unpaid taxes or unpaid special assessments as of \_\_\_\_\_, 1991, on any of the land included in the FIRST ADDITION TO KAITLYNN.

Date:

City Finance Director - Ed Soles

## CITY COUNCIL RESOLUTION

Resolved, that the FIRST ADDITION TO KAITLYNN in the City of Oshkosh, Kurt A. Koeppler, Thomas N. Runch, and La Vern Klement, owners, is hereby approved by the Common Council.

Date:

Approved: Common Council Representative

Date:

Signed: Common Council Representative

I hereby certify that the foregoing is a copy of a resolution adopted by the Common Council of the City of Oshkosh.

City Clerk - Donna G. Service




Dated this 14<sup>th</sup> day of January, 1991  
*Steven T. Chronis*  
 Steven T. Chronis  
 Wisconsin Registered Land Surveyor, #4913

DRIVE

87.63'


KAITLYNN

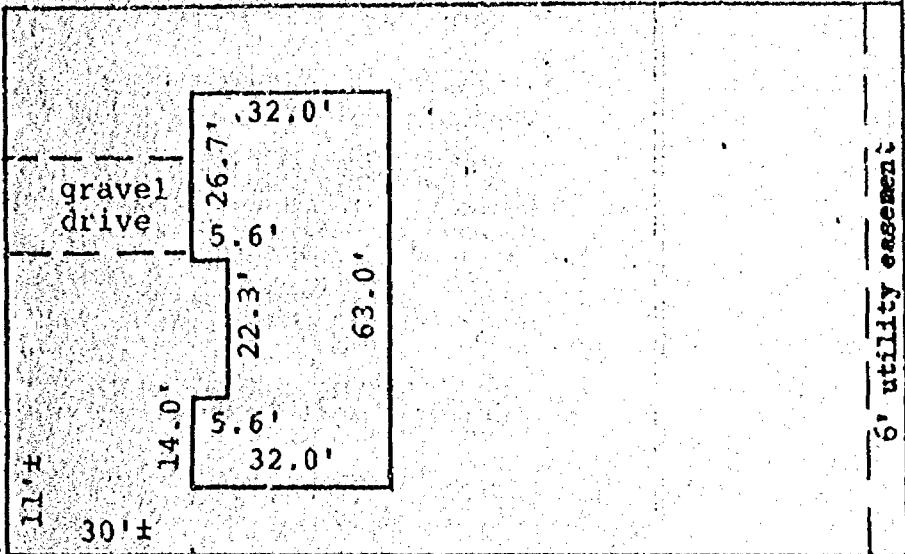

Legal Description: Lot Seventeen (17) in KAITLYNN, In the Twelfth Ward, City of Oshkosh, Winnebago County, Wisconsin

RICKY A. AND DEBRA A. GARBE  
2570 KAITLYNN DRIVE, OSHKOSH  
FOUNDATION ONLY  
NO BUILDING ENCROACHMENTS PRESENT

88.26'

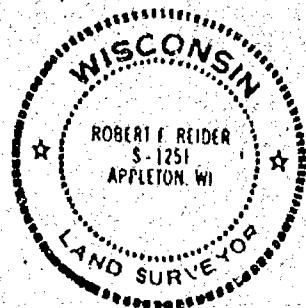

*Robert F. Reider*

I, Robert F. Reider, certify that this mortgagee's inspection was made by us or under my direction and control of the described property according to the official records and that this drawing is a true representation of the principal building lines thereon and was based on occupational evidence, existing monuments, if any, and municipal improvements.

This is not a Boundary Survey nor intended to be one.  
This mortgage inspection was made for the exclusive use of:  
Oshkosh Savings & Loan

The Surveyor and Client agree that this work will not meet the minimum standards for property surveys (Chapter A-E 7, Wisconsin Administrative Code) in the following respects. A-E 7.01(2)

- 1) The bearing reference will not be expressed [A-E 7.05(2)]
- 2) No monuments will be set to mark property corners [A-E 7.05(4), 7.07]
- 3) Distances and angles will not be measured to the accuracy specified in the Standards [A-E 7.05(3)(5), 7.08(2)(3)(4)(5)]
- 4) The exact length and bearing of the boundaries will not be shown. [A-E 7.05(4), 7.08(5)]

REVISIONS	Oshkosh Savings & Loan P. O. Box 80, Oshkosh, Wisconsin 54902-0080		
	CAHOW LAND SURVEYING CO., INC., P.O. BOX 1297 1837 W. WISCONSIN AVE., APPLETON, WI 54912		
DRAWN BY CP MS DV	SCALE 1"=30'	DRAWING NO 92-44	
XPOO	DATE 7-23-92		

Chapter A-E 8

MINIMUM STANDARDS FOR PROPERTY SURVEYS

A-E 8.01 Minimum standards for prop. A-E 8.02 U.S. public land survey monu-  
ents record

**A-E 5.01 Minimum standards for property surveys.** (1) **Scope.** The minimum standards of this section apply to every property survey performed in this state except that,

(a) Where other standards for property surveys are prescribed by statute, administrative rule or ordinance, then such standards shall govern; and

(b) The land surveyor and his or her client or employer may agree in a signed statement to exclude any land surveying work from the requirements of this section except the preparation of a U.S. Public Land Survey Monument Record, providing any map prepared by the land surveyor for the client or employer includes a note which states that an agreement to exclude work from the requirements of this section has been made, the names of the parties making the agreement and a description in plain language of the requirements not complied with.

(2) **PROPERTY SURVEY, DEFINITION.** In this section, "property survey" means any land surveying which includes as one of its principal purposes describing, monumenting, locating the boundary lines of or mapping one or more parcels of land. The term includes the restoration, perpetuation or reestablishment of a U.S. public survey corner.

(3) **BOUNDARY LOCATION.** Every property survey should be made in accordance with records of the register of deeds as nearly as is practicable. The surveyor shall acquire data necessary to retrace record title boundaries such as deeds, maps, certificates of title, and center lines and other boundary line locations. The surveyor shall analyze the data and make a careful determination of the position of the boundaries of the parcel being surveyed. The surveyor shall make a field survey, traversing and connecting monuments necessary for location of the parcel and coordinate the facts of such survey with the analysis. The surveyor shall set monuments marking the corners of such parcel unless monuments already exist at such corners.

(4) **DESCRIPTIONS.** Descriptions defining land boundaries written for conveyance or other purposes shall be complete, providing definite and unequivocal identification of lines or boundaries. The description must contain necessary ties to adjacents together with data of dimensions sufficient to enable the descriptor to be mapped and retraced and shall describe the land surveyed by government lot, recorded private claim, quarter-quarter section, section, township, range and county, and by metes and bounds commencing with some corner marked and established by the U.S. public land survey; or if such land is located in a recorded subdivision or recorded addition thereto, then by the number or other description of the lot, block or subdivision thereof which has been previously tied to a corner marked and established by the U.S. public land survey.

Register, August, 1982, No. 320

(5) **MAPS.** A map shall be drawn for every property survey showing information developed by the survey and including the following elements:

(a) The map shall be drawn to a convenient scale;

(b) The map shall be referenced as provided in s. 59.61, Stats.;

(c) The map shall show the exact length and bearing of the boundaries of the parcels surveyed. Where the boundary lines show bearings, lengths or locations which vary from those recorded in deeds, abutting plats, or other instruments there shall be the following note placed along such lines, "recorded as (show recorded bearing, length or location)";

(d) The map shall show and describe all monuments necessary for the location of the parcel and shall indicate whether such monuments were found or placed;

(e) The map shall identify the person for whom the survey was made, the date of the survey, and shall describe the parcel as provided in (4), above;

(f) The map shall bear the stamp or seal and signature of the land surveyor under whose direction and control the survey was made with a statement certifying that the survey is correct to the best of his knowledge and belief.

(6) **MEASUREMENTS.** (a) Measurements shall be made with instruments and methods capable of attaining the required accuracy for the particular problem involved.

(b) The minimum accuracy of linear measurements between points shall be 1 part in 3,000 on all property lines of boundary or interior surveys.

(c) In a closed traverse the sum of the measured angles shall agree with the theoretical sum by a difference not greater than 30 seconds per angle, or the sum of the total angles shall not differ from the theoretical sum by more than 120 seconds, whichever is smaller.

(d) Any closed traverse depicted on a property survey map shall have a latitude and departure closure ratio of less than 1 in 3,000.

(e) Bearings or angles on any property survey map shall be shown to the nearest minute; distances shall be shown to the nearest 1/100th foot.

(7) **MONUMENTS.** The type and position of monuments to be set on any survey shall be determined by the nature of the survey, the permanency required, the nature of the terrain, the cadastral features involved, and the availability of material.

History: Cr. Register, June, 1974, No. 222, eff. 7-1-74; am. (b) (e) and (6) (e), Register, June, 1975, No. 231, eff. 7-1-75; am. (1) (b), Register, January, 1982, No. 313, eff. 8-1-82; am. (1) (b) and (1) and recr. (2), Register, August, 1982, No. 320, eff. 8-1-82.

**A-E 5.02 U.S. public land survey monument record.** (1) **WHEN MONUMENT RECORD REQUIRED.** A U.S. public land survey monument record shall be prepared as part of any land survey which includes or requires the perpetuation, restoration or reestablishment of a U.S. public land survey corner, and, either,

Register, August, 1982, No. 320