



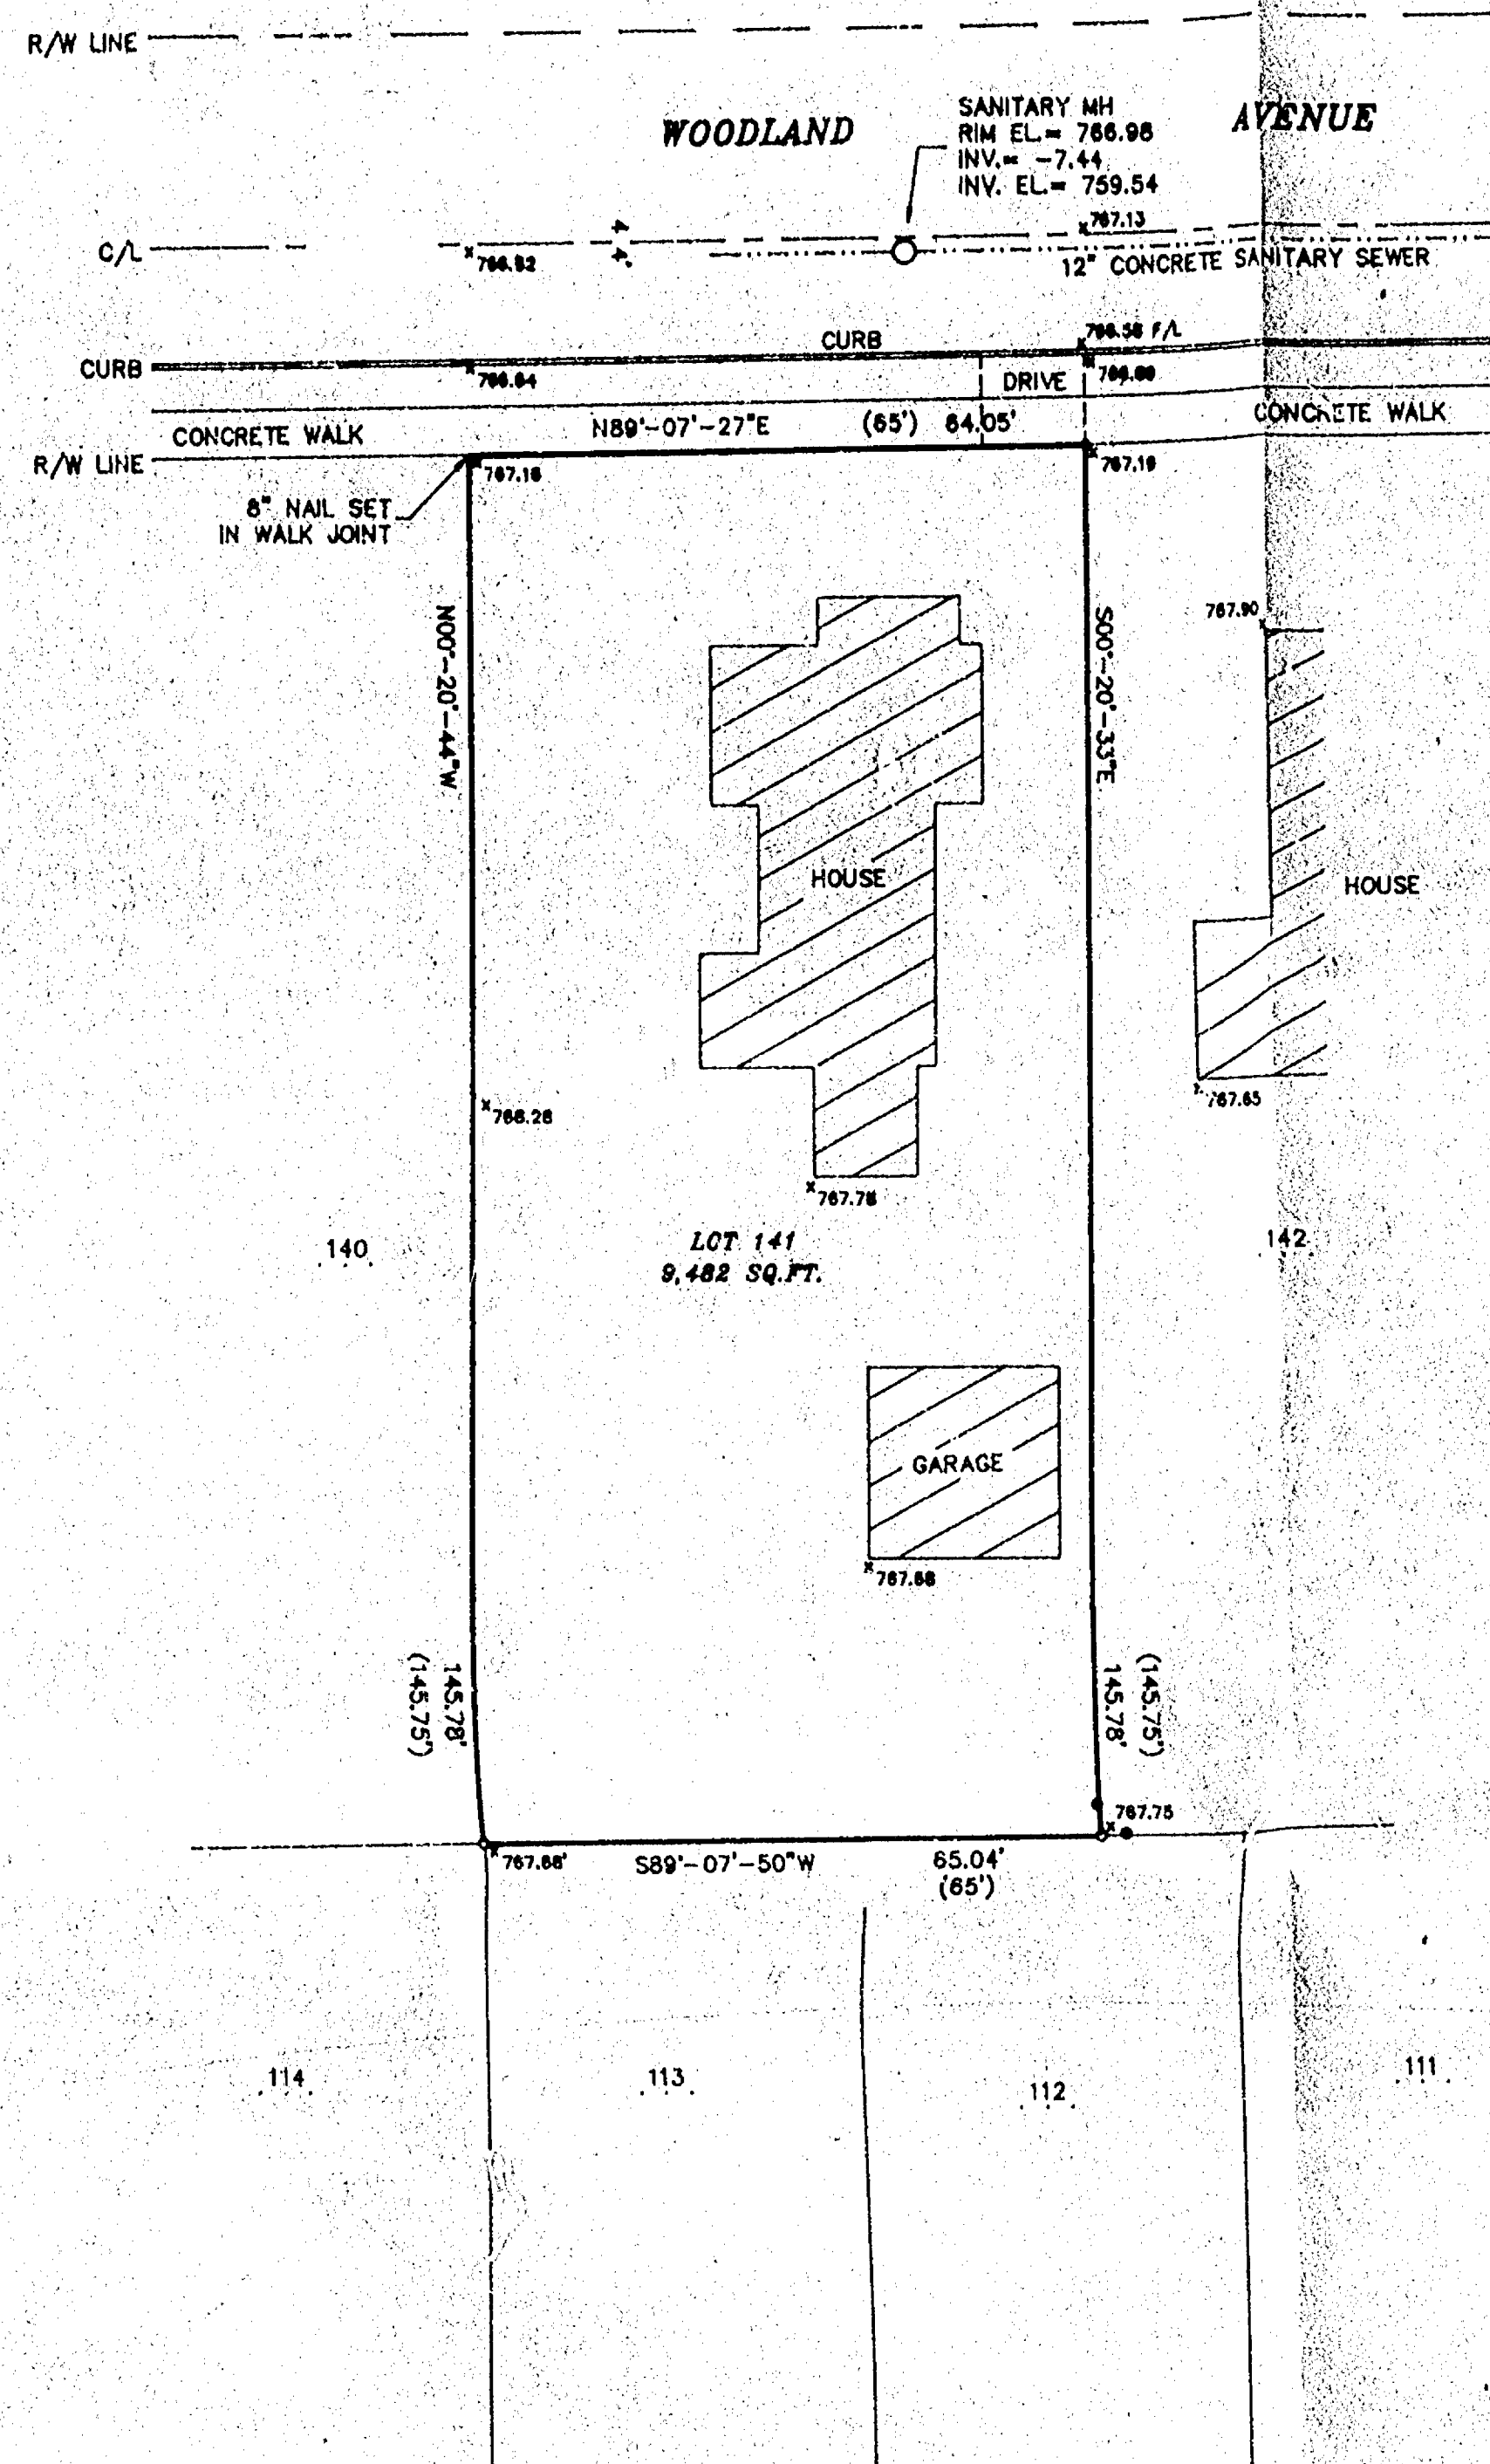


— LEGEND —

- = 1" x 24" IRON PIPE SET
- = 3/4" IRON PIPE FOUND
- = 1" IRON PIPE FOUND
- () = RECORDED INFORMATION

ALL ELEVATIONS REFERENCED
TO CITY OF OSHKOSH DATUM

ALL UTILITIES WERE FIELD LOCATED
OR TAKEN FROM CITY RECORDS

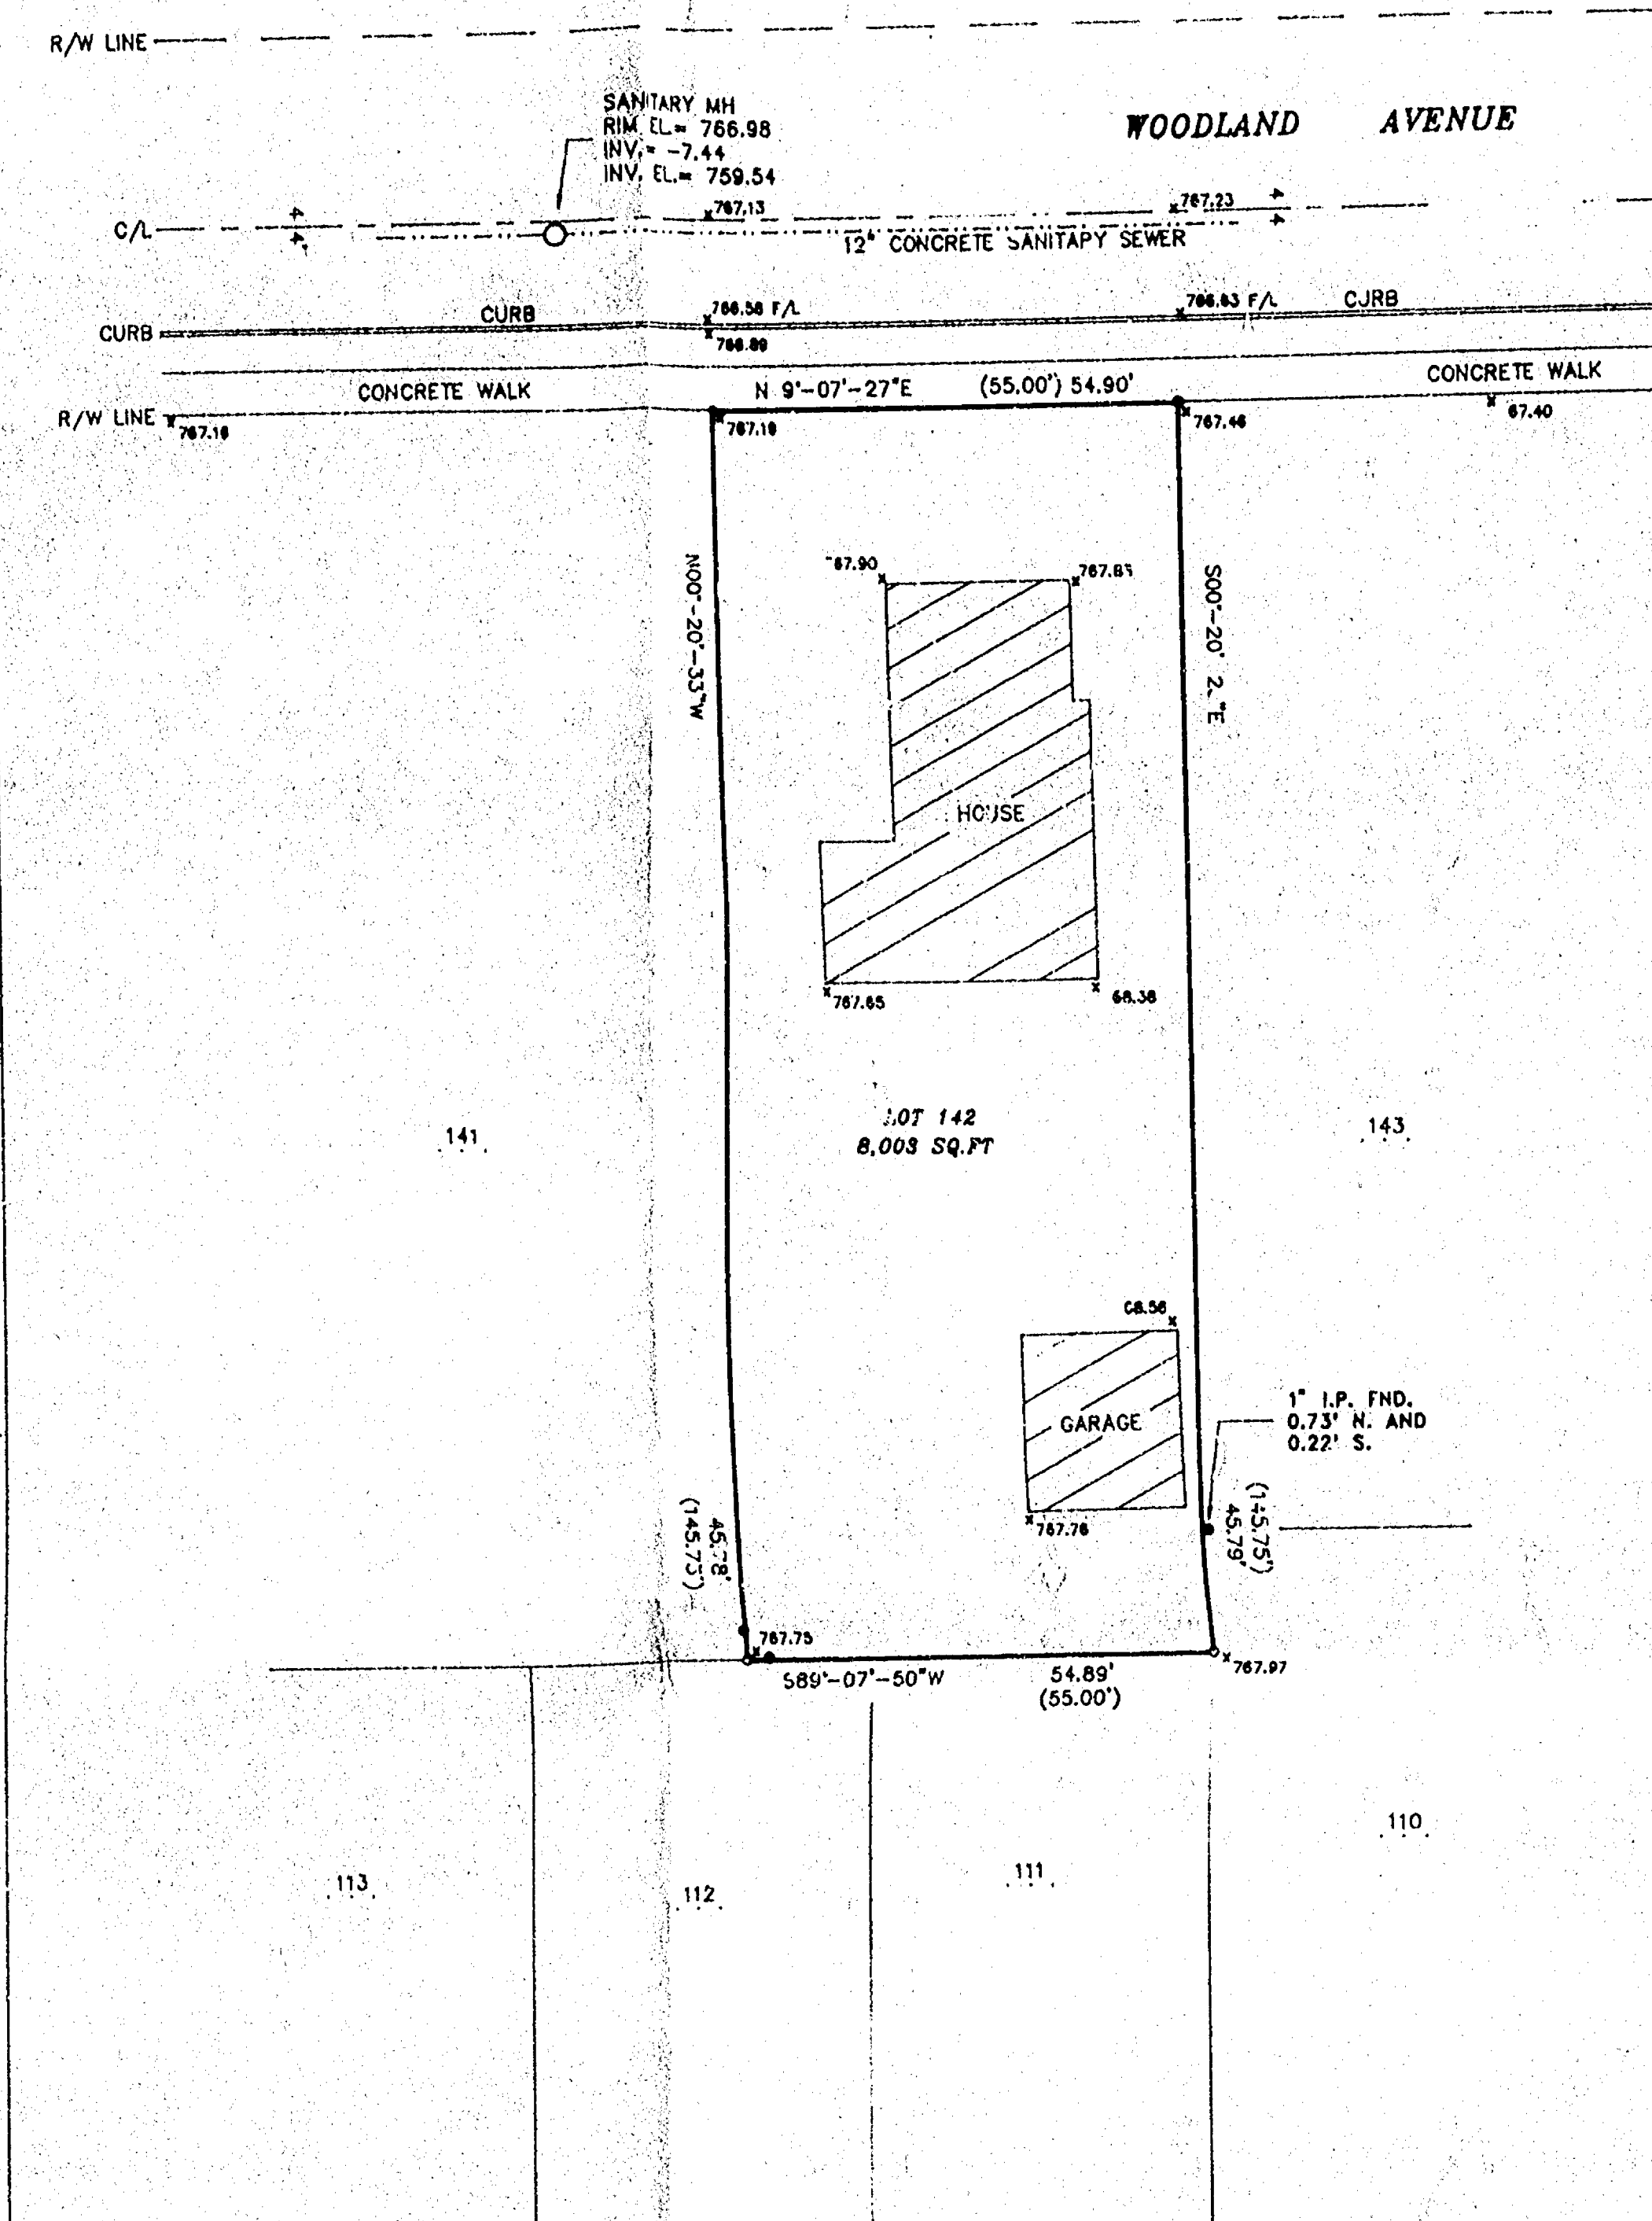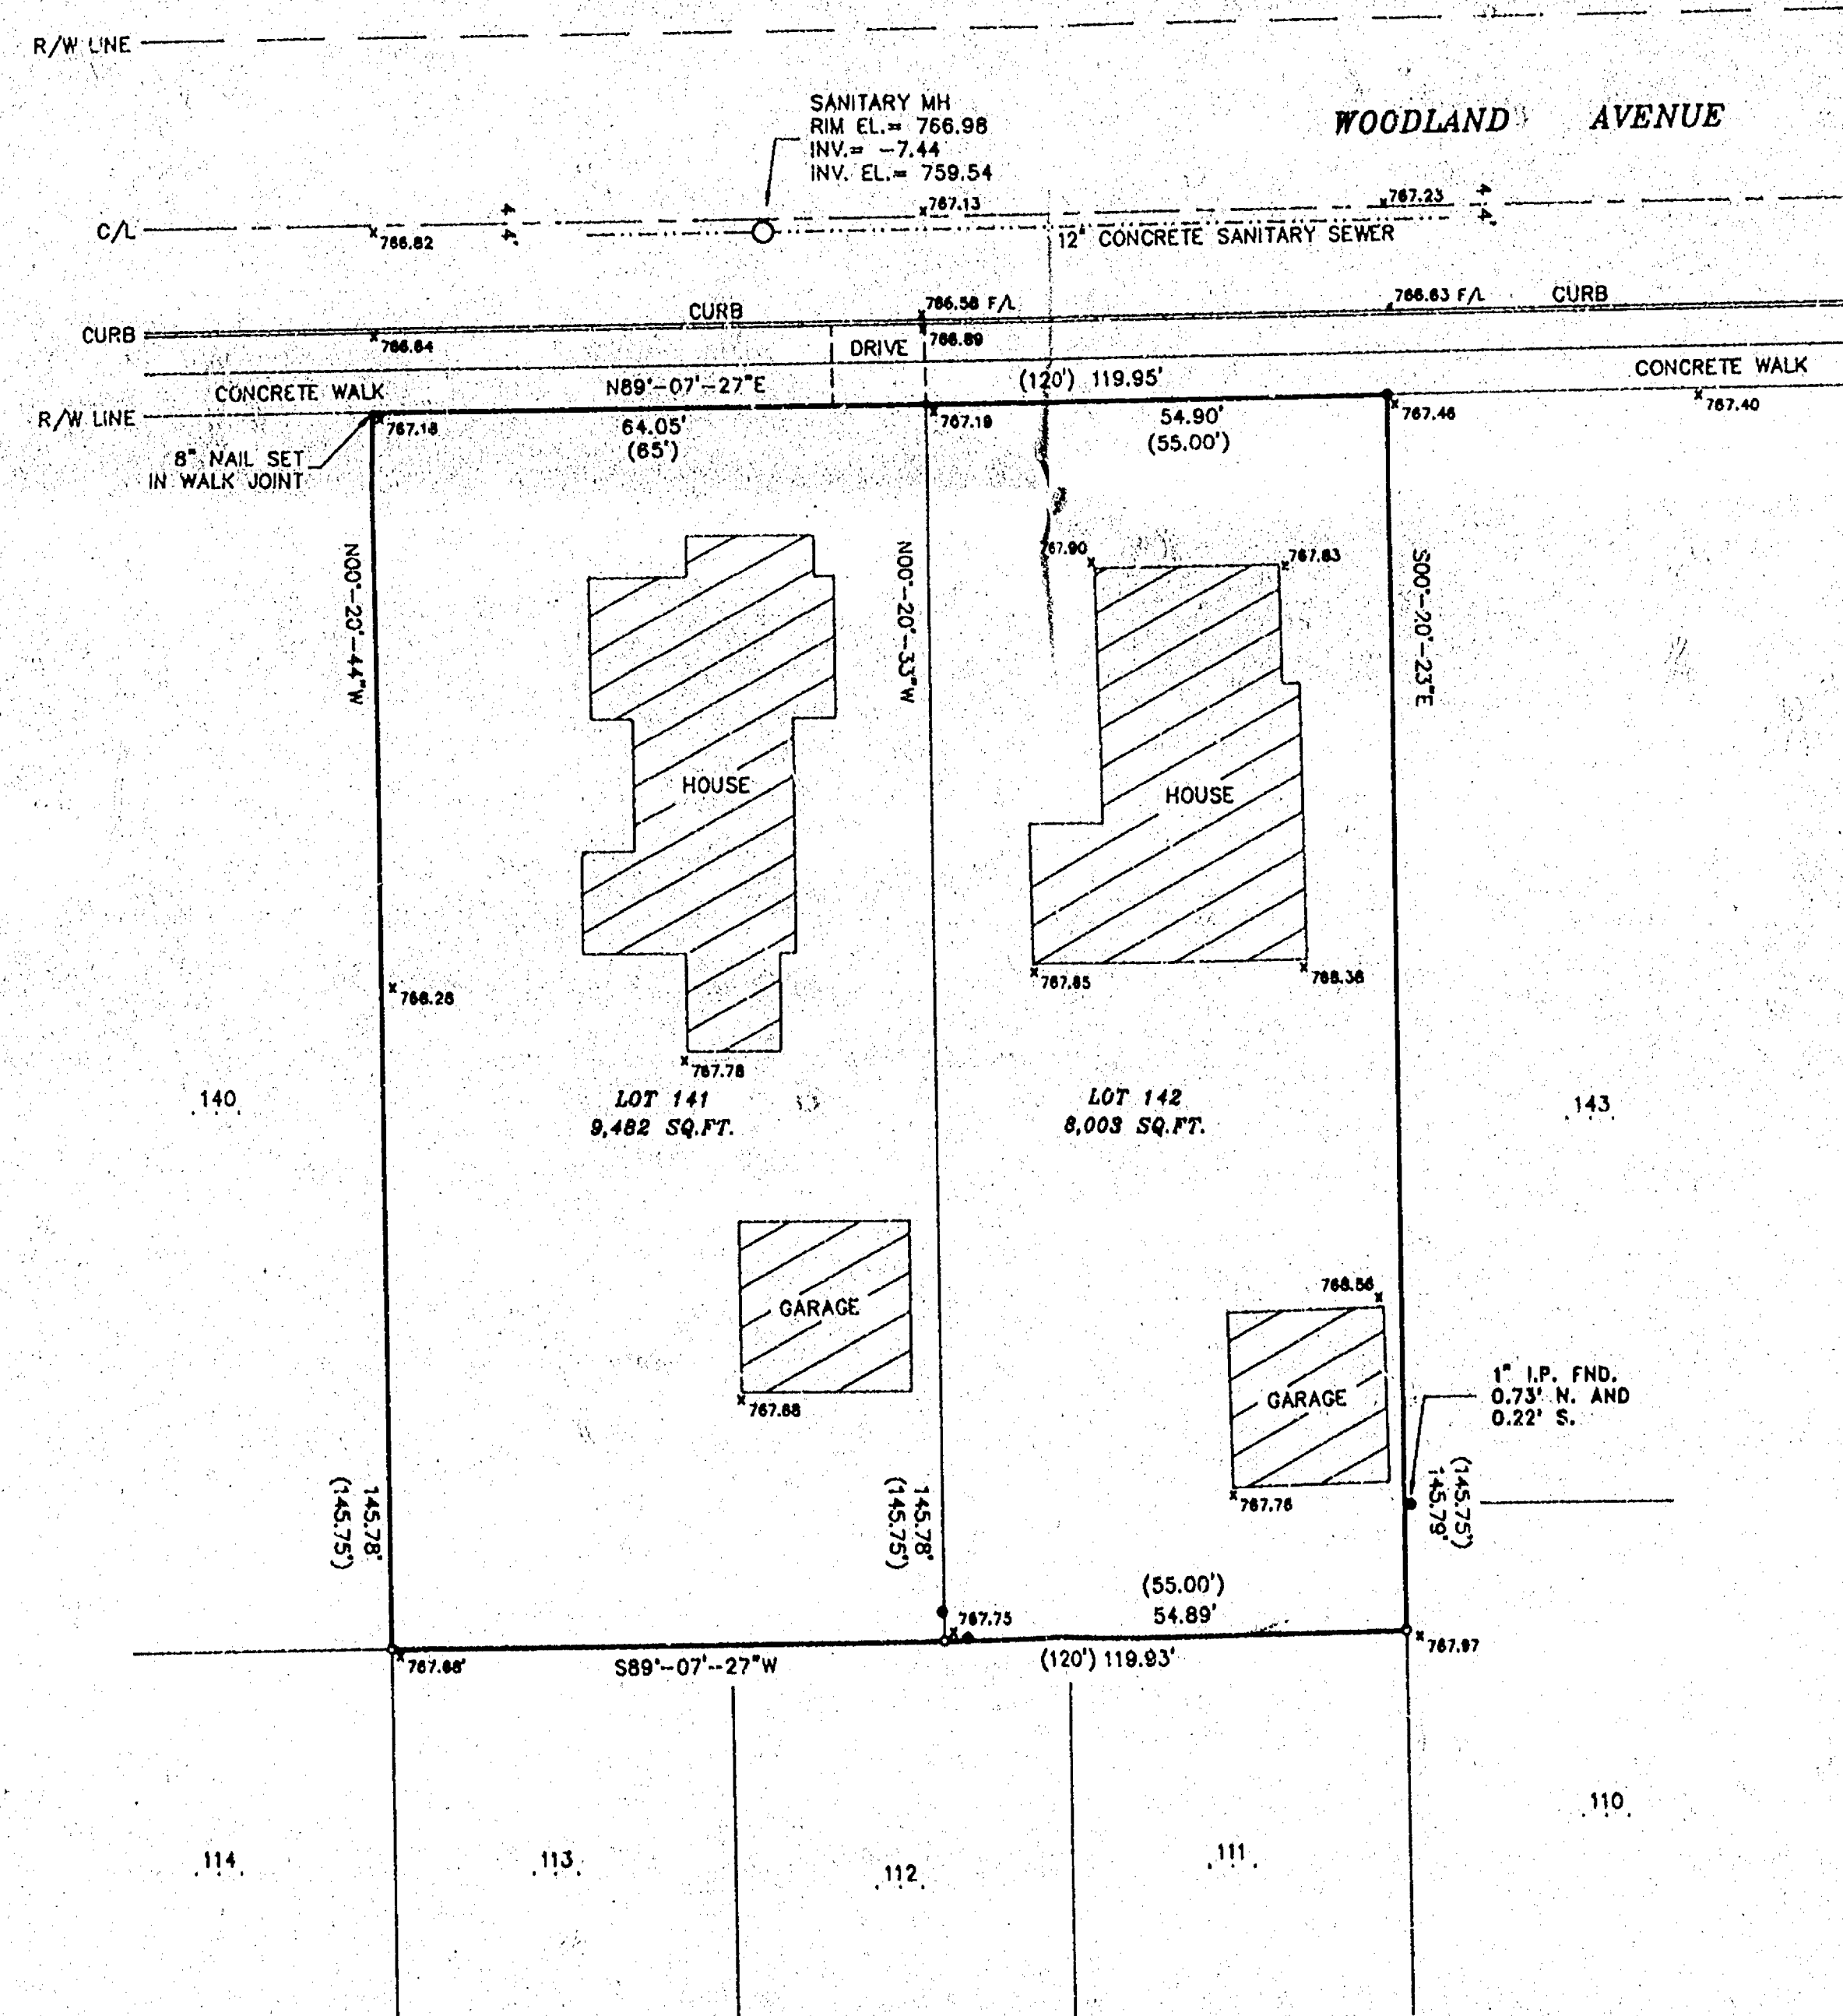


SURVEYORS CERTIFICATE

I, Lawrence C. Kriescher, Wisconsin Registered Land Surveyor of Aero-Metric Engineering, Inc., certify that I have surveyed the described property and that the maps shown are a true and accurate representation thereof to the best of my knowledge and belief.

Dated this 10TH day of OCTOBER, 1994.

Lawrence C. Kriescher
Lawrence C. Kriescher, S-1599
WISCONSIN REGISTERED LAND SURVEYOR

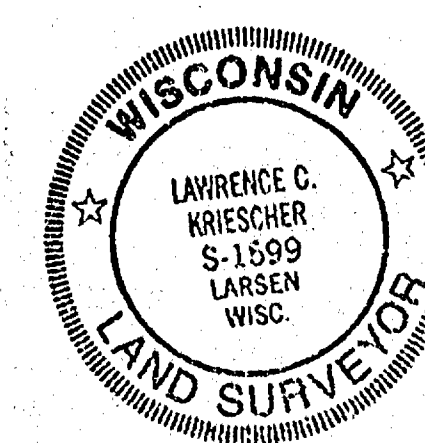

DATE: 10-10-94 SCALE: 1"=20'


REVISIONS:

DRAWN BY: S.S. CHECKED BY: L.C.K.

DWG. FILE: STRUNES3

PROJECT NO.: 2940902

NOTEBOOK: 129 PAGE: 40-45

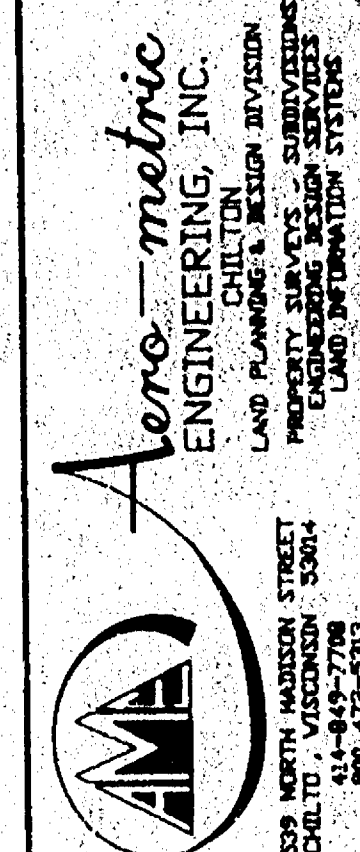

Only if the surveyor's signature or stamp is in RED is this an original copy. Anything other than an original copy may contain unauthorized alterations to the original.


The surveyor accepts no responsibility for non-original copies of this document.

SURVEY FOR
NICOLET INVESTMENTS

ALL OF LOT 141 AND LOT 142 OF CITY'S REPLAT NO. 2 IN THE 5TH WARD, CITY OF OSHKOSH, WINNEBAGO COUNTY, WISCONSIN.

SHEET NO.
1 OF 1

FILE NO.
K-467

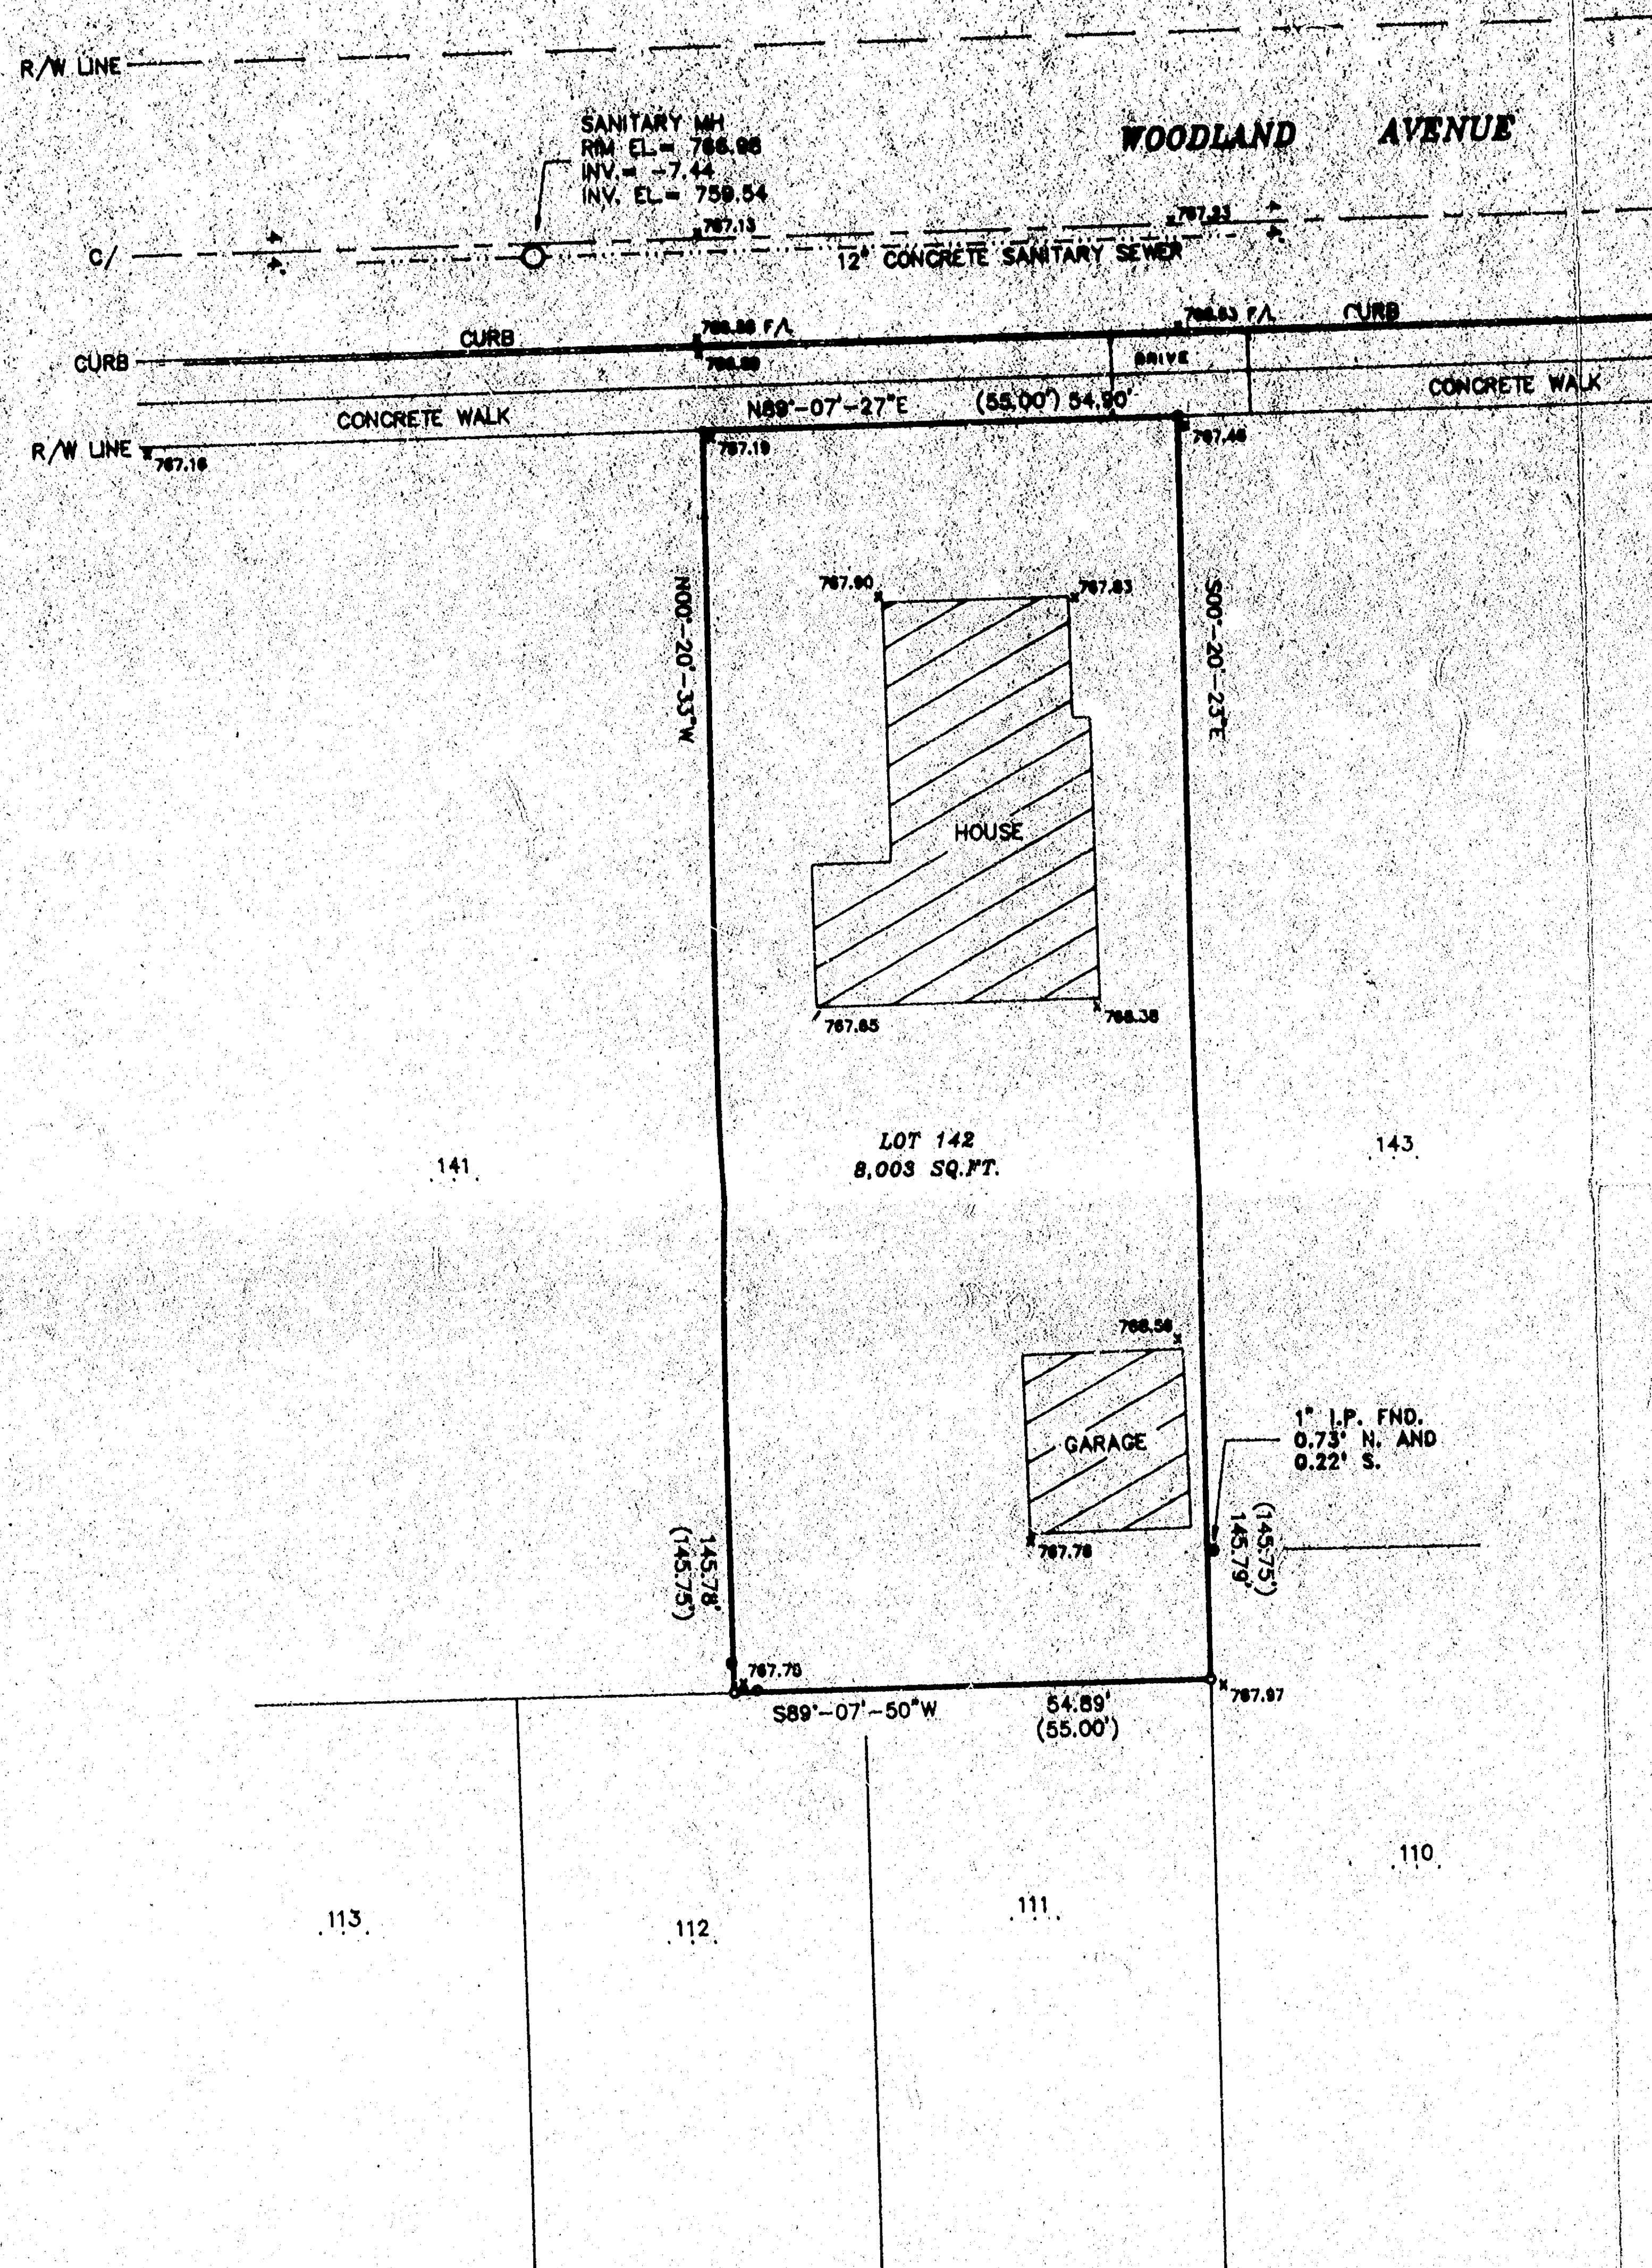

SURVEY **FOR** **NICOLET INVESTMENTS**


ALL OF LOT 142 OF CITY'S REPLAT
NO. 2 IN THE 5TH WARD, CITY OF OSHKOSH,
WINNEBAGO COUNTY, WISCONSIN.

SURVEYORS CERTIFICATE

I, Lawrence C. Kriescher, Wisconsin Registered Land Surveyor of Aero-Metric Engineering, Inc., certify that I have surveyed the above described property and that the map shown to the left is a true and accurate representation thereof to the best of my knowledge and belief.

Dated this 26TH day of SEPTEMBER, 1994.

Lawrence C. Kriescher
WISCONSIN REGISTERED LAND SURVEYOR
Lawrence C. Kriescher, S-1599

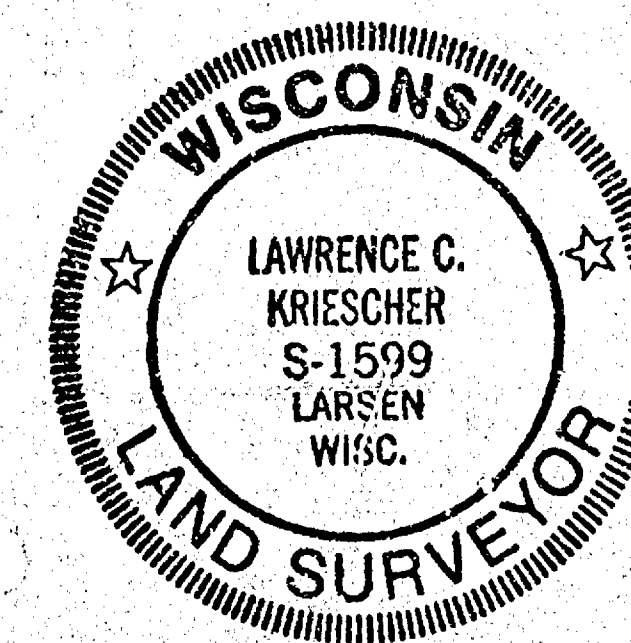


- LEGEND -

- = 1"x24" IRON PIPE SET
- = 3/4" IRON PIPE FOUND
- = 1" IRON PIPE FOUND
- () = RECORDED INFORMATION


ALL ELEVATIONS REFERENCED
TO CITY OF OSHKOSH DATUM

ALL UTILITIES WERE FIELD LOCATED
OR TAKEN FROM CITY RECORDS

Only if the surveyor's signature or stamp
is in RED is this an original copy. Anything
other than an original copy may contain
unauthorized alterations to the original.
The surveyor accepts no responsibility for
non-original copies of this document.

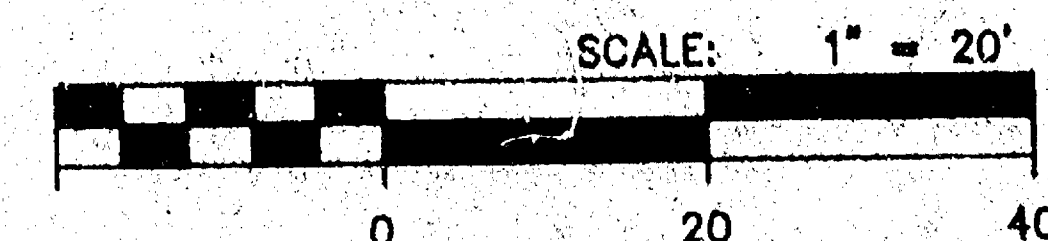

BEARINGS REFERENCED TO THE
SOUTH LINE OF WOODLAND AVENUE
ASSIGNED: N89°-07'-27"E

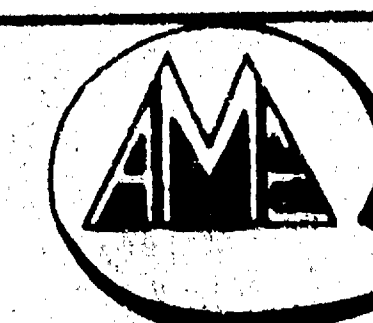

Aero-metric
ENGINEERING, INC.
CHILTON
LAND PLANNING & DESIGN DIVISION
PROPERTY SURVEYS & SUBDIVISIONS
ESTABLISHED 1968
LAND INFORMATION SYSTEMS

DRAWN BY : S.F.S. **DATE :** 09-23-94
PROJECT NO. : 2940902 **SCALE :** 1"=20"
DRAWING NAME : STRUNSE2
NOTEBOOK : 129 **PAGE :** 40-45 **D -** 429

City of Oshkosh City's REPLAT NO 2 5th Ward