


PLAT OF SURVEY

KNOWN AS 450 WEST 6TH AVENUE, BEING LOT 112 IN CITY'S REPLAT #3,
6TH WARD, CITY OF OSHKOSH, WINNEBAGO COUNTY, WISCONSIN.

MAY 31 1963

SURVEY FOR GLEN BARGENDER

SURVEY NO. 234

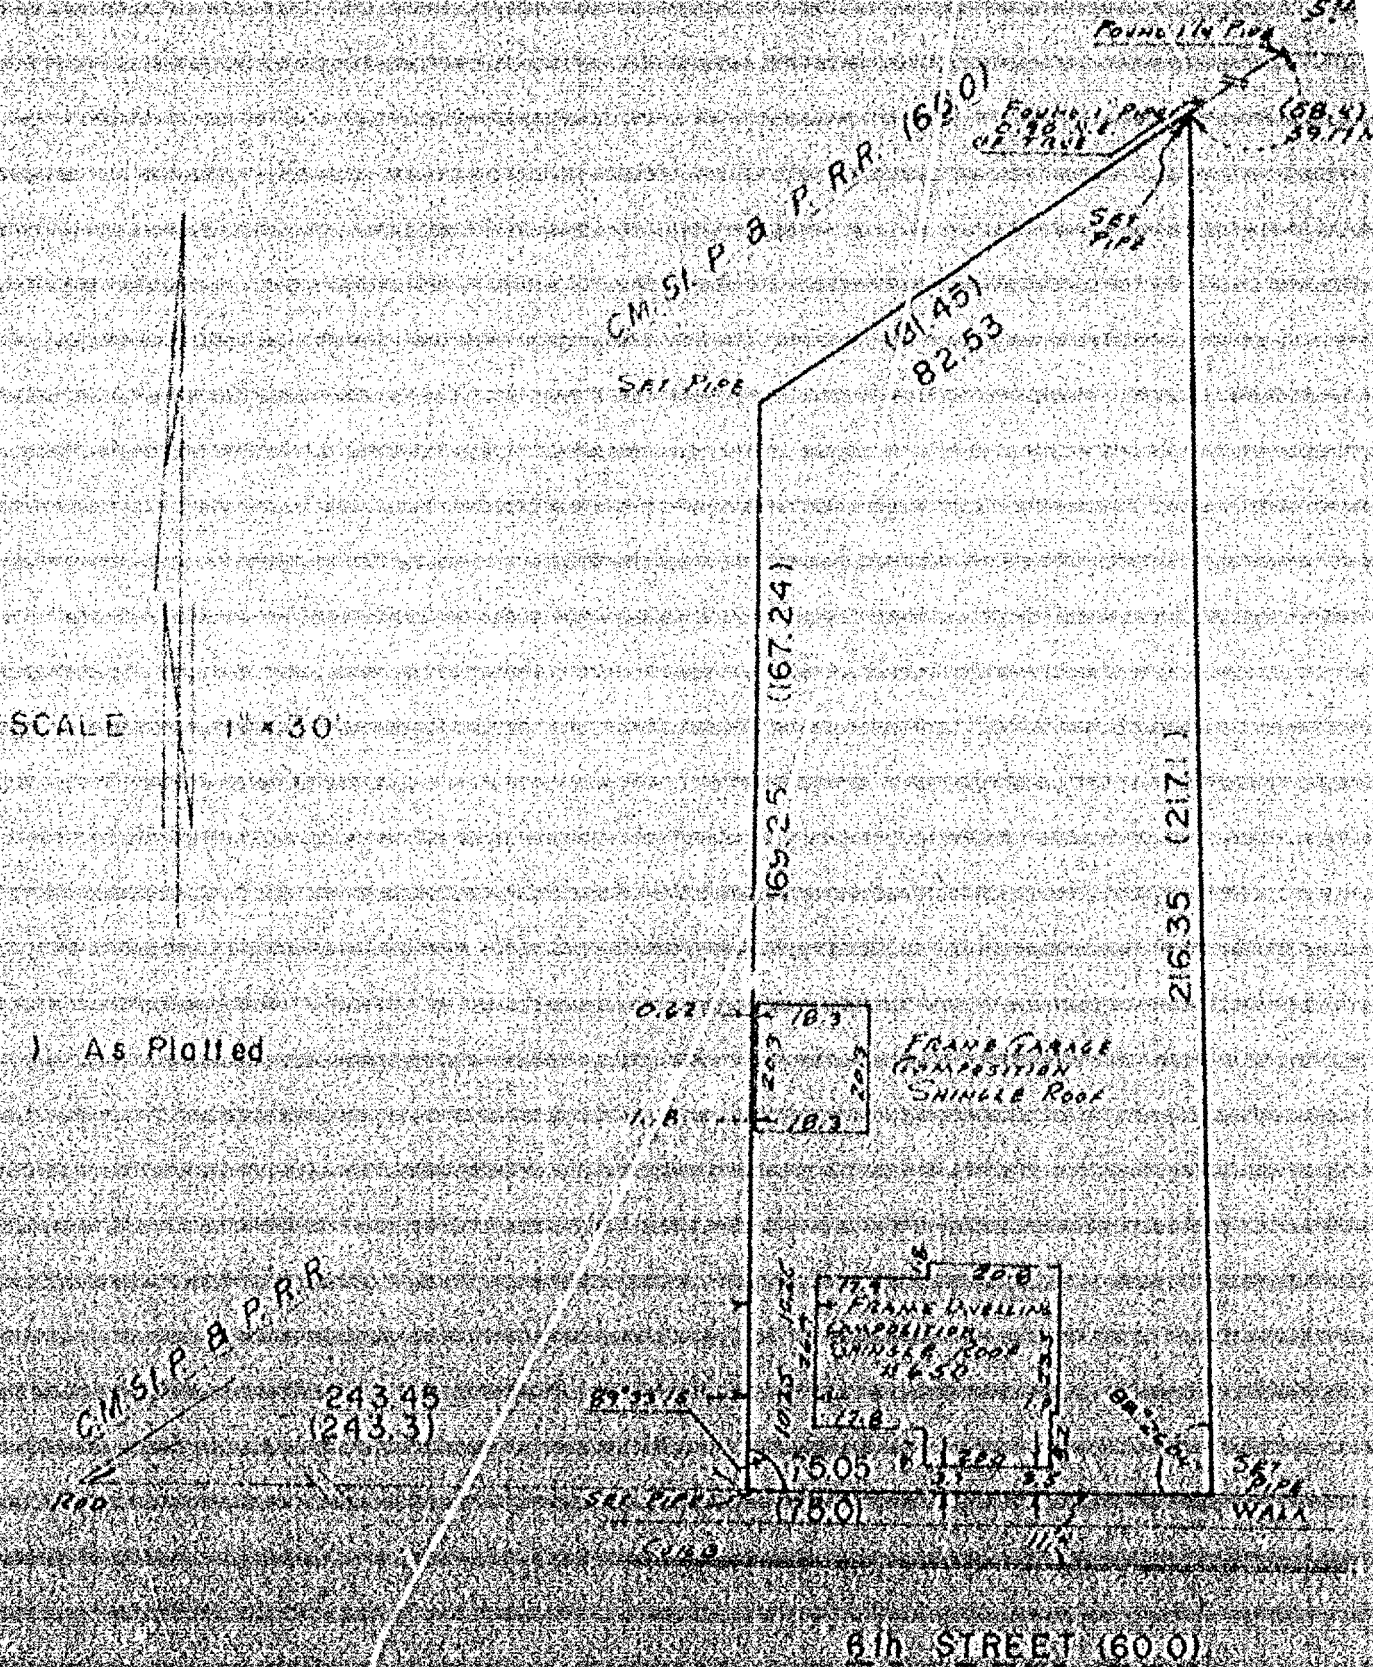


I Certify that I have surveyed the above described property (Property), and the above map is a true and correct representation thereof and shows the true and location of the Property, its exterior boundaries, the location and direction of all visible structures thereon, boundary lines, easements and easements and easements and visible attachments. This survey is made for the exclusive use of the present owners of the Property. I, the undersigned, do not and cannot guarantee the title thereto, with or without any other interest.



national survey & engineering

417 NORTH SAWYER STREET
OSHKOSH, WISCONSIN 54903

419-426-2800

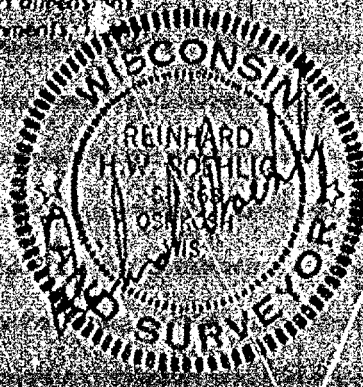


PLAT OF SURVEY

KNOWN AS 1508 D'ARLIO STREET, BEING LOT 15 IN BLOCK 9 OF MASTERSON'S PARK PLAT, IN THE 12TH WARD, CITY OF OSHKOSH, WINNEBAGO COUNTY, WISCONSIN

OCTOBER 7, 1993

SURVEY FOR JAMES PROVINCANO

SURVEY NO. 1326-S

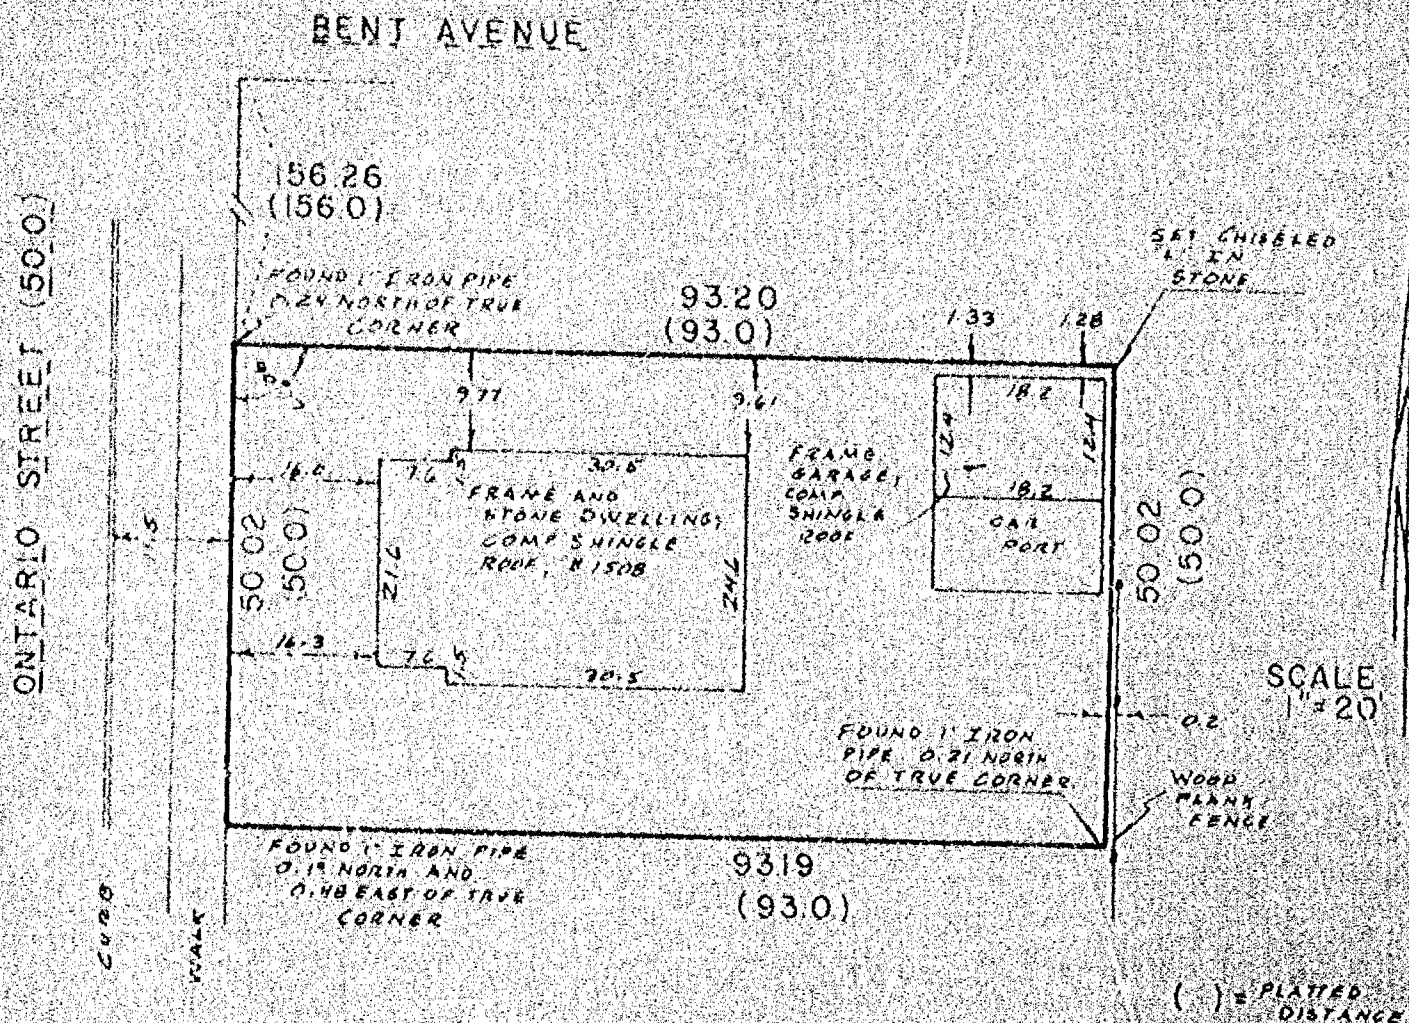

I Certify that I have surveyed the above described property (Property), and the above map is a true representation thereof and shows the size and location of the Property, its exterior boundaries, the location and dimensions of all visible structures thereon, boundary, fences, apparent easements and roadways and visible encroachments, if any. This survey is made for the exclusive use of the present owners of the Property, and also those who purchase, mortgage, or guarantee the title thereto, within one (1) year from date hereof.



national survey & engineering

417 NORTH SAWYER STREET / P.O. BOX 2963

OSHKOSH, WISCONSIN 54903

(414) 426-2800



PLAT OF SURVEY


KNOWN AS 1936 GROVE STREET, BEING LOT 109 IN THE THIRD ADDITION TO NORTH
POINT PLAT, IN THE 15th WARD, CITY OF OSHKOSH, WINNEBAGO COUNTY, WISCONSIN.

OCTOBER 10, 1983

SURVEY FOR OSHKOSH SAVINGS
APPLICANT: RICHARD EHKE
MONUMENT WAIVER ON FILE

SURVEY NO. 1329-M

MALLARD AVENUE

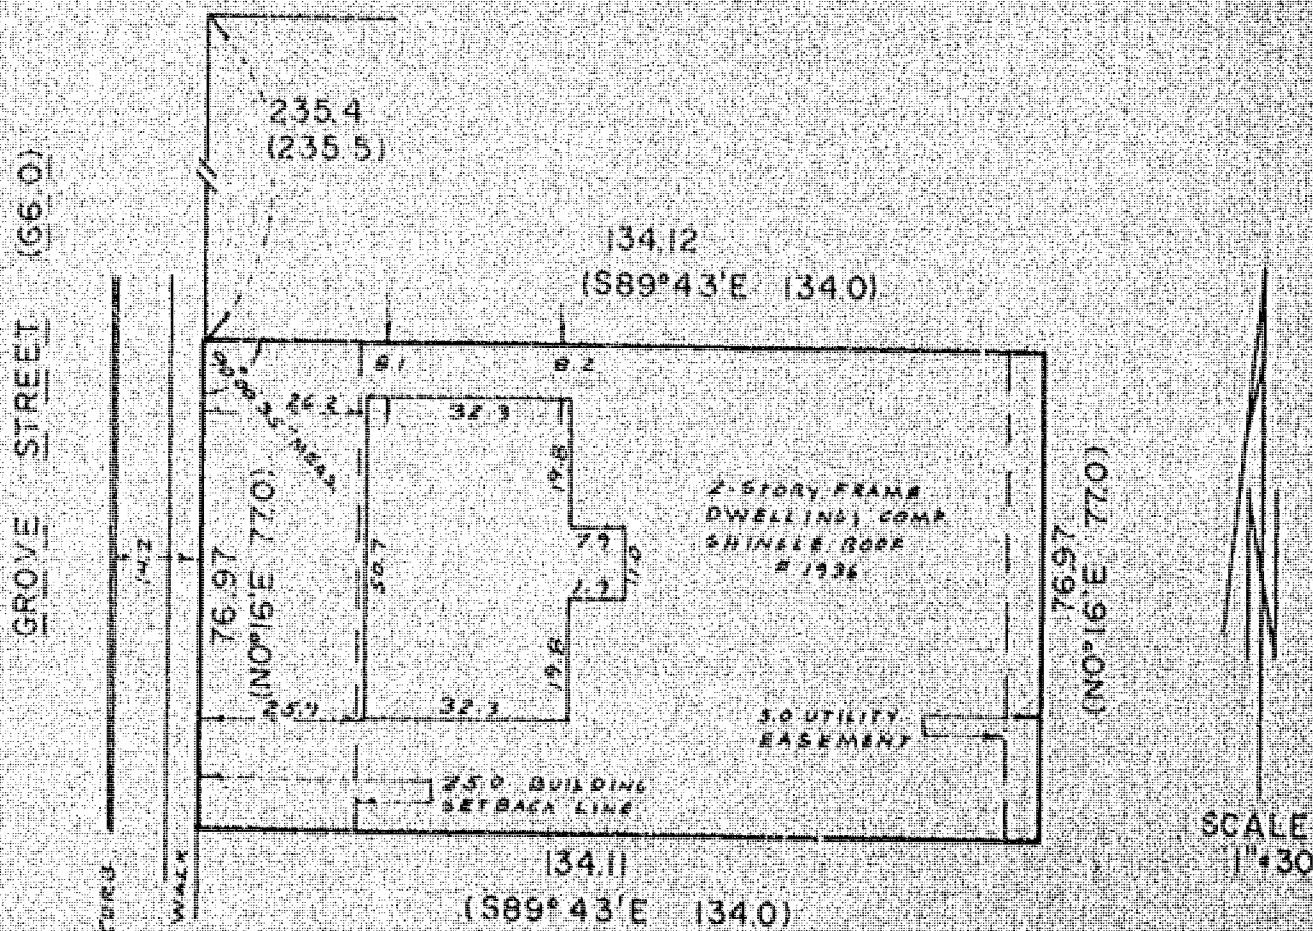

SCALE
1"=30'

() = Platted Dimension

I Certify that I have surveyed the above described property (Property), and the above map is a true representation thereof and shows the size and location of the Property, its exterior boundaries, the location and dimensions of all visible structures thereon, boundary, fence, apparent easements and roadways and visible encroachments, if any. This survey is made for the exclusive use of the present owners of the Property, and also those who purchase, mortgage, or guarantee the title thereto, within one (1) year from date hereof.



national survey & engineering

417 NORTH SAWYER STREET / P.O. BOX 2863
OSHKOSH, WISCONSIN 54903
(414) 428-2800



PLAT OF SURVEY

KNOWN AS 45 WEST 9TH AVENUE, BEING THE EAST 40.0 FT. OF THE NORTH 100.0 FT. OF LOT 2 IN BLOCK 16 OF THE PLAT OF THE ORIGINAL THIRD WARD, IN THE THIRD JARD, CITY OF OSHKOSH, PER LEACH'S MAP OF 1894, WINNEBAGO COUNTY, WISCONSIN.


OCTOBER 10, 1983

SURVEY FOR OSHKOSH SAVINGS
APPLICANT: RALPH MARTIN
MONUMENT-WAIVER ON FILE

SURVEY NO. 1330-11

NINTH AVENUE (60.0)

NEBRASKA STREET

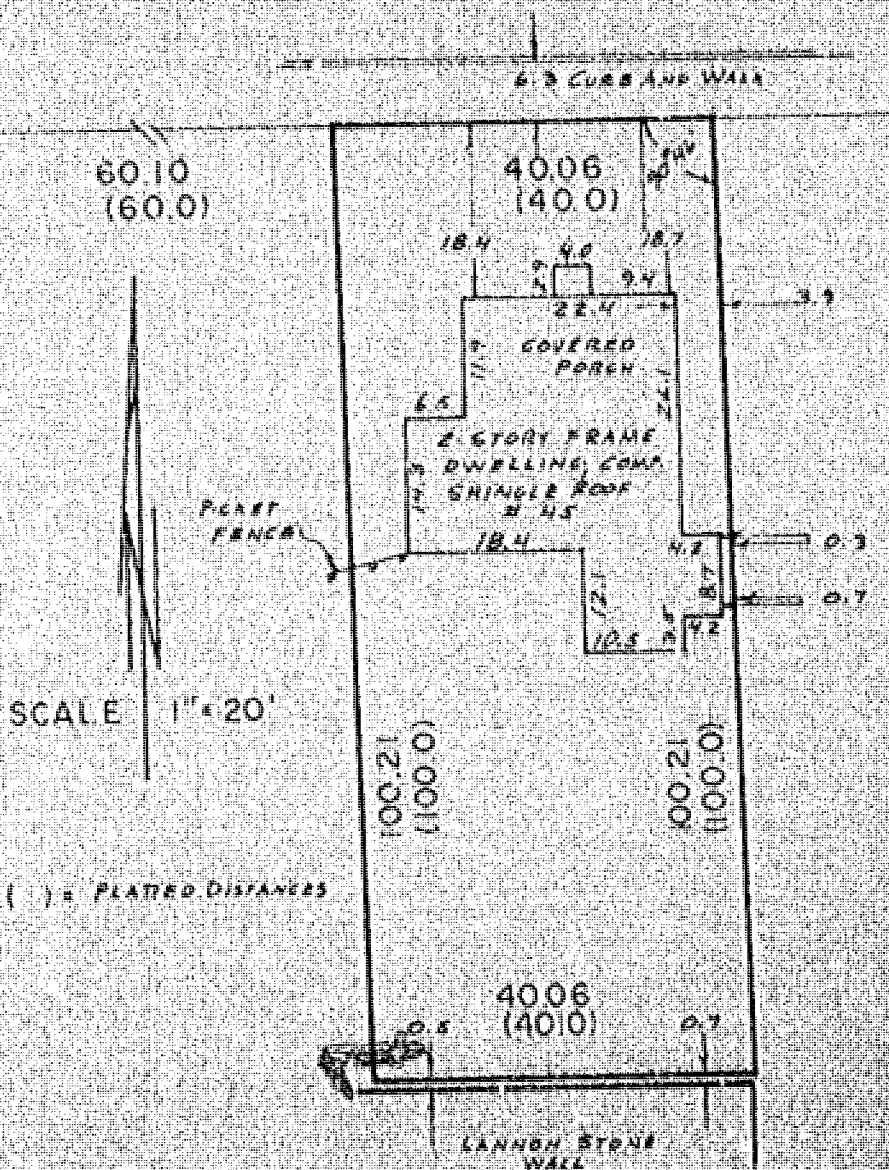

I Certify that I have surveyed the above described property (Property), and the above map is a true representation thereof and shows the size and location of the Property, its exterior boundaries, the location and dimensions of all visible structures thereon, boundary, fences, apparent easements and roadways and visible encroachments, if any. This survey is made for the exclusive use of the present owners of the Property, and of so those who purchase, mortgage, or guarantee the title thereto, within one (1) year from date hereof.



National Survey & Engineering
411 NORTH SAWYER STREET / P.O. BOX 1963
OSHKOSH, WISCONSIN 54903
(414) 428-2800



PLAT OF SURVEY


KNOWN AS 813 VINE STREET, BEING LOT 85 IN CITY'S REPLAT NO. 1, IN THE FIFTH JARD, CITY OF OSHKOSH, WINNEBAGO COUNTY, WISCONSIN.

OCTOBER 13, 1983

SURVEY FOR OSHKOSH SAVINGS
APPLICANT: DOUGLAS HUNT
MONUMENT WAIVER ON FILE

SURVEY NO. 1331-M

VINE STREET (60.0)

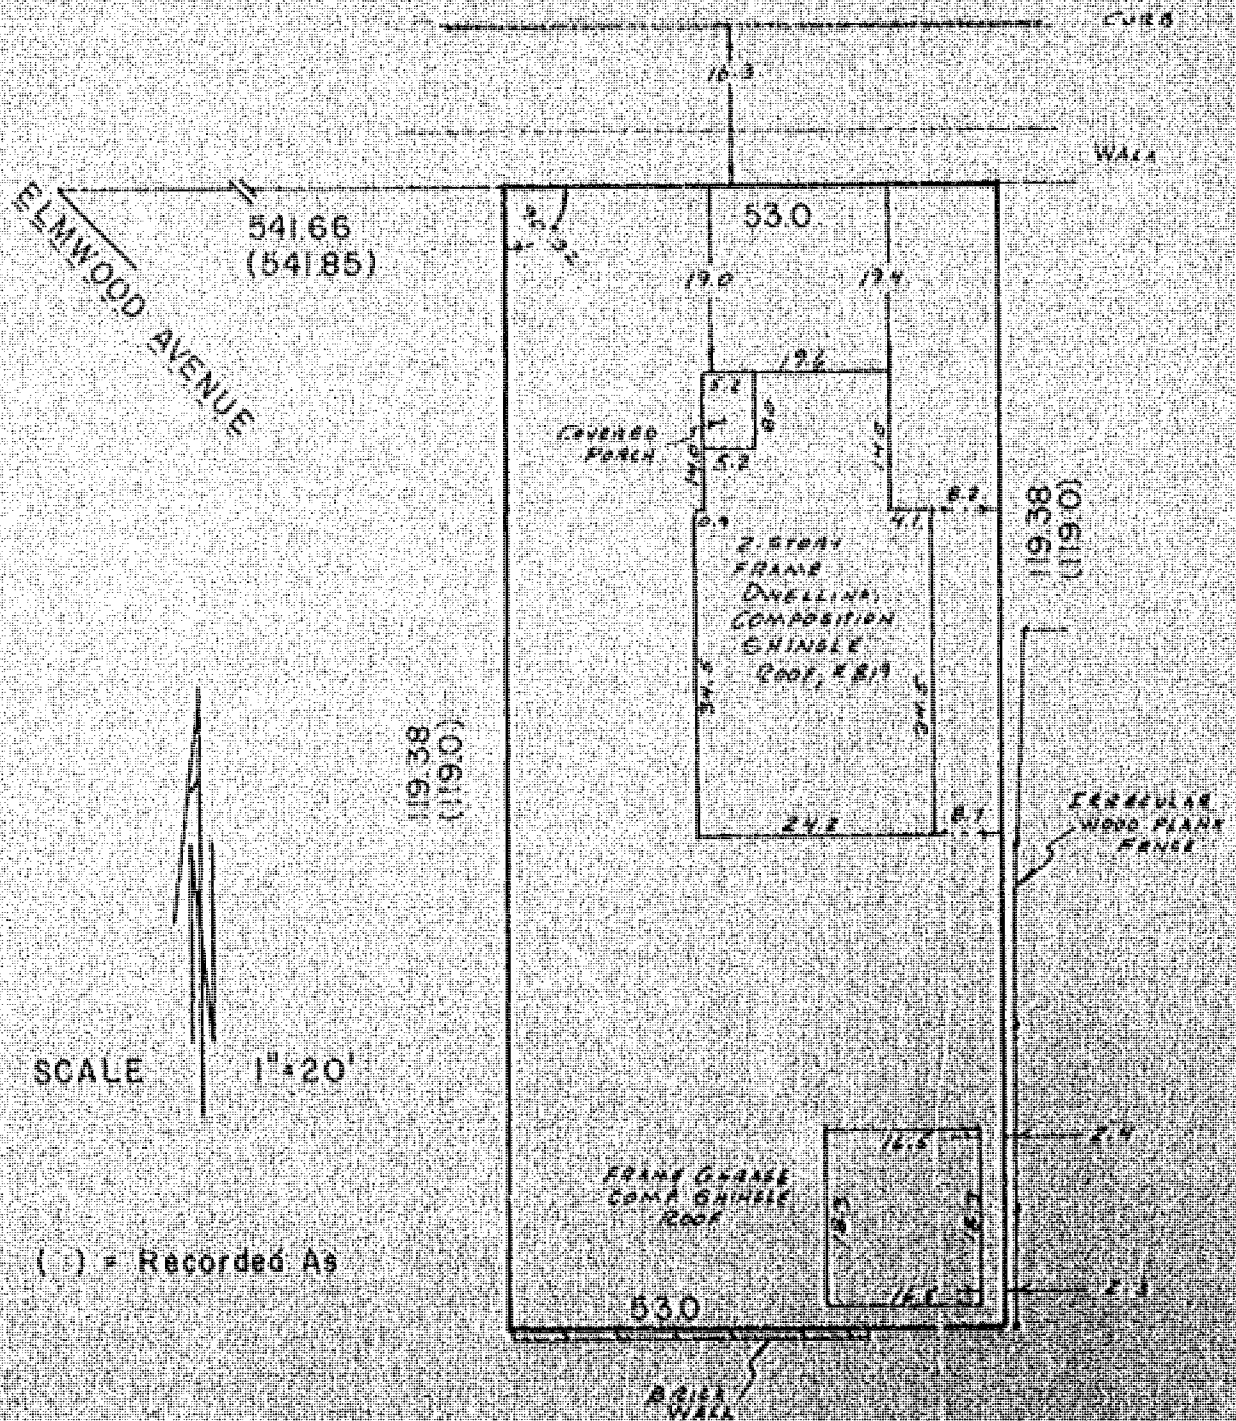

I Certify that I have surveyed the above described property (Property), and the above map is a true representation thereof and shows the size and location of the Property, its exterior boundaries, the location and dimensions of all visible structures thereon, boundary, fences, apparent easements and roadways and visible encroachments, if any. This survey is made for the exclusive use of the present owners of the Property, and all those who purchase, mortgage, or guarantee the title thereto, within one (1) year from date hereof.



National Survey & Engineering

317 NORTH SAWYER STREET / PO BOX 2963
OSHKOSH, WISCONSIN 54903
(414) 428-2800



PLAT OF SURVEY

OCTOBER 19, 1983
SURVEY FOR OSHKOSH SAVINGS
APPLICANT: M. C. HOUGE
SURVEY NO. 1333-S



O = 1" DIAMETER P.H.
SER OR FOUND



national survey & engineering
117 NORTH SAWYER STREET / P.O. BOX 2963
OSHKOSH, WISCONSIN 54903
(414) 426-3800


PLAT OF SURVEY

LOT 7 AND THE NORTH 10.0 FT. FRONT AND REAR OF LOT 8 IN SMITH GROVE LAND COMPANY'S REPLAT OF LOTS 25 THROUGH 48 INCLUSIVE AND LOTS 53, 54, 55, 56, 60, 61, 62, 63, 64, 66, 67, 68 IN LOTS SMITH'S ADDITION, THIRD WARD, CITY OF OSHKOSH, AND NOW IN THE 14TH WARD OF SAID CITY, WINNEBAGO COUNTY, WISCONSIN.

OCTOBER 18, 1983

SURVEY FOR OSHKOSH SAVINGS
APPLICANT: PECK
MONUMENT WAIVER ON FILE

SURVEY NO. 1335-1

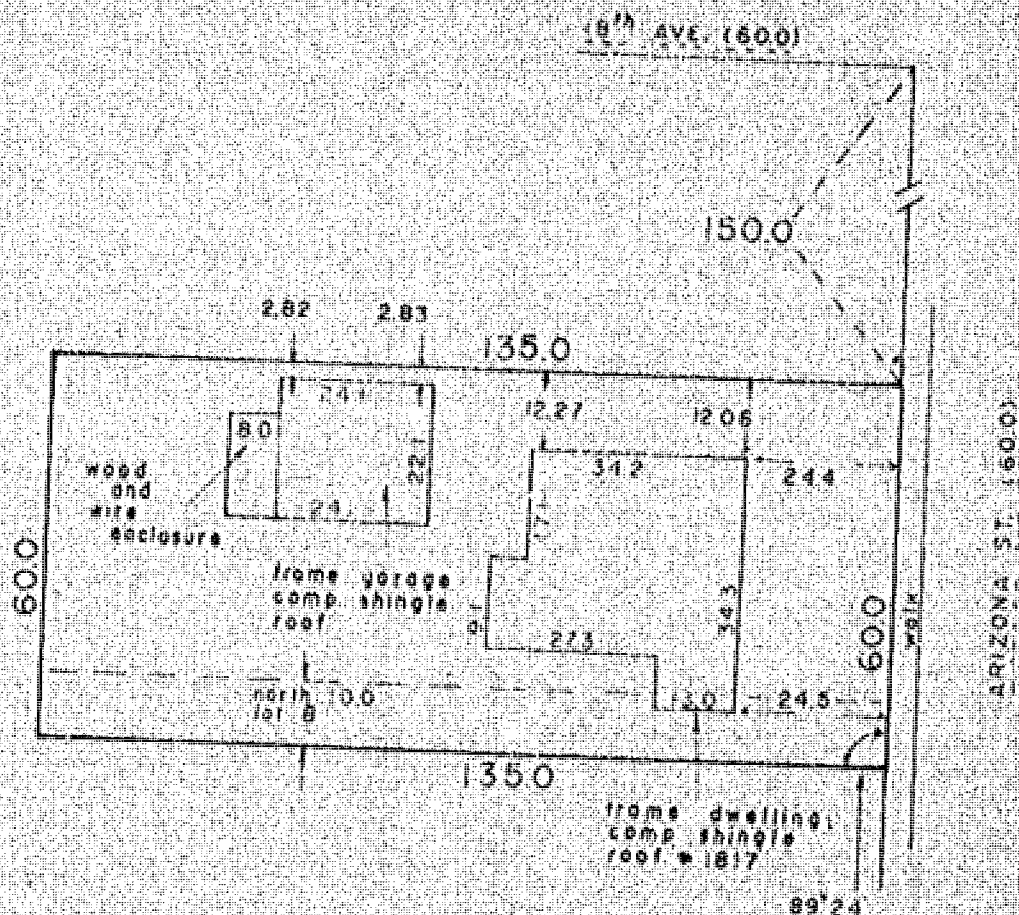

I Certify that I have surveyed the above described property (Property), and the above map is a true representation thereof and shows the size and location of the Property, its exterior boundaries, the location and dimensions of all visible structures thereon, boundary, fences, apparent easements and roadways and visible encroachments, if any. This survey is made for the exclusive use of the present owners of the Property, and also those who purchase, mortgage, or guarantee the title thereto, within one (1) year from date hereof.



National Survey & Engineering

417 NORTH SAWYER STREET, P.O. BOX 2983
OSHKOSH, WISCONSIN 54901
(414) 328-2800



PLAT OF SURVEY

OCTOBER 18, 1983


SURVEY FOR OSHKOSH SAVINGS

SURVEY NO. 1334-H

APPLICANT: PAULICK

MONUMENT: VALVER ON FILE

WASHINGTON AVENUE

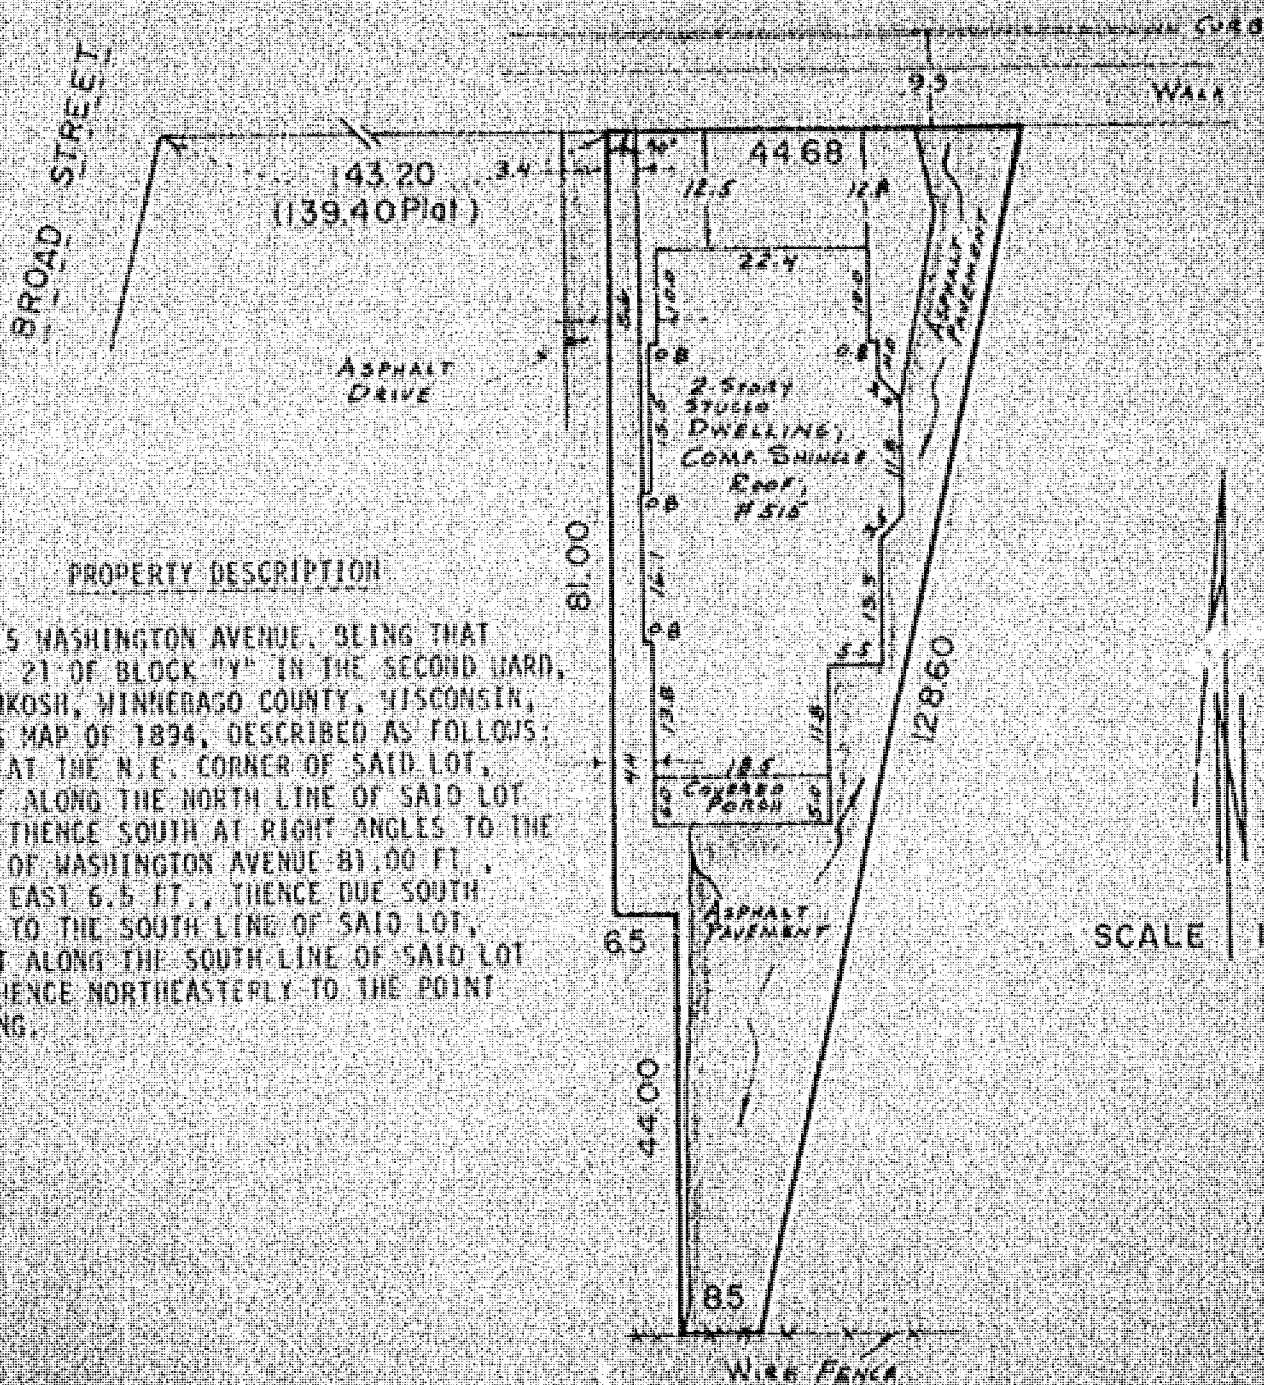

PROPERTY DESCRIPTION

KNOWN AS 515 WASHINGTON AVENUE, BEING THAT PART OF LOT 21 OF BLOCK "Y" IN THE SECOND WARD, CITY OF OSHKOSH, WINNEBAGO COUNTY, WISCONSIN, PER LEACH'S MAP OF 1894, DESCRIBED AS FOLLOWS: COMMENCING AT THE N.E. CORNER OF SAID LOT, THENCE WEST ALONG THE NORTH LINE OF SAID LOT 44.68 FT., THENCE SOUTH AT RIGHT ANGLES TO THE SOUTH LINE OF WASHINGTON AVENUE 81.00 FT., THENCE DUE EAST 6.5 FT., THENCE DUE SOUTH 49.00 FT., TO THE SOUTH LINE OF SAID LOT, THENCE EAST ALONG THE SOUTH LINE OF SAID LOT 8.5 FT., THENCE NORTHEASTERLY TO THE POINT OF BEGINNING.


SCALE 1"=20'

I Certify that I have surveyed the above described property (Property), and the above map is a true representation thereof and shows the size and location of the Property, its exterior boundaries, the location and dimensions of all visible structures thereon, boundary, fences, apparent easements and roadways and visible encroachments. This survey is made for the exclusive use of the present owners of the Property, and also those who purchase, mortgage, or guarantee the title thereto, within one (1) year from date hereof.



National Survey & Engineering

411 NORTH SAWYER STREET / P.O. BOX 2963
OSHKOSH, WISCONSIN 54903
608/220-2800

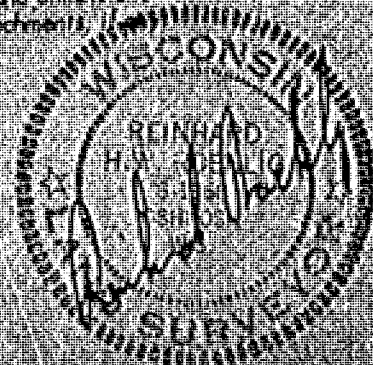


PLAT OF SURVEY

KNOWN AS 1007 BAY SHORE DRIVE, THAT PART OF LOT 6 IN CITY REPLAT NO. 3, 8th WARD, CITY OF OSHKOSH, WINNEBAGO COUNTY, WISCONSIN WHICH IS DESCRIBED AS: BEGINNING AT THE N.E. CORNER OF LOT 6, THENCE SOUTH $30^{\circ}33'42''$ WEST ALONG THE EAST LINE OF LOT 6 AFORESAID 120.00 FT. TO A POINT, THENCE NORTH $43^{\circ}01'00''$ WEST 75.00 FT. TO A POINT, THENCE NORTH $51^{\circ}45'46''$ EAST 119.12 FT. TO A POINT ON THE SOUTH LINE OF BAY SHORE DRIVE, THENCE SOUTH $43^{\circ}01'00''$ EAST ALONG THE SOUTH LINE OF BAY SHORE DRIVE 47.50 FT. TO THE POINT OF BEGINNING. SAID PARCEL CONTAINS 0.167 ACRES.

APRIL 29, 1981

(SURVEY FOR FIRST SAVINGS)
(WAIVER ON FILE)

SURVEY NO. 23-M

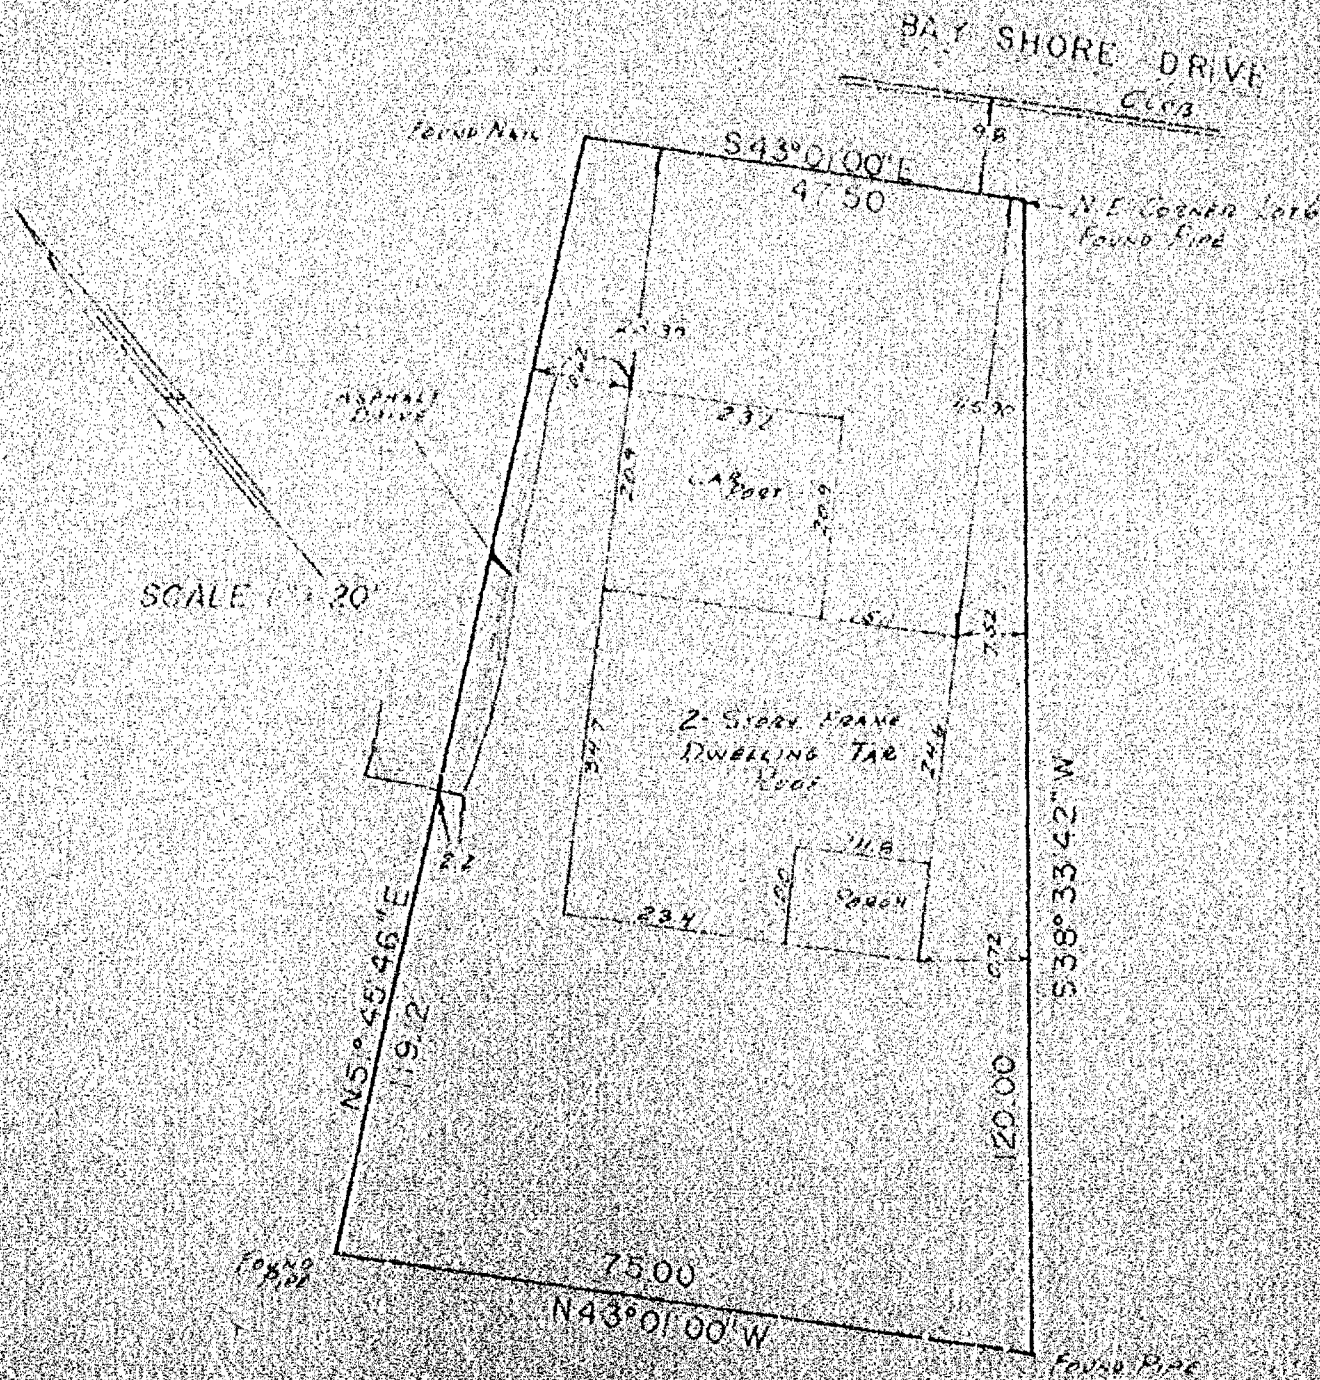

I Certify that I have surveyed the above described property (Property), and the above map is a true representation thereof and shows the size and location of the Property, its exterior boundaries, the location and dimensions of all visible structures thereon, boundary, fences, apparent easements and roadways and visible encroachments, if any. This survey is made for the exclusive use of the present owners of the Property, and also those who purchase, mortgage, or guarantee the title thereto, within one (1) year from date hereof.



national survey & engineering

812 NORTH SAWYER STREET, P.O. BOX 1863
OSHKOSH, WISCONSIN 54901
(608) 426-2800

Reinhard H.W. Roehlig




120.00' RECORDED
120.28' PROPORTIONED

0.25'

JEFFERSON STREET (49.5')

DESCRIPTION: LOT 6, BLOCK "B", MERRITTS 2ND
ADDITION TO OSHKOSH, WINNEBAGO COUNTY,
WISCONSIN.

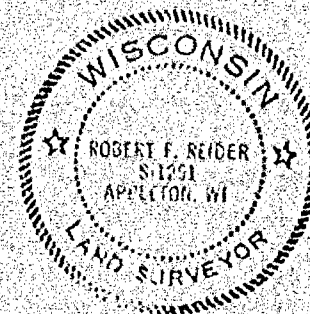

120.26' PROPORTIONED
120.00' RECORDED

○ = 1" ROUND IRON PIPE FOUND
● = 3/4 x 24" SOLID ROUND #6
IRON REBAR SET
X = CHISEL CROSS SET

I, ROBERT F. REIDER, CERTIFY THAT THIS PLAT OF
SURVEY IS A CORRECT REPRESENTATION OF THE ABOVE
DESCRIBED PROPERTY.

Robert F. Reider 1-20-81

REVISIONS	RUSS YOUNG 2308 JACKSON DR. OSHKOSH, WISCONSIN 54901		
	CAROW LAND SURVEYING CO., INC. 604 N. RICHMOND ST. APPLETON, WI 54911		
	DRAWN BY TF-KV	TFH	SCALE 1" = 50'
	APP'D LEO	DATE 1-20-81	DRAWING NO. A8862-81



City of Oshkosh

PLAT OF SURVEY

OSH


KNOWN AS 1800 HUBBARD STREET, BEING LOTS 23 AND 24, IN BLOCK 3 OF POPE'S AND SMITH'S ADDITION, IN THE 14th WARD (CITY OF OSHKOSH) WINNEBAGO COUNTY, WISCONSIN.

JUNE 29, 1981

SURVEY FOR DONALD MACDONALD

SURVEY NO. 180-3

WEST 8th AVENUE (60.0)

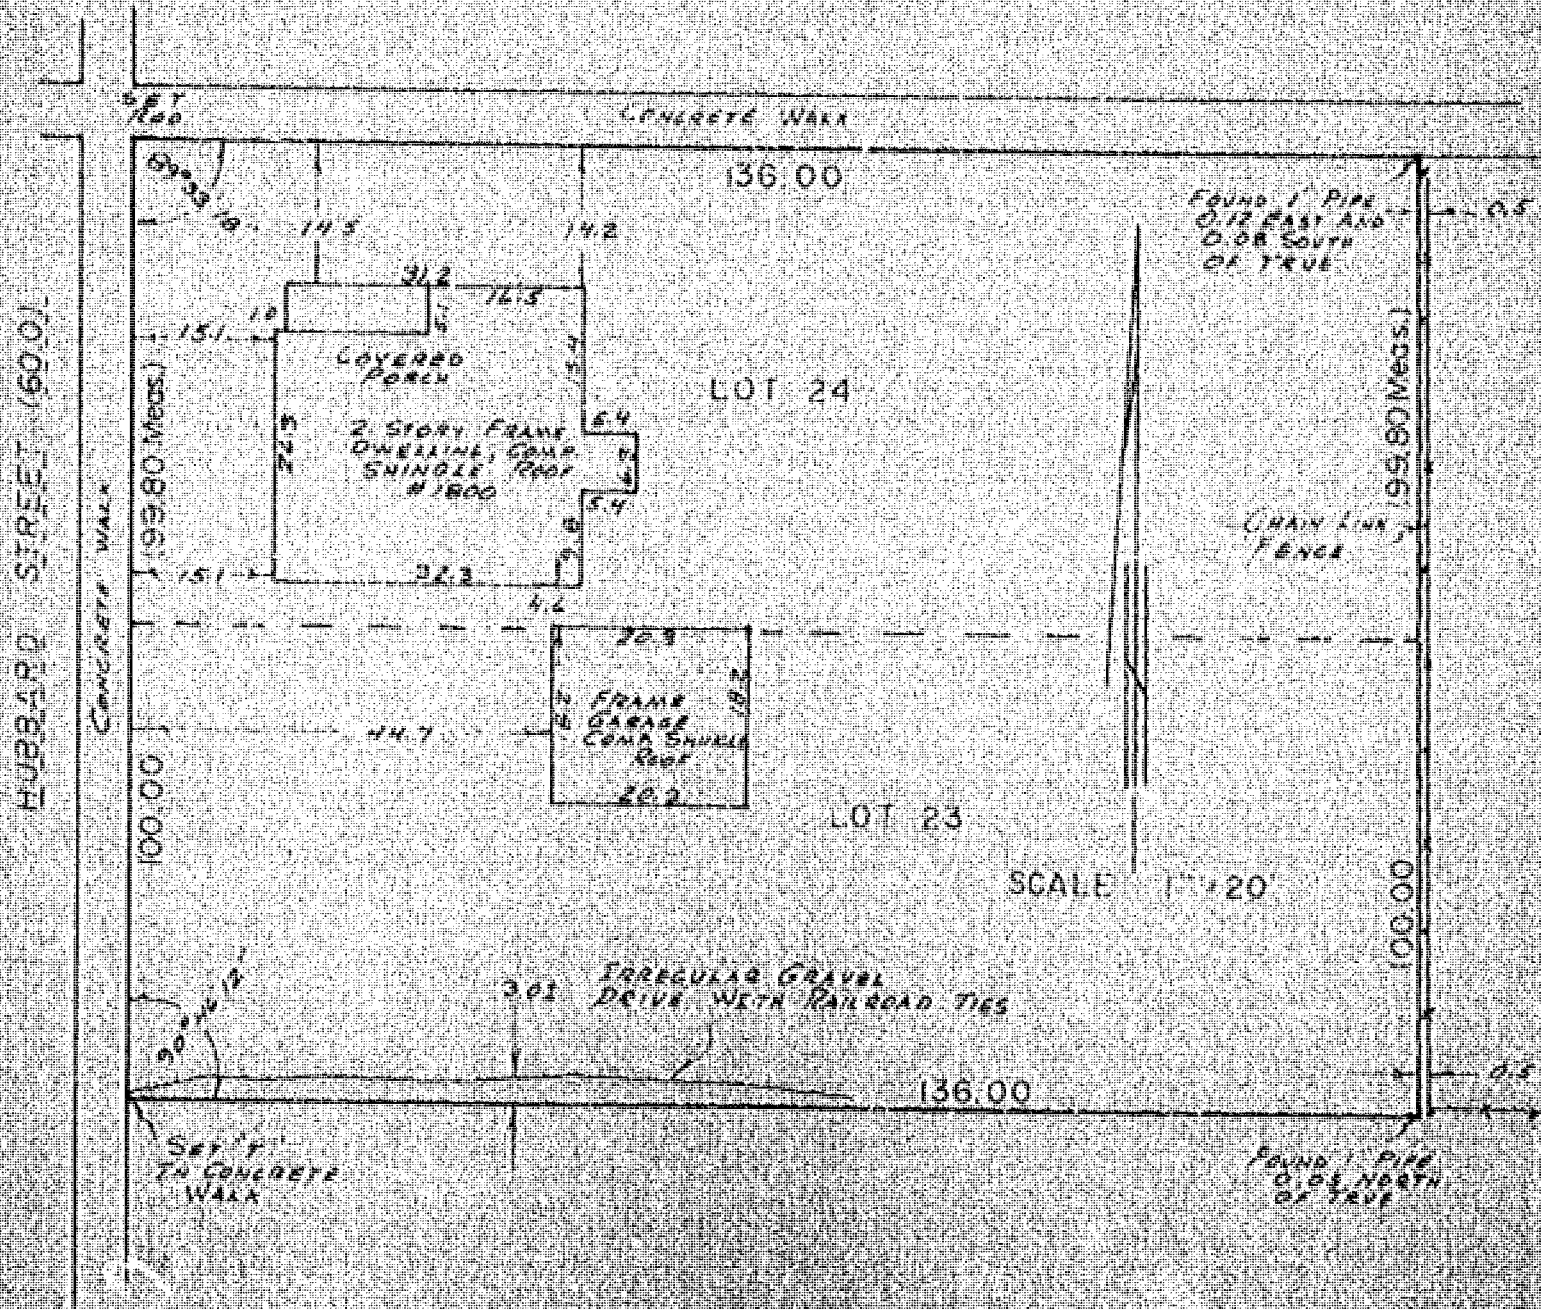

I Certify that I have surveyed the above described property (Property), and the above map is a true representation thereof and shows the size and location of the Property, its exterior boundaries, the location and dimensions of all visible structures thereon, boundary, fences, apparent easements and roadways and visible encroachments, if any. This survey is made for the exclusive use of the present owners of the Property, and also those who purchase, mortgage, or guarantee the title thereto, within one (1) year from date hereof.



National Survey & Engineering

517 NORTH VAN DYKE STREET, P.O. BOX 2983
OSHKOSH, WISCONSIN 54903
TEL: 428-2800


Richard Reichly



Winnabago Plat of Survey

Client: B. Slowik
926 No. Main St.
Oshkosh, Wisconsin 54901

Lot 12 and the North 1/4 feet of Lot 11, all in Block "D" in BALDWIN-KNAPP & FITZGERALD'S ADD'N., in the Tenth Ward, City of Oshkosh, per Leach's Map of 1894.

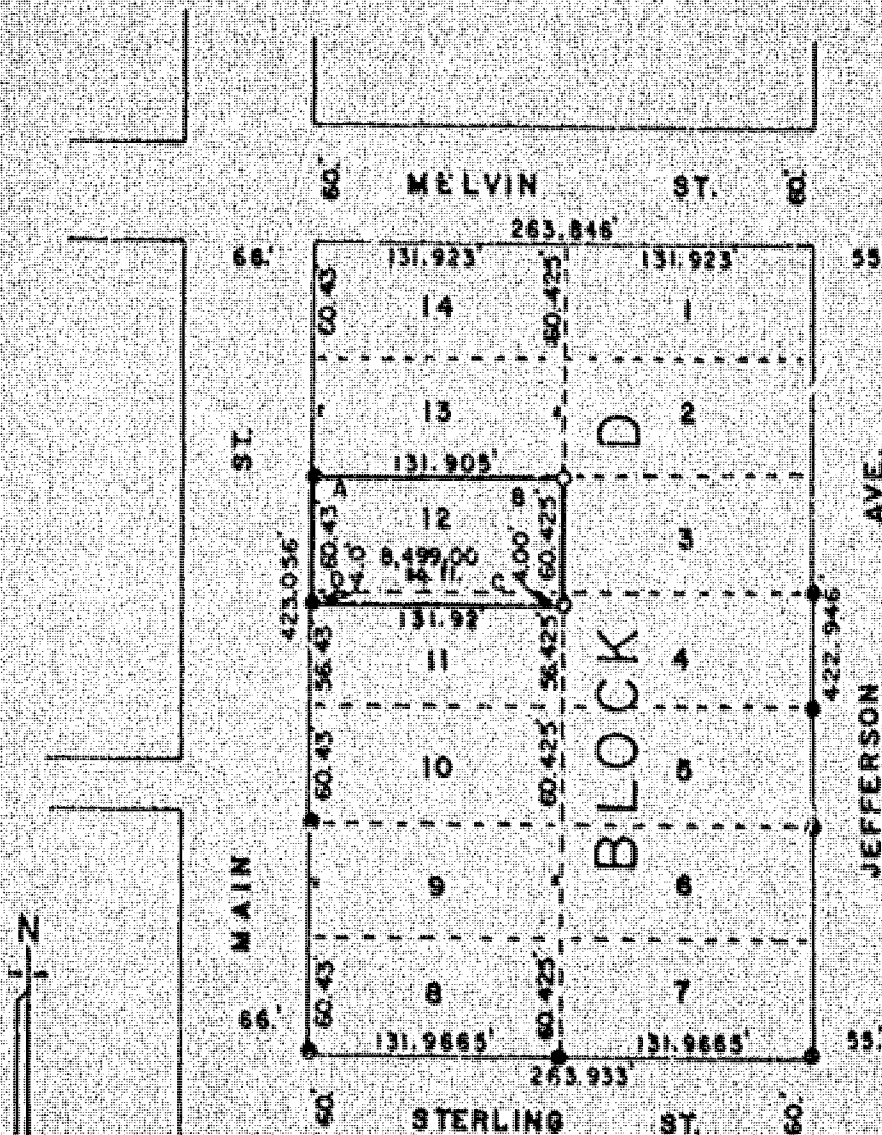

Interior angles:

- A. $89^{\circ}36'22''$
- B. $90^{\circ}23'59''$
- C. $89^{\circ}36'25''$
- D. $90^{\circ}23'14''$
- $360^{\circ}00'00''$



Lots prorated per pipes and dimensions of E.M. Wolverton survey of 1931.

LEGEND

- = Existing monuments
- = 2" x 30" iron pipe set
- = 1" x 30" iron pipe set
- = reference cops or R.R. spikes
- = Bernier or Harrison monuments
- X-X = fence
- () = recorded as
- = stone monument

SURVEYORS CERTIFICATE

I, hereby certify that I have surveyed the property as shown, according to official records and that the plat above drawn is an accurate and correct representation of said survey. SEPTEMBER 20 1979

Calvin W. Hawksworth, S-1290
Wisconsin Registered Land Surveyor

R. K. SAYLER, INC.
LAND SURVEYORS
WINNECONNE, WI 54986

SCALE 1 in. = 100 ft.


PROJECT NO. 9-001503

FIELD BOOK 20 PAGE 8

Cty of Oshkosh

IRON 0.15' WEST & 0.10' NORTH OF CORNER
EAST 107.33' P 107.36' R

IRON 0.15' EAST & 0.25' NORTH OF CORNER

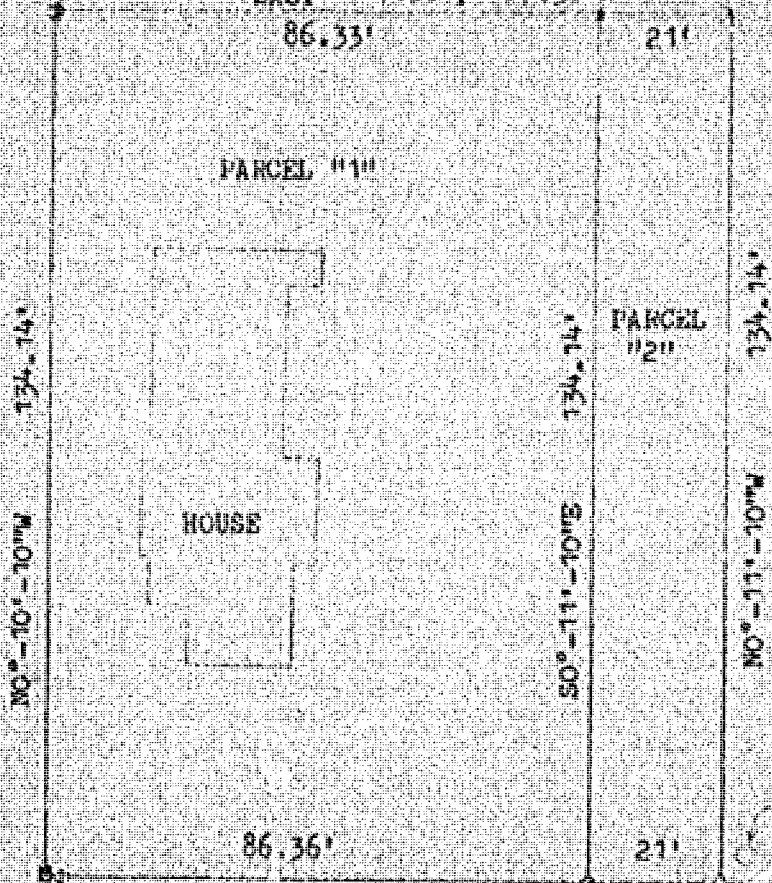

DESCRIPTION FOR PARCEL "1": LOTS 19 AND 20, VOSS SUBDIVISION, LESS THE EAST 21.00 FEET THEREOF, ELEVENTH WARD CITY OF OSHKOSH, WINNEBAGO COUNTY, WISCONSIN, MORE FULLY DESCRIBED AS FOLLOWS: COMMENCING AT THE SOUTHEAST CORNER OF VOSS SUBDIVISION; THENCE WEST 80.48 FEET PROPORTIONED, 80.50 FEET RECORDED, ALONG THE SOUTH LINE OF VOSS SUBDIVISION TO THE POINT OF BEGINNING; THENCE CONTINUING WEST ALONG SAID SOUTH LINE, 86.36 FEET PROPORTIONED 86.40 FEET RECORDED TO THE WEST LINE OF LOT 20; THENCE NO°-10'-10"W, 134.14 FEET ALONG SAID WEST LINE TO THE NORTH LINE OF LOT 20; THENCE EAST, 86.33 FEET PROPORTIONED, 86.36 FEET RECORDED, ALONG SAID NORTH LINE; THENCE SO°-11'-10"E, 134.14 FEET TO THE POINT OF BEGINNING. SUBJECT TO ALL EASEMENTS AND RESTRICTIONS OF RECORD. * AND THE NORTH LINE OF LOT 19;

DESCRIPTION FOR PARCEL "2": THE EAST 21.00 FEET OF LOT 19, VOSS SUBDIVISION, ELEVENTH WARD CITY OF OSHKOSH, WINNEBAGO COUNTY, WISCONSIN, MORE FULLY DESCRIBED AS FOLLOWS: COMMENCING AT THE SE CORNER OF VOSS SUBDIVISION; THENCE WEST ALONG THE SOUTH LINE OF VOSS SUBDIVISION 59.48 FEET PROPORTIONED, 59.50 FEET RECORDED TO THE SE CORNER OF LOT 19 AND THE POINT OF BEGINNING; THENCE CONTINUING WEST ALONG SAID SOUTH LINE 21.00 FEET; THENCE NO°-11'-10"W, 134.14 FEET TO THE NORTH LINE OF LOT 19; THENCE EAST ALONG SAID NORTH LINE 21.00 FEET TO THE EAST LINE OF LOT 19; THENCE SO°-11'-10"E, 134.14 FEET ALONG SAID EAST LINE TO THE POINT OF BEGINNING. SUBJECT TO ALL EASEMENTS AND RESTRICTIONS OF RECORD.

WEST 107.36' P
IRON 0.05' EAST OF 107.40' R
CORNER
MERRITT ST.
(49.5')

IRON 0.25' EAST & 0.35' NORTH OF CORNER

SOUTHEAST CORNER OF VOSS SUBDIVISION

LEGEND

- = 3/4x24" SOLID ROUND IRON ROD SET
- = 5" SPIKE SET
- C = 1 1/2" IRON PIPE FOUND
- D = 1" IRON PIPE FOUND
- S = 1" IRON BAR FOUND
- A = RAILROAD SPIKE FOUND
- X = PAINT CROSS SET
- R = RECORDED DISTANCE
- P = PROPORTIONED DISTANCE
- ✱ = CHISEL CROSS FOUND



I, ROBERT F. REIDER, CERTIFY THAT THIS PLAT OF SURVEY IS A CORRECT REPRESENTATION OF THE ABOVE DESCRIBED PROPERTIES.

PREPARERS		CAROL VERNER FREID-WERNER REALTORS	
		838 JACKSON DR., OSHKOSH, WISCONSIN	
		CAROL LAND SURVEYING CO., INC. P.O. BOX 1297	
		1837 W. WISCONSIN AVE., APPLETON, WI 54912	
DATE	BY	SCALE	DRAWING NO.
8/10/81	RFV KJV	1" = 30'	818.67
APPROVED	SEC		

PLAT OF SURVEY


BEING AS 870 GRAND STREET, BEING LOT 28 OF TOWN AND SECTION'S PLAT, IN THE 10TH WARD, (CITY OF DEPT. 2744) WINNEBAGO COUNTY, WISCONSIN;

OCTOBER 2, 1981

SURVEY FOR DONALD HOGAN

GARVEY NO. 192-5

STERLING AVE (60.0)

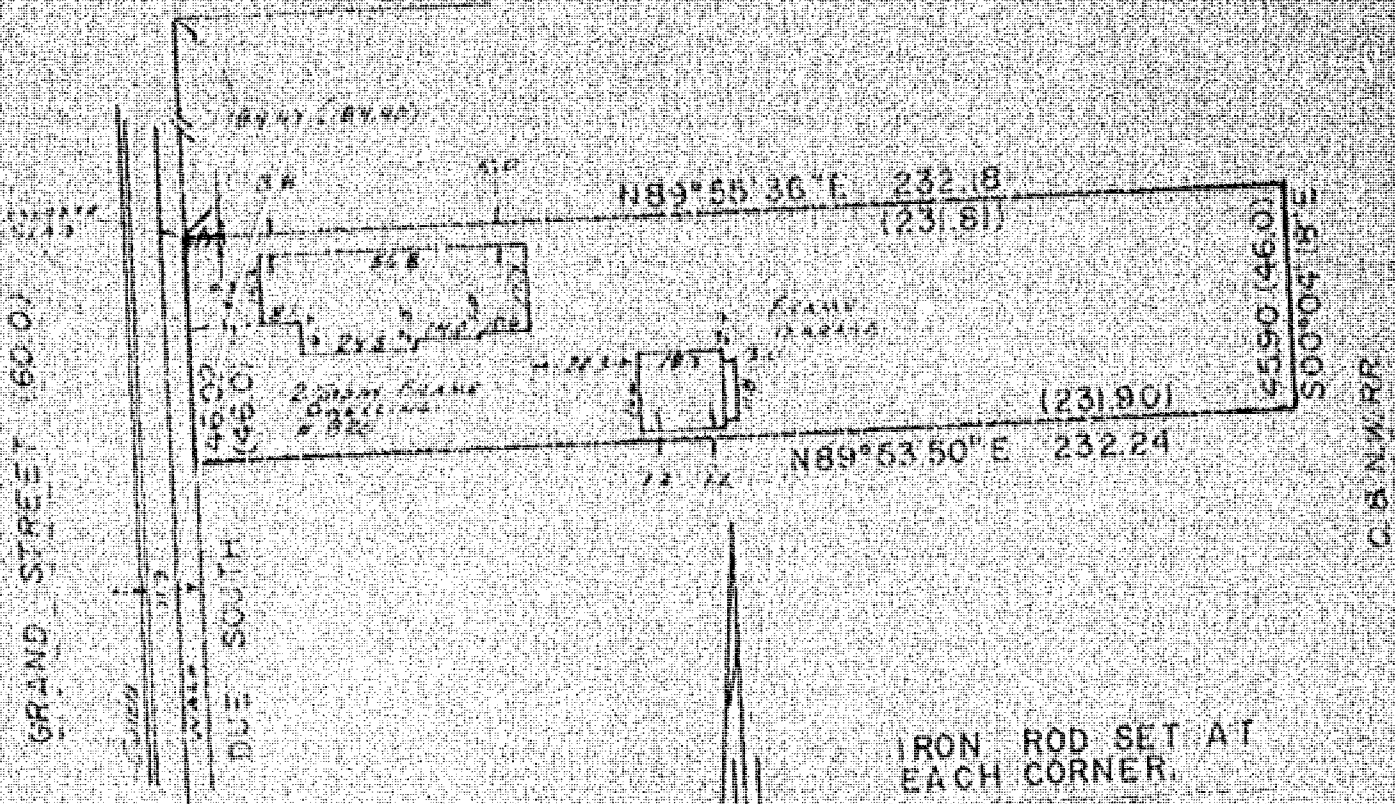

IRON ROD SET AT EACH CORNER.

Scale 1" = 40'

() = Plotted Distances

I Certify, that I have surveyed the above described property (Property), and the above map is a true and correct representation thereof and shows the site and location of the Property, its exterior boundaries, the location and dimensions of all visible structures thereon, boundary, fences, apparent easements and roadways and visible encroachments, if any. This survey is made for the exclusive use of the present owners of the Property, and also those who purchase, mortgage, or otherwise the title thereof, with effect from date hereof.



National Survey & Engineering

10 NORTH JAMES STREET, 2ND FLOOR
OSHKOSH, WISCONSIN 54901
TELE 424-1800

Richard Roehlig



PLAT OF SURVEY

KNOWN AS 530 MAIN STREET, LOTS 4, 5, 12, 13, 14, 17, 18, AND THE SOUTH 20.0 FT. OF LOT 6, ALL IN BLOCK 1 IN MERRITT'S ADDITION, IN THE FOURTH WARD, (CITY OF OSHKOSH), WINNEBAGO COUNTY, WISCONSIN, PER LEACH'S MAP OF 1894, EXCEPTING THEREFROM THE SOUTH 20.0 FT. OF SAID LOT 14.

THAT PART OF LOT 3 IN BLOCK 1 IN MERRITT'S ADDITION, IN THE FOURTH WARD, CITY OF OSHKOSH, WINNEBAGO COUNTY, WISCONSIN, PER LEACH'S MAP OF 1894 DESCRIBED AS FOLLOWS, VIZ:-


COMMENCING AT THE N.W. CORNER OF SAID LOT, THENCE SOUTH, ALONG THE WEST LINE OF SAID LOT 39.69 FEET, THENCE EASTERLY, TO A POINT ON THE EAST LINE OF SAID LOT 3 THAT IS 39.16 FEET SOUTH OF THE NORTH EAST CORNER OF SAID LOT, THENCE NORTH, ALONG THE EAST LINE OF SAID LOT 39.16 FEET TO THE N.E. CORNER OF SAID LOT, THENCE WEST ALONG THE NORTH LINE OF SAID LOT TO THE PLACE OF BEGINNING.


THE SOUTH 2.0 FEET OF LOT 11 IN BLOCK 1 IN MERRITT'S ADDITION, IN THE FOURTH WARD, CITY OF OSHKOSH, WINNEBAGO COUNTY, WISCONSIN, PER LEACH'S MAP OF 1894.

OCTOBER 27, 1931

(SURVEY FOR MAJOR CONSTRUCTION)

SURVEY NO. 85-S-Reg.

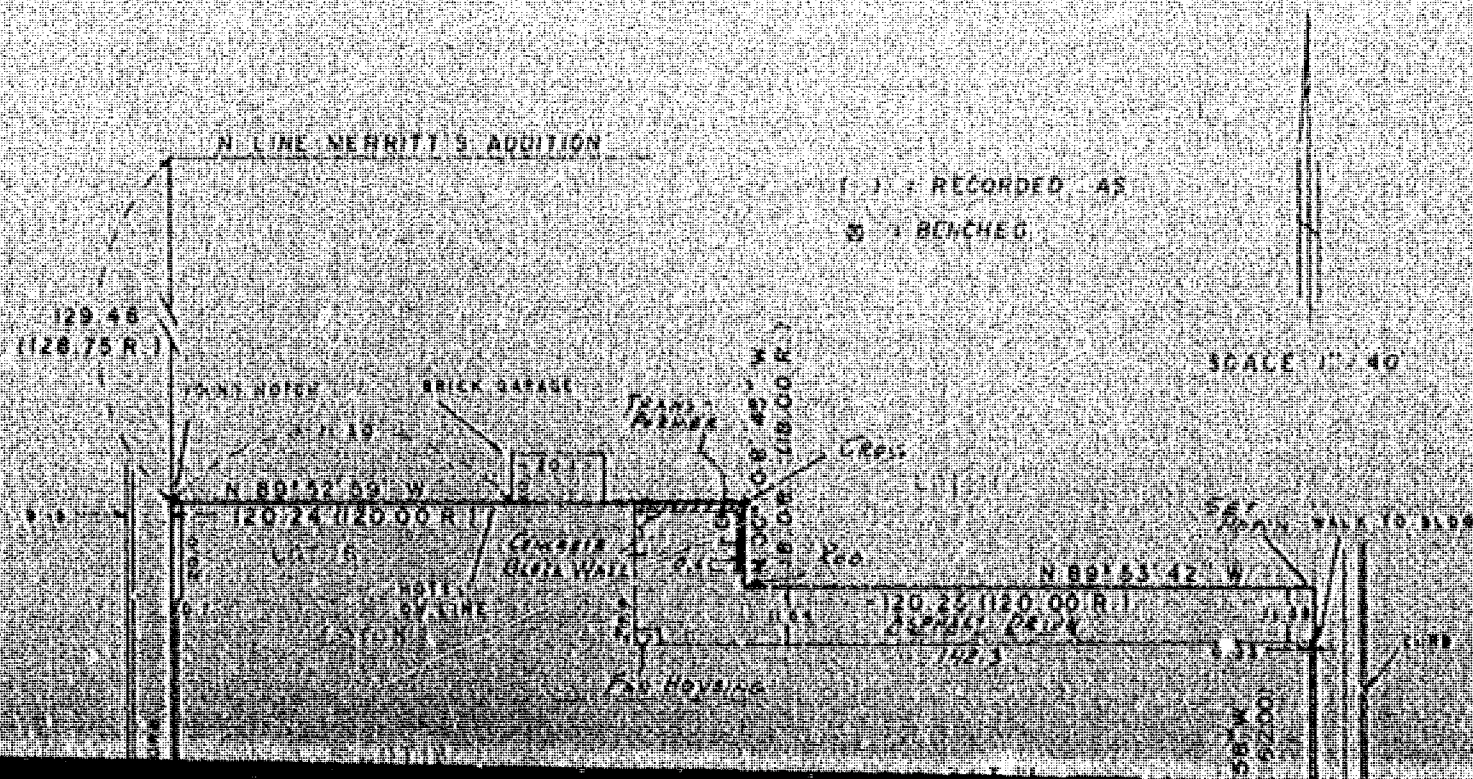

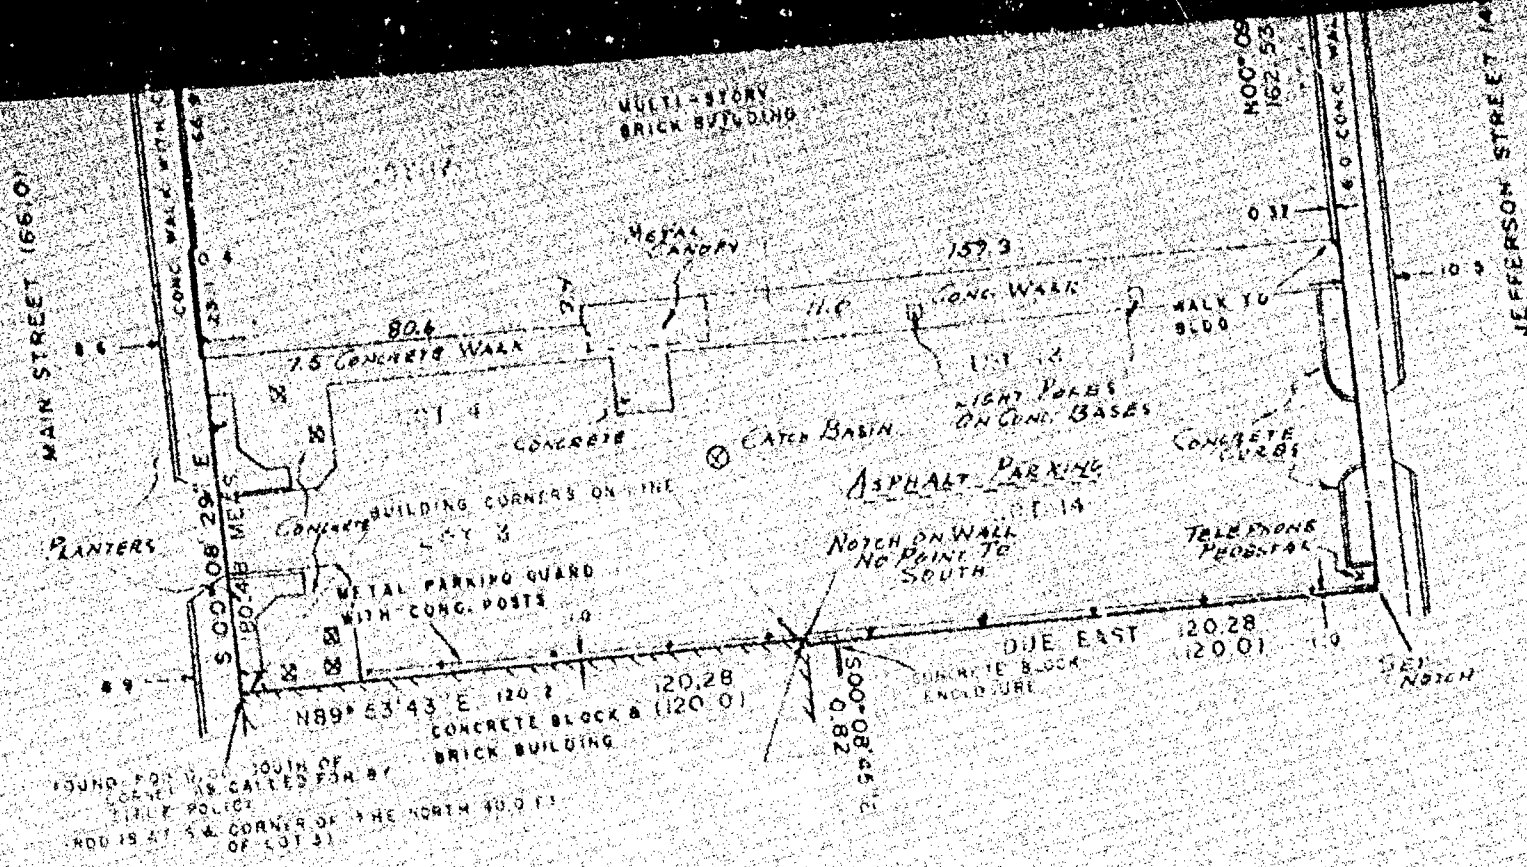


I Certify that I have surveyed the above described property (Property), and the above map is a true representation thereof and shows the size and location of the Property, its exterior boundaries, the location and dimensions of all visible structures thereon, boundary, fences, apparent easements and roadways and visible encroachments, if any. This survey is made for the exclusive use of the present owners of the Property, and also those who purchase, mortgage, or guarantee the title thereto, within one (1) year from date hereof.



national survey & engineering


412 W. 1st St. - SAWYER STREET - P.O. BOX 2983
 OSHKOSH, WISCONSIN 54903
 (414) 426-2800

Reinhard Roehlig

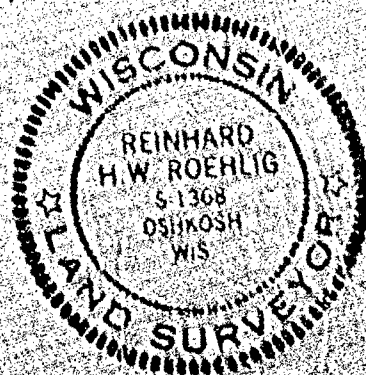


10/30/80

WINNEBAGO COUNTY CERTIFIED SURVEY MAP NO. _____
 Part of Lot 1 of Block 1 in ANNA M. LULL'S FIRST ADD'N. in the
 City of Oshkosh

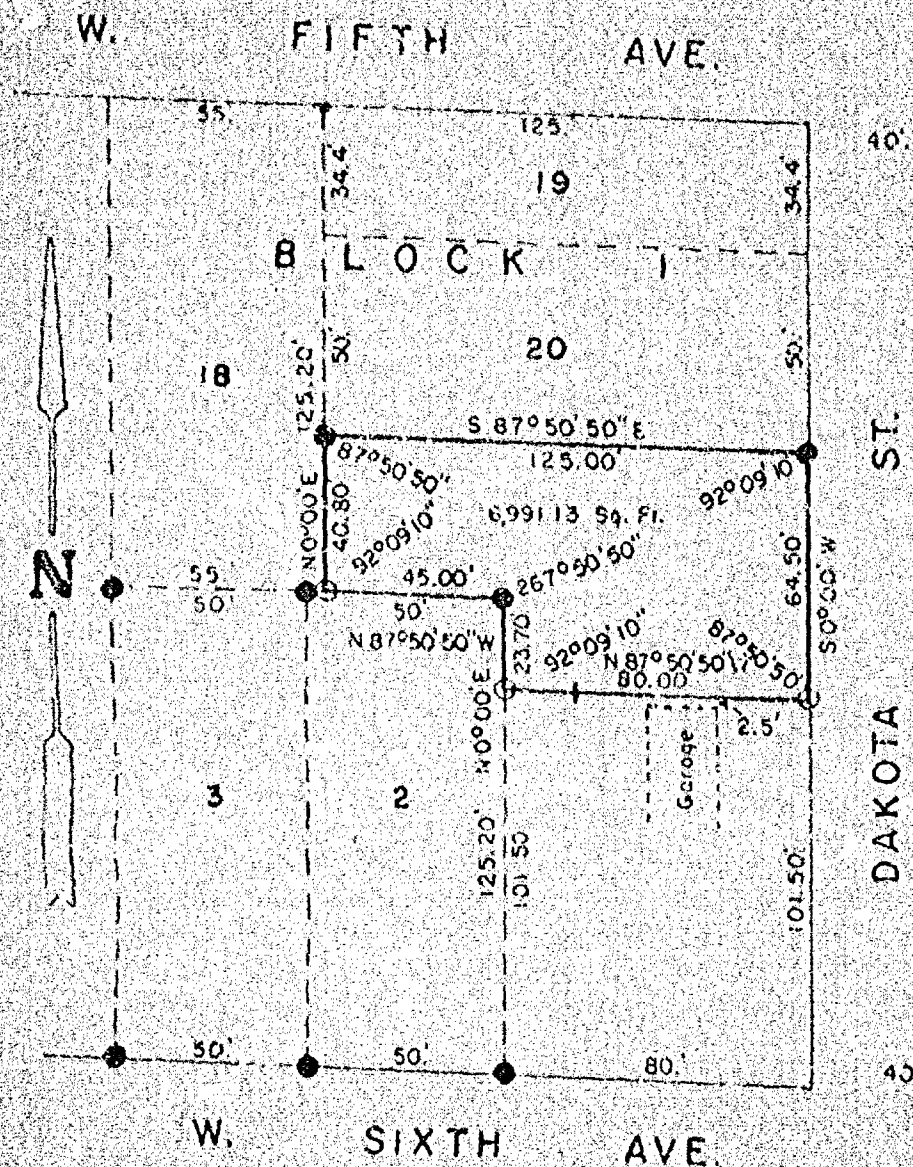

- Existing iron pipe
- 1" x 30" iron pipe weighing 1.13 lbs. per lineal ft.

Bearings are referenced to the West line of Dakota St., assumed bearing, N0°00'.

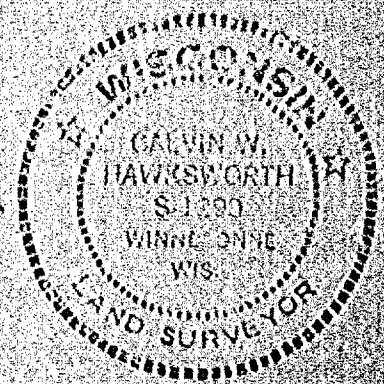

I, Calvin W. Hawksworth, registered land surveyor, hereby certify that I have surveyed and mapped part of Lot 1 of Block 1 in Anna M. Lull's First Add'n. in the City of Oshkosh, Winnebago County, Wisconsin, more specifically described as follows: Beginning at an iron pipe that is 101.50 ft., N0°00'E of the S.E. corner of said Lot 1, Block 1. From that point running N87°50'50"W, 80.00 ft., thence N0°00'E, 23.70 ft., thence N87°50'50"E, 45.00 ft., thence N0°00'E, 40.80 ft., thence S87°50'50"E, 125.00 ft., to the R.O.W. line of Dakota St., thence S0°00'W, along said R.O.W. line, 61.50 ft. to the said point of beginning. Being a parcel of land of 6,991.13 sq. ft. in area, more or less.

That said map is a true representation of the exterior boundaries of the land surveyed; that I have fully complied with the provisions of Sec. 236.34 of the Wisconsin Statutes in surveying and mapping the same.

(See reverse side)

Calvin W. Hawksworth
 Surveyor
 June 24, 1977

OWNER'S CERTIFICATE

As owner, I hereby certify that I caused the land described on this map to be surveyed and mapped as represented hereon.

Owner _____

Date: _____

CITY PLANNING COMMISSION CERTIFICATE:

This Certified Survey Map of part of Lot 1 of Block 1 in
ANNA M. LUELL'S FIRST ADDITION, City of Ooshkosh, _____,
owner, is hereby approved.

David Wendtland
Secretary of Planning Commission

Dated this _____ day of _____, 1977.

Calvin W. Hawksworth J.R.L.S. 6-1290

FOR Fox Valley Land Title Corp.
230 N. Morrison Street
Appleton, WI 54911

Jeffrey A. Lawson
2370 Kincaid Avenue
Oshkosh, WI



PROPERTY DESCRIPTION:

PROPERTY DESCRIPTION: Lot Thirty-four (34), FIRST ADDITION TO WESTWAY PLAT, Sixth Ward, City of Oshkosh, Winnebago County, Wisconsin.



0 = 3/4" x 24" Rebar Set

2 = 3/4" Rebar Recovered

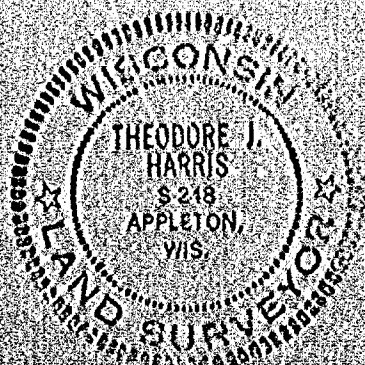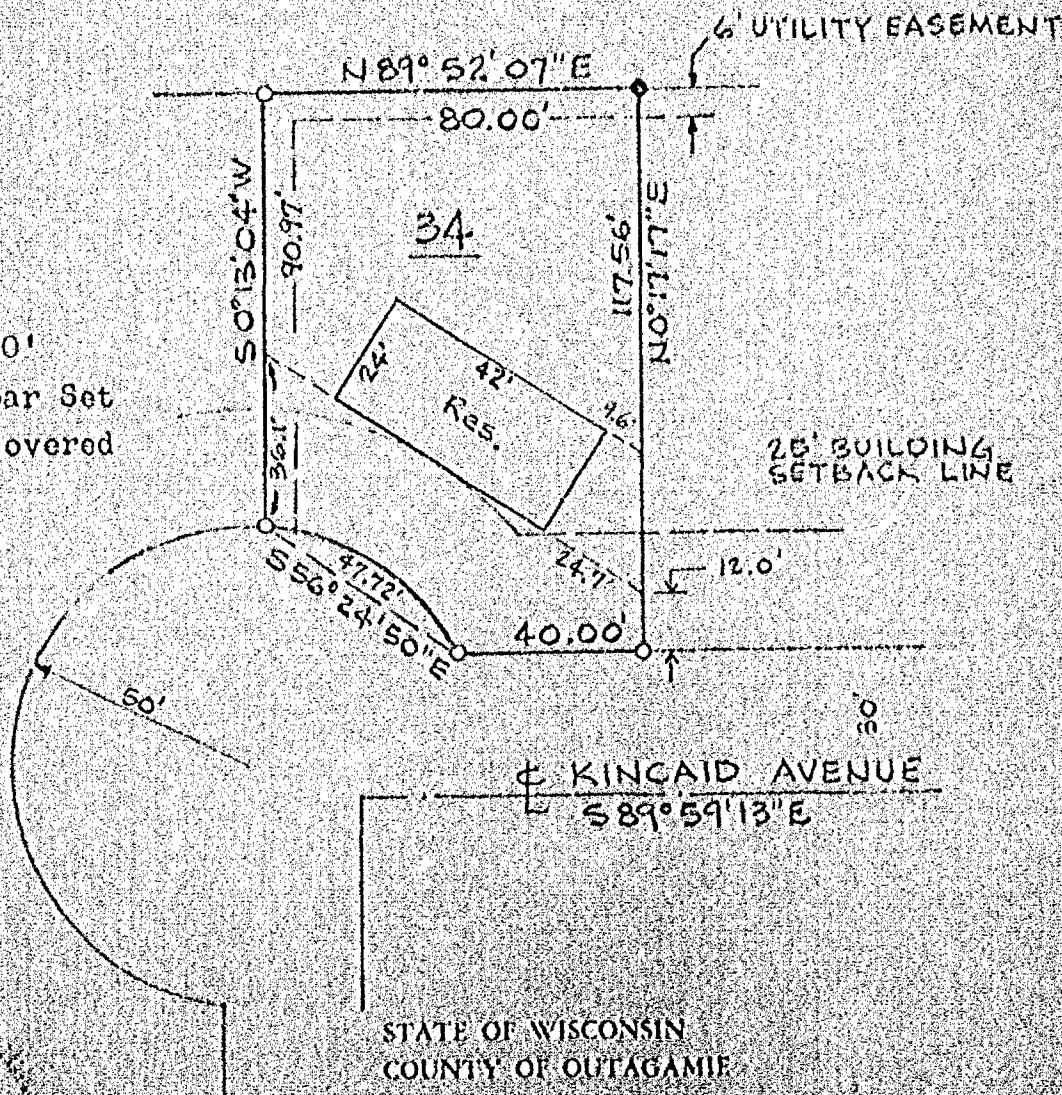

STATE OF WISCONSIN
COUNTY OF OUTAGAMIE

I do hereby certify that I have surveyed the property described above according to official records, and that the plat above drawn is a correct representation of said survey.

Appleton, WI November 20, 1981

Heidi Hanes
REGISTERED LAND SURVEYOR


HARRIS AND ASSOCIATES, INC.

APPLETON, WISCONSIN

DWG. AS. 4071

[illegible][illegible]

DATED THIS 10th DAY OF December 1939
 STRAY V. CHANDLER
 DISCUSSION REGISTERED (450) 5-1111
 BICYCLE CARPENTERS

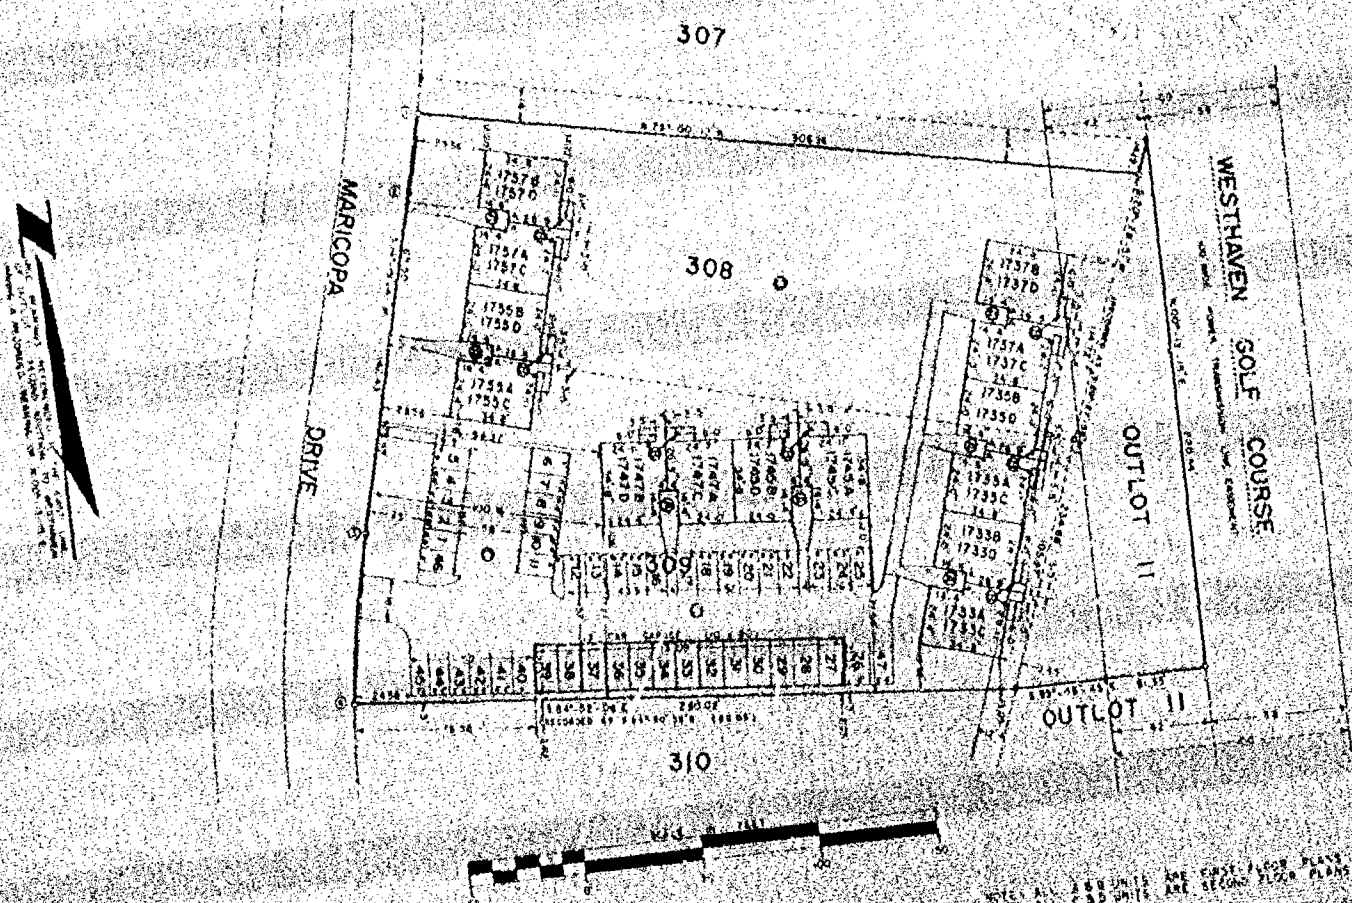

NOTE: ALL ADD UNITS ARE FIRST FLOOR PLANS
AND UNITS ARE SECOND FLOOR PLANS

12-10-60
FROM: PIRI, PIRI
TO: PIRI, PIRI
SUBJECT: PIRI, PIRI
PIRI, PIRI, PIRI

ALL DISTANCES ARE MEASURED TO
THE NEAREST HUNDREDTH OF A FOOT

CURVE NO.		RADIUS INCHES	CURVE LENGTH FEET	CHORD LENGTH FEET	AREA SQUARE FEET	PERCENT AREA OF CHORD	PERCENT AREA OF CHORD
1	2	14.61	14.61	14.61	14.61	100.00	100.00
3	4	14.61	14.61	14.61	14.61	100.00	100.00

UNITED STATES OF AMERICA
COMMON ELEMENTS: (1), (2), (3)
COMMON ELEMENT: (4)

NOTE: USDA: UNIT NUMBER
 (1) ENTRANCE TO UNIT
 (2) UNIT PATIO
 (3) ALL DRIVEWAYS & PARKING AREAS ENCLOSED AND OPEN
 (4) ALL LAND EXCLUSIVE OF UNIT, ENTRANCE TO UNIT,
 UNIT PATIOS, DRIVEWAYS & PARKING, ENCLOSED AND OPEN

THE ABOVE DESCRIBED FACILITY IS SUBJECT TO ALL EASEMENTS IN RECORD AND EASEMENTS UNDERWRITTEN BY THE ESTATEMENTS, SUCH AS SANITARY SEWER EASEMENTS, WATER EASEMENTS, TELEPHONE EASEMENTS.

THIS INSTRUMENT DRAFTED BY STATE'S COUNSEL

AERO-METRIC ENGINEERING, INC.
5 PRITCHARD DRIVE, WILMINGTON
MASS. 01890
OLIVERO, WILCOX

DATE - NOV 14 1964
 AREA - 100
 DRAWN BY -
 CHECKED BY -
 DES - 100
 100


PLAT OF GREEN TEE SOUTH CONDOMINIUM
BEING 25 LOT 308 & OUT

ALL OF LOT 309 & A PART OF LOT 308 & OUTLOT 11
OF THE SECOND ADDITION TO WESTHAVEN, 13TH WARD,
CITY OF DSHKOSH, WINNEBAGO COUNTY, WISCONSIN

SURVEY
FOR
DANNY R. HARRINGTON & KAREN M. HARRINGTON
OF

The North 67.8 feet of the South 117 feet of Lots 25 and 26; Block "D" in the Second Addition to Oshkosh in the 8th Ward, City of Oshkosh, Winnebago County, Wisconsin.

The West 20 feet of the North 67.80 feet of the South 117 feet of Lot 24, Block "D" in the Second Addition to Oshkosh, in the 8th Ward, City of Oshkosh, Winnebago County, Wisconsin.

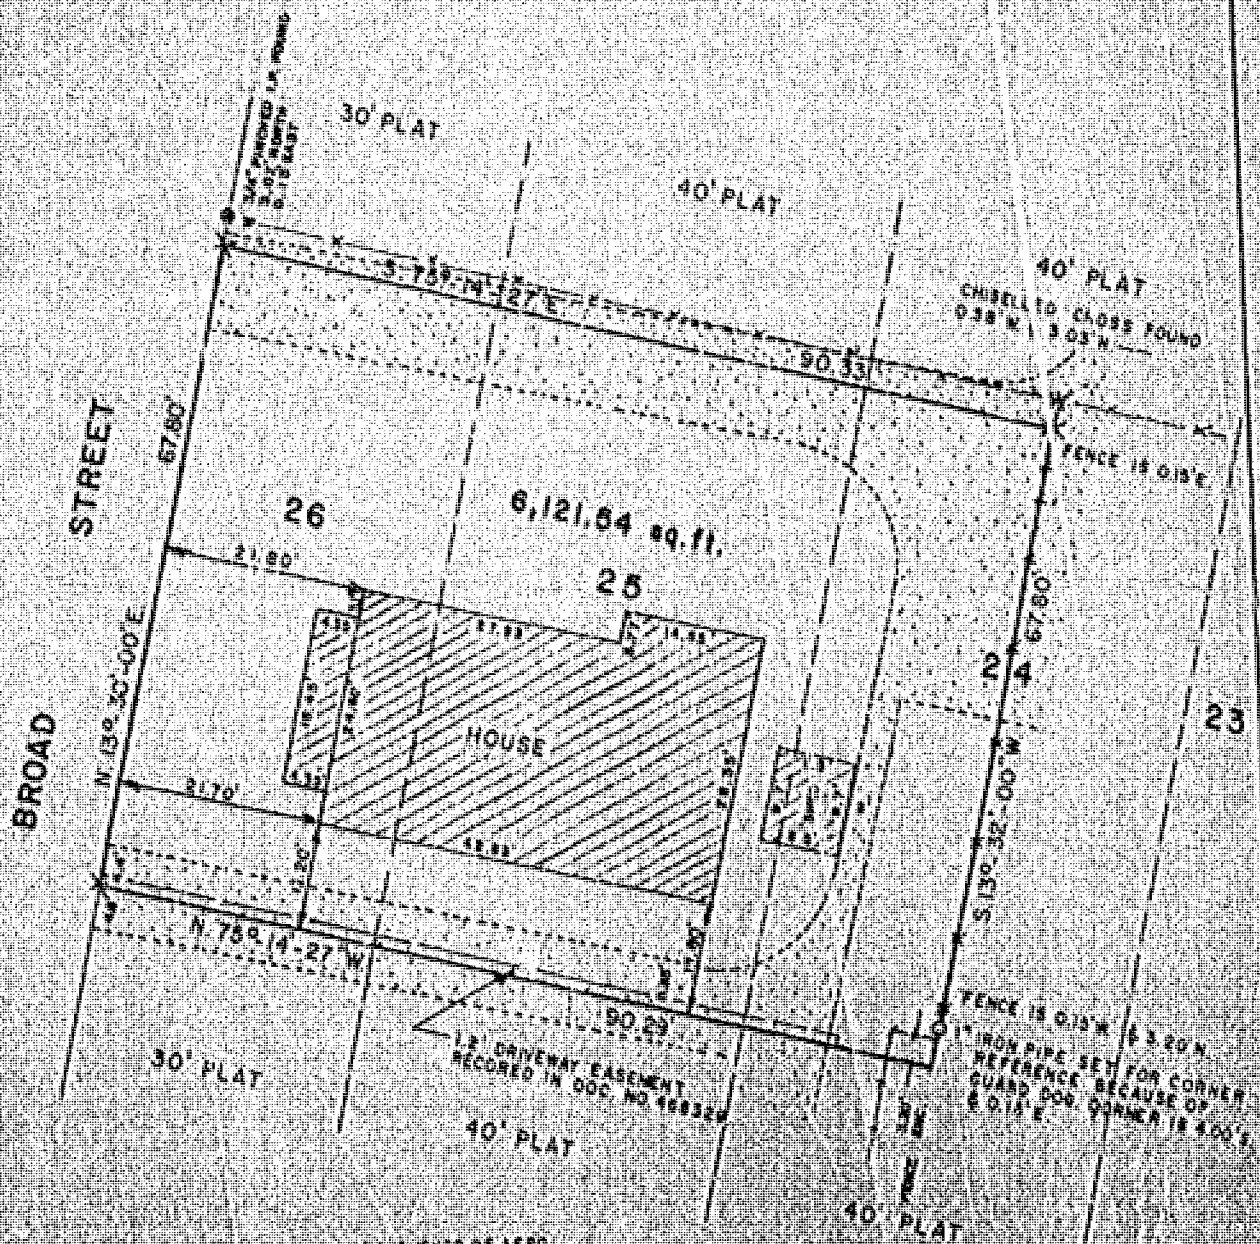


I, STEVEN T. CHRONIS, WISCONSIN REGISTERED LAND SURVEYOR OF AERO METRIC ENGINEERING, INC., HAVE SURVEYED THE ABOVE DESCRIBED PROPERTY AND THE ABOVE MAP IS A TRUE REPRESENTATION THEREOF AND SHOWS THE SIZE AND LOCATION OF THE PROPERTY, ITS EXTERIOR BOUNDARIES, THE LOCATION AND DIMENSIONS OF ALL STRUCTURES THEREON, FENCES, APPARENT EASEMENTS AND ROADWAYS AND VISIBLE ENCROACHMENTS IF ANY.


THIS SURVEY IS MADE FOR THE EXCLUSIVE USE OF THE PRESENT OWNERS OF THE PROPERTY AND ALSO THOSE WHO PURCHASE MORTGAGE OR GUARANTEE THE TITLE THEREIN WITHIN ONE (1) YEAR FROM DATE HEREOF, AND AS TO THEM, I HEREBY CERTIFY THAT SAID SURVEY AND THE ABOVE MAP WERE MADE IN ACCORDANCE WITH ACCEPTABLE PROFESSIONAL STANDARDS AND THAT THE INFORMATION CONTAINED THEREIN IS TO THE BEST OF MY KNOWLEDGE, INFORMATION AND BELIEF, A TRUE AND ACCURATE REPRESENTATION THEREOF.

Steven T. Chronis
STEVEN T. CHRONIS
WISCONSIN REGISTERED LAND SURVEYOR S-913


DATED THIS 18th DAY OF May, 1981

AERO-METRIC ENGINEERING, INC.
PHOTOGRAMMETRIC ENGINEERS
LAND SURVEYORS
OSHKOSH, WISCONSIN

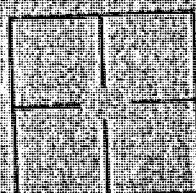

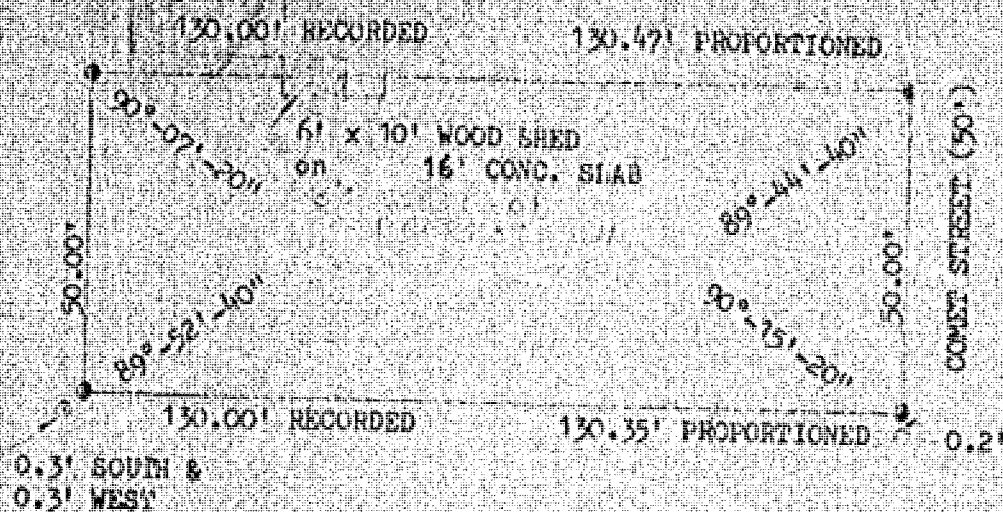

DESCRIPTION: LOT 19, BLOCK 16, INTERURBAN LAND CO'S, THIRD ADDITION, CITY OF OSHKOSH, WINNEBAGO COUNTY, WISCONSIN.

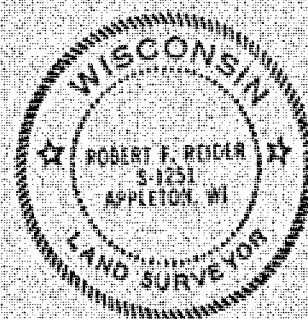

- = 1" ROUND IRON PIPE FOUND
- = 2" ROUND IRON PIPE FOUND
- = 3/4 x 24" SOLID ROUND #6 IRON REBAR SET

I, ROBERT F. REIDER, CERTIFY THAT THIS PLAT OF SURVEY IS A CORRECT REPRESENTATION OF THE ABOVE DESCRIBED PROPERTY.

Robert F. Reider 3-25-81


PLANNING OFFICE
RECEIVED
APR 06 1981
RECEIVED

REVISIONS	RUSS YOUNG 2305 JACKSON ST., OSHKOSH, WISCONSIN 54901		
	GAROW LAND SURVEYING CO., INC. P.O. BOX 1287 1837 W. WISCONSIN AVE., APPLETON, WI 54912		
DATE BY	DATE	SCALE	GRAPHIC
11-11-80	11-11-80	1"=30'	(813) 180
FILED	11-11-80	DATE	3-25-81


NO.	SURVEYED FOR	SURVEYOR	DATE	PLAT NO.	CERTIFIED MAP NO.	SURVEYS		SURVEY LOCATION
						VOL.	PAGE	
	N. Guerrero	Roehling	10-30-80					Merritts Add
	R. Young	Reider	3-24-81					Plat 9 Interurban Land
	R. Young	Reider	3-25-81					" 8 " " "
	D. Harrington	Chonco	5-18-81					2nd Add to 8th Ward
	James A. Brown	Chonco	12-10-81					2nd Add Westmore
	V.J. Larson	Harris	11-20-81					1st add Westway
	D. Wendtland	Haukew.	6-24-77					Imma Falls 1st Add
	D. Hegare	Roehling	10-2-81					Imma Falls 1st Add
	Hutted Condt	Roehling	10-30-80					Imma Falls 1st Add
	C. Werner	Reider	8-10-81					Imma Falls 1st Add
	D. Slowik	Haukew.	9-20-77					Imma Falls 1st Add
	D. Montgomery	Roehling	6-29-81					Imma Falls 1st Add
	R. Young	Reider	7-20-81					Imma Falls 1st Add
	First Savings	Roehling	4-29-81					Imma Falls 1st Add
	A. Krauel	Haukew.	10-26-80					Imma Falls 1st Add
	P. Koll	" "	5-7-77					Imma Falls 1st Add
	F. Schorman	" "	5-11-81					Imma Falls 1st Add
	G. Kemp	" "	4-8-80					Imma Falls 1st Add
	R. Cappe	" "	4-9-80					Imma Falls 1st Add
	R. Berndt	" "	6-5-80					Imma Falls 1st Add
	G. Manske	" "	5-11-77					Imma Falls 1st Add
	T. O'Brien	" "	6-20-80					Imma Falls 1st Add
	G. Salm	" "	5-20-80					Imma Falls 1st Add
	Schafel & Muga	" "	8-6-80					Imma Falls 1st Add


NO.	SURVEYED FOR	SURVEYOR	DATE	PLAT NO.	CERTIFIED MAP NO.	SURVEYS		SURVEY	LOCATION
						VOL.	PAGE		
	L. Young	Reider	9-7-1979	Suttons Add.				lot 23	Block A
	N. Wells	Reider	8-31-1979	Sakenaw Pl.				lot 8-10	Block 2
	M. Rose	Riberson	6-19-1979	Replat #4				lot 10	Block 2
	L. Young	Reider	9-7-1979	Oshkosh Land Co.				lot 11	Blk 18
	L. Kuff	Rohlig	3-21-1980	Seaches Map				lot 10	Blk 107
	G. Diller	Rohlig	2-15-1980	Pleasant Home				lot 14	Blk 28
	E. Steele	Rohlig	2-4-1980	Sakenaw Park				lot 4, 7	
	Tru Valley Lillo	Harris	7-24-1980	Westway Plat				lot 44	
	J. Miller	Col	5-2-1980	Algonia Add.				lot 153	
	G. Mackie	Rohlig	7-10-1980	John Smiths Add 1		710		lot 19	
	Minnesota Group	Rohlig	9-22-1980	Wright's 3rd		1	816	lot 24, 5 Blk 18	
	R. Schulz	Miller	7-31-1978					24, 118N, R16E	NE 1/4
	G. Blumenthal	Chronis	8-9-1979	Seaches Map				lot 62	Block 30
	Wolfe Christianson	Chronis	8-7-1980	Clayton Add.				lots 109-111	
	Oshk. Housing Auth.	Col	4-3-1980	Westhoren 3rd Add.				lots 483-485	
	Universal Laundry	Chronis	9-24-1979	Western Add.				Block 2	
	Basler	Chronis	8-18-1978	Olsen Acres				Block 3	
	Oshk. YUCA	Rohlig	9-15-1980	Seaches Map				lot 3, 5, 6, 7, 8, 14	Blk 39
	Oshk. Ind. Dev.	Chronis	1-26-1980	15th Ward				1, 118N, R16E	NE 1/4
	1st Ass. of Soc.	Chronis	9-16-1980	Sawyer Sub.				lot 4	
	Leistikow	Rohlig	7-21-1980	Kelly Sub.				27, 178N, R16E	NE 1/4
	Urban Child	Rohlig	7-28-1980						
	H. Jones	Chronis	10-20-1980	2nd + 8th Ward				lot 109, Replat Blk. 29	
	T. Wex	Rohlig	8-27-81					Block 2 addn.	
	Tower Point	Chronis	9-18-81					Original Plat 3rd Ward	
	Disabld	Spate	8-14-81					First add Westhoren	
	C. Culbertson	Chronis	7-20-81					John Smiths 2nd Add	
	J. Dubruin	Kriecher	2-27-81					Plat 9 Orchards	
	J. Horvath	Derks	4-22-81					John Smiths 2nd	
	E. Skowd	Chronis	4-29-81					" " "	
	Village Square	Kriecher	4-17-81					Village Square Dev.	
	F. Flanagan	Chronis	11-25-80					Schintz Add	

LOTS 22 AND 24 LYING EASTERLY OF JACKSON STREET AND ALL OF LOT 20,
BLOCK 16, LEACH'S MAP; ALSO ALL OF LOTS 17 AND 25, BLOCK 16, N.W. WRIGHT'S
3 RD ADDITION, 1ST WARD, CITY OF OSHKOSH, WINNEBAGO COUNTY, WISCONSIN.

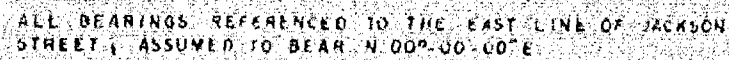


- = 1" IRON PIPE FOUND
- = P K NAIL SET
- ▲ = RAILROAD SPIKE SET

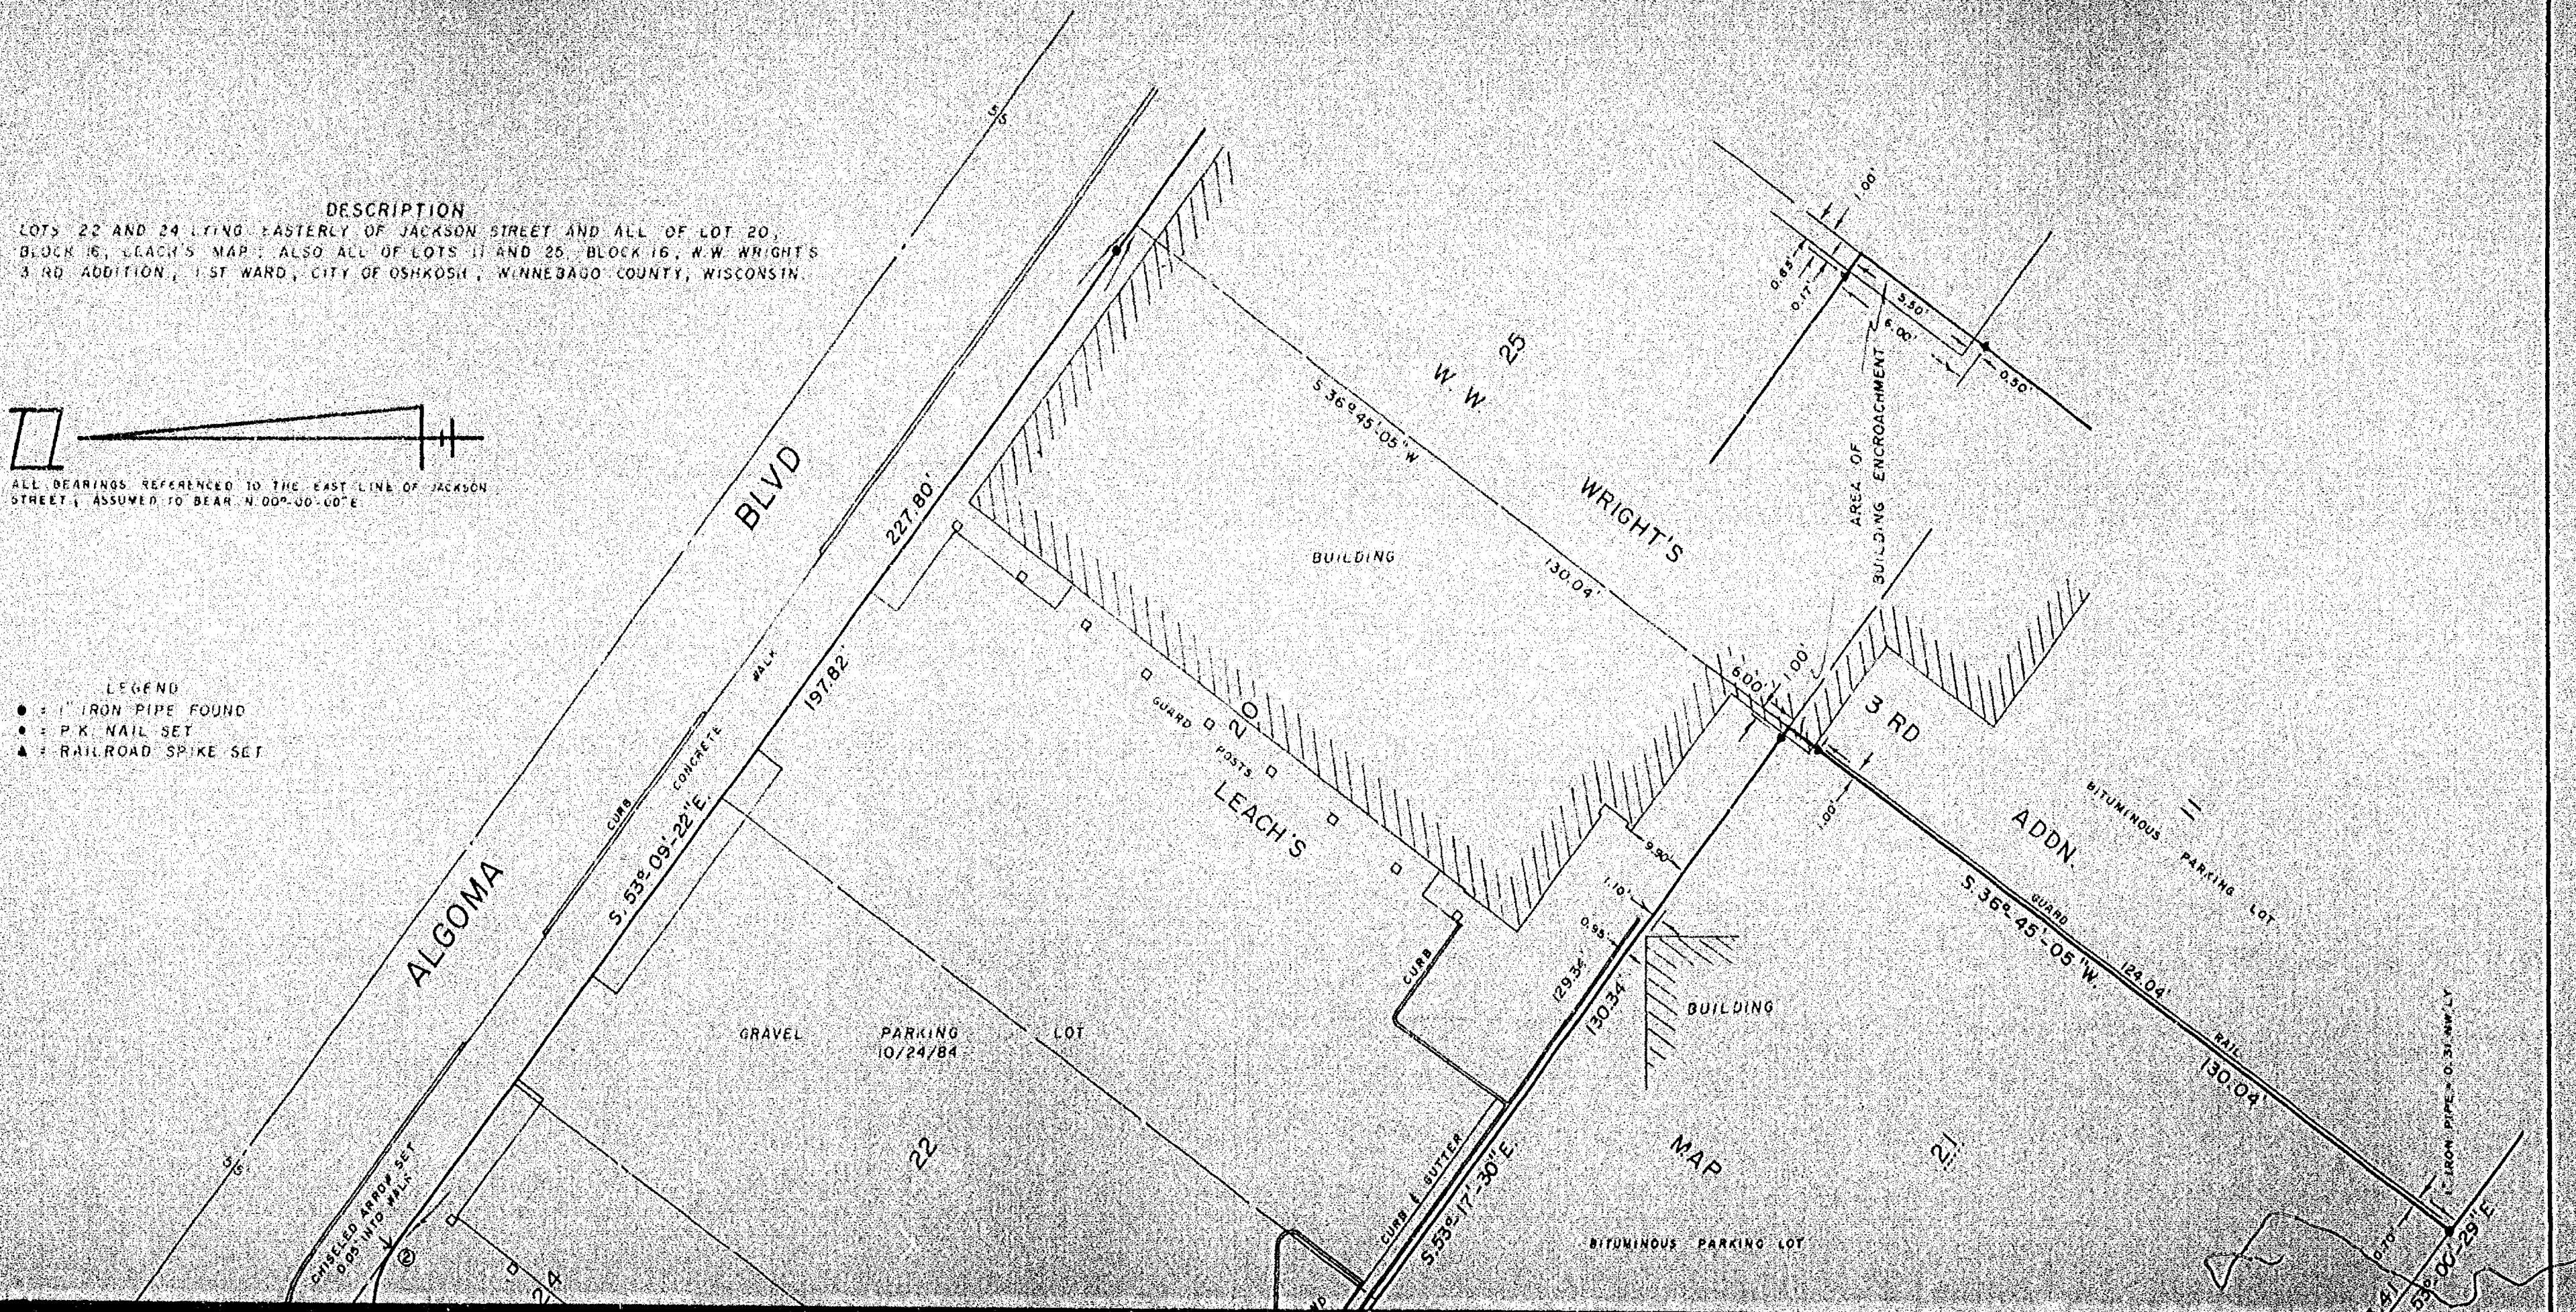

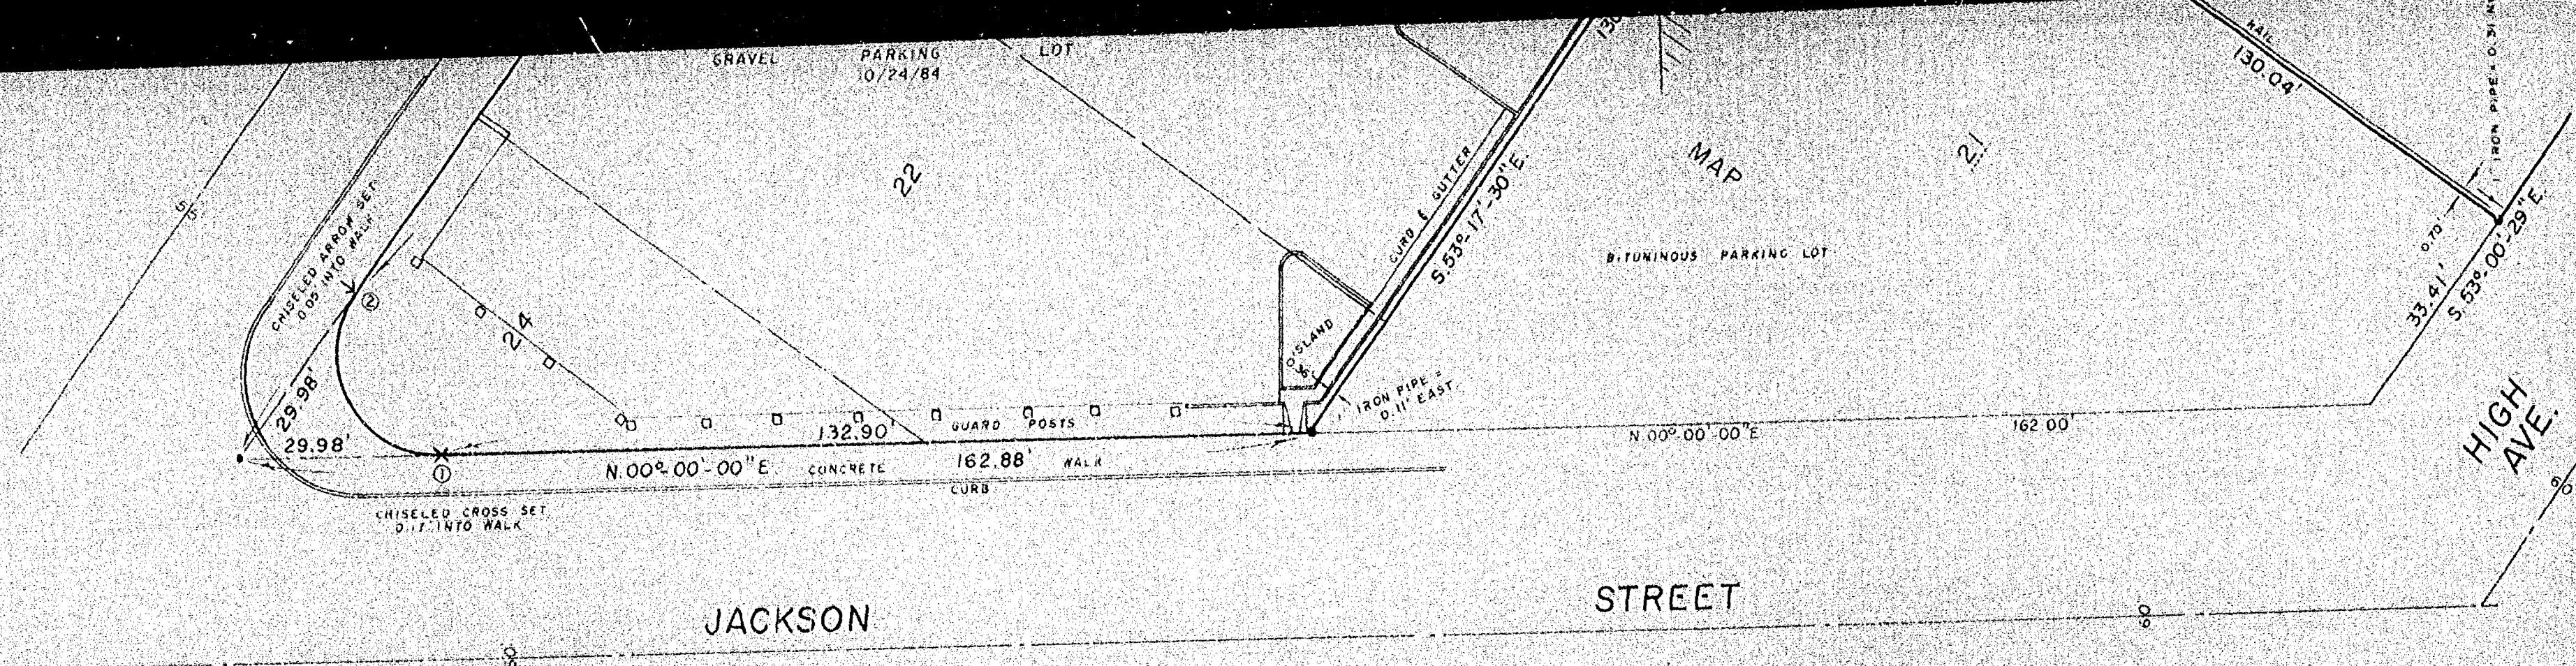


CURVE 1 - 2
 RADIUS = 15.00'
 CHORD BEARING = N. 63° 25' 19" E
 CHORD LENGTH = 26.83'
 ARC LENGTH = 33.21'
 CENTRAL ANGLE = 126° 50' 38"
 TANGENT BEARING = S. 00° 00' 00" E
 " = S. 53° 09' 22" E

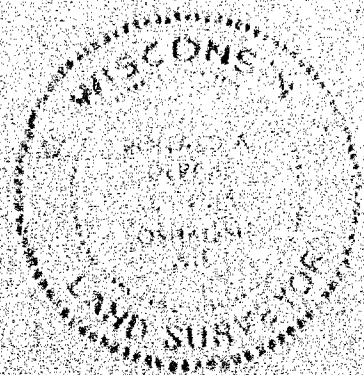

DATED THIS 25th DAY OF October, 1984

Ronald A. Dercks
 WISCONSIN REGISTERED LAND SURVEYOR S-1615
 RONALD A. DERCKS

I, RONALD A. DERCKS, WISCONSIN REGISTERED LAND SURVEYOR OF AERO-ENGINEERING, INC.,
 CERTIFY THAT I HAVE SURVEYED THE ABOVE DESCRIBED PROPERTY AND THAT THE MAP SHOWN
 ABOVE IS A TRUE AND CORRECT REPRESENTATION THEREOF TO THE BEST OF MY KNOWLEDGE
 AND BELIEF

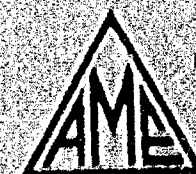

AERO-METRIC ENGINEERING, INC.

1091 SOUTH WASHBURN STREET OSHKOSH, WISCONSIN 54901
 DATE: 10/24/84 NOTEBOOK: 85 PAGE: 22-26 SCALE: 1" = 20'

SURVEY FOR C.R. MEYER CONSTRUCTION
 COMPANY OF PORTION OF WISCONSIN TELEPHONE
 COMPANY PROPERTY, 1ST WARD, CITY OF
 OSHKOSH

OTTER AVE.

SURVEY
FOR
RAMON VOILS

N. $76^{\circ}-15'-00''$ W. 48.93'

1" I.P. Found
0.39' South

(19')

(30')
(49')

1" I.P. Found
0.14' South

West half Lot 10 and the East
19 feet of Lot 11, Block 5,
Bowen's Addition, 8th Ward,
City of Oshkosh, Winnebago
County, Wisconsin.

8078.556 Sq. Ft.

LOT 11

LOT 10

S. $14^{\circ}-00'-09''$ W. 165.08'

(165')

N. $13^{\circ}-59'-44''$ E. 165.06'

(165')

I, Lawrence C. Kriescher,
Wisconsin Registered Land
Surveyor of Aero-Metric
Engineering, Inc., certify
that I have surveyed the
above described property
and that the map shown to
the left is a true and
accurate representation
thereof to the best of my
knowledge and belief.

Lawrence C. Kriescher
Wisconsin Registered Land Surveyor
Lawrence C. Kriescher S-1599



LEGEND

● 1" IRON PIPE FOUND
SCALE: 1" = 20'
DATE: OCT. 10, 1984

1" I.P. Found

(19')

(30')

1" I.P. Found
0.27' South

S. $76^{\circ}-16'-44''$ E. 48.95'

ALLEY

Aero-Metric Engineering, Inc.
1091 S. Washburn Street
Oshkosh, Wisconsin

L-1339

SURVEY FOR MILTON GALOW
1763 Southland Avenue

PURPOSE: Separate the consolidation of Lots 8 & 11 in Skyview Acres, being recognized as one parcel, into two parcels: Lot 8 Skyview Acres and Lot 11 Skyview Acres.


RESTRICTION: The garage located on LOT 11 shall be used by the owner of LOT 11. The owner of LOT 8 shall no longer have any rights to said garage.

CERTIFICATE OF PLANNING COMMISSION:

The city of Oshkosh Planning Commission approves the lot Division of Milton Galow of Lots 8 and 11 Skyview Acres, 6th Ward, City of Oshkosh.

Date _____

Paul Ehrfurth
Secretary of Planning Commission

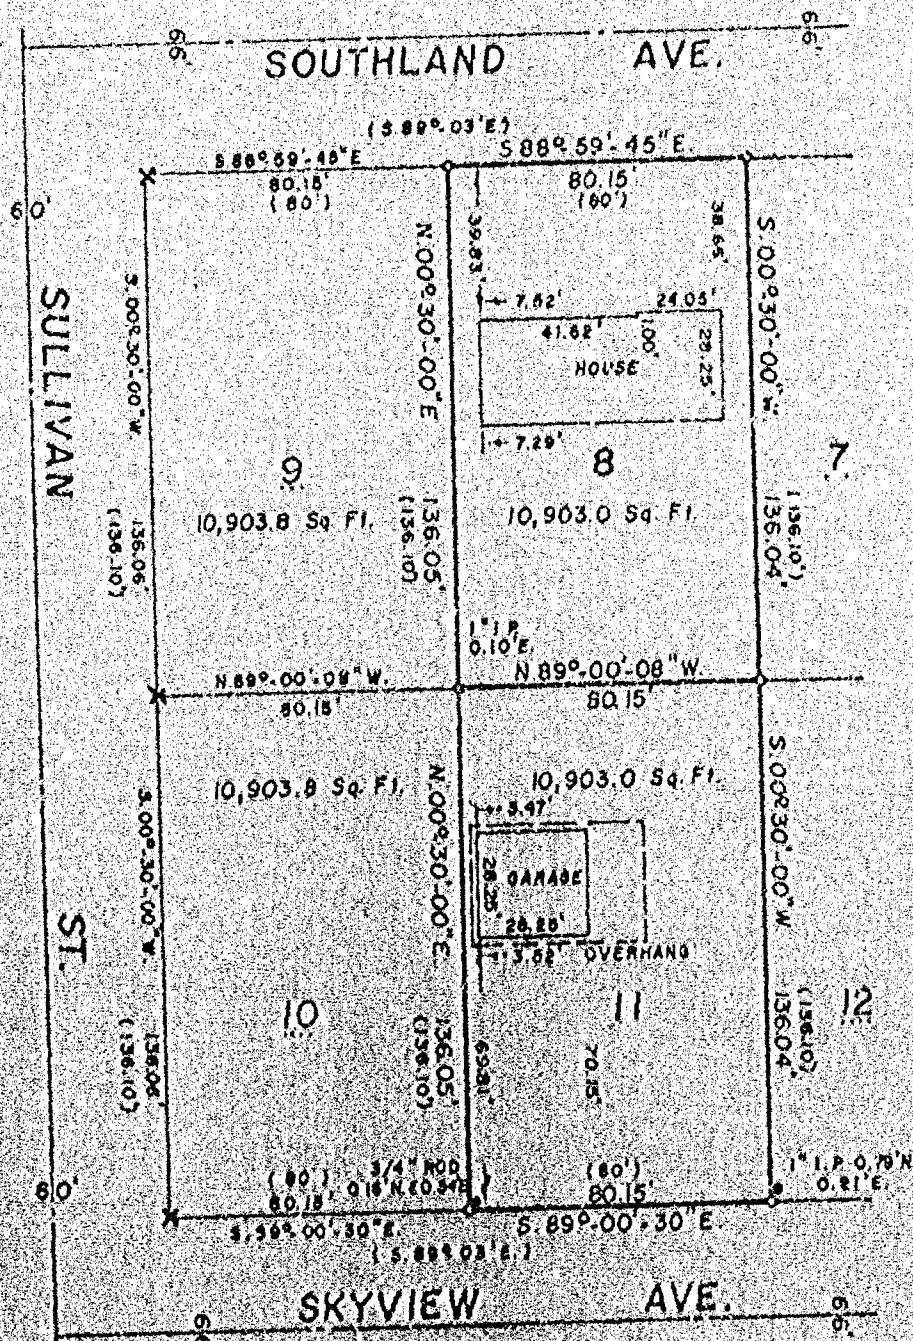

LEGEND

- = 1" IRON PIPE SET
- X = CHISELED CROSS SET
- = 1" IRON PIPE FOUND
- = 3/4" ROD FOUND

SCALE: 1" = 50'
OCTOBER 17, 1984

I, Ronald A. Dercks, Wisconsin Registered Land Surveyor of Aero Metric Engineering, Inc., certify that I have surveyed Lots 8 & 11 Skyview Acres and that the map shown above is a true and accurate representation thereof to the best of my knowledge and belief.

AERO-METRIC ENGINEERING, INC.
PHOTOGRAMMETRIC ENGINEERS
LAND SURVEYORS
OSHKOSH, WISCONSIN


Ronald A. Dercks
WIS. REGISTERED LAND SURVEYOR S-1615
NOTEBOOK 85 PAGE 17



SURVEY
for
ATTORNEY FINTAN M. FLANAGAN
of

The South 38 feet of lot 24 and the North 2 feet of lot 25 in Block 65 of SCHINTZ'S ADDITION, 11th Ward, City of Oshkosh, Winnebago County, Wisconsin.

Description for PROPOSED JOINT DRIVEWAY EASEMENT: The West 108 feet of the South 3 feet of lot 24 and the West 108 feet of the North 7 feet of lot 25 all in Block 65 of SCHINTZ'S ADDITION, 11th Ward, City of Oshkosh, Winnebago County, Wisconsin.

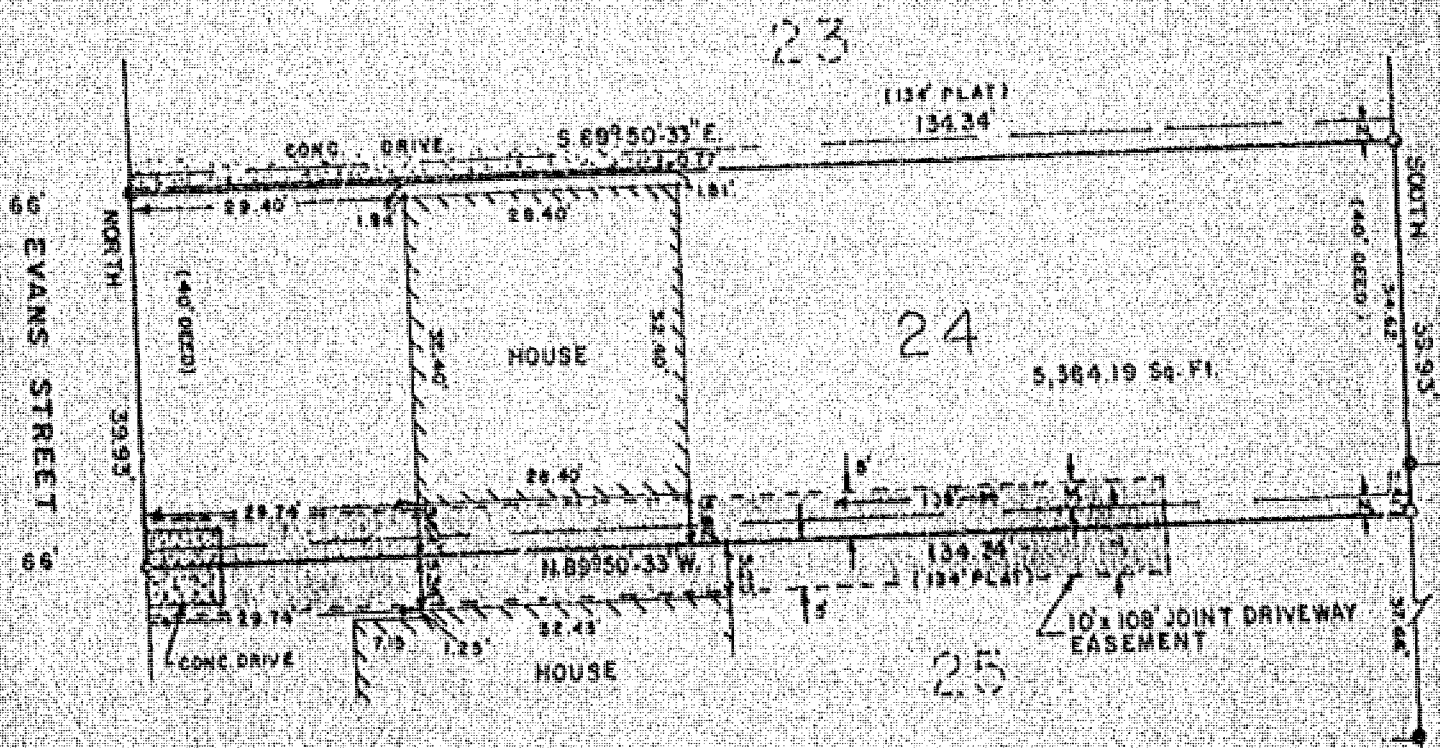

LEGEND
O x 1" IRON PIPE SET
x 1/2" REBAR SET
● x 1" IRON PIPE FOUND
SCALE 1"=20'
DATE NOV. 24, 1980

I, STEVEN T. CHRONIS, WISCONSIN REGISTERED LAND SURVEYOR OF AERO-METRIC ENGINEERING, INC., HAVE SURVEYED THE ABOVE DESCRIBED PROPERTY AND THE ABOVE MAP IS A TRUE REPRESENTATION THEREOF AND SHOWS THE SIZE AND LOCATION OF THE PROPERTY, ITS EXTERIOR BOUNDARIES, THE LOCATION AND DIMENSIONS OF ALL STRUCTURES THEREON, FENCES, APPARENT EASEMENTS AND ROADWAYS AND VISIBLE ENCROACHMENTS IF ANY.

"THIS SURVEY IS MADE FOR THE EXCLUSIVE USE OF THE PRESENT OWNERS OF THE PROPERTY AND ALSO THOSE WHO PURCHASE, MORTGAGE OR GUARANTEE THE TITLE THEREIN WITHIN ONE (1) YEAR FROM DATE HEREOF AND AS TO THEM I HEREBY CERTIFY THAT SAID SURVEY AND THE ABOVE MAP WERE MADE IN ACCORDANCE WITH ACCEPTABLE PROFESSIONAL STANDARDS AND THAT THE INFORMATION CONTAINED THEREIN IS TO THE BEST OF MY KNOWLEDGE, INFORMATION AND BELIEF, A TRUE AND ACCURATE REPRESENTATION THEREOF."


Steven T. Chronis
STEVEN T. CHRONIS
WISCONSIN REGISTERED LAND SURVEYOR A-913

DATED THIS 25th DAY OF November 1980

AERO-METRIC ENGINEERING, INC.
PHOTOGRAMMETRIC ENGINEERS
LAND SURVEYORS
OSHKOSH, WISCONSIN





ALL BEARINGS REFERENCE TO THE EAST
LINE OF EVANS STREET ASSUMED TO BE AN
NORTH

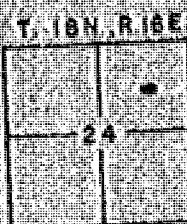

NOTE: SURVEY PREPARED FROM QUIT CLAIM DEED DOCUMENT NO. 559822 FOR THE EXTERIOR BOUNDARY AND QUIT CLAIM DEED VOLUME 989 PAGE 368 FOR TITAN COURT AND THE INTERIOR LOTS WERE SURVEYED FROM THE CITY ASSESSOR'S DESCRIPTIONS AND SURVEY DESCRIPTIONS PREPARED BY JOHN SCHNEIDER


CURVE NO.	LOT NO.	RADIUS LENGTH	CHORD BEARING	CURVE DATA			
				CHORD LENGTH	CENTRAL ANGLE	ARC LENGTH	TANGENT BEARING
1-2	1	40.00'	S. 04°-26'-26" E.	6.26'	08°-50'-46"	6.27'	N. 01°-20'-10" E.
3-4	3	35.00'	N. 89°-45'-36" E.	40.00'	69°-41'-55"	42.00'	S. 55°-17'-35" E.
	4	35.00'	S. 18°-31'-42" W.	11.73'	73°-41'-43"	44.71'	N. 55°-07'-24" E.
	5	35.00'	S. 54°-02'-46" E.	41.12'	71°-57'-18"	43.90'	N. 11°-10'-49" E.
	6	35.00'	N. 53°-48'-35" E.	41.31'	72°-20'-40"	44.19'	S. 00°-01'-21" W.
	7	40.00'	N. 18°-45'-59" E.	41.59'	72°-49'-07"	44.89'	S. 11°-30'-22" W.
5-6	8	40.00'	N. 04°-33'-33" W.	6.73'	09°-04'-27"	6.73'	S. 00°-01'-21" W.
	7	40.00'	N. 02°-28'-05" W.	3.41'	04°-53'-25"	3.41'	S. 00°-01'-21" W.
	8	40.00'	N. 07°-00'-16" W.	2.92'	04°-10'-55"	2.92'	S. 00°-01'-21" W.

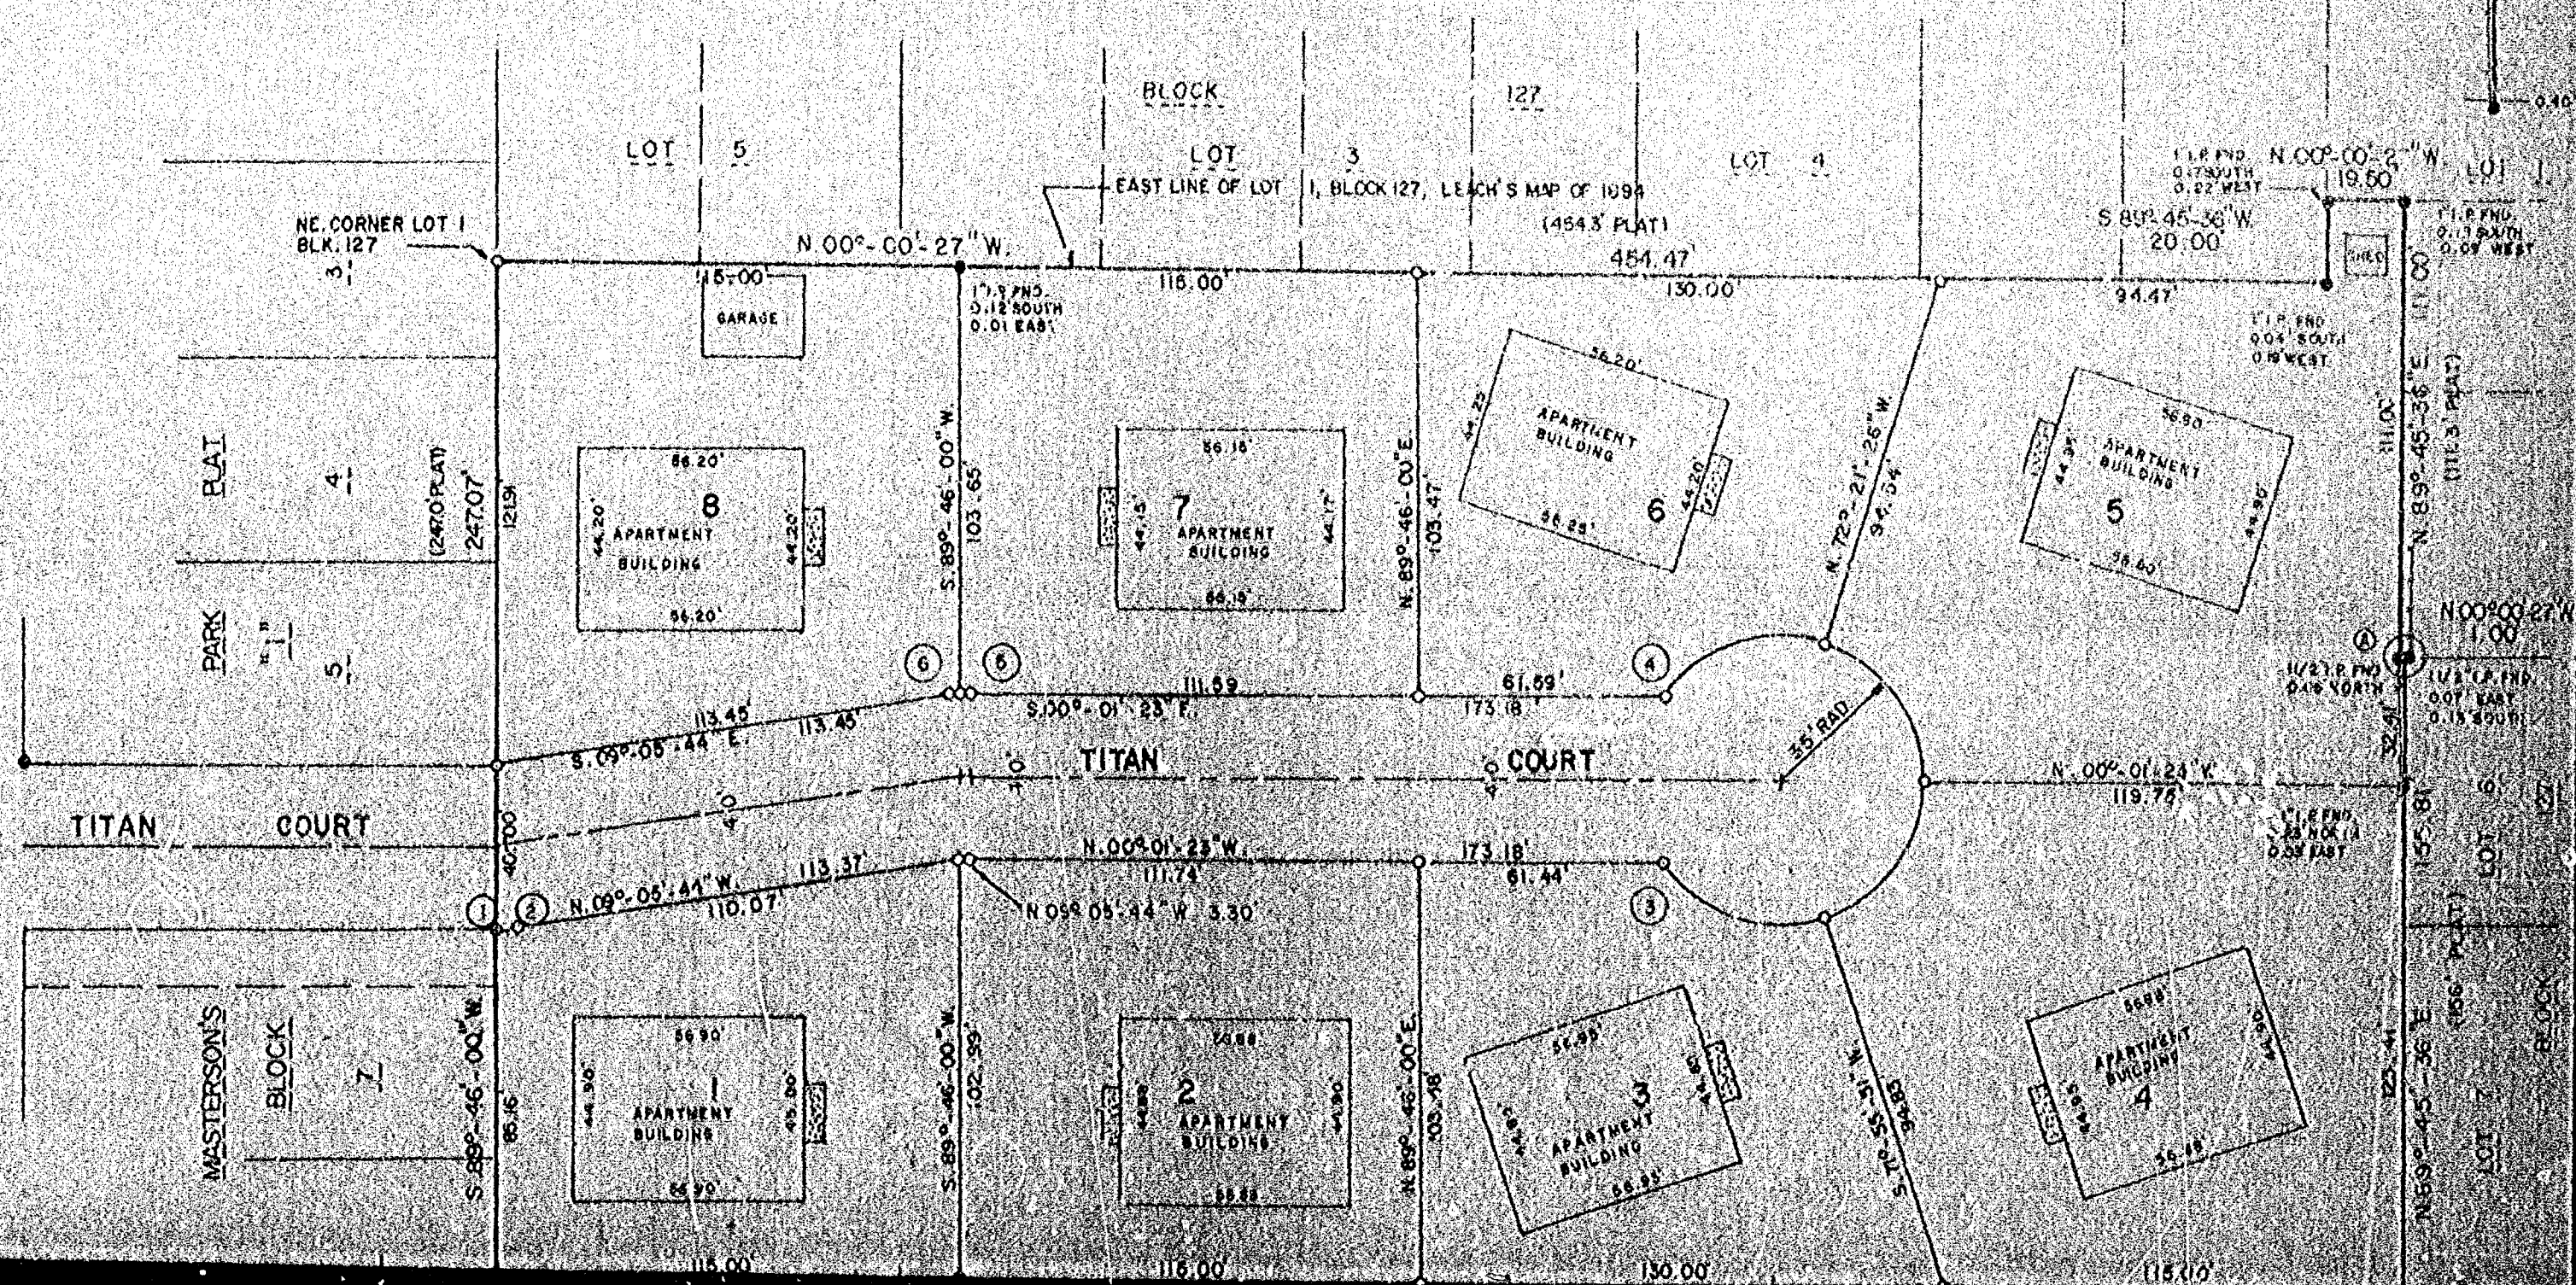

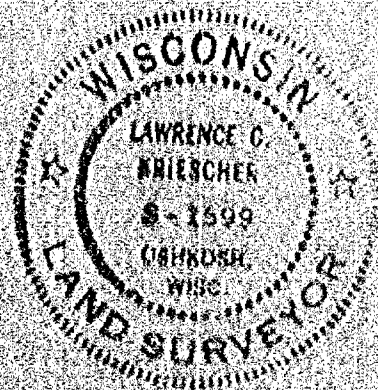


Lawrence C. Kriescher
WISCONSIN REGISTERED LAND SURVEYOR S-1599
LAWRENCE C. KRIESCHER

DATED THIS 17TH DAY OF April, 1981

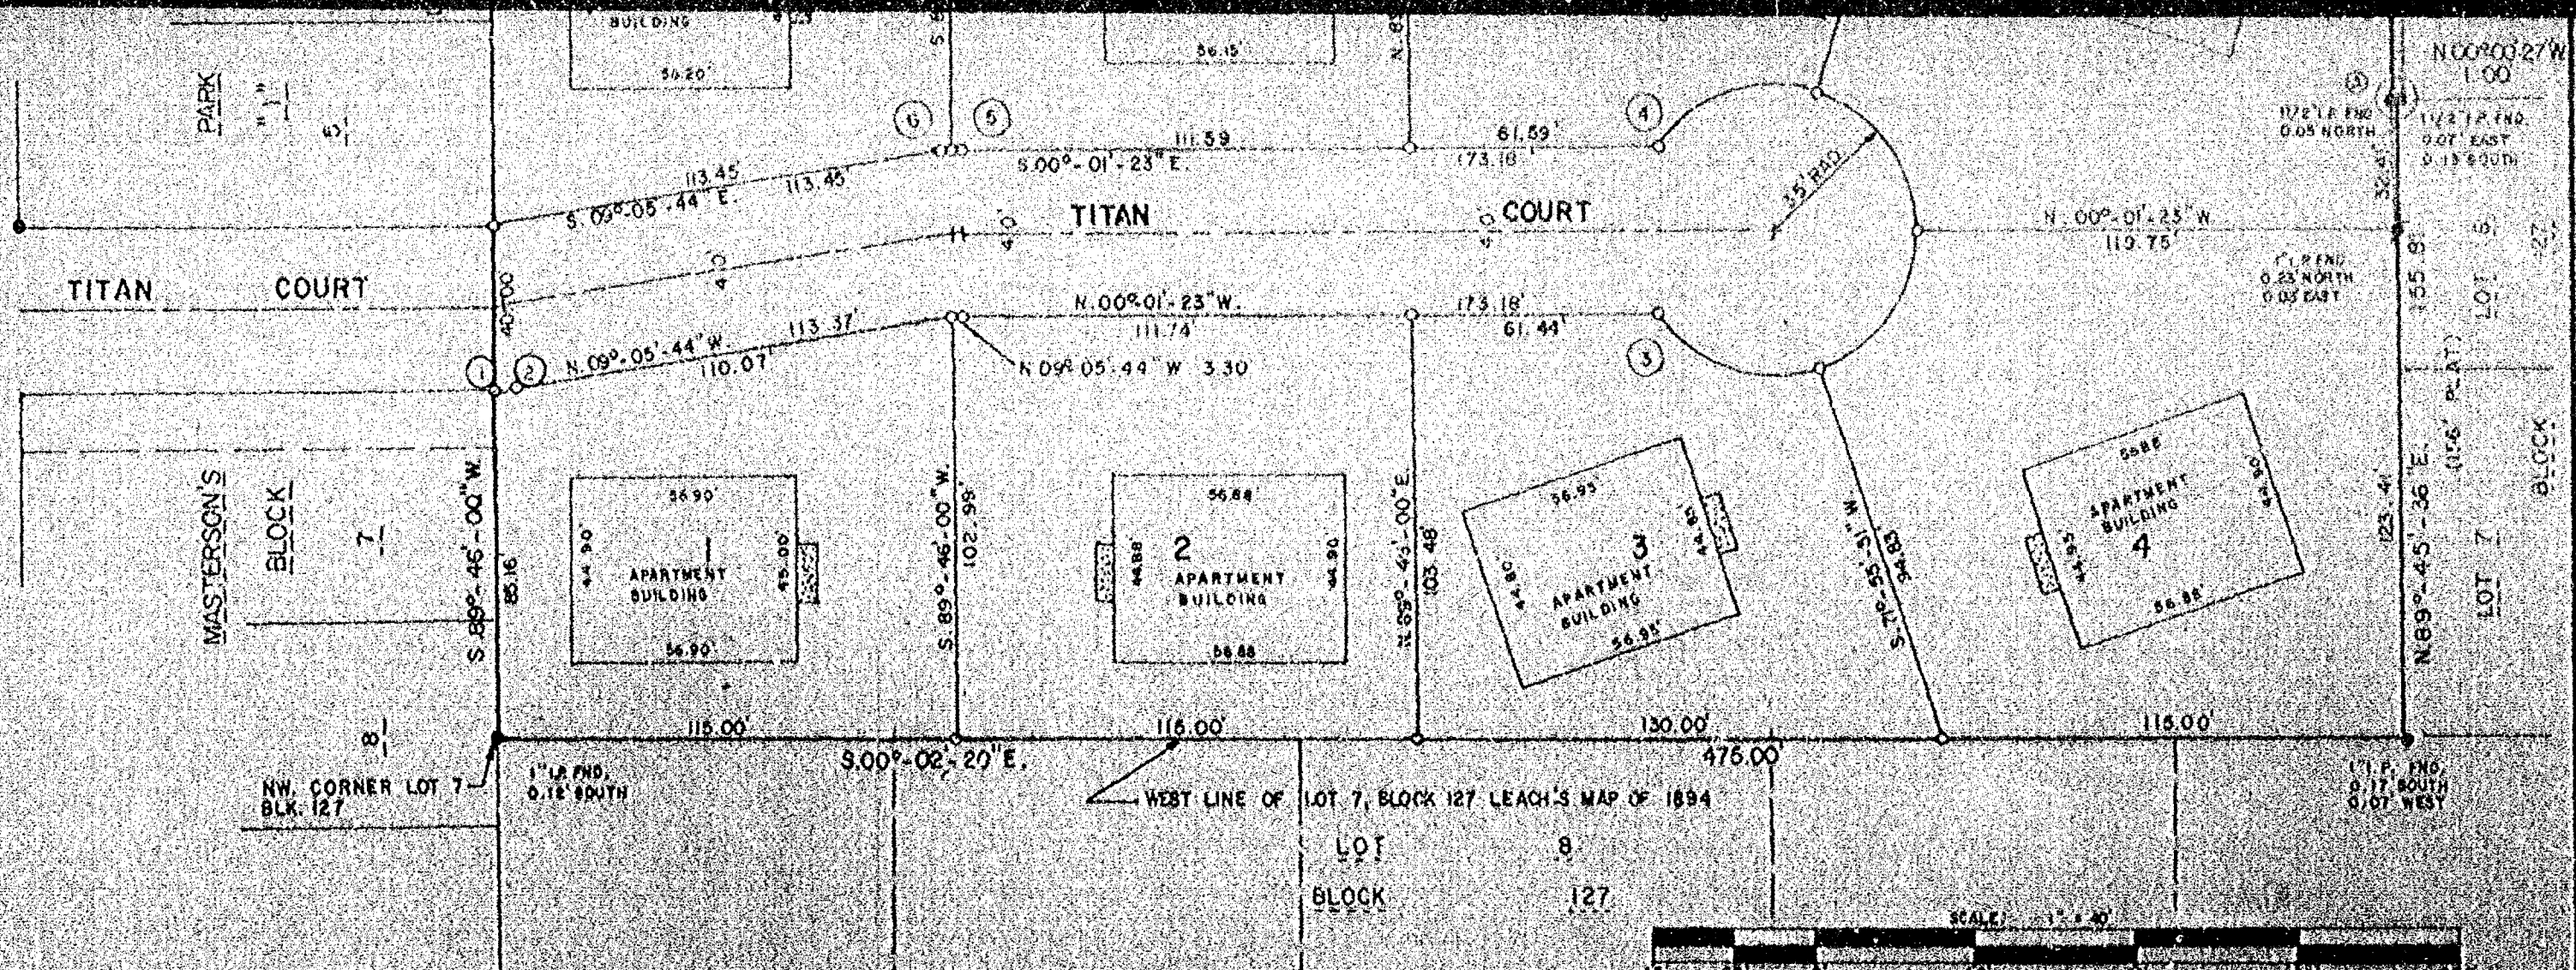

LEGEND
○ = 1" IRON PIPE SET
○ = RAILROAD SPIKE SET
● = IRON PIPE FOUND

ALL BEARINGS REFERENCED TO THE EAST LINE OF WISCONSIN AVE. ASSUMED TO BEAR NORTH.

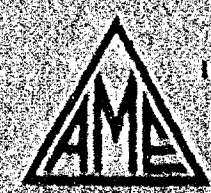


AERO-METRIC ENGINEERING, INC.

1091 SOUTH WASHBURN STREET OSHKOSH, WISCONSIN 54901
DATE: 4/17/81 NOTEBOOK: 58 PAGE: 40-48 SCALE: 1" = 40'

SURVEY FOR VILLAGE SQUARE DEVELOPMENT INC.
OF A PART OF LOTS 1 AND 2, BLOCK 127 OF
LEACH'S MAP OF 1894, 12TH WARD, CITY OF
OSHKOSH, WINNEBAGO COUNTY, WISCONSIN.

SURVEY
FOR
CITY 5200

The East 49.00 feet of the West 104.00 feet of Lot 17, John Smith's Second Addition to Oshkosh, Ninth (9th) Ward, City of Oshkosh, Winnebago County, Wisconsin --- 9741.45 sq. ft.

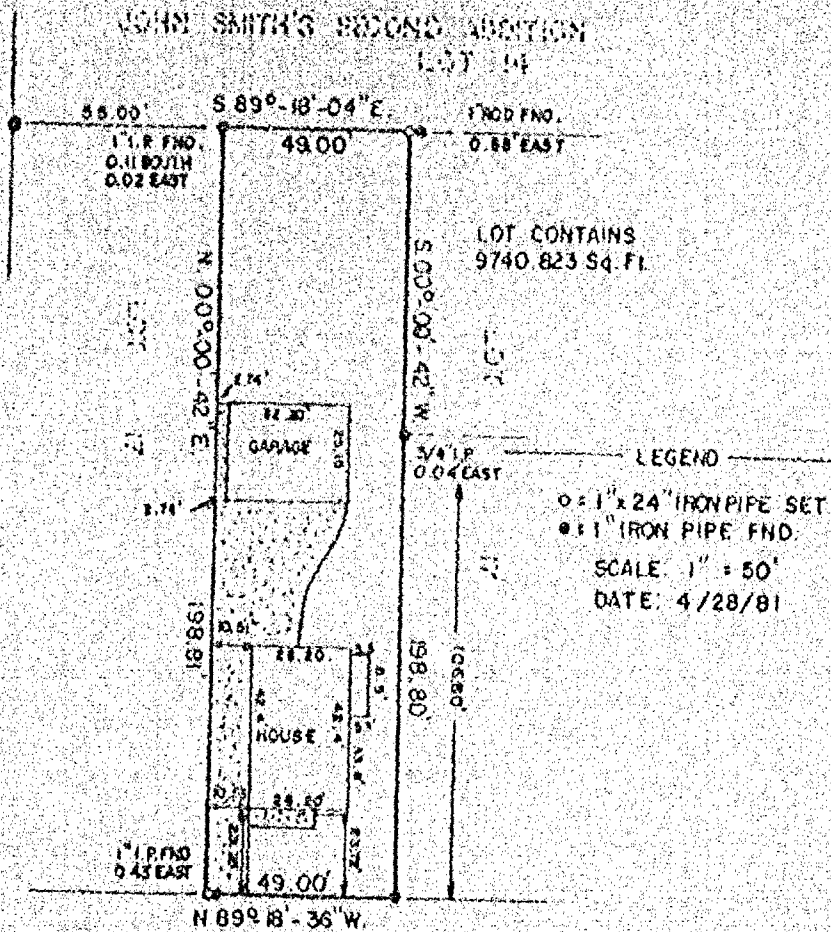

ALL BEARINGS REFERENCED TO THE EAST LINE OF LOT 17
JOHN SMITH'S SECOND ADDITION, ASSUMED TO BE A NORTH

W. 17th AVENUE


I, STEVEN T. CHRONIS, WISCONSIN REGISTERED LAND SURVEYOR OF AERO-METRIC ENGINEERING, INC., HAVE SURVEYED THE ABOVE DESCRIBED PROPERTY AND THE ABOVE MAP IS A TRUE REPRESENTATION THEREOF AND SHOWS THE SIZE AND LOCATION OF THE PROPERTY, ITS EXTERIOR BOUNDARIES, THE LOCATION AND DIMENSIONS OF ALL STRUCTURES THEREON, FENCES, APPARENT EASEMENTS AND ROADWAYS AND VISIBLE ENCROACHMENTS IF ANY.

"THIS SURVEY IS MADE FOR THE EXCLUSIVE USE OF THE PRESENT OWNERS OF THE PROPERTY, AND ALSO THOSE WHO PURCHASE, MORTGAGE OR GUARANTEE THE TITLE THEREIN WITHIN ONE (1) YEAR FROM DATE HEREOF, AND AS TO THEM I HEREBY CERTIFY THAT SAID SURVEY AND THE ABOVE MAP WERE MADE IN ACCORDANCE WITH ACCEPTABLE PROFESSIONAL STANDARDS AND THAT THE INFORMATION CONTAINED THEREON IS, TO THE BEST OF MY KNOWLEDGE, INFORMATION AND BELIEF, A TRUE AND ACCURATE REPRESENTATION THEREOF."

Steven T. Chronis
STEVEN T. CHRONIS
WISCONSIN REGISTERED LAND SURVEYOR S-913

DATED THIS 29th DAY OF April, 1981

AERO-METRIC ENGINEERING, INC.
PHOTOGRAMMETRIC ENGINEERS
LAND SURVEYORS
OSHKOSH, WISCONSIN

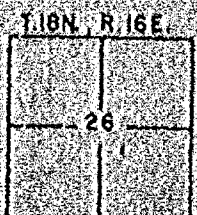


PLAT OF SURVEY

KNOWN AS 2003-2005 MITCHELL STREET, BEING LOT 6 AND THE SOUTH 42.5 FT. OF LOT 7 OF BLOCK 3 IN THE ALEXIA PARK PLAT, 12th WARD, CITY OF OMAHA, WINNEBAGO COUNTY, WISCONSIN, EXCEPTING THEREFROM THE WEST 27.8 FT. THEREOF.

AUGUST 4, 1933

SURVEY FOR OSIROSH SAVINGS
APPLICANT: SULLIVAN
(MOMENT WAIVER ON FILE)


SUBJECT NO. 1278-41

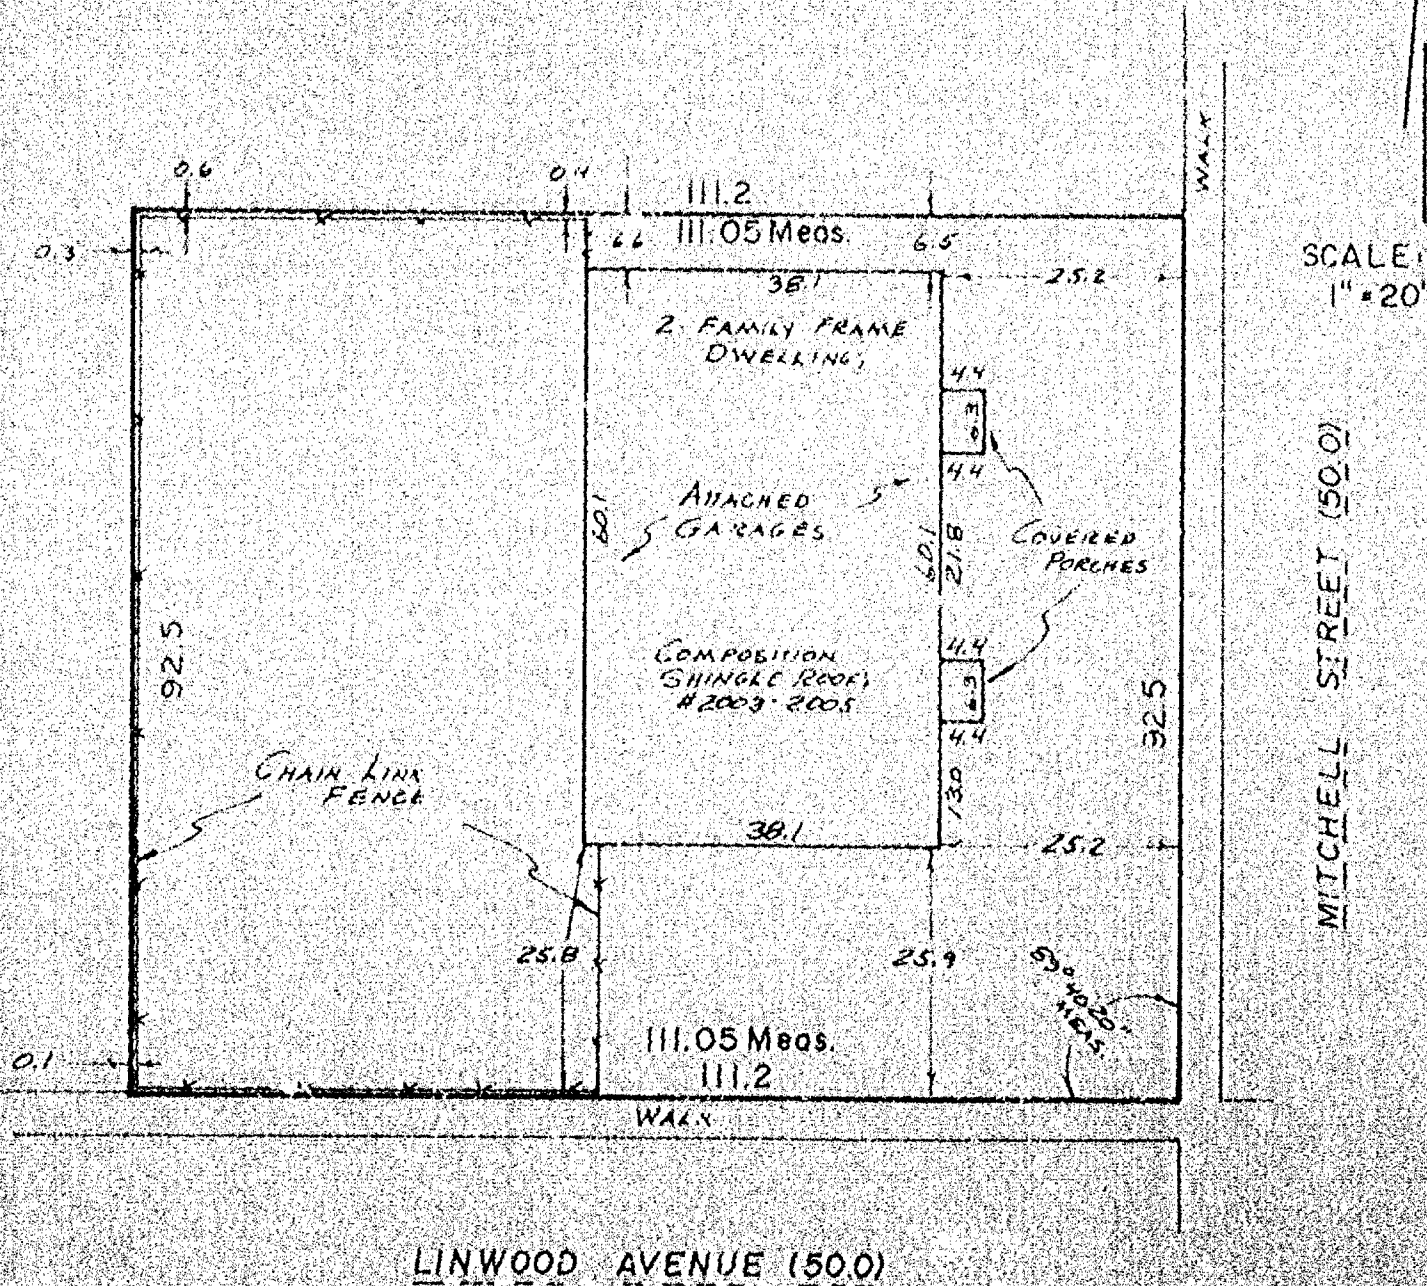

I Certify that I have surveyed the above described property (Property), and the above map is a true representation thereof and shows the size and location of the Property, its exterior boundaries, the location and dimensions of all visible structures thereon, boundary, fences, apparent easements and roadways and visible encroachments, if any. This survey is made for the exclusive use of the present owners of the Property, and also those who purchase, mortgage, or guarantee the title thereto, within one (1) year from date hereof.



national survey & engineering
417 NORTH SAWYER STREET / P.O. BOX 2963
ASHKOSH, WISCONSIN 54903
(414) 426-2800

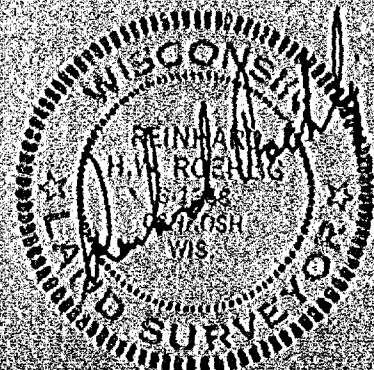


PLAT OF SURVEY

KNOWN AS 1927 PLYMOUTH STREET, BEING LOT 4 OF BLOCK 12 IN ALCONA PARK
PLAT, IN THE 12TH WARD, CITY OF OSHKOSH, WINNEBAGO COUNTY, WISCONSIN.

JULY 28, 1983

DEWILY FOR OSHKOSH SAVINGS
 APPLICANT: BURGERT
 (IMMUNT WAIVER ON FILE)

SURVEY NO. 1275-M

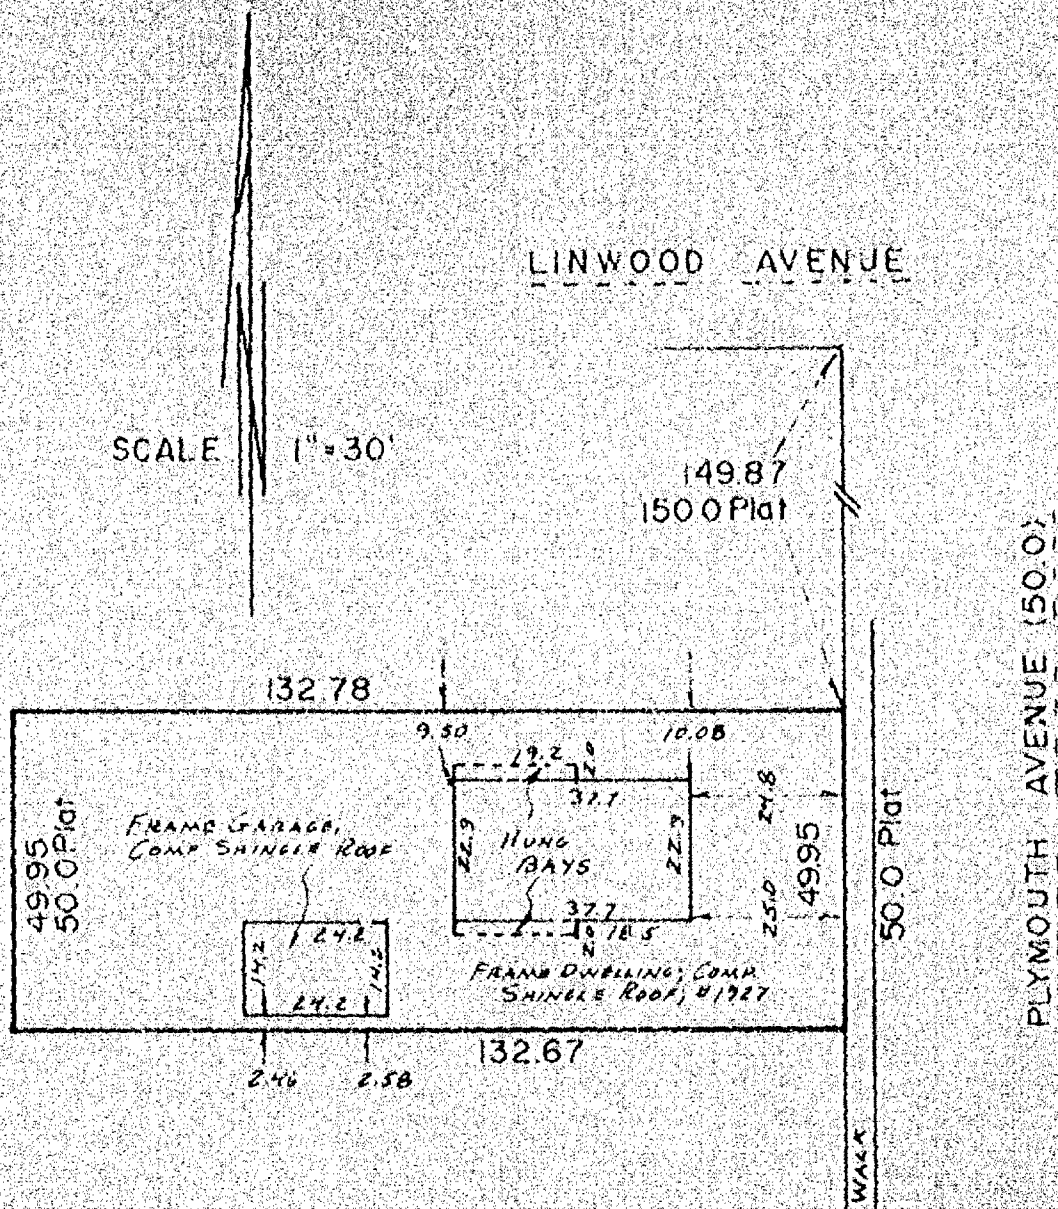

I Certify that I have surveyed the above described property (Property), and the above map is a true representation thereof and shows the size and location of the Property, its exterior boundaries, the location and dimensions of all visible structures thereon, boundary, fences, apparent easements and roadways and visible encroachments, if any. This survey is made for the exclusive use of the present owners of the Property, and also those who purchase, mortgage, or guarantee the title thereto, within one (1) year from date hereof.



national survey & engineering

417 NORTH SAWYER STREET / P.O. BOX 2963
OSHKOSH, WISCONSIN 54903
(414) 426-2800



PLAT OF SURVEY

KNOWN AS 2035 HAMILTON STREET, BEING LOTS 117 AND 118 IN E.M. CRANE'S ADDITION TO ALGONA PARK PLAT, IN THE 12TH WARD, CITY OF OSHKOSH, WINNEBAGO COUNTY, WISCONSIN.


AUGUST 15, 1983

SURVEY FOR OSHKOSH SAVINGS
APPLICANT: RICHARD DUNKE
(CONSENT WAIVER ON FILE)

SURVEY NO. 1282-H


ROOSEVELT STREET (50.0)

HAMILTON STREET (50.0)

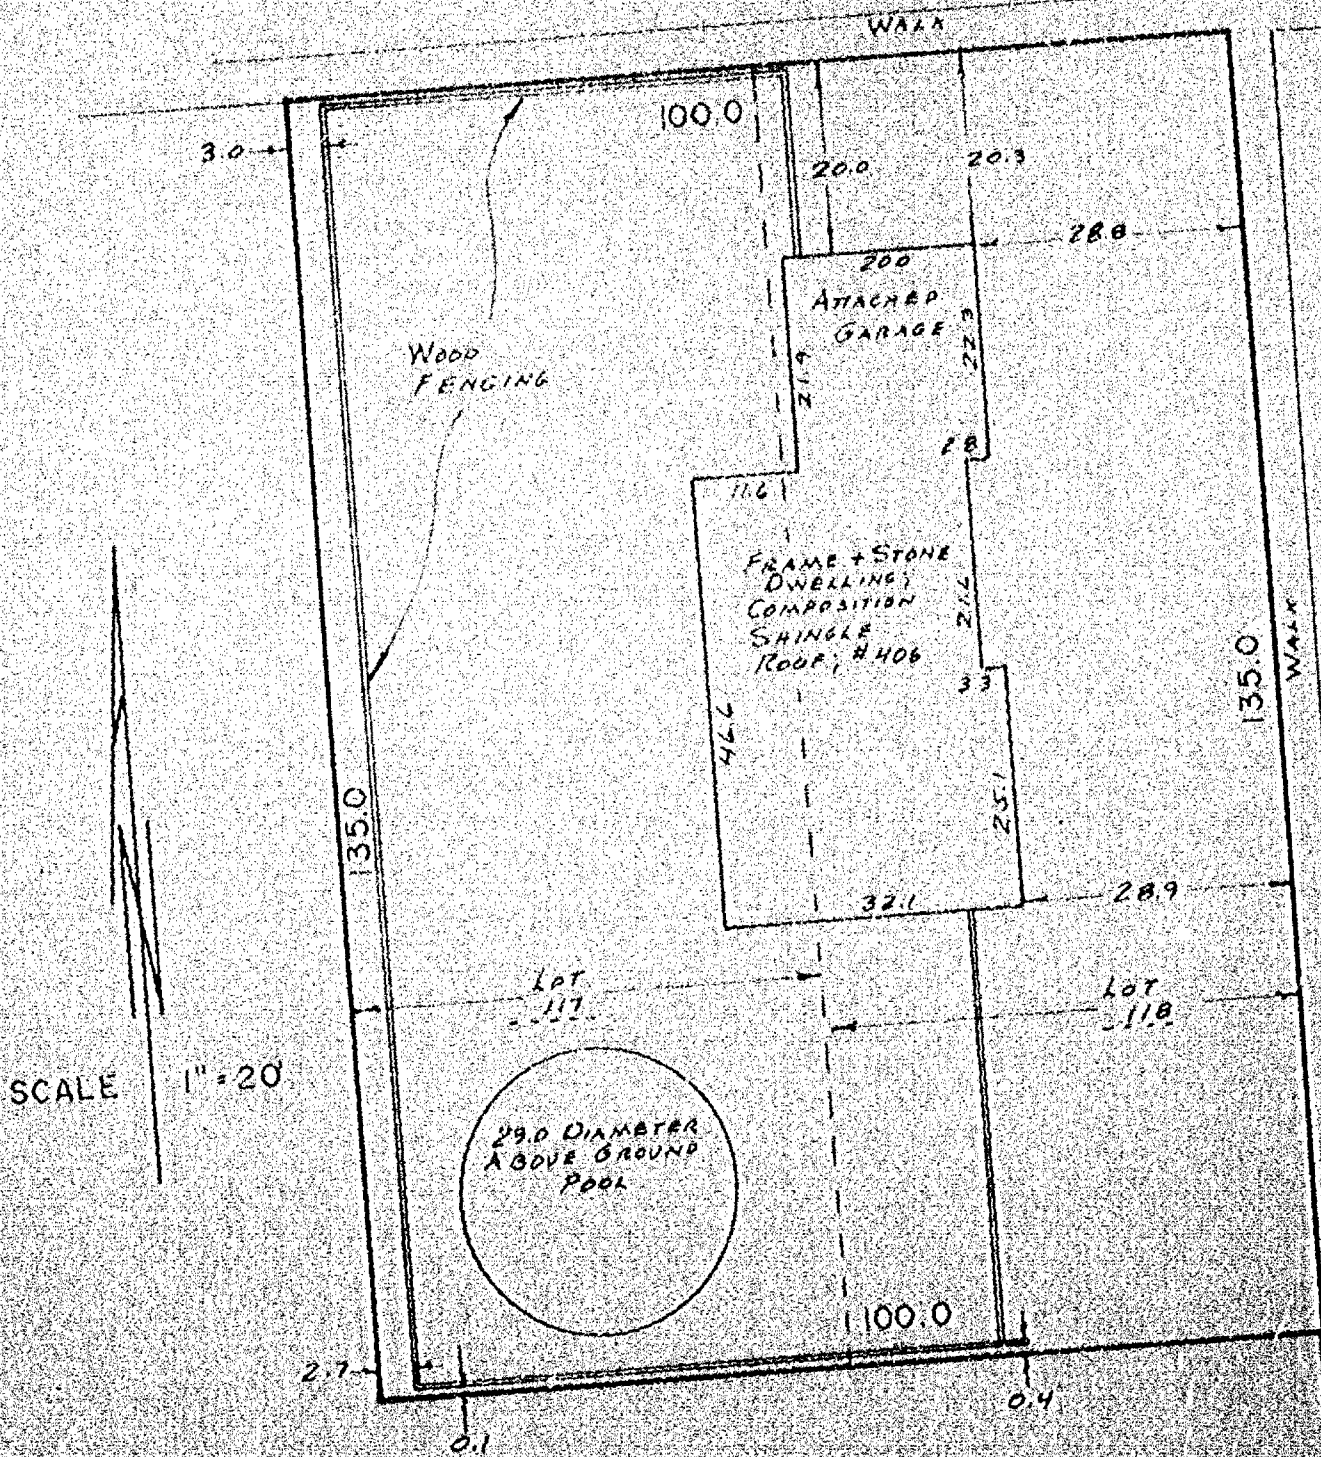

SCALE 1" = 20'

I Certify that I have surveyed the above described property (Property), and the above map is a true representation thereof and shows the size and location of the Property, its exterior boundaries, the location and dimensions of all visible structures thereon, boundary, fences, apparent easements and roadways and visible encroachments, if any. This survey is made for the exclusive use of the present owners of the Property, and also those who purchase, mortgage, or guarantee the title thereto, within one (1) year from date hereof.

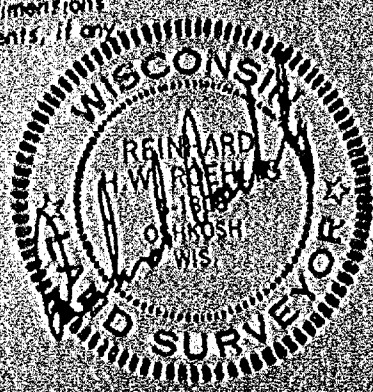

national survey & engineering
417 NORTH SAWYER STREET / P.O. BOX 2963
OSHKOSH, WISCONSIN 54903
(414) 426-2800


PLAT OF SURVEY

KNOWN AS 1629 IOWA STREET, BEING THE NORTH 58.9 FT. OF LOT 7 AND THE SOUTH 95.2 FT. OF THE EAST 50.0 FT. OF THE WEST 1/2 OF LOT 4 IN JOHN SMITH'S 2nd ADDITION, IN THE 9th WARD, CITY OF OSHKOSH, WINNEBAGO COUNTY WISCONSIN.

AUGUST 15, 1983

SURVEY FOR OSHKOSH SAVINGS
APPLICANT: ANDRASHKO & FELKER
(MORTGAGE WAIVER ON FILE)

SURVEY NO. 1283-M

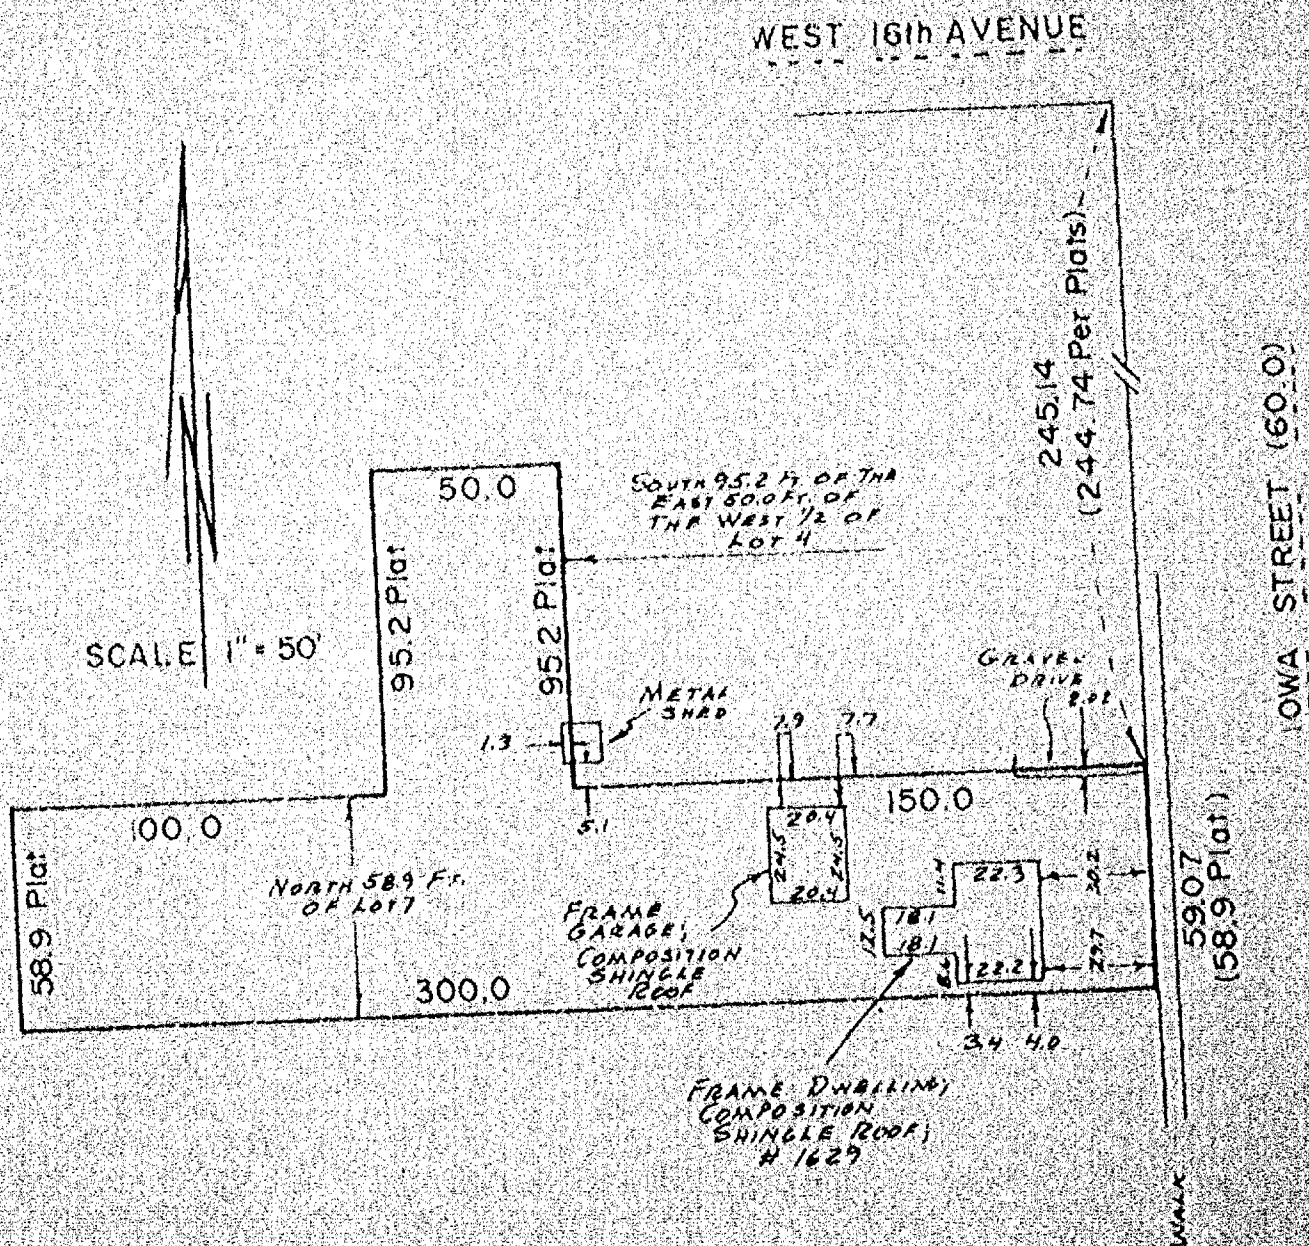

I Certify that I have surveyed the above described property (Property), and the above map is a true representation thereof and shows the size and location of the Property, its exterior boundaries, the location and dimensions of all visible structures thereon, boundary, fences, apparent easements and roadways and visible encroachments. This survey is made for the exclusive use of the present owners of the Property, and also those who purchase, mortgage, or guarantee the title thereto, within one (1) year from date hereof.



national survey & engineering

417 NORTH SAWYER STREET / PO BOX 2883
OSHKOSH, WISCONSIN 54903
(414) 428-2800




Winnebago Land Surveying
511 Baldwin Avenue, Oshkosh, Wisconsin 54901
Phone (414) 426-4951

MAP OF SURVEY

LOT 6, YOUNG-MULLER PARKSIDE PLAT, 12TH WARD, CITY OF OSHKOSH,
WINNEBAGO COUNTY, WISCONSIN

PARKSIDE DRIVE (66')

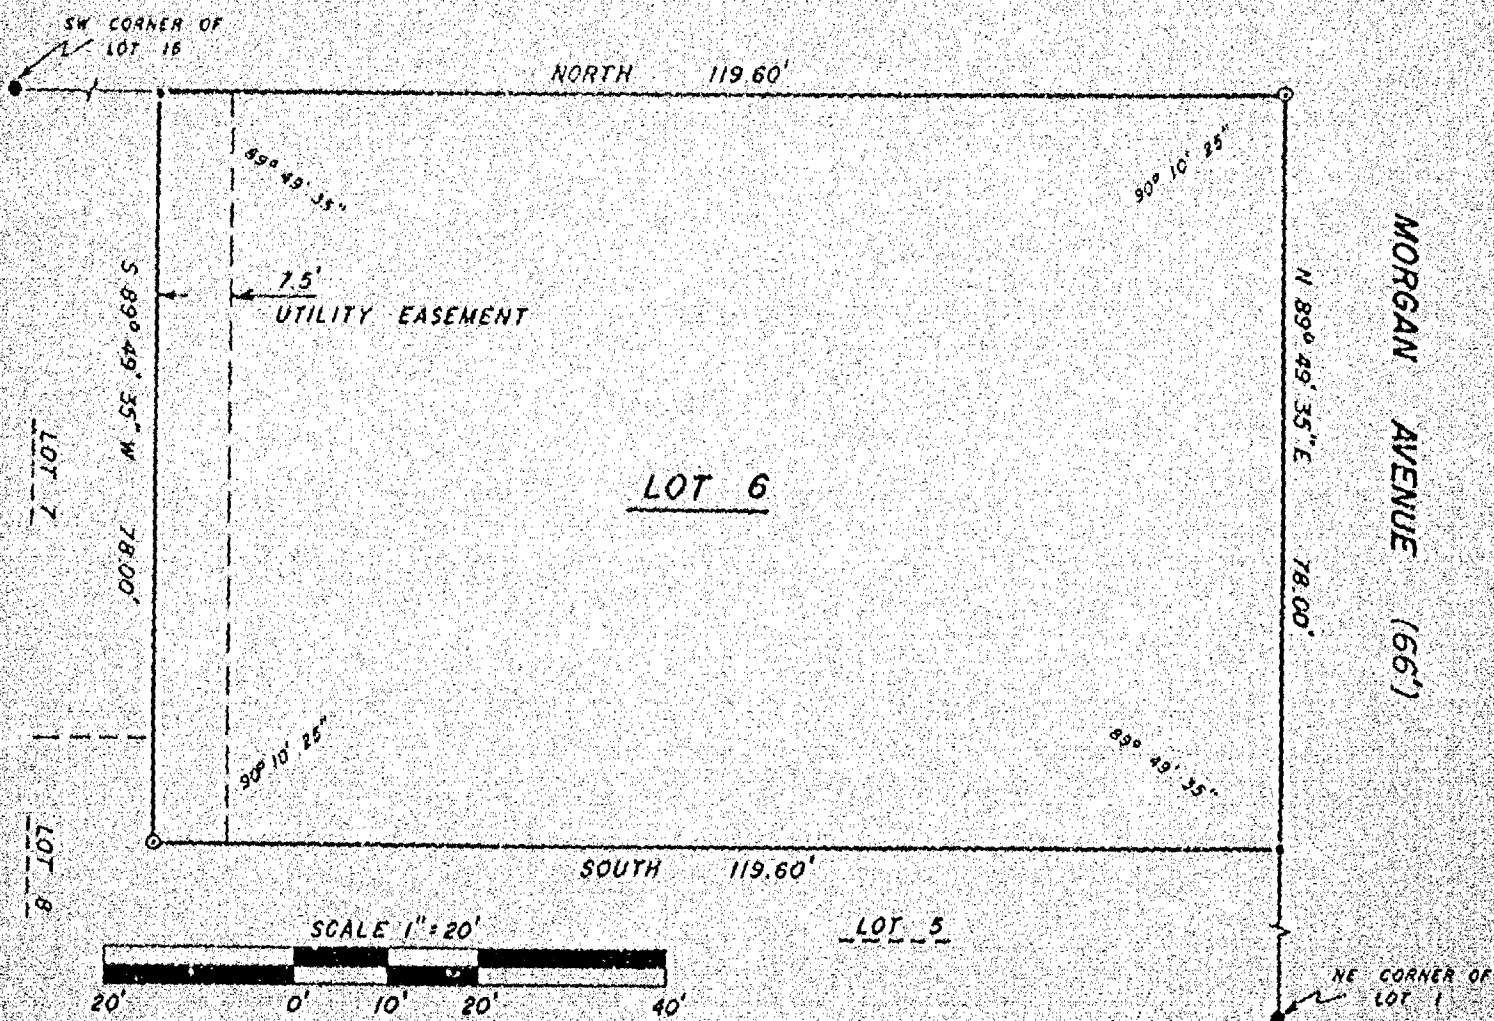

LEGEND

- ⊙ -- 1" 30" REBAR SET
- -- 3/4" REBAR FOUND
- -- 1 1/4" REBAR FOUND

BEARINGS REFERENCED TO THE EAST LINE OF LOT 6,
ASSUMED TO BEAR SOUTH

SURVEYOR'S CERTIFICATE

I, ALAN K. SHUTE, WISCONSIN REGISTERED LAND SURVEYOR, HAVE SURVEYED THE SITE SHOWN ON THIS MAP. THIS SURVEY AND MAP SHOWS THE SIZE AND LOCATION OF THE PROPERTY, ITS EXTERIOR BOUNDARIES, THE LOCATION AND DIMENSIONS OF ALL STRUCTURES THEREON, FENCES, APPARENT EASEMENTS, ROADWAYS AND VISIBLE ENCROACHMENTS IF ANY. THIS SURVEY IS MADE FOR THE EXCLUSIVE USE OF: RUSS YOUNG INC., 2308 JACKSON DRIVE, OSHKOSH, WISCONSIN, 54901 AND THOSE WHO PURCHASE, MORTGAGE OR GUARANTEE THE TITLE THERETO WITHIN ONE (1) YEAR FROM THE DATE HEREOF. TO THEM I CERTIFY THAT THIS SURVEY AND MAP WERE MADE IN ACCORDANCE WITH ACCEPTABLE PROFESSIONAL STANDARDS AND IN MY PROFESSIONAL OPINION THE ACCOMPANYING MAP IS A TRUE AND ACCURATE REPRESENTATION OF THIS SITE TO THE BEST OF MY KNOWLEDGE, INFORMATION AND BELIEF.



ALAN K. SHUTE S-1518
DATED THIS 9th DAY OF MAY, 1983

DB NO. 19-1047-03

FLDBOOK 102, PAGES 3, 4

RUSS YOUNG INC.
2308 JACKSON DRIVE
OSHKOSH, WISCONSIN 54901

PAGE 1 OF 1


DRAWN BY ALAN K. SHUTE

Winnebago Surveying

511 Baldwin Avenue, Oshkosh, Wisconsin 54901
Phone (414) 426-4937

MAP OF SURVEY

LOT 1, BLOCK B, BARBER AND FORWARD'S REPLAT, 12TH WARD,
CITY OF OSHKOSH, WINNEBAGO COUNTY, WISCONSIN

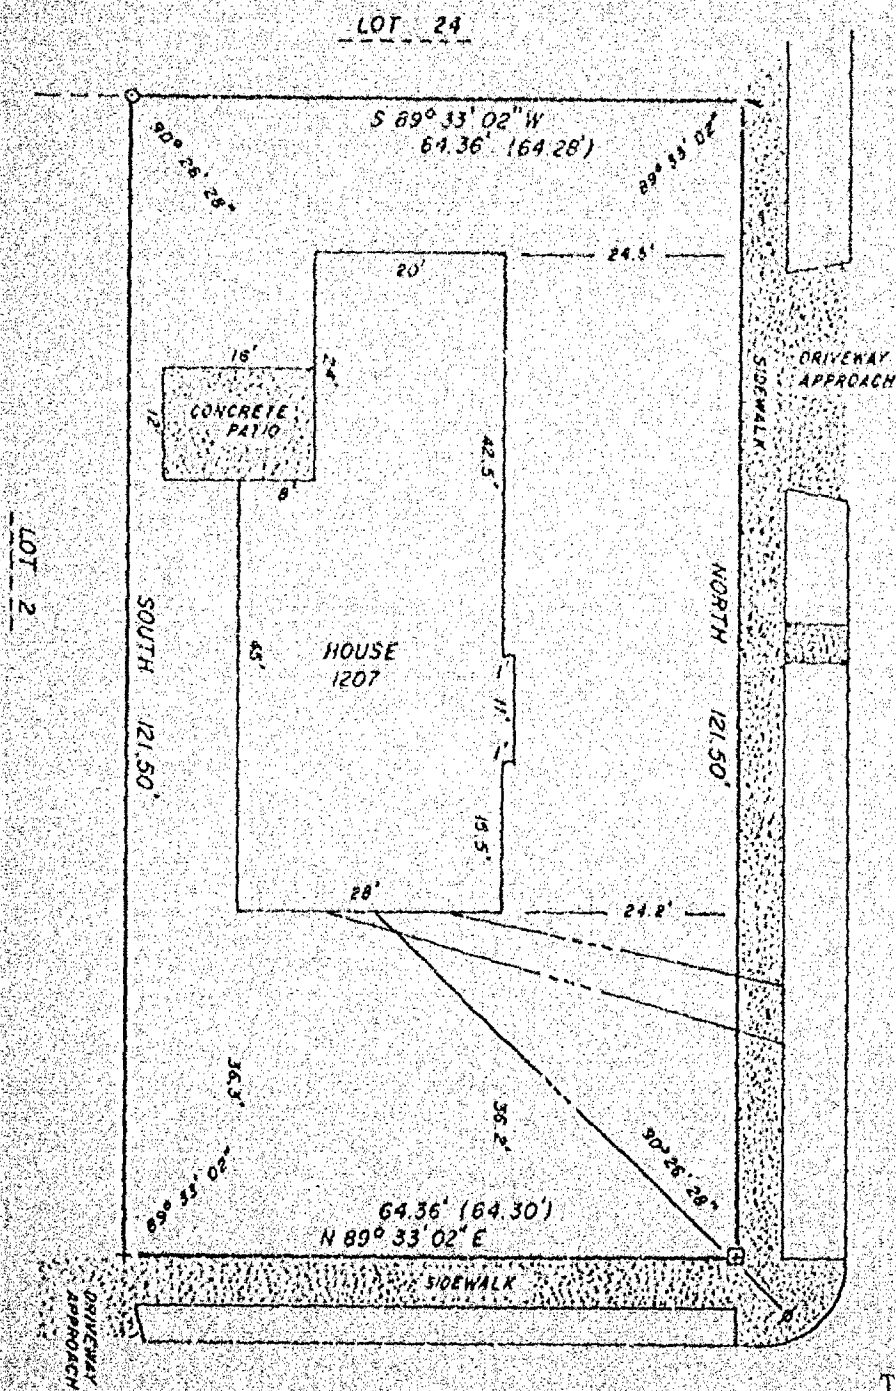

LEGEND

- - 1" 30" REBAR SET
- ✕ - CHISELED NOTCH SET
- ✚ - CHISELED CROSS SET
- Ⓜ - STONE FOUND
- () - RECORDED AS
- OVERHEAD UTILITY LINE

SURVEYOR'S CERTIFICATE

I, ALAN K. SHUTE, WISCONSIN REGISTERED LAND SURVEYOR, HAVE SURVEYED THE SITE SHOWN ON THIS MAP. THIS SURVEY AND MAP REFLECT THE SITE DESCRIBED IN WARRANTY DEED #537514 AND SHOWS THE SIZE AND LOCATION OF THE PROPERTY, ITS EXTERIOR BOUNDARIES, THE LOCATION AND DIMENSIONS OF ALL STRUCTURES THEREON, FENCES, APPARENT EASEMENTS, ROADWAYS AND VISIBLE ENCROACHMENTS IF ANY. THIS SURVEY IS MADE FOR THE EXCLUSIVE USE OF STEVEN RUEDINGER, 1207 WALNUT STREET, OSHKOSH, WISCONSIN, 54901 AND THOSE WHO PURCHASE, MORTGAGE OR GUARANTEE THE TITLE THERETO WITHIN ONE (1) YEAR FROM THE DATE HEREOF. TO THEM I CERTIFY THAT THIS SURVEY AND MAP WERE MADE IN ACCORDANCE WITH ACCEPTABLE PROFESSIONAL STANDARDS AND IN MY PROFESSIONAL OPINION THE ACCOMPANYING MAP IS A TRUE AND ACCURATE REPRESENTATION OF THIS SITE TO THE BEST OF MY KNOWLEDGE, INFORMATION AND BELIEF.

Alan K. Shute

ALAN K. SHUTE R.L.S. - 1518
DATED THIS 17th DAY OF MAY, 1981




Winnebago Surveying

511 Baldwin Avenue, Oshkosh, Wisconsin 54901
Phone (414) 426-4951

MAP OF SURVEY

LOT 14, BLOCK 5, LAKEVIEW PARK, 15TH WARD, CITY OF
OSHKOSH, WINNEBAGO COUNTY, WISCONSIN

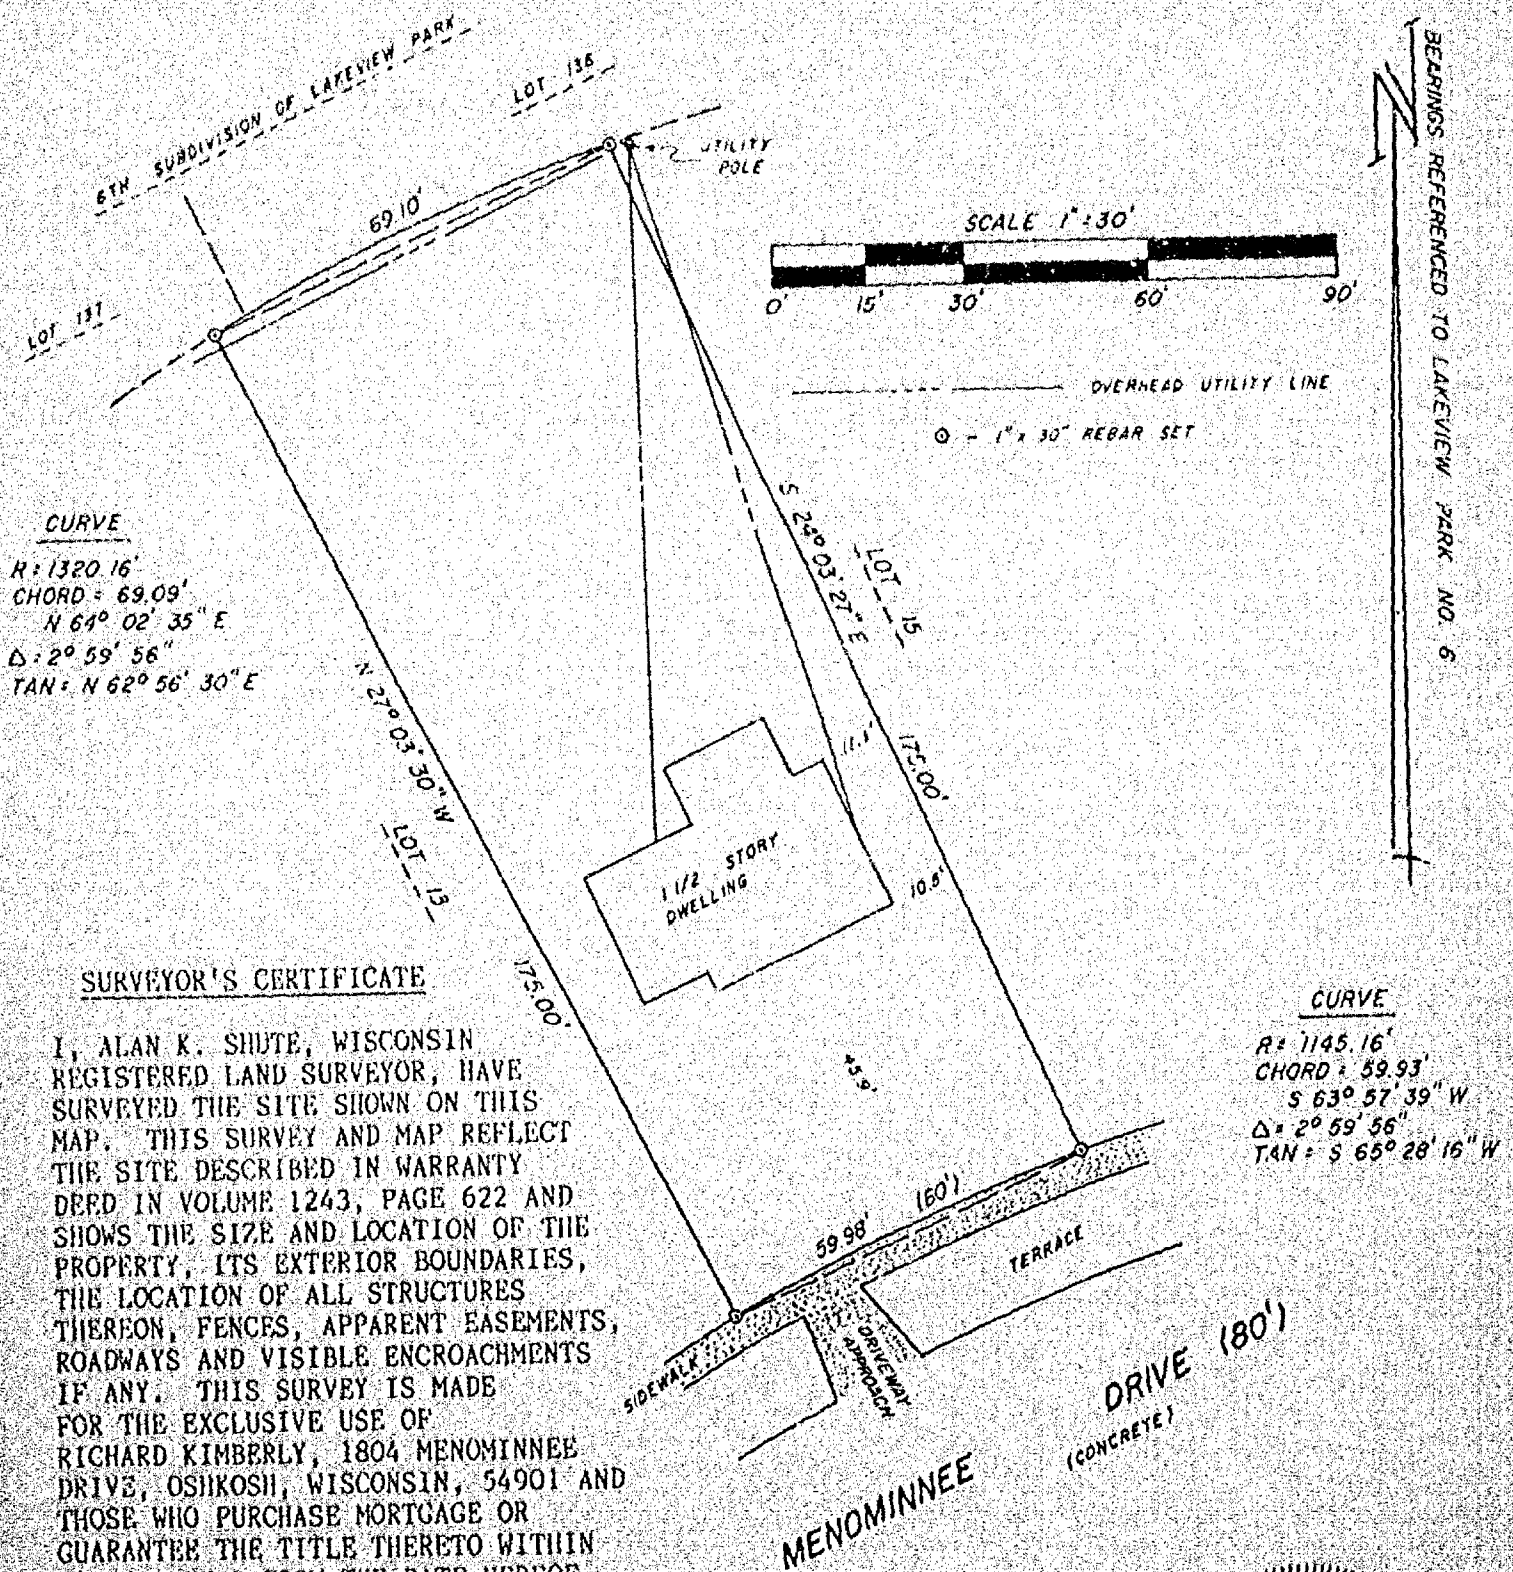

SURVEYOR'S CERTIFICATE

I, ALAN K. SHUTE, WISCONSIN REGISTERED LAND SURVEYOR, HAVE SURVEYED THE SITE SHOWN ON THIS MAP. THIS SURVEY AND MAP REFLECT THE SITE DESCRIBED IN WARRANTY DEED IN VOLUME 1243, PAGE 622 AND SHOWS THE SIZE AND LOCATION OF THE PROPERTY, ITS EXTERIOR BOUNDARIES, THE LOCATION OF ALL STRUCTURES THEREON, FENCES, APPARENT EASEMENTS, ROADWAYS AND VISIBLE ENCROACHMENTS IF ANY. THIS SURVEY IS MADE FOR THE EXCLUSIVE USE OF RICHARD KIMBERLY, 1804 MENOMINNEE DRIVE, OSHKOSH, WISCONSIN, 54901 AND THOSE WHO PURCHASE MORTGAGE OR GUARANTEE THE TITLE THERETO WITHIN ONE (1) YEAR FROM THE DATE HEREOF. TO THEM I CERTIFY THAT THIS SURVEY AND MAP WERE MADE IN ACCORDANCE WITH ACCEPTABLE PROFESSIONAL STANDARDS AND IN MY PROFESSIONAL OPINION THE ACCOMPANYING MAP IS A TRUE AND ACCURATE REPRESENTATION OF THIS SITE TO THE BEST OF MY KNOWLEDGE, INFORMATION AND BELIEF.

Alan K. Shute
 ALAN K. SHUTE R.L.S.-1518

DATED THIS 26th DAY OF MAY, 1983
 REVISED THIS 20th DAY OF JUNE, 1983




Winnebago Land Surveying

311 Baldwin Avenue, Oshkosh, Wisconsin 54901
Phone (414) 426-4951

MAP OF SURVEY

LOT 16, BLOCK 83, ORIGINAL 3RD WARD, NOW 9TH WARD,
CITY OF OSHKOSH, WINNEBAGO COUNTY, WISCONSIN

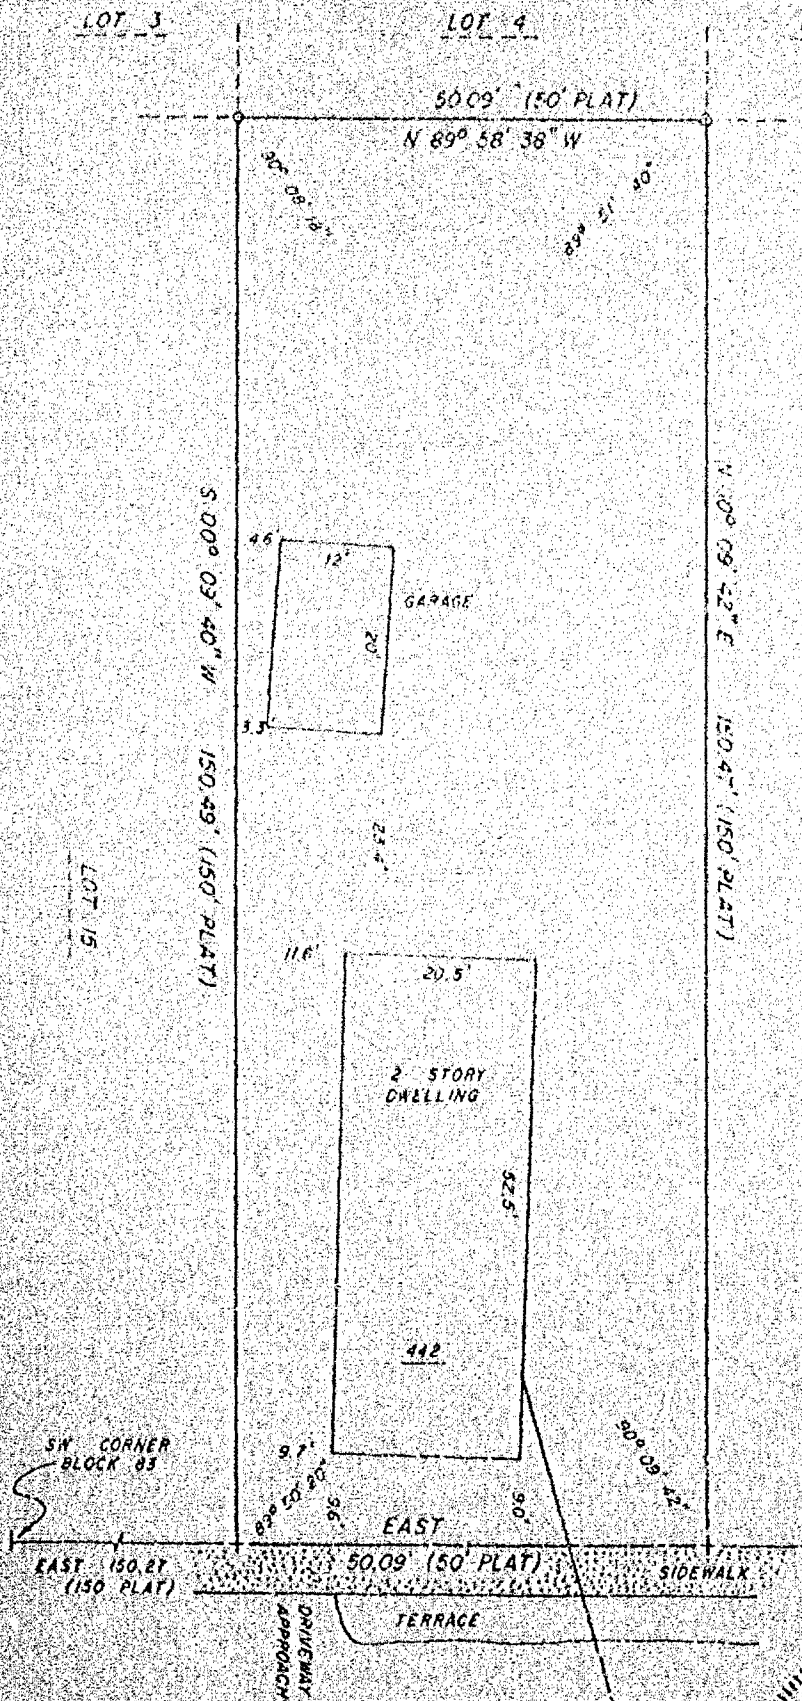


LEGEND

- o 1" x 30" REBAR SET
- + CHISELED CROSS SET
- OVERHEAD UTILITY LINE
- o 2" IRON PIPE WITH 1" IRON PIPE INSIDE FOUND 05' N, 15' E OF TRUE

SURVEYOR'S CERTIFICATE

I, ALAN K. SHUTE, WISCONSIN REGISTERED LAND SURVEYOR HAVE SURVEYED THE SITE SHOWN ON THIS MAP. THIS SURVEY AND MAP REFLECT THE SITE DESCRIBED IN VOLUME 889, PAGE 117 OF WARRANTY DEEDS AND SHOWS THE SIZE AND LOCATION OF THE PROPERTY, ITS EXTERIOR BOUNDARIES, THE LOCATION AND SIZE OF ALL STRUCTURES THEREON, FENCES, ROADWAYS, APPARENT EASEMENTS AND VISIBLE ENCROACHMENTS IF ANY. THIS SURVEY IS MADE FOR THE EXCLUSIVE USE OF ROBERT SCHMIDT, 442 WEST 10TH AVENUE, OSHKOSH, WISCONSIN, 54901 AND THOSE WHO PURCHASE, MORTGAGE OR GUARANTEE THE TITLE THERETO WITHIN ONE (1) YEAR FROM THE DATE HEREOF. TO THEM I CERTIFY THAT THIS SURVEY AND MAP WERE MADE IN ACCORDANCE WITH ACCEPTABLE PROFESSIONAL STANDARDS AND IN MY PROFESSIONAL OPINION THE ACCOMPANYING MAP IS A TRUE AND ACCURATE REPRESENTATION OF THIS SITE TO THE BEST OF MY KNOWLEDGE, INFORMATION AND BELIEF.

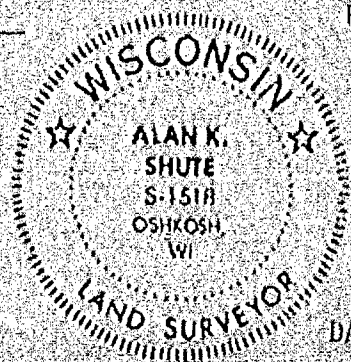

Alan K. Shute
ALAN K. SHUTE S-1518
DATED THIS 2nd OF JUNE, 1983

WEST 10TH AVENUE (60')
(BITUMINOUS)


SCALE 1"=20'



Winnebago Land Surveying
511 Baldwin Avenue, Oshkosh, Wisconsin 54901
Phone (414) 426-4951

MAP OF SURVEY

LOT 19 AND EAST 1/2 LOT 20, BLOCK 6, G. F. WRIGHT'S ADDITION,
5TH WARD, CITY OF OSHKOSH, WINNEBAGO COUNTY, WISCONSIN

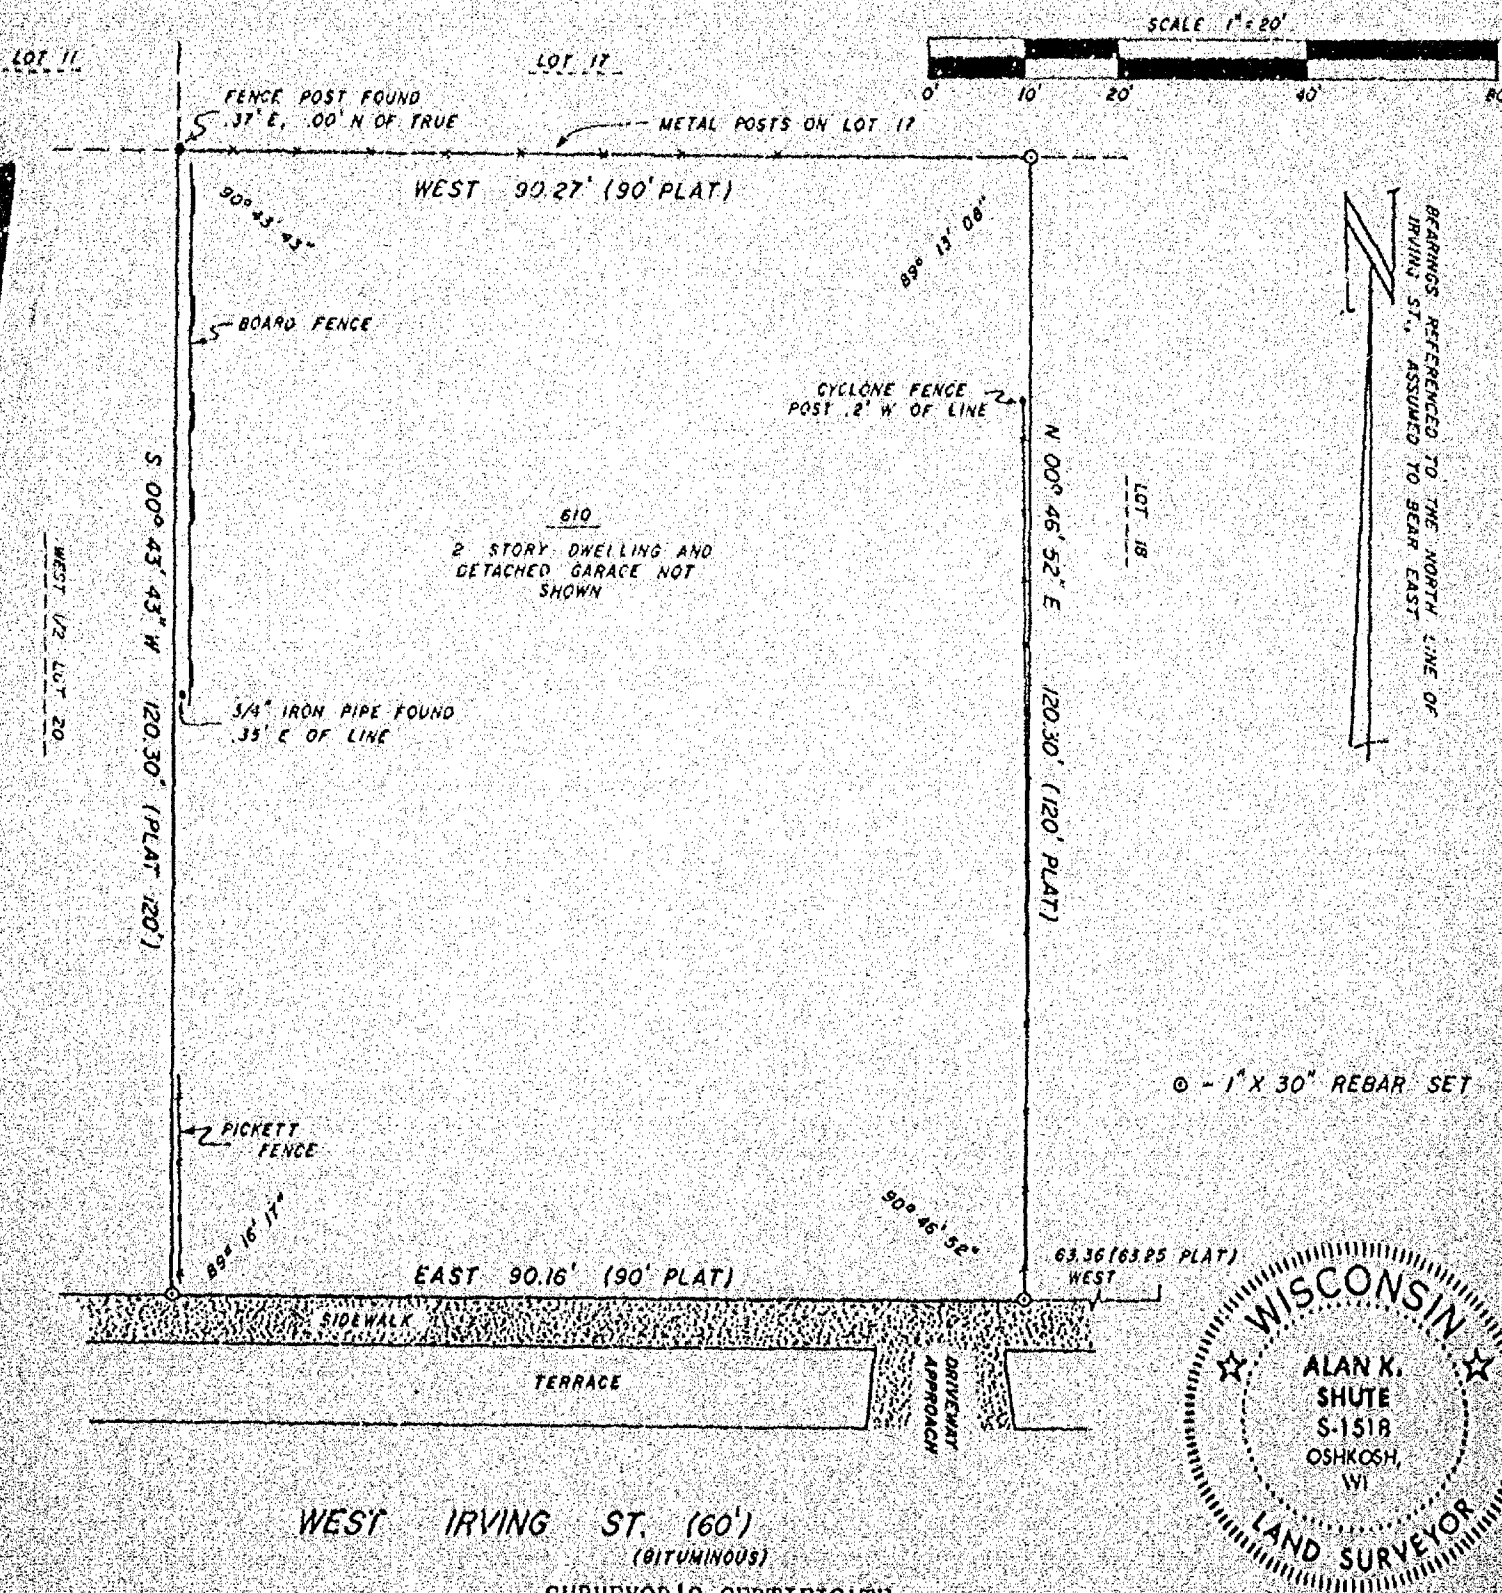

SURVEYOR'S CERTIFICATE

I, ALAN K. SHUTE, WISCONSIN REGISTERED LAND SURVEYOR, HAVE SURVEYED THE SITE SHOWN ON THIS MAP. THIS SURVEY AND MAP REFLECT THE SITE DESCRIBED IN WARRANTY DEED #591071 AND SHOWS THE SIZE AND LOCATION OF THE PROPERTY, ITS EXTERIOR BOUNDARIES, FENCES, APPARENT EASEMENTS, ROADWAYS AND VISIBLE ENCROACHMENTS IF ANY. THIS SURVEY IS MADE FOR THE EXCLUSIVE USE OF RONALD HANSCH, 52 EVELINE, OSHKOSH, WISCONSIN, 54901 AND THOSE WHO PURCHASE, MORTGAGE OR GUARANTEE THE TITLE THERETO WITHIN ONE (1) YEAR FROM THE DATE HEREOF. TO THEM I CERTIFY THAT THIS SURVEY AND MAP WERE MADE IN ACCORDANCE WITH ACCEPTABLE PROFESSIONAL STANDARDS AND IN MY PROFESSIONAL OPINION THE ACCOMPANYING MAP IS A TRUE AND ACCURATE REPRESENTATION OF THIS SITE TO THE BEST OF MY KNOWLEDGE, INFORMATION AND BELIEF.

DATED THIS 6th DAY OF JUNE, 1983.

Alan K. Shute

JOB NO. 19-1054-83

FIELDBOOK 102, PAGES 23, 24



RON HANSCH
52 EVELINE
OSHKOSH, WISCONSIN 54901

PAGE 1 OF 1

DRAWN BY ALAN K. SHUTE

Winnebago Surveying
 511 Baldwin Avenue, Oshkosh, Wisconsin 54901
 Phone (414) 426-4951

MAP OF SURVEY PART OF LOTS 1, 2, 19, 20, BLOCK J, WESTERN ADDITION, 1ST WARD, CITY OF OSHKOSH, WINNEBAGO COUNTY, WISCONSIN

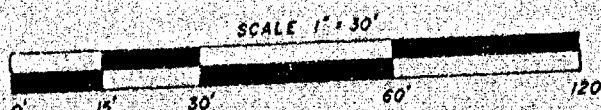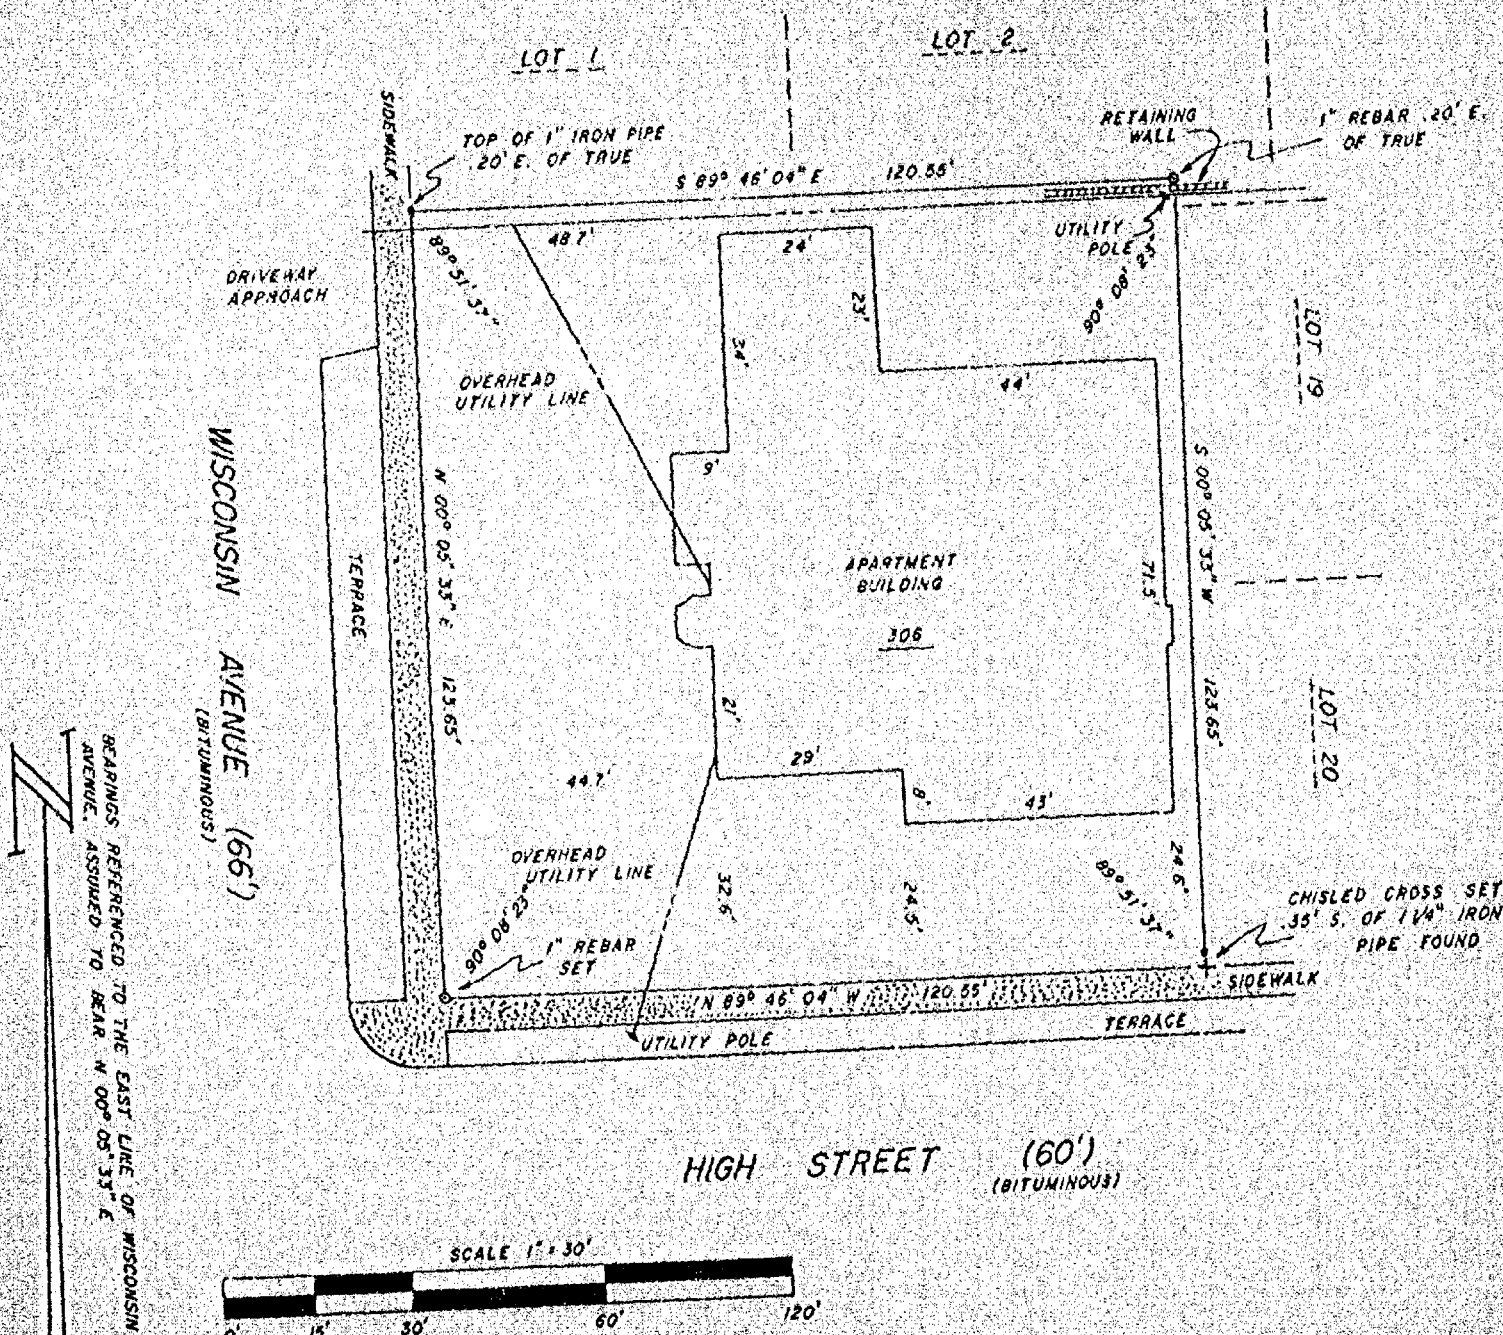

SURVEYOR'S CERTIFICATE

I, ALAN K. SHUTE, WISCONSIN REGISTERED LAND SURVEYOR, HAVE SURVEYED THE SITE SHOWN ON THIS MAP. THIS SURVEY AND MAP REFLECT THE SITE DESCRIBED IN WARRANTY DEED #553912 AND SHOWS THE SIZE AND LOCATION OF THE PROPERTY, ITS EXTERIOR BOUNDARIES, THE SIZE AND LOCATION OF ALL STRUCTURES THEREON, FENCES, APPARENT EASEMENTS, ROADWAYS AND VISIBLE ENCROACHMENTS IF ANY. THIS SURVEY IS MADE FOR THE EXCLUSIVE USE OF CENTURY APARTMENT GROUP, OSHKOSH, WISCONSIN, 54901 AND THOSE WHO PURCHASE, MORTGAGE OR GUARANTEE THE TITLE THERETO WITHIN ONE (1) YEAR FROM THE DATE HEREOF. TO THEM I CERTIFY THAT THIS SURVEY AND MAP WERE MADE IN ACCORDANCE WITH ACCEPTABLE PROFESSIONAL STANDARDS AND IN MY PROFESSIONAL OPINION THE ACCOMPANYING MAP IS A TRUE AND ACCURATE REPRESENTATION OF THIS SITE TO THE BEST OF MY KNOWLEDGE, INFORMATION AND BELIEF.



Alan K. Shute
 ALAN K. SHUTE S-1518
 DATED THIS 21st DAY OF JUNE, 1983



Winnipeg Surveying

511 Baldwin Avenue, Oshkosh, Wisconsin 54901
Phone (414) 426-4951

MAP OF SURVEY

PART OF LOTS 165, 166 AND 168, E. M. CRANE'S ADDITION TO
ALGOMA PARK, 12TH WARD, CITY OF OSHKOSH, WINNEBAGO
COUNTY, WISCONSIN

LINWOOD AVENUE (50')
(BITUMINOUS)

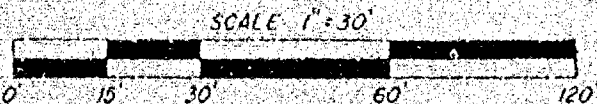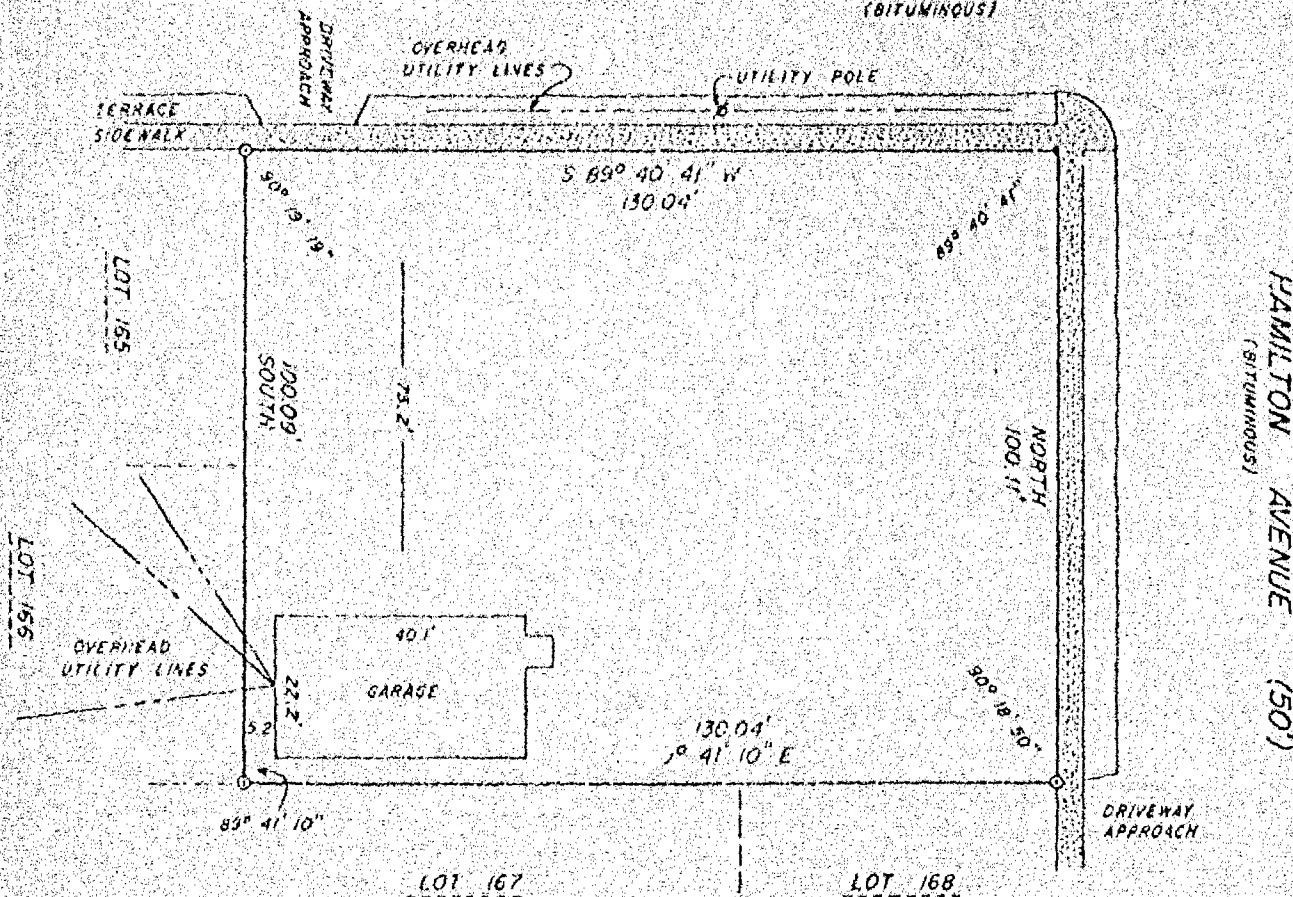

LEGEND


- ⊙ - 1" X 30" REBAR SET
- - 1" IRON PIPE FOUND

SURVEYOR'S CERTIFICATE

I, ALAN K. SHUTE, WISCONSIN REGISTERED LAND SURVEYOR, HAVE SURVEYED THE SITE SHOWN ON THIS MAP. THIS SURVEY AND MAP SHOWS THE SIZE AND LOCATION OF THE PROPERTY, ITS EXTERIOR BOUNDARIES, THE SIZE AND LOCATION OF ALL STRUCTURES THEREON, FENCES, APPARENT EASEMENTS, ROADWAYS AND VISIBLE ENCROACHMENTS IF ANY. THIS SURVEY IS MADE FOR THE EXCLUSIVE USE OF RUSS YOUNG INC., 2308 JACKSON DRIVE, OSHKOSH, WISCONSIN, 54901 AND THOSE WHO PURCHASE, MORTGAGE OR GUARANTEE THE TITLE THERETO WITHIN ONE (1) YEAR FROM THE DATE HEREOF. TO THEM I CERTIFY THAT THIS SURVEY AND MAP WERE MADE IN ACCORDANCE WITH ACCEPTABLE PROFESSIONAL STANDARDS AND IN MY PROFESSIONAL OPINION THE ACCOMPANYING MAP IS A TRUE AND ACCURATE REPRESENTATION OF THIS SITE TO THE BEST OF MY KNOWLEDGE, INFORMATION AND BELIEF.

Alan K. Shute

ALAN K. SHUTE S-1518
DATED THIS 22nd DAY OF JUNE, 1983

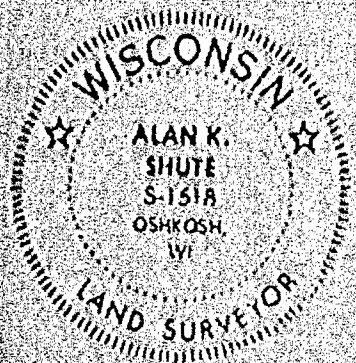


Winnebago Land Surveying

511 Baldwin Avenue, Oshkosh, Wisconsin 54901
Phone (414) 426-4951

MAP OF SURVEY

WEST 40', LOT 11, BLOCK 83, ORIGINAL THIRD WARD, NOW 9TH
WARD, CITY OF OSHKOSH, WINNEBAGO COUNTY, WISCONSIN

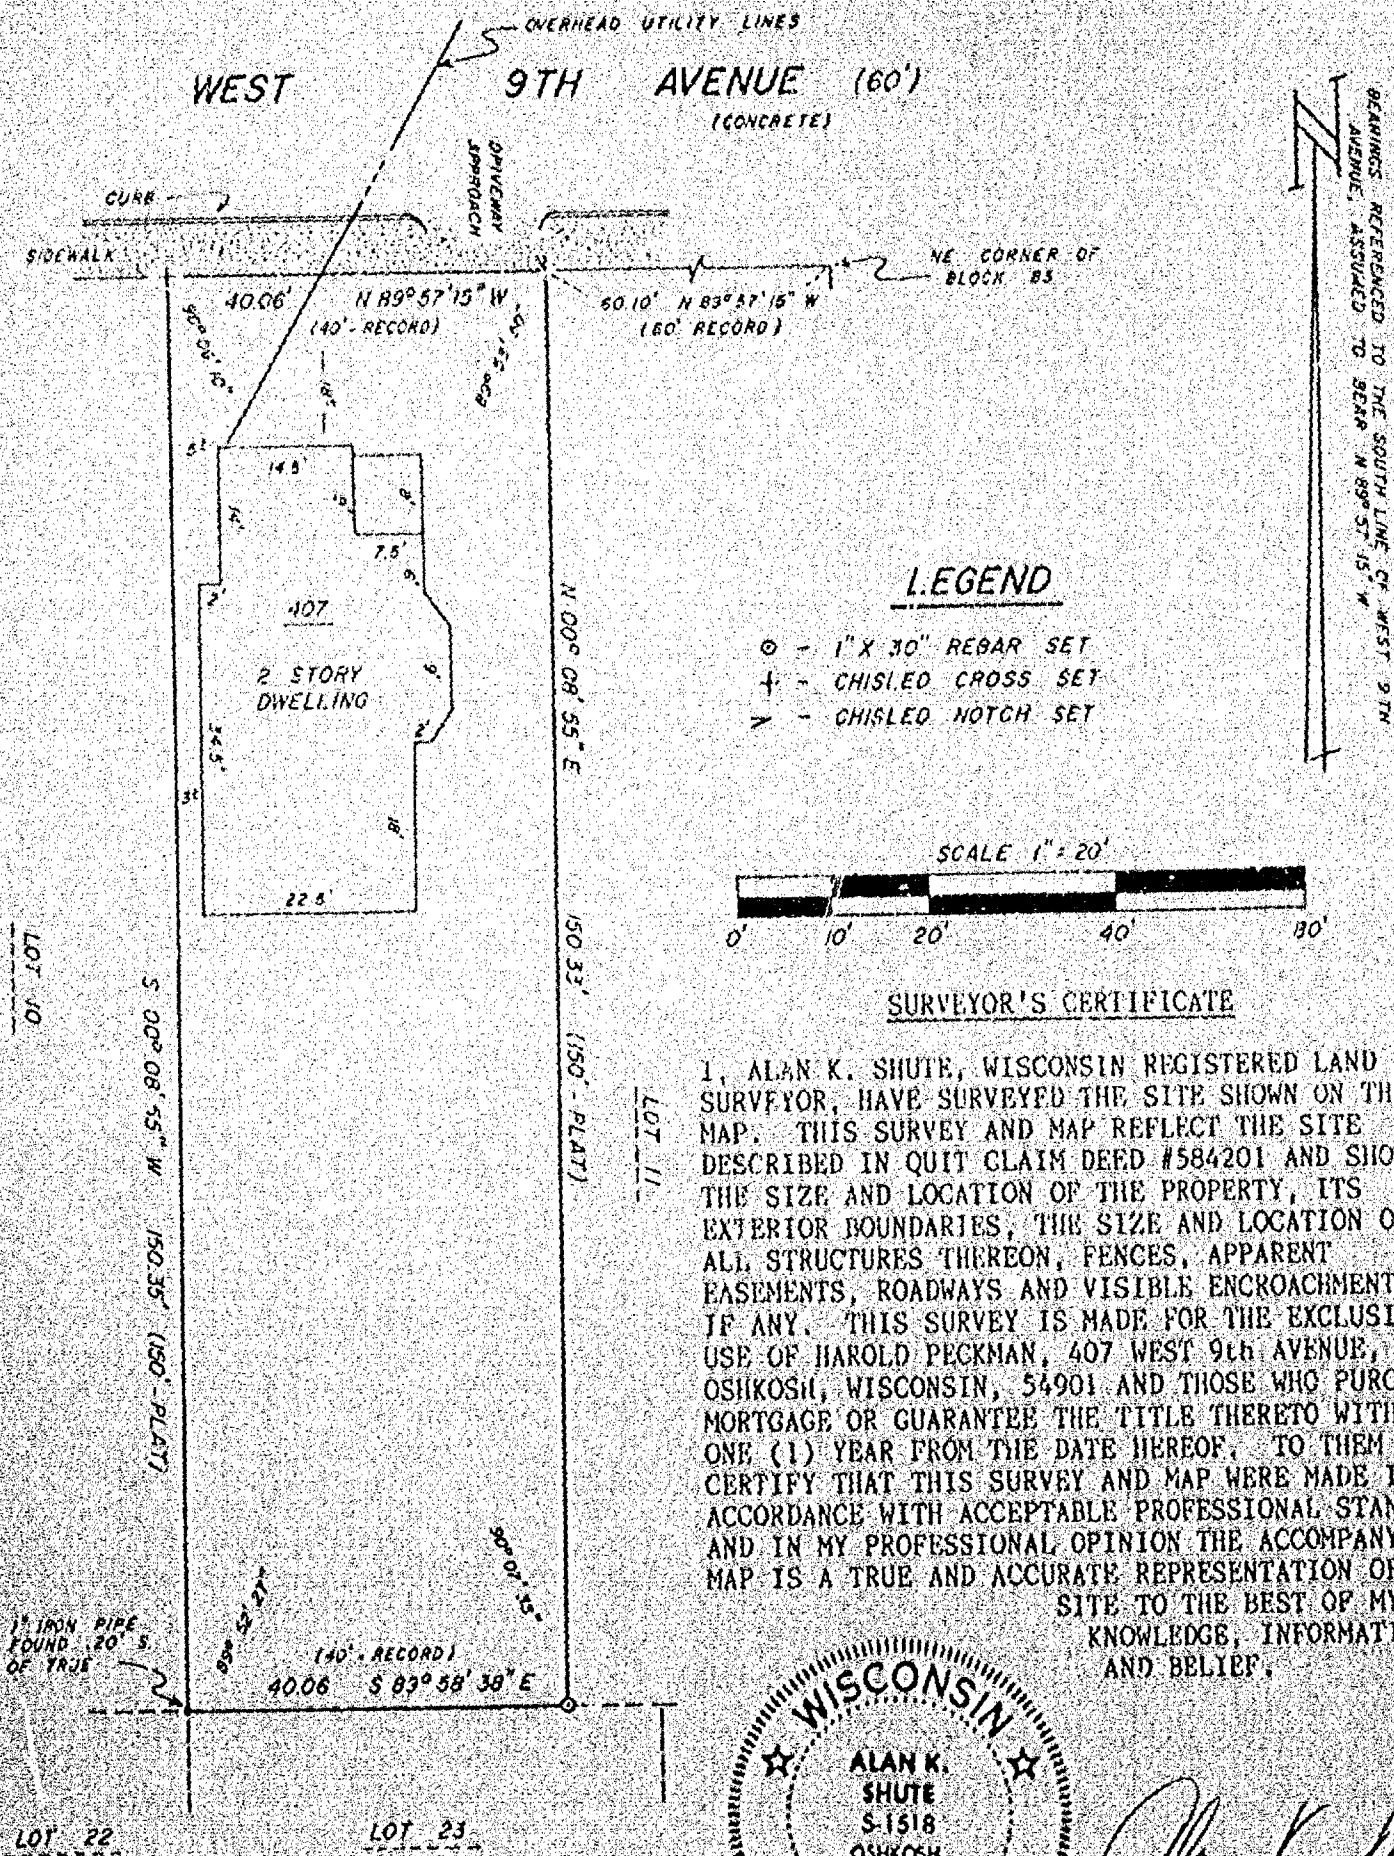

SURVEYOR'S CERTIFICATE

I, ALAN K. SHUTE, WISCONSIN REGISTERED LAND SURVEYOR, HAVE SURVEYED THE SITE SHOWN ON THIS MAP. THIS SURVEY AND MAP REFLECT THE SITE DESCRIBED IN QUIT CLAIM DEED #584201 AND SHOWS THE SIZE AND LOCATION OF THE PROPERTY, ITS EXTERIOR BOUNDARIES, THE SIZE AND LOCATION OF ALL STRUCTURES THEREON, FENCES, APPARENT EASEMENTS, ROADWAYS AND VISIBLE ENCROACHMENTS IF ANY. THIS SURVEY IS MADE FOR THE EXCLUSIVE USE OF HAROLD PECKMAN, 407 WEST 9th AVENUE, OSHKOSH, WISCONSIN, 54901 AND THOSE WHO PURCHASE, MORTGAGE OR GUARANTEE THE TITLE THERETO WITHIN ONE (1) YEAR FROM THE DATE HEREOF. TO THEM I CERTIFY THAT THIS SURVEY AND MAP WERE MADE IN ACCORDANCE WITH ACCEPTABLE PROFESSIONAL STANDARDS AND IN MY PROFESSIONAL OPINION THE ACCOMPANYING MAP IS A TRUE AND ACCURATE REPRESENTATION OF THIS SITE TO THE BEST OF MY KNOWLEDGE, INFORMATION AND BELIEF.



Alan K. Shute
ALAN K. SHUTE S-1518

DATED THIS 29th OF JUNE, 1983

Winnebago Surveying

511 Baldwin Avenue, Oshkosh, Wisconsin 54901
Phone (414) 426-4951

MAP OF SURVEY

LOT 20 AND PART OF LOT 21, CITY'S REPLAT NO. 4, 11TH
WARD, CITY OF OSHKOSH, WINNEBAGO COUNTY, WISCONSIN

KIRBY AND BEGLINGER SUBDIVISION, BLOCK 1

LOT 3

LOT 2

SURVEYOR'S CERTIFICATE


I, ALAN K. SHUTE, WISCONSIN REGISTERED LAND SURVEYOR, HAVE SURVEYED THE SITE SHOWN ON THIS MAP. THIS SURVEY AND MAP REFLECT THE SITE DESCRIBED IN VOLUME 1308, PAGE 46 AND SHOWS THE SIZE AND LOCATION OF THE PROPERTY, ITS EXTERIOR BOUNDARIES, THE SIZE AND LOCATION OF ALL STRUCTURES THEREON, FENCES, APPARENT EASEMENTS, ROADWAYS AND VISIBLE ENCROACHMENTS IF ANY. THIS SURVEY IS MADE FOR THE EXCLUSIVE USE OF LOUIS VOGEL, 835 POWERS STREET, OSHKOSH, WISCONSIN 54901 AND THOSE WHO PURCHASE, MORTGAGE OR GUARANTEE THE TITLE THERETO WITHIN ONE (1) YEAR FROM THE DATE HEREOF. TO THEM I CERTIFY THAT THIS SURVEY AND MAP WERE MADE IN ACCORDANCE WITH ACCEPTABLE PROFESSIONAL STANDARDS AND IN MY PROFESSIONAL OPINION THE ACCOMPANYING MAP IS A TRUE AND ACCURATE REPRESENTATION OF THIS SITE TO THE BEST OF MY KNOWLEDGE, INFORMATION AND BELIEF.

Alan K. Shute

ALAN K. SHUTE

S-1518

DATED THIS 1ST DAY OF JULY, 1983

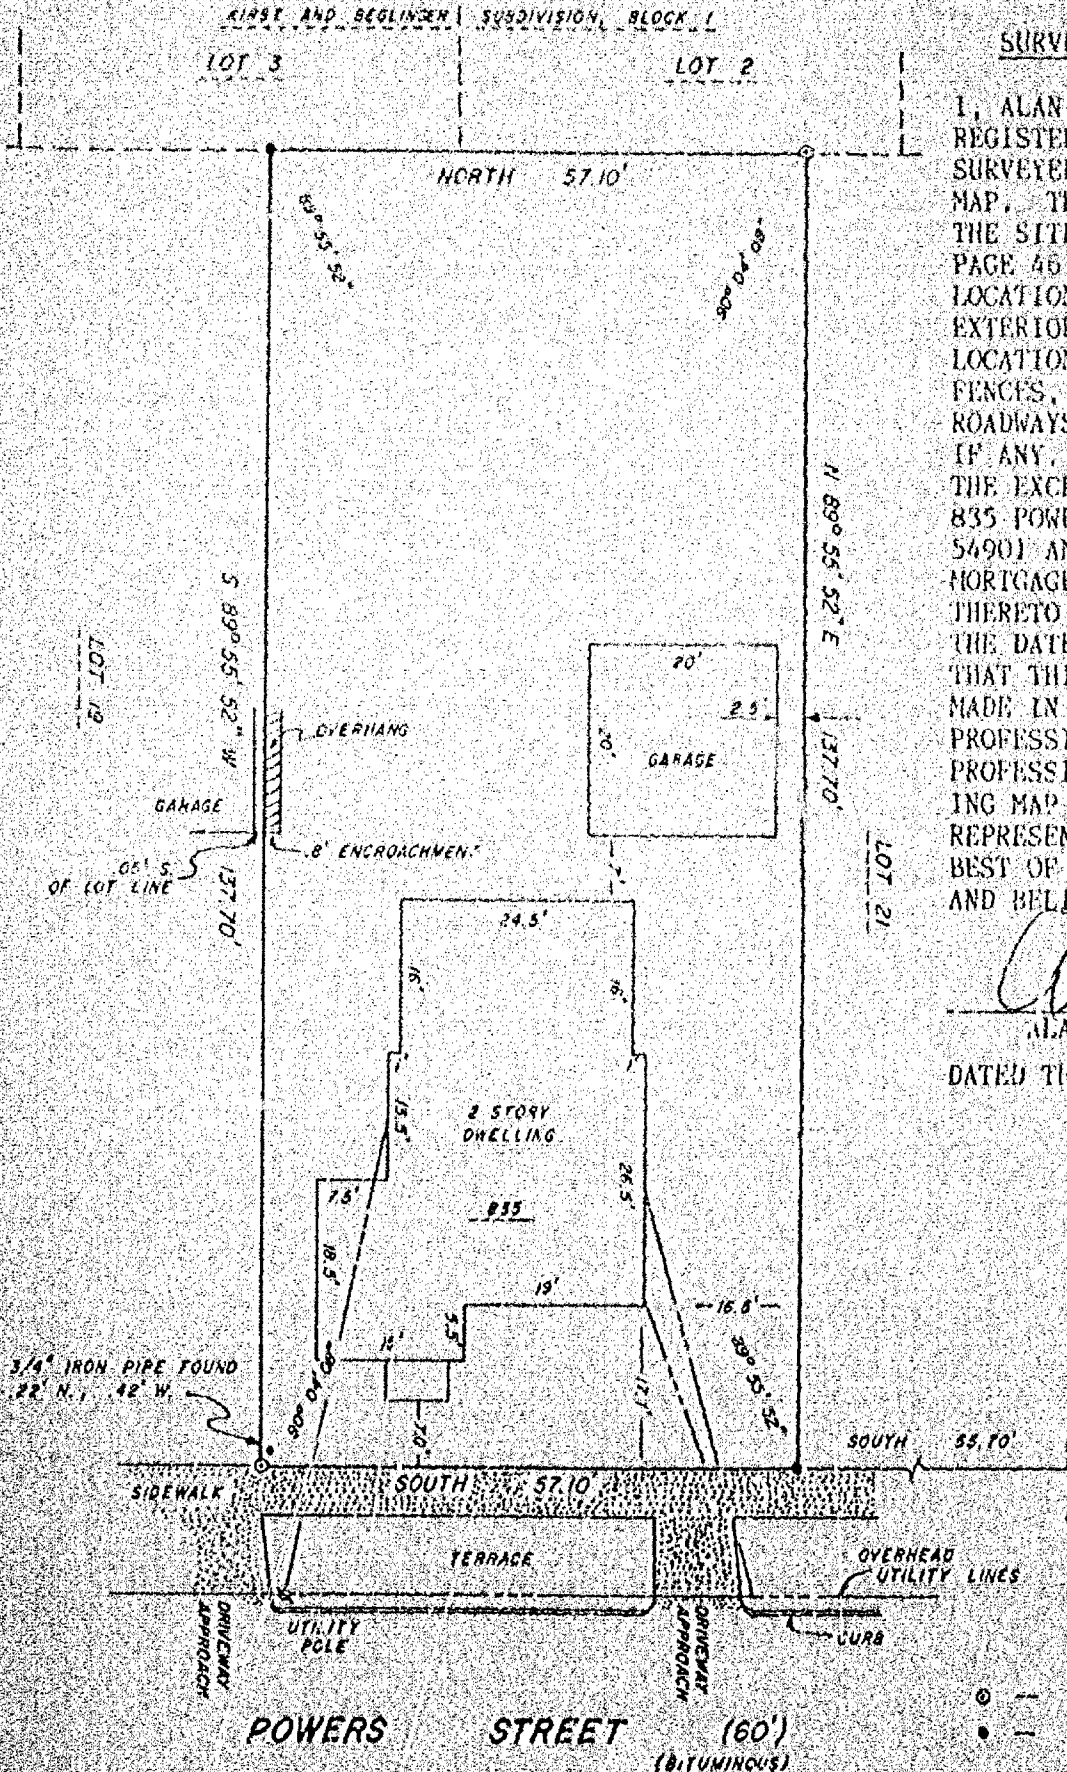

LEGEND


- -- 1" X 30" REBAR SET
- -- 1" IRON PIPE FOUND

BEARINGS REFERENCED TO THE WEST LINE OF POWERS STREET,
ASSUMED TO BEAR NORTH-SOUTH

PLAT OF EASEMENT

for Wisconsin Telephone Company

A part of Lot 478, Third Addition to Westhaven, City of Oshkosh, WI

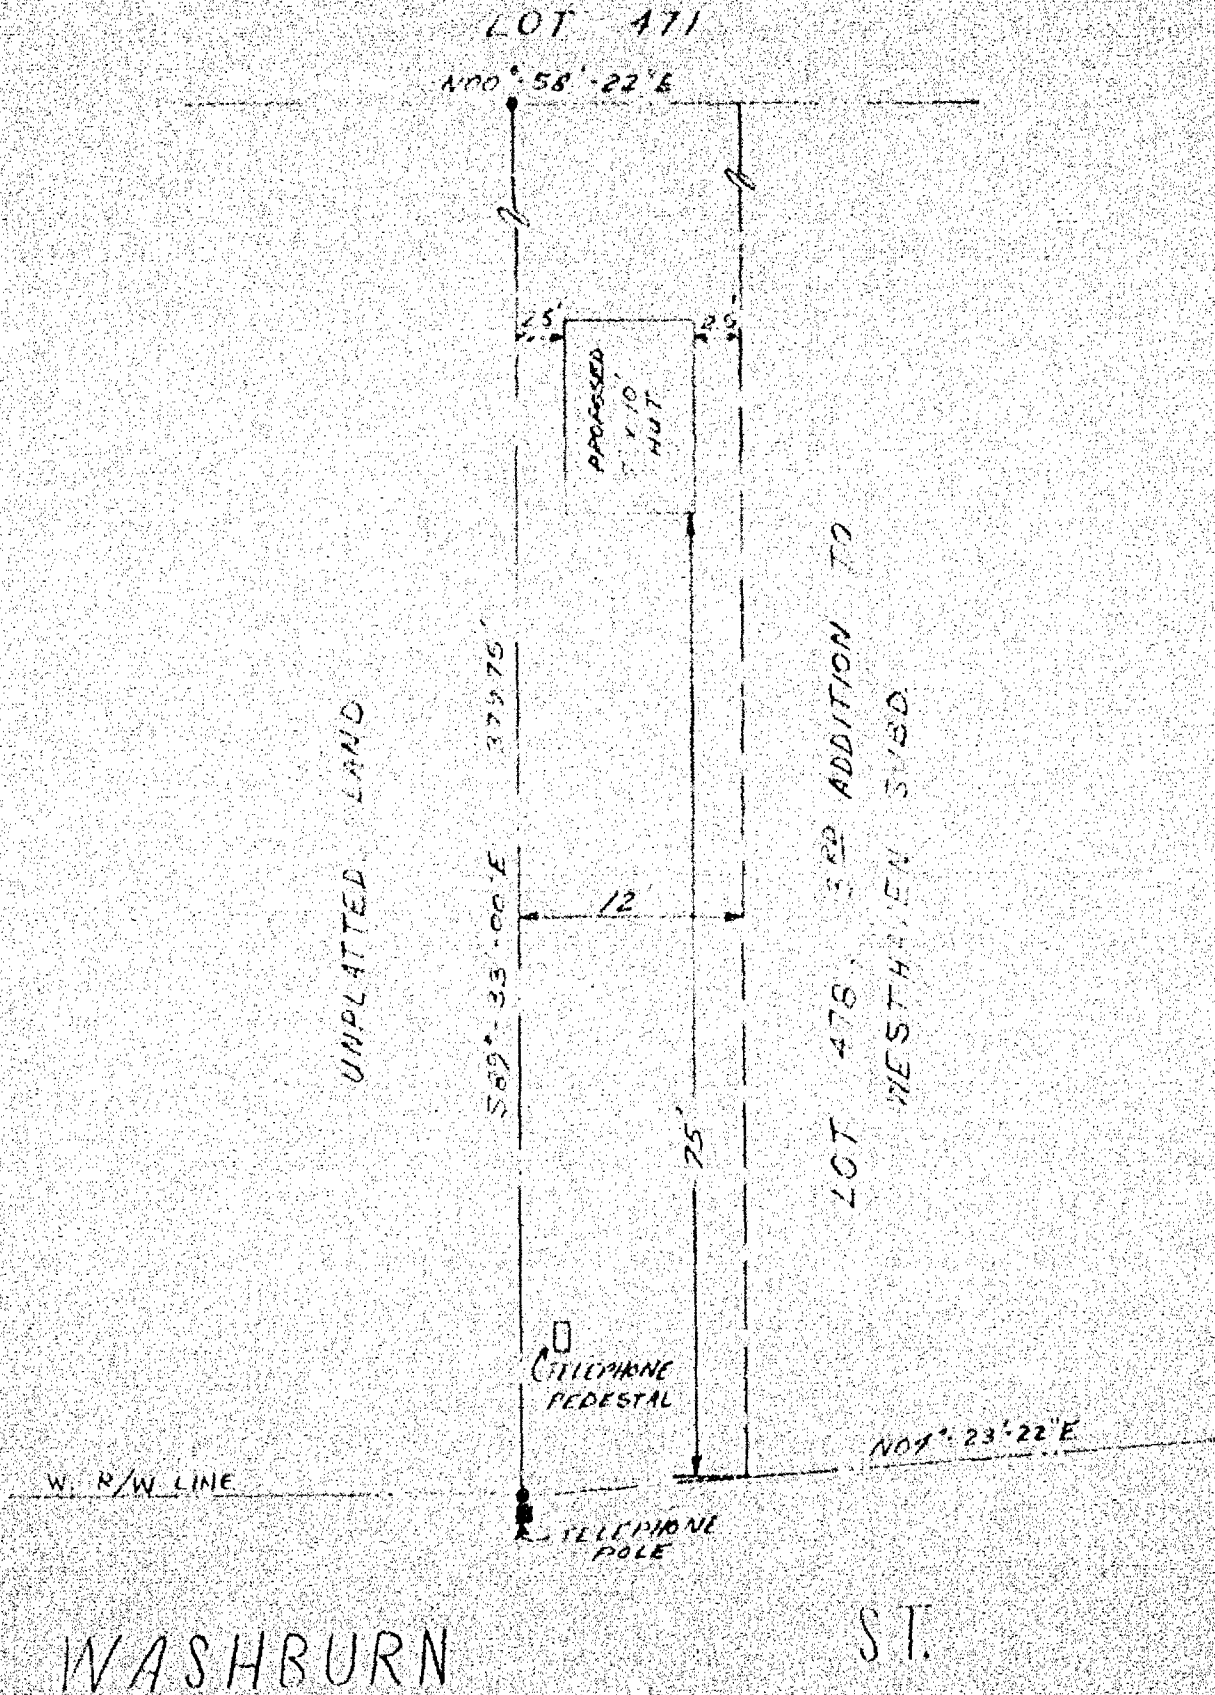


WASHBURN

ST.

I hereby certify that I have surveyed the above described property and that the above map is a true representation thereof and shows the size and location of the property, its exterior boundaries, the location of all visible structures and dimensions of all principal buildings thereon, boundary fences, apparent easements, roadways and visible encroachments, if any.
This survey is made for the use of the present owners of the property, and also those who purchase, mortgage, or guarantee the title thereto within one (1) year from date hereof.

Kenneth R. Wolf
Wis. Registered Land Surveyor S-1121

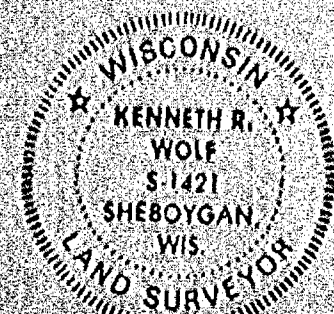

Revised August 28, 1983

T/BN	R/BA
28	

Donohue

Engineers & Architects

Scale	0' 5' 10' 20'
Date	AUG. 4, 1983
Project No.	13,130,136
Drawn by	K. WOLF
File No.	2-9977

PLAT OF SURVEY


KIXKI AS 15 SOUTH AVENUE, BEING PART OF THE N.W. 1/4 OF THE S.W. 1/4 OF SECTION 12, T18N, R16E; THE WEST 70 FT. OF THE EAST 200 FT. OF THE NORTH 150 FT. LYING WEST OF THE WEST LINE OF MAIN STREET AND SOUTH OF THE SOUTH LINE OF SOUTH AVENUE AS LAID OUT IN THE INTERURBAN LAND COMPANY'S THIRD ADDITION TO THE PLAT AS RECORDED IN VOLUME 6 OF PLATS ON PAGE 49, NOW IN THE 15TH WARD, CITY OF OSHKOSH, WINNEBAGO COUNTY, WISCONSIN.

SEPTEMBER 9, 1983

SURVIV FOR OSHKOSH SAVINGS
APPLICANT: JODY TORN
MARRIAGE WAIVER ON FILE

SURVEY NO. 1301-01

WEST SMITH AVENUE (60.0)

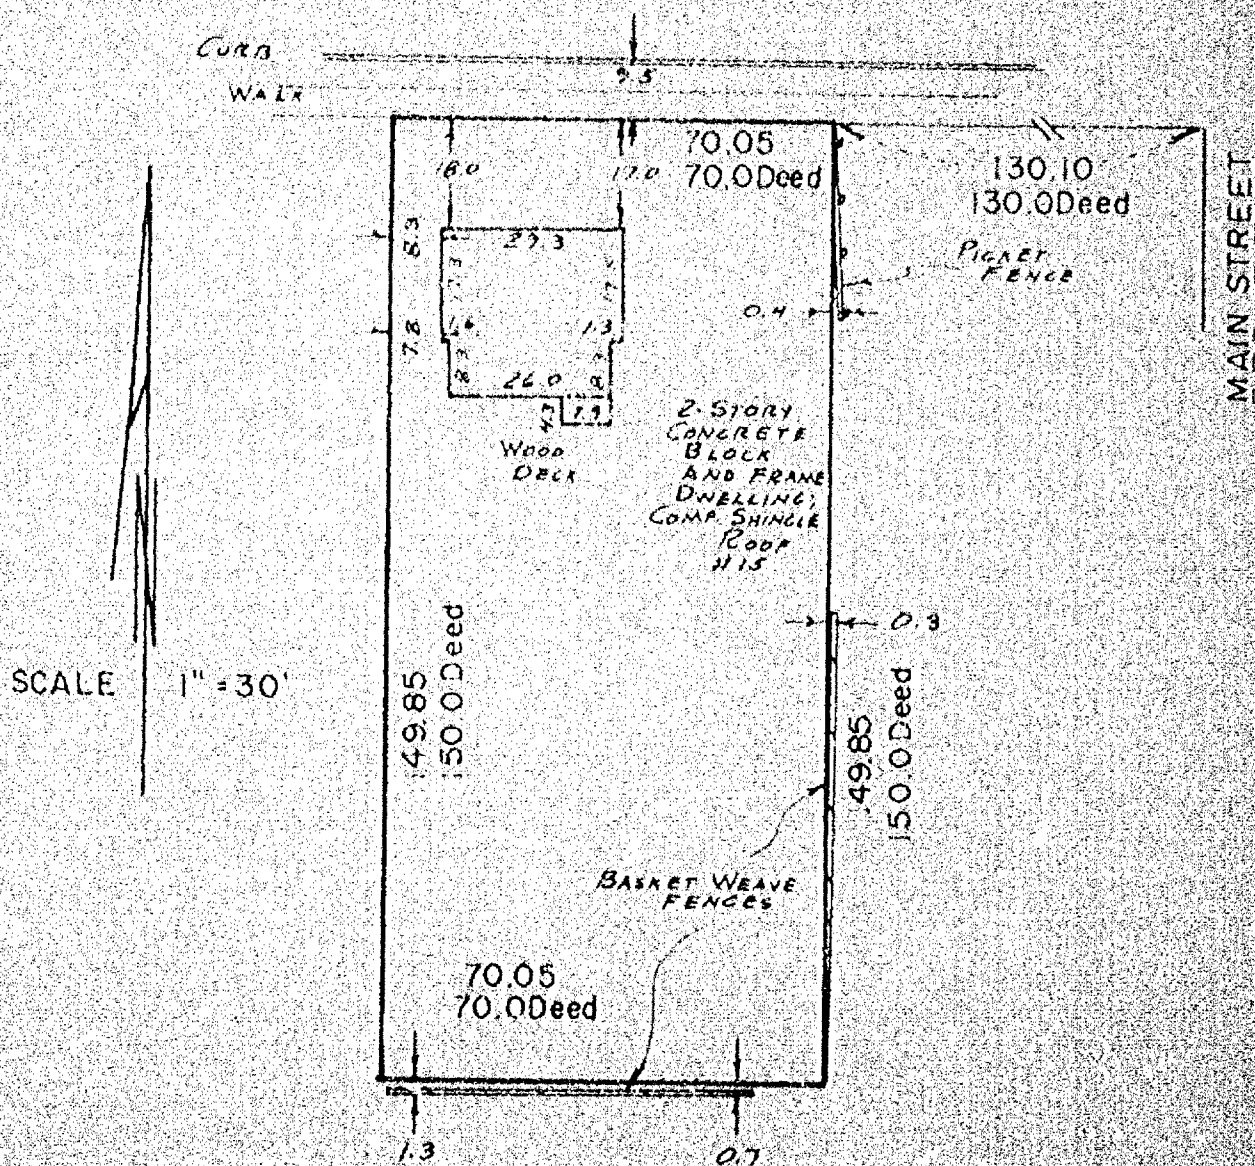

I Certify that I have surveyed the above described property (Property), and the above map is a true representation thereof and shows the size and location of the Property, its exterior boundaries, the location and dimension of all visible structures thereon, boundary, fences, apparent easements and roadways and visible encroachments.

This survey is made for the exclusive use of the present owners of the Property, and also those who purchase, mortgage, or guarantee the title thereto, within one (1) year from date hereof.



national survey & engineering

417 NORTH SAWYER STREET / P.O. BOX 2963
 OSHKOSH, WISCONSIN 54903
 (414) 426-2800




PLAT OF SURVEY

KNOWN AS 729 CENTRAL STREET, BEING THE NORTH 1/2 OF LOT 5 IN BLOCK 73 IN
COTT, READ AND EIGHTH'S ADDITION, IN THE 10th WARD, CITY OF OSHKOSH, PER
LEACH'S MAP OF 1894, WINNEBAGO COUNTY, WISCONSIN.

SEPTEMBER 8, 1983

SURVEY FOR OSHKOSH SAVINGS
(MORTGAGE WAIVER ON FILE)

SURVEY NO. 1300-M

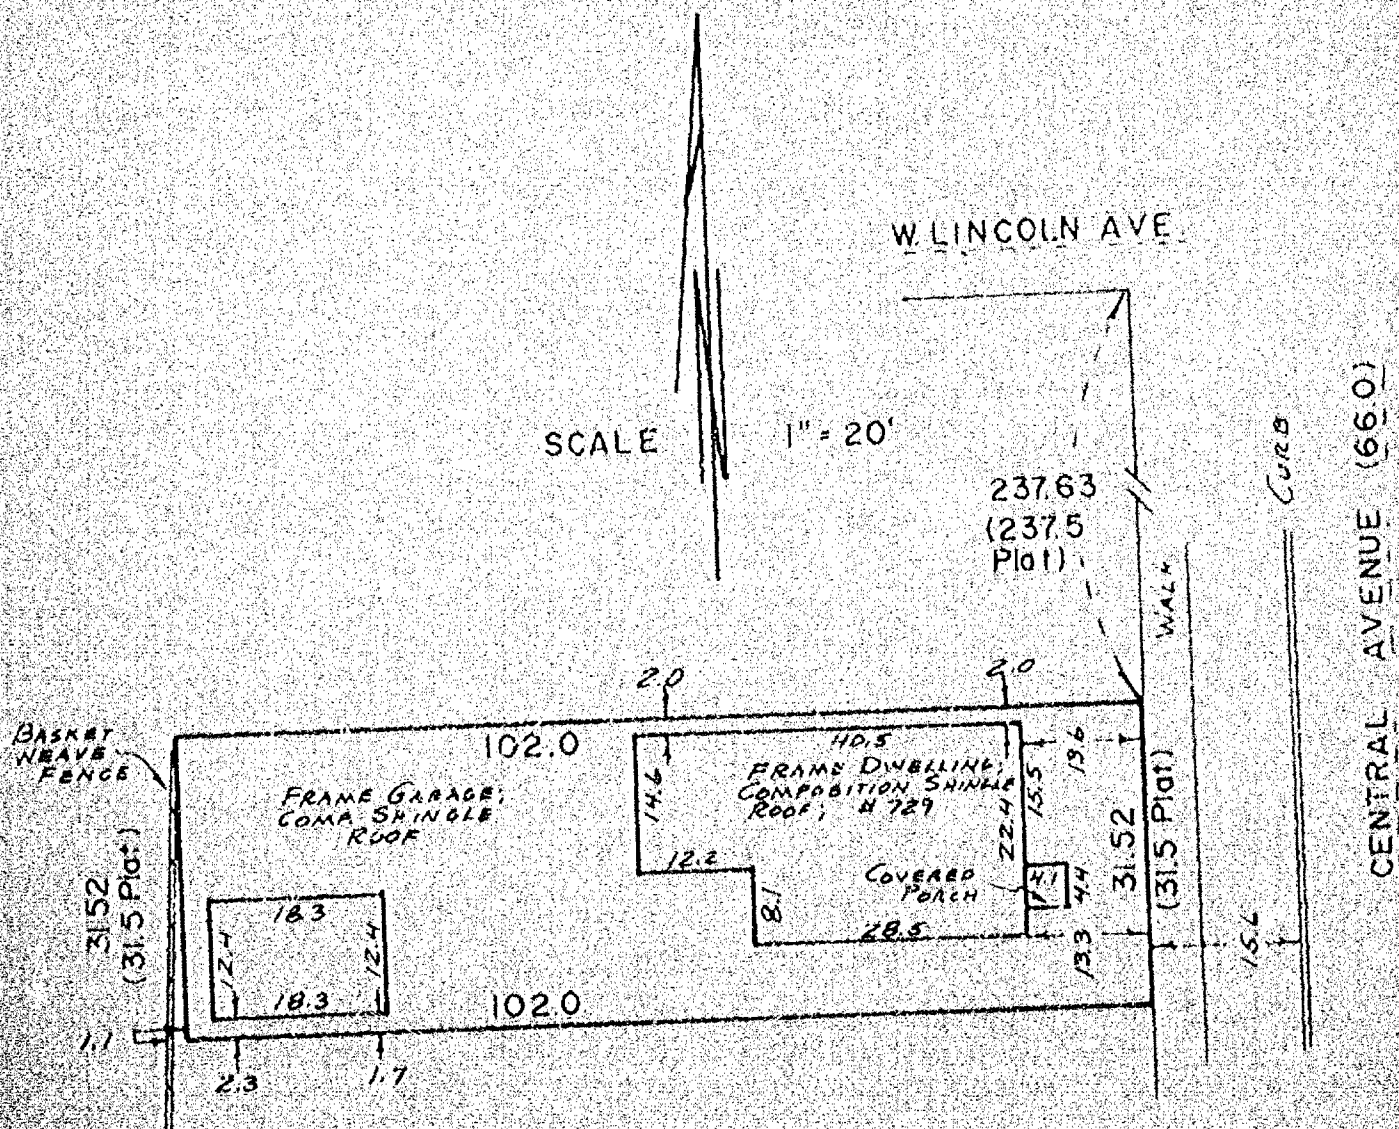

I Certify that I have surveyed the above described property (Property), and the above map is a true representation thereof and shows the size and location of the Property, its exterior boundaries, the location and dimensions of all visible structures thereon, boundary, fences, apparent easements and roadways and visible encroachments, if any. This survey is made for the exclusive use of the present owners of the Property, and also those who purchase, mortgage, or guarantee the title thereto, within one (1) year from date hereof.



national survey & engineering

417 NORTH SAWYER STREET / P.O. BOX 2963
OSHKOSH, WISCONSIN 54903
(414) 426-2800



PLAT OF SURVEY


KNOWN AS 934 WEST 9th AVENUE, BEING LOT 23 OF BLOCK 3 IN ANNA M. LULL'S
2nd ADDITION TO THE CITY OF OSHKOSH, IN THE 6th WARD, CITY OF OSHKOSH,
WINNEBAGO COUNTY, WISCONSIN.

AUGUST 30, 1983

SURVEY FOR OSHKOSH SAVINGS
APPLICANT: GARY KILGAS
MONUMENT WAIVER ON FILE

SURVEY NO. 1298-1

KNAPP STREET

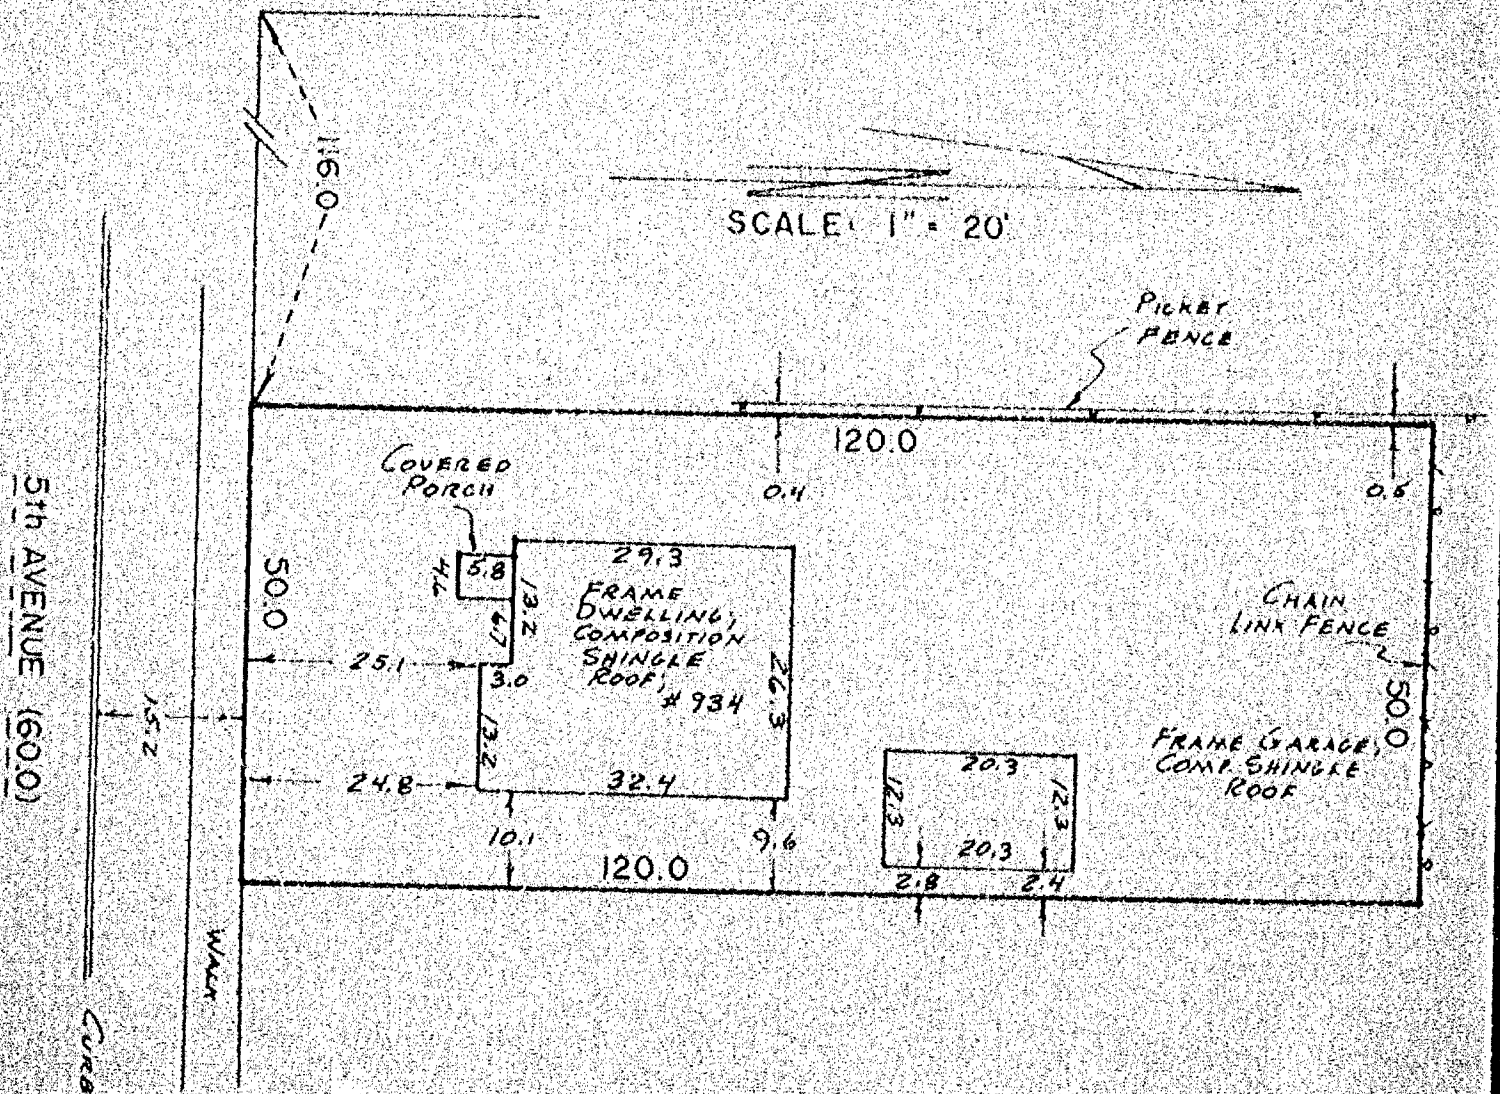

I Certify that I have surveyed the above described property (Property), and the above map is a true representation thereof and shows the size and location of the Property, its exterior boundaries, the location and dimensions of all visible structures thereon, boundary, fences, apparent easements and roadways and visible encroachments, if any.

This survey is made for the exclusive use of the present owners of the Property, and also those who purchase, mortgage, or guarantee the title thereto, within one (1) year from date hereof.



national survey & engineering

417 NORTH SAWYER STREET / P.O. BOX 2963
OSHKOSH, WISCONSIN 54903

1414 426-2800




PLAT OF SURVEY

BEING AS 334-336 WOODLAND AVENUE, BEING LOT 172 AND THE WEST 10.0 FT. OF LOT 171
IN CITY'S REPLAT 11, IN THE 5th WARD, CITY OF OSHKOSH, WINNEBAGO COUNTY, WISCONSIN.


AUGUST 31, 1983

SURVEY FOR OSHKOSH SAVINGS
APPLICANT: JAMES ZIEGLERBERGER
FORFEIT WAIVER ON FILE

SURVEY NO. 1299-M

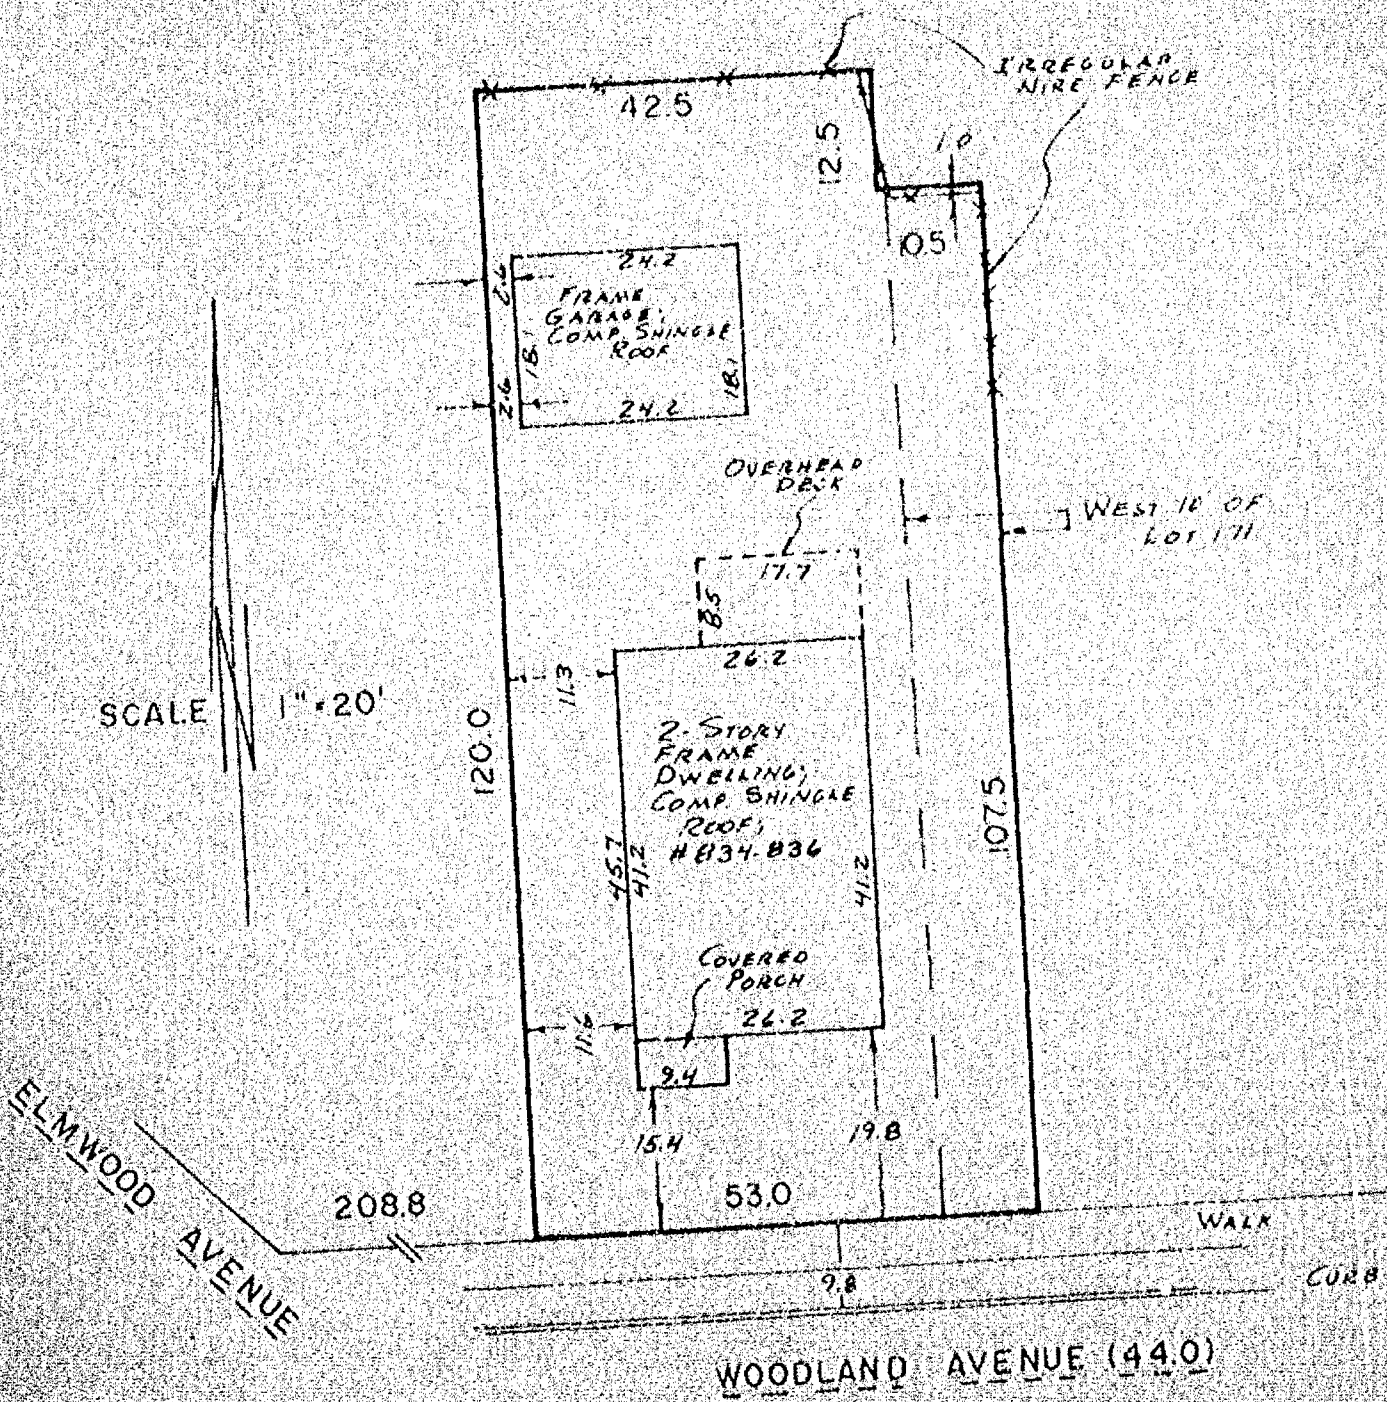

I Certify that I have surveyed the above described property (Property), and the above map is a true representation thereof and shows the size and location of the Property, its exterior boundaries, the location and dimensions of all visible structures thereon, boundary, fences, apparent easements and roadways and visible encroachments, if any. This survey is made for the exclusive use of the present owners of the Property, and also those who purchase, mortgage, or guarantee the title thereto, within one (1) year from date hereof.

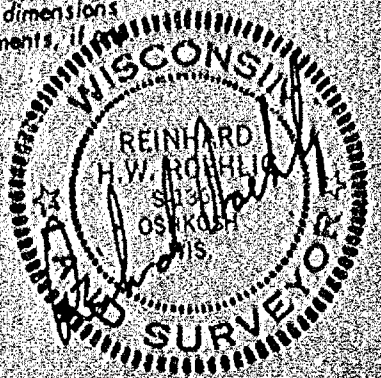

national survey & engineering
417 NORTH SAWYER STREET / P.O. BOX 2963
OSHKOSH, WISCONSIN 54903
(414) 426-2800


PLAT OF SURVEY

KNOWN AS 2250 CRANE STREET, BEING THAT PART OF LOTS 2 AND 3 OF E.M. CRANE'S ADDITION TO AUXIA WHICH IS BOUND AND DESCRIBED AS FOLLOWS: COMMENCING AT THE N.W. CORNER OF LOT 1 OF SAID SUBDIVISION, THENCE SOUTH 00-24-49 WEST 65.00 FT. TO THE POINT OF BEGINNING, THENCE CONTINUING SOUTH 00-24-49 WEST 65.00 FT. TO A POINT, THENCE SOUTH 89-56-09 EAST 171.00 FT. TO A POINT, THENCE NORTH 00-24-49 EAST 65.00 FT. TO A POINT, THENCE NORTH 89-56-09 WEST 171.00 FT. TO THE POINT OF BEGINNING.

AUGUST 30, 1983

SURVEY FOR OSHKOSH SAVINGS
APPLICANT: RONNY LARSON

SURVEY NO. 1295-4

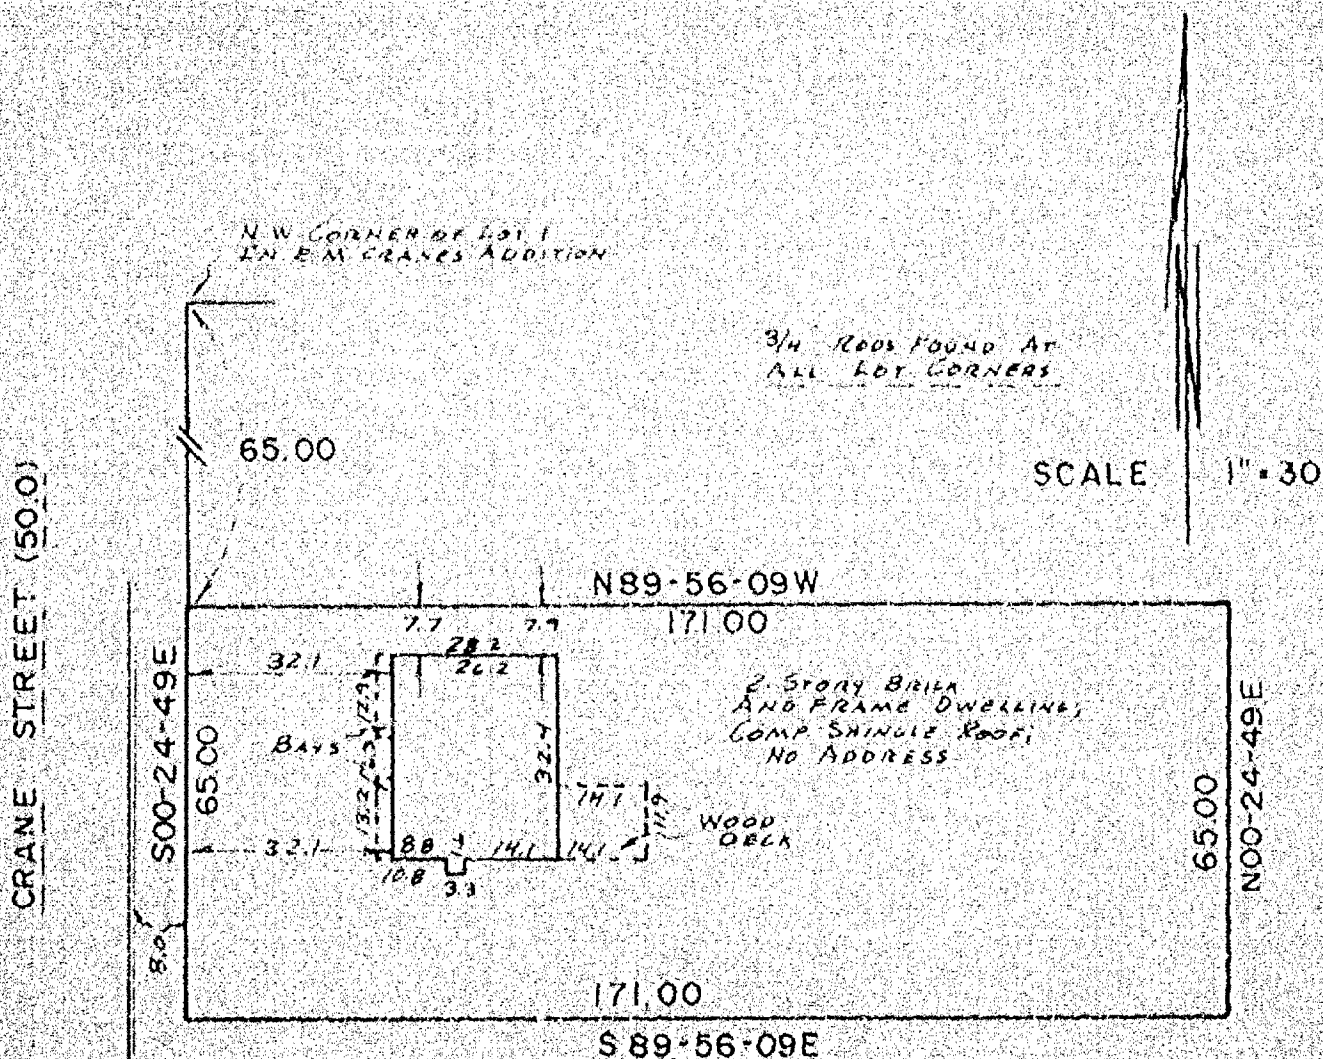


I Certify that I have surveyed the above described property (Property), and the above map is a true representation thereof and shows the size and location of the Property, its exterior boundaries, the location and dimensions of all visible structures thereon, boundary, fences, apparent easements and roadways and visible encroachments, if any. This survey is made for the exclusive use of the present owners of the Property, and also those who purchase, mortgage, or guarantee the title thereto, within one (1) year from date hereof.



national survey & engineering

417 NORTH SAWYER STREET / PO. BOX 2063
OSHKOSH, WISCONSIN 54903
(414) 426-2800

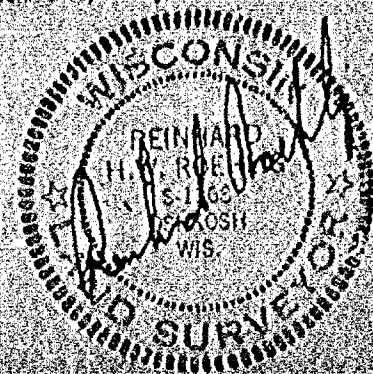


PLAT OF SURVEY

KNOWN AS 1300 MARICOPA DRIVE, BEING LOT 32 IN THE PLAT OF WESTHAVEN, 13TH WARD,
CITY OF OSHKOSH, WINNEBAGO COUNTY, WISCONSIN.

SURVEY NO. 1279-M

AUGUST 4, 1983

SURVEY FOR OSHKOSH SAVINGS
APPLICANT: BLAINE FELSMAN
(CONSENT WAIVER ON FILE)

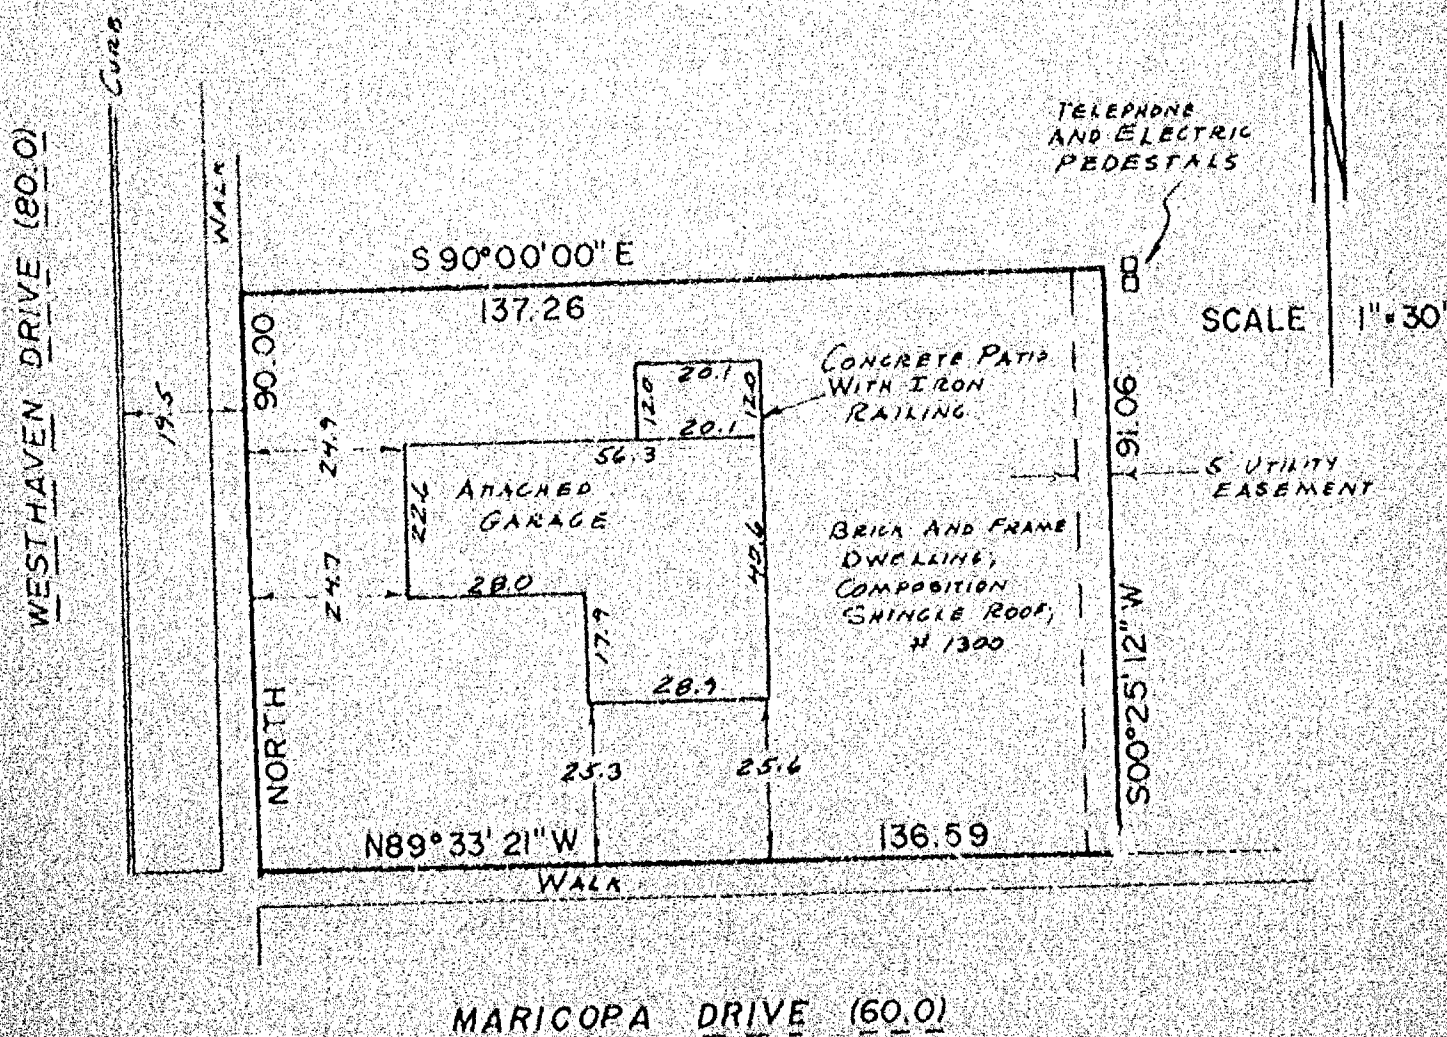

I Certify that I have surveyed the above described property (Property), and the above map is a true representation thereof and shows the size and location of the Property, its exterior boundaries, the location and dimensions of all visible structures thereon, boundary, fences, apparent easements and roadways and visible encroachments, if any. This survey is made for the exclusive use of the present owners of the Property, and also those who purchase, mortgage, or guarantee the title thereto, within one (1) year from date hereof.



national survey & engineering
417 NORTH SAWYER STREET / P.O. BOX 2863
OSHKOSH, WISCONSIN 54903
(414) 426-2800



PLAT OF SURVEY


KNOWN AS 1217 EVANS STREET, BEING LOT 5 OF BLOCK 30 IN PLEASANT HOME LAND COMPANY'S 4th ADDITION IN THE 15th WARD, CITY OF OSHKOSH, WINNEBAGO COUNTY, WISCONSIN.

AUGUST 26, 1983

SURVEY FOR OSHKOSH SAVINGS
APPLICANT: LAWRENCE DANIELS
MONUMENT WAIVER ON FILE

SURVEY NO. 1289-41


SCALE 1" = 30'

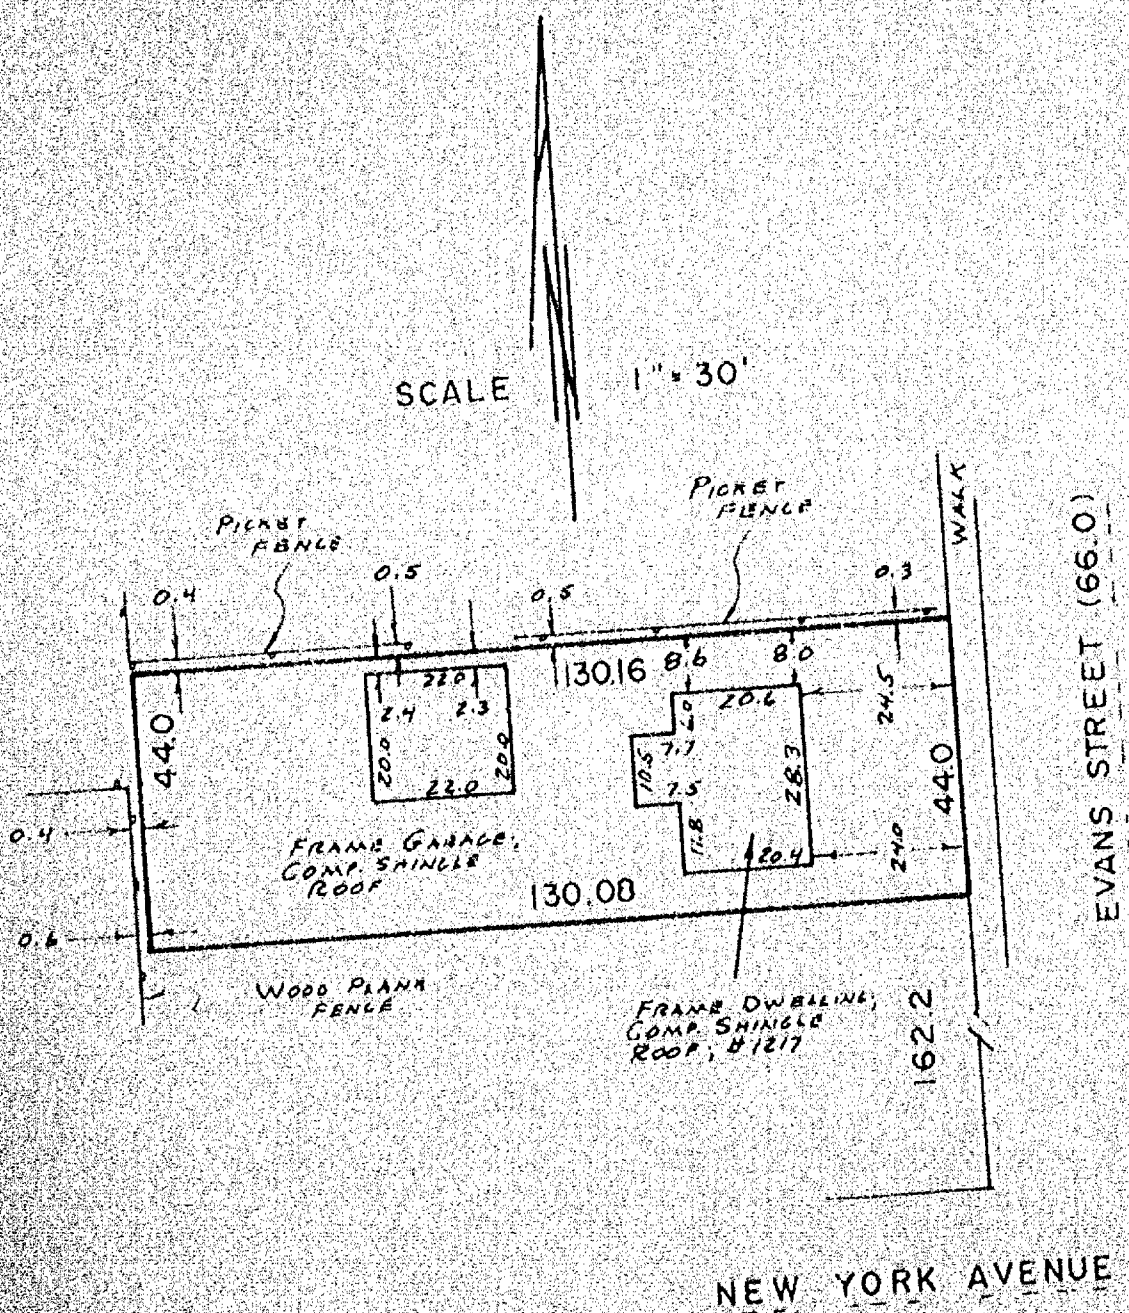

I Certify that I have surveyed the above described property (Property), and the above map is a true representation thereof and shows the size and location of the Property, its exterior boundaries, the location and dimensions of all visible structures thereon, boundary, fences, apparent easements and roadways and visible encroachments, if any. This survey is made for the exclusive use of the present owners of the Property, and also those who purchase, mortgage, or guarantee the title thereto, within one (1) year from date hereof.



national survey & engineering
417 NORTH SAWYER STREET / P.O. BOX 2963
OSHKOSH, WISCONSIN 54903
(414) 428-2800

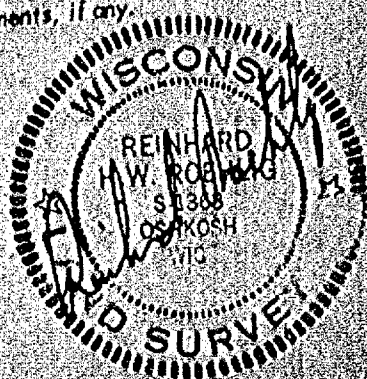


PLAT OF SURVEY

KNOWN AS 707 JACKSON STREET, BEING THE NORTH 35.0 FT. FRONT AND REAR OF THE SOUTH 99.0 FT. FRONT AND REAR OF THE EAST 120.0 FT. OF LOT 16 OF BLOCK 8 IN C.H. FORD'S SUBDIVISION OF BLOCK 9 IN G.P. WRIGHT'S ADDITION TO OSHKOSH, IN THE 5TH WARD, CITY OF OSHKOSH, WINNEBAGO COUNTY, WISCONSIN.

AUGUST 26, 1983

SURVEY FOR OSHKOSH SAVINGS
APPLICANT: JEFFERY FILIMORE
MONUMENT WAIVER ON FILE

SURVEY NO. 1290-M

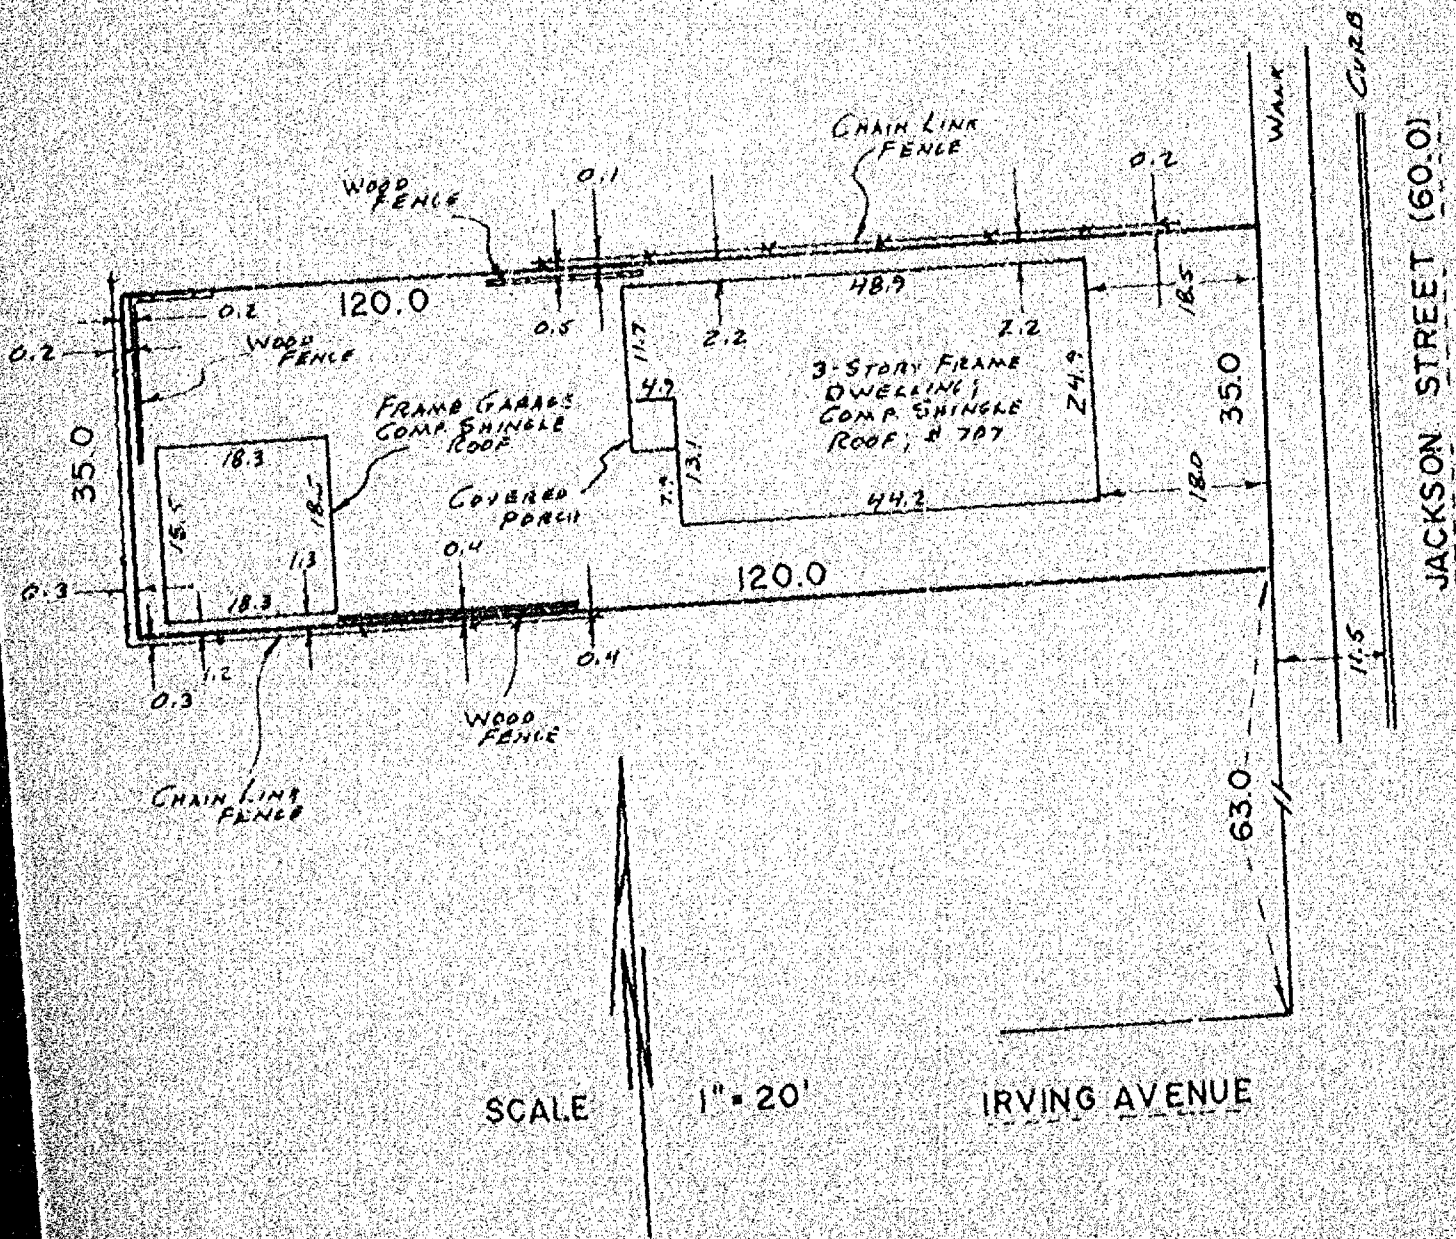

I Certify that I have surveyed the above described property (Property), and the above map is a true representation thereof and shows the size and location of the Property, its exterior boundaries, the location and dimensions of all visible structures thereon, boundary, fences, apparent easements and roadways and visible encroachments, if any. This survey is made for the exclusive use of the present owners of the Property, and also those who purchase, mortgage, or guarantee the title thereto, within one (1) year from date hereof.



national survey & engineering
417 NORTH SAWYER STREET / P.O. BOX 2963
OSHKOSH, WISCONSIN 54903
(414) 428-2800




PLAT OF SURVEY

KNOWN AS 2219 ALLERTON AVENUE, BEING LOT 446 IN THE THIRD ADDITION TO WESTHAVEN, IN THE 13TH WARD, CITY OF OSHKOSH, WINNEBAGO COUNTY, WISCONSIN.

AUGUST 25, 1983

SURVEY FOR OSHKOSH SAVINGS
APPLICANT: DALE SANKOZY
(MORTGAGE WAIVER ON FILE)


SURVEY NO. 1293-41

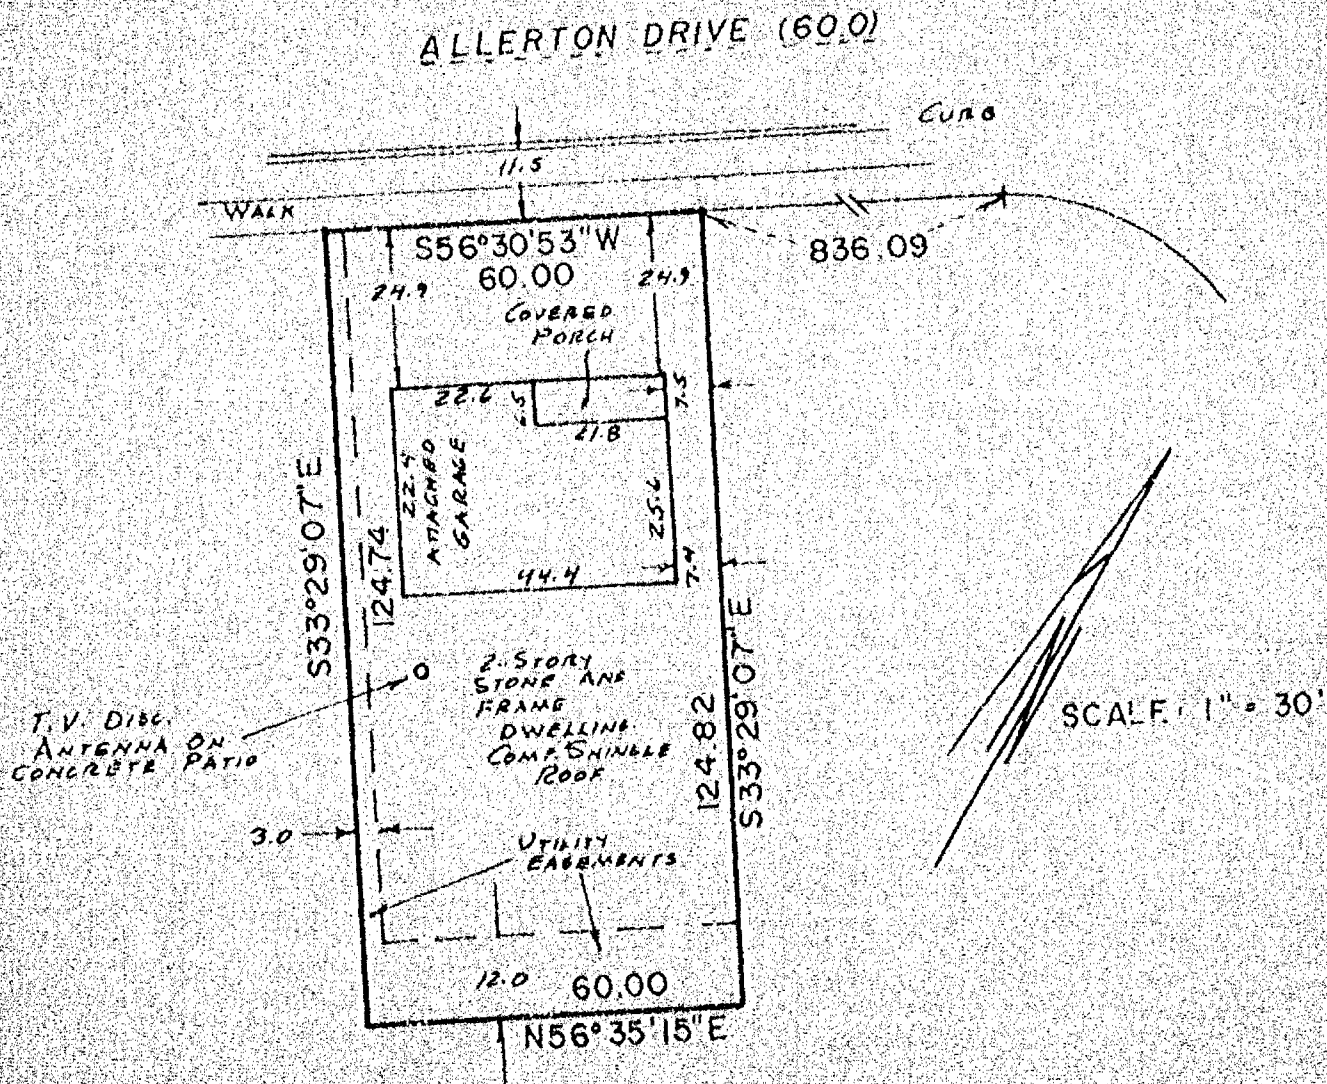

I Certify that I have surveyed the above described property (Property), and the above map is a true representation thereof and shows the size and location of the Property, its exterior boundaries, the location and dimensions of all visible structures thereon, boundary, fences, apparent easements and roadways and visible encroachments, if any. This survey is made for the exclusive use of the present owners of the Property, and also those who purchase, mortgage, or guarantee the title thereto, within one (1) year from date hereof.



national survey & engineering
417 NORTH SAWYER STREET / P.O. BOX 2863
OSHKOSH, WISCONSIN 54903
(414) 426-2800

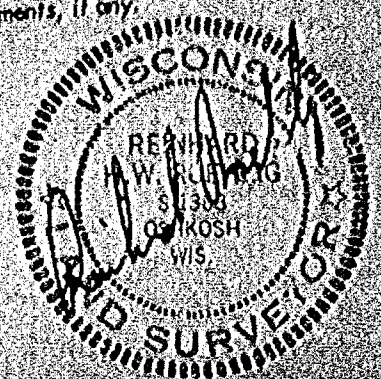


PLAT OF SURVEY

Known as 930 MONROE STREET, BEING LOT 4 OF BLOCK 5 IN FIRST AND BELLINGER'S SUBDIVISION, IN THE 11th WARD, CITY OF OSHKOSH, WINNEBAGO COUNTY, WISCONSIN.

APRIL 25, 1981

SURVEY FOR OSHKOSH SAVINGS
APPLICANT: JOSEPH KRONSCHEIDT
EXHIBIT WAIVER ON FILE

SURVEY NO. 1286-81

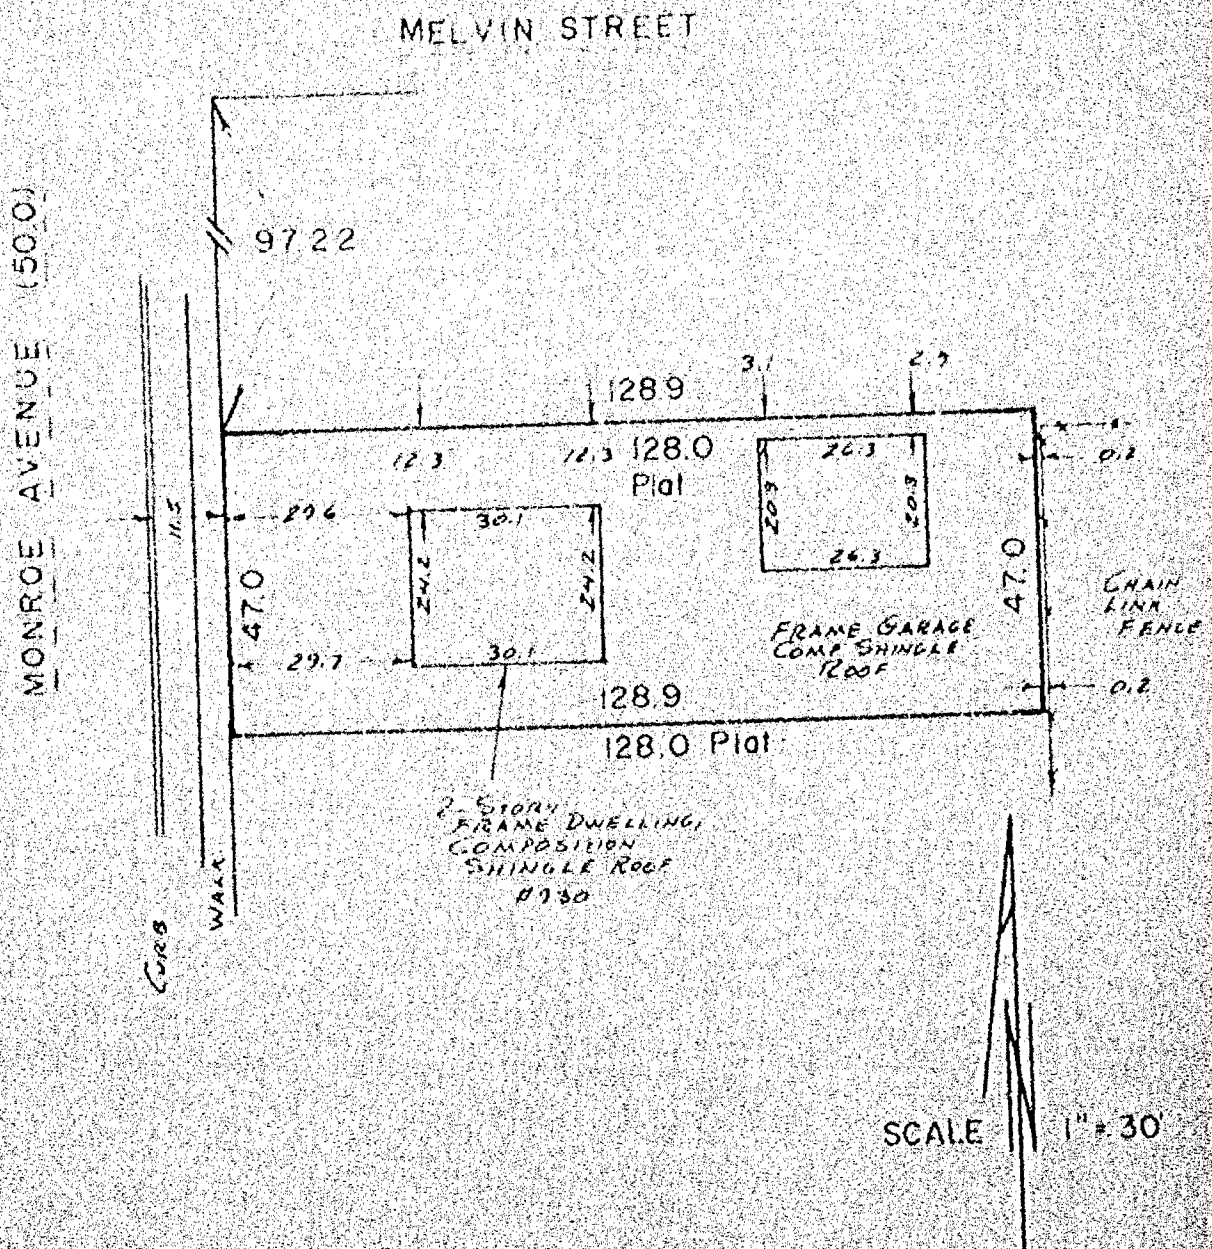

I Certify that I have surveyed the above described property (Property), and the above map is a true representation thereof and shows the size and location of the Property, its exterior boundaries, the location and dimensions of all visible structures thereon, boundary, fences, apparent easements and roadways and visible encroachments, if any. This survey is made for the exclusive use of the present owners of the Property, and also those who purchase, mortgage, or guarantee the title thereto, within one (1) year from date hereof.



national survey & engineering

417 NORTH SAWYER STREET / P.O. BOX 2963
OSHKOSH, WISCONSIN 54903
(414) 425-2800



PLAT OF SURVEY

KNOWN AS 2395 ALLERTON DRIVE, BEING LOT 425 IN THE THIRD ADDITION TO WESTHAVEN
IN THE 13TH WARD, CITY OF OSHKOSH, WINNEBAGO COUNTY, WISCONSIN.

OCTOBER 4, 1983


SURVEY FOR OSHKOSH SAVINGS
APPLICANT: ANTHONY TRALLER
MONUMENT WAIVER ON FILE

SURVEY NO. 1321-M

MARICOPA DRIVE

CURVE DATA
ARC: 101.24
RADIUS: 115.00
CHORD: 58.416 22-E
98.00

ALLERTON DRIVE (60.0)

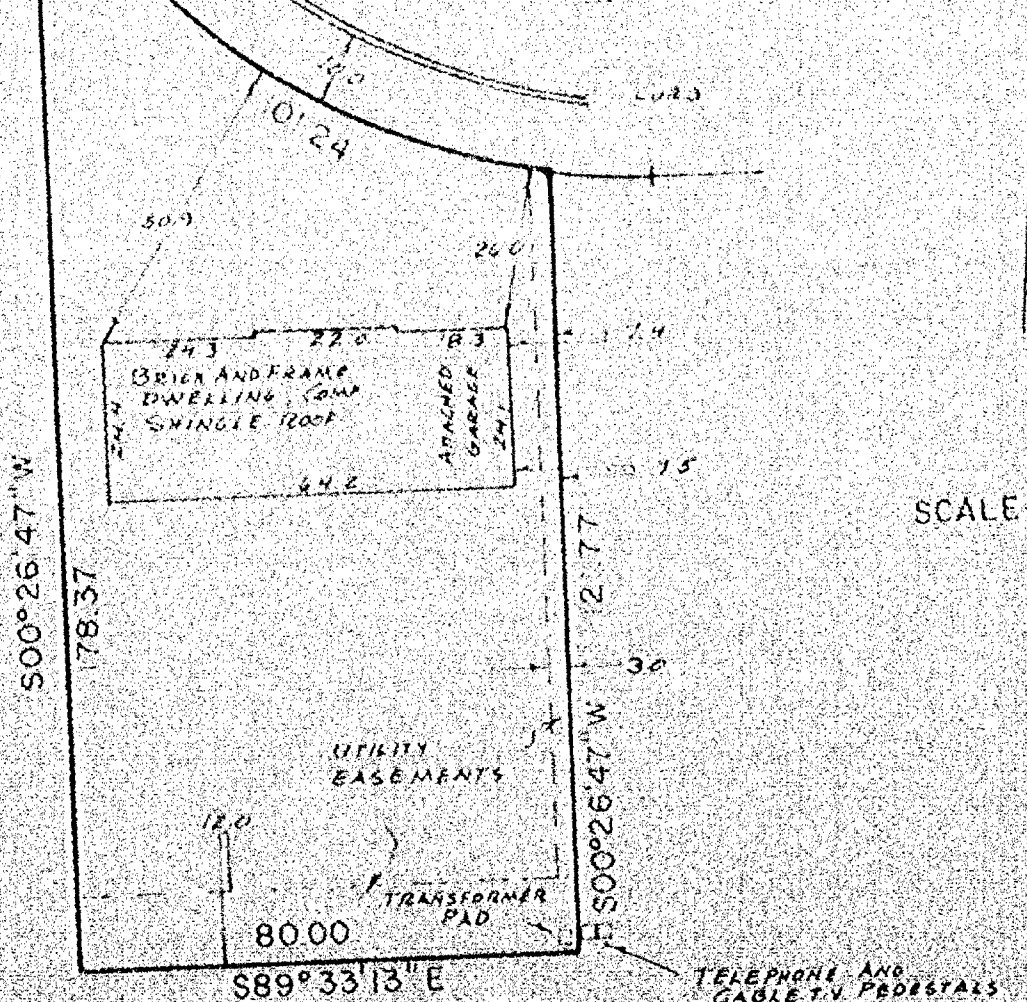


SCALE 1" = 30'

I Certify that I have surveyed the above described property (Property), and the above map is a true representation thereof and shows the size and location of the Property, its exterior boundaries, the location and dimensions of all visible structures thereon, boundary, fences, apparent easements and roadways and visible encroachments, if any. This survey is made for the exclusive use of the present owners of the Property, and also those who purchase, mortgage, or guarantee the title thereto, within one (1) year from date hereof.



national survey & engineering

417 NORTH SAWYER STREET / P.O. BOX 2963
OSHKOSH, WISCONSIN 54903
(914) 428-2800

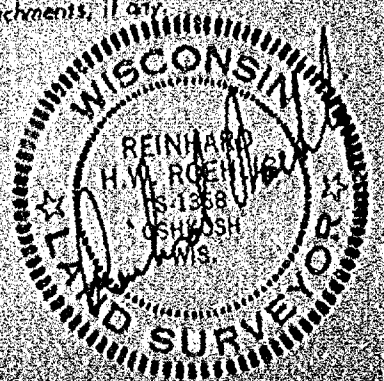


PLAT OF SURVEY

KNOWN AS 2016 SHERIDAN STREET, BEING LOT 1 AND THE NORTH 35.85 FT. OF LOT 2
IN BLOCK 3 OF ALGOMA PARK PLAT, CITY OF OSHKOSH, WINNEBAGO COUNTY, WISCONSIN.

SEPTEMBER 28, 1983

SURVEY FOR OSHKOSH SAVINGS
APPLICANT: DAVID EDWARDS
MONUMENT WAIVER ON FILE

SURVEY NO. 1320-11

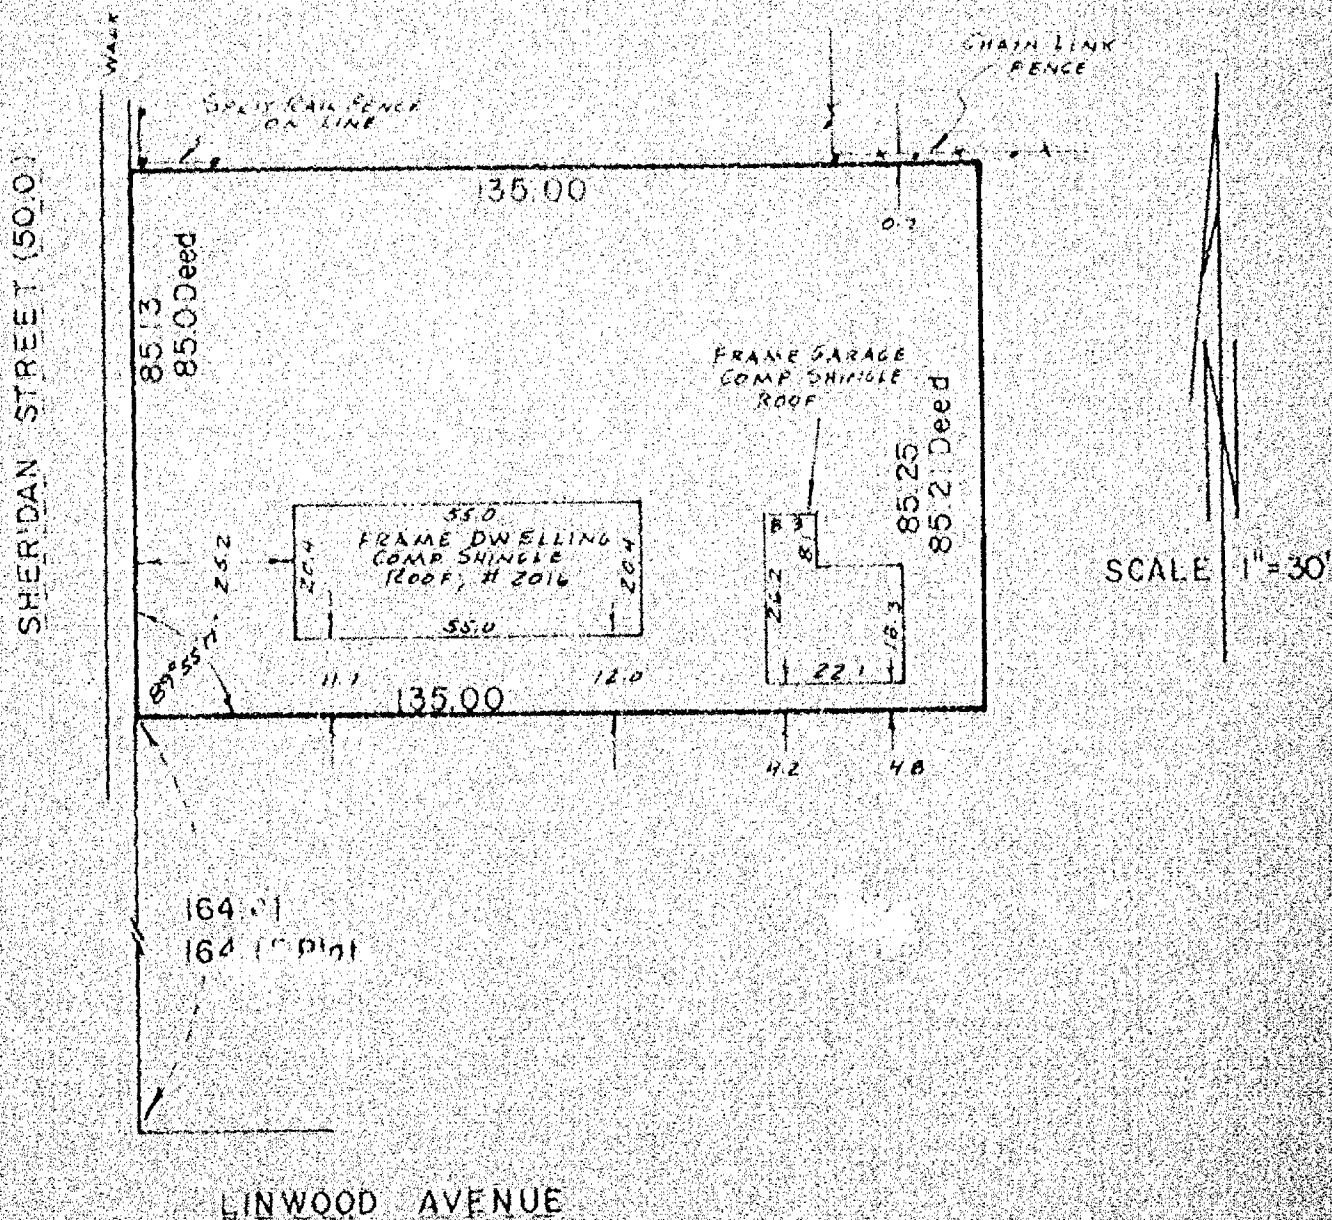

I Certify that I have surveyed the above described property (Property), and the above map is a true representation thereof and shows the size and location of the Property, its exterior boundaries, the location and dimensions of all visible structures thereon, boundary, fences, apparent easements and roadways and visible encroachments, if any. This survey is made for the exclusive use of the present owners of the Property, and also those who purchase, mortgage, or guarantee the title thereto, within one (1) year from date hereof.



national survey & engineering

417 NORTH SAWYER STREET / PO BOX 2963
OSHKOSH, WISCONSIN 54903
(414) 426-2800



PLAT OF SURVEY


THE NORTH 45.0 FT. OF THE WEST 70.0 FT. OF LOT 32 IN G.F. WRIGHT'S SUBDIVISION OF THE SOUTH PART OF BLOCK 46 IN THE 7TH WARD, CITY OF OSHKOSH AND THE EAST 30.0 FT. OF THE WEST 70.0 FT. OF LOT 31 IN G.F. WRIGHT'S SUBDIVISION OF THE SOUTH PART OF BLOCK 46 IN THE 7TH WARD, CITY OF OSHKOSH, WINNEBAGO COUNTY, WISCONSIN. KNOWN AS 523 AMHERST STREET.

SEPTEMBER 27, 1983

SURVEY FOR OSHKOSH SAVINGS
APPLICANT: A.B. PROPERTIES
MONUMENT WAIVER ON FILE

SURVEY NO. 1309-11

AMHERST AVENUE (60.0)

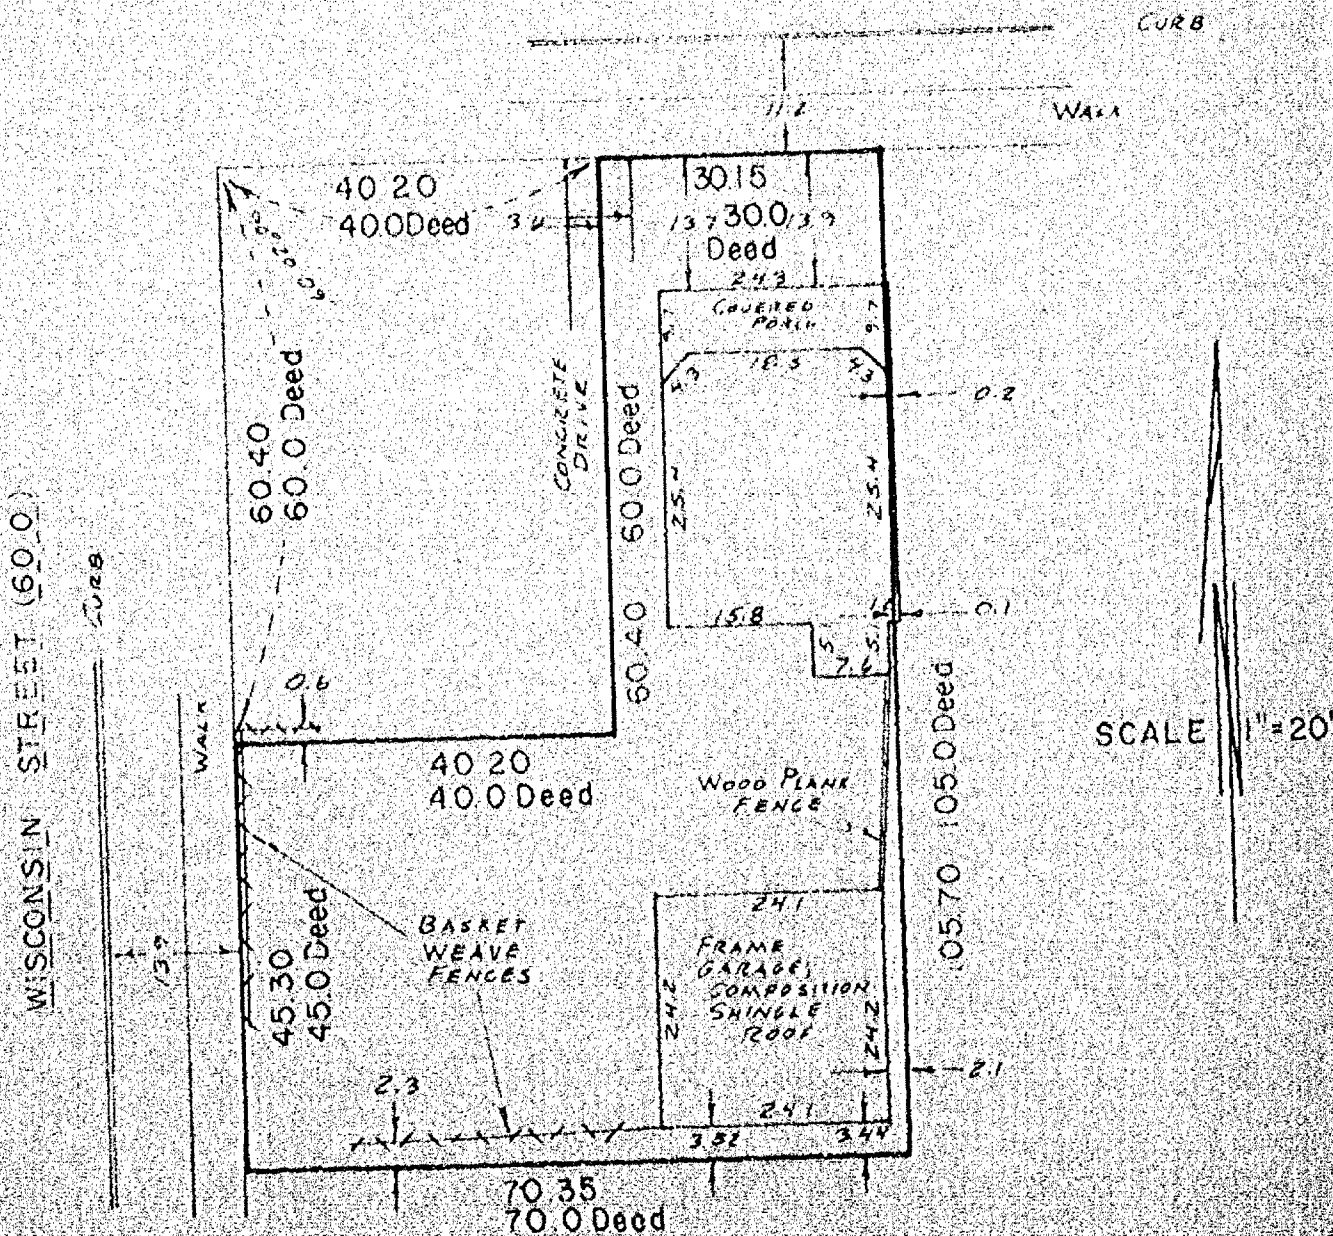

I Certify that I have surveyed the above described property (Property), and the above map is a true representation thereof and shows the size and location of the Property, its exterior boundaries, the location and dimensions of all visible structures thereon, boundary, fences, apparent easements and roadways and visible encroachments. This survey is made for the exclusive use of the present owners of the Property, and also those who purchase, mortgage, or guarantee the title thereto, within one (1) year from date hereof.



national survey & engineering
417 NORTH SAWYER STREET / PO. BOX 2963
OSHKOSH, WISCONSIN 54903
(414) 426-2800

PLAT OF SURVEY


KNOWN AS 1114 MERRILL STREET, BEING THE SOUTH 23.0 FT. OF LOT 12 IN BLOCK 2 OF SUHL'S ADDITION IN THE 10TH WARD, CITY OF OSHKOSH, PER LEACH'S MAP OF 1894, WINNEBAGO COUNTY, WISCONSIN.

KNOWN AS 1120 MERRILL STREET, BEING LOT 11 IN BLOCK 2 OF SUHL'S ADDITION, IN THE 10TH WARD, CITY OF OSHKOSH, PER LEACH'S MAP OF 1894, WINNEBAGO COUNTY, WISCONSIN.

SEPTEMBER 27, 1983

SURVEY FOR OSHKOSH SAVINGS
APPLICANT: RICHARD AMUNDSON
MONUMENT WAIVER ON FILE

SURVEY NO. 1310-M

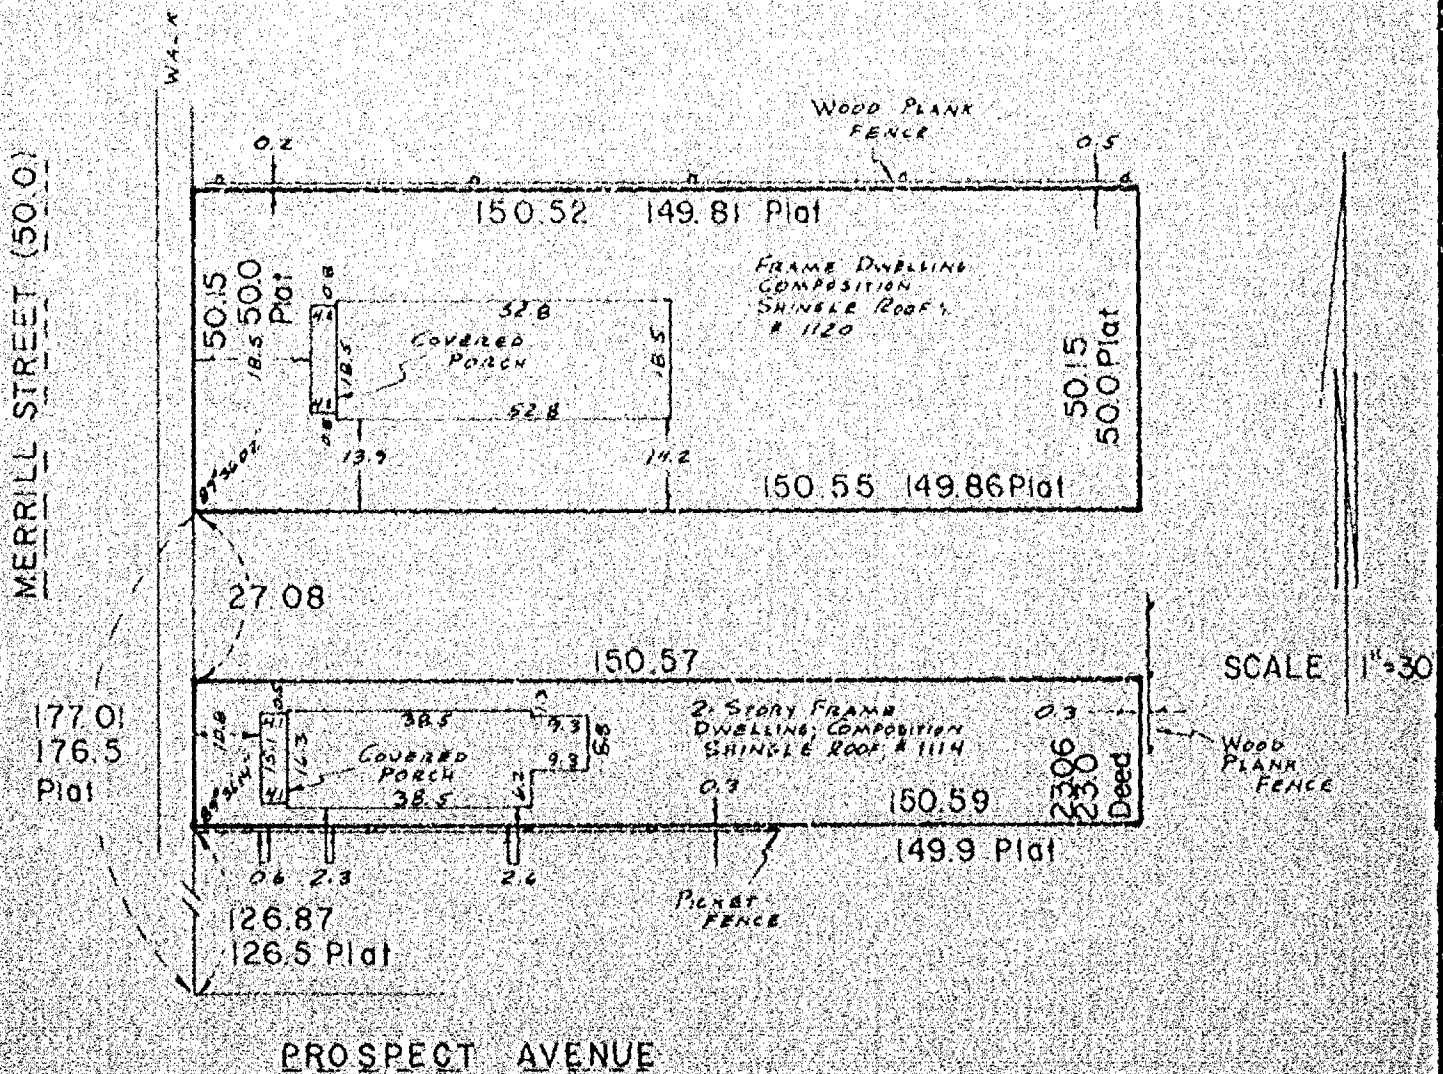

PROSPECT AVENUE

I Certify that I have surveyed the above described property (Property), and the above map is a true representation thereof and shows the size and location of the Property, its exterior boundaries, the location and dimensions of all visible structures thereon, boundary, fences, apparent easements and roadways and visible encroachments, if any. This survey is made for the exclusive use of the present owners of the Property, and also those who purchase, mortgage, or guarantee the title thereto, within one (1) year from date hereof.



national survey & engineering
417 NORTH SAWYER STREET / P.O. BOX 2963
OSHKOSH, WISCONSIN 54903
(414) 428-2800




PLAT OF SURVEY

KNOWN AS 636 WAUGOO, BEING LOT 10 IN BLOCK "J" OF THE SECOND ADDITION TO OSHKOSH, IN THE 2nd WARD, CITY OF OSHKOSH, WINNEBAGO COUNTY, WISCONSIN.

SEPTEMBER 26, 1983

SURVEY FOR OSHKOSH SAVINGS
APPLICANT: SPANBAUER
MONUMENT WAIVER ON FILE

SURVEY NO. 1311-M

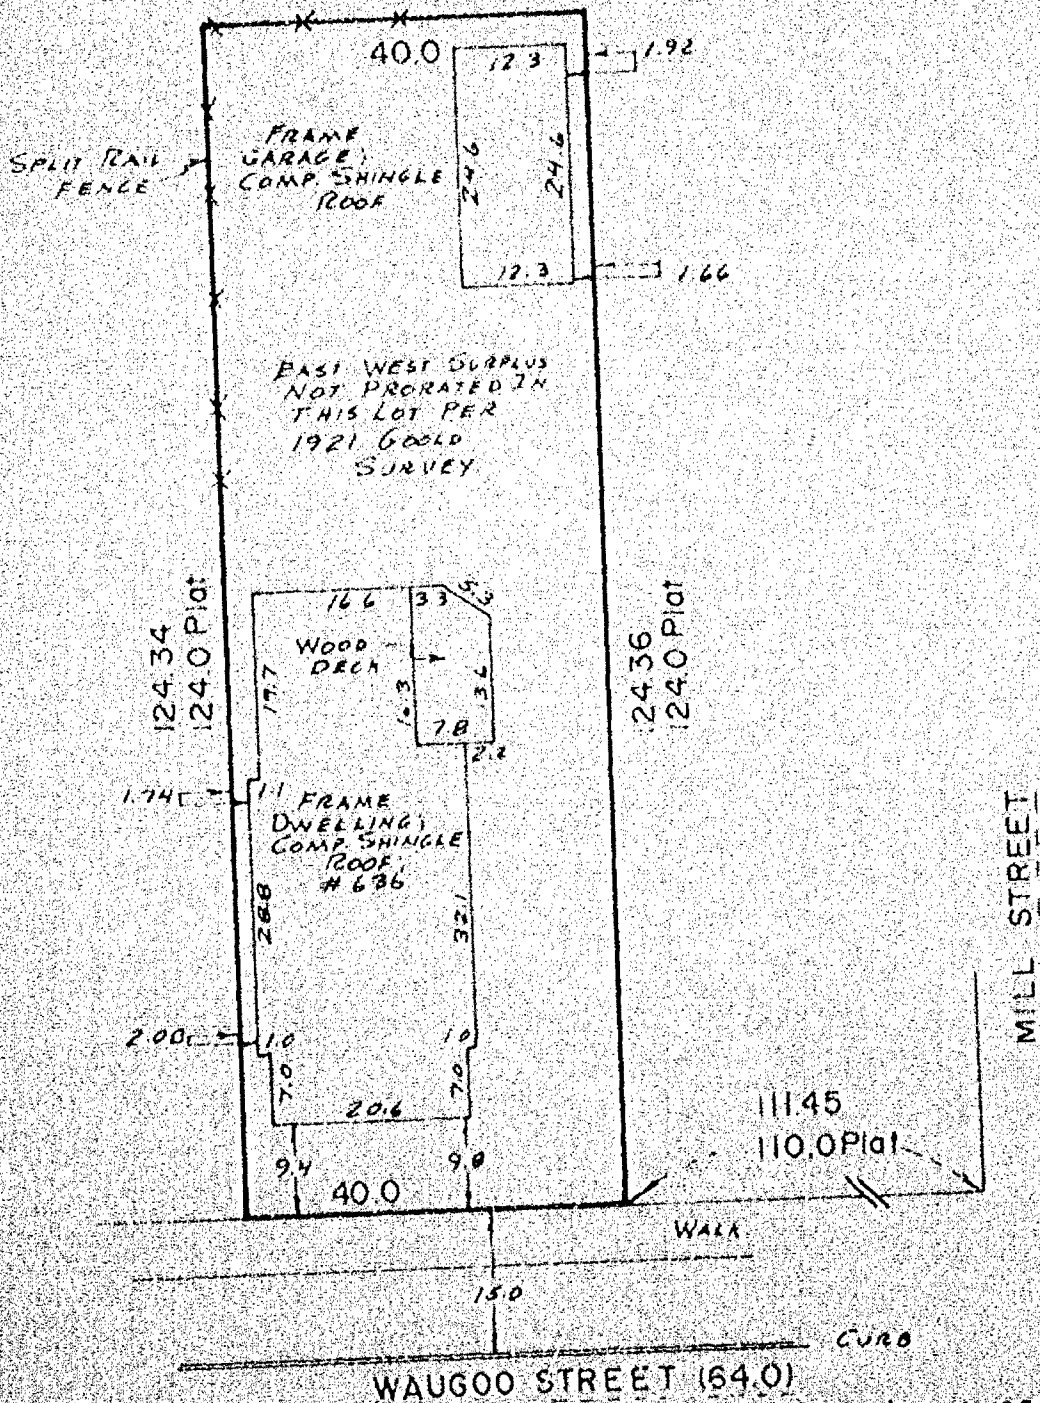


SCALE 1" = 20'

I Certify that I have surveyed the above described property (Property), and the above map is a true representation thereof and shows the size and location of the Property, its exterior boundaries, the location and dimensions of all visible structures thereon, boundary, fences, apparent easements and roadways and visible encroachments, if any. This survey is made for the exclusive use of the present owners of the Property, and also those who purchase, mortgage, or guarantee the title thereto, within one (1) year from date hereof.



national survey & engineering
417 NORTH SAWYER STREET / P.O. BOX 2963
OSHKOSH, WISCONSIN 54903
(414) 426-2800

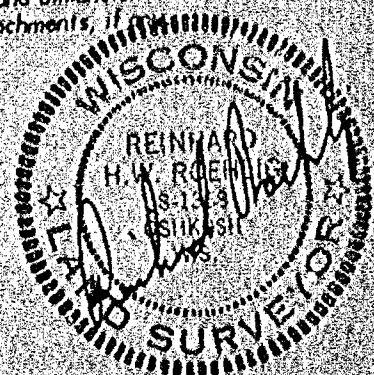


PLAT OF SURVEY

KNOWN AS 908 CENTRAL STREET, BEING THAT PART OF THE NORTH 36.0 FT. OF LOT 1, BLOCK 80 IN P.V. WRIGHT'S SUBDIVISION LYING WEST OF THE WESTERLY LINE OF THE SOO LINE RAILROAD AND THAT PART OF THE SOUTH 18.0 FT. OF LOT 2, BLOCK 80 IN P.V. WRIGHT'S SUBDIVISION LYING WEST OF THE WESTERLY LINE OF THE SOO LINE RAILROAD, ALL IN THE 10TH WARD, CITY OF OSHKOSH, WINNEBAGO COUNTY, WISCONSIN.

SEPTEMBER 12, 1983

SURVEY FOR OSHKOSH SAVINGS
APPLICANT: WILLIAM PURTELL
EXHIBIT WAIVER ON FILE

SURVEY NO. 1307-M

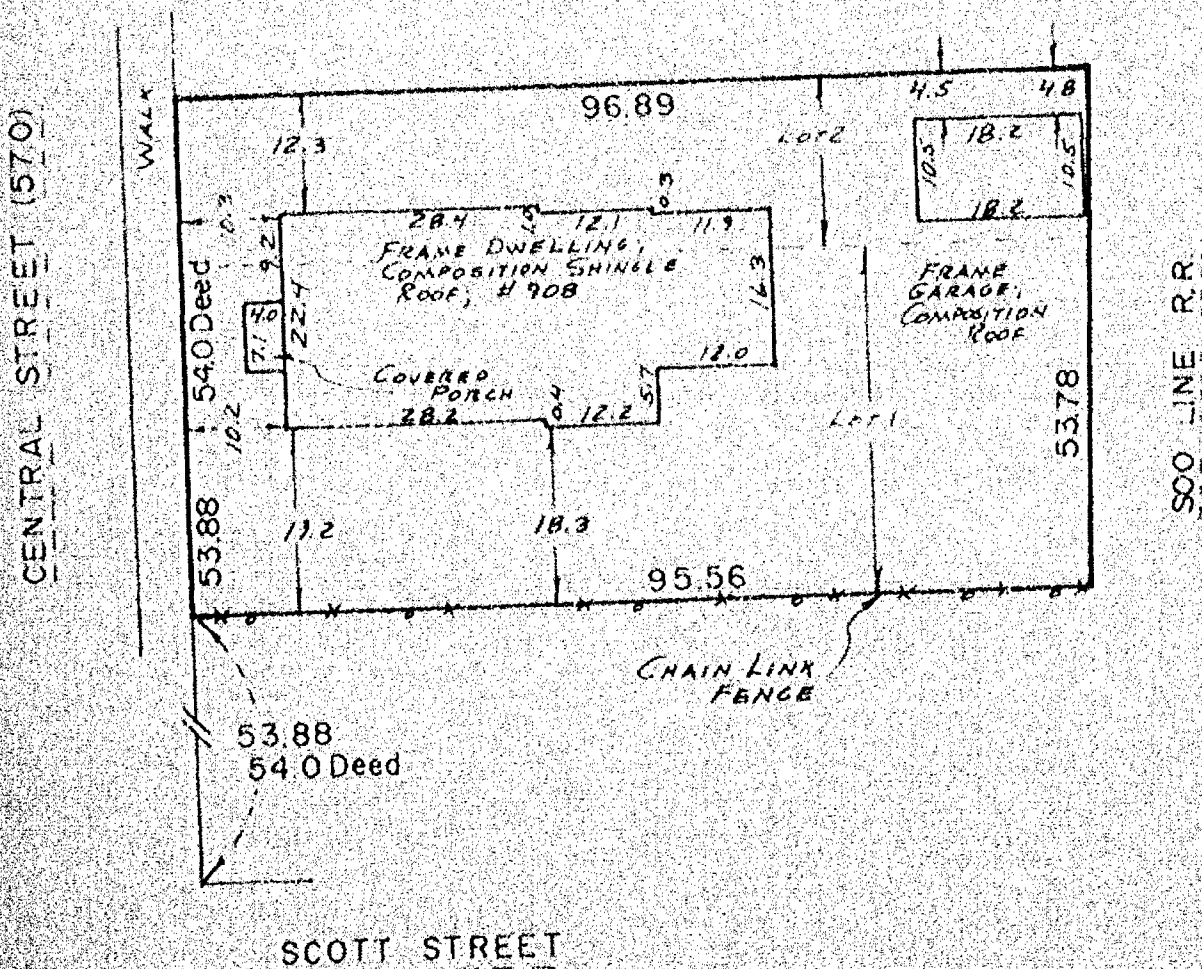

I Certify that I have surveyed the above described property (Property), and the above map is a true representation thereof and shows the size and location of the Property, its exterior boundaries, the location and dimensions of all visible structures thereon, boundary, fences, apparent easements and roadways and visible encroachments. This survey is made for the exclusive use of the present owners of the Property, and also those who purchase, mortgage, or guarantee the title thereto, within one (1) year from date hereof.



national survey & engineering
317 NORTH SAWYER STREET / P.O. BOX 2963
OSHKOSH, WISCONSIN 54903
(414) 426-2800


PLAT OF SURVEY

LOTS 9, 10, 11, 12 AND THE WEST 1/2 OF LOT 13 IN BLOCK 22 OF THE OSKOSH LAND COMPANY'S PLAT, IN THE 16TH WARD, CITY OF OSKOSH, WINNEBAGO COUNTY, WISCONSIN.

SEPTEMBER 16, 1983

SURVEY FOR MICHAEL CASTLE

SURVEY NO. 1305-3

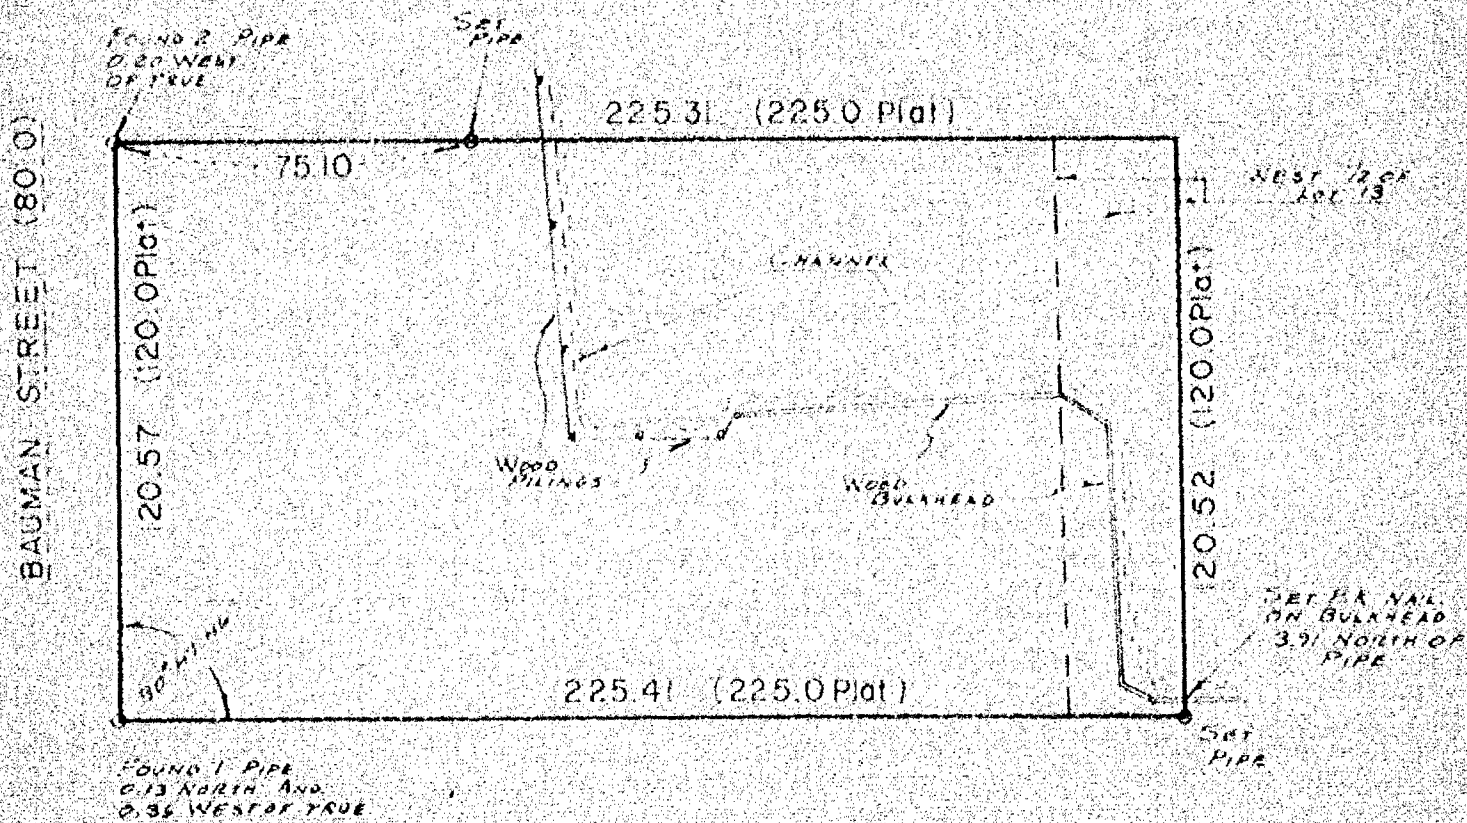

ADAMS AVENUE (60.0)

SCALE 1" = 40'

I Certify that I have surveyed the above described property (Property), and the above map is a true representation thereof and shows the size and location of the Property, its exterior boundaries, the location and dimensions of all visible structures thereon, boundary, fences, apparent easements and roadways and visible encroachments, if any.

This survey is made for the exclusive use of the present owners of the Property, and also those who purchase, mortgage, or guarantee the title thereto, within one (1) year from date hereof.



national survey & engineering

417 NORTH SAWYER STREET / P.O. BOX 2963
OSHKOSH, WISCONSIN 54903
(414) 426-2800




PLAT OF SURVEY

KNOWN AS 830 HARBORVIEW COURT, BEING LOT 137 IN THE 316 ADDITION TO NICOLET ANCHORAGE, IN THE 15TH WARD, CITY OF OSHKOSH, WINNEBAGO COUNTY, WISCONSIN.

SEPTEMBER 19, 1933

SURVEY FOR OSHA/OSHA SAVINGS
APPLICANT: DONALD PERICH
MONUMENT WAIVER ON FILE

SURVEY NO. 1303-M

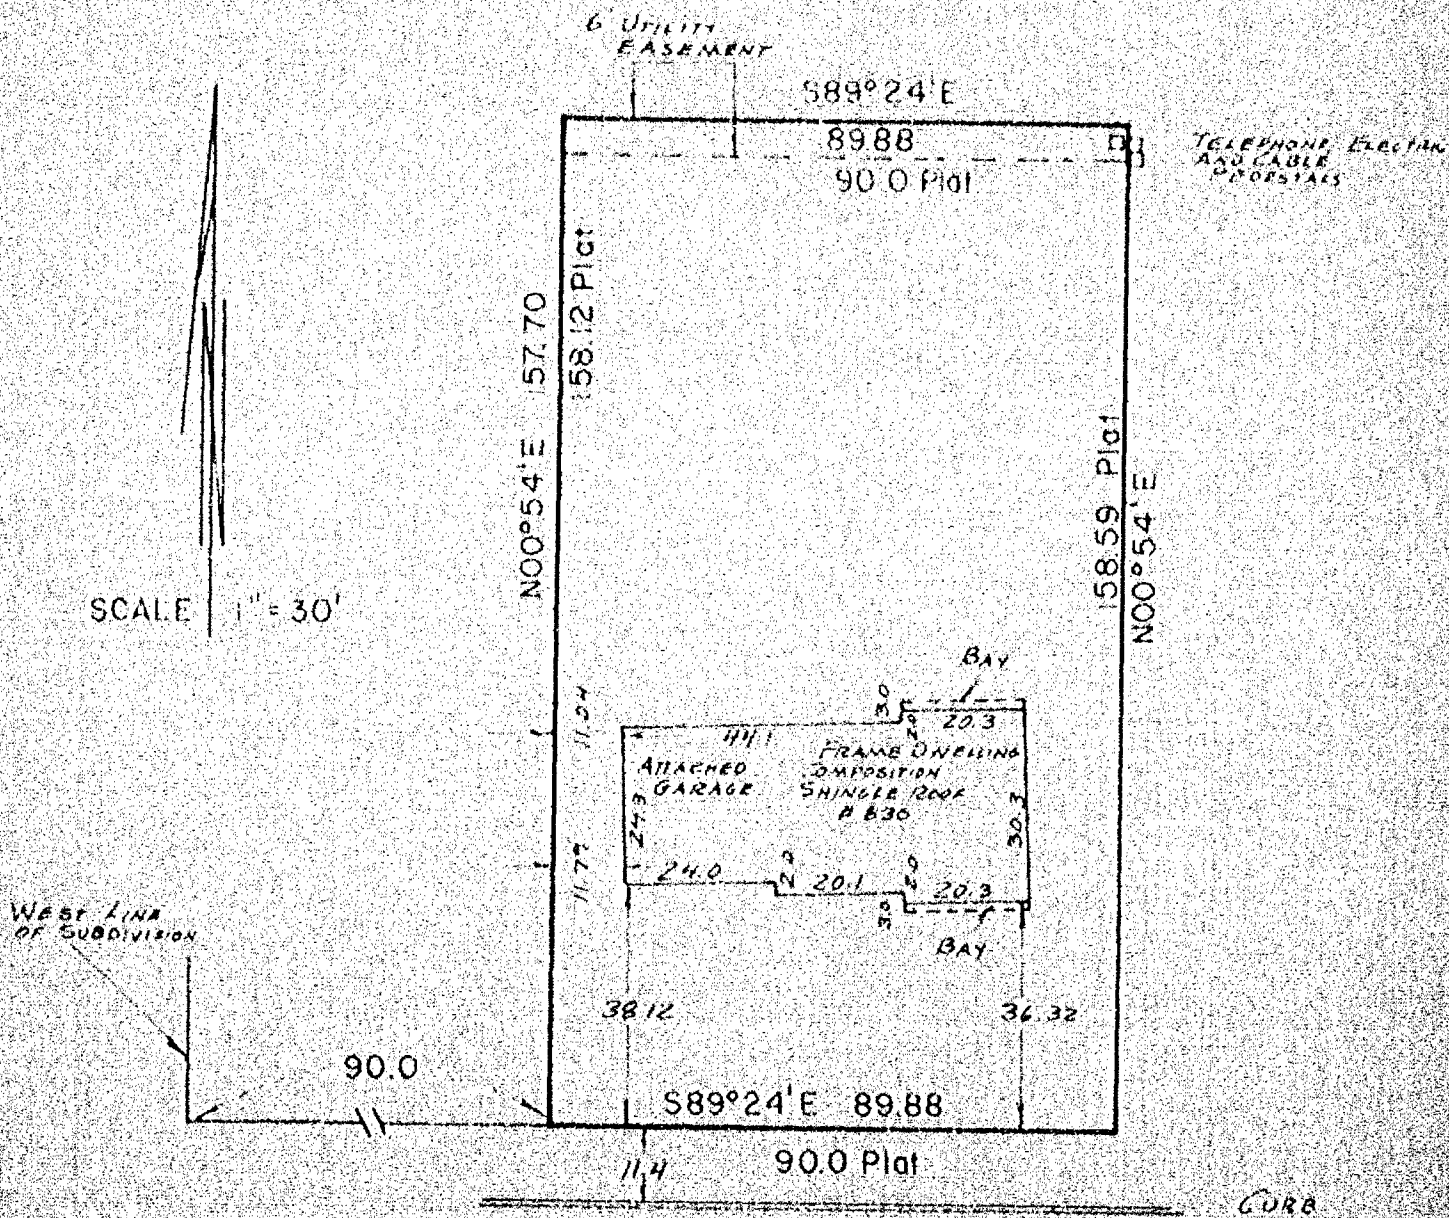

HARBORVIEW COURT (60.0)

I Certify that I have surveyed the above described property (Property), and the above map is a true representation thereof and shows the size and location of the Property, its exterior boundaries, the location and dimensions of all visible structures thereon, boundary, fences, apparent easements and roadways and visible encroachments, if any. This survey is made for the exclusive use of the present owners of the Property, and also those who purchase, mortgage, or guarantee the title thereto, within one (1) year from date hereof.



national survey & engineering

417 NORTH SAWYER STREET / P.O. BOX 2963
OSHKOSH, WISCONSIN 54903
(414) 426-2800




PLAT OF SURVEY

KNOWN AS 2205 SHERIDAN STREET, BEING LOT 22 AND THE SOUTH 1/2 OF THAT PART OF AN ALLEY, NOW VACATED, LYING NORTH AND ADJACENT TO SAID LOT 22 AND BETWEEN THE EXTENDED EAST AND WEST LINES THEREOF, ALL IN E.M. CRANE'S ADDITION TO ALGOMA PARK PLAT, IN THE 12TH WARD, CITY OF OSHKOSH, WINNEBAGO COUNTY, WISCONSIN.

SEPTEMBER 22, 1983

SURVEY FOR OSHKOSH SAVINGS
APPLICANT: VAN LINN
MONUMENT WAIVER ON FILE

SURVEY NO. 1306-X

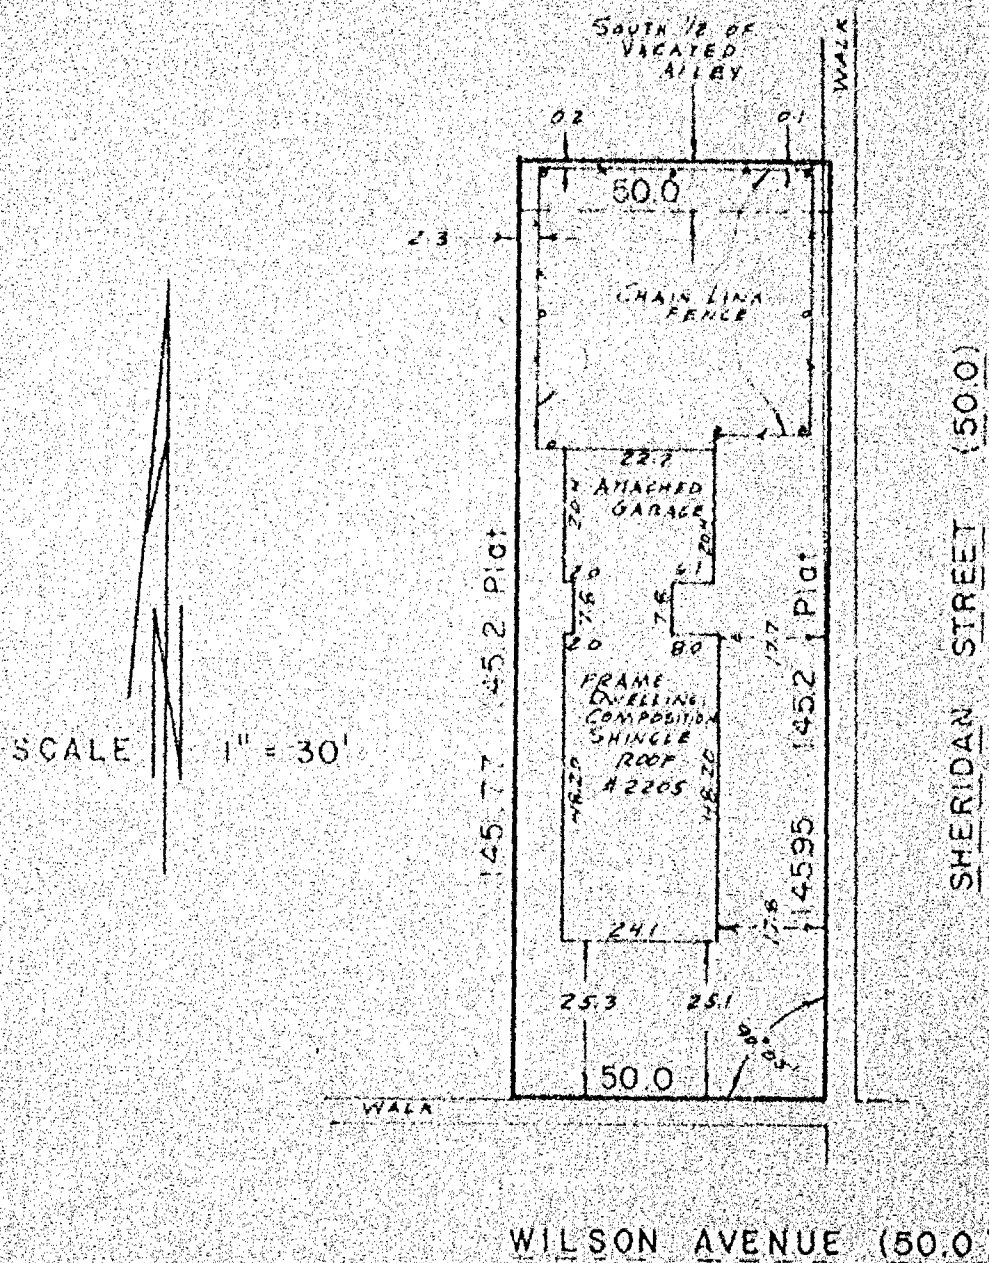


I Certify that I have surveyed the above described property (Property), and the above map is a true representation thereof and shows the size and location of the Property, its exterior boundaries, the location and dimensions of all visible structures thereon, boundary, fences, apparent easements and roadways and visible encroachments, if any. This survey is made for the exclusive use of the present owners of the Property, and also those who purchase, mortgage, or guarantee the title thereto, within one (1) year from date hereof.



national survey & engineering

417 NORTH SAWYER STREET / P.O. BOX 2863
OSHKOSH, WISCONSIN 54903
1414 426-2800

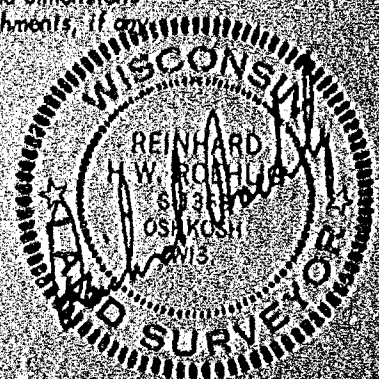


PLAT OF SURVEY

KNOWN AS 615 MONROE STREET, BEING LOT 3 IN BLOCK 60 OF FORD'S ADDITION TO THE CITY OF OSHKOSH, IN THE 4TH WARD, CITY OF OSHKOSH, WINNEBAGO COUNTY, WISCONSIN.

SEPTEMBER 26, 1983

SURVEY FOR OSHKOSH SAVINGS
APPLICANT: PURTELL
MONUMENT WAIVER ON FILE

SURVEY NO. 1313-M

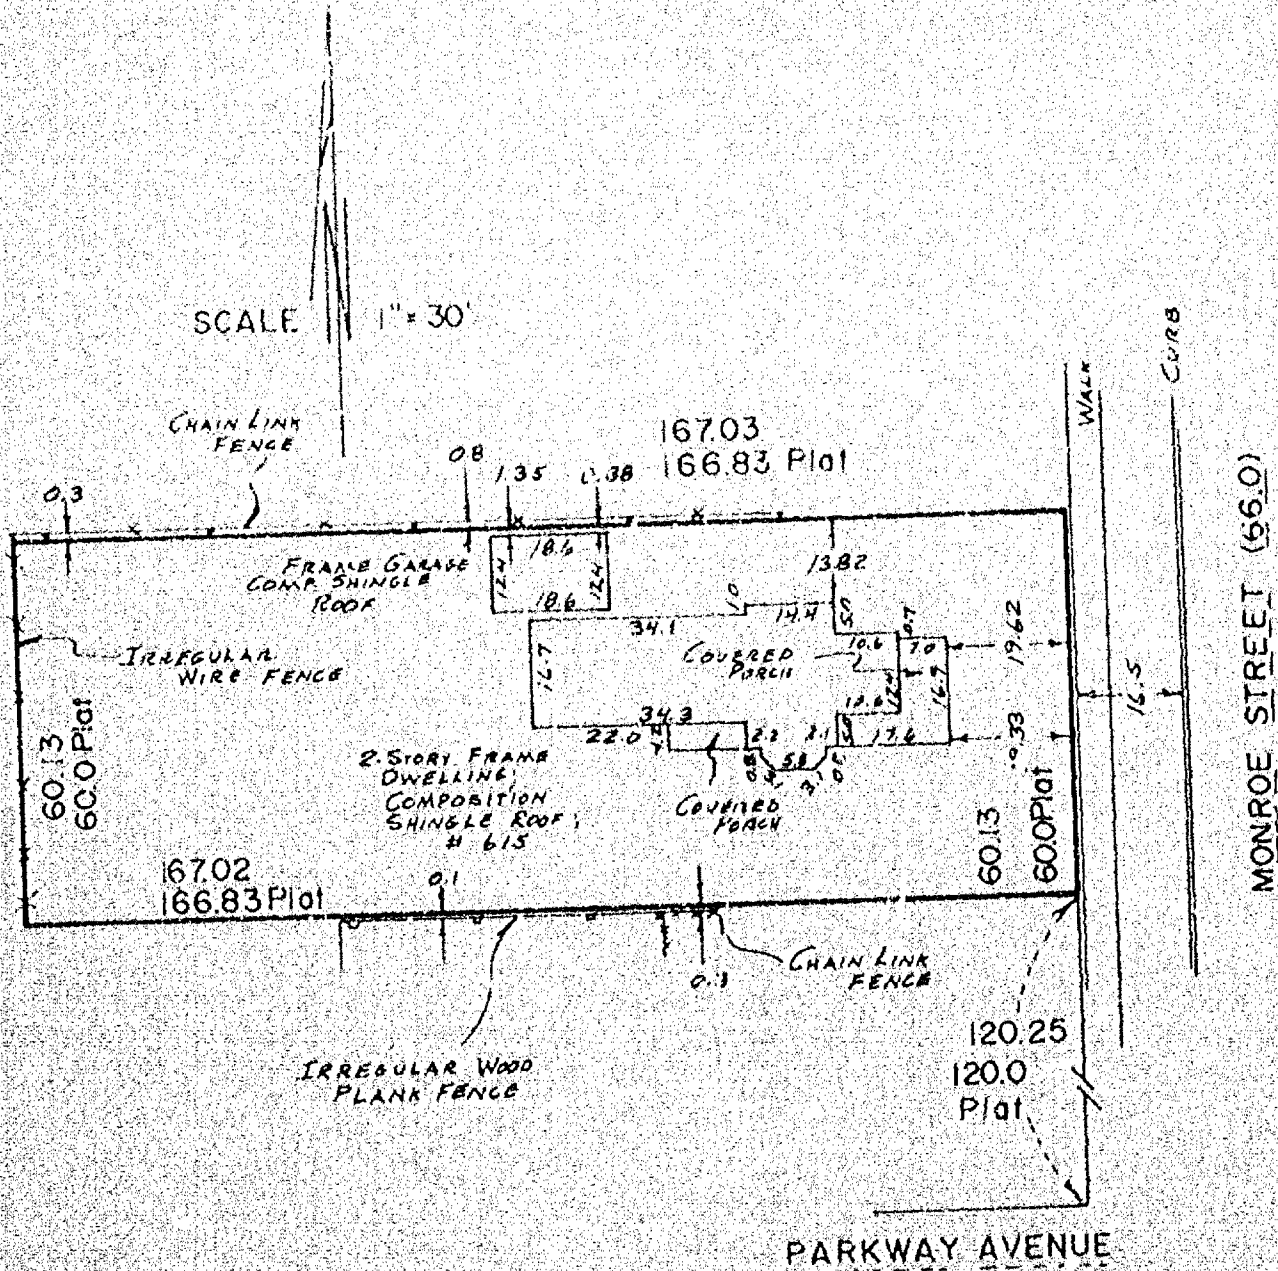


I Certify that I have surveyed the above described property (Property), and the above map is a true representation thereof and shows the size and location of the Property, its exterior boundaries, the location and dimensions of all visible structures thereon, boundary, fences, apparent easements and roadways and visible encroachments, if any. This survey is made for the exclusive use of the present owners of the Property, and also those who purchase, mortgage, or guarantee the title thereto, within one (1) year from date hereof.



national survey & engineering

417 NORTH SAWYER STREET / P.O. BOX 2963
OSHKOSH, WISCONSIN 54903
(414) 426-2800

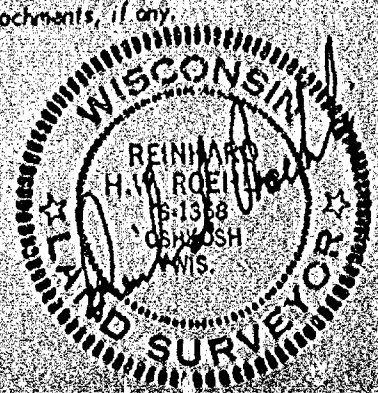


PLAT OF SURVEY

KNOWN AS 439, 439-A, 439-B, 439-C MOUNT VERNON STREET, BEING LOT 9 IN BLOCK 1 OF MERRITT AND EASTMAN'S ADDITION, IN THE 4TH WARD, CITY OF OSHKOSH PER LEACH'S MAP OF 1891, WINNEBAGO COUNTY, WISCONSIN, EXCEPTING THEREFROM THE NORTH 5.0 FT. OF SAID LOT.

SEPTEMBER 23, 1983

SURVEY FOR OSHKOSH SAVINGS
APPLICANT: CAROL SCHULKE
MONUMENT WAIVER ON FILE

SURVEY NO. 1312-M

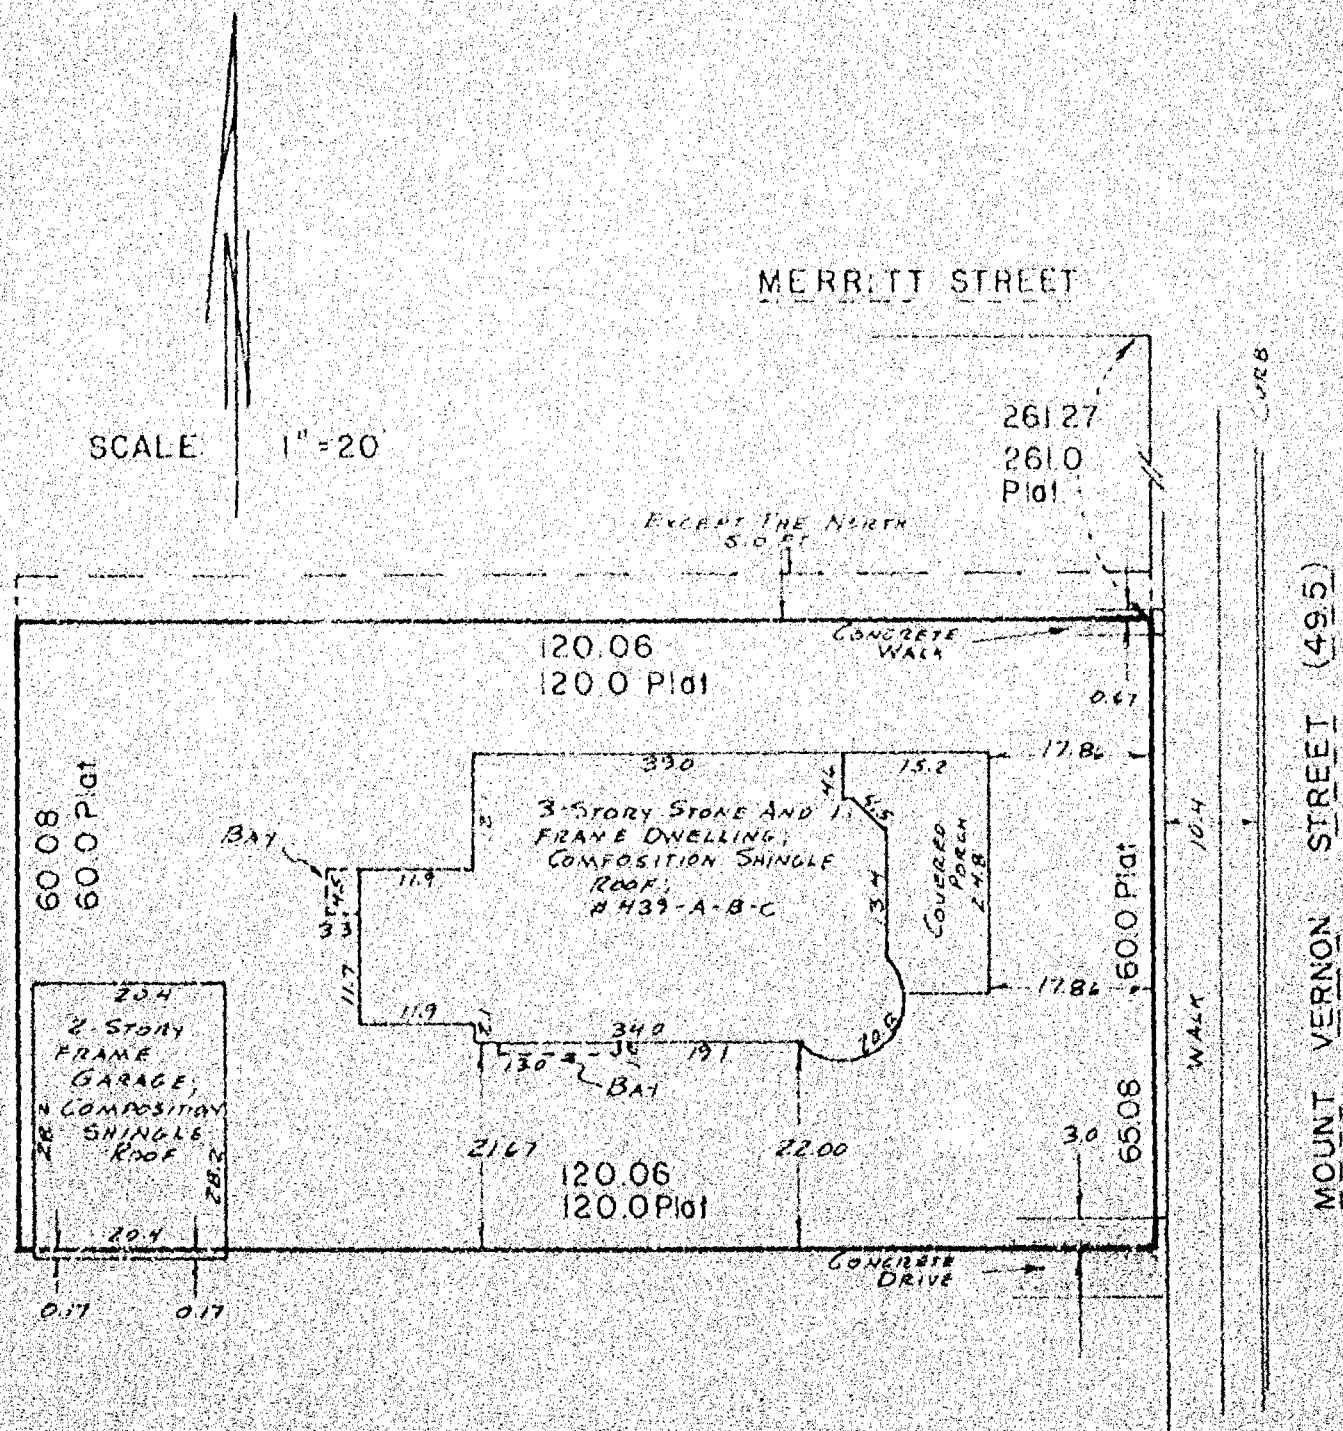

I Certify that I have surveyed the above described property (Property), and the above map is a true representation thereof and shows the size and location of the Property, its exterior boundaries, the location and dimensions of all visible structures thereon, boundary, fences, apparent easements and roadways and visible encroachments, if any. This survey is made for the exclusive use of the present owners of the Property, and also those who purchase, mortgage, or guarantee the title thereto, within one (1) year from date hereof.



national survey & engineering


417 NORTH SAWYER STREET / P.O. BOX 2963
OSHKOSH, WISCONSIN 54903
(414) 426-2800



SURVEY
FOR
KEITH WOELLHOF

Lot 6, Block 90 in the Plat of the Original Third Ward now in the Ninth Ward, and a part of Lot 3, in John Smith's Second Addition, Ninth Ward, City of Oshkosh, Winnebago County, Wisconsin.

(See Sheet 2 of 2 for Description of Parcel "A")

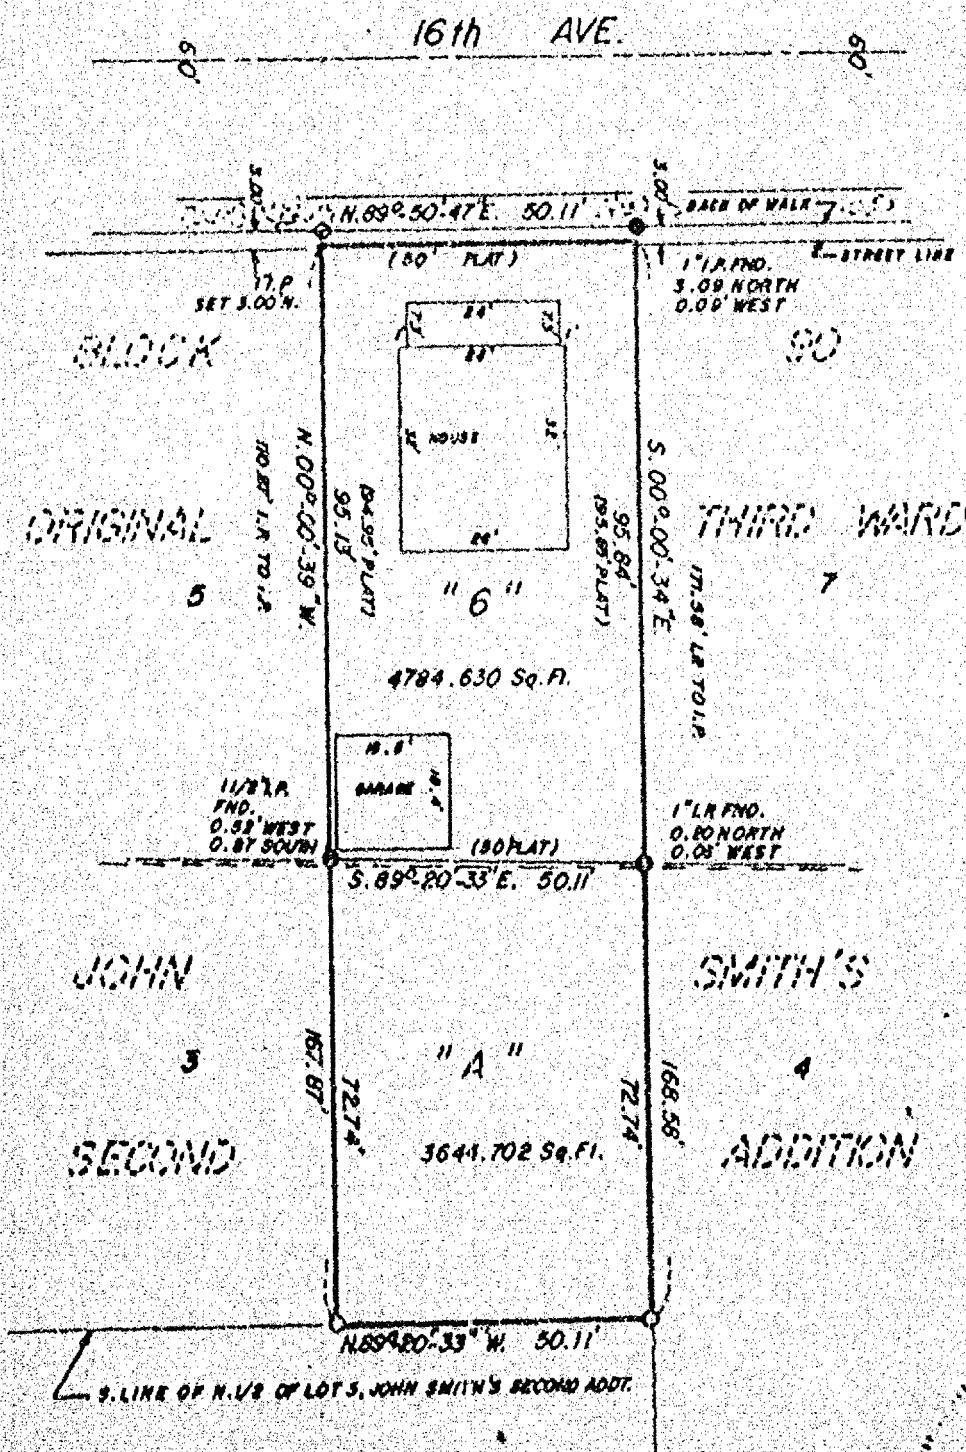


ALL BEARINGS REFERENCED TO THE EAST LINE OF WICHITA ST. ASSUMED TO BE N. 00° 01' 00" W.



LEGEND
0 = 1" = 24" IRON PIPE SET
DATE: OCTOBER 14, 1983
SCALE: 1" = 30'
TOTAL AREA = 8429.327 Sq. Ft.

"PARCEL A"

A part of Lot 3 in John Smith's Second Addition, Ninth Ward, City of Oshkosh, Winnebago County, Wisconsin containing 3644.630 square feet of land and being described by:
Commencing at the NE corner of said Lot 3; thence S. $00^{\circ}-00'-34''$ E. 72.74 feet, along the East line of said Lot 3 to the Southeast corner of the North half of said Lot 3; thence N. $89^{\circ}-20'-33''$ W. 50.11 feet, along the South line of the North half of said Lot 3; thence N. $00^{\circ}-00'-39''$ W. 72.74 feet, to a point on the North line of said Lot 3; thence S. $89^{\circ}-20'-33''$ E. 50.11 feet, along the North line of said Lot 3 to the true point of beginning.

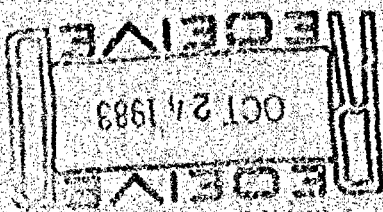


PLAT OF SURVEY

KNOWN AS 1224 GRAND STREET, BEING LOT 12 IN BLOCK 12 OF PLEASANT HOME LAND COMPANY'S FIRST ADDITION, IN THE 15th WARD, CITY OF OSHKOSH, WINNEBAGO COUNTY, WISCONSIN.

OCTOBER 27, 1983

SURVEY FOR OSHKOSH SAVINGS
APPLICANT: GRACE COONEN
MONUMENT WAIVER ON FILE

SURVEY NO. 1340-M

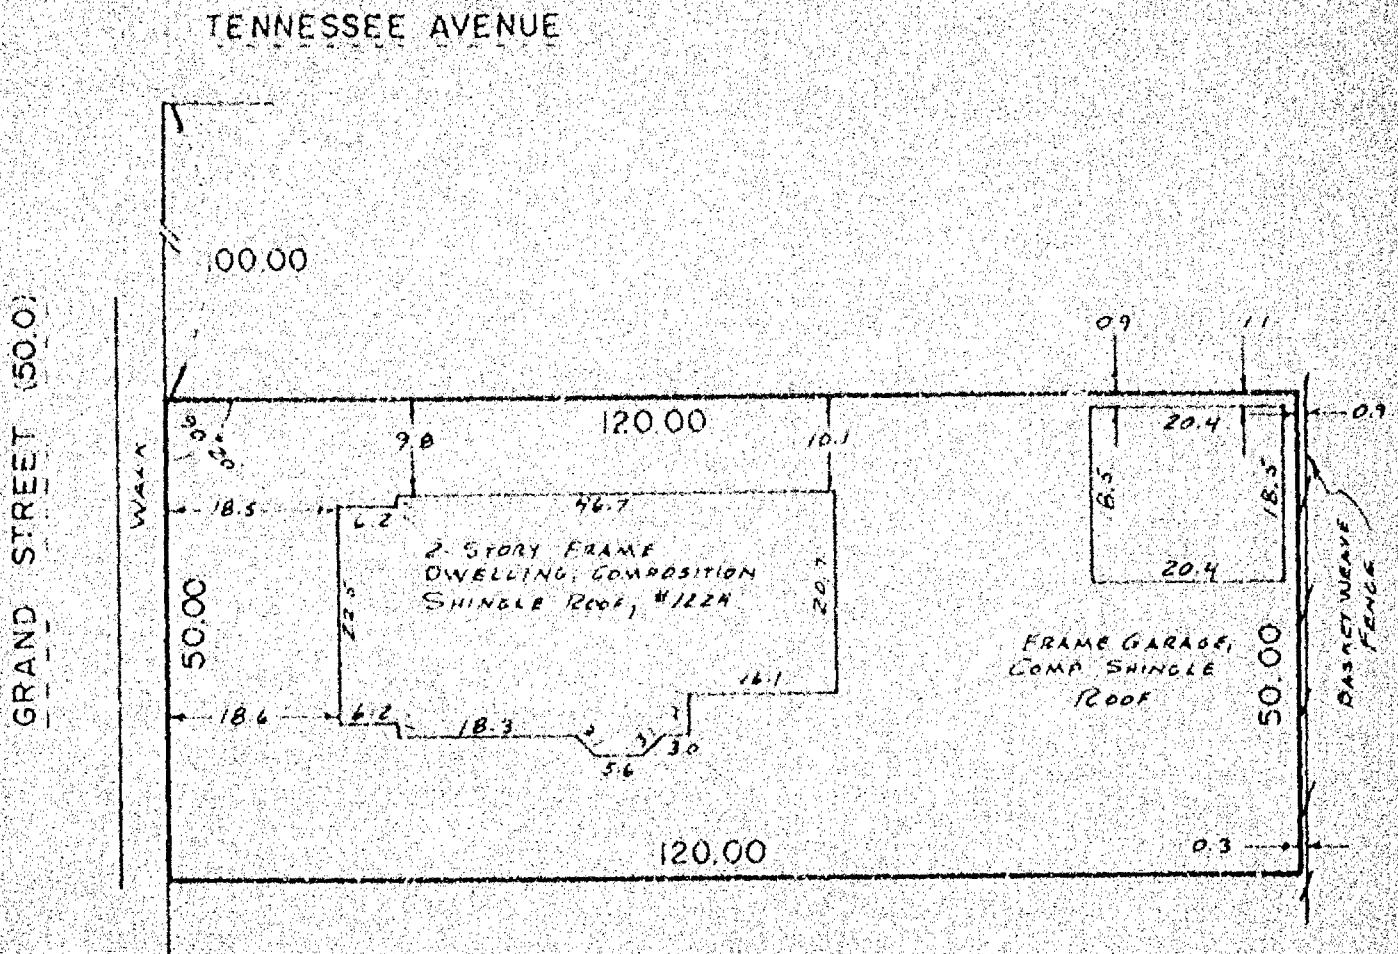

SCALE 1" = 20'

I Certify that I have surveyed the above described property (Property), and the above map is a true representation thereof and shows the size and location of the Property, its exterior boundaries, the location and dimensions of all visible structures thereon, boundary, fences, apparent easements and roadways and visible encroachments, if any. This survey is made for the exclusive use of the present owners of the Property, and of so those who purchase, mortgage, or guarantee the title thereto, within one (1) year from date hereof.



national survey & engineering

412 NORTH SAWYER STREET / P.O. BOX 2963
OSHKOSH, WISCONSIN 54903
(414) 426-2800




PLAT OF SURVEY

KNOWN AS 414 - 414A MONROE STREET, BEING LOT 7 OF BLOCK 54 IN FORD'S ADDITION,
IN THE 4TH WARD, CITY OF OSHKOSH, WINNEBAGO COUNTY, WISCONSIN.

OCTOBER 27, 1983

SURVEY FOR OSHKOSH SAVINGS
APPLICANT: GARY MARTZKE
MONUMENT WAIVER ON FILE

SURVEY NO. 1339-M

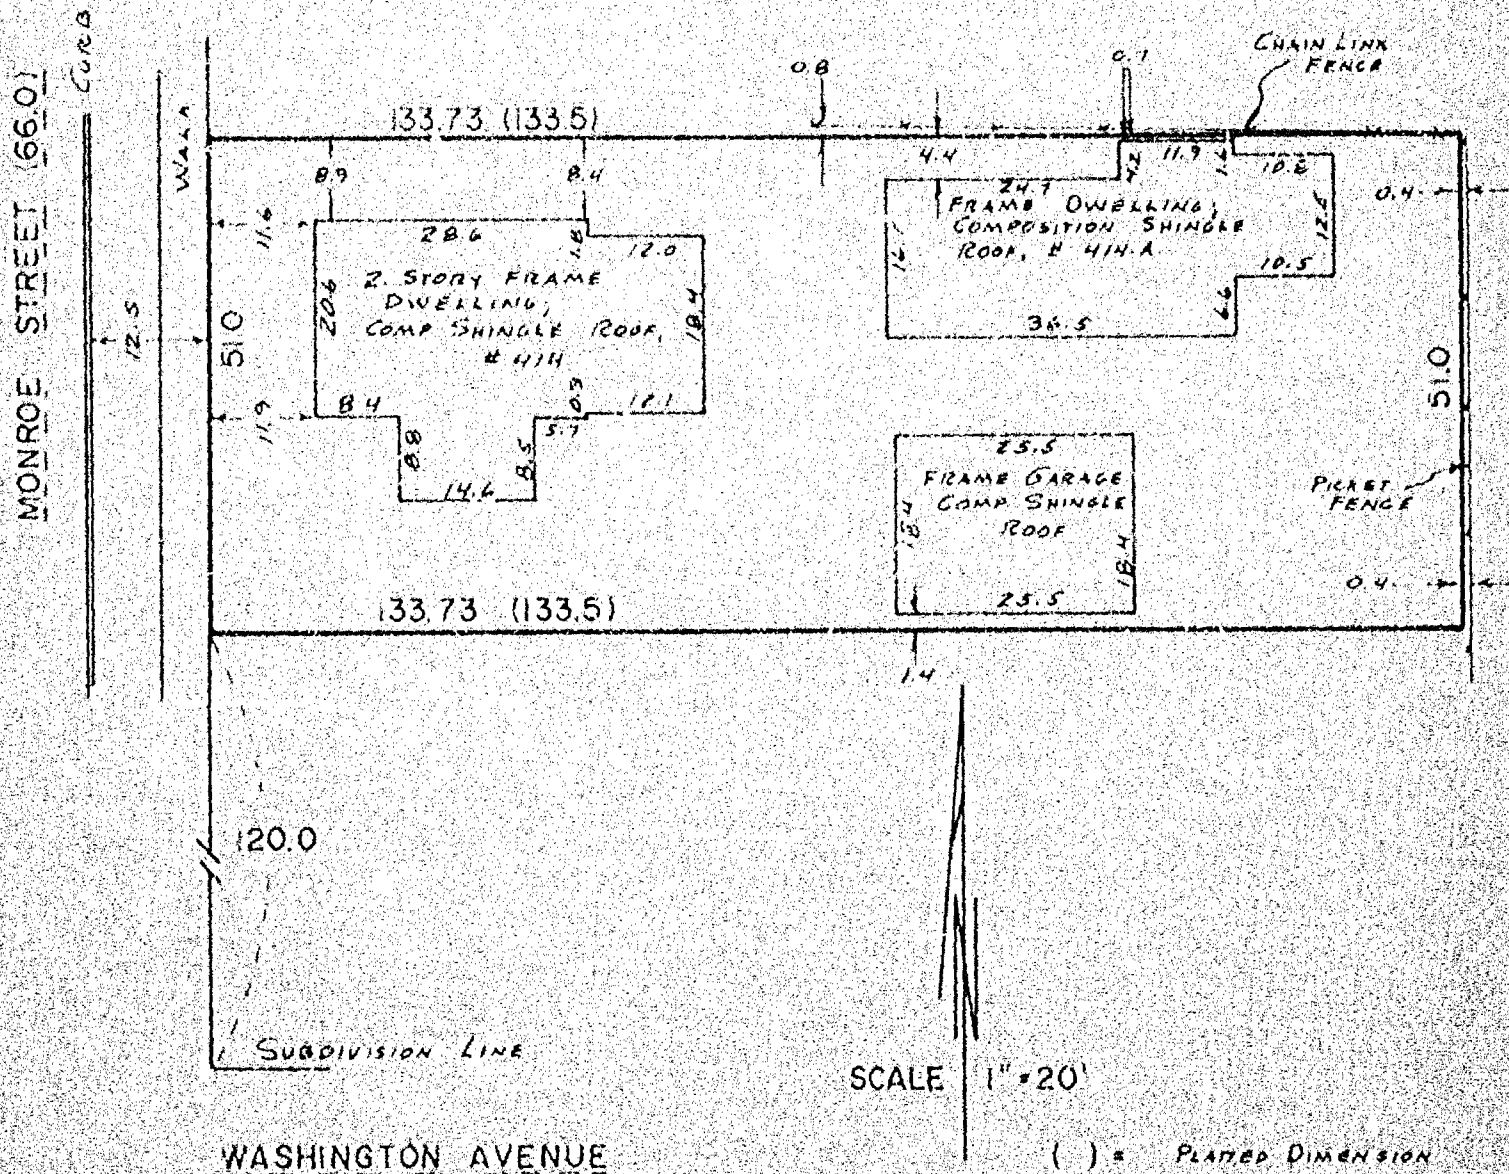


I Certify that I have surveyed the above described property (Property), and the above map is a true representation thereof and shows the size and location of the Property, its exterior boundaries, the location and dimensions of all visible structures thereon, boundary, fences, apparent easements and roadways and visible encroachments, if any.

This survey is made for the exclusive use of the present owners of the Property, and also those who purchase, mortgage, or guarantee the title thereto, within one (1) year from date hereof.



national survey & engineering

417 NORTH SAWYER STREET / P.O. BOX 2963
OSHKOSH, WISCONSIN 54903
(414) 426-2800

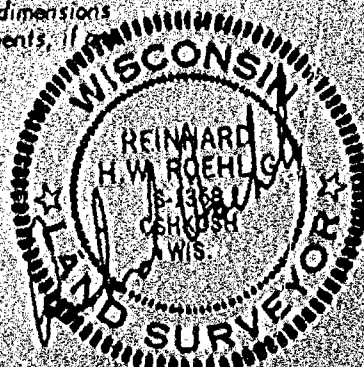

PLAT OF SURVEY

KNOWN AS 2327 MOUNT VERNON STREET, BEING LOT 19 AND THE EAST 1/2 OF THAT PART OF AN ALLEY (NOW VACATED) LYING WEST OF AND ADJACENT TO SAID LOT 19 AND BETWEEN THE EXTENDED NORTH AND SOUTH LINES OF SAID LOT 19, ALL IN BLOCK 12 IN THE SECOND ADDITION TO THE PLAT OF THE INTERURBAN LAND COMPANY, 15th WARD, CITY OF OSHKOSH, WINNEBAGO COUNTY, WISCONSIN.

NOVEMBER 1, 1983


SURVEY FOR OSHKOSH SAVINGS
APPLICANT: GARY MARTZKE
MONUMENT WAIVER ON FILE

SURVEY NO. 1343-M

LIBBEY AVENUE

SCALE 1" = 20'

() = PLATED DIMENSION

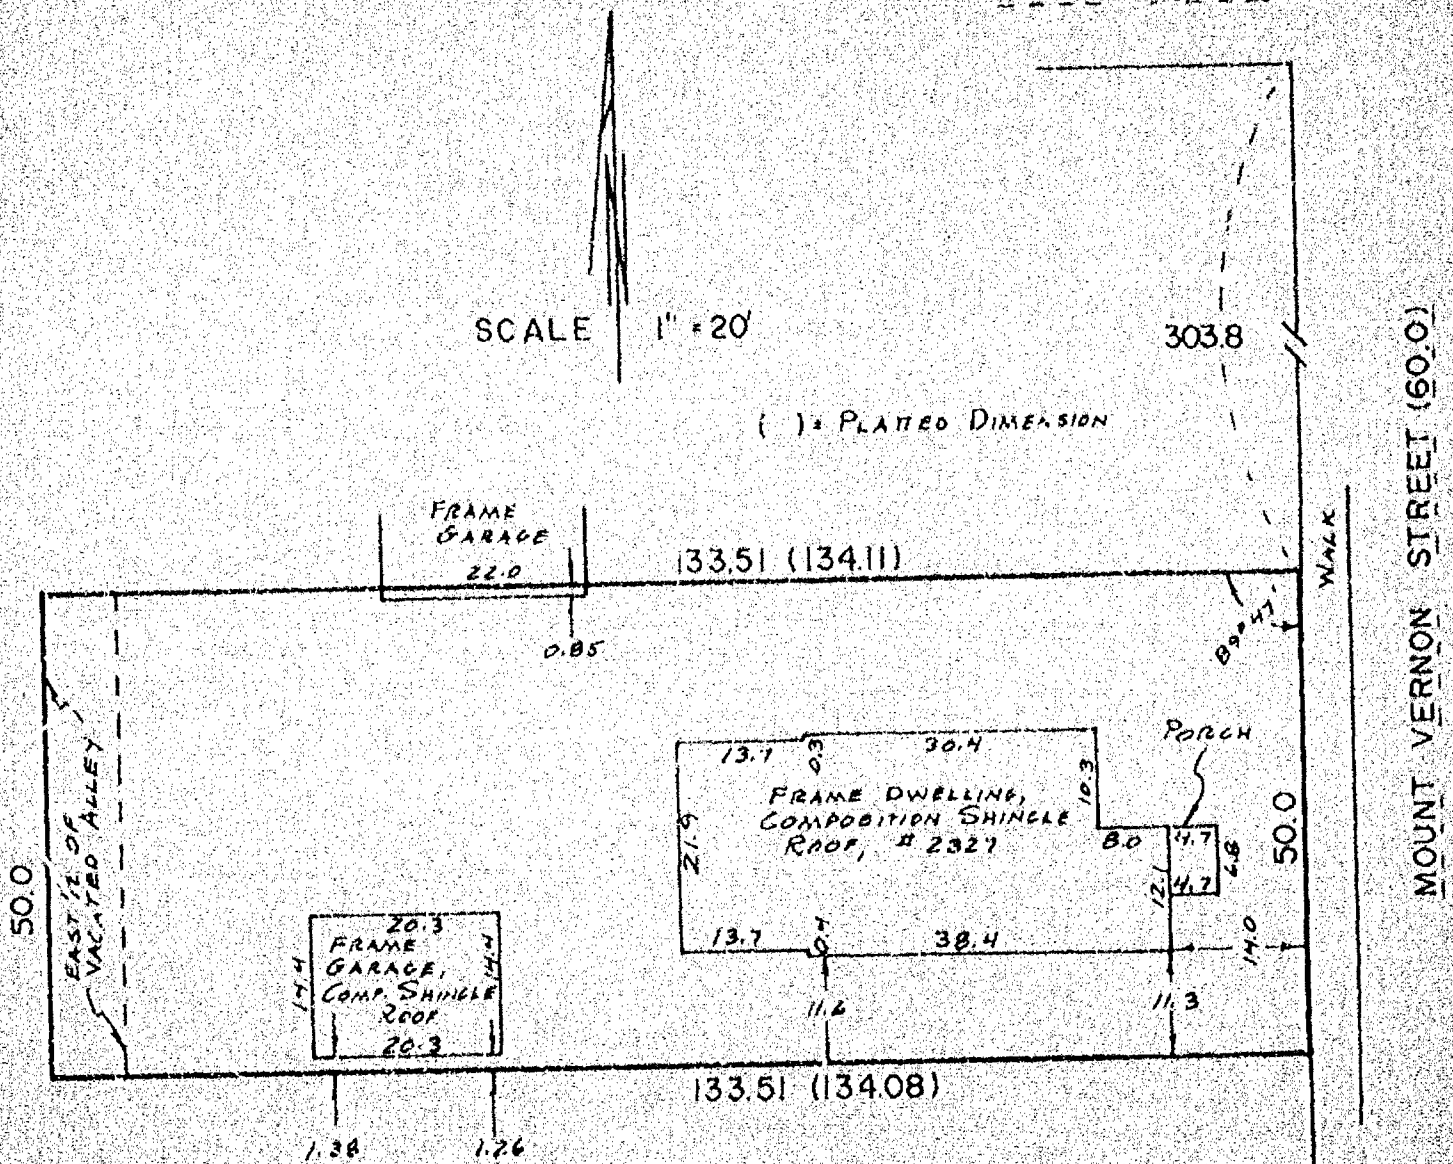

I Certify that I have surveyed the above described property (Property), and the above map is a true representation thereof and shows the size and location of the Property, its exterior boundaries, the location and dimensions of all visible structures thereon, boundary, fences, apparent easements and roadways and visible encroachments, if any. This survey is made for the exclusive use of the present owners of the Property, and also those who purchase, mortgage, or guarantee the title thereto, within one (1) year from date hereof.



national survey & engineering
417 NORTH SAWYER STREET / P.O. BOX 2963
OSHKOSH, WISCONSIN 54903
(414) 426-2800




PLAT OF SURVEY

KNOWN AS 67 FRANKFORT STREET, BEING THE SOUTHERLY 60.0 FT. OF THE NORTHERLY 135.00 FT. OF THE EASTERLY 120.0 FT. OF LOT 2 IN BLOCK 35 IN THE 8TH WARD, CITY OF OSHKOSH, WINNEBAGO COUNTY, WISCONSIN, PER LEACH'S MAP OF 1894, THAT PART OF LOT 2 OF BLOCK 35 IN THE 8TH WARD, CITY OF OSHKOSH, WINNEBAGO COUNTY, WISCONSIN PER LEACH'S MAP OF 1894 DESCRIBED AS FOLLOWS: COMMENCING AT THE N.E. CORNER OF SAID LOT, THENCE SOUTHERLY ALONG THE EASTERLY LINE OF SAID LOT 75.0 FT., THE PLACE OF BEGINNING, THENCE WESTERLY, PARALLEL WITH THE NORTHERLY LINE OF SAID LOT 64.05 FT., THENCE NORTH 2.5 FT. TO A POINT THAT IS 64.05 FT. WESTERLY OF THE PLACE OF BEGINNING, THENCE EASTERLY 64.05 FT. TO THE PLACE OF BEGINNING.

NOVEMBER 1, 1983 SURVEY FOR OSHKOSH SAVINGS
APPLICANT: SCOTT TRIPPE
MONUMENT WAIVER
ON FILE.

HARNEY AVENUE SURVEY NO. 1344-M

SCALE 1" = 20'

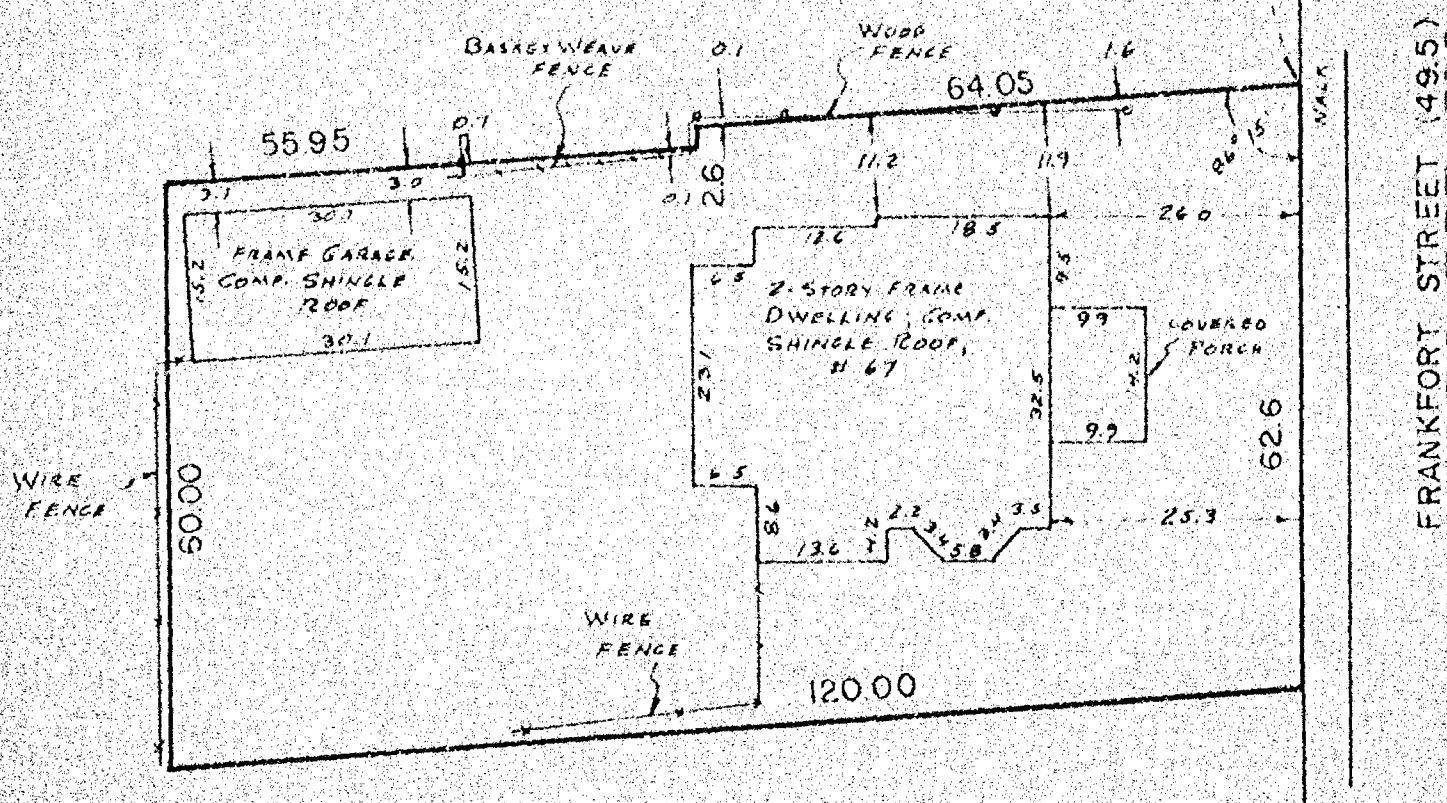

PLAT OF SURVEY


KNOWN AS 1460 MARICOPA DRIVE, BEING LOT 743 IN THE 5th ADDITION TO NESTHAVEN,
13th WARD, CITY OF OSHKOSH, WINNEBAGO COUNTY, WISCONSIN.

NOVEMBER 3, 1993

SURVEY FOR OSHKOSH SAVINGS
APPLICANT: KISSINGER
MONUMENT WAIVER ON FILE

SURVEY NO. 1346

MARICOPA DRIVE (60.0)

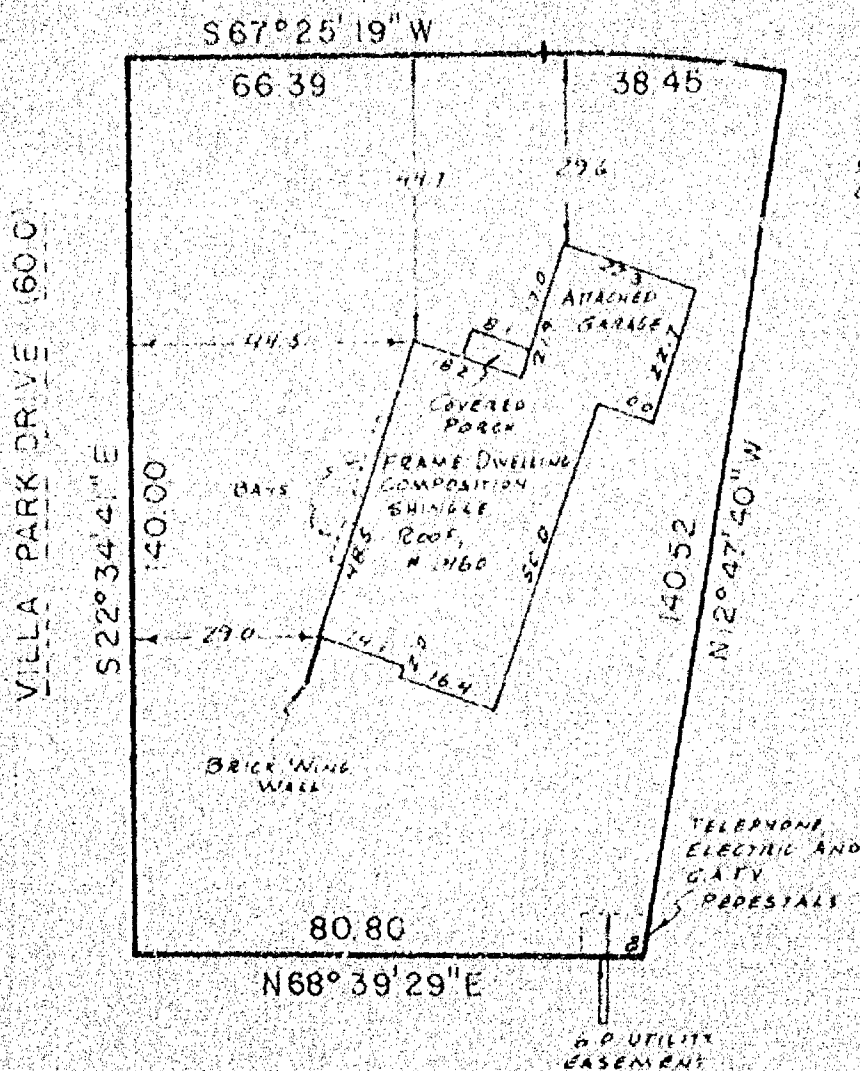

CURVE DATA

R = 225.20
C = 5720' 18.495" W
38.41
Δ = 3841.01"

SCALE
1" = 30'

I Certify that I have surveyed the above described property (Property), and the above map is a true representation thereof and shows the size and location of the Property, its exterior boundaries, the location and dimensions of all visible structures thereon, boundary, fences, apparent easements and roadways and visible encroachments, if any. This survey is made for the exclusive use of the present owners of the Property, and also those who purchase, mortgage, or guarantee the title thereto, within one (1) year from date hereof.



national survey & engineering

417 NORTH SAWYER STREET / PO BOX 2963
OSHKOSH, WISCONSIN 54903
(414) 426-2800



PLAT OF SURVEY


KNOWN AS 724 JACKSON STREET, BEING THE SOUTH 1/2 OF LOT 14 AND THE NORTH 15.75 FT. OF LOT 15, ALL IN BLOCK 75 OF GOTT, READ AND EIGMEL'S ADDITION, IN THE 10TH WARD, CITY OF OSHKOSH, WINNEBAGO COUNTY, WISCONSIN, PER LEACH'S MAP OF 1894.

NOVEMBER 8, 1983

SURVEY FOR OSHKOSH SAVINGS
APPLICANT: THOMAS HELFRICH
MONUMENT WAIVER ON FILE

SURVEY NO. 1350-M

SCALE 1" = 20'

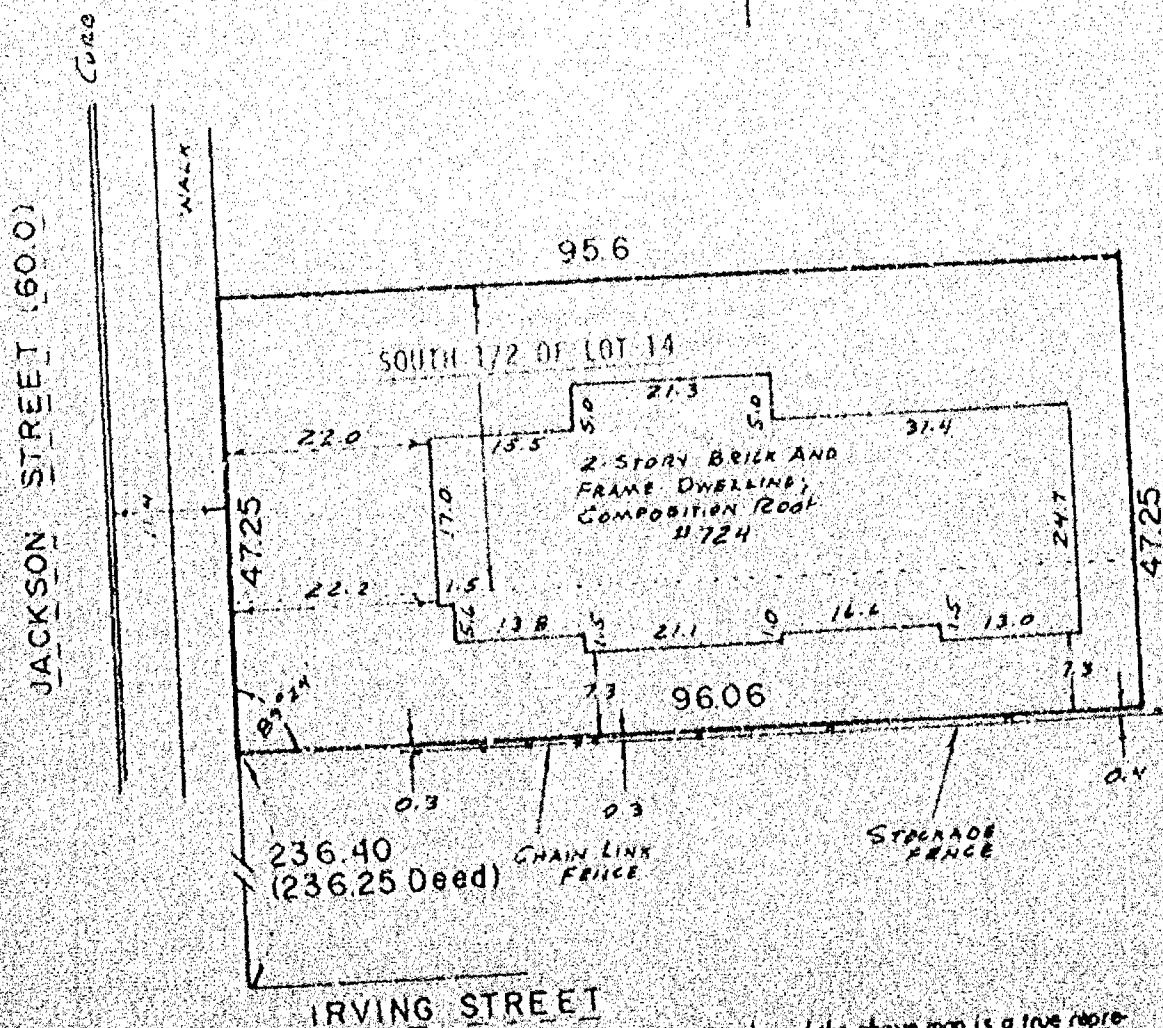

I Certify that I have surveyed the above described property (Property), and the above map is a true representation thereof and shows the size and location of the Property, its exterior boundaries, the location and dimensions of all visible structures thereon, boundary, fences, apparent easements and roadways and visible encroachments, if any. This survey is made for the exclusive use of the present owners of the Property, and also those who purchase, mortgage, or guarantee the title thereto, within one (1) year from date hereof.



national survey & engineering

417 NORTH SAWYER STREET / PO. BOX 2963
OSHKOSH, WISCONSIN 54903
(414) 426-2800


PLAT OF SURVEY

KNOWN AS 1221 ONTARIO STREET, BEING L 1 IN BLOCK #1 OF MASTERSON'S SUBDIVISION,
IN THE 12TH WARD, CITY OF OSHKOSH, WI DAGO COUNTY, WISCONSIN.


NOVEMBER 9, 1983

SURVEY FOR OSHKOSH SAVINGS
APPLICANT: SARA ROGERS
MONUMENT WAIVER ON FILE

SURVEY NO. 1348-M

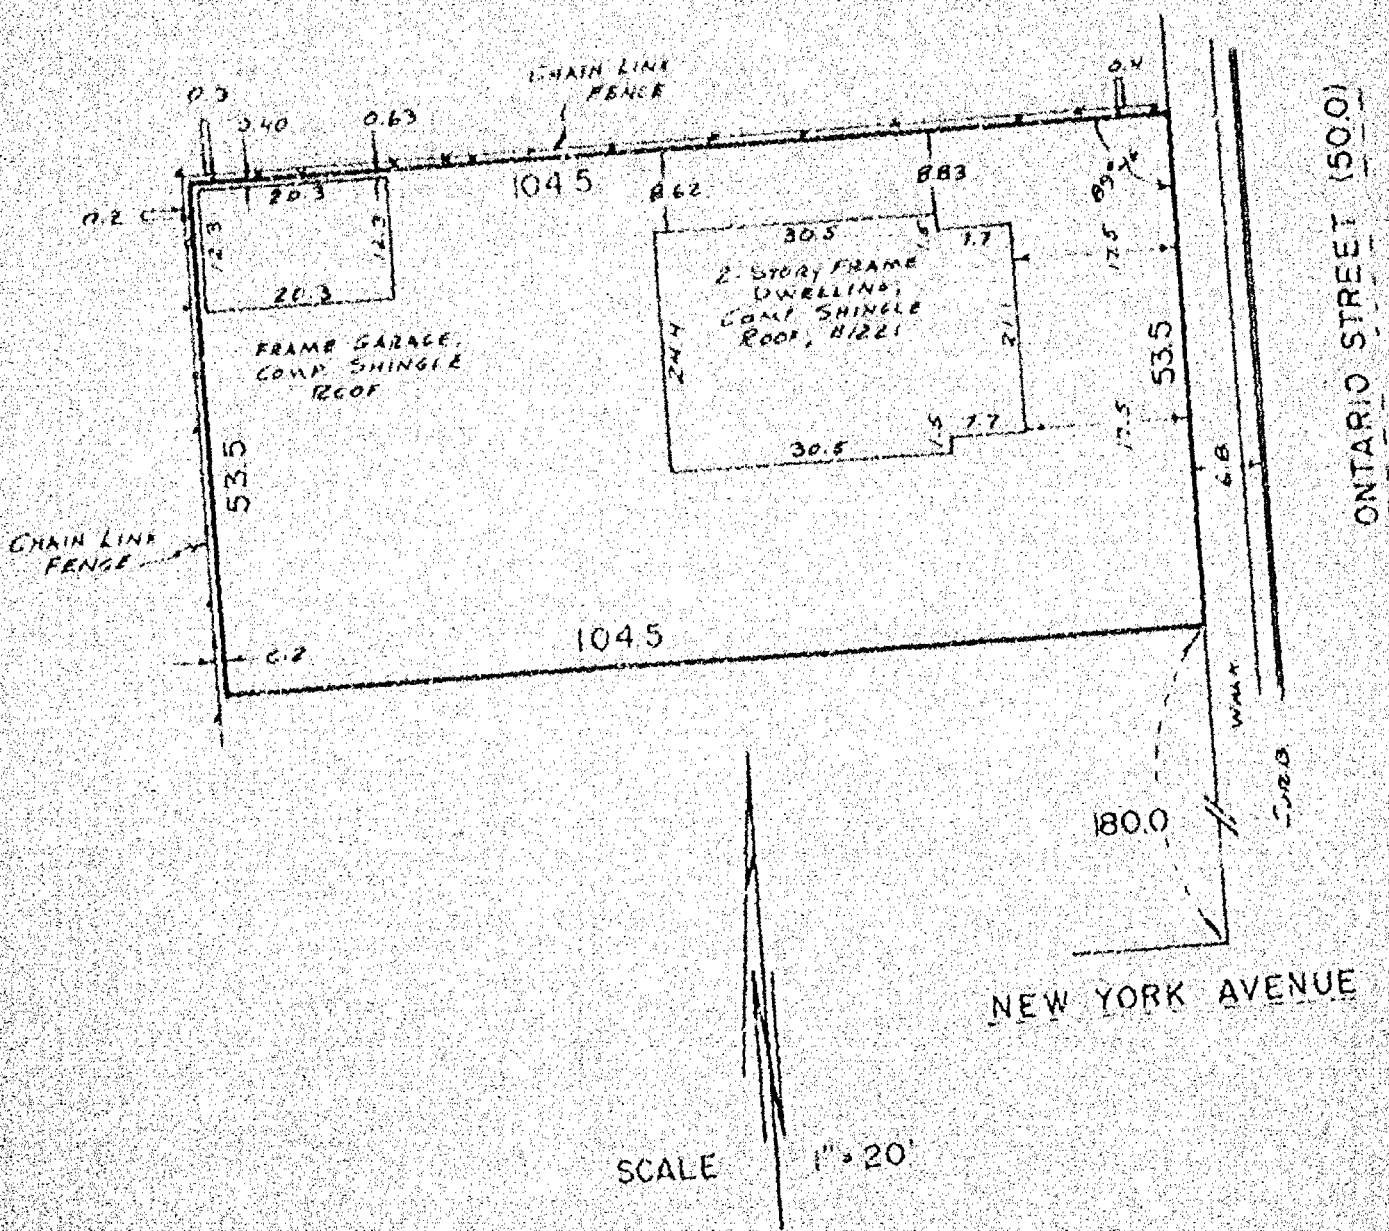

I Certify that I have surveyed the above described property (Property), and the above map is a true representation thereof and shows the size and location of the Property, its exterior boundaries, the location and dimensions of all visible structures thereon, boundary, fences, apparent easements and roadways and visible encroachments, if any. This survey is made for the exclusive use of the present owners of the Property, and also those who purchase, mortgage, or guarantee the title thereto, within one (1) year from date hereof.

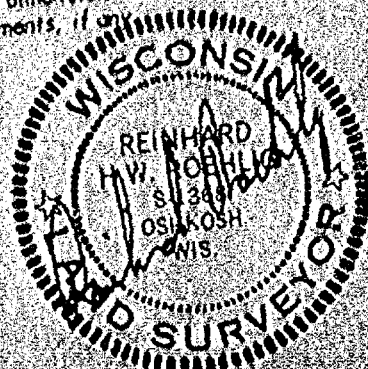

national survey & engineering
417 NORTH SAWYER STREET / P.O. BOX 2963
OSHKOSH, WISCONSIN 54903
(414) 426-2800


PLAT OF SURVEY

KNOWN AS 1221 ONTARIO STREET, BEING LOT 3 IN BLOCK #1 OF MASTERSON'S SUBDIVISION, IN THE 12TH WARD, CITY OF OSHKOSH, WINNEBAGO COUNTY, WISCONSIN.

NOVEMBER 9, 1983

SURVEY FOR OSHKOSH SAVINGS
APPLICANT: LARA ROGERS
MONUMENT WAIVER ON FILE

SURVEY NO. 1348-11

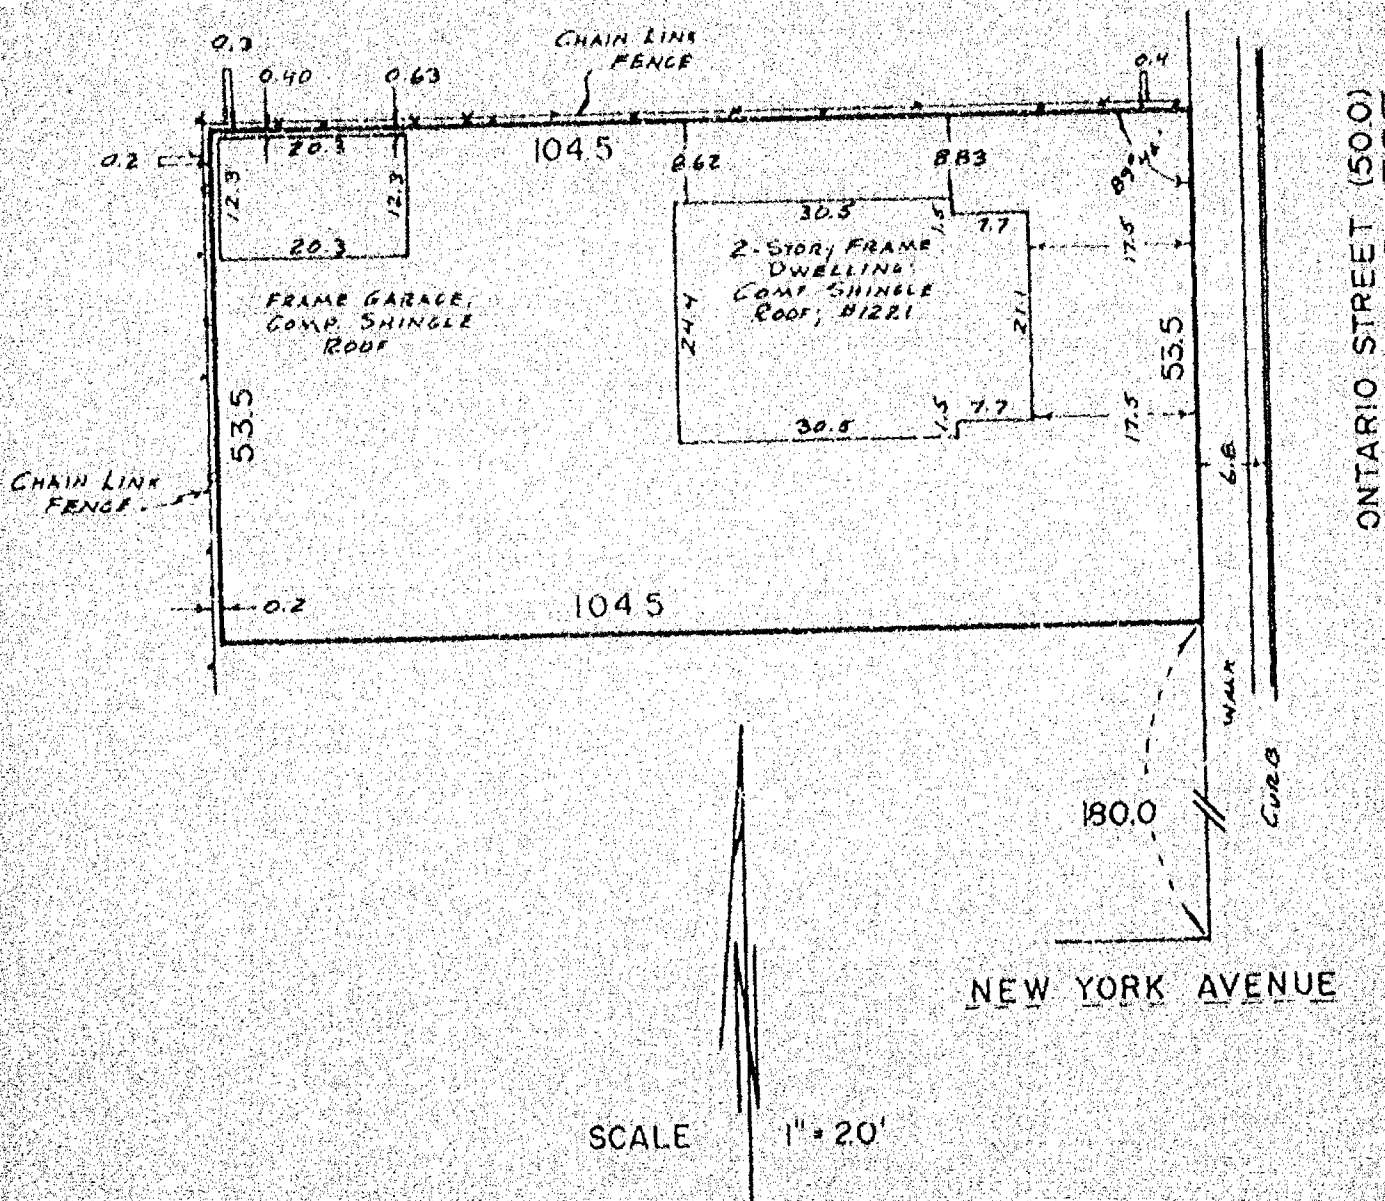

I Certify that I have surveyed the above described property (Property), and the above map is a true representation thereof and shows the size and location of the Property, its exterior boundaries, the location and dimensions of all visible structures thereon, boundary, fences, apparent easements and roadways and visible encroachments, if any. This survey is made for the exclusive use of the present owners of the Property, and also those who purchase, mortgage, or guarantee the title thereto, within one (1) year from date hereof.



National Survey & Engineering

417 NORTH SAWYER STREET / P.O. BOX 2963
OSHKOSH, WISCONSIN 54903
(414) 426-2800



PLAT OF SURVEY

KNOWN AS 320 DALE STREET, BEING THE SOUTH 50.0 FT. OF LOT 2 IN PARKINSON'S SUBDIVISION OF LOTS 17 THROUGH 20 IN BLOCK 42, PER LEACH'S MAP OF 1894, IN THE 4TH WARD, CITY OF OSHKOSH, WINNEBAGO COUNTY, WISCONSIN, EXCEPT THE WEST 20.0 FT. AND EXCEPT THE EAST 50.0 FT.


NOVEMBER 11, 1983

SURVEY FOR OSHKOSH SAVINGS

SURVEY NO. 1342-H

APPLICANT: RUDINGER

MONUMENT WAIVER ON FILE

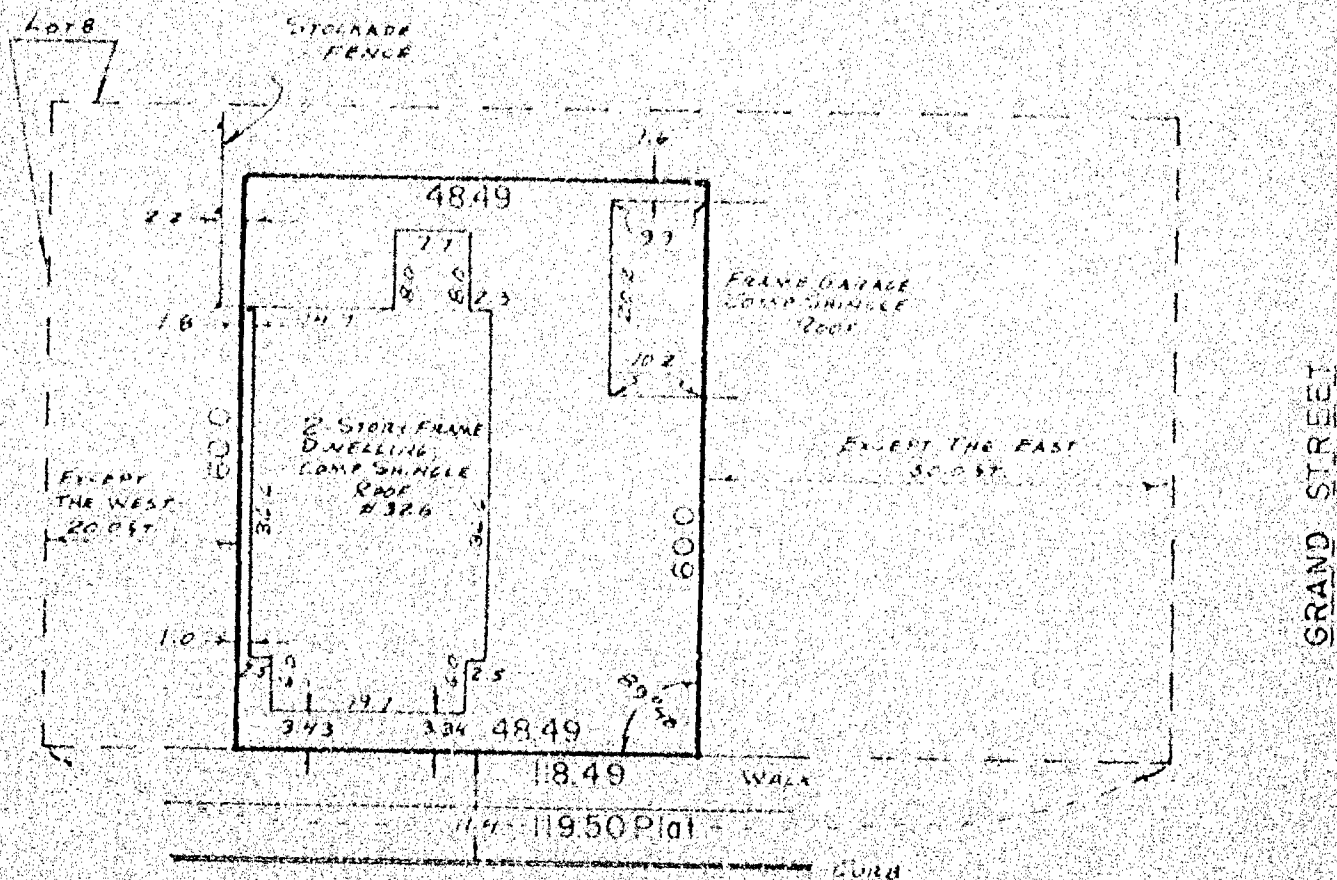

DALE AVENUE (50 FT)

SCALE 1" = 20'

I Certify that I have surveyed the above described property (Property), and the above map is a true representation thereof and shows the size and location of the Property, its exterior boundaries, the location and dimensions of all visible structures thereon, boundary, fences, apparent easements and roadways and visible encroachments, if any. This survey is made for the exclusive use of the present owners of the Property, and also those who purchase, mortgage, or guarantee the title thereto, within one (1) year from date hereof.



national survey & engineering

417 NORTH SAWYER STREET / P.O. BOX 2963
OSHKOSH, WISCONSIN 54903
(414) 426-2800




PLAT OF SURVEY

KNOWN AS 342 WEST 16th AVENUE, BEING LOT 16 IN BLOCK 73 IN THE PLAT OF THE ORIGINAL THIRD WARD, IN THE 13th WARD, CITY OF OSHKOSH, PER LEACH'S MAP OF 1894 AND NOW IN THE 3rd WARD OF SAID CITY, WINNEBAGO COUNTY, WISCONSIN.

NOVEMBER 11, 1983

SURVEY FOR OSHKOSH SAVINGS
APPLICANT: DOLORES MOEN
MONUMENT WAIVER ON FILE

SURVEY NO. 1353-H

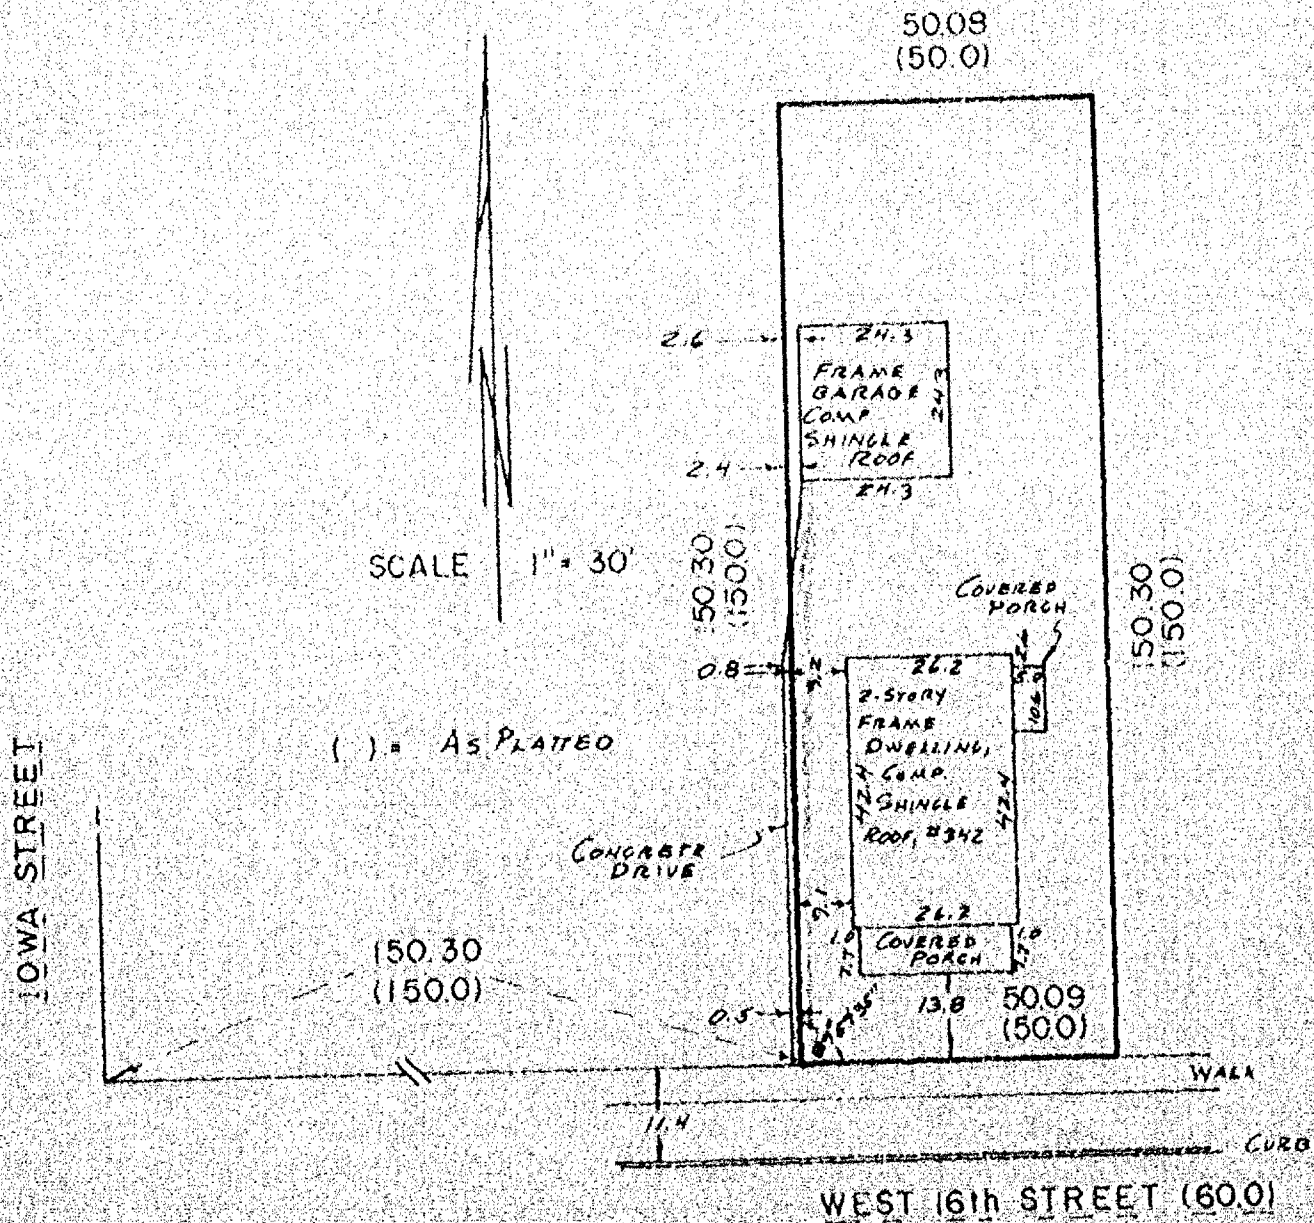

I Certify that I have surveyed the above described property (Property), and the above map is a true representation thereof and shows the size and location of the Property, its exterior boundaries, the location and dimensions of all visible structures thereon, boundary, fences, apparent easements and roadways and visible encroachments, if any. This survey is made for the exclusive use of the present owners of the Property, and also those who purchase, mortgage, or guarantee the title thereto, within one (1) year from date hereof.



national survey & engineering
417 NORTH SAWYER STREET / P.O. BOX 2983
OSHKOSH, WISCONSIN 54903
(414) 426-2800




PLAT OF SURVEY

KNOWN AS 1032 BOWEN STREET, BEING LOT 11 AND THE NORTH 1/2 OF LOT 10 IN THE GLOBE ADDITION NO. 1 IN THE 11TH WARD, CITY OF OSHKOSH, WINNEBAGO COUNTY, WISCONSIN.

NOVEMBER 16, 1983

SURVEY FOR OSHKOSH SAVINGS
APPLICANT: GREGORY CHAPIN
MONUMENT WAIVER ON FILE

SURVEY NO. 1357-M

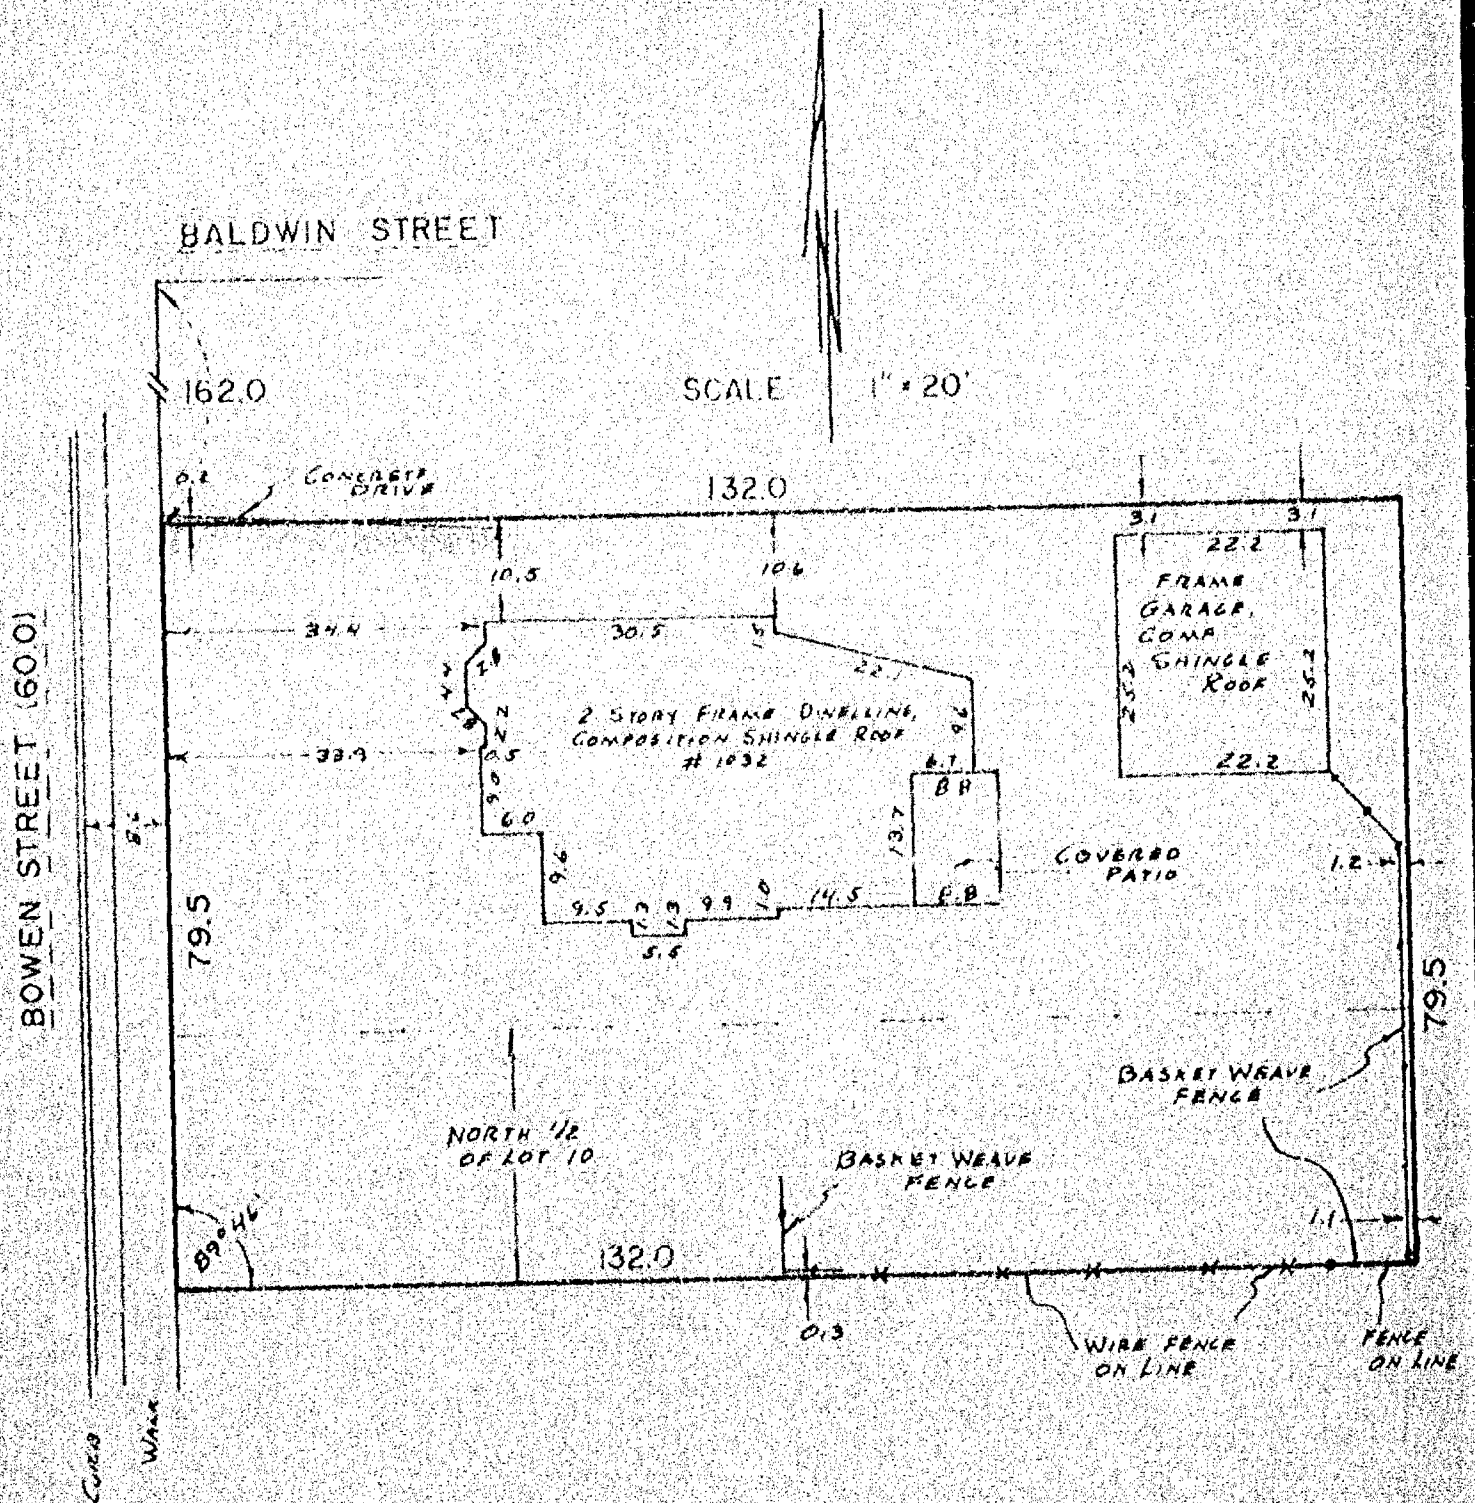

I Certify that I have surveyed the above described property (Property), and the above map is a true representation thereof and shows the size and location of the Property, its exterior boundaries, the location and dimensions of all visible structures thereon, boundary, fences, apparent easements and roadways and visible encroachments, if any. This survey is made for the exclusive use of the present owners of the Property, and also those who purchase, mortgage, or guarantee the title thereto, within one (1) year from date hereof.



national survey & engineering

417 NORTH SAWYER STREET / P.O. BOX 2963
OSHKOSH, WISCONSIN 54903
(414) 426-2850



PLAT OF SURVEY

KNOWN AS 307-307A MERRITT AVENUE, BEING THE NORTH 30.0 FT. OF THE EAST 50.0 FT. OF THE WEST 100.0 FT. OF LOT 22 AND THE EAST 50.0 FT. FRONT AND REAR, OF THE WEST 100.0 FT. OF LOT 23, ALL IN BLOCK 39 IN THE 4TH WARD, CITY OF OSHKOSH, PER LEACH'S MAP OF 1894, CITY OF OSHKOSH, WINNEBAGO COUNTY, WISCONSIN.


NOVEMBER 16, 1983

SURVEY FOR OSHKOSH SAVINGS
APPLICANT: RICHARD ANDERSON
MONUMENT WAIVER ON FILE

SURVEY NO. 1356-M

MERRITT AVENUE (49.5)

MADISON STREET

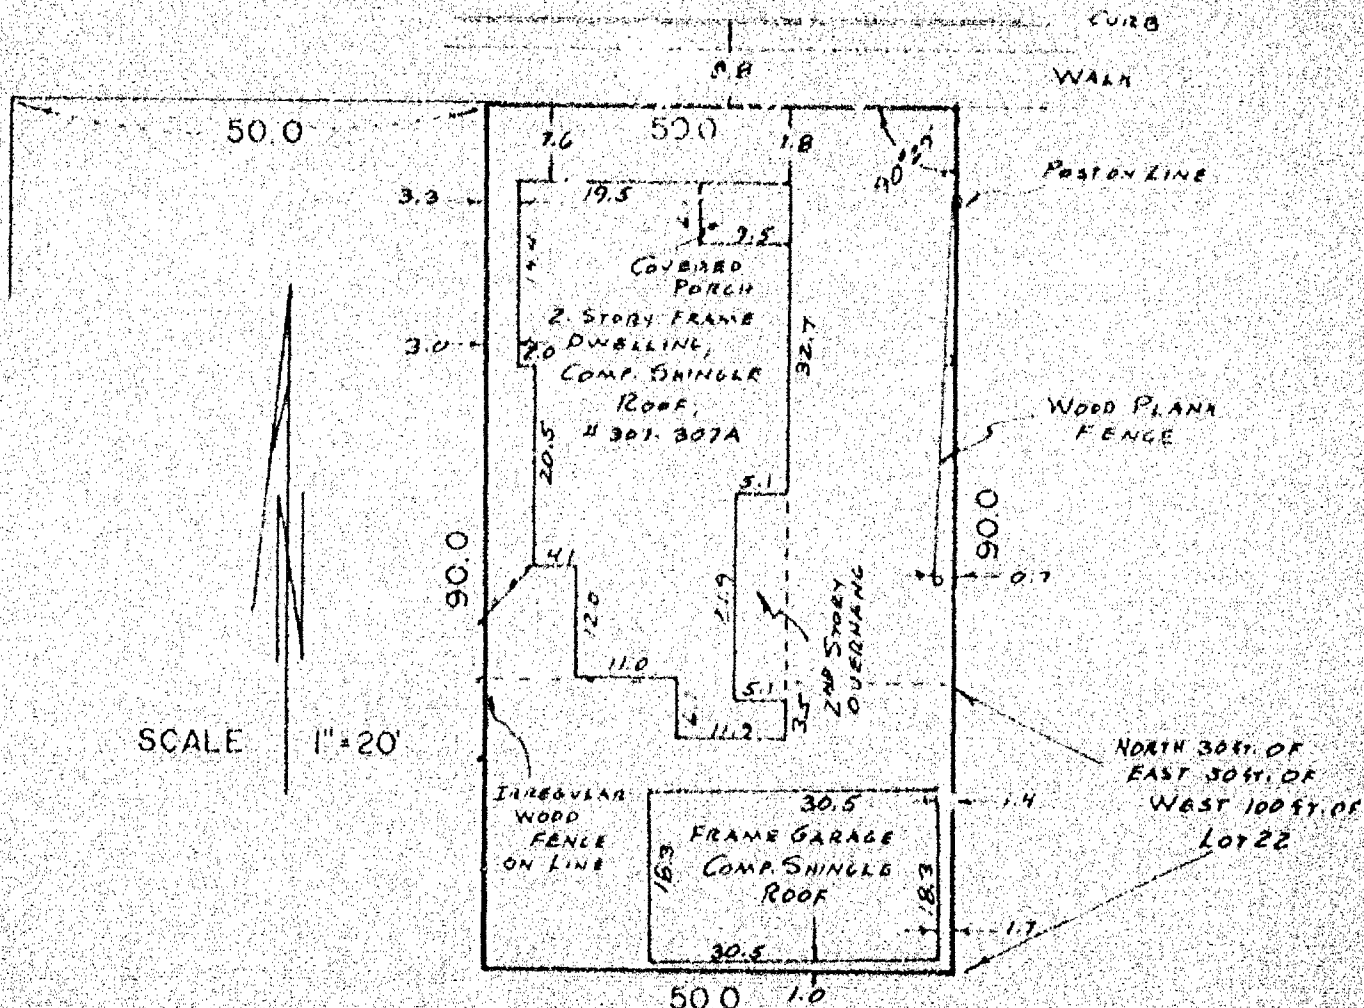

I Certify that I have surveyed the above described property (Property), and the above map is a true representation thereof and shows the size and location of the Property, its exterior boundaries, the location and dimensions of all visible structures thereon, boundary, fences, apparent easements and roadways and visible encroachments, if any. This survey is made for the exclusive use of the present owners of the Property, and also those who purchase, mortgage, or guarantee the title thereto, within one (1) year from date hereof.



national survey & engineering
417 NORTH SAWYER STREET / P.O. BOX 2963
OSHKOSH, WISCONSIN 54903
(414) 426-2800




PLAT OF SURVEY

KNOWN AS 1880 OAKWOOD ROAD, BEING LOT 677 IN THE 4th ADDITION TO WESTHAVEN,
IN THE 13th WARD, CITY OF OSHKOSH, WINNEBAGO COUNTY, WISCONSIN,

NOVEMBER 16, 1983

SURVEY FOR OSHKOSH SAVINGS
APPLICANTS FRANK NEEDLETON
MONUMENT WAIVED ON FILE

SURVEY NO. 1359-H

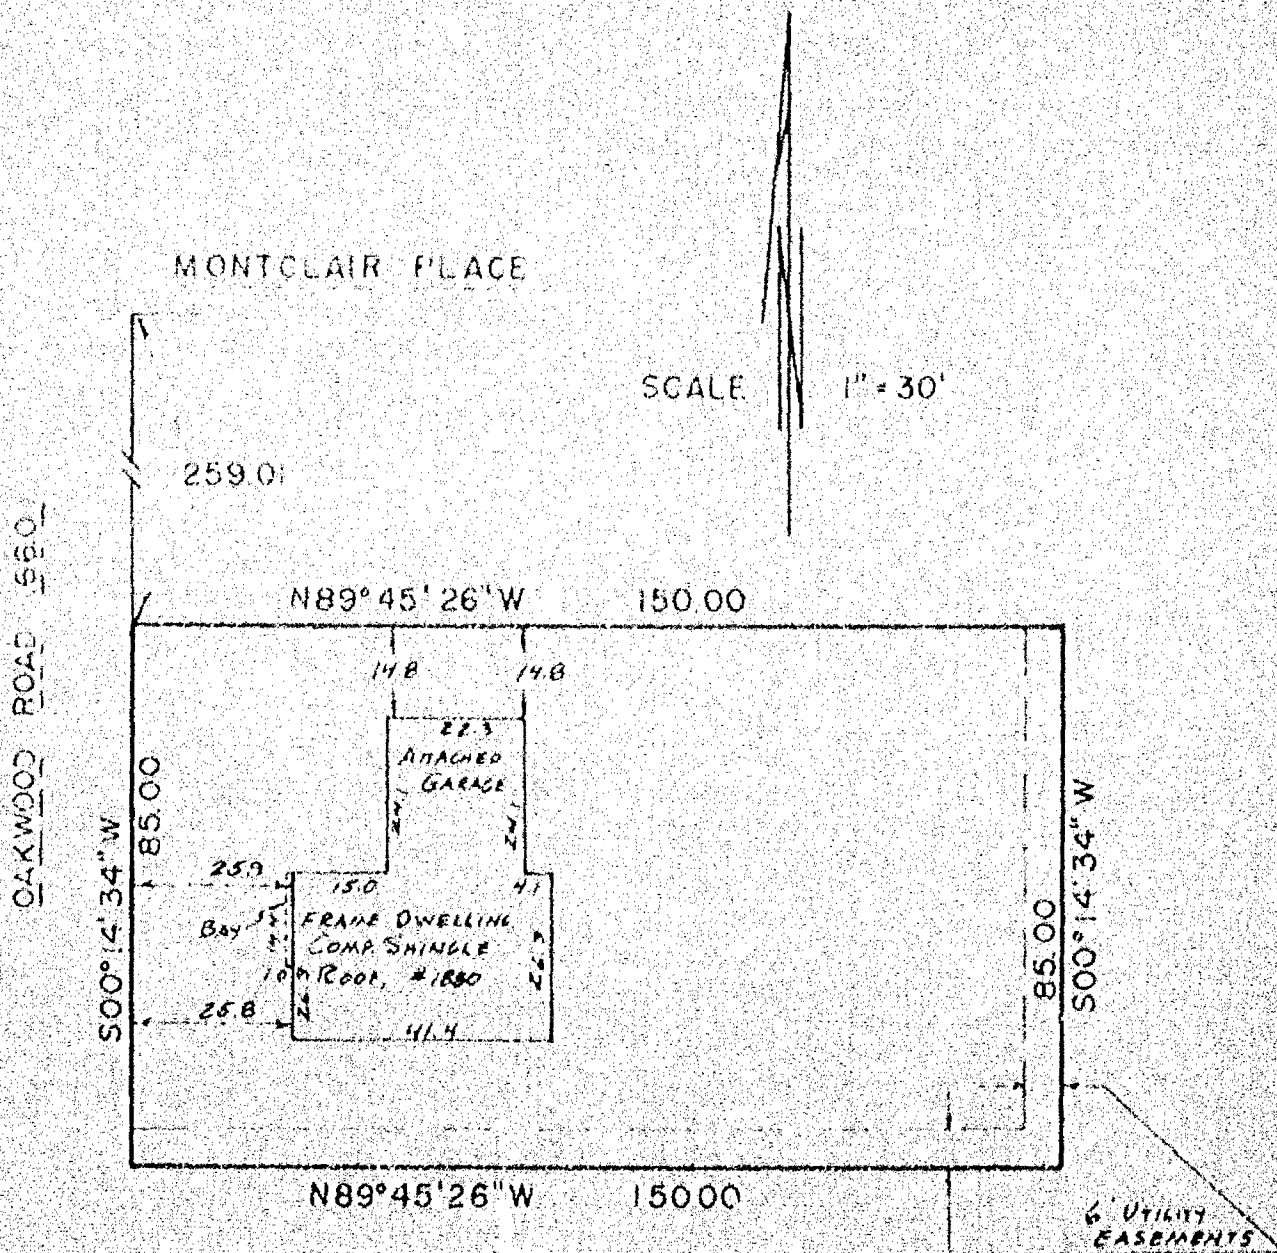

I Certify that I have surveyed the above described property (Property), and the above map is a true representation thereof and shows the size and location of the Property, its exterior boundaries, the location and dimensions of all visible structures thereon, boundary, fences, apparent easements and roadways and visible encroachments, if any.

This survey is made for the exclusive use of the present owners of the Property, and also those who purchase, mortgage, or guarantee the title thereto, within one (1) year from date hereof.



national survey & engineering

417 NORTH SAWYER STREET / P.O. BOX 2963
OSHKOSH, WISCONSIN 54903

(414) 428-2800




PLAT OF SURVEY

KNOWN AS 1406 MONROE STREET, BEING LOT 2 IN BLOCK 19 OF PLEASANT HOME LAND COMPANY'S 2ND ADDITION, IN THE 15TH WARD, CITY OF OSHKOSH, WINNEBAGO COUNTY, WISCONSIN.

NOVEMBER 22, 1983

SURVEY FOR OSHKOSH SAVINGS SURVEY NO. 1060-M
APPLICANT: JEFFREY CHRISTIANSON
MONUMENT WAIVER ON FILE

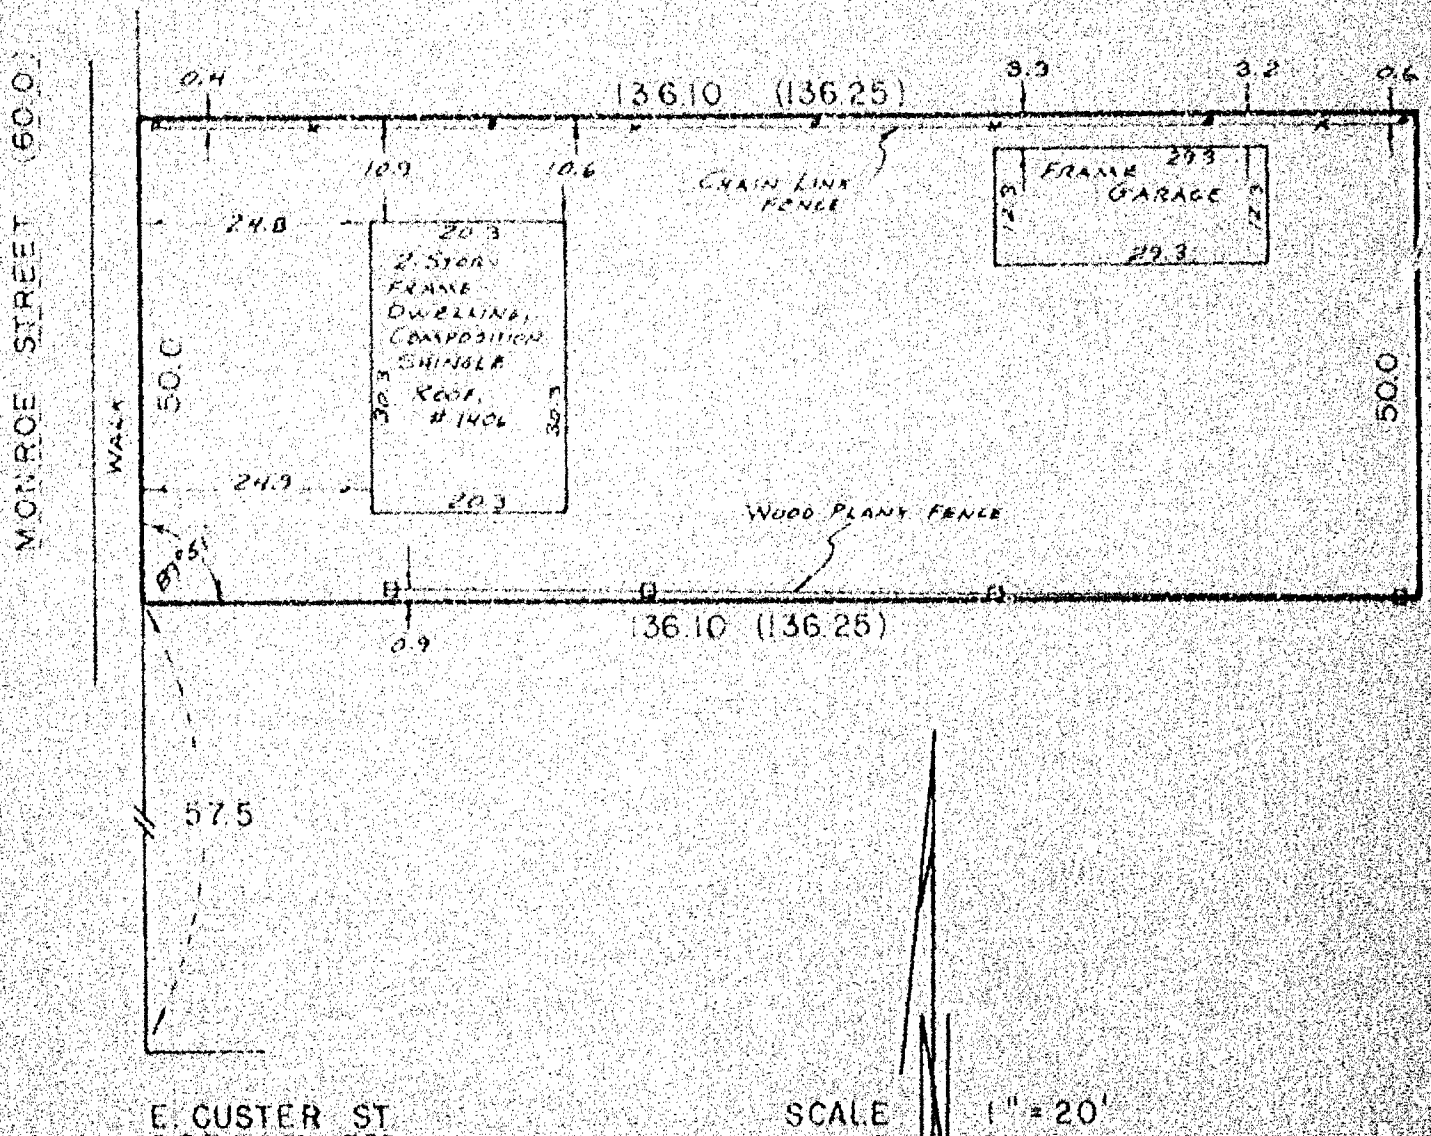

I Certify that I have surveyed the above described property (Property), and the above map is a true representation thereof and shows the size and location of the Property, its exterior boundaries, the location and dimensions of all visible structures thereon, boundary, fences, apparent easements and roadways and visible encroachments, if any. This survey is made for the exclusive use of the present owners of the Property, and also those who purchase, mortgage, or guarantee the title thereto, within one (1) year from date hereof.



national survey & engineering
417 NORTH SAWYER STREET / P.O. BOX 2963
OSHKOSH, WISCONSIN 54903
(414) 426-2800

