
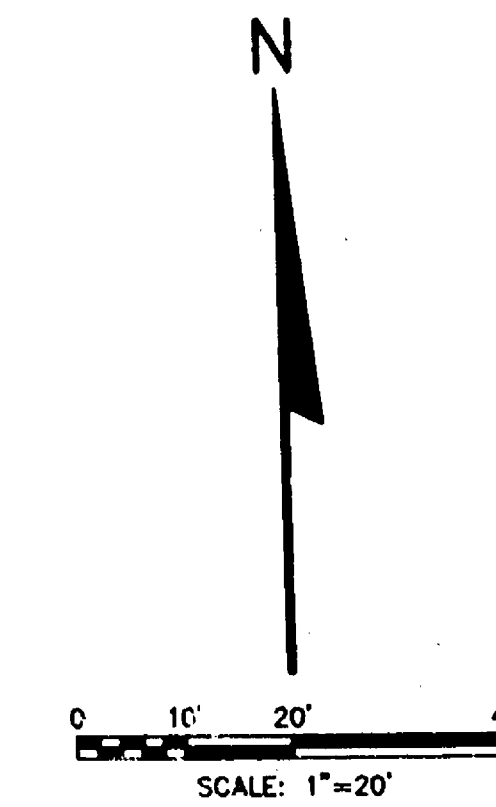


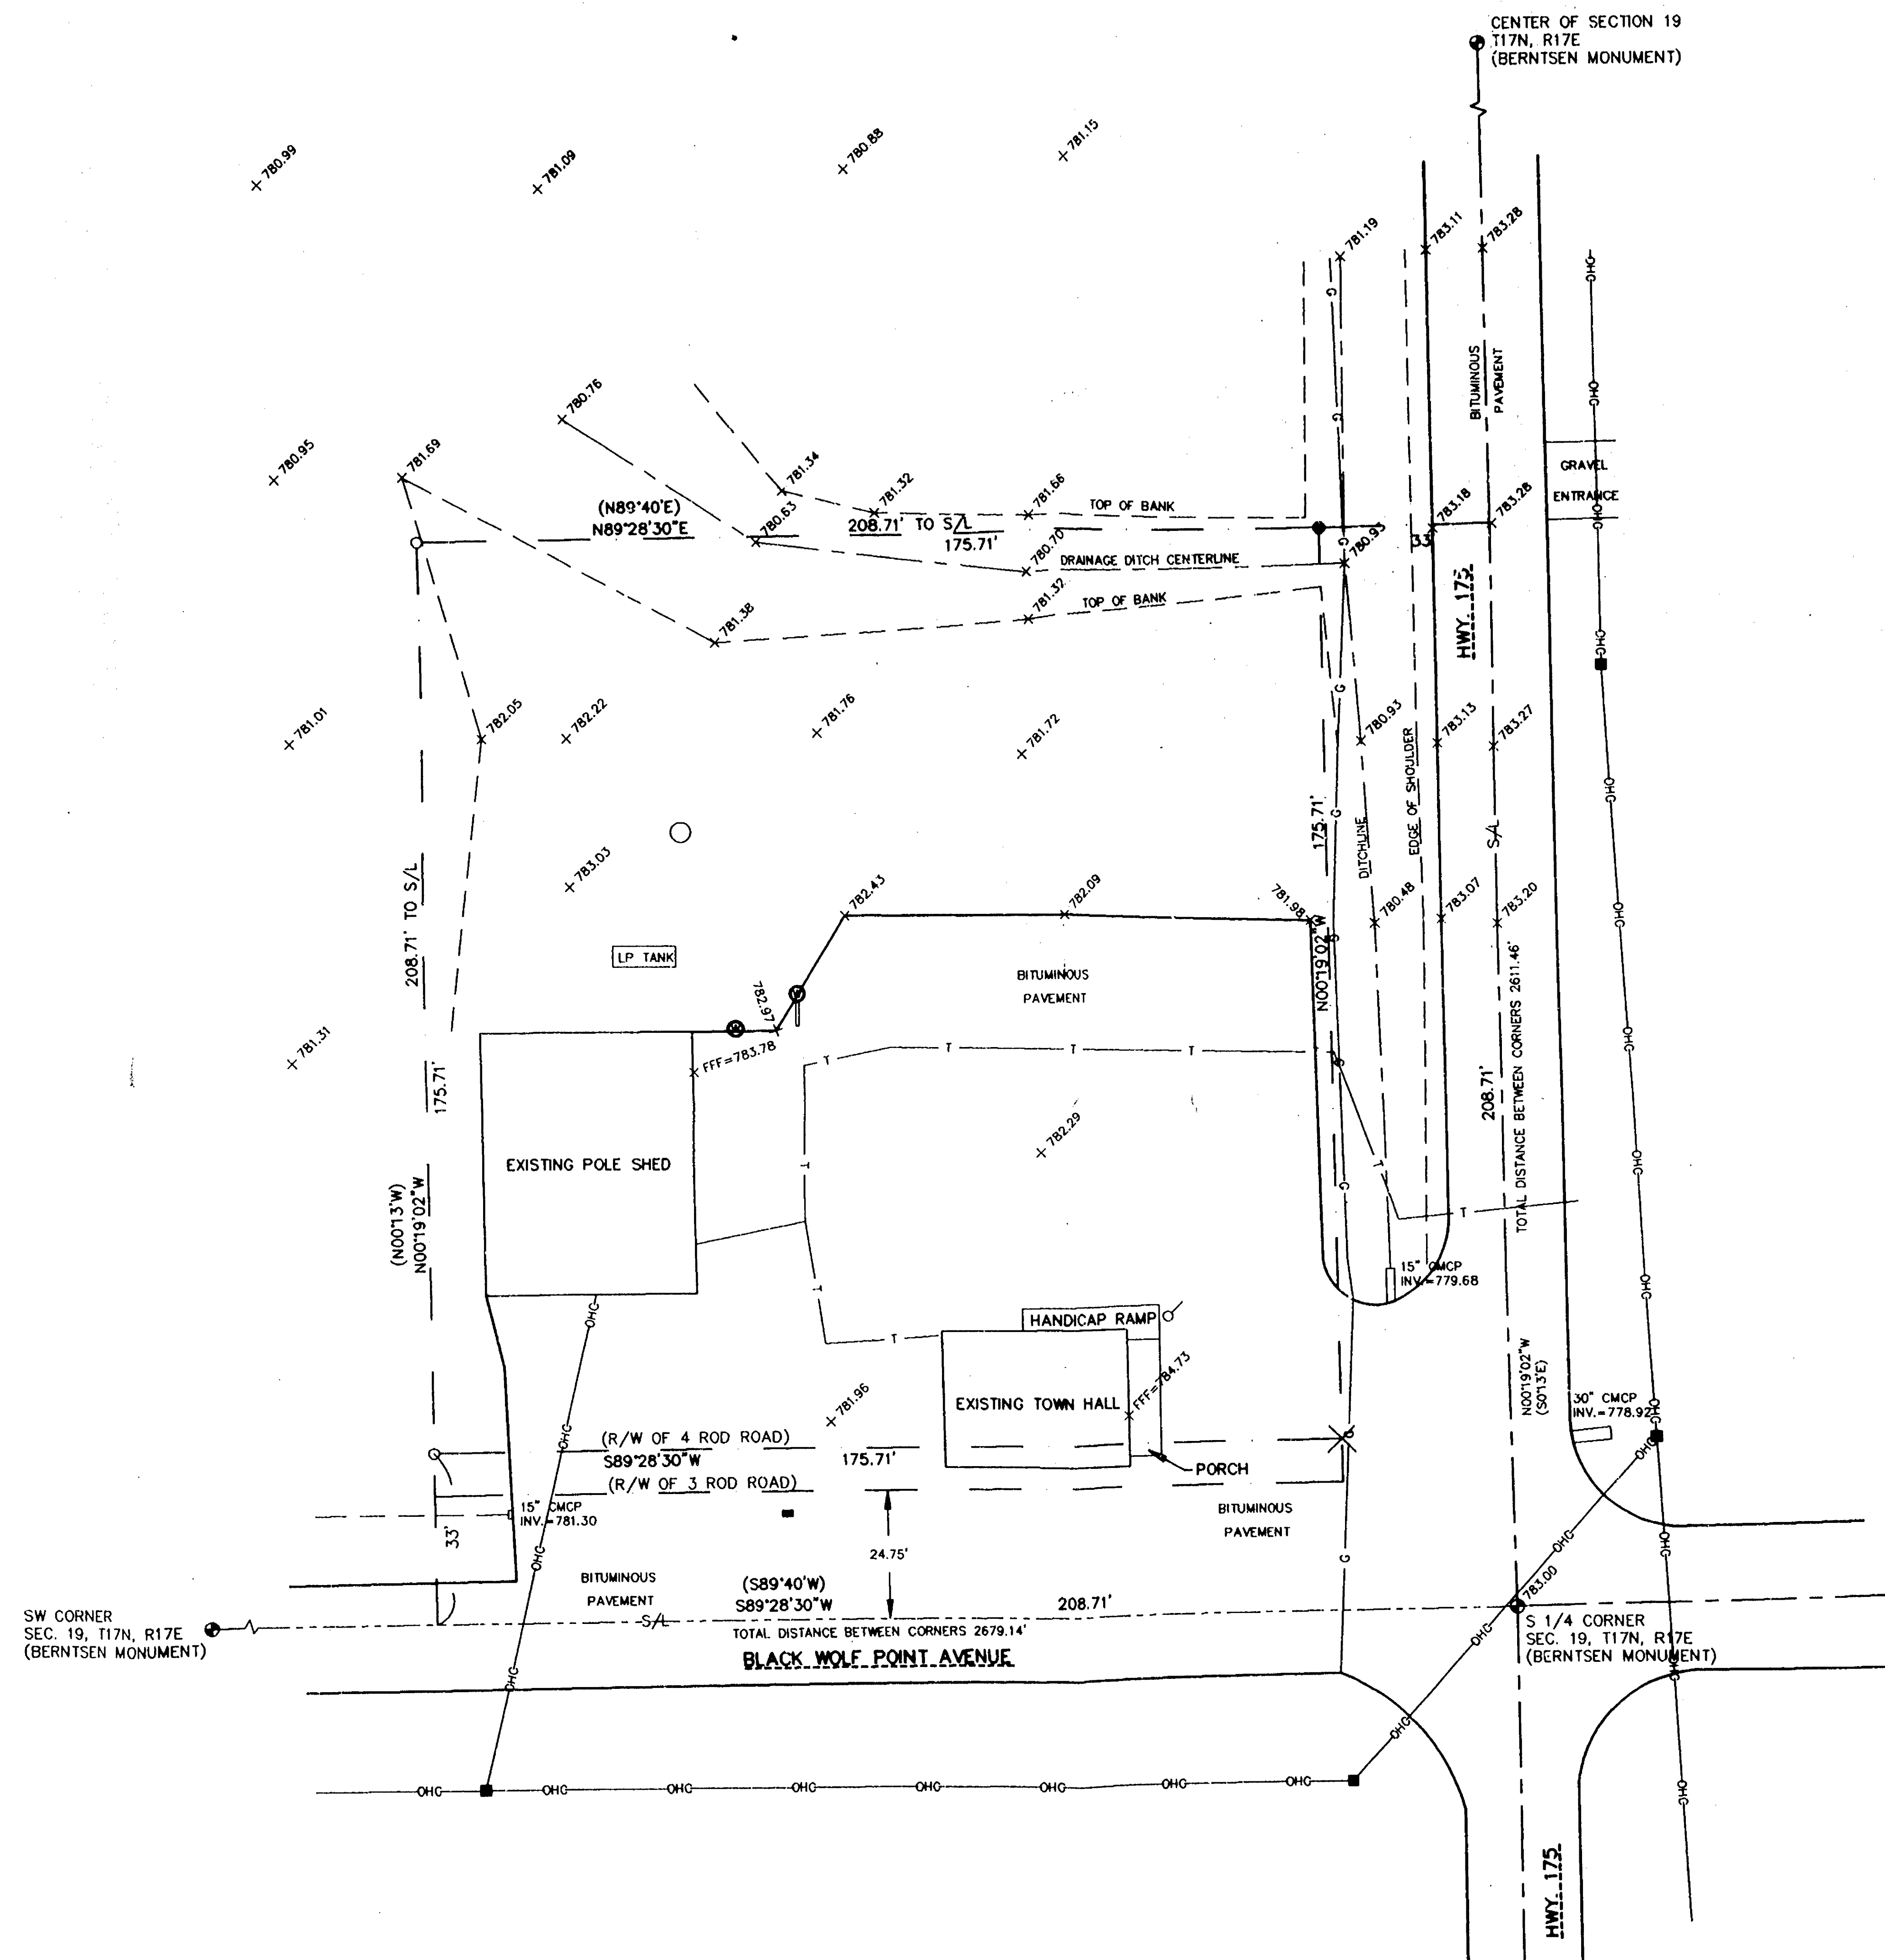

NOTES:

1. "DIGGER'S HOTLINE" SHALL BE CONTACTED BEFORE ANY CONSTRUCTION, EXCAVATION, OR EARTH MOVING IS STARTED WITHIN THIS SITE. UTILITY LOCATIONS SHOWN HEREON ARE TAKEN FROM "DIGGER'S HOTLINE" INFORMATION; AND SUCH INFORMATION MAY BE INCOMPLETE OR THE LOCATIONS MAY BE APPROXIMATE.
2. ELEVATIONS ARE RELATIVE TO THE INTERSECTION OF S.T.H. "175" AND BLACK WOLF POINT AVENUE, WHICH IS AN ASSUMED ELEVATION OF 783.00 PER THE 1980 USGS QUADRANGLE MAP OF VAN DYNE.

LEGEND

- SECTION CORNER MONUMENT
- SET 3/4" REBAR (2 1/2" LONG, 1.502#/LIN. FT.)
- EXISTING 3/4" REBAR
- INLET
- POWER POLE
- WELL
- WELL WITH SPOUT
- MANHOLE FOR HOLDING TANK
- LP TANK
- CHISELED "X" IN RAILROAD SPIKE
- DENOTES SPOT ELEVATION (ELEVATIONS BASED ON BERNTSEN MONUMENT AT INTERSECTION OF BLACK WOLF POINT AVENUE AND HWY. 175 WHICH IS ASSUMED 783.00)
- FLAGPOLE
- DENOTES TELEPHONE LINE
- DENOTES OVERHEAD CABLE
- DENOTES GASMAIN
- FINISHED FIRST FLOOR (ELEVATION)
- (100.00') R/W
- RECORDED MEASUREMENTS
- RIGHT-OF-WAY

OMNI ASSOCIATES
301 S. BROADWAY
APPLETON, WI 54911
PHONE (414) 782-3914
FAX (414) 782-3915

PART OF THE SE 1/4, SW 1/4,
SECTION 19, T17N, R17E,
TOWN OF BLACK WOLF,
WINNEBAGO COUNTY, WI

BLACK WOLF SANITARY DISTRICT
DAN ESSLINGER, PRESIDENT
AS-BUILT TOPO. SITE AND UTILITY MAP
EXISTING TOWN HALL SITE

DATE	BY

DATE	BY