


WETLANDS MAP

Being Part of Government Lot 4, Located in the South Half of the Southeast Quarter, of Section 28, Township 17 North, Range 17 East, Town of Black Wolf, Winnebago County, Wisconsin, also identified as Assessment Parcel 004040803.

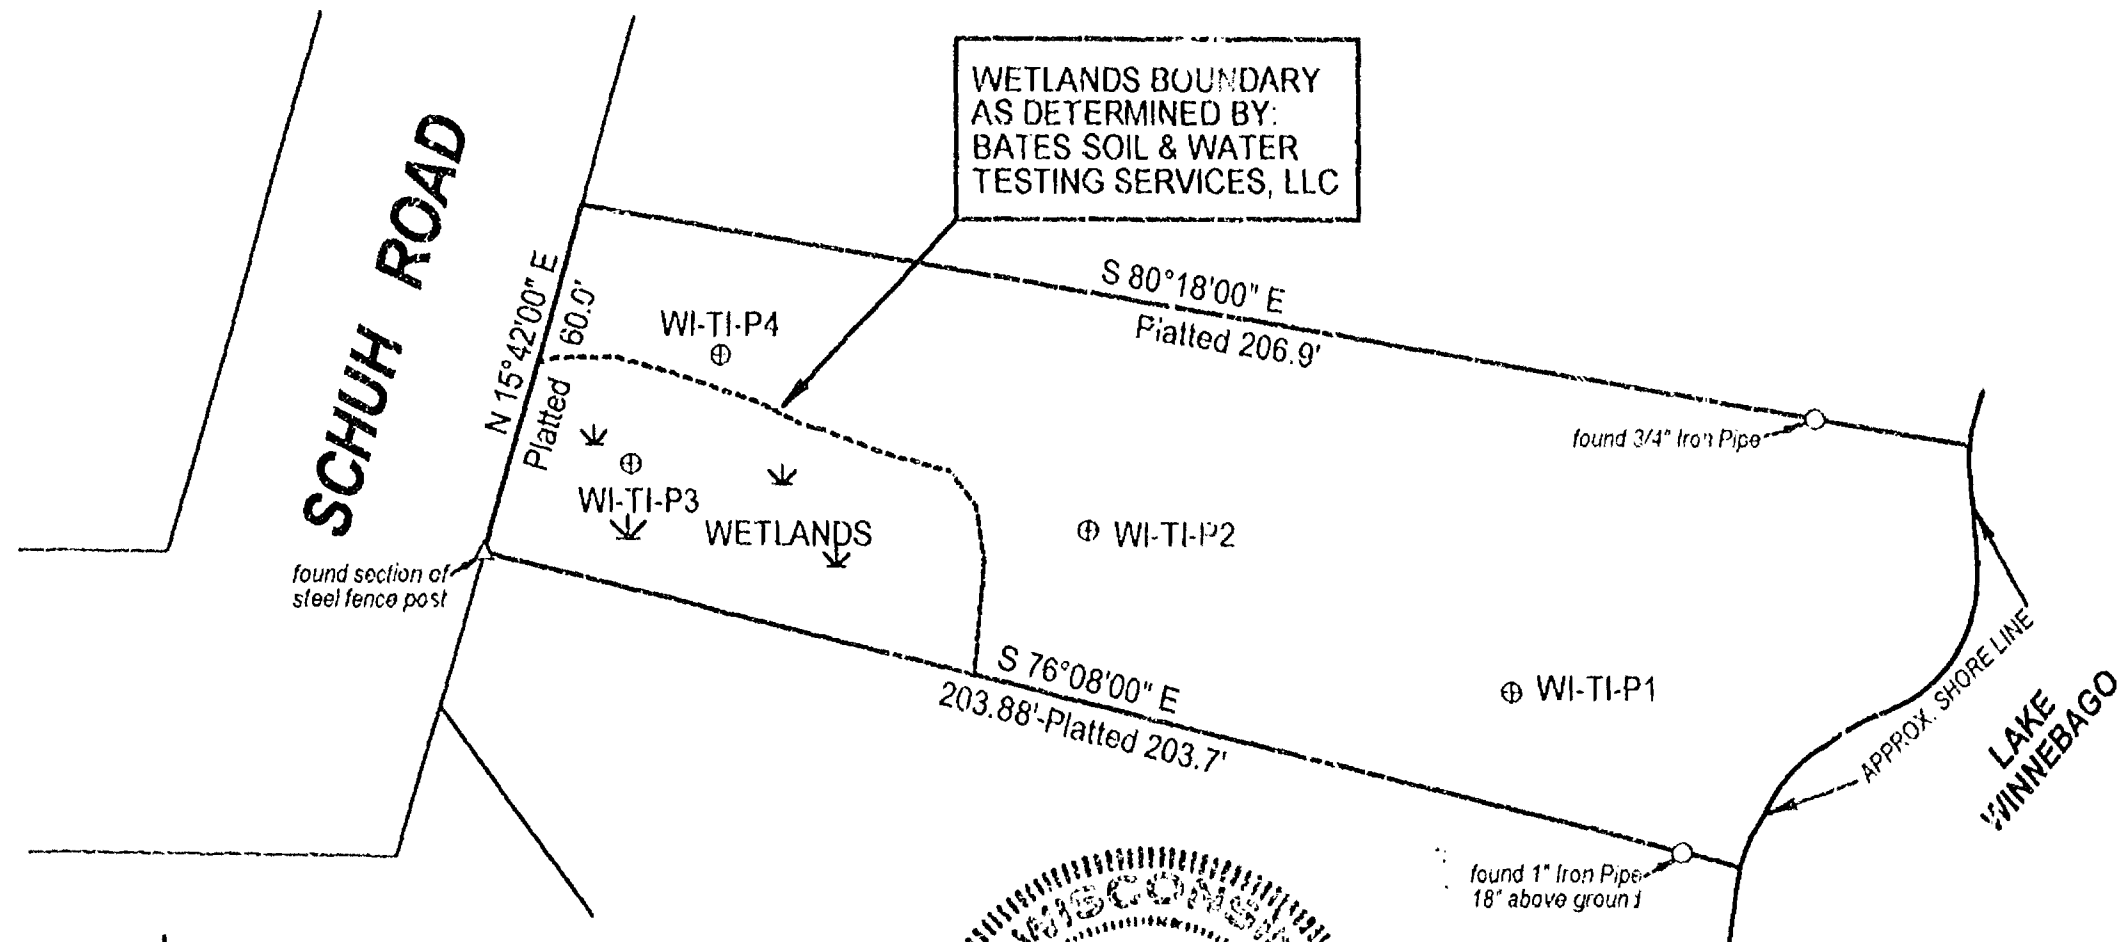


KEY

W1 CORRESPONDS TO THE APPROPRIATE WETLANDS AREA

T1 REPRESENTS THE TRANSECT LINE NUMBER

P1-P2 REFERS TO NUMBER OF PITS IN THE TRANSECT

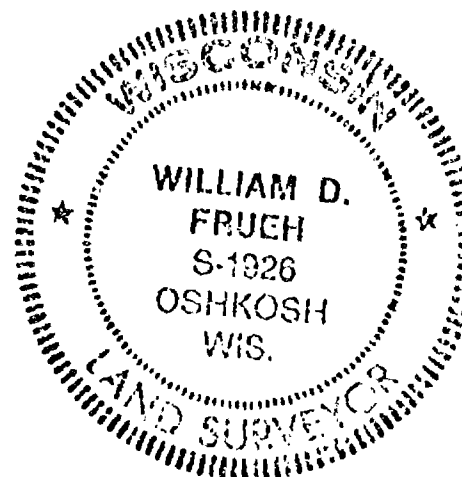


SURVEYOR'S CERTIFICATE

I, William D. Frueh, Registered Land Surveyor No. S-1926, hereby certify that I have surveyed the location of points established by a Wetlands Study conducted by Bates Soil and Water Testing Services, LLC, and that the above map is a correct representation thereof and shows the locations marked by said soil testing firm.

11/11/03
Date

William D. Frueh
William D. Frueh, Registered
Land Surveyor S-1926

Note: Bearings and Distances are according to deed descriptions

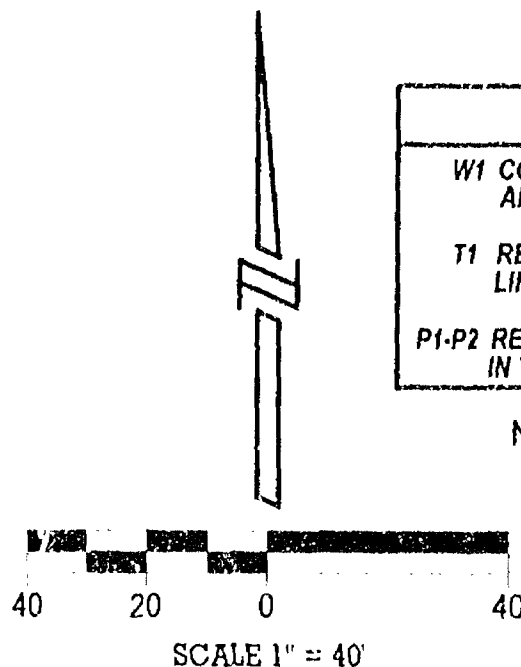


FRUEH CONSULTING SERVICES, LLC
ENGINEERING AND LAND SURVEYING

P. O. Box 282, Oshkosh Wisconsin 54903
TELEPHONE (920) 235-0279

WETLANDS MAP

Being Part of Government Lot 4, Located in the South Half of the Southeast Quarter, of Section 28, Township 17 North, Range 17 East, Town of Black Wolf, Winnebago County, Wisconsin, also identified as Assessment Parcel 004040803.

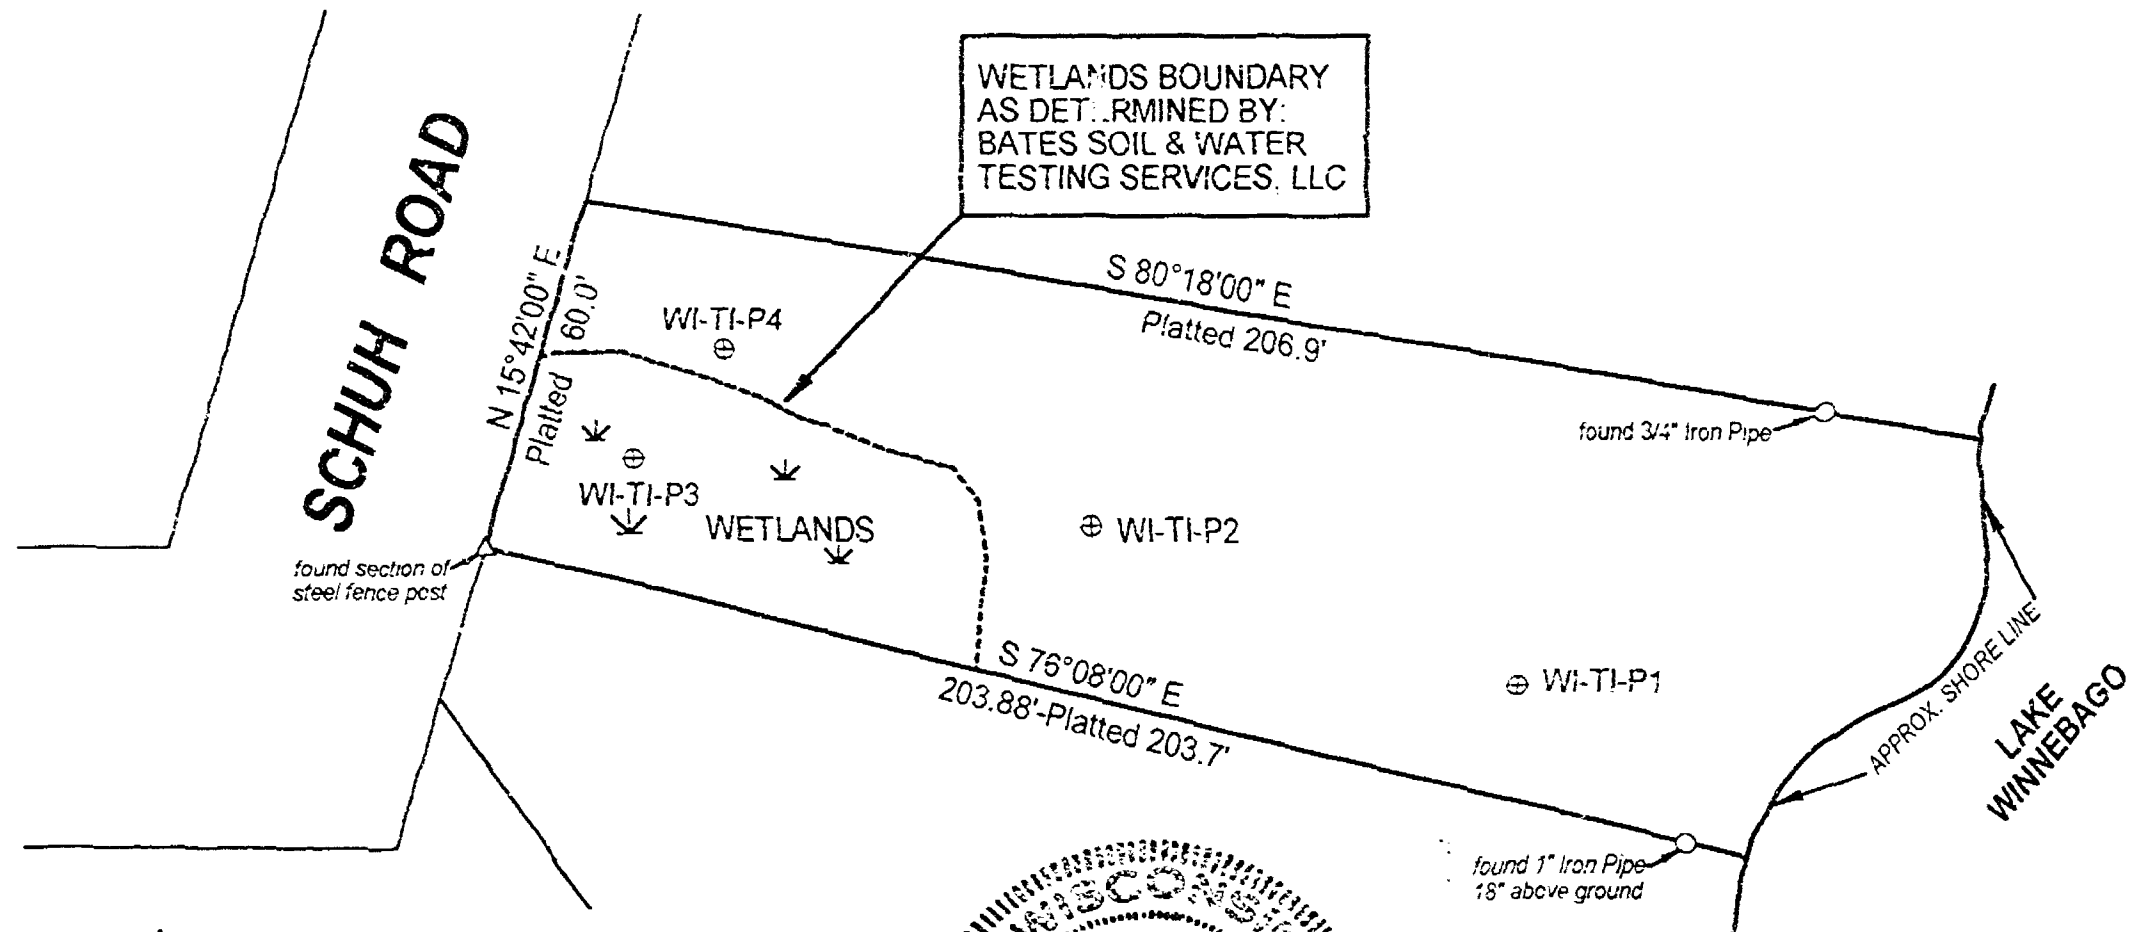


KEY

W1 CORRESPONDS TO THE
APPROPRIATE WETLANDS AREA

T1 REPRESENTS THE TRANSECT
LINE NUMBER

P1-P2 REFERS TO NUMBER OF PITS
IN THE TRANSECT

Note: Bearings and Distances are according to deed descriptions

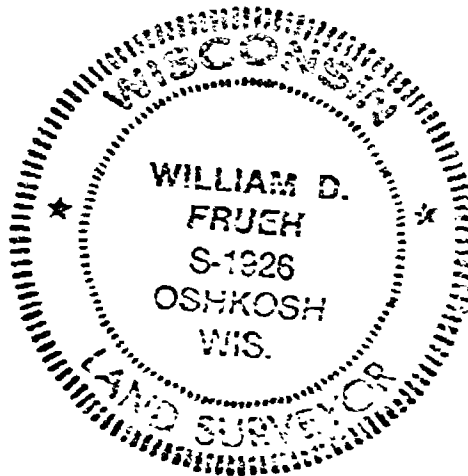


SURVEYOR'S CERTIFICATE

I, William D. Frueh, Registered Land Surveyor No. S-1926, hereby certify that I have surveyed the location of points established by a Wetlands Study conducted by Bates Soil and Water Testing Services, LLC, and that the above map is a correct representation thereof and shows the locations marked by said soil testing firm.

11/11/03
Date

William D. Frueh
William D. Frueh, Registered
Land Surveyor S-1926

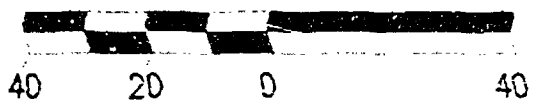

SCALE 1" = 40'

FRUEH CONSULTING SERVICES, LLC

ENGINEERING AND LAND SURVEYING

P. O. Box 282, Oshkosh Wisconsin 54903

TELEPHONE (920) 235-0279

JAN 03, 1996

TO: Drainage Inspector/Cartographer/Zoning Secretary

FM: Zoning Administrator

RE: Navigability Determination Map Updates

Rick/Diane/Lisa:

Please update the GIS for the following DNR navigability determinations:

1. SW, SE, S 20, T 17N, R 17E, BLACK WOLF (COURTER)
PARCEL ~~004-0401~~ ONLY Richard Brewer
004-0401

Rick: Update USGS Quads

Diane: After updating, determine the affected parcels where navigable and attach a list of parcel numbers affected and within 300' so that file 13 can be updated.


Lisa: Update File 13, file in parcel file(s) and microfiche in Surveyors Records according to Section, Town, Range.

USGS Quads Updated 3/26/96 by Rick H.

GIS Updated 3-28-96 by D. Culver

File 13 Updated 4-11-96 by A. Jan

Verified by Zoning administrator [Signature]

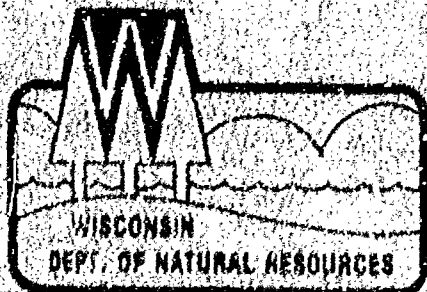

George E. Meyer, Secretary
William R. Selbig, District Director

State of Wisconsin \ DEPARTMENT OF NATURAL RESOURCES

Oshkosh Area Office
905 Bayshore Drive
Box 2566

Oshkosh, Wisconsin 54903
Telephone #: (414)424-3060
Telefax #: (414)424-4404

December 18, 1995

File Ref: 3500

Greg Courter
3031 County Road Z
Oshkosh, WI 54901

SUBJECT: Navigability determination

Dear Mr. Courter:

I am writing you in regards to your request for a navigability determination of an unnamed watercourse on property located in the SW1/4, SE1/4, Section 28, Township 17 north, Range 17 east, Town of Black Wolf, Winnebago County, Wisconsin.

On November 15, 1995 I met with you to inspect the property. At that time I determined that the unnamed watercourse that was mapped on the parcel map was not navigable in that there was no defined bed or bank.

I have enclosed an application for a dredging permit for your proposed dredging of Lake Winnebago. Please make sure that you submit a complete application so that the processing of your application is not delayed.

If you have any questions you can contact me at the address above or call (414)424-7885.

Sincerely,


Richard L. Wissink

Richard L. Wissink
Water Management Specialist

cc: Ron Fassbender, LMD
Robert Braun, Winnebago County Zoning

ROBERT E. BRAUN
Zoning Administrator
KATHRYN M. LARSON
Zoning Inspector
CARY A. ROWE
Code Enforcement Officer
RICK HOPPE
Drainage Inspector

OSHKOSH
(414) 236-4844
FOX CITIES
(414) 727-2880
FAX
(414) 236-4799

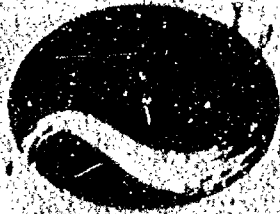

Winnebago County
Zoning Department

The Wave of the Future

January 09, 1996

Mr. Rich Wissink
Oshkosh DNR
P.O. Box 2565
Oshkosh, WI 54903-2565

RE: Courter Navigability Determination

Dear Rich:

I have returned your letter pertaining to the Courter navigability determination for clarification as follows:

1. The property owned by Courter is in the Town of Nokimi. Your letter states Black Wolf. *Black Wolf*
2. The Courter property is in Section 35, T 17N, R 16E. Your letter says Section 28, T 17N, R 17E.
3. No map was included with your letter so we cannot determine what property you are referring to.

Please clarify this matter as soon as practicable.

Respectfully,

Robert E. Braun
Zoning Administrator

encl DNR letter, December 18, 1995 (Courter)

cc letter/encl Drainage Inspector



George E. Meyer, Secretary
William R. Selbig, District Director

State of Wisconsin | DEPARTMENT OF NATURAL RESOURCES

Oshkosh Area Office
805 Bayshore Drive
Box 2888
Oshkosh, Wisconsin 54903
Telephone #: (414) 424-3050
Telefax #: (414) 424-4406

December 18, 1995

File Ref: 3500

Greg Courter
3031 County Road Z
Oshkosh, WI 54901

SUBJECT: Navigability determination.

Dear Mr. Courter:

I am writing you in regards to your request for a navigability determination of an unnamed watercourse on property located in the SW1/4, SE1/4, Section 28, Township 17 north, Range 17 east, Town of Black Wolf, Winnebago County, Wisconsin.

On November 15, 1995 I met with you to inspect the property. At that time I determined that the unnamed watercourse that was mapped on the parcel map was not navigable in that there was no defined bed or bank.


I have enclosed an application for a dredging permit for your proposed dredging of Lake Winnebago. Please make sure that you submit a complete application so that the processing of your application is not delayed.

If you have any questions you can contact me at the address above or call (414) 424-7885.


Sincerely,

Richard L. Wissink
Richard L. Wissink
Water Management Specialist

cc: Ron Fassbender, LMD
Robert Braun, Winnebago County Zoning

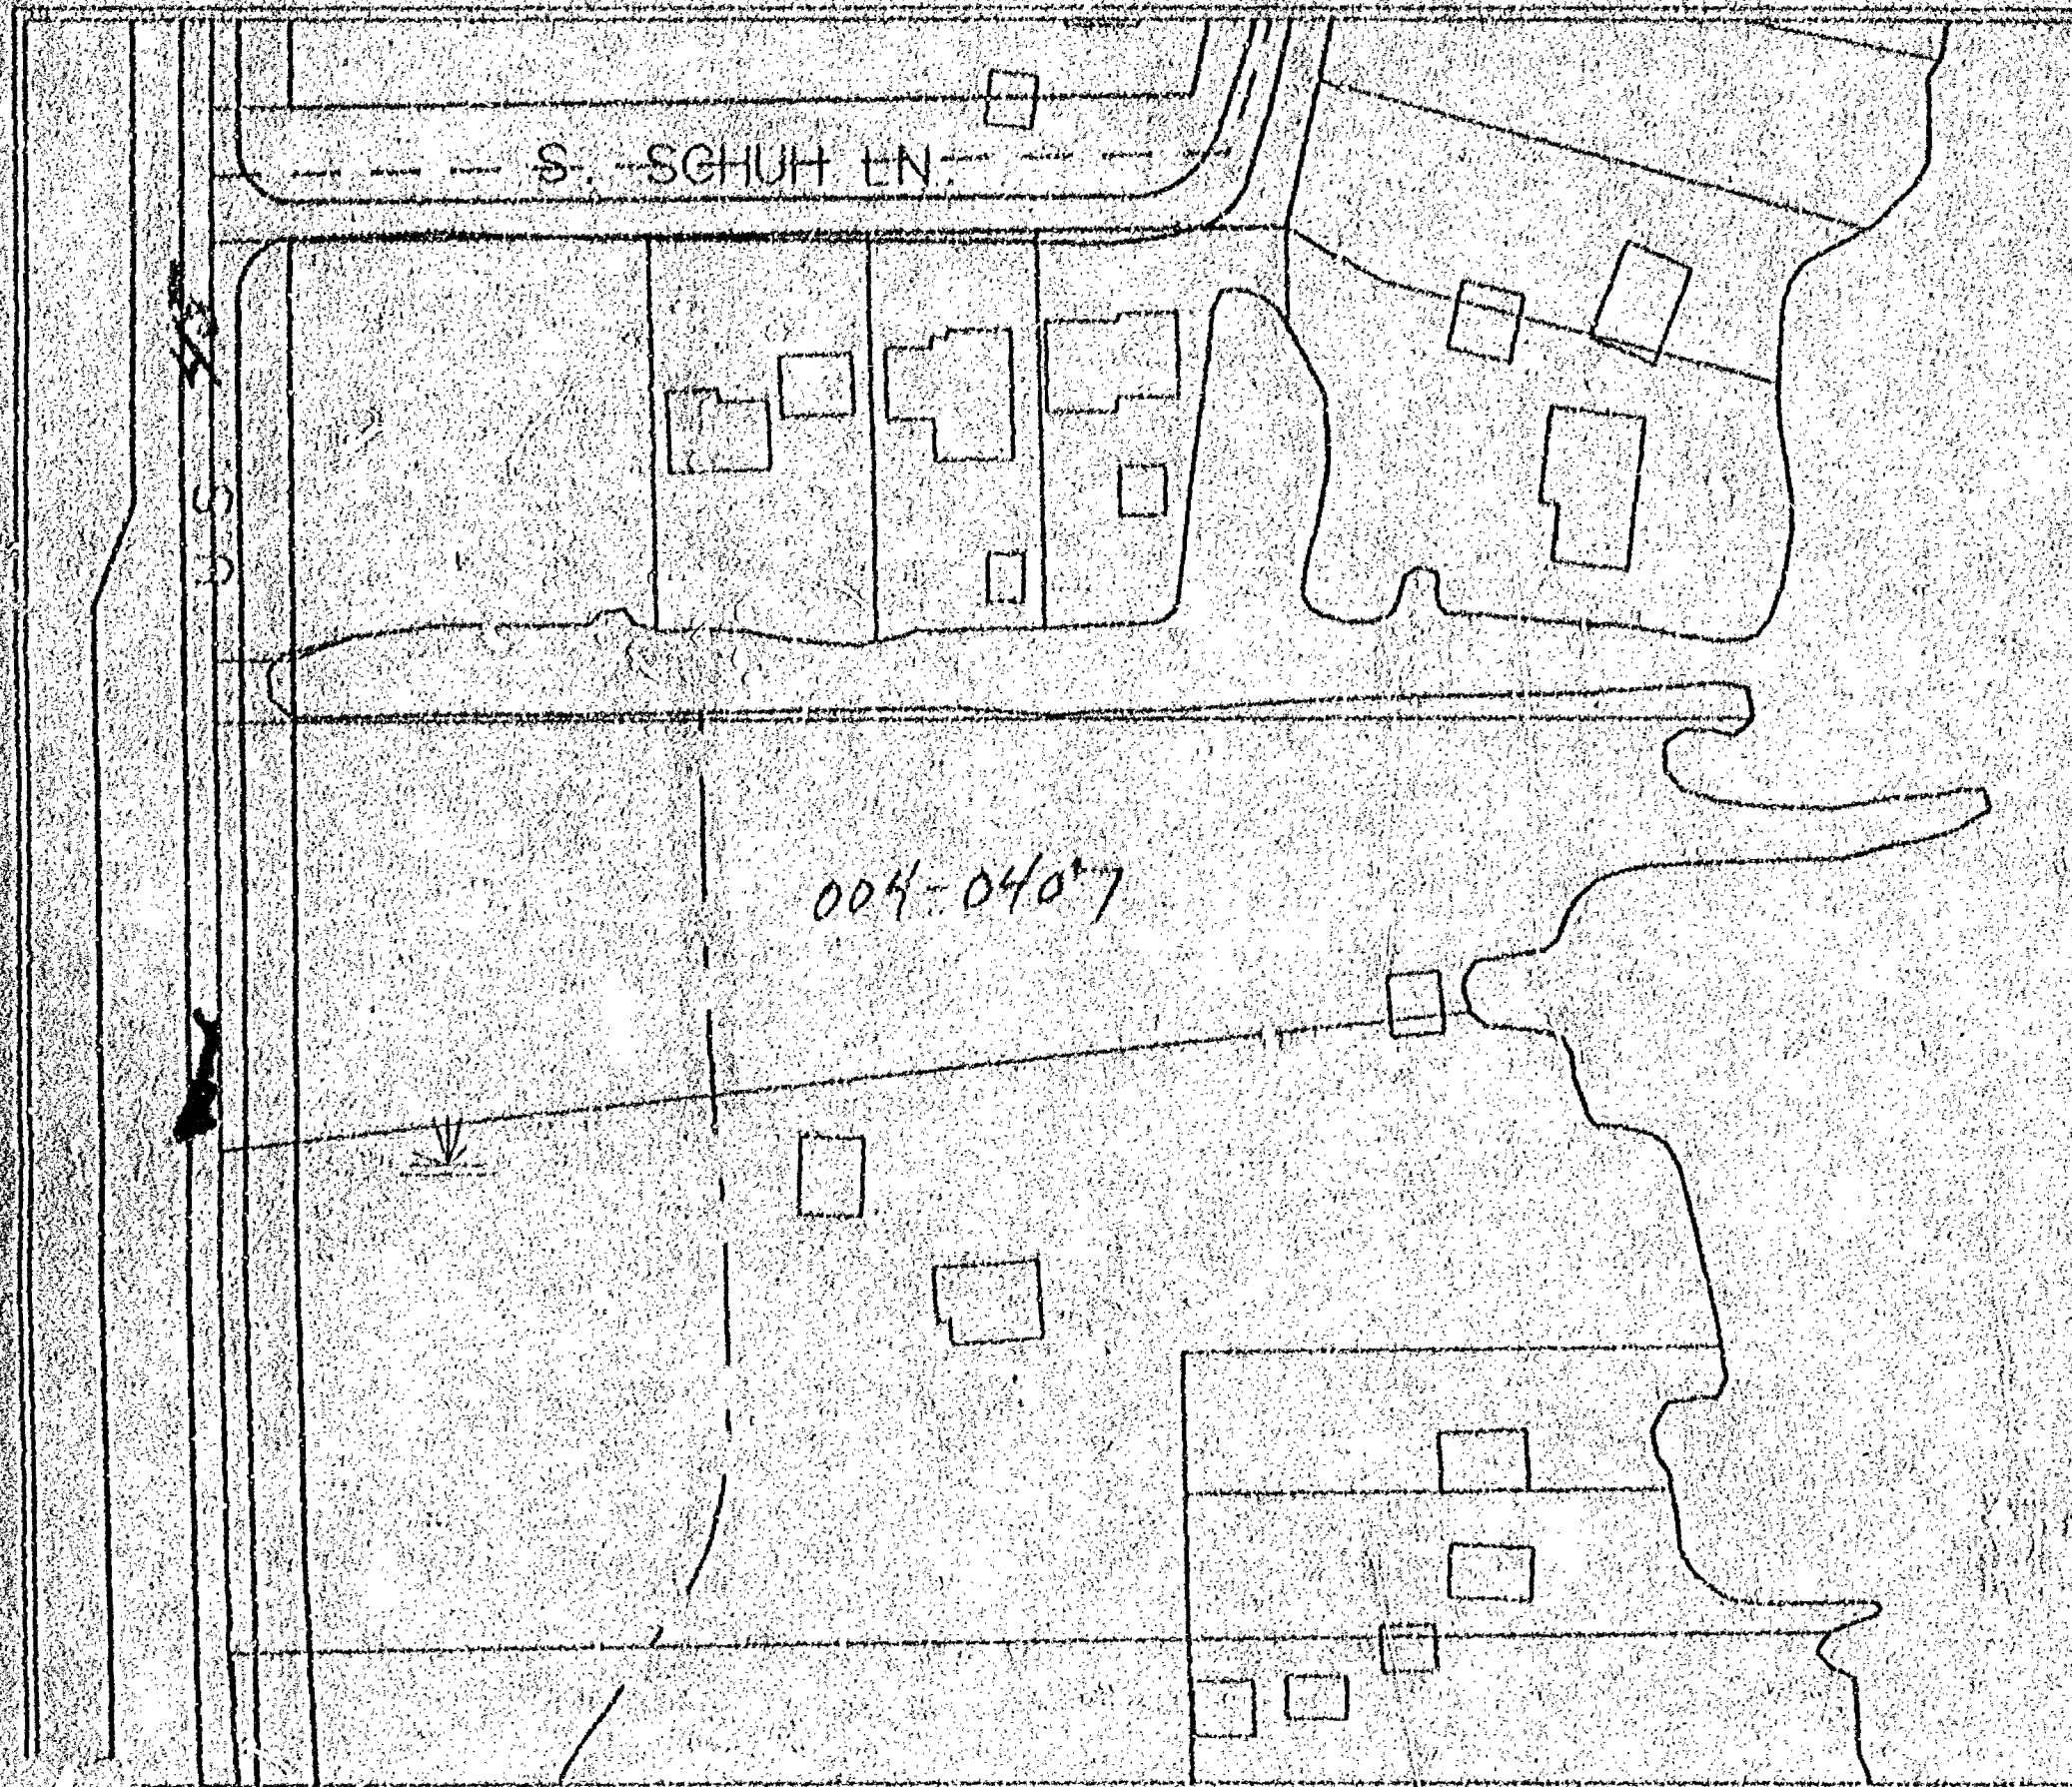

004-0407

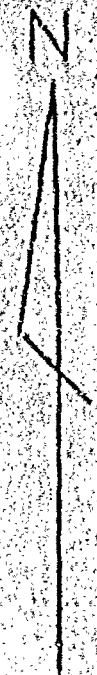


Winnebago County WINGS Project

DISCLAIMER


This data was created for use by the Winnebago County Geographic Information System Project. Any other use or application of this information is the responsibility of the user and such use or application is at their own risk. Winnebago County disclaims all liability regarding fitness of the information for any use other than Winnebago County business.

Scale: 1 in. = 100 ft.

Date: Tue Sep 19 15:12:23 CDT 1995
Created by: - kathy

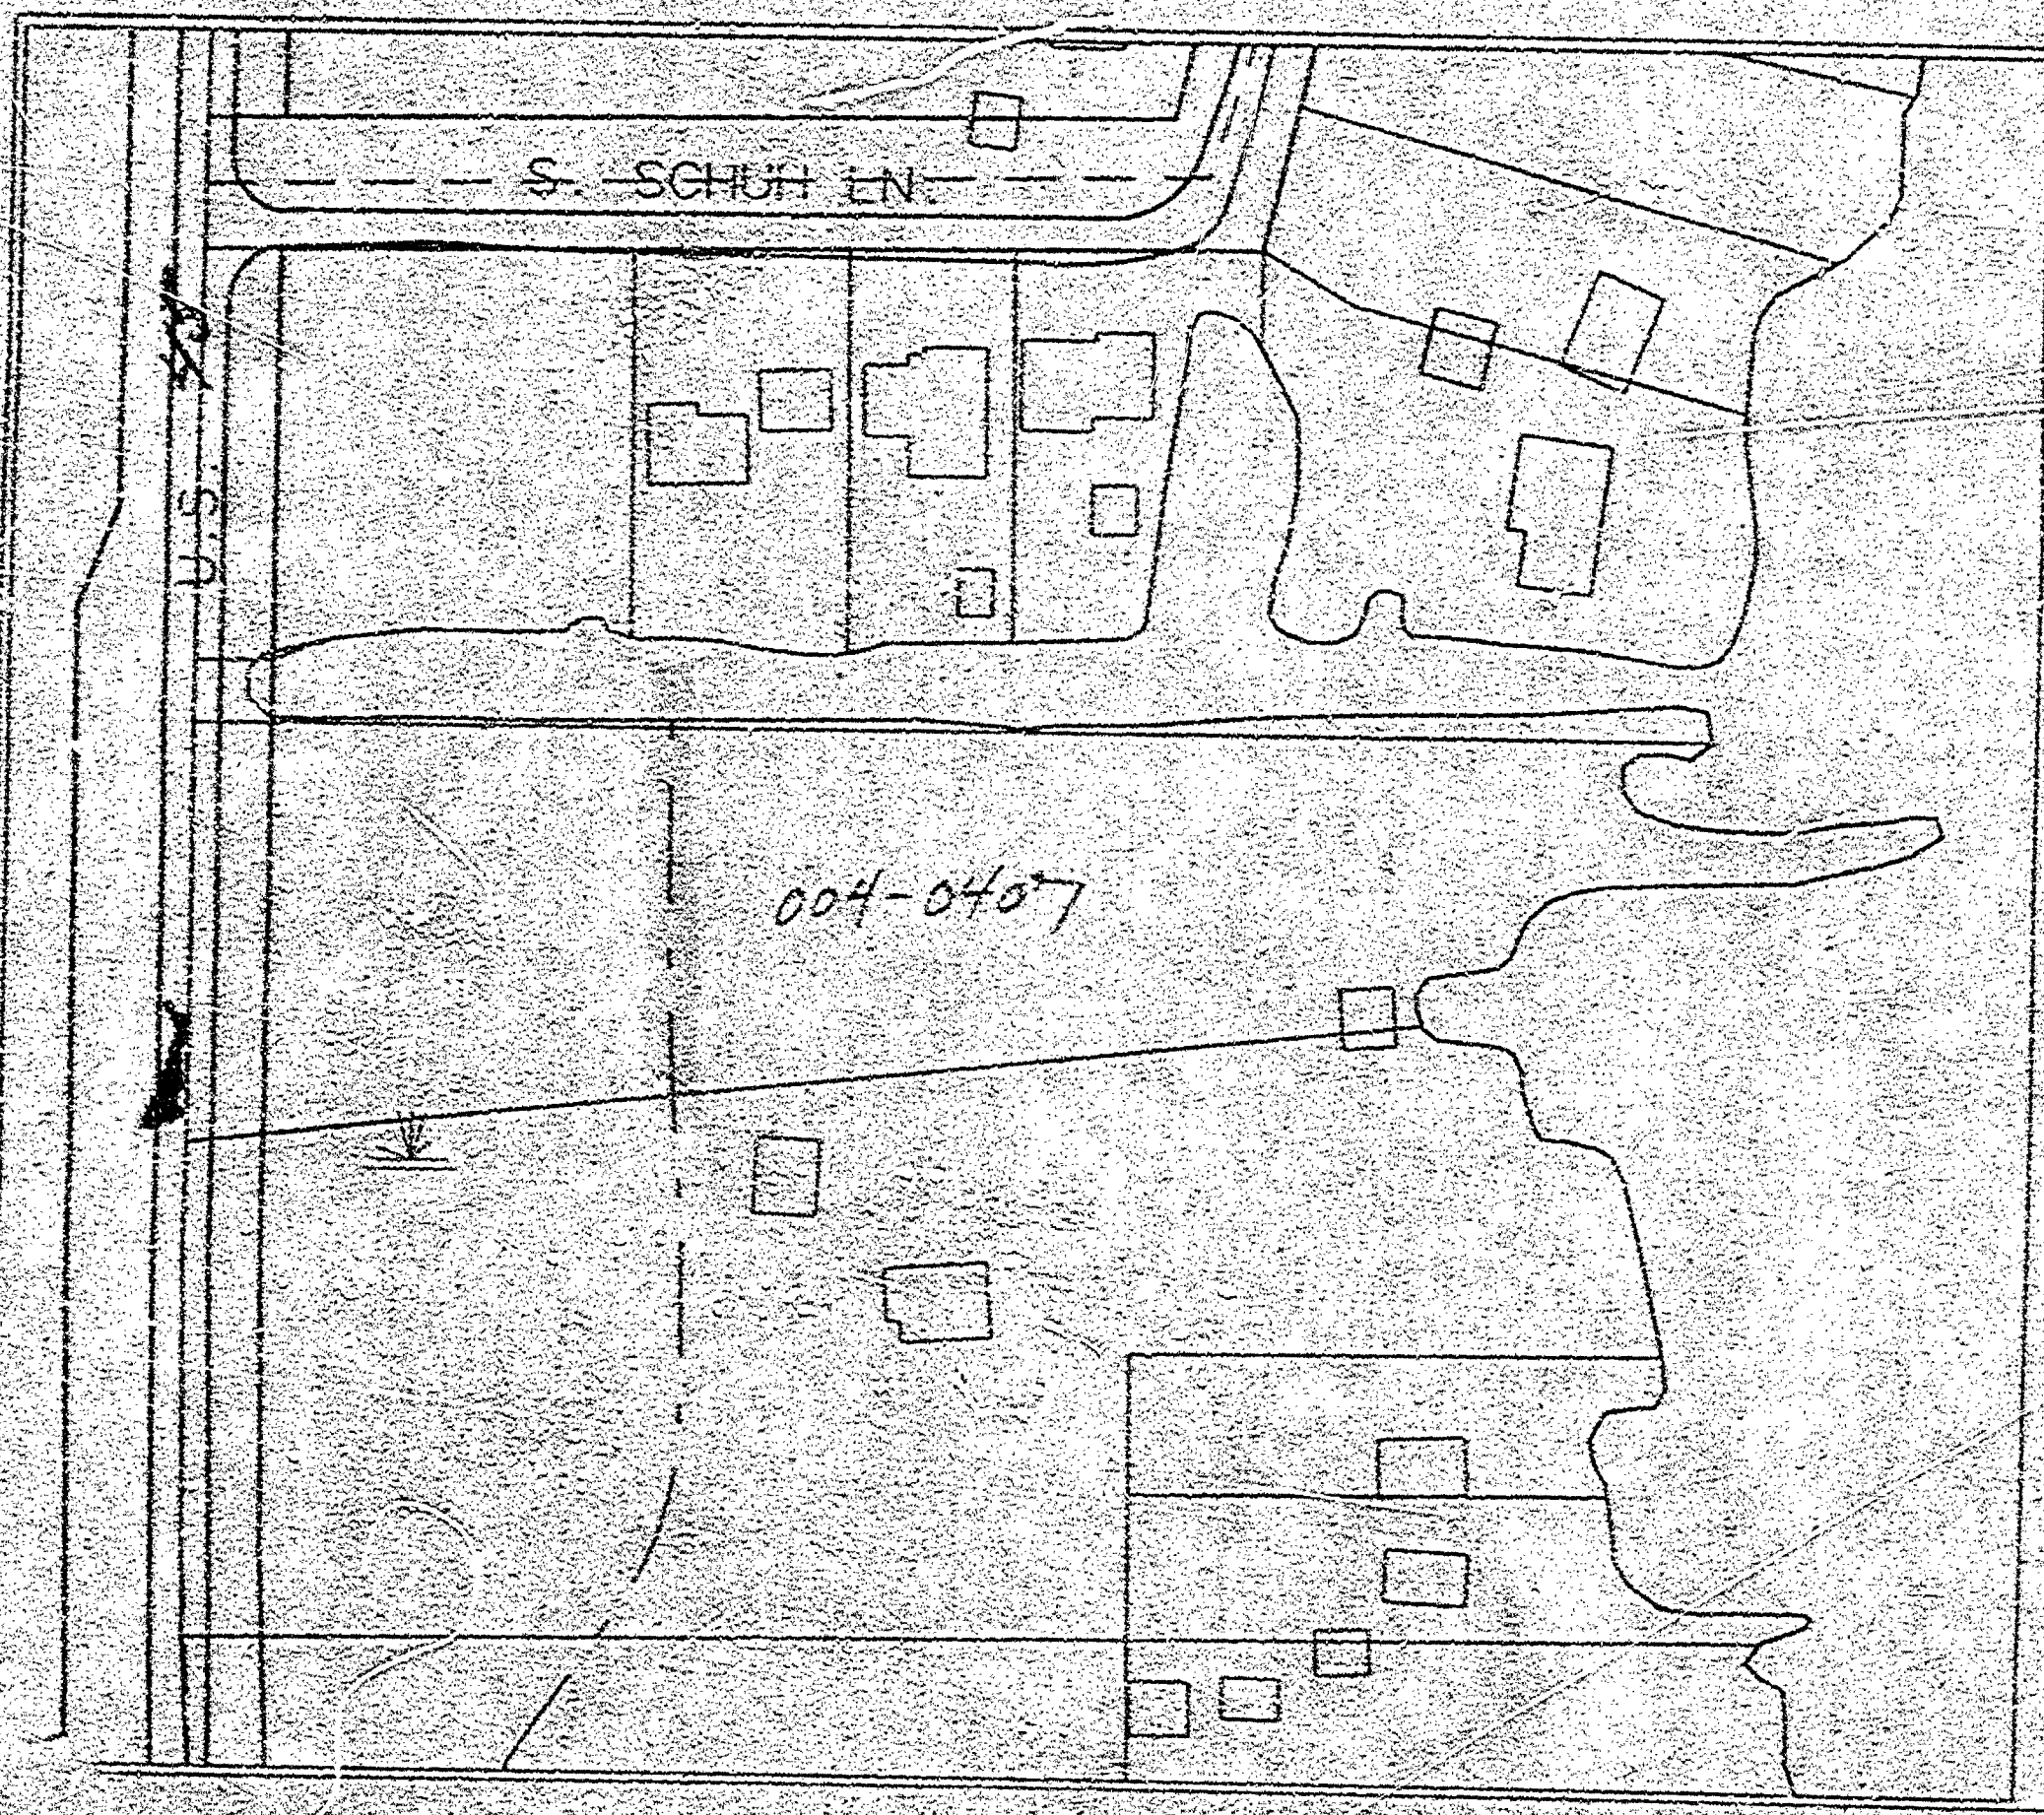

004-0407

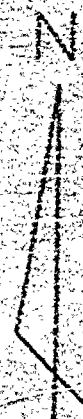

Winnebago County
WINGS Project

DISCLAIMER

This data was created for use by the
Winnebago County Geographic
Information System Project. Any
other use/reproduction of this
information is the responsibility of the
user and such use/application is at their
own risk. Winnebago County declines
all liability regarding fitness of the
information for any use other than
Winnebago County business.

Scale: 1 in. = 100 ft.

Date: Tue Sep 19 15:32:25 CDT 1995
Created by: jldyl

ROBERT E. BRAUN
Zoning Administrator
KATHRYN M. LARSON
Zoning Inspector
CARY A. ROWE
Code Enforcement Officer
RICK HOLIT
Drainage Inspector



Winnebago County
Zoning Department

The Wave of the Future

OAKKOSH
(414) 736-4844
FOX CITIES
(414) 737-1880
FAX
(414) 215-4799

January 09, 1996

Mr. Rich Wissink
Oakkosh DNR
P.O. Box 2565
Oakkosh, WI 54903-2565

RE: Courter Navigability Determination

Dear Rich:

I have returned your letter pertaining to the Courter navigability determination for clarification as follows:

1. The property owned by Courter is in the Town of Nekimi. Your letter states Black Wolf.
2. The Courter property is in Section 35, T 17N, R 16E. Your letter says Section 28, T 17N, R 17E.
3. No map was included with your letter so we cannot determine what property you are referring to.


Please clarify this matter as soon as practicable.

Respectfully,

Robert E. Braun
Zoning Administrator

encl DNR letter, December 18, 1995 (Courter)

cc letter/encl Drainage Inspector

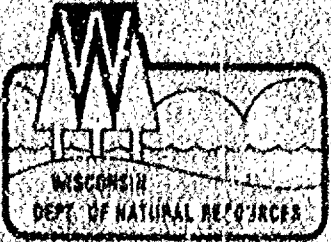

STATE OF WISCONSIN \ DEPARTMENT OF NATURAL RESOURCES

George E. Meyer
Secretary

Oshkosh Area Office
905 N. York Drive
P.O. Box 2566
Oshkosh, WI 54903-2566

telex: #141424-4404

October 23, 1993

File Ref:
3-LM-93-613

Donna & Joan Legget
4051 S. 74th St.
Milwaukee, WI 53220

WINNEBAGO COUNTY
PLANNING DEPT.

Dear Mr. & Mrs. Legget:

This letter is in response to your application for a D.N.R. permit 3-LM-93-613 to place sand on the bed of Lake Winnebago.

Thank you for your prompt response to my letter dated September 30, 1993. I am pleased that you do not plan to place sand on the lake bed. Since this is the case I am hereby dismissing your sand blanket application.

However, you should contact Robert Braun, Winnebago County Zoning Administrator, 415 Jackson St., Oshkosh, WI 54902, telephone (414)235-4844 to see if permits are required from them, as you indicated you would like to place sand landward of the rock rip rap.

If you have any questions please contact me at the above address or call me at 414-424-4003.

Sincerely,

Tere Locke

Tere Locke
Water Management Specialist

TLks

cc: Ron Fassbender
Robert Braun