


8 - 18 - 15

NO.	SURVEYED FOR	SURVEYOR	DATE	PLAT NO.	CERTIFIED MAP NO.	SURVEYS		SURVEY	LOCATION
						VOL.	PAGE		
	City of Omro	Wolverton	8-31-51					8, T18N	RISE SW1/4
	City of Omro	Wolverton	9-17-52					8, T18N	RISE SW1/4
	H. Jackson	Stearns	10-19-61					8, T18N	RISE
	R. Strehlow	Chronis	1-23-79					8, T18N	RISE Galt
	G. Maggione	Chronis	1-31-79					8, T18N	RISE Galt
	A. Winkler	Chronis	3-12-79					8, T18N	RISE Galt
	HA. Kessler	Chronis	8-5-77					8, T18N	RISE Lot 1
	G. Chromakelau	Chronis	1-31-79					8, T18N	RISE Lot 6
	W. H. Plura	Chronis	1-31-79					8, T18N	RISE Lot 6
	Frank Add.							8, T18N	RISE Lot 1
	E. Mathe	Sauler	2-4-75	Frank's Add.				8, T18N	RISE Lot 8, 9
	W. Uneng	Stearns	5-2-64					8, T18N	RISE Lot 3, 4
	K. (Uneng)	Stearns	3-8-67					8, T18N	RISE SE 1/4
	W. Uneng	Stearns	4-28-68					8, T18N	RISE NE 1/4
	R. Kassel	Sauler	10-12-60					8, T18N	RISE SE 1/4
	A. Kellum	MC Mahon	12-57					8, T18N	RISE
	R. Collins	Kessler	8-30-79					8, T18N	RISE
	D. Dodd	Chronis	8-4-80	Leonard Pt.				8, T18N	RISE
	City of Omro	Wolverton	5-26-53					8, T18N	RISE
	City of Omro	Wolverton						8, T18N	RISE
	A. & Kessler	Chronis	8-3-77					8, T18N	RISE Lot 1
	A. Kessler	Chronis	7-11-77					8, T18N	RISE
	Christler, Outboard	Capelle	3-13-75			1	133	8, T18N	RISE SE 1/4
	F. McKeehan	Wolverton	6-7-59					8, T18N	RISE
	M. Tural	Hauksmith	5-1-80		549257	1	755	8, T18N	RISE SW 1/4
	J. Roggen	Hauksmith	8-3-79		5390.38	1	643	8, T18N	RISE
	Omro	" " "	11-5-80						SW 1/4
	M. Schultz	" " "	2-4-80					Galt Lot 6	

8 18 15 10

That Part Of The N.E.1/4 Of Sec. 8-18-15 & Govt. Lot # 4, Town Of Omro, Winnebago County, Wis. Described As Follows: Commencing At The North West Corner Of Said N.E.1/4, Thence South, Along The West Line Of Said N.E.1/4, 1412.0 ft., Thence East, Parallel With The North Line Of Said Quarter, 2280.0 ft., Thence N.7°18'E., 177.8 ft., Thence S.83°45'E., 19.25 ft., Thence N.15°55'E., 245.0 ft. To The Place Of Beginning; Thence N.15°55'E., 125.0 ft., Thence S.84°16'E., To The Westerly Bank Of A Canal, As Now Located, Thence Southerly, Along The Westerly Bank Of Said Canal, As Now Located, To A Point That Is S.84°16'E. Of The Place Of Beginning, Thence N.84°16'W. To The Place Of Beginning.

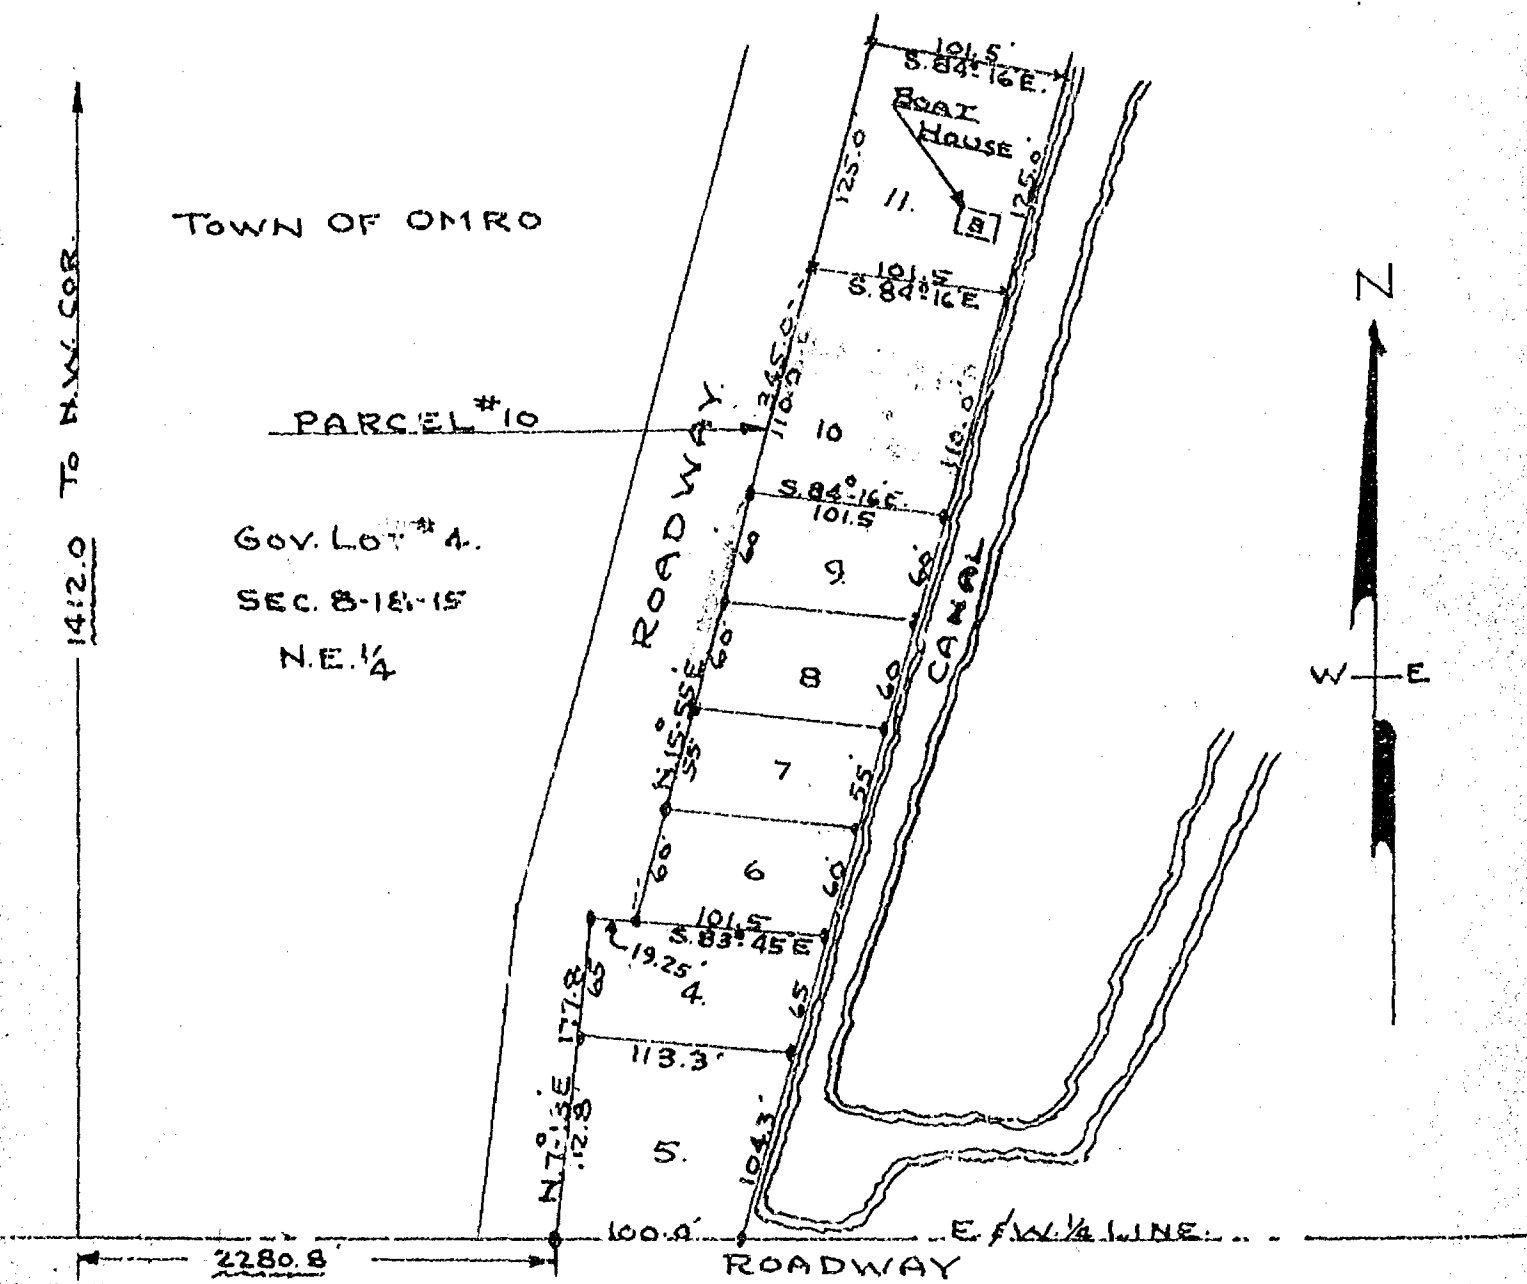

Survey & Platting Co.
Oshkosh, Wis.
T.E. Stearns - Reg. Surveyor
Sept. 28, 1968

(3)

N 1/4 CORNER SEC 8-18-15

1635.5 EAST 180

EAST LINE SEC. 9
APPROX. LOCATION —→

SURVEY
SHOWING LOCATION ROADS
TO F.M. McKEOUGH ET AL PROPERTY
SEC. 8 & 9 T18 N R 15 E
F.M. WOLVERTON REGISTERED SURVEYOR
SCALE 1" = 300' JUNE 7 1959



EAST BANK CANAL
12' ROAD ALONG EAST BANK

Free Lot 3
Sec. 9

TRANSIT LINE& MEANDER

MEMORANDUM

2A 1476. 08 01744

Rev. A

—207X20

STEELE

MEAN 75 D
LINE

← W. YOUNG WEST LINE

W. YOUNG SOUTH LINE

266399

1207.1437.0 FEET

EAST 1/4 LINE

END CANAL

2450.3
E 125
3" 11600

2578.8
EAST

2648 Enst
Mander, Lina

Description on reverse side.

Register's Office

Winnebago County, Wis.

Received for record this 12th

day of June A.D. 1957

at 1:20 o'clock P M. and

Recorded in Vol. 1 of S.M

Page 1

Hernice L. Fuller
Register of Deeds

Jensen & Wallace
Eng 7/52

DESCRIPTION OF RIGHT OF WAY

Granting unto the Grantees herein, their heirs or assigns, a right of way over, across and through the following described real estate, to-wit:

That part of the NORTH EAST 1/4 of Section 8 - 18 - 15 and of FRACTIONAL LOT THREE (3) of Section 9 - 18 - 15, described as follows, viz:-

Commencing on the West line of the North East 1/4 of said Section 8 at a point 1444 feet south of the Northwest corner of said North East 1/4 (Center line of State Trunk Highway No. 116), thence east, parallel with the North line of said Section 8, 1721 feet, more or less, to a point 34 feet west of the West line (or extended West line) of a Dredged Ditch, running East and West, as now located, thence north, parallel with the West line of said North East 1/4 32 feet, thence east, parallel with the North line of said Section 8, to a point 2578.8 feet east of the West line of said North East 1/4, (hereinafter referred to as Line "X"), thence northeasterly to the most Southeasterly corner of a Dredged Ditch or Canal (the most Westerly Dredged Ditch or Canal located in Fractional Lot 3 of said Section 9 and in the Southeasterly part of the North East 1/4 of said Section 8), (hereinafter referred to as Line "Y"), thence northerly along the Easterly line of last mentioned Dredged Ditch or canal (hereinafter referred to as Line "Z") to the Southwest corner of land heretofore conveyed to F. M. McKoeugh by Deed recorded in Winnebago County Registry in Volume 904 on Page 575, thence easterly, along the South line of the tract of land conveyed to F. M. McKoeugh as aforementioned, to a point that is 12 feet Easterly of the Easterly line of said Line "Z", (measured at right angles to said Line "Z"), thence southerly, parallel with said lines "Z" and "Y", and 12 feet distant therefrom to a point that is 34 feet south of said Line "X" extended, thence west, parallel with the North line of said Section 8, to a point 1755 feet, more or less, east of the West line of the North East 1/4 of said Section 8, and on the West, or extended West, line of a Dredged Ditch running in an East and West direction, as aforementioned, thence south, parallel with the West line of the North East 1/4 of said Section 8, 34 feet, thence West, parallel with the North line of said Section 8, to the West line of the North East 1/4 of said Section 8, thence north, along the West line of the North East 1/4 of said Section 8, 34 feet, to the place of beginning.

STATE OF WISCONSIN)
WINNEBAGO COUNTY) ss.

This is to certify that I, Fred M. Wolverton, a registered surveyor, No. 227, surveyed and mapped the parcel of land above described at the direction of the owner, Willis A. Young of Omro, Wisconsin and that the above is a clear and concise description of the land surveyed and that said map is a correct representation of all of the exterior boundaries of the land herein surveyed and that I have complied fully with all of the provisions of Chapter 236 of the Wisconsin Statutes in surveying and mapping the above described land.

Dated this 10th day of June, 1959.

Fred M. Wolverton
Fred M. Wolverton, Surveyor

STATE OF WISCONSIN)
WINNEBAGO COUNTY) ss WINNEBAGO COUNTY CERTIFIED SURVEY MAP NO. 1103

SHEET 1 of 3

A part of Government Lot 3 of Fractional Section 8, Township 18 North, Range 15 East and a part of Lots 3, 4, 5, 28 and 29 and of vacated Street lying east of and adjoining said Lots 3, 4, 5 and 28 in David Humes' Addition to the Omro Plat, First Ward, City of Omro, Winnebago County, Wisconsin

WISCONSIN REGISTERED LAND SURVEYOR, S-0913
STEVEN T. CHRONIS

DATED THIS 29th DAY OF March, 1983.



NORTH 1/4 CORNER

NORTH LINE NE 1/4 SECTION 17, T.10N, R.15E.
N. 69°-22'-39"E. 243.18

O = 1"x24" IRON PIPE WEIGHING 1.68
 LBS./LINEAL FOOT SET.
 A = 2" IRON PIPE FOUND 31
 O = 1" IRON PIPE FOUND
 □ = WINNEBAGO COUNTY BERTSEN
 MONUMENT (KIEDROWSKI CONTRACT)



WOOD RD.

**CENTER
SECTION 17**

AERO-METRIC ENGINEERING, INC.
1091 SOUTH WASHBURN STREET
OSHKOSH, WISCONSIN 54901

THIS INSTRUMENT DRAFTED BY STEVEN T. CHROHIS

L-1166

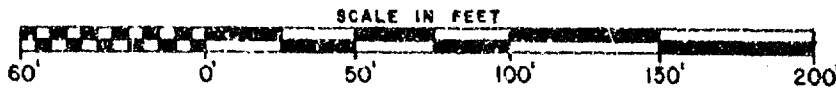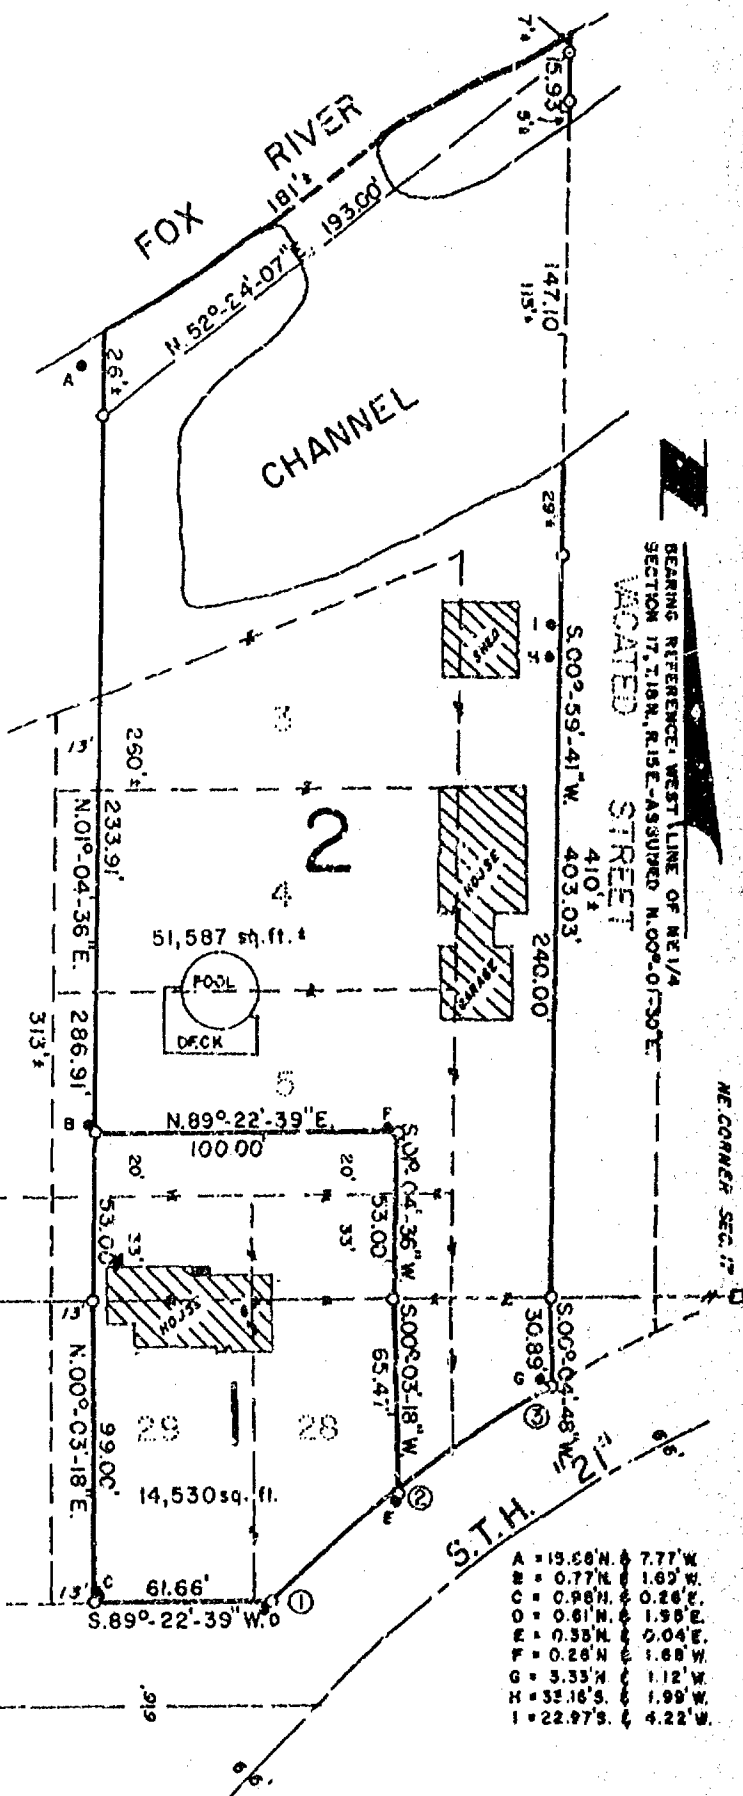

-----CURVE DATA-----

	---1 - 2---	---2 - 3---	---1 - 3---
Radius	: 456.72'	456.72'	456.72'
Chord length	: 51.23'	62.21'	113.22'
Chord bearing	: N.48°-29'-47"E.	N.55°-36'-59.5"E.	N.52°-24'-04.5"E.
Central angle	: 06°-25'-50"	07°-48'-35"	14°-14'-25"
Arc length	: 51.26'	62.25'	113.51'
Tangent bearing:	N.45°-16'-52"E.	N.51°-42'-42"E.	N.45°-16'-52"E.
Tangent bearing:	N.51°-42'-42"E.	N.59°-31'-17"E.	N.59°-31'-17"E.

State of Wisconsin)
 Winnebago County) SS

Surveyor's Certificate:

I, Steven T. Chronis, Wisconsin Registered Land Surveyor of Aero-Metric Engineering, Inc., certify that I have surveyed, divided and mapped under the direction of Earl S. Calhoun a part of Government Lot 3 of Fractional Section 8, T.18N., R.15E. and a part of Lots 3, 4, 5, 28 and 29 and of vacated Street lying East of and adjoining said Lots 3, 4, 5 and 28 in David Humes' Addition to the Omro Plat, First Ward, City of Omro, Winnebago County, Wisconsin containing 66,117 square feet more or less and being described by: Commencing at the North $\frac{1}{4}$ corner of Section 17, T.18N., R.15E., thence N.89°-22'-39"E. 243.18 feet to the true point of beginning, running thence N.01°-04'-36"E. 286.91 feet to a point which is 26 feet more or less from the water's edge of the Fox River, thence N.52°-24'-07"E. 193.00 feet along a meander line to a point which is 7 feet more or less from the water's edge of the Fox River and the end of the meander line, thence S.00°-59'-41"W. 403.03 feet, thence S.00°-04'-48"W. 30.89 feet, thence Southwesterly 113.51 feet along the arc of a curve to the left having a radius of 456.72 feet and the chord of which bears S.52°-24'-04.5"W. 113.22 feet, thence S.89°-22'-39"W. 61.66 feet, thence N.00°-03'-18"E. 99.00 feet to the true point of beginning, including all the land lying between the meander line and the water's edge of the Fox River.

That such is a correct representation of all exterior boundaries of the land surveyed.

That I have fully complied with the provisions of Chapter 236.34 of the Wisconsin Statutes and the Land Subdivision Ordinance of the City of Omro in surveying and mapping the same.

Dated this 29th day of March, 1983

Steven T. Chronis
 Wisconsin Registered Land Surveyor, S-0913
 Steven T. Chronis

City of Omro Planning Committee Certificate:

This Certified Survey Map of a part of Government Lot 3 of Fractional Section 8, T.18N., R.15E., and a part of Lots 3, 4, 5, 28 and 29 and of vacated Street lying East of and adjoining said Lots 3, 4, 5, and 28 in David Humes' Addition to the Omro Plat, City of Omro, Earl S. Calhoun, Irene M. Calhoun and Edward C. Kiesow, owners, is hereby approved.

3/30/83
 Date Approved

Edna Kiesow
 Authorized Representative

State of Wisconsin) SS
Winnebago County)

Owner's Certificate:

As owners, we hereby certify that we caused the land described on this Certified Survey Map to be surveyed, divided and mapped as represented on this map.

Dated this 30th day of March, 1983

In the Presence of:


Judith A. Schuster
Sonya Schuster

Earl S. Calhoon
Earl S. Calhoon
Irene M. Calhoon
Irene M. Calhoon

State of Wisconsin) SS
Winnebago County)


Personally came before me this 30th day of March, 1983, the above named Earl S. Calhoon, Irene M. Calhoon ~~to me known to be the~~ persons who executed the foregoing instrument and acknowledged the same.

James T. Chronis
Notary Public Wisconsin
My Commission Expires Aug 18, 1984

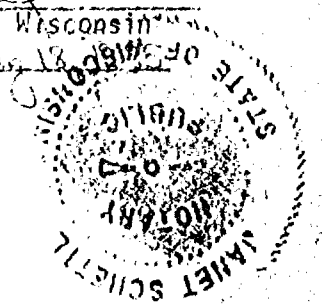

Steven T. Chronis
Wisconsin Registered Land Surveyor, S-0913
Steven T. Chronis

Dated this 29th day of March, 1983.

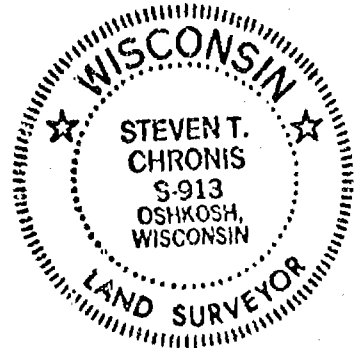

587992

L-1166


Earl S. Calhoon

Register's Office
Winnebago County, WI
Received for record this 30th day of March, A.D. 1983
at 11:32 o'clock A.M.
recorded in Vol. 103 of S.M.
James T. Chronis
Notary Public

Bd.
8.00

WINNEEAGO COUNTY CERTIFIED SURVEY MAP NO. 643


Lots 2 and 3 and part of Lots 1 and 4 of Block 3 of JOHNSON'S
FIRST ADDITION to the City of Onro.

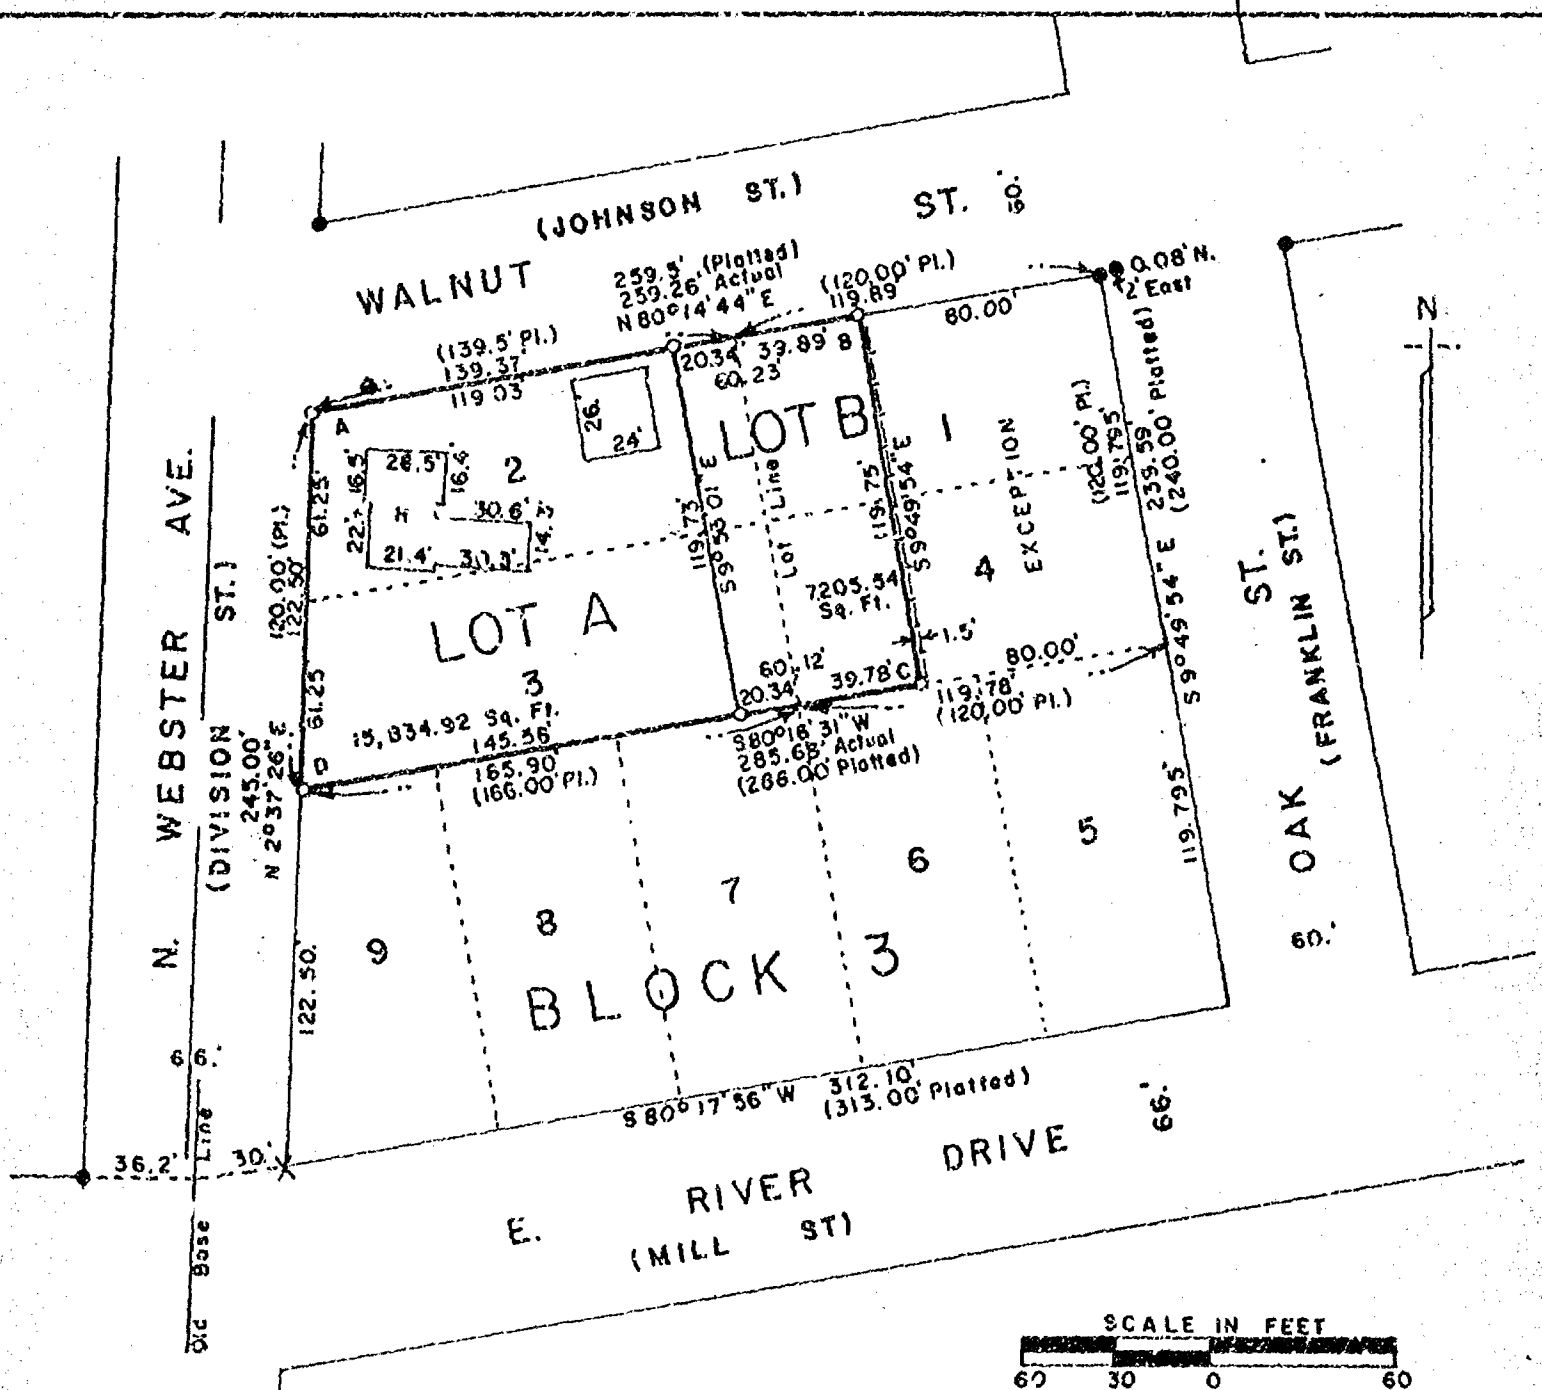

Interior angles:

- A. $102^{\circ}22'42''$
 B. $90^{\circ}04'38''$
 C. $89^{\circ}53'35''$
 D. $77^{\circ}39'05''$
 $360^{\circ}00'00''$

- Existing iron pipe
 - |- Existing board fence
 - Existing buildings
 - X Cross cut in concrete
 - 1"x30" iron pipe weighing 1.13 lbs./lineal ft.
- Bearings are referenced to the West line
of Block 3 of Johnson's First Addition,
assumed bearing, $N2^{\circ}37'26''E$.

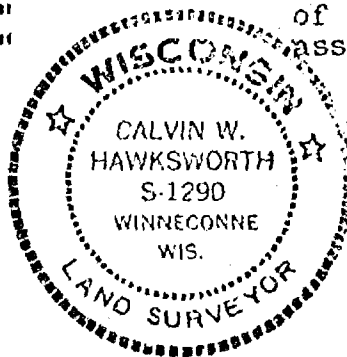

Calvin W. Hawksworth
 Calvin W. Hawksworth S-1290
 Wisconsin Registered Land Surveyor
 August 3, 1979.

Sheet 1 of 2 sheets

WINNEBAGO COUNTY CERTIFIED SURVEY MAP NO. 643

Lots 2 and 3 and part of Lots 1 and 4 of Block 3 of JOHNSON'S FIRST ADDITION to the City of Omro.

I, Calvin W. Hawksworth, registered land surveyor, hereby certify:

That I have surveyed, divided and mapped the parcels of land located in part of Block 3 of JOHNSON'S FIRST ADDITION to the City of Omro, Winnebago County, Wisconsin, described as follows:

LOT A


Lots 2 and 3 of Block 3 of JOHNSON'S FIRST ADDITION to the city of Omro, Winnebago County, Wisconsin, excepting therefrom the Easterly 20.34 ft., thereof.

LOT B

Lots 1 and 4 and the Easterly 20.34 ft. of Lots 2 and 3 of Block 3 of JOHNSON'S FIRST ADDITION to the City of Omro, Winnebago County, Wisconsin, excepting therefrom the Easterly 80.00 ft. of Lots 1 and 4.

That I have made such survey, division and map by the direction of Jamil Roggow, 2317 Minerva St., Oshkosh, Wisconsin, 54901; that such map is a true and correct representation of the exterior boundaries of the land surveyed.

That I have fully complied with the provisions of Sec. 236.34 of the Wisconsin Statutes and Ordinance No. 222 of the City of Omro in surveying and mapping the same.

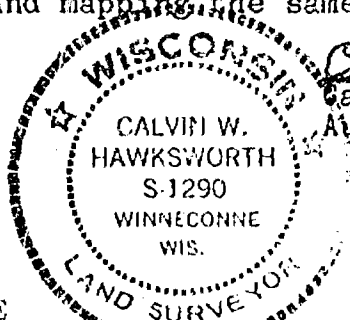

Calvin W. Hawksworth
Calvin W. Hawksworth S-1290 WRLS
August 3, 1979

OWNER'S CERTIFICATE

As owner(s) I(we) hereby certify that I(we) caused the land described on this map to be surveyed and mapped as represented hereon.

8-16-79
Date

Jamil C. Roggow
owner(s)

2317 Minerva St.
Address

Oshkosh, Wis. 54901
City-State Zip

PLANNING COMMISSION CERTIFICATE

This Certified Survey Map of part of Block 3 of JOHNSON'S FIRST ADDITION to the City of Omro is hereby approved.

8-21-79
Date

Edwin Sheppard
Authorized representative

539038


Registrar's Office
Winnebago County, Wis.
Received for record this 24th
day of August, A.D., 1979
at 11:00 o'clock A.M. and
recorded in Vol. of Survey maps
on page 1243.

John M. Davis
Registrar of Deeds

John A. Roggow AD
2.00

Topographic Survey
for
James A. Wirth
of

A part of Government Lot 5 of Fractional Section 8, T. 18 N., R. 15 E., Town of Omro, Winnebago County, Wisconsin being 1860.85 feet South of the Northwest corner of Government Lot 5 and East 33 feet, N. 78°-50' E. 180 feet, N. 67°-38' E. 180 feet, N. 55°-08' E. 240 feet to the Northwest corner of property. Property described in Document No. 512321 of Records.

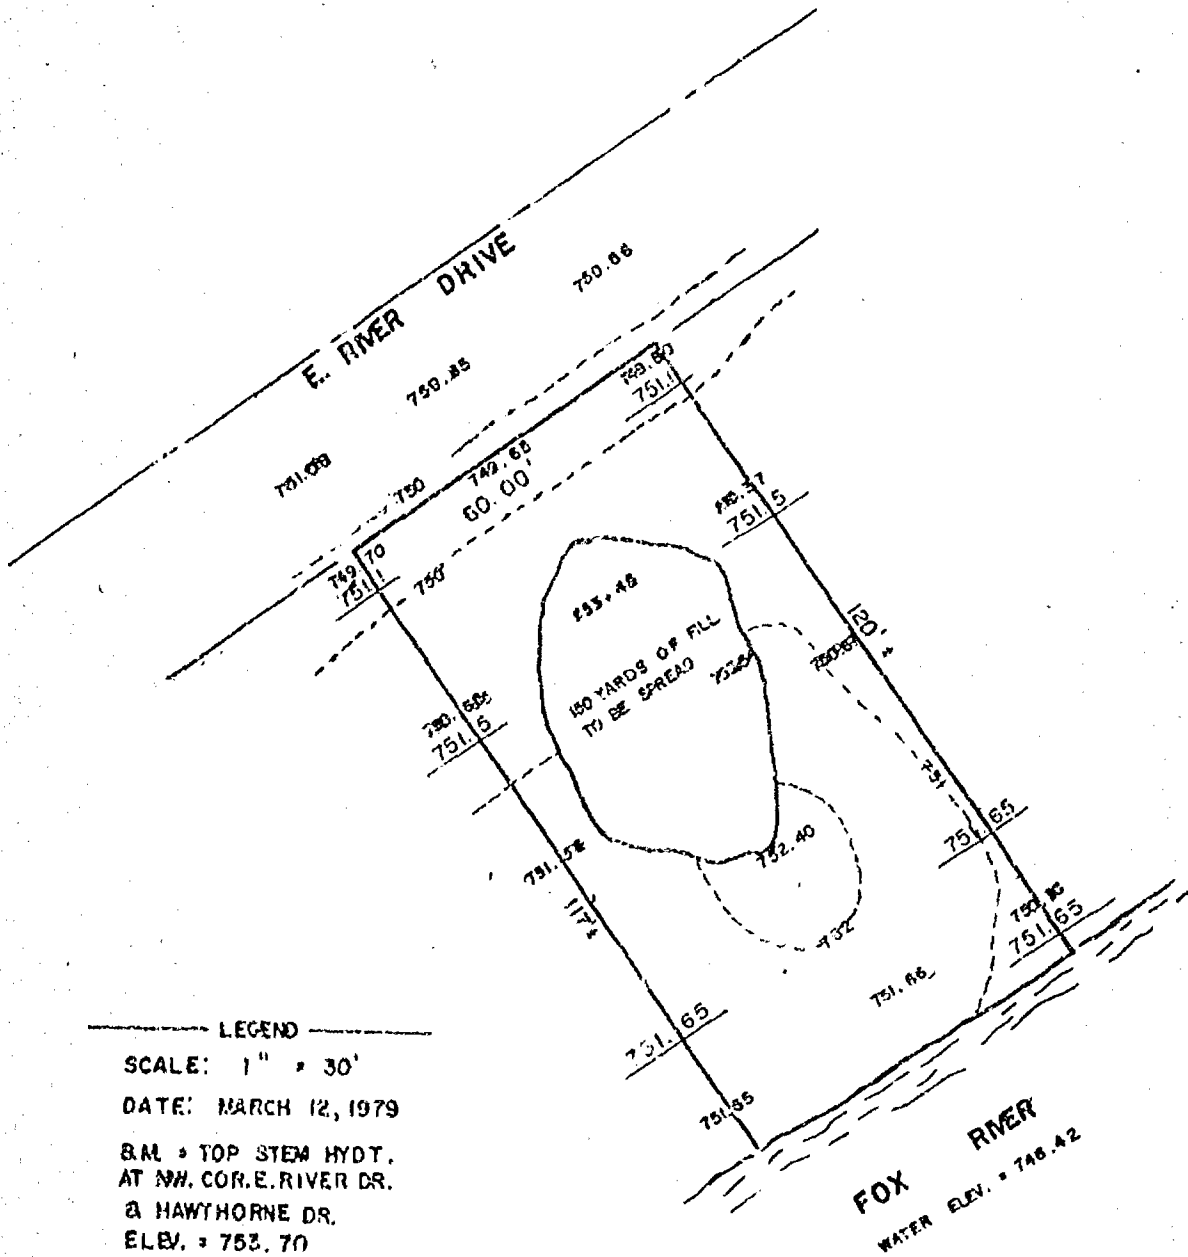

LEGEND

SCALE: 1" = 30'

DATE: MARCH 12, 1979

B.M. * TOP STEM HYDT.
AT NW. COR. E. RIVER DR.

2 HAWTHORNE DR.

ELEV. = 753.70

750.0 • EXISTING GROUND EL.

751.5 = GRADE AFTER FILL IS SPREAD

751.5 : WATER EL. OF BASE FLOOD




AERO-METRIC ENGINEERING, INC.
PHOTOGRAMMETRIC ENGINEERS
LAND SURVEYORS
OSHKOSH, WISCONSIN

Harvey T. Chromab
WIS. REGISTERED LAND SURVEYOR S-913

WIS. REGISTERED LAND SURVEYOR S-913

NOTEBOOK 17 PAGE 49-50

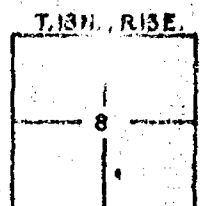


L-648

8 18 15 12

EUGENE MATHE

LOTS 8 & 9 OF FRANK'S ADDITION TO THE
CITY OF OMRO, WINNEBAGO CO., WISCONSIN

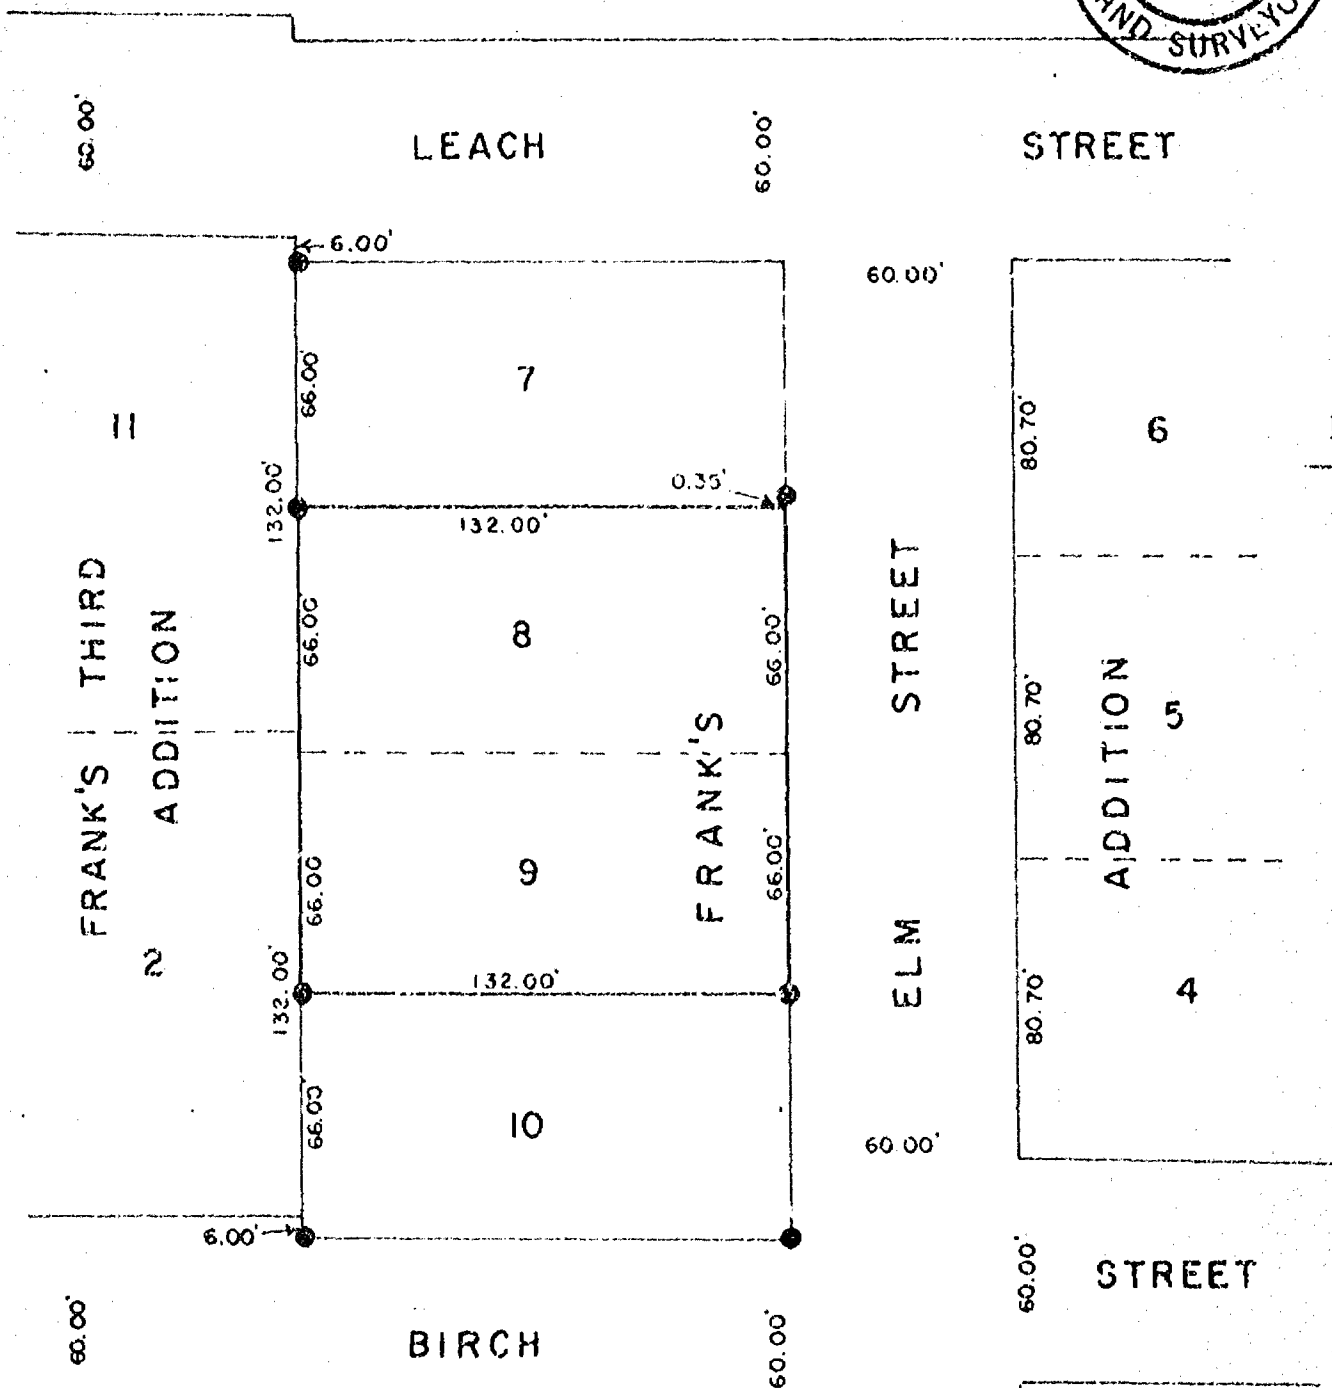

R. K. Saylor
Surveyor S-417

● DENOTES EXISTING IRON PIPE

SCALE: 1 in. = 50 ft.

BK. 28

P. 126

FEBRUARY 4, 1975


S - 000416

LOT 1 FRANK'S 3RD ADD
OMRO

8 18 15 15

Page 123

5.16 chains

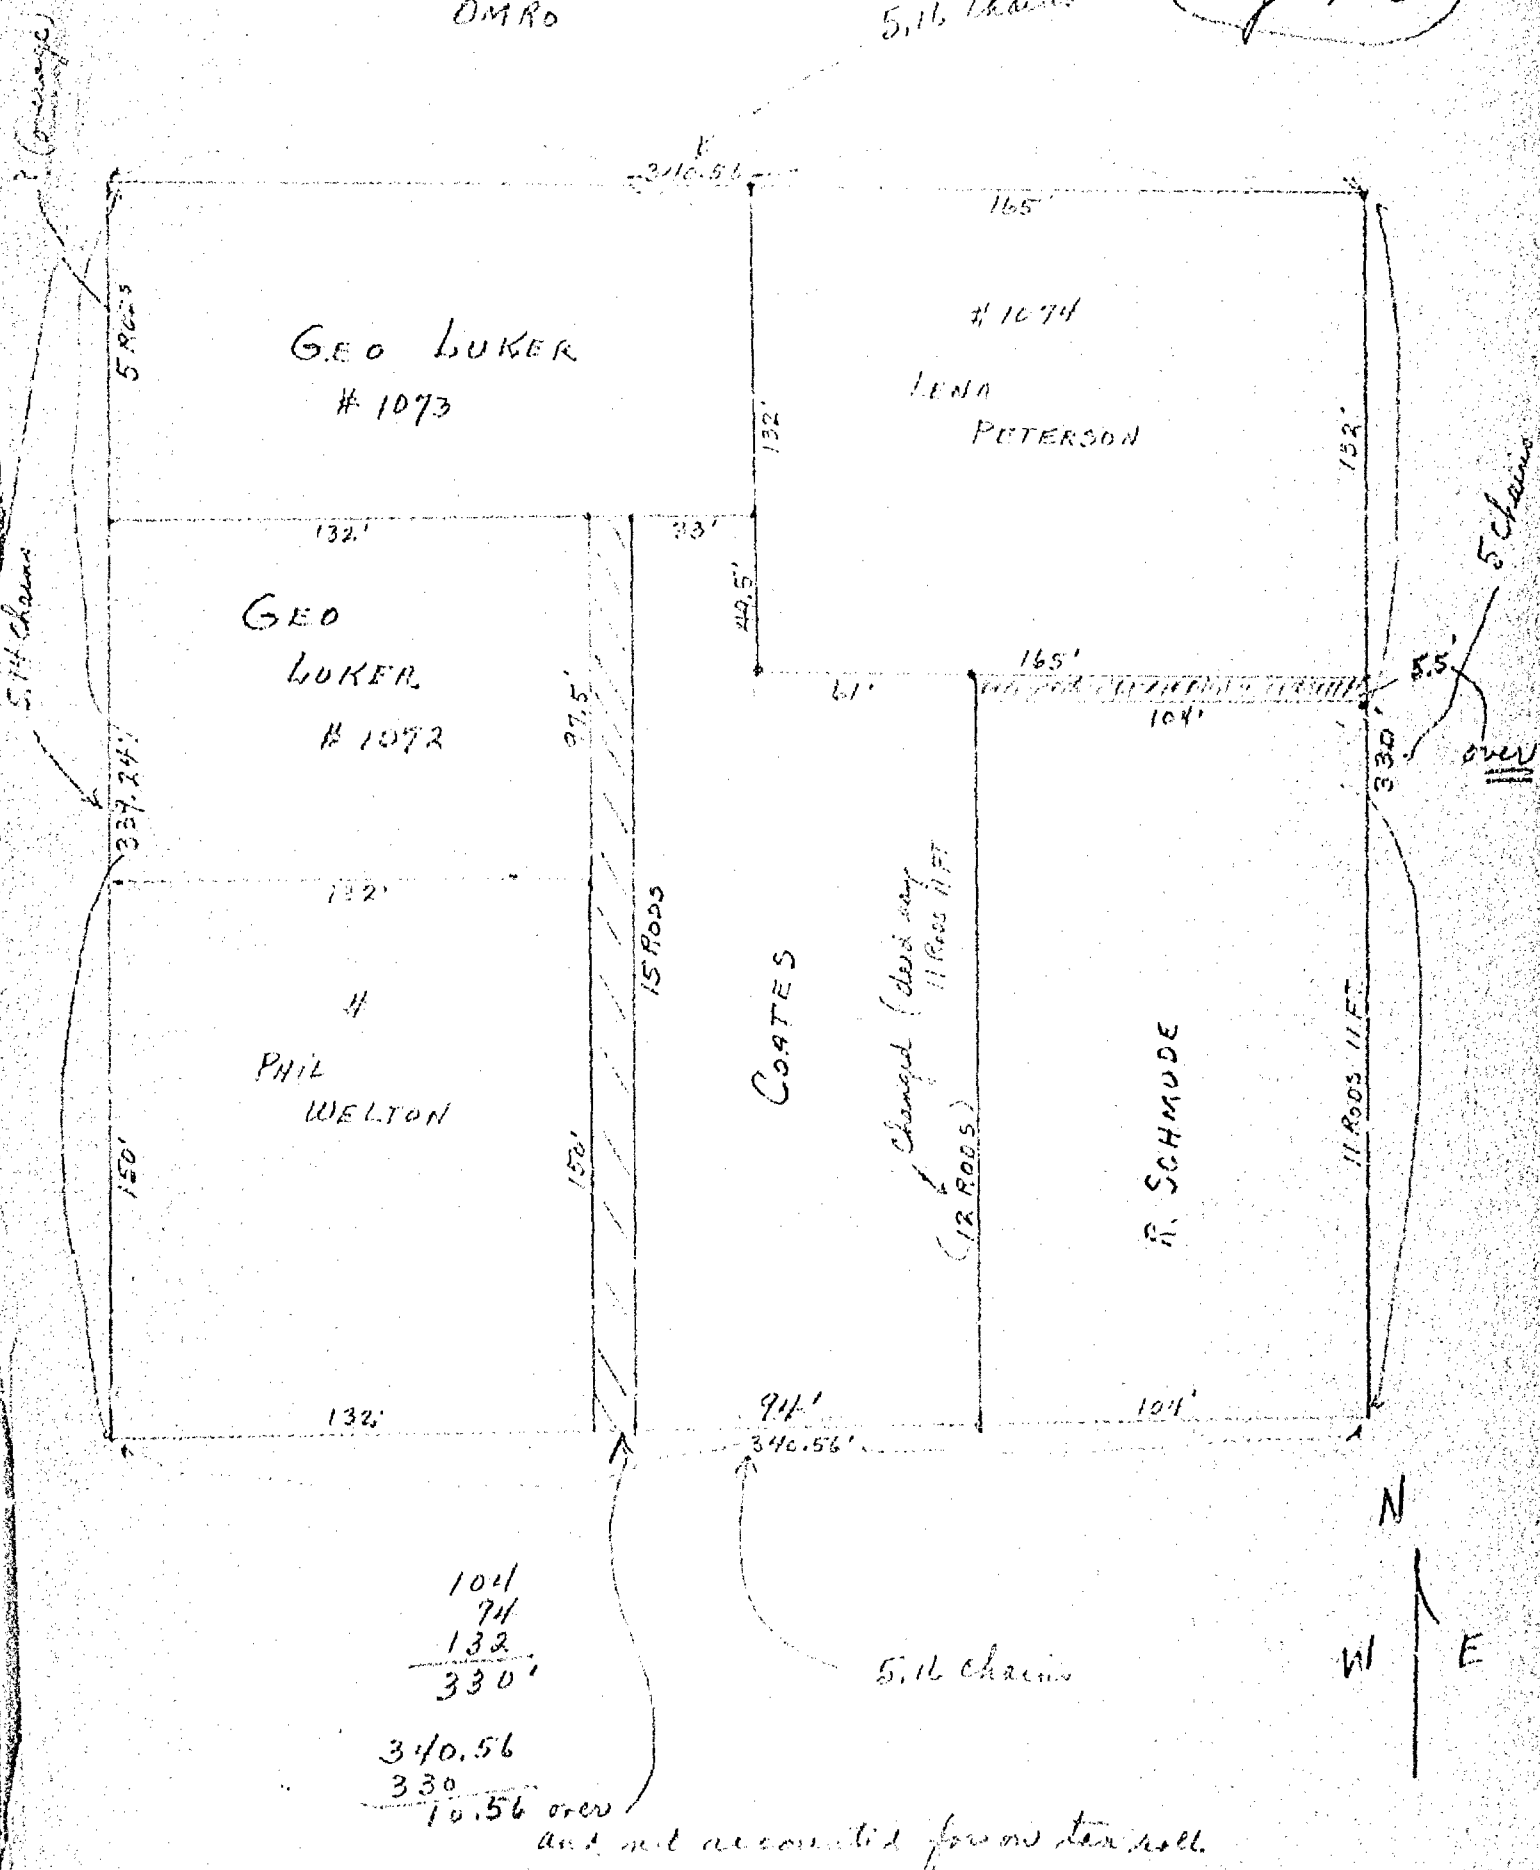


Winn. Co.

FORM NO. 985-A

18-15-8


WINNEBAGO COUNTY CERTIFIED SURVEY MAP NO.
Part of Gov't. Lot 6 of the Fractional SE $\frac{1}{4}$ of the SW $\frac{1}{4}$ of Sec. 8,
T.13N., R.15E., City of Omro, Winnebago County, Wisconsin

CORRECTION TO DOC. NO. 549257 of Vol. 1 of Certified Survey Maps
Bearings are referenced to the East line of Outlots 6&7, assumed
bearing, S02°52'18"E..

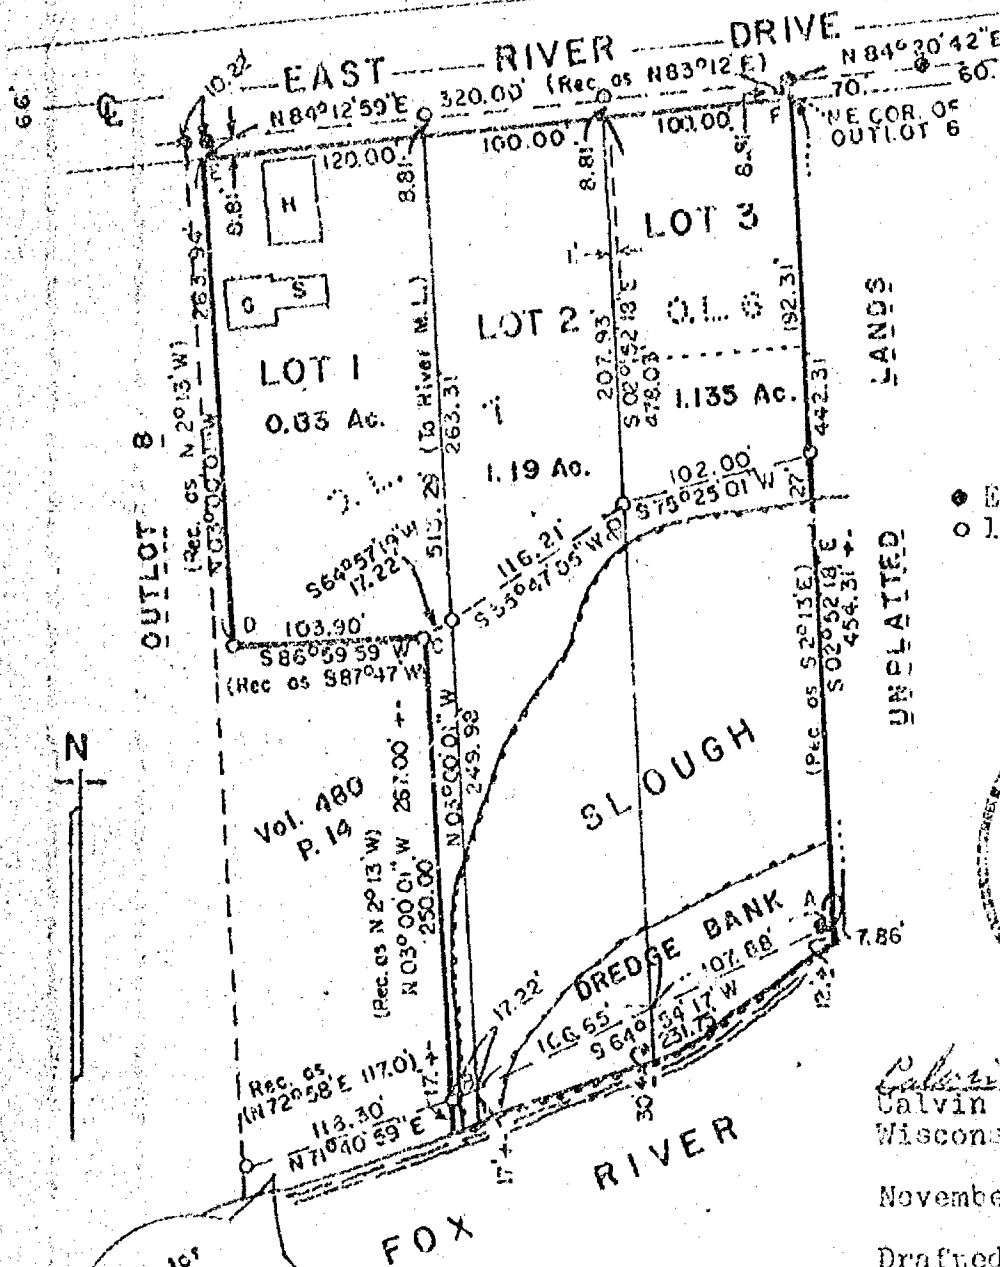

Interior Angles:
A. 112°13'25"
B. 67°54'18"
C. 270°00'00"
D. 90°00'00"
E. 92°47'00"
F. 87°05'17"
720°00'00"

• Existing monuments
• 1"x30" iron pipe
weighing 1.13 lbs.
per lineal ft. set

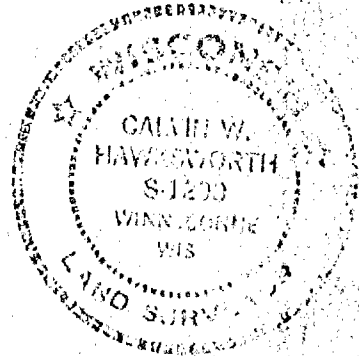

Calvin W. Hawksworth
Calvin W. Hawksworth S-1290
Wisconsin Registered Land
Surveyor

November 5, 1980

Drafted by Irene Haedt

CITY PLANNING COMMISSION CERTIFICATE

Approved for recording by Omro City Planning Commission action
of _____

Authorized representative

Sheet 1 of 2 sheets

WINNEBAGO COUNTY CERTIFIED SURVEY MAP NO.
Part of Gov't. Lot 6 of the Fractional SE $\frac{1}{4}$ of the SW $\frac{1}{4}$ of Sec. 8,
T.18N., R.15E., City of Omro, Winnebago County, Wisconsin.

CORRECTION TO DOC. NO. 549257 of Vol. 1 of Certified Survey Maps


I, Calvin W. Hawksworth, registered land surveyor, hereby certify:

That I have corrected and mapped the parcel of land located in part of Gov't. Lot 6 in the Fractional SE $\frac{1}{4}$ of the SW $\frac{1}{4}$ of Sec. 8, T.18N., R.15E., including Outlot 6 and part of Outlot 7 of the PLAT OF OUTLOTS NORTH OF THE FOX RIVER, all in the City of Omro, Winnebago County, Wisconsin, which is recorded as Document No. 549257 of Certified Survey Maps of Winnebago County Records and which is correctly described as follows: Beginning at the Northeast corner of Outlot 6 of the PLAT OF OUTLOTS NORTH OF THE FOX RIVER. From that point running S02°52'18"E, 442.31 ft. to a meander line of the Fox River, thence S64°54'17"W, along said meander line, 231.75 ft., thence N03°00'01"W, 250.00 ft., thence S86°59'59"W, 103.90 ft., thence N03°00'01"W, 263.94 ft. to the Southerly R.O.W. line of East River Drive, thence N84°12'59"E, along said R.O.W. line, 320.00 ft. to the said point of beginning. Including all of the land lying between the meander line and the water's edge of the Fox River. Subject to easements and restrictions of record.

That I have made such correction to Document No. 549257 because of an unnoticed addendum to Vol. 480, Page 14 of Winnebago County Records; that such map is a correct representation of the exterior boundaries of the land surveyed.

That I have fully complied with the provisions of Sec. 236.34 of the Wisconsin Statutes and Ordinance No. 222 of the City of Omro in surveying, dividing and mapping the same.


Calvin W. Hawksworth
Calvin W. Hawksworth S-1290
Wisconsin Registered Land Surveyor
November 5, 1980

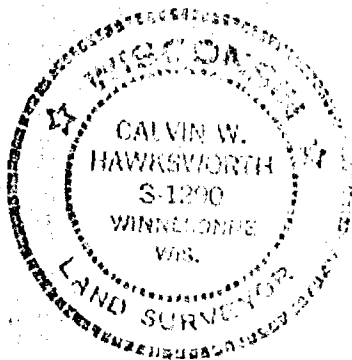

ZONING OFFICE
RECEIVED
 FEB 12 1979
RECEIVED

Topographic Survey
 for
 William Hellwig
 of


A part of Lot 1 North of the Fox River, according to Plat of Outlots in the Village of Omro and now in the 3rd Ward, City of Omro, being a part of Con't Lot 6 of Fractional Section 8, T. 18 N., R. 15 E., Winnebago County, Wisconsin.

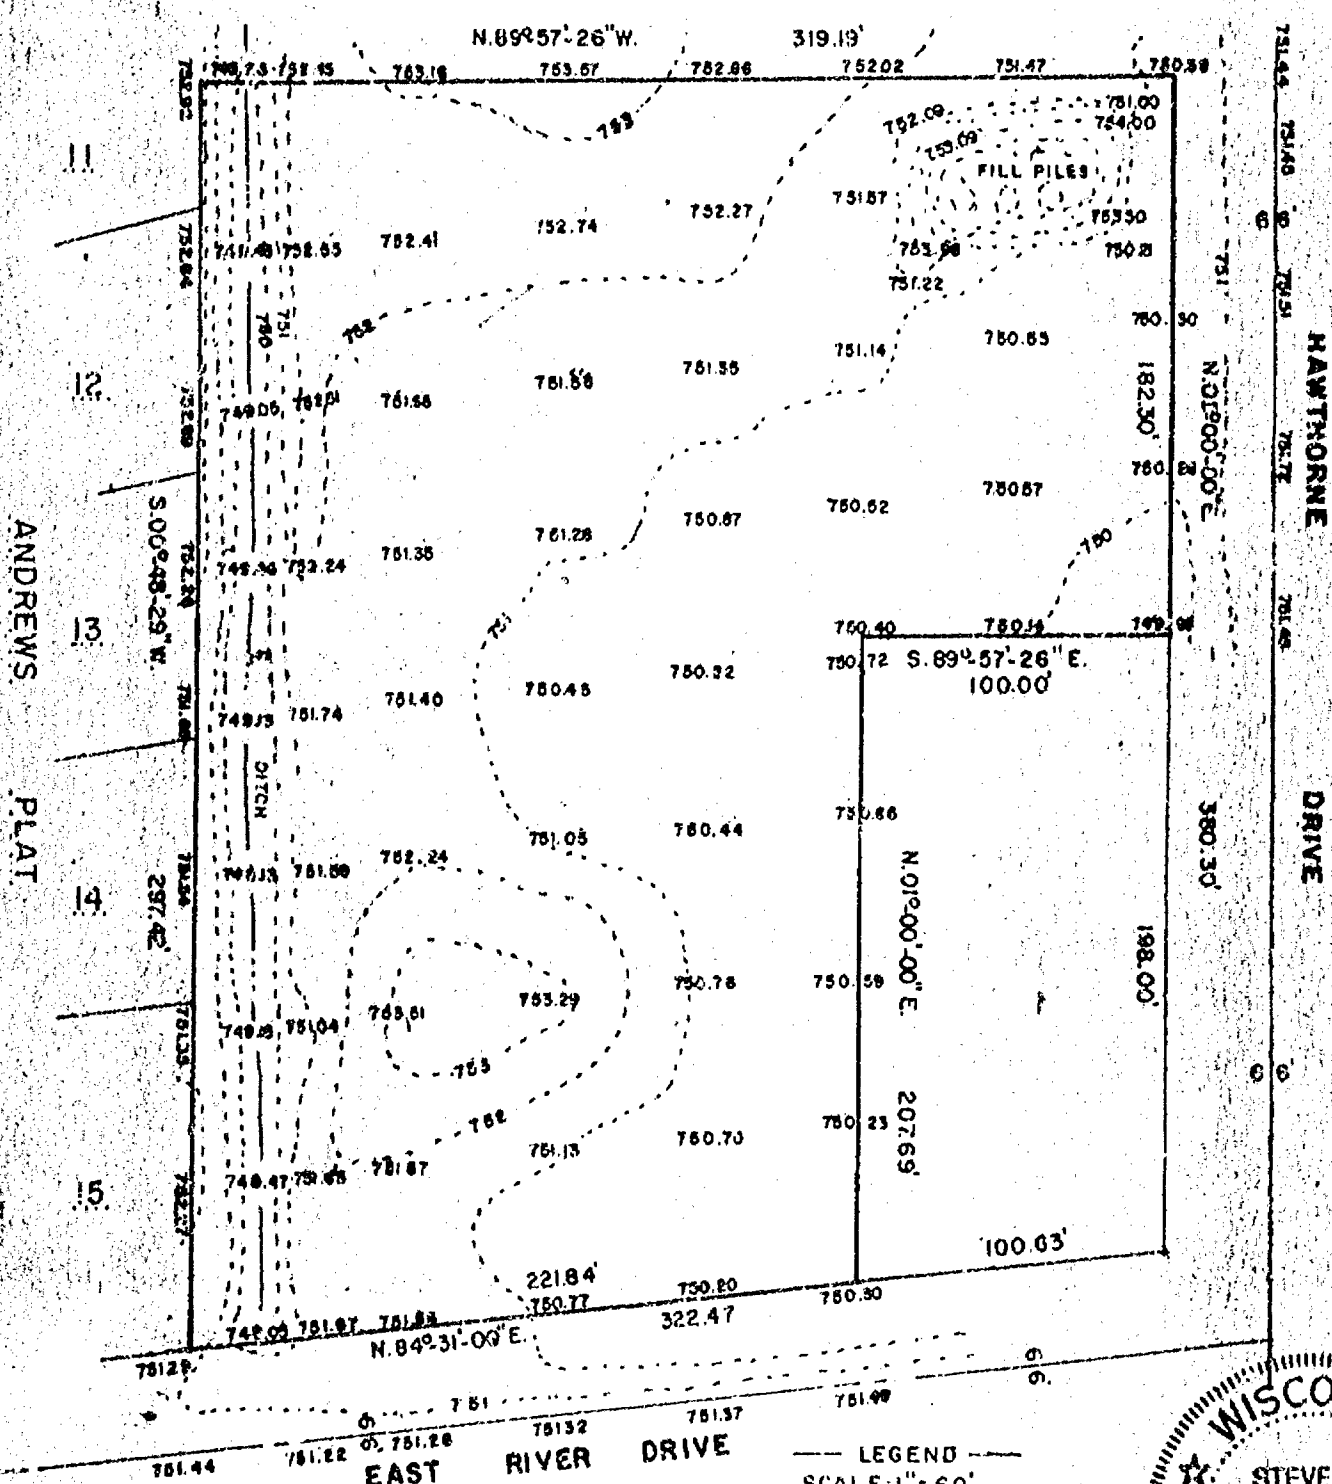

AERO-METRIC ENGINEERING, INC.
 PHOTOGRAMMETRIC ENGINEERS
 LAND SURVEYORS
 OSHKOSH, WISCONSIN

Steven T. Chronis
 WIS. REGISTERED LAND SURVEYOR 9-913

LEGEND
 SCALE: 1" = 60'
 DATE JAN. 31, 1979
 BM = TOP STEM RD. AT
 NW COR. HAWTHORNE & B
 EAST RIVER DR. ELEV. = 753.70'

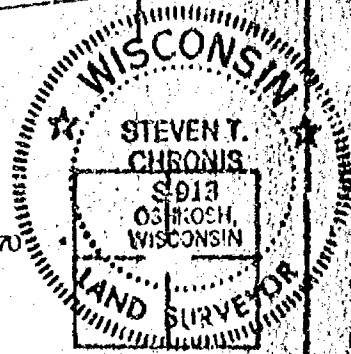


CARL M.

8 18 15 8

ELMER KOSSEL TO RICHARD C. KOSSEL
PART OF GOV'T LOT 2 OF THE S.E. 1/4 OF
SEC. 8, T.18N., R.15E., IN THE CITY OF
OMRO, WINNEBAGO COUNTY, WISCONSIN
Scale 1 in. = 100 ft. Oct. 12, 1960
R. K. Saylor Surveyor

S-417

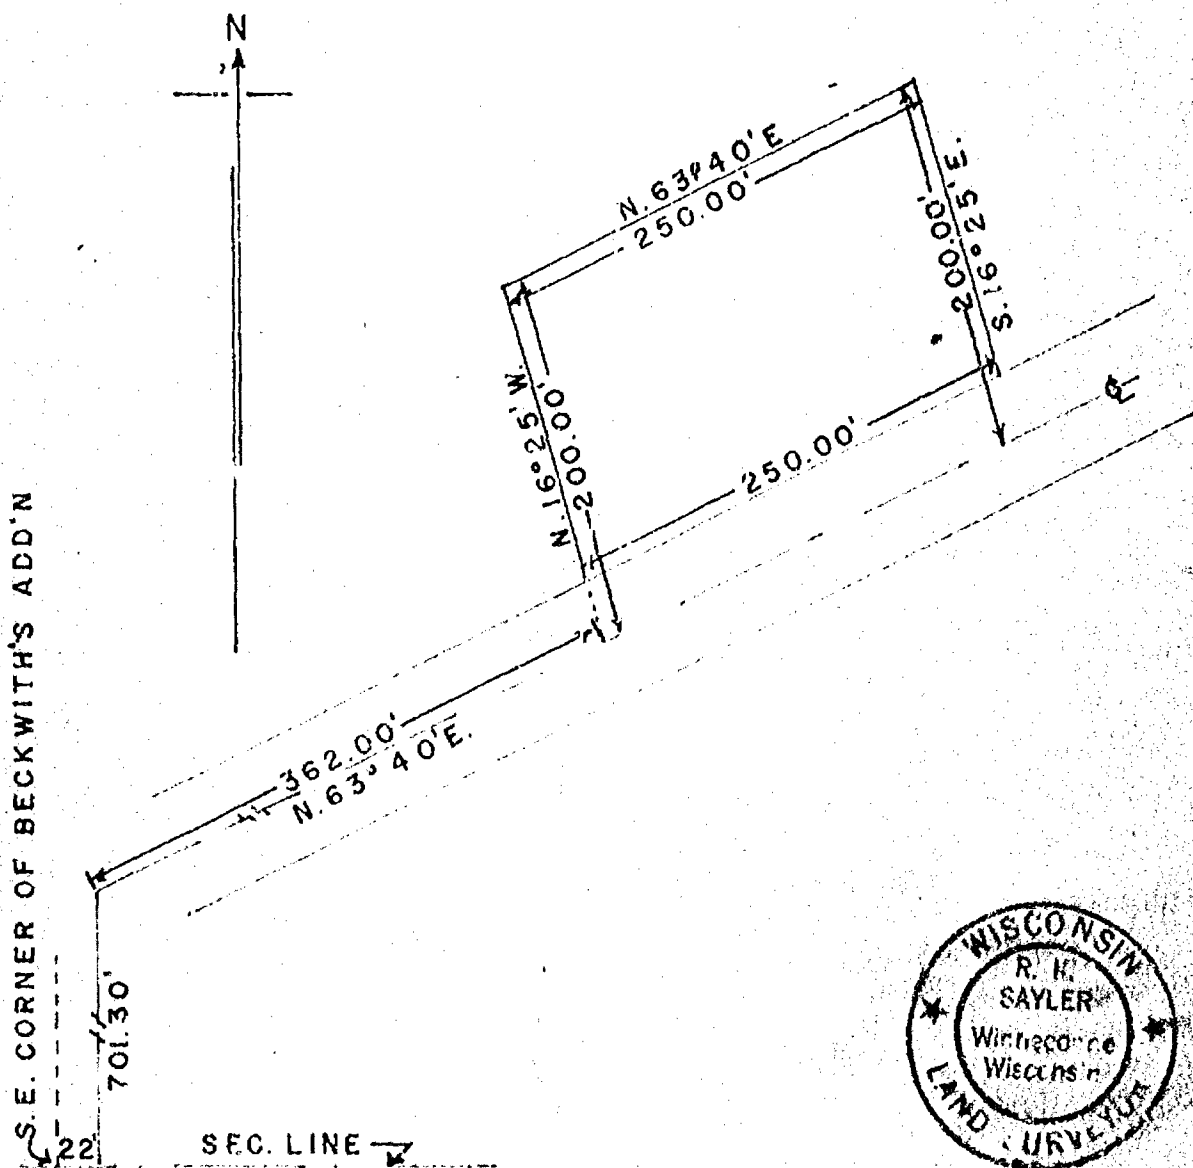


8-18-15


Winnebago

Plat of Survey

CLIENT: Margaret Schulz
526 E. River Drive
Omro, Wisconsin 54963

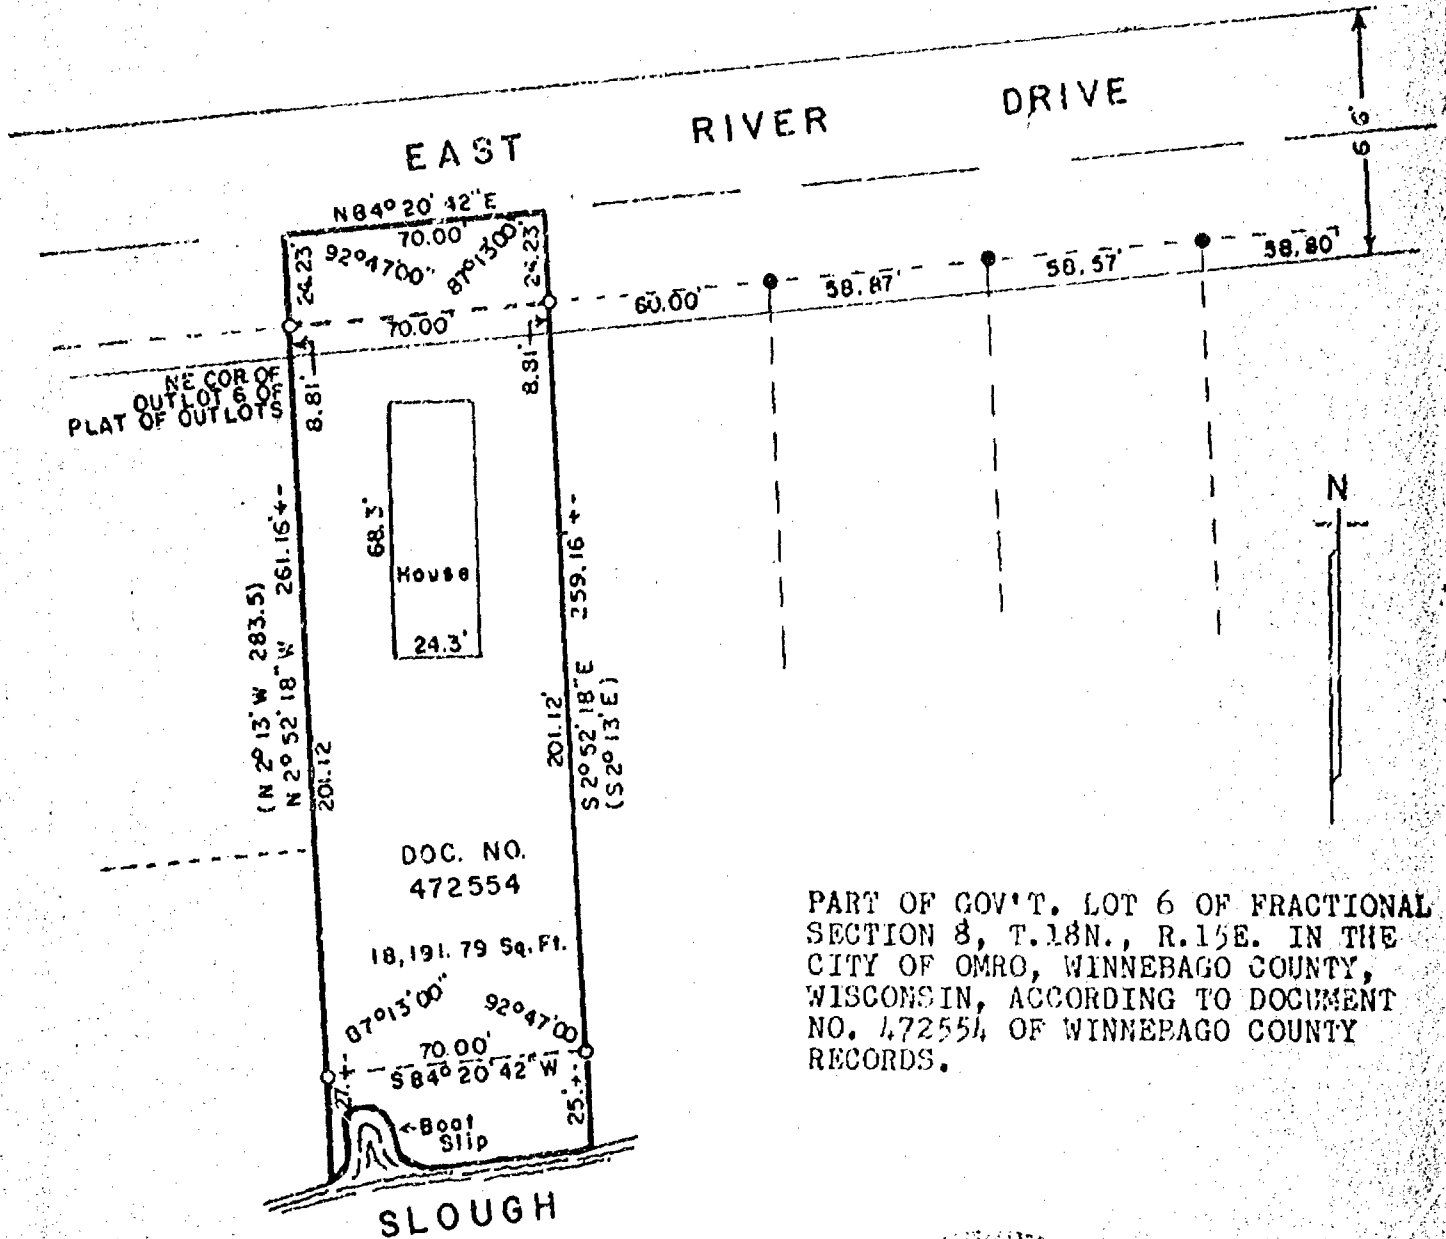

PART OF GOV'T. LOT 6 OF FRACTIONAL SECTION 8, T.18N., R.15E. IN THE CITY OF OMRO, WINNEBAGO COUNTY, WISCONSIN, ACCORDING TO DOCUMENT NO. 172554 OF WINNEBAGO COUNTY RECORDS.

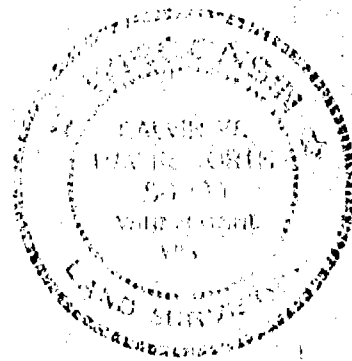

LEGEND

- = Existing monuments
- = 2" x 30" iron pipe set
- = 1" x 30" iron pipe set
- = reference caps or RR spikes
- = Bernsten or Harrison monuments
- x-x = fence
- () = recorded as
- = stone monument

SURVEYORS CERTIFICATE

I, hereby certify that I have surveyed the property as shown, according to official records and that the plat above drawn is an accurate and correct representation of said survey. **FEBRUARY 4, 1980**

Calvin W. Krohn
Wisconsin Registered Land Surveyor S-1250




R. K. SAYLER, INC.
LAND SURVEYORS
WINNECONNE, WI 54986

SCALE 1 in. = 50 ft.
PROJECT NO. S-00154
FIELD BOOK 37 PAGE 47


Stock No. 26273

REVISED WINNEBAGO COUNTY CERTIFIED SURVEY MAP NO. 1161
 Located in part of Government Lot 6 of the Fractional Southeast $\frac{1}{4}$
 of the Southwest $\frac{1}{4}$ of Section 8, T.18N., R.15E., City of Omro,
 Winnebago County, Wisconsin

Revision of Certified Survey Map No. 837, Recorded Dec. 8, 1980
in Vol. 1, Page 837, Document No. 558222

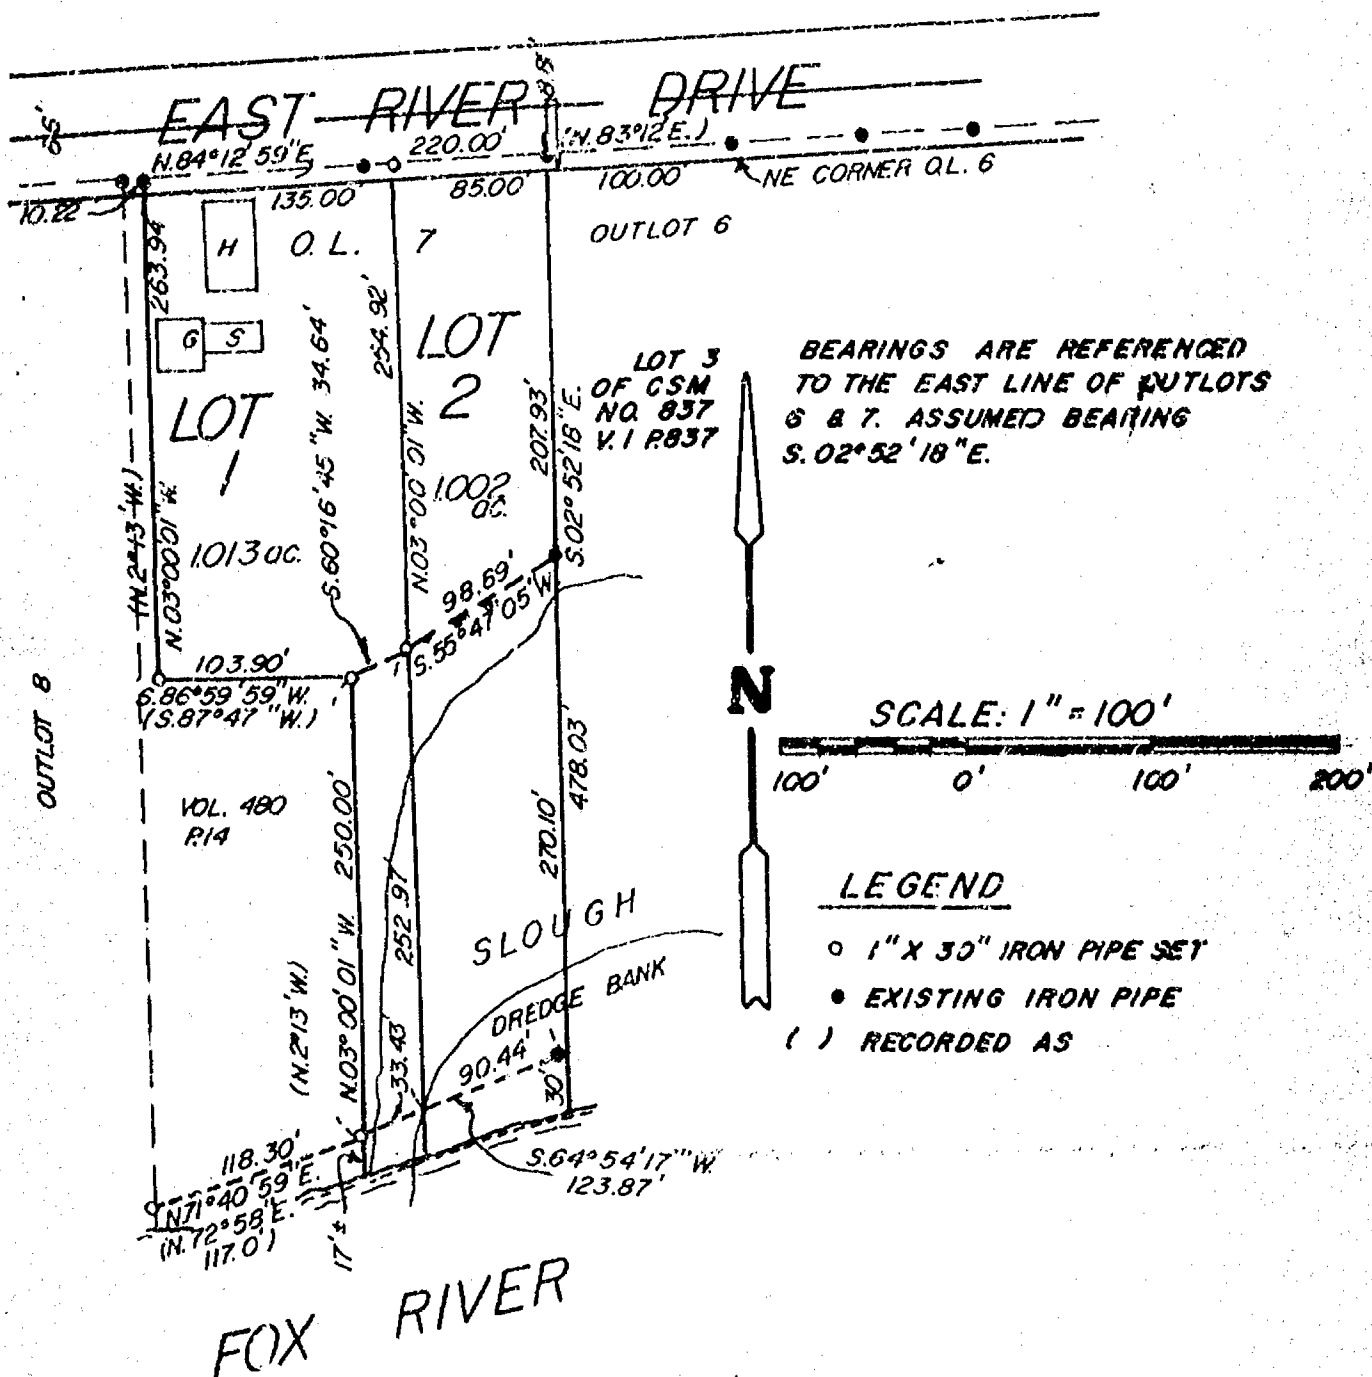

 Calvin W. Hawksworth S-1290
Wisconsin Registered Land Surveyor
July 29, 1983



Stock No. 26273

REVISED WINNEBAGO COUNTY CERTIFIED SURVEY MAP NO. 1161
 Located in part of Government Lot 6 of the Fractional Southeast $\frac{1}{4}$
 of the Southwest $\frac{1}{4}$ of Section 8, T.18N., R.15E., City of Omro,
 Winnebago County, Wisconsin

SURVEYOR'S CERTIFICATE

I, Calvin W. Hawksworth, registered land surveyor, hereby certify:

That I have surveyed, divided and mapped the parcel of land located in part of Government Lot 6 of the Fractional Southeast $\frac{1}{4}$ of the Southwest $\frac{1}{4}$ of Section 8, T.18N., R.15E., City of Omro, Winnebago County, Wisconsin, described as follows: Beginning at a point that is 100.00 ft. S.84°12'59"W. from the Northeast corner of Outlot 6, PLAT OF THE OUTLOTS NORTH OF THE FOX RIVER. From that point running S.02°52'18"E. 478.03 ft. to a point that is 30 ft. N.02°52'18"W. of the high water mark of the Fox River, thence S.64°54'17"W. 123.87 ft. along a meander line, thence N.03°00'01"W. 250.00 ft., thence S.86°59'59"W. 103.90 ft., thence N.03°00'01"W. 263.94 ft. to the southerly right-of-way line of East River Drive, thence N.84°12'59"E. 220.00 ft. along said southerly right-of-way line to the point of beginning. Including all land lying between the meander line and the high water mark of the Fox River. Being a parcel of land of 2.015 acres, more or less.

That I have made such survey, land division and map by the direction of Stanley Andruski, 510 E. River Drive, Omro, WI 54963; that such map is a true and correct representation of the exterior boundaries of the land surveyed.

That I have fully complied with the provisions of Sec. 236.34 of the Wisconsin Statutes and the City of Omro Subdivision Ordinance in surveying, dividing and mapping the same.



Calvin W. Hawksworth
 Calvin W. Hawksworth S-1290
 Wisconsin Registered Land Surveyor
 July 29, 1983

CITY OF OMRO PLANNING COMMISSION CERTIFICATE

This Certified Survey Map is hereby approved for recording by the Omro City Planning Commission.

9/6/83
 Date Approved

David Chase
 Authorized Signature

Sheet 2 of 3 Sheets

SAYLER SURVEY, INC. 330 Birch St., Box 252, Winneconne, WI 54986
 414-582-4234

Stock No. 26273

REVISED WINNEBAGO COUNTY CERTIFIED SURVEY MAP NO. 1161
 Located in part of Government Lot 6 of the Fractional Southeast $\frac{1}{4}$
 of the Southwest $\frac{1}{4}$ of Section 8, T.18N., R.15E., City of Omro,
 Winnebago County, Wisconsin

OWNER'S CERTIFICATE

As owner(s), I (we) hereby certify that I (we) caused the
 land described on this certified survey map to be surveyed, divided
 and mapped as represented hereon.

WITNESS the hand and seal of said owner(s) this 4th day
 of August, 1983.

In presence of:

John H. Wallace III
 Witness John H. Wallace III

Stanley Andruski
 Stanley Andruski - Owner


510 E. River Dr.

Street Address

Omro, WI 54963
 City State Zip

STATE OF WISCONSIN)
 WINNEBAGO COUNTY) SS

Personally came before me this 4th day of August,
 1983, the above named owner(s) to me known to be the person(s) who
 executed the foregoing instrument and acknowledged the same.

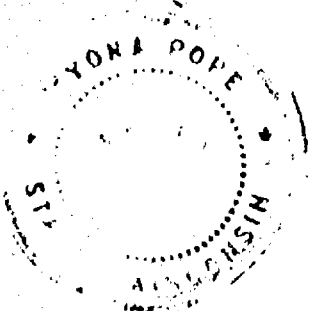

Wyona Pope
 Notary Public, Winnebago Co. WI
 Wyona Pope

My commission expires 10/2/83.

Calvin W. Hawksworth
 Calvin W. Hawksworth S-1290
 Wisconsin Registered Land Surveyor
 July 29, 1983

Sheet 3 of 3 Sheets

SAYLER SURVEY, INC. 330 Birch St., Box 252, Winneconne, WI 54986
 414-582-4234

597702

Register's Office

Winnebago County, Wis.

Received for record this 9th
 day of Sept, A.D., 1983
 at 8:50 o'clock A.M. and
 recorded in Vol. 1 of S.M.
 on page 1161

Wynne A. Dahm
 Register of Deeds



Sayler Survey Pd 8⁰⁰

zoning

8-18-15


FORM NO. 985-A

N.C.M. & Co. Inc.

WINNEBAGO COUNTY CERTIFIED SURVEY MAP NO. 837
Part of Gov't. Lot 6 of the Fractional SE $\frac{1}{4}$ of the SW $\frac{1}{4}$ of Sec. 8,
T.18N., R.15E., City of Omro, Winnebago County, Wisconsin.

CORRECTION TO DOC. NO. 549257 of Vol. 1 of Certified Survey Maps Page 755


Bearings are referenced to the East line of Outlots 6&7, assumed bearing, S02°52'18"E.

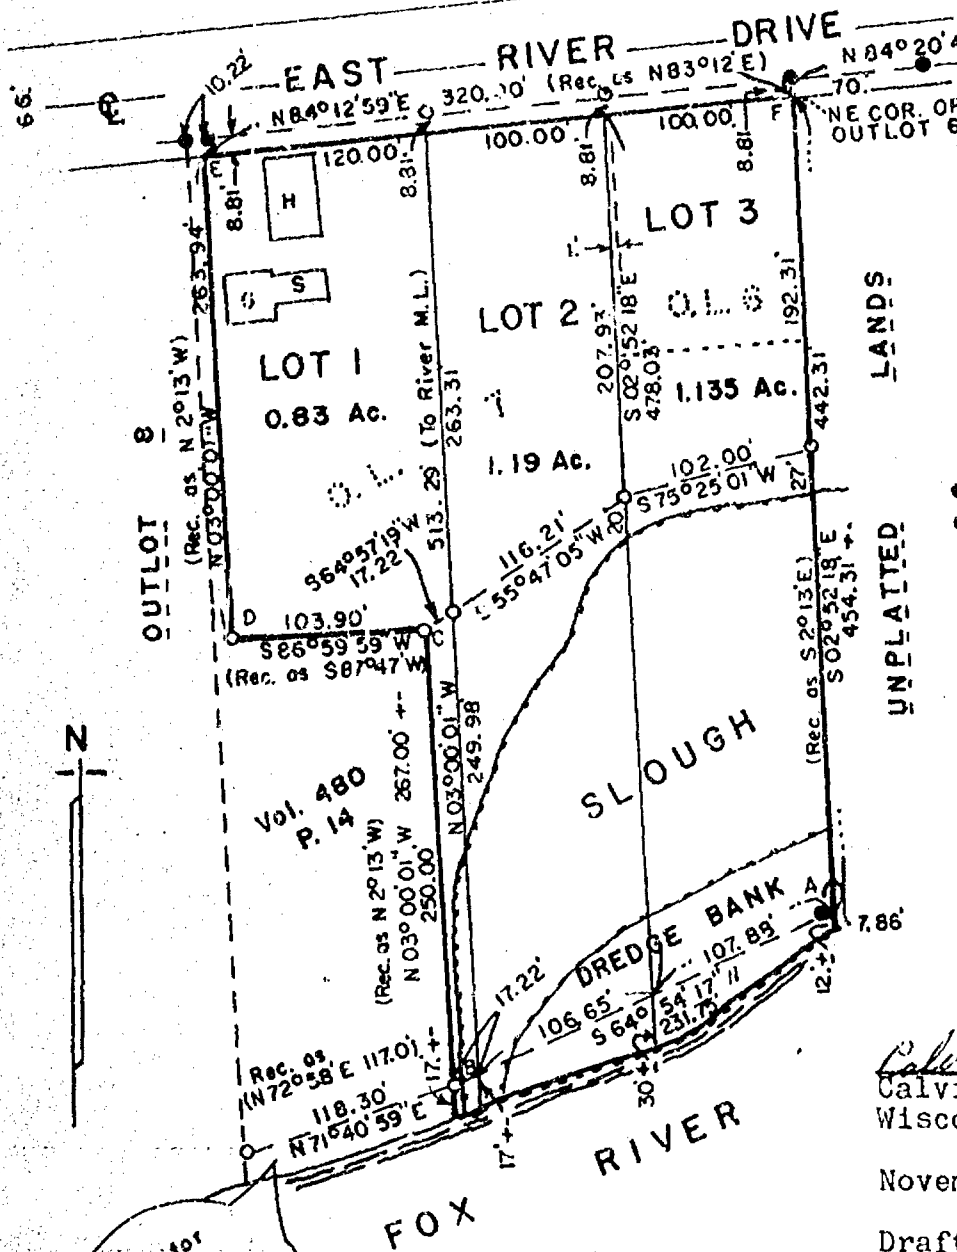

Interior Angles:

- A. 112°13'25"
- B. 67°54'18"
- C. 270°00'00"
- D. 90°00'00"
- E. 92°47'00"
- F. 87°05'17"
- 720°00'00"

- Existing monuments
- 1"x30" iron pipe
- weighing 1.13 lbs.
- per lineal ft. set

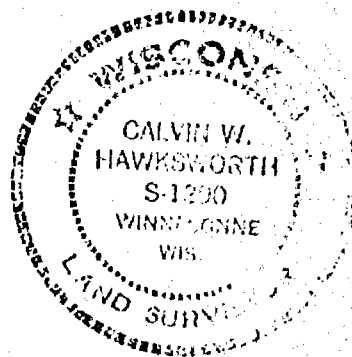


Calvin W. Hawksworth
Calvin W. Hawksworth S-1290
Wisconsin Registered Land
Surveyor

November 5, 1980

Drafted by Irene Haedt

Reason for
correction
Vol. 480 P.14
This area owned
by City of
Omro

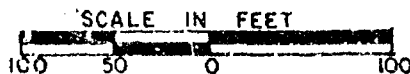

CITY PLANNING COMMISSION CERTIFICATE

Approved for recording by Omro City Planning Commission action
of December 1, 1980.

Edouard Chave
Authorized representative

Sheet 1 of 2 sheets

WINNEBAGO COUNTY CERTIFIED SURVEY MAP NO. 837
 Part of Gov't. Lot 6 of the Fractional SE $\frac{1}{4}$ of the SW $\frac{1}{4}$ of Sec. 8,
 T.18N., R.15E., City of Omro, Winnebago County, Wisconsin..

CORRECTION TO DOC. NO. 549257 of Vol. 1 of Certified Survey Maps

I, Calvin W. Hawksworth, registered land surveyor, hereby certify:

That I have corrected and mapped the parcel of land located in part of Gov't. Lot 6 in the Fractional SE $\frac{1}{4}$ of the SW $\frac{1}{4}$ of Sec. 8, T.18N., R.15E., including Outlot 6 and part of Outlot 7 of the PLAT OF OUTLOTS NORTH OF THE FOX RIVER, all in the City of Omro, Winnebago County, Wisconsin, which is recorded as Document No. 549257 of Certified Survey Maps of Winnebago County Records and which is correctly described as follows: Beginning at the North-east corner of Outlot 6 of the PLAT OF OUTLOTS NORTH OF THE FOX RIVER. From that point running S02°52'18"E, 442.31 ft. to a meander line of the Fox River, thence S64°54'17"W, along said meander line, 231.75 ft., thence N03°00'01"W, 250.00 ft., thence S86°59'59"W, 103.90 ft., thence N03°00'01"W, 263.94 ft. to the Southerly R.O.W. line of East River Drive, thence N84°12'59"E, along said R.O.W. line, 320.00 ft. to the said point of beginning. Including all of the land lying between the meander line and the water's edge of the Fox River. Subject to easements and restrictions of record.

That I have made such correction to Document No. 549257 because of an unnoticed addendum to Vol. 480, Page 14 of Winnebago County Records; that such map is a correct representation of the exterior boundaries of the land surveyed.

That I have fully complied with the provisions of Sec. 236.34 of the Wisconsin Statutes and Ordinance No. 222 of the City of Omro in surveying, dividing and mapping the same.

Calvin W. Hawksworth
 Calvin W. Hawksworth S-1290
 Wisconsin Registered Land Surveyor
 November 5, 1980



558222

Sheet 2 of 2 sheets

Registrar's Office
 Winnebago County, Wis.
 Received for record this 20
 day of Dec. A.D. 1980
 at 12:54 o'clock P M. and
 recorded in Vol. 1 of Survey
 on page 837....

John M. Miller
 Registrar of Deeds

R.K. Sayre


PD
 22

PLAT OF SURVEY T18N R15E S. 2

JANUARY 4, 1984

SURVEY FOR OSHKOSH SAVINGS
APPLICANT: GORDON HELSTROM
MONUMENT WAIVER ON FILE

SURVEY NO. 1379-H
SHEET 1 of 2
EAST RIVER DRIVE

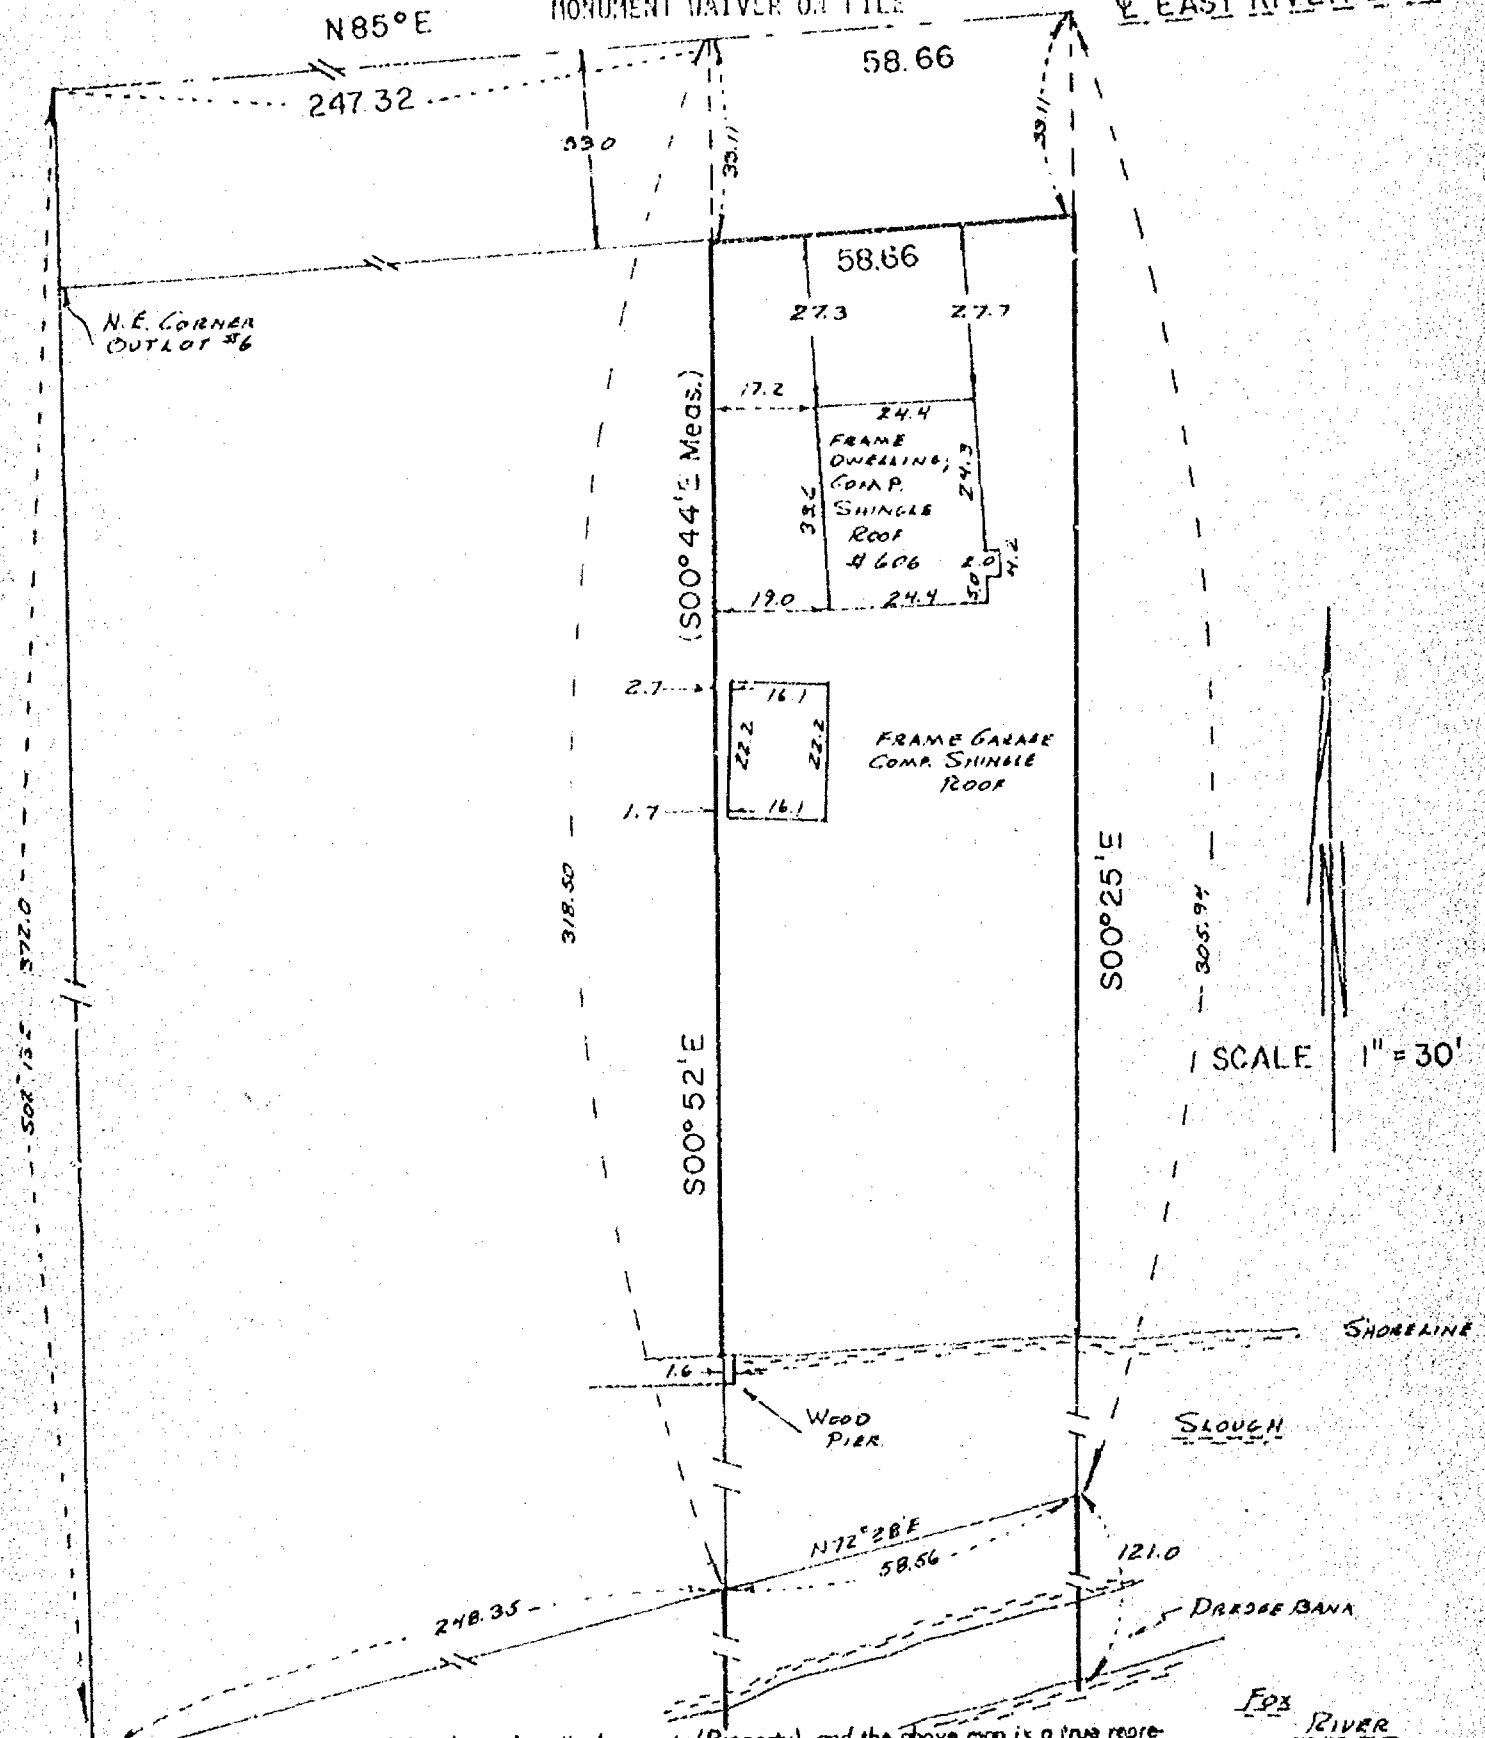


I Certify that I have surveyed the above described property (Property), and the above map is a true representation thereof and shows the size and location of the Property, its exterior boundaries, the location and dimensions of all visible structures thereon, boundary, fences, apparent easements and roadways and visible encroachments, if any. This survey is made for the exclusive use of the present owners of the Property, and also those who purchase, mortgage, or guarantee the title thereto, within one (1) year from date hereof.



national survey & engineering

417 NORTH SAWYER STREET / P.O. BOX 2963
OSHKOSH, WISCONSIN 54903
(414) 426-2800

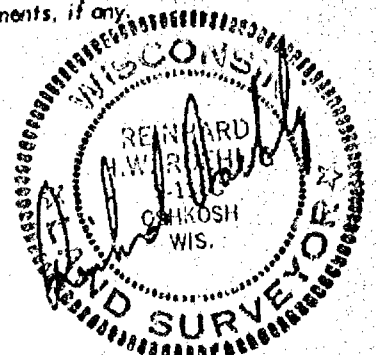

SURVEY FOR OSHKOSH SAVINGS
APPLICANT: GORDON HELSTROM
SHEET 2 of 2

SURVEY NO. 1379


PROPERTY DESCRIPTION

PARCEL "A" THAT PART OF FRACTIONAL LOT 6 (FRACTIONAL S.E. 1/4 OF S.W. 1/4 OF SECTION 8-18-15), IN THE THIRD WARD, CITY OF OMRO, WINNEBAGO COUNTY, WISCONSIN, DESCRIBED AS FOLLOWS:

COMMENCING IN THE CENTER OF MILL STREET (NOW EAST RIVER DRIVE), IN SAID CITY, WHERE THE EXTENDED EAST LINE OF LOT 6, NORTH OF FOX RIVER, ACCORDING TO THE PLAT OF OUTLOTS IN THE VILLAGE OF OMRO, AS RECORDED IN WINNEBAGO COUNTY, WISCONSIN REGISTRY IN VOLUME 4 OF PLATS ON PAGE 24, INTERSECTS THE SAME, THENCE NORTH 85-00 EAST, ALONG THE CENTERLINE OF SAID STREET 247.32 FT. THE PLACE OF BEGINNING, THENCE CONTINUING NORTH 85-00 EAST ALONG THE CENTERLINE OF SAID STREET 58.66 FT. THENCE SOUTH 00-25 EAST TO THE NORTHERLY BANK OF A BODY OF WATER KNOWN AS "THE SLOUGH", THENCE SOUTHWESTERLY ALONG THE NORTHERLY BANK TO A POINT THAT IS SOUTH 00-52 EAST OF THE PLACE OF BEGINNING, THENCE NORTH 00-52 WEST TO THE PLACE OF BEGINNING.



PARCEL "B" THAT PART OF FRACTIONAL LOT 6 (FRACTIONAL S.E. 1/4 OF THE S.W. 1/4 OF SECTION 8-18-15), IN THE THIRD WARD, CITY OF OMRO, WINNEBAGO COUNTY, WISCONSIN, DESCRIBED AS FOLLOWS;

COMMENCING AT A POINT THAT IS SOUTH 02-13 EAST 372.0 FT. FROM THE N.E. CORNER OF OUTLOT 6 IN THE PLAT OF OUTLOTS NORTH OF FOX RIVER, THENCE NORTH 72-28 EAST 600.0 FT., THENCE SOUTH 02-13 EAST 121.0 FT. TO RIVER, THENCE SOUTHWESTERLY ALONG SAID RIVER 600.0 FT. TO THE EAST LINE OR EXTENDED EAST LINE OF OUTLOT 7, THENCE NORTHERLY 121.0 FT. TO THE PLACE OF BEGINNING, THAT LIES BETWEEN THE EXTENDED EASTERLY AND WESTERLY LINES (EXTENDED SOUTHERLY) OF ABOVE DESCRIBED PARCEL "A".

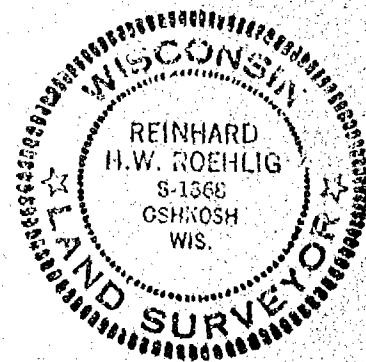

ZONING OFFICE
RECEIVED
 FEB 12 1979

Topographic Survey for Red L. H. Streblow, 407 East River Drive, Omro
 of a part of Govn't Lot 6 of Fractional Section 8, T. 18 N., R. 15 E.,
 City of Omro, Winnebago County, Wisconsin.

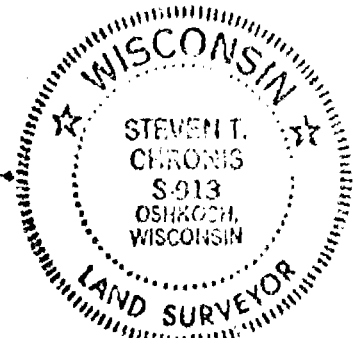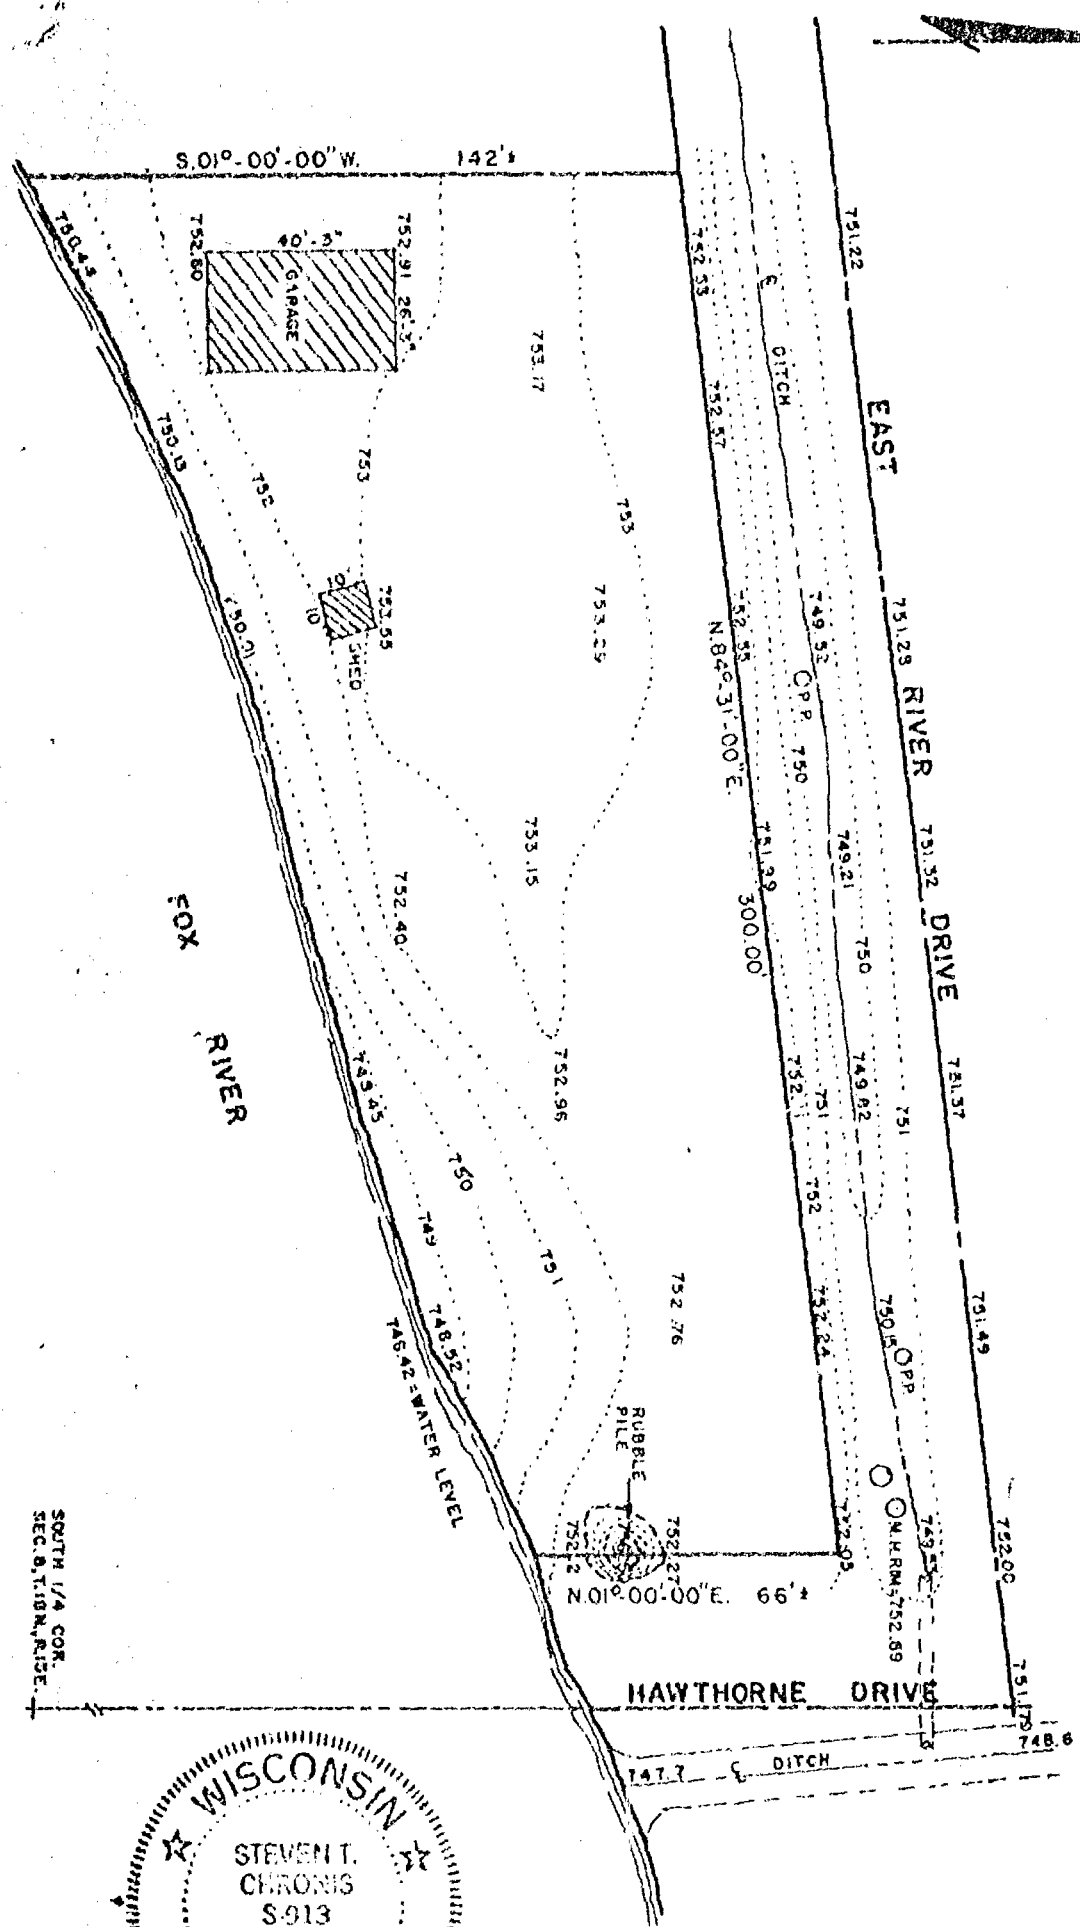

AERO-METRIC ENGINEERING, INC.
 PHOTOGRAMMETRIC ENGINEERS
 LAND SURVEYORS
 OSHKOSH, WISCONSIN

DATED THIS 23rd DAY OF January, 1979
Steven T. Chronis
 WIS. REGISTERED LAND SURVEYOR S-513
 NOT. BOOK 17 PAGE 36-39


T. 18 N. R. 15 E.

8	

9 18 15 1

U3700
BUE N.
SW COR.
SW 1/4 SEC 9

THIS LINE ESTABLISHED BY PREVIOUS
SURVEY AND LINE OF OCCUPATION

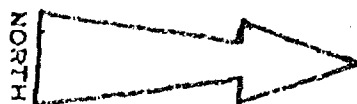


LEGEND
O = (X) IRONS SET
● = EXISTING IRONS
● = P.K. NAILS ON CENTER LINE
OF STREET
() = RECORDED AS

SPRINGBROOK

602 ACRES ±

FUTURE
ROAD

CURVE DATA
R - 585.78
A - 245.14
T - 124.52
C - 24° 49' 30"
CHORD
BEAR - S 12° 58' 15" E
DIST - 243.23

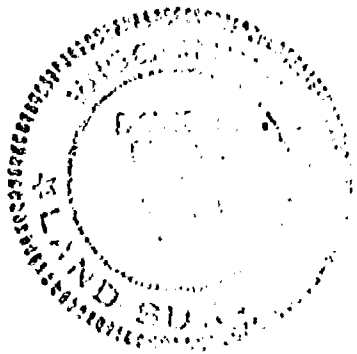

CERTIFICATE of SURVEY

I, David D. Eisele, hereby certify
that the property shown hereon was
surveyed under my supervision and
that this is a true and correct repre-
sentation thereof.

David D. Eisele
David D. Eisele, 5-974
Reg. Wis. Land Surveyor

Date: *January 12, 1974*

FILE	DATE	DRAWN K.H. CHECKED D.E. SCALE 1-100	SURVEY FOR STU STREY N.W. 1/4 OF THE SW 1/4 OF SEC 9 T18N R15E CITY OF OMRO WINNABAGO CO. WISCONSIN	REVISION DATE BY
------	------	---	---	------------------------

J. R. Howlett

DESCRIPTION for STU STREY

All that part of the Southwest 1/4 of Section Nine (9),
Township 18 North, Range 15 East, Town of Omro, Winnebago
County, Wisconsin more fully described as follows:

Commencing at the Southwest corner of the Southwest 1/4 of
said Section Nine (9); thence North on and along the West line of
said Southwest 1/4, 1,137.0 ft. to the point of beginning of lands
herein described; thence North $0^{\circ}20'15''$ West along previously
established line 370.88 ft. to an existing iron rod; thence North
 $0^{\circ}36'00''$ West along a line established by occupation 25.1 ft. to
a point; thence North $64^{\circ}39'00''$ East 712.62 ft. to a point;
thence South $0^{\circ}31'30''$ East 106.43 ft. to a point of curvature; thence
along the arc of a curve to the left having a radius of 565.78 ft.
and a chord of 243.23 ft. which bears South $12^{\circ}56'15''$ East to the point
of tangency; thence South $24^{\circ}21'00''$ East 24.75 ft. to a point on the
centerline of a Town Road (Known as Spring Brook Rd.); thence
South $64^{\circ}39'00''$ West on and along said centerline 782.98 ft. to the
point of beginning.

Reserving the Southeasterly 24.75 ft. for town road purposes.

Total parcel contains 6.02 acres more or less.


Combine # 262.
264

6.02 ACRES.

chd area on ~~262~~ 262-5
33 ACRES.

McMahon Associates, Inc.
DDE:erh
7/19/74

DESCRIPTION: LOT 2 EXCEPT THE SOUTH 3.00 FEET,
BLOCK 1, JOHNSON'S ADDITION TO THE TOWN PLAT OF
OMRO, NOW IN THE CITY, CITY OF OMRO, WINNEBAGO
COUNTY, WISCONSIN.

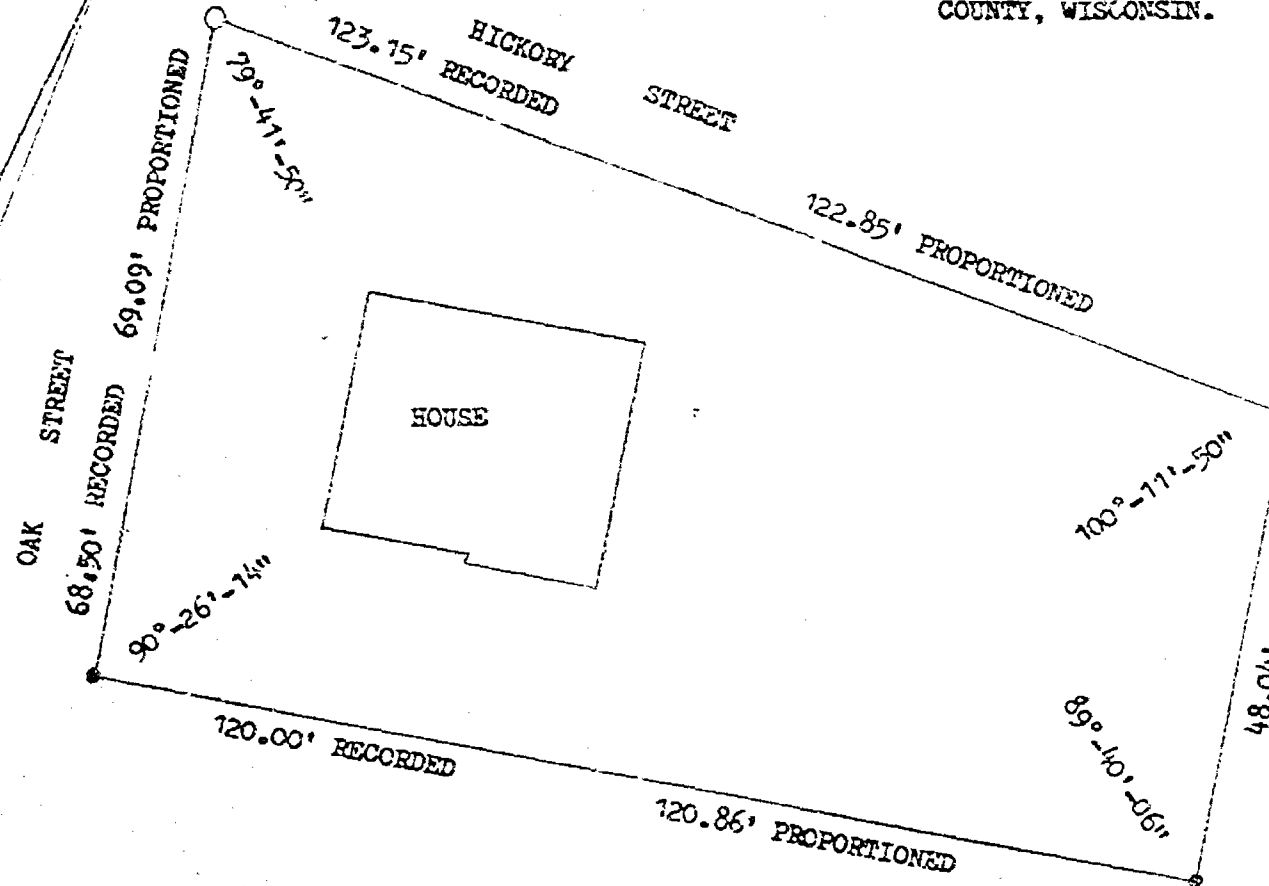

LEGEND:

- = 1" IRON PIPE FOUND
- = 3/4" X 24" SOLID
ROUND IRON ROD SET



I, ROBERT F. REIDER, CERTIFY THAT THIS PLAT
OF SURVEY IS A CORRECT REPRESENTATION OF THE
ABOVE DESCRIBED PROPERTY.

Robert F. Reider 8-30-79

REVISIONS		MRS. ROBERT A. COLLINS	
342-77 T11		530 OAK ST. OMRO, WISC 54963	
		CAROW LAND SURVEYING CO., INC.	
		604 N. RICHMOND ST. APPLETON, WI 54911	
DRAWN BY	BY	SCALE	DRAWING NO.
APP'D	LEC	1"=20'	A-7576-
		DATE	79
		8-30-79	

COPY


87 18 15 5

Map File

Sheet 1 of 2

SCALE 1" = 200'
0 = 1" x 24" IRON PIPE WEIGHING 115 LBS.
PER LINEAL FOOT.

ASSUMED NORTH PER "WOLVERTON" RECORDS

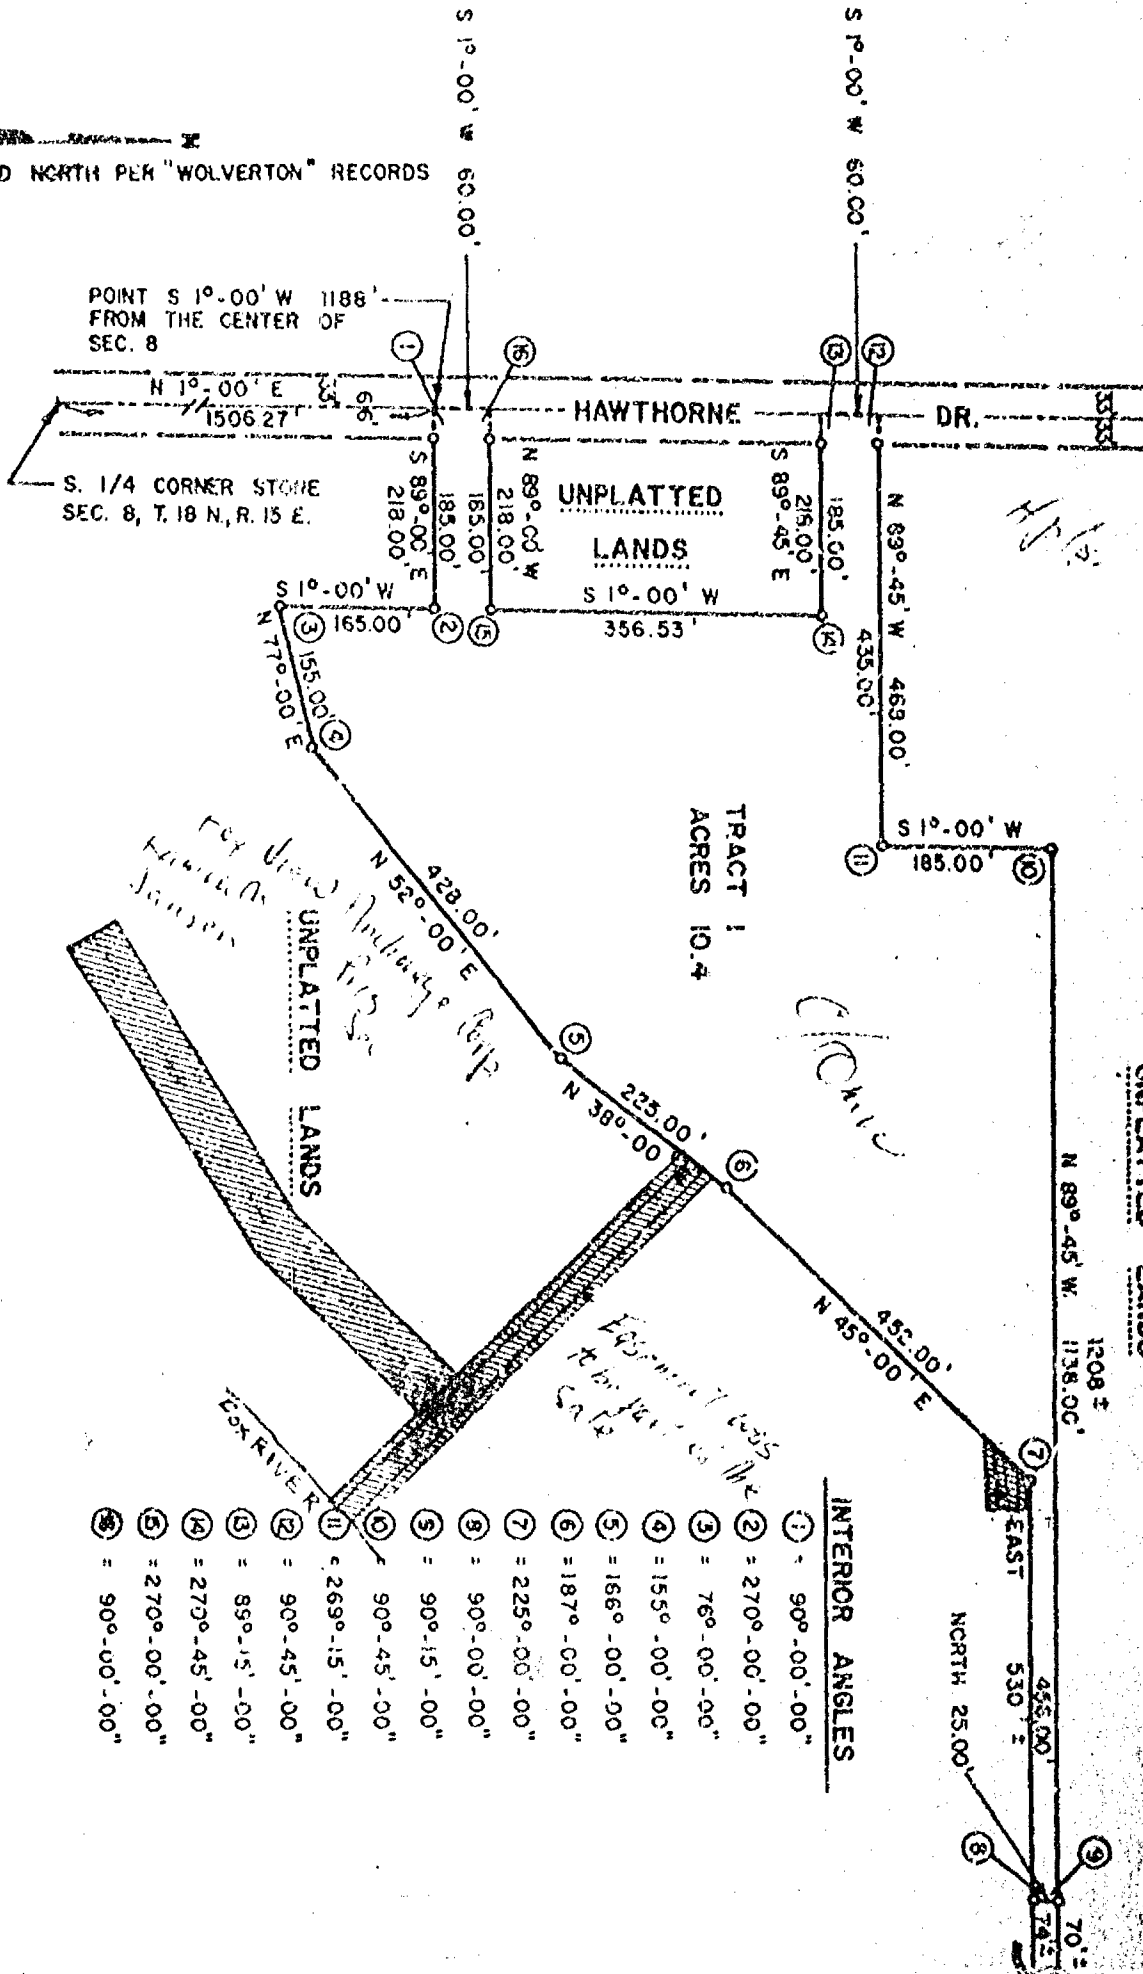


DONORPUE & ASSOCIATES, INC.,
CONSULTING ENGINEERS
P. O. BOX 483-SHEBOYGAN, WISCONSIN

L-6818

JUL 13 1977

Sheet 1 of 2


Survey
for
Alfred J. Reisler

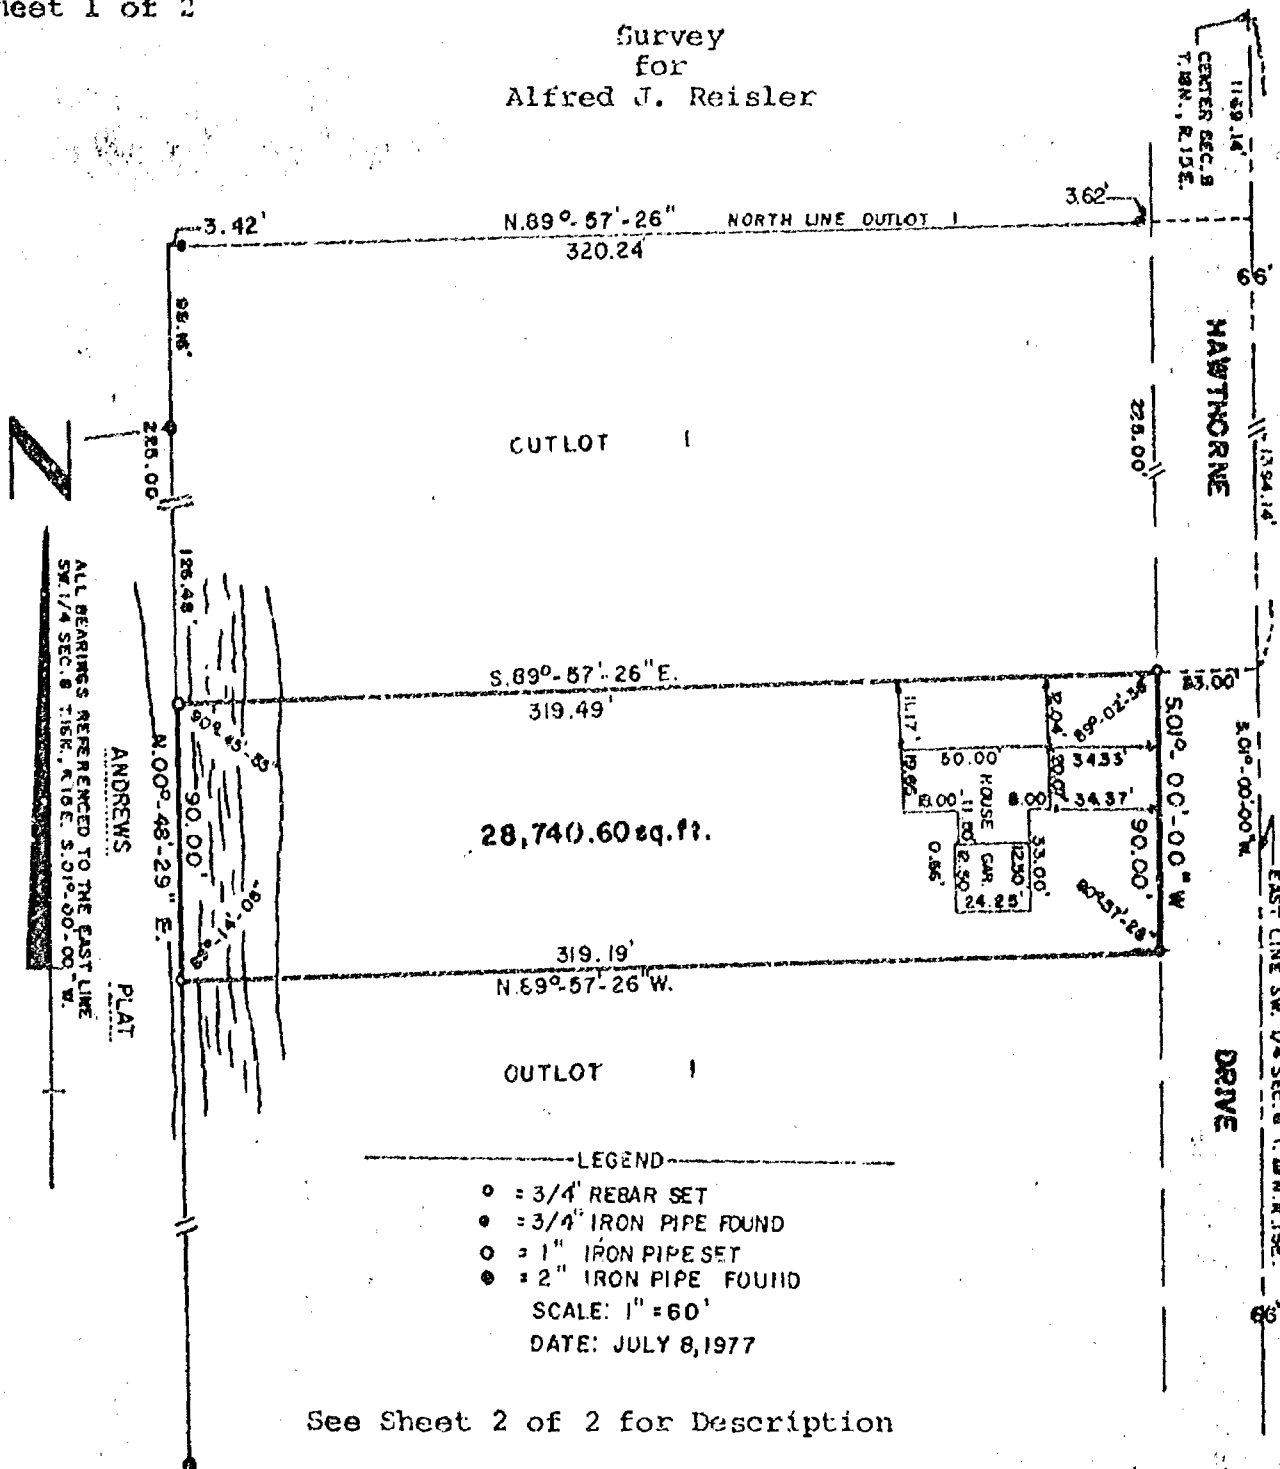

See Sheet 2 of 2 for Description

I, STEVEN T. CHRONIS, WISCONSIN REGISTERED LAND SURVEYOR OF AERO-METRIC ENGINEERING, INC., HAVE SURVEYED THE ABOVE DESCRIBED PROPERTY AND THE ABOVE MAP IS A TRUE REPRESENTATION THEREOF AND SHOWS THE SIZE AND LOCATION OF THE PROPERTY, ITS EXTERIOR BOUNDARIES, THE LOCATION AND DIMENSIONS OF ALL STRUCTURES THEREON, FENCES, APPARENT EASEMENTS AND ROADWAYS AND VISIBLE ENCROACHMENTS IF ANY.


"THIS SURVEY IS MADE FOR THE EXCLUSIVE USE OF THE PRESENT OWNERS OF THE PROPERTY, AND ALSO THOSE WHO PURCHASE, MORTGAGE OR GUARANTEE THE TITLE THERE TO WITHIN ONE (1) YEAR FROM DATE HEREOF, AND AS TO THEM I HEREBY CERTIFY THAT SAID SURVEY AND THE ABOVE MAP WERE MADE IN ACCORDANCE WITH ACCEPTABLE PROFESSIONAL STANDARDS AND THAT THE INFORMATION CONTAINED THEREIN IS, TO THE BEST OF MY KNOWLEDGE, INFORMATION AND BELIEF, A TRUE AND ACCURATE REPRESENTATION THEREOF.

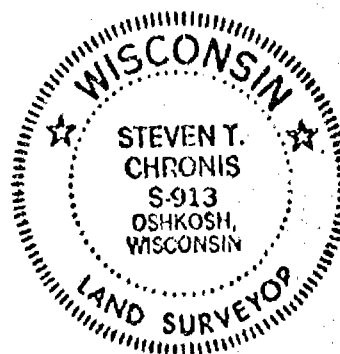

Steven T. Chronis
STEVEN T. CHRONIS
WISCONSIN REGISTERED LAND SURVEYOR S-913

DATED THIS 11th DAY OF July, 1977

AERO-METRIC ENGINEERING, INC.
PHOTOGRAMMETRIC ENGINEERS
LAND SURVEYORS
OSHKOSH, WISCONSIN

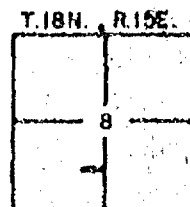

Description
for
Alfred J. Reisler

A part of Lot One (1) North of the Fox River, according to Plat of Outlots in the Village of Omro and now in the Third Ward, City of Omro, Winnebago County, Wisconsin containing 28,740.60 square feet of land and being described by: Commencing at the Northeast corner of Andrews Plat thence S. $00^{\circ}-48'-29''$ W. 126.48 feet along the East line of Andrews Plat recorded as S. $00^{\circ}-39'-30''$ W. to the true point of beginning, running thence S. $89^{\circ}-57'-26''$ E. 319.49 feet to a point on the West line of Hawthorne Drive, thence S. $01^{\circ}-00'-00''$ W. 90.00 feet along the West line of Hawthorne Drive, thence N. $89^{\circ}-57'-26''$ W. 319.19 feet to a point on the East line of Andrews Plat, thence N. $00^{\circ}-48'-29''$ E. 90.00 feet along the East line of Andrews Plat recorded as N. $00^{\circ}-39'-30''$ E. to the true point of beginning.

STATE OF WISCONSIN)
WINNEBAGO COUNTY) SS

CERTIFIED SURVEY MAP
for
Alfred J. Reisler


SURVEYOR'S CERTIFICATE:

I, Steven T. Chronis, Wisconsin Registered Land Surveyor of Aero-Metric Engineering, Inc., certify that I have surveyed, divided and mapped a part of Lot One (1) North of the Fox River, according to Plat of Outlots in the Village of Omro and now in the Third Ward, City of Omro, Winnebago County, Wisconsin containing 1.652 acres of land and being described by: Commencing at the Northeast Corner of Andrews Plat, thence N. 00°-48'-29" E. 98.16 feet along the West Line of said Lot 1 to its Northwest Corner, thence S. 89°-57'-26" E. 320.24 feet along the North Line of said Lot 1 to its Northeast Corner, recorded as 313.5 feet, thence S. 01°-00'-00" W. 225.00 feet along the West Line of Hawthorne Drive, thence N. 89°-57'-26" W. 319.49 feet to a point on the East Line of Lot 10 of said Andrews Plat, thence N. 00°-48'-29" E. 126.84 feet along the East Line of said Lot 10, previously recorded as N. 00°-39'-30" E. to the point of commencement.



That such is a correct representation of all exterior boundaries of the land surveyed.

That I have fully complied with the provisions of Chapter 236.34 of the Wisconsin Statutes in surveying and mapping the same.

Dated this 23rd day of September, 1977.

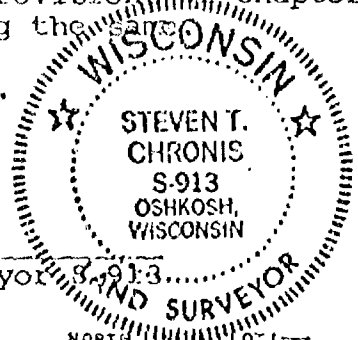

Steven T. Chronis
Wisconsin Registered Land Surveyor
Steven T. Chronis

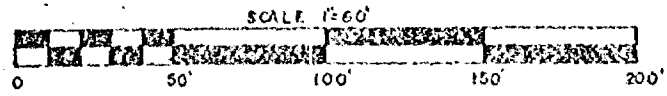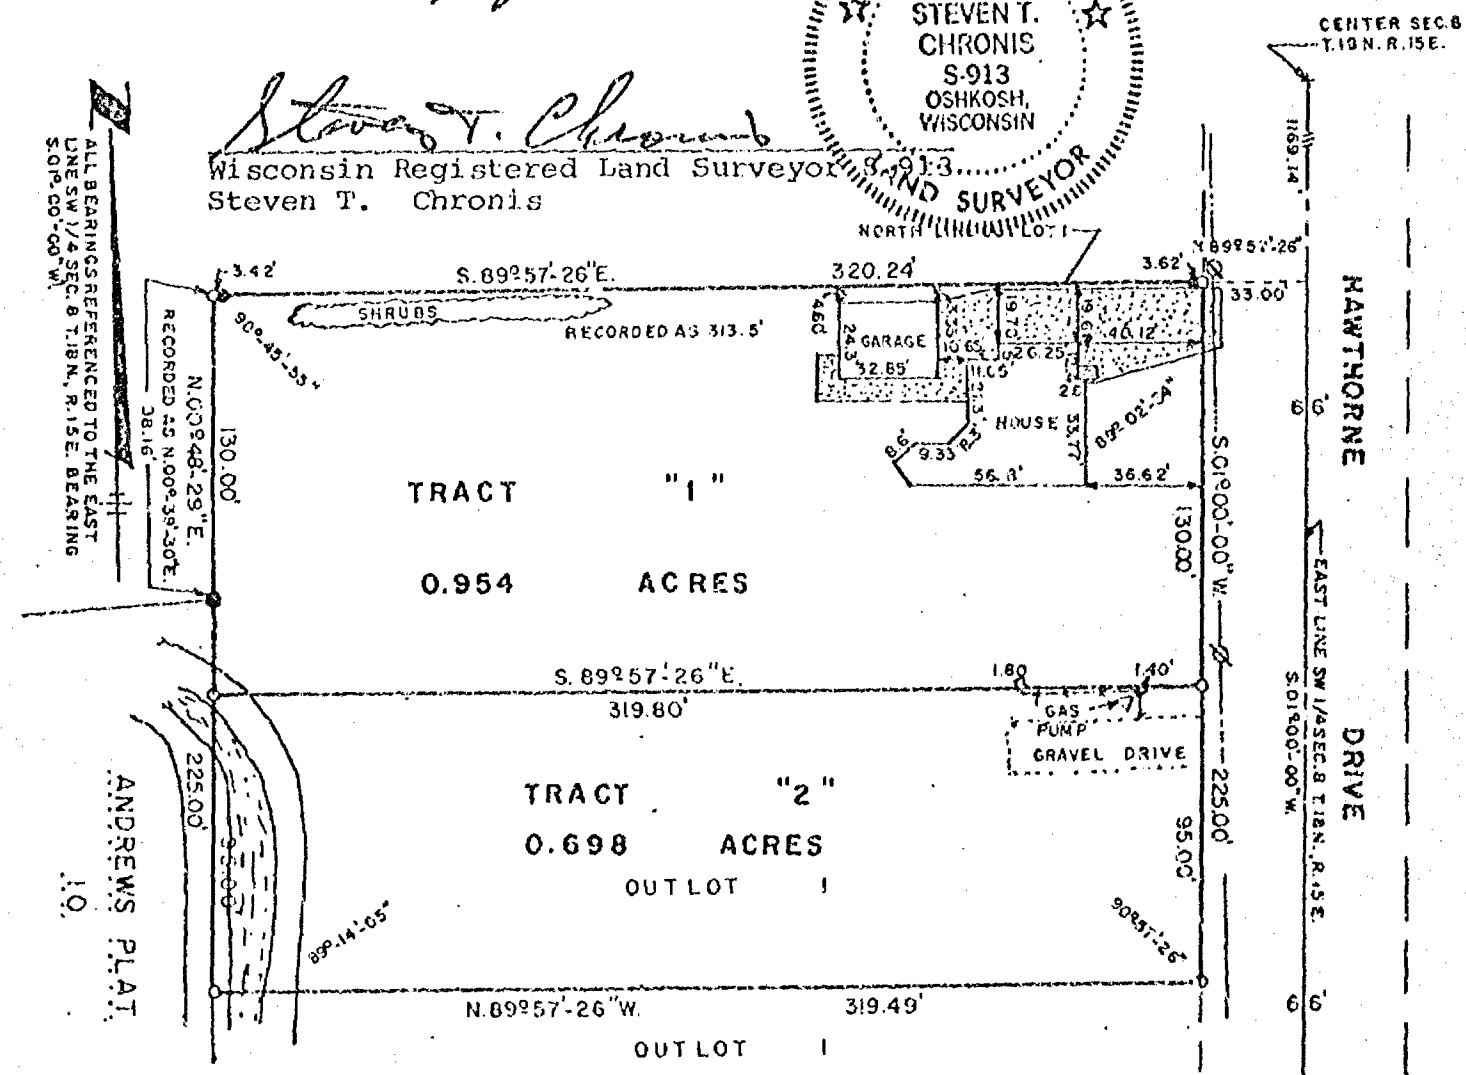


- LEGEND
- = 1" x 24" IRON PIPE WEIGHING 1.68 LBS. PER LINEAL FOOT
 - = 1" IRON PIPE FOUND
 - ⊙ = 2" IRON PIPE FOUND
 - ⊖ = NO. 6 REBAR 24" LONG WEIGHING 1.502 LBS. PER LINEAL FOOT
- DATE SEPT. 20, 1977

SURVEY
for
Alfred J. Reisler
of

AUG 9 1977

A part of Lot One (1) North of the Fox River, according to Plat of Outlots in the Village of Omro and now in the Third Ward, City of Omro, Winnebago County, Wisconsin containing 1.652 acres of land and being described by: Commencing at the Northeast Corner of Andrews Plat, thence N. 00°-48'-29" E. 98.16 feet along the West Line of said Lot 1 to its Northwest Corner, thence S. 89°-57'-26" E. 320.24 feet along the North Line of said Lot 1 to its Northeast corner, recorded as 313.5 feet, thence S. 01°-00'-00" W. 225.00 feet along the West Line of Hawthorne Drive, thence N. 89°-57'-26" W. 319.49 feet to a point on the East Line of Lot 10 of said Andrews Plat, thence N. 00°-48'-29" E. 126.84 feet along the East Line of said Lot 10, previously recorded as N. 00°-39'-30" E. to the point of commencement.

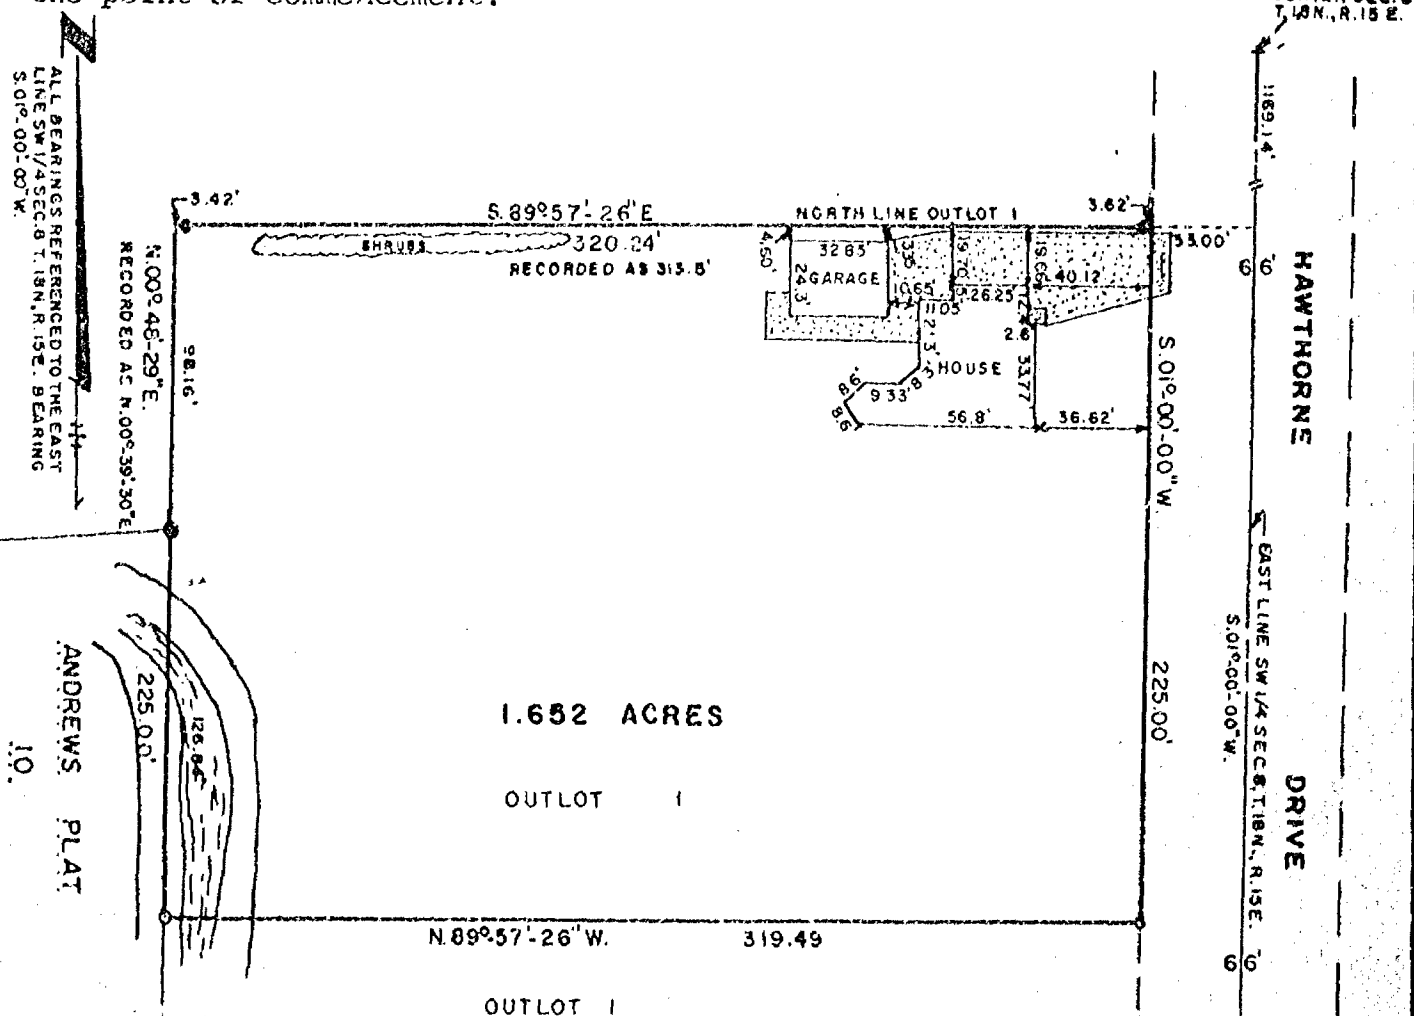

I, STEVEN T. CHRONIS, WISCONSIN REGISTERED LAND SURVEYOR OF AERO-METRIC ENGINEERING, INC., HAVE SURVEYED THE ABOVE DESCRIBED PROPERTY AND THE ABOVE MAP IS A TRUE REPRESENTATION THEREOF AND SHOWS THE SIZE AND LOCATION OF THE PROPERTY, ITS EXTERIOR BOUNDARIES, THE LOCATION AND DIMENSIONS OF ALL STRUCTURES THEREON, FENCES, APPARENT EASEMENTS AND ROADWAYS AND VISIBLE ENCROACHMENTS IF ANY.

"THIS SURVEY IS MADE FOR THE EXCLUSIVE USE OF THE PRESENT OWNERS OF THE PROPERTY, AND ALSO THOSE WHO PURCHASE, MORTGAGE OR GUARANTEE THE TITLE THERE TO WITHIN ONE (1) YEAR FROM DATE HEREOF, AND AS TO THEM I HEREBY CERTIFY THAT SAID SURVEY AND THE ABOVE MAP WERE MADE IN ACCORDANCE WITH ACCEPTABLE PROFESSIONAL STANDARDS AND THAT THE INFORMATION CONTAINED THEREON IS, TO THE BEST OF MY KNOWLEDGE, INFORMATION AND BELIEF, A TRUE AND ACCURATE REPRESENTATION THEREOF."

LEGEND



- = 1" IRON PIPE SET
- ◊ = 3/4" IRON REBAR SET
- = 1" IRON PIPE FOUND
- ⊙ = 2" IRON PIPE FOUND

SCALE 1" = 60'
DATE: AUG. 3, 1977

Steven T. Chronis
STEVEN T. CHRONIS
WISCONSIN REGISTERED LAND SURVEYOR S-913

DATED THIS 5th DAY OF August 1977


AERO-METRIC ENGINEERING, INC.
PHOTOGRAMMETRIC ENGINEERS
LAND SURVEYORS
OSHKOSH, WISCONSIN

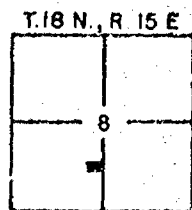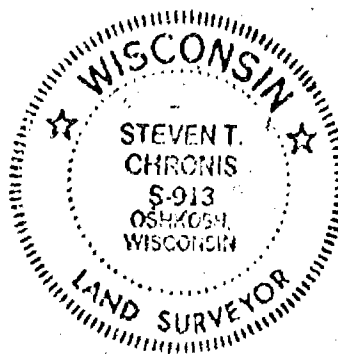

SURVEY
FOR
ALFRED J. FEISLER

AUG 9 1977

SHEET 1 of 2

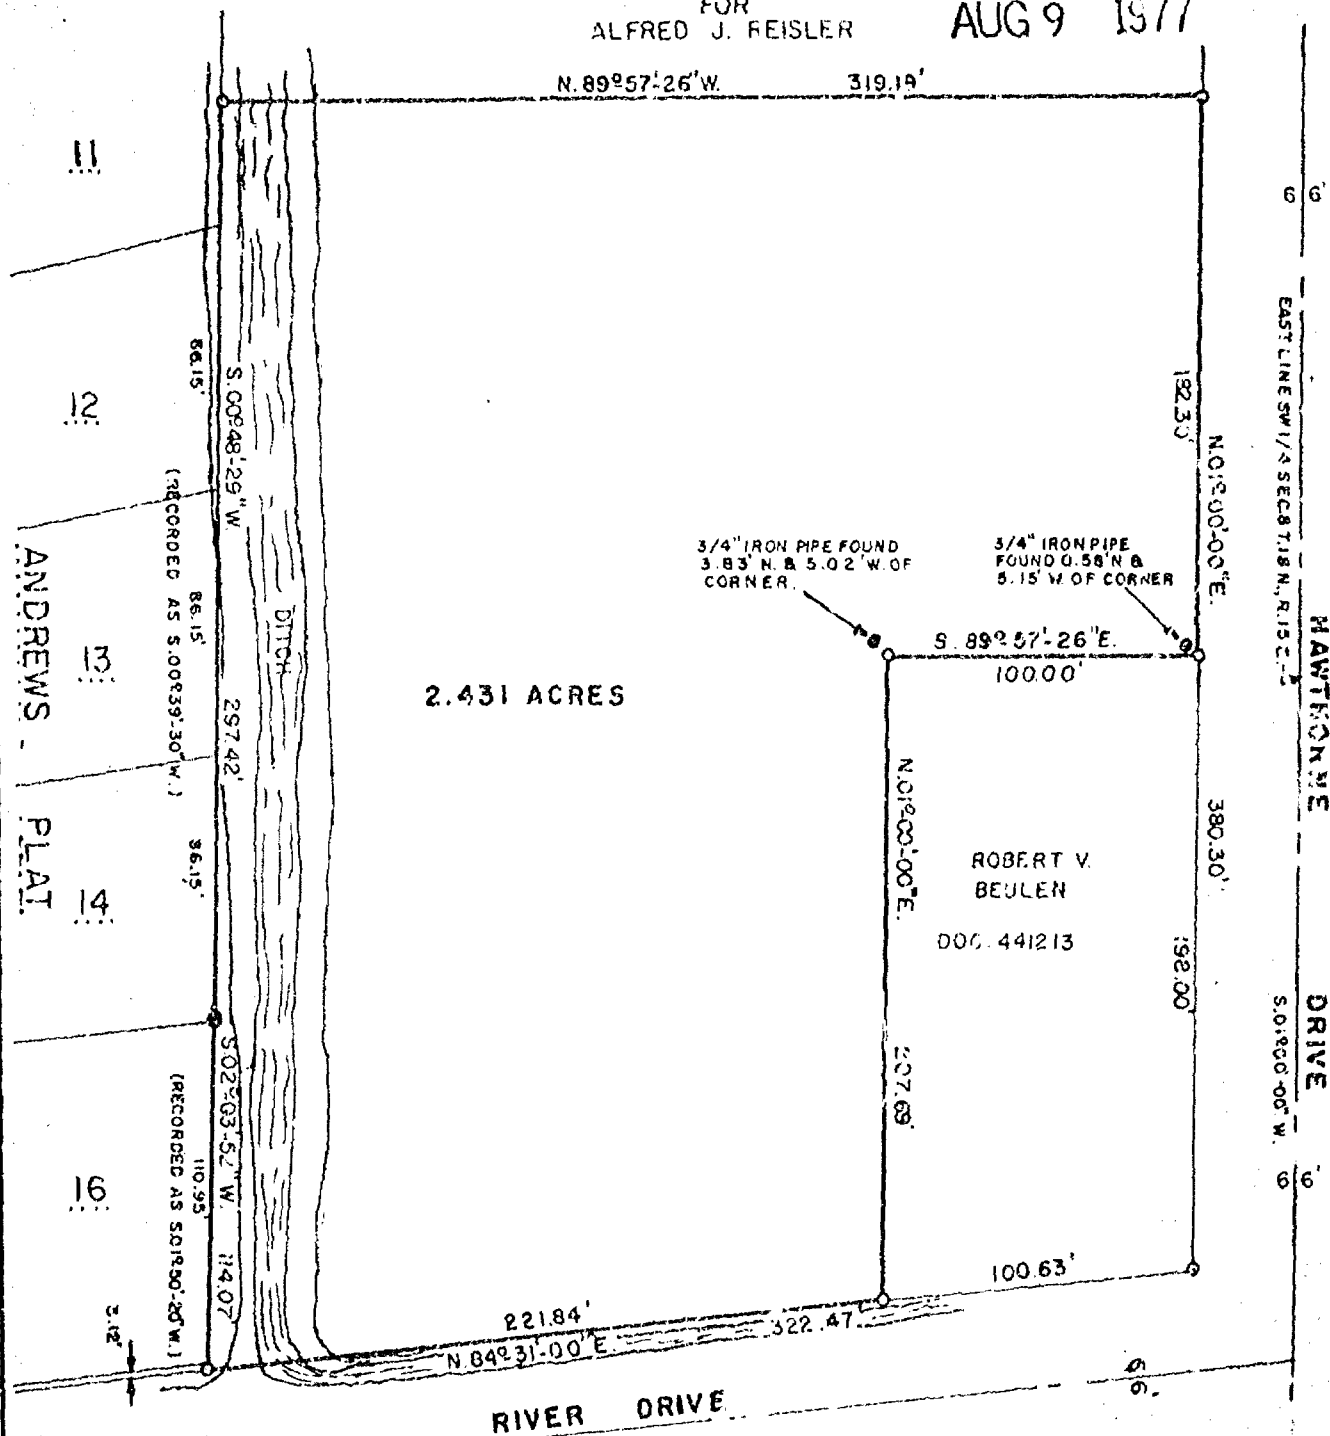

N 84° 31' 00" E. PER WOLVERTON LINE OF 1953 24.85' SOUTH
I, STEVEN T. CHRONIS, WISCONSIN REGISTERED LAND SURVEYOR OF AERO-METRIC ENGINEERING, INC., HAVE SURVEYED THE ABOVE DESCRIBED PROPERTY AND THE ABOVE MAP IS A TRUE REPRESENTATION THEREOF AND SHOWS THE SIZE AND LOCATION OF THE PROPERTY, ITS EXTERIOR BOUNDARIES, THE LOCATION AND DIMENSIONS OF ALL STRUCTURES THEREON, FENCES, APPARENT EASEMENTS AND ROADWAYS AND VISIBLE ENCROACHMENTS IF ANY.


"THIS SURVEY IS MADE FOR THE EXCLUSIVE USE OF THE PRESENT OWNERS OF THE PROPERTY, AND ALSO THOSE WHO PURCHASE, MORTGAGE OR GUARANTEE THE TITLE THERETO WITHIN ONE (1) YEAR FROM DATE HEREOF, AND AS TO THEM I HEREBY CERTIFY THAT SAID SURVEY AND THE ABOVE MAP WERE MADE IN ACCORDANCE WITH ACCEPTABLE PROFESSIONAL STANDARDS AND THAT THE INFORMATION CONTAINED THEREON IS, TO THE BEST OF MY KNOWLEDGE, INFORMATION AND BELIEF, A TRUE AND ACCURATE REPRESENTATION THEREOF."

LEGEND
○ = 3/4" REBAR SET
● = 2" IRON PIPE FOUND
● = 3/4" IRON PIPE FOUND
SCALE = 1" = 60'
DATE = AUG. 3, 1977

SEE SHEET 2 of 2 FOR DESCRIPTION

ALL BEARINGS REFERRED TO THE
EAST LINE SW 1/4 SEC. 8, T. 18 N., R. 15 E.
BEARING S. 01° 00' 00" W.


T. 18 N., R. 15 E.

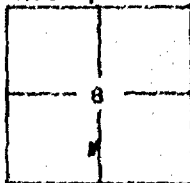

Steven T. Chronis
STEVEN T. CHRONIS
WISCONSIN REGISTERED LAND SURVEYOR 5-913

DATED THIS 5th DAY OF August 1977

AERO-METRIC ENGINEERING, INC.
PHOTOGRAMMETRIC ENGINEERS
LAND SURVEYORS
OSHKOSH, WISCONSIN

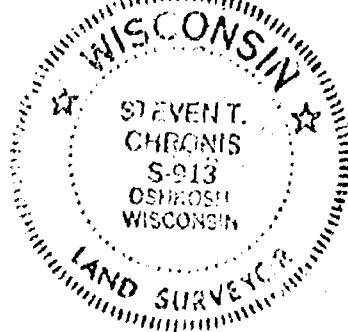

NOTEBOOK 17 PAGE 16-17

L-375

DESCRIPTION
for
Alfred J. Reisler

Sheet 2 of 2 sheets

A part of Lot One (1) North of the Fox River, according to Plat of Outlots in the Village of Omro and now in the Third Ward, City of Omro, Winnebago County, Wisconsin containing 2.431 acres of land and being described by: Commencing at the Southeast corner of Lot 14 of Andrews Plat, thence S. $02^{\circ}-03'-52''$ W. 114.07 feet along the East Line of Andrews Plat to a point on the North Line of River Drive, thence N. $84^{\circ}-31'-00''$ E. 221.84 feet along the North Line of River Drive to the Southwest corner of the Beulen Property recorded as Document No. 441213, thence N. $01^{\circ}-00'-00''$ E. 207.69 feet along the West Line of said Beulen Property to the Northwest corner thereof, thence S. $89^{\circ}-57'-26''$ E. 100.00 feet along the North Line of said Beulen Property to the Northeast corner thereof, thence N. $01^{\circ}-00'-00''$ E. 182.30 feet along the West Line of Hawthorne Drive, thence N. $89^{\circ}-57'-26''$ W. 319.19 feet to a point on the East Line of Andrews Plat, thence S. $00^{\circ}-48'-29''$ W. 297.42 feet, recorded as S. $00^{\circ}-39'-30''$ W., along the East Line of Andrews Plat to the point of commencement.

ZONING OFFICE


RECEIVED

FEB 12 1979

RECEIVED


Topographic Survey
for
Gerold Chamberlain
of

A part of Govn't Lot 6 of Fractional Section 8, T. 18 N., R. 15 E.,
3rd Ward, City of Omro, Winnebago County, Wisconsin.

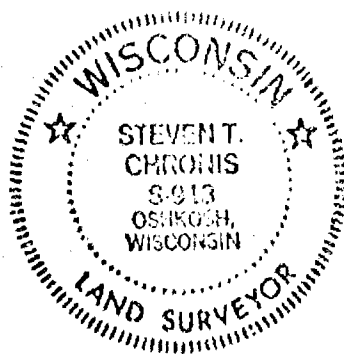


LEGEND


SCALE: 1"=30'
DATE JAN. 31, 1979
3M= TOP STEM HYD
AT NW COR. E RIVER
DR. & HAWTHORNE DR.
ELEV.=753.70

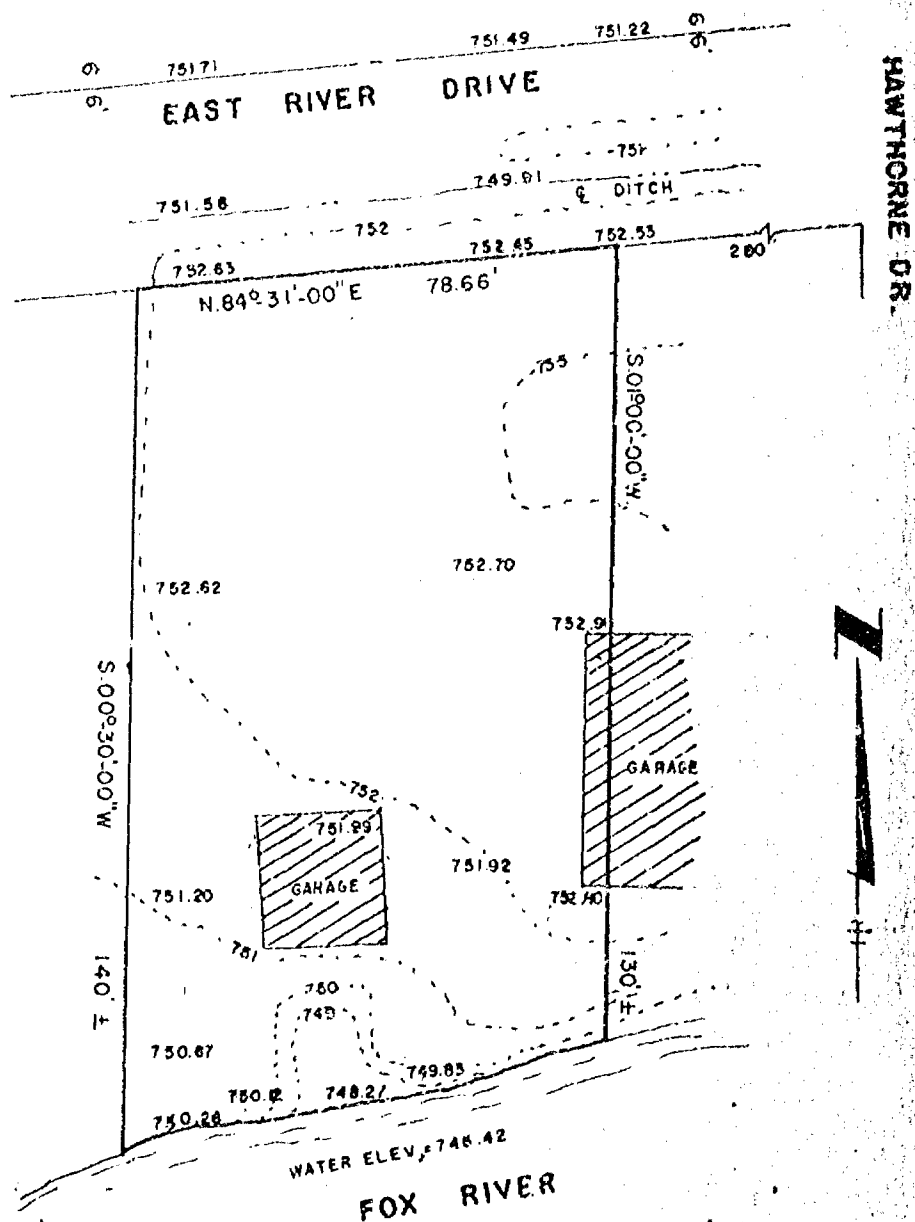

AERO-METRIC ENGINEERING, INC.
PHOTOGRAMMETRIC ENGINEERS
LAND SURVEYORS
OSHKOSH, WISCONSIN


Steven T. Chronis
WIS. REGISTERED LAND SURVEYOR S-913

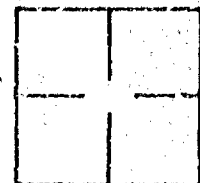

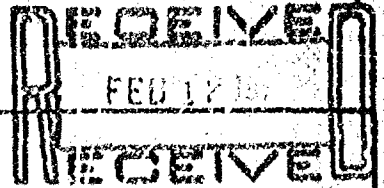

Topographic Survey
for
John J. Maggiore
of


A part of Government Lot 6 of Fractional Section 8, T. 18 N.,
R. 15 E., 3rd Ward, City of Omro, Winnebago County, Wisconsin.

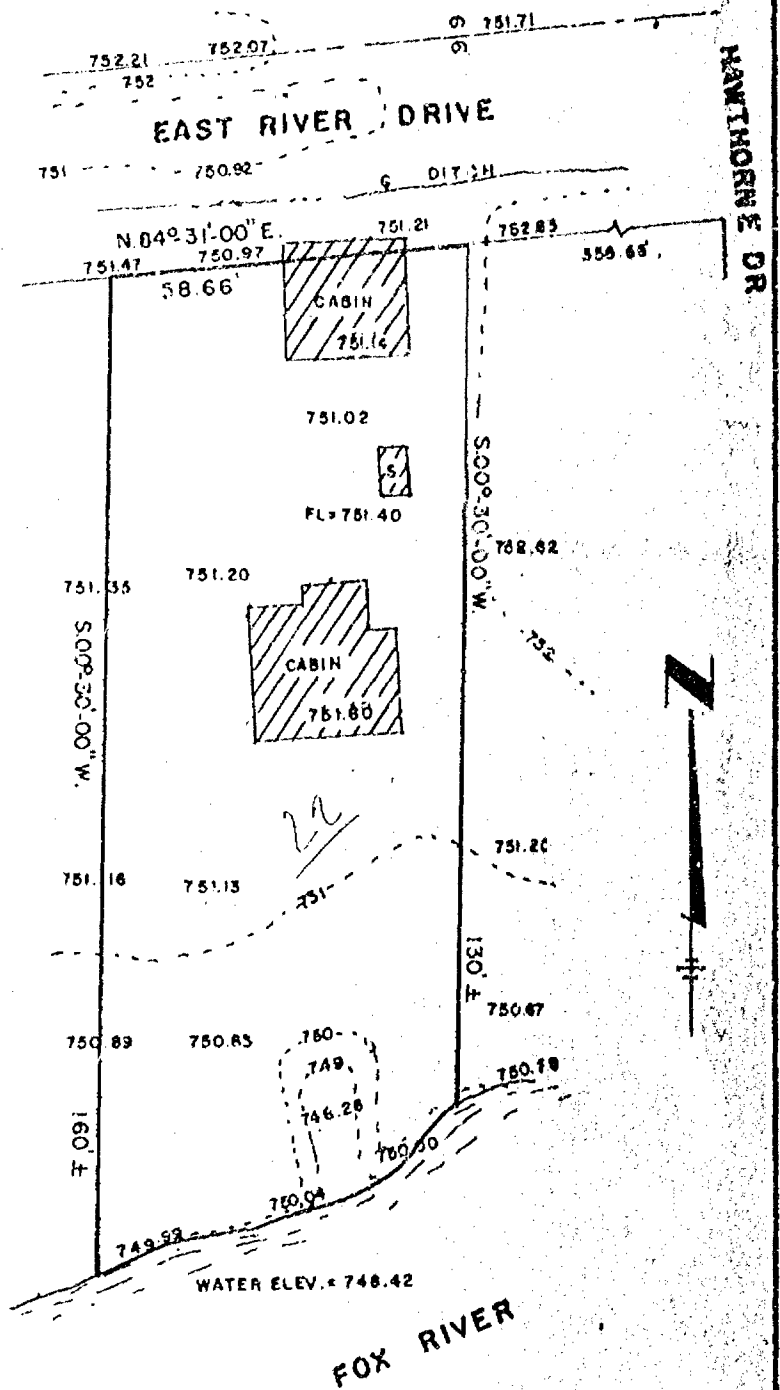



LEGEND
SCALE: 1"=30'
DATE JAN. 31, 1979
BM = TOP STEM HYD. AT NW
COR. E. RIVER DR. & HAWTHORNE
DR. ELEV. 753.70

AERO-METRIC ENGINEERING, INC.
PHOTOGRAMMETRIC ENGINEERS
LAND SURVEYORS
OSHKOSH, WISCONSIN

Steven T. Chronis
WIS. REGISTERED LAND SURVEYOR S-913
NOTEBOOK 17 PAGE 40

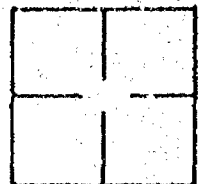

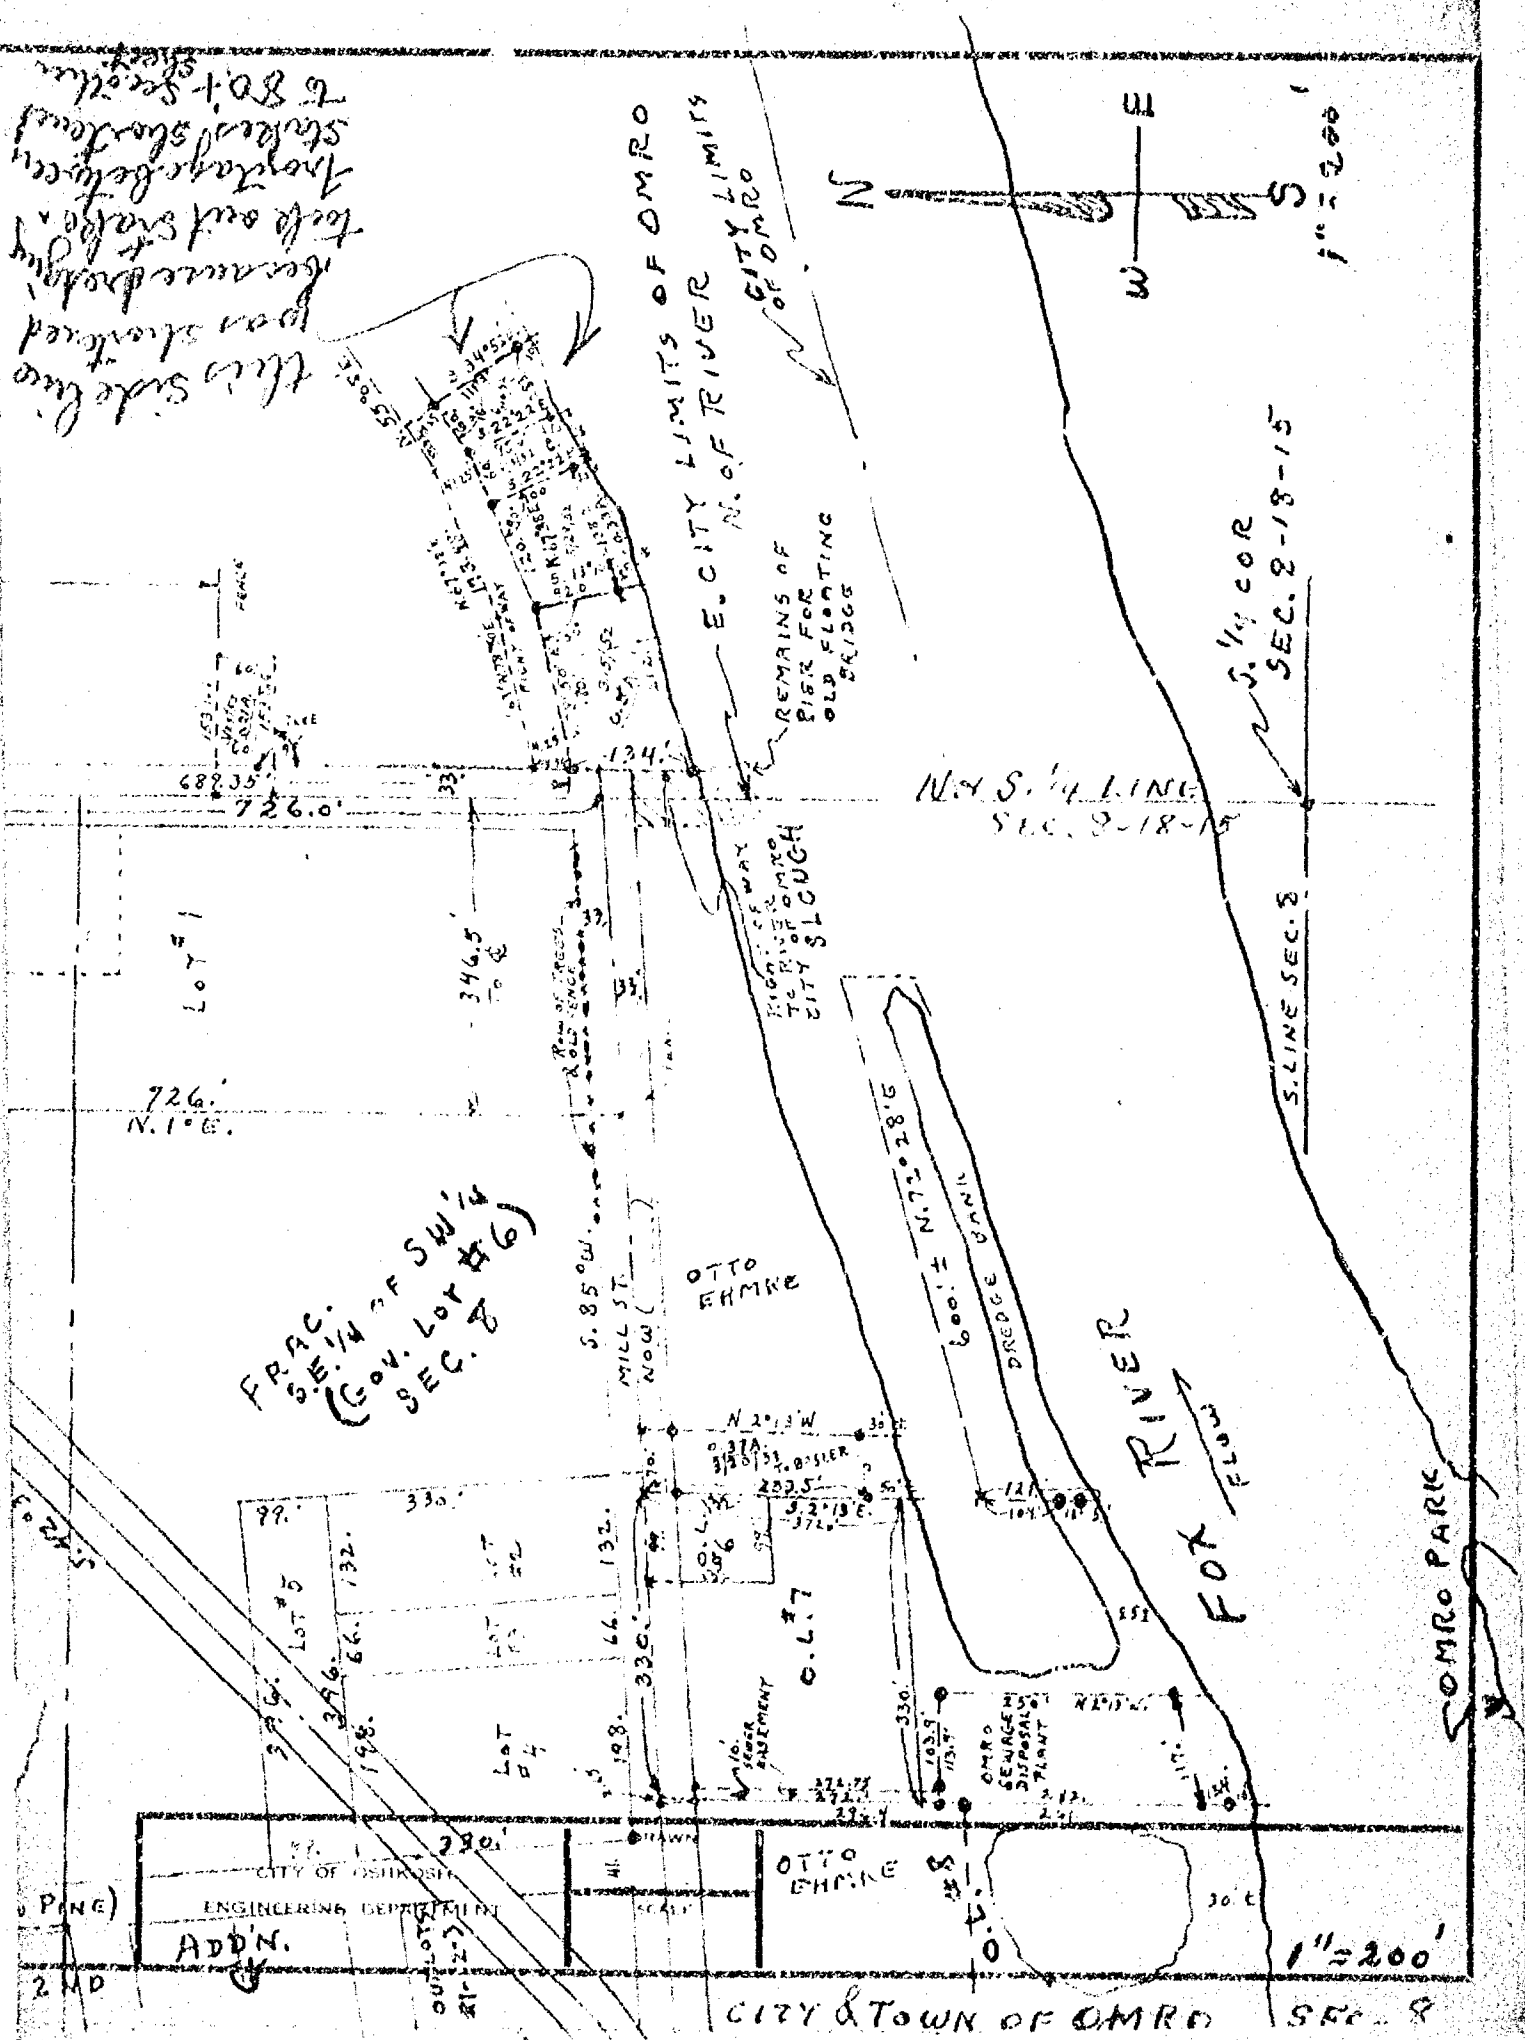

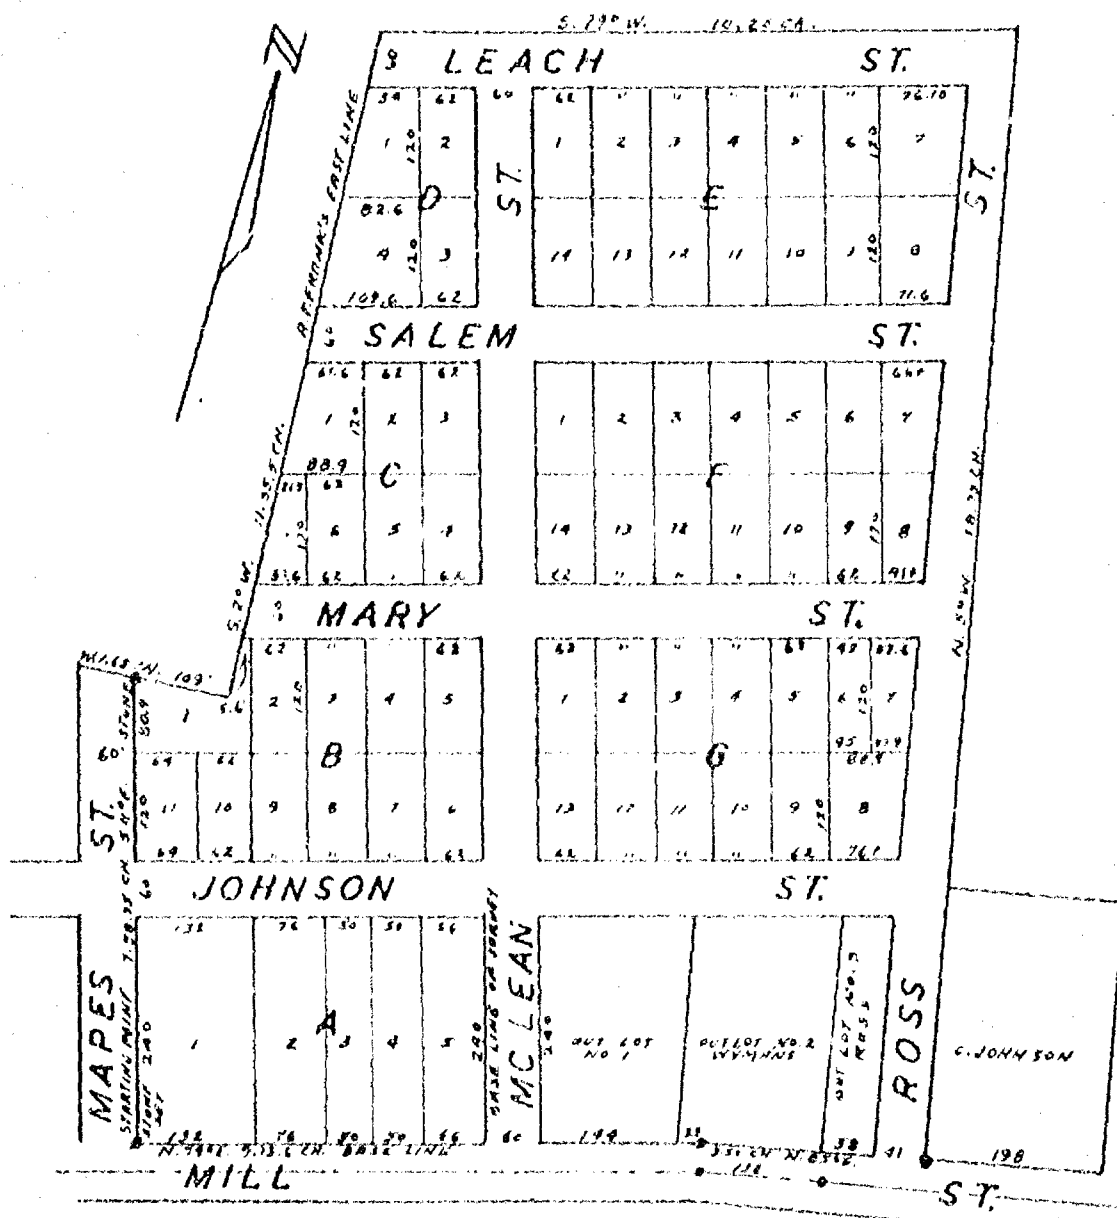


HARRY M. SCHMITT
ABSTRACT CO.
OSHKOSH, WIS

SCALE 1"=200'
VOL. 2 PG. 45

JOHNSON'S 2ND ADDITION
TO OMRO


8-12-15

7-18-15
228-15

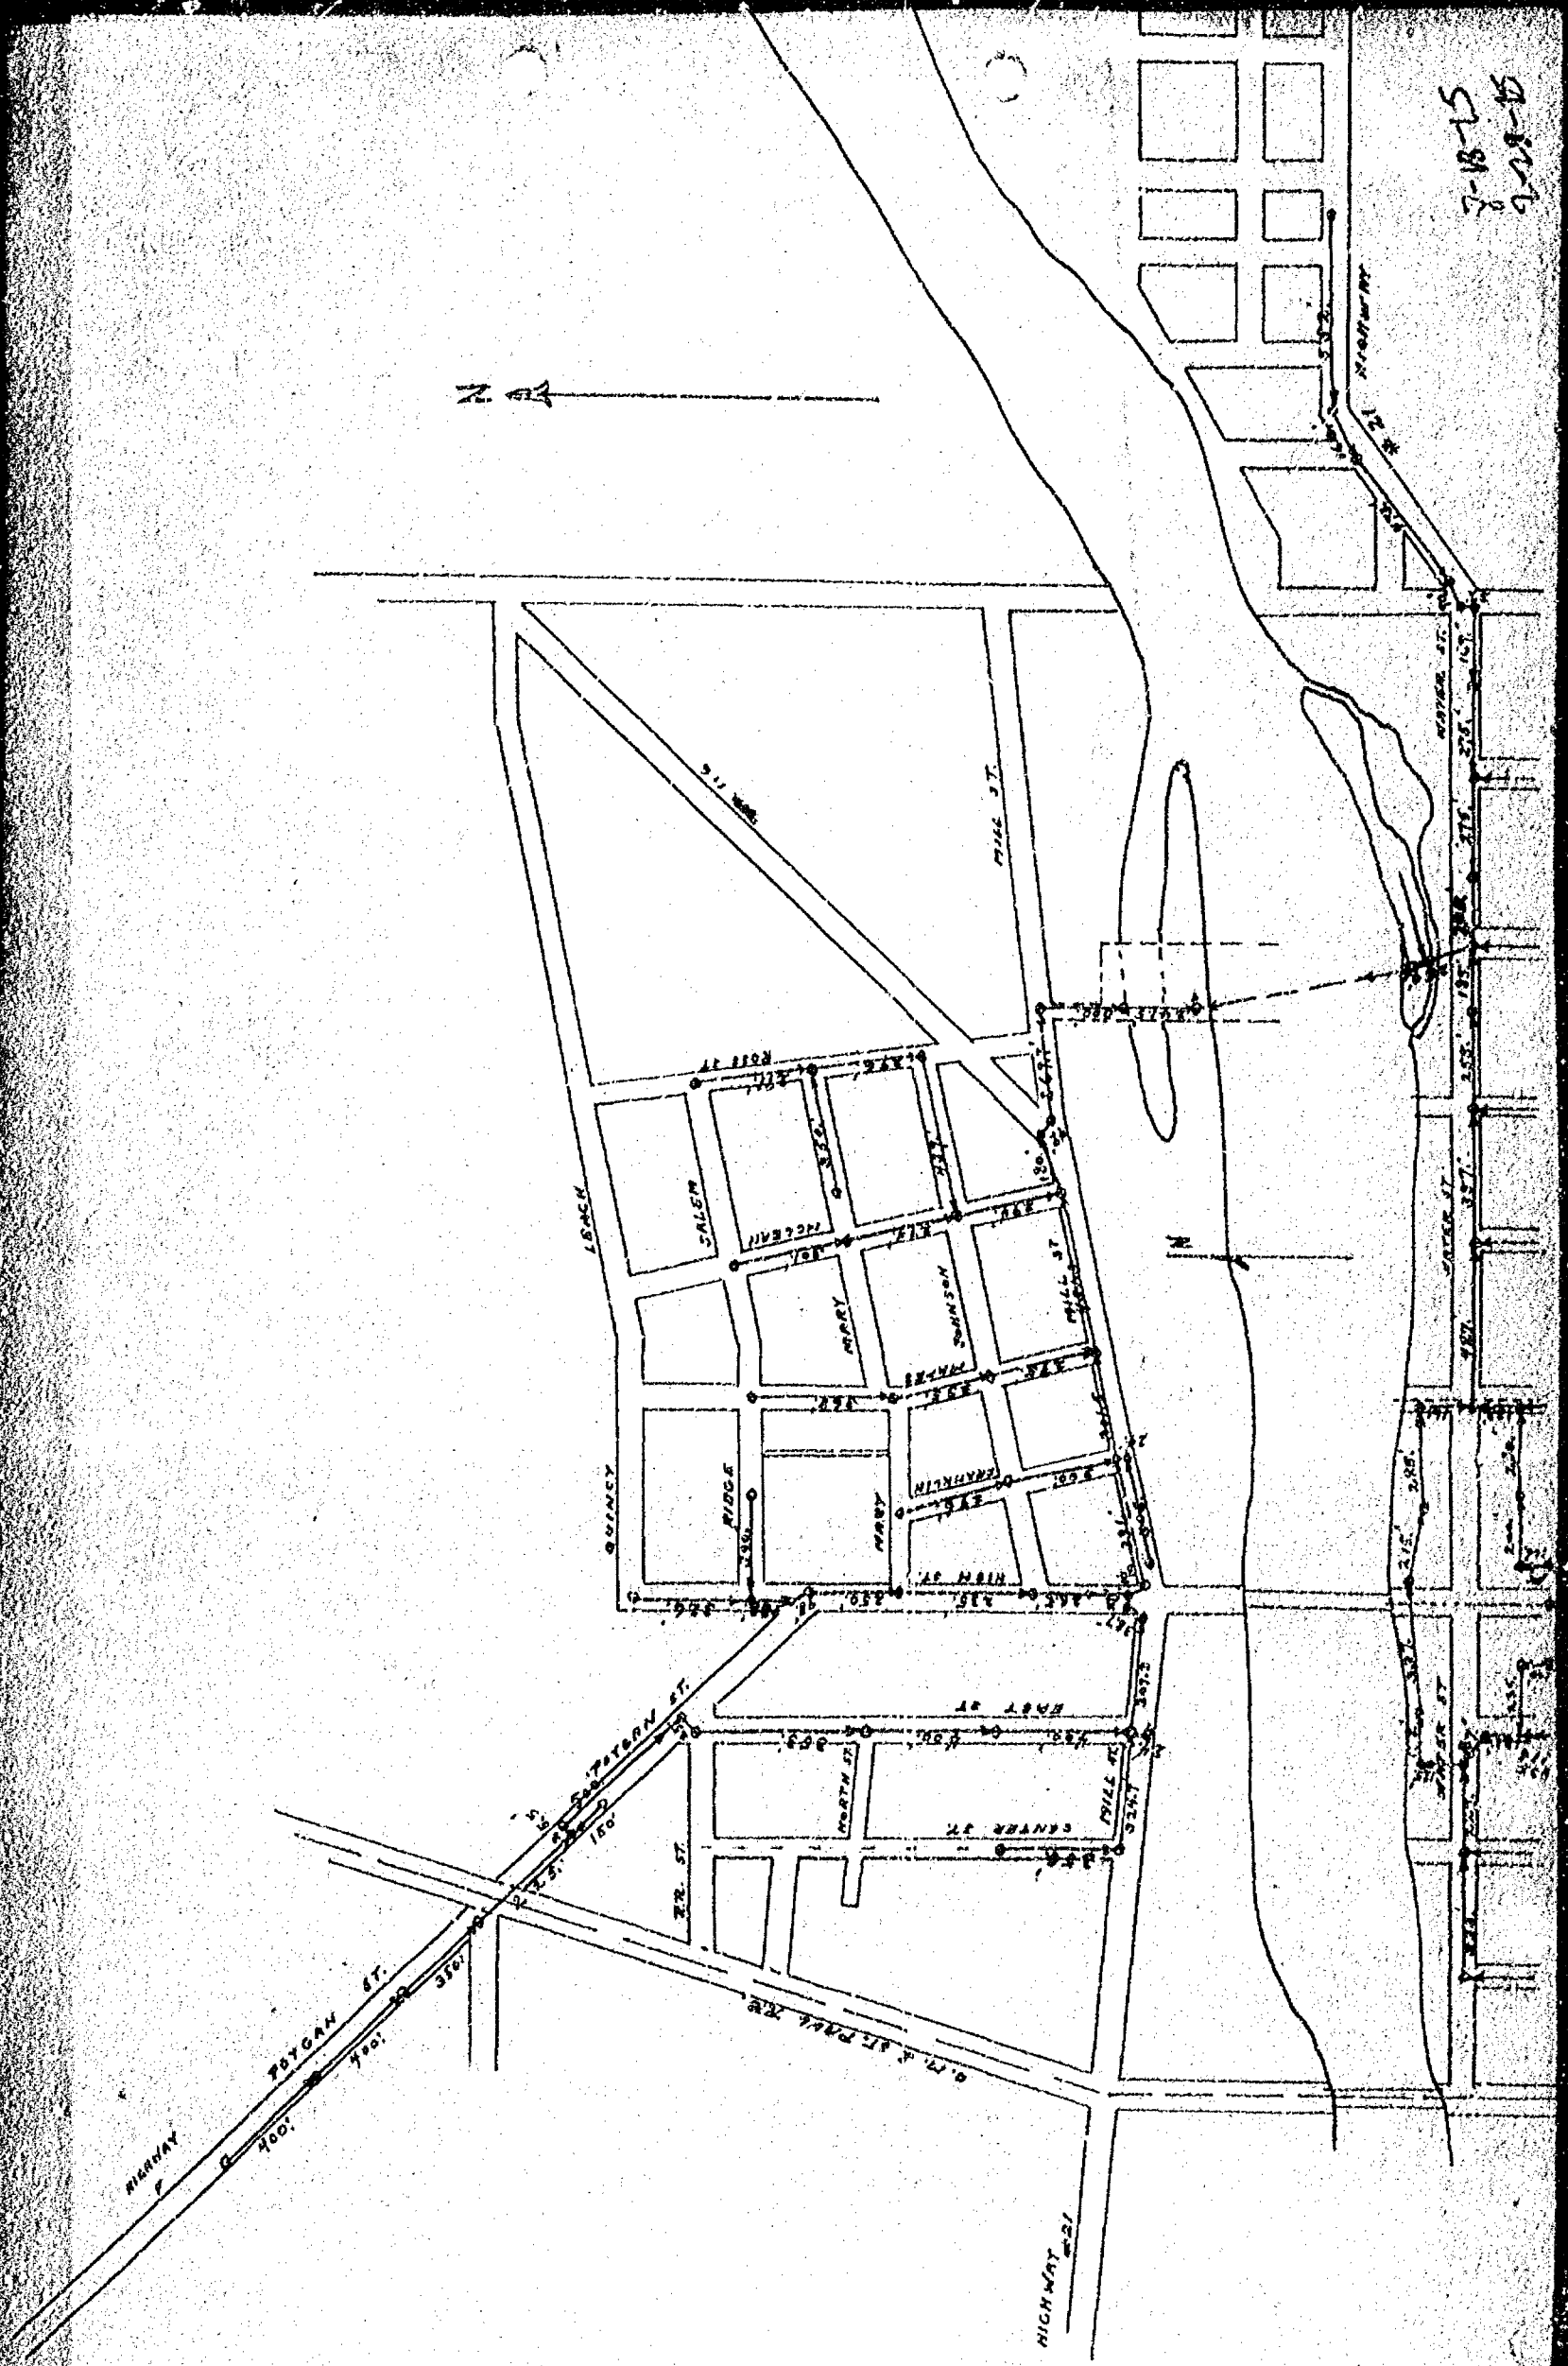

Survey of Piece of Land in N 1/2 SW 1/4 Sec 8 T18R15E East

141

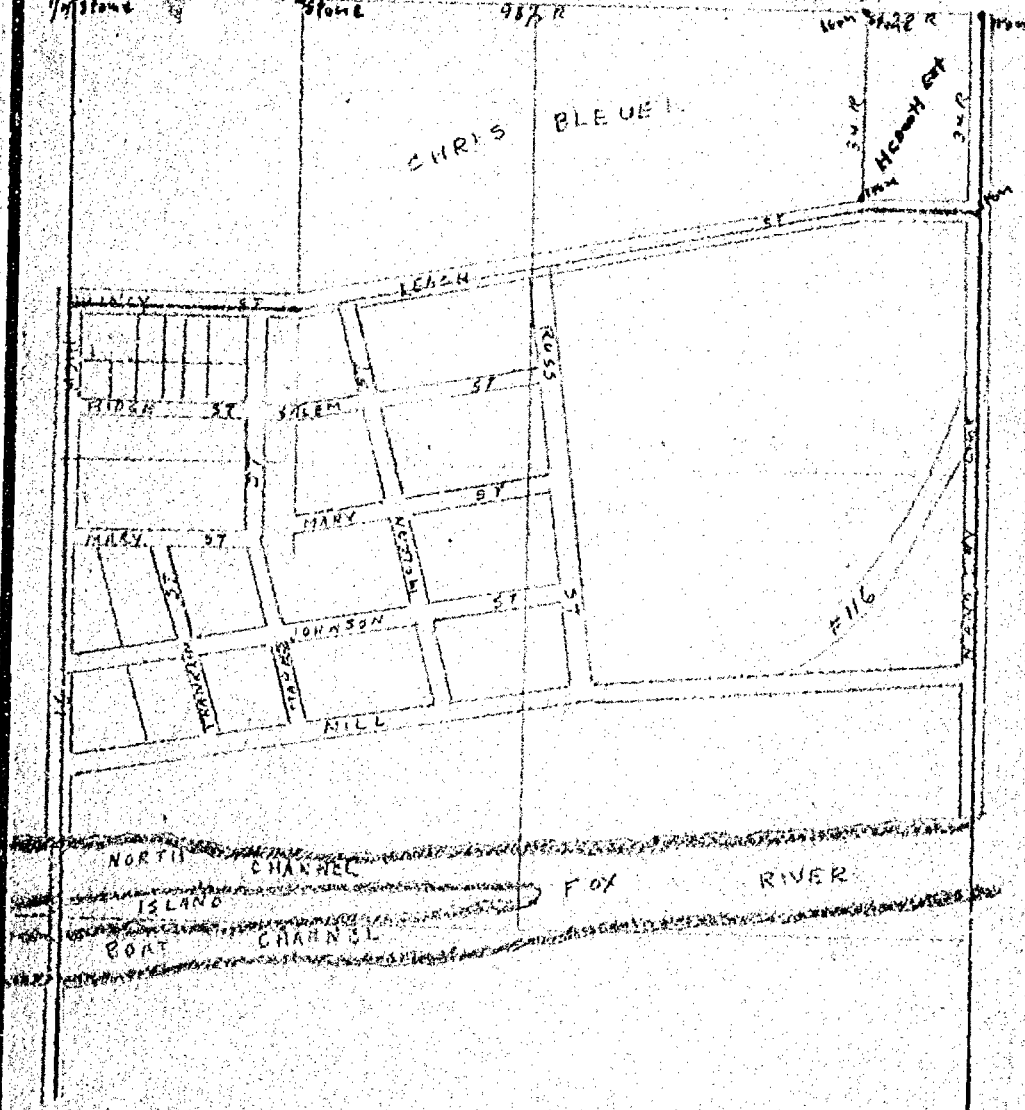

At the center of Sec 8 I dug in Road and found a small piece of a rotten stake I set in this spot a 1 inch gas pipe 2 1/2 ft long set it down level with the ground and around the top I placed an old thimble skein of a waggon I then from this stake surveyed out the land as shown on the within map and set iron stakes as shown marked in Red Ink Began May 16th 1913 Completed May 16th 1913 W W Gould Co Surveyor

Henry Anderson Chainman
Chris Bleuer

CITY OF OSHKOSH
ENGINEERING DEPARTMENT

DRAWN


SCALE

SURVEY OF PIECE OF LAND IN N 1/2 SW 1/4
SEC 8 TOWN 18 RANGE 15 EAST TOWN OF OMBRO
WINNEBAGO COUNTY WIS.

Survey For J.F. Dodd:

Description:

That Part Of Sec. 8-18-15, Town Of Omro, Winnebago County, Wis.
Described As Follows: That Part Of The N.E. 1/4 Of Sec. 8-18-15
Described As Follows: The South 300.0 ft. Of The West 150.0 ft.
Of The North 1411.0 ft. Of The N.E. 1/4 Of Sec. 8-18-15, Said
Parcel Contains 1.03 Acres More Or Less.

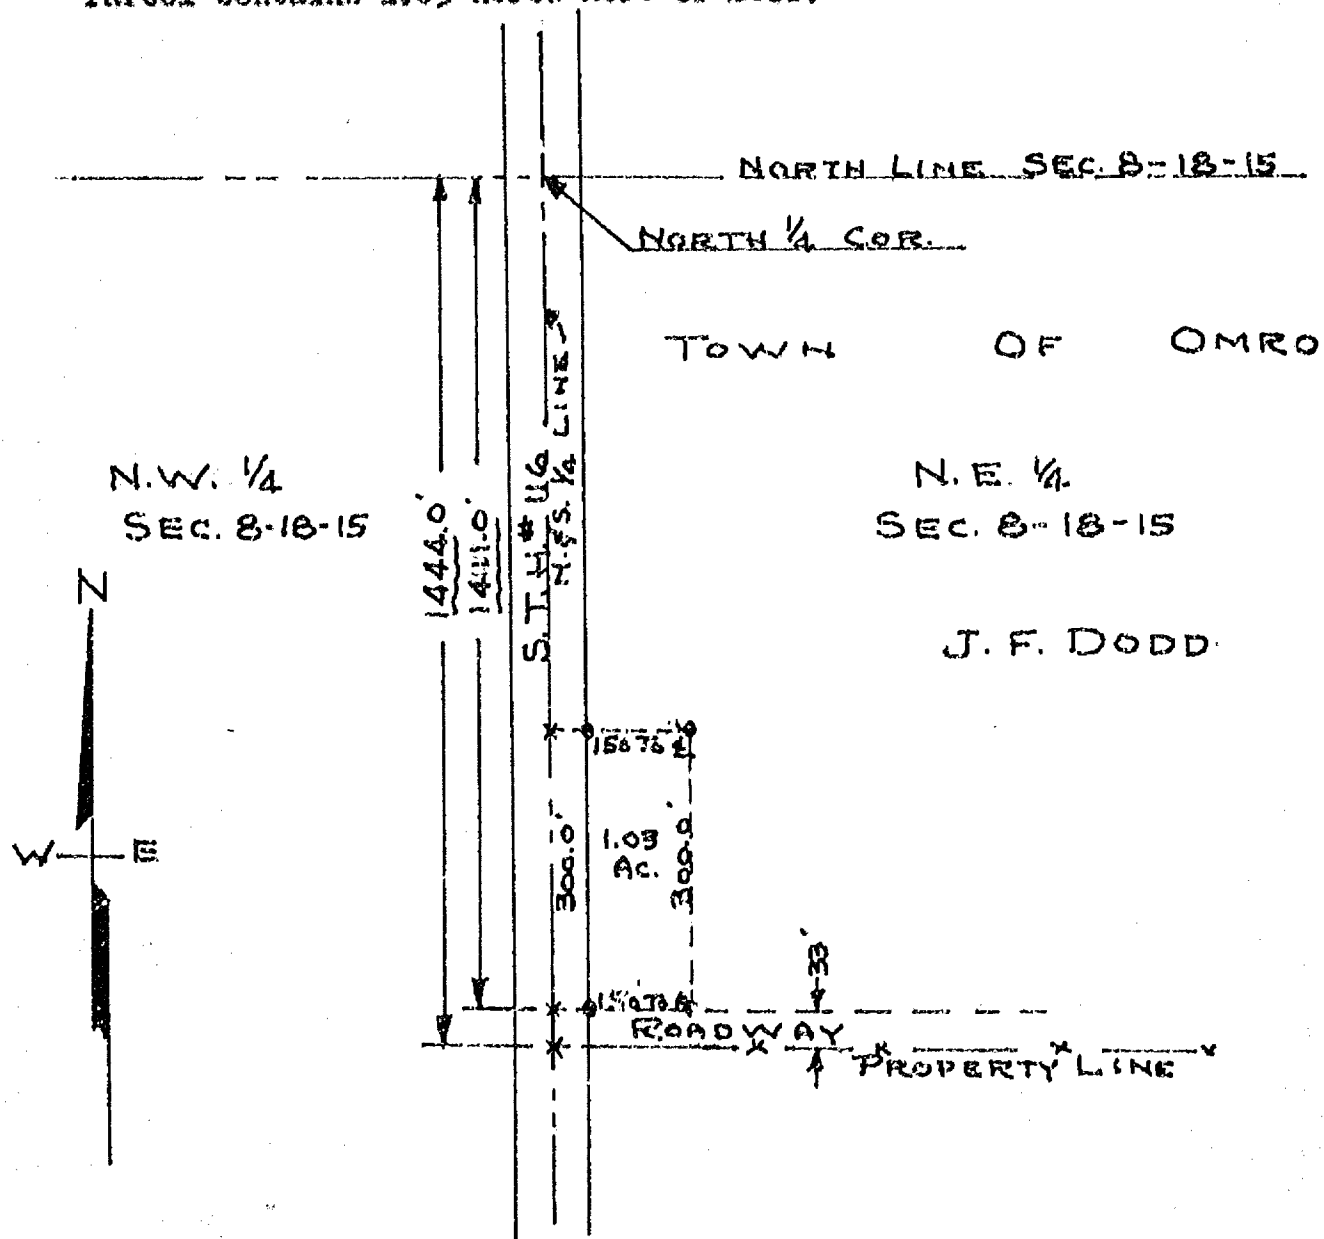


Scale
1" = 200'
Iron Stakes Shown Thus * *

SURVEY & PLATTING CO
OSHKOSH, WIS.
T.E. STEARNS & CO. SURVEYOR
April 19, 1961

4

Survey For J.F. Dodd:

That Part Of Sec. 8-18-15, T. 2 N. Of Oshkosh, Winnebago County, Wis. Described As Follows: That Part Of The E. 1/4 Of The N.E. 1/4 And The S.W. 1/4 Of The N.E. 1/4 Of Sec. 8-18-15 Described As Follows: Commencing At The N 1/4 Cor. Of Sec. 8, Thence South Along The North & South 1/4 Line A Distance Of 1248.0 ft. To The Place Of Beginning; Thence Due East A Distance Of 150.0 ft., Thence South Parallel With The North & South 1/4 Line A Distance Of 200.0 ft., Thence Due West A Distance Of 150.0 ft. To A Point On The North & South 1/4 Line, Thence North Along Said 1/4 Line A Distance Of 200.0 ft To The Place Of Beginning. Said Parcel Contains 0.69 Ac. More Or Less.

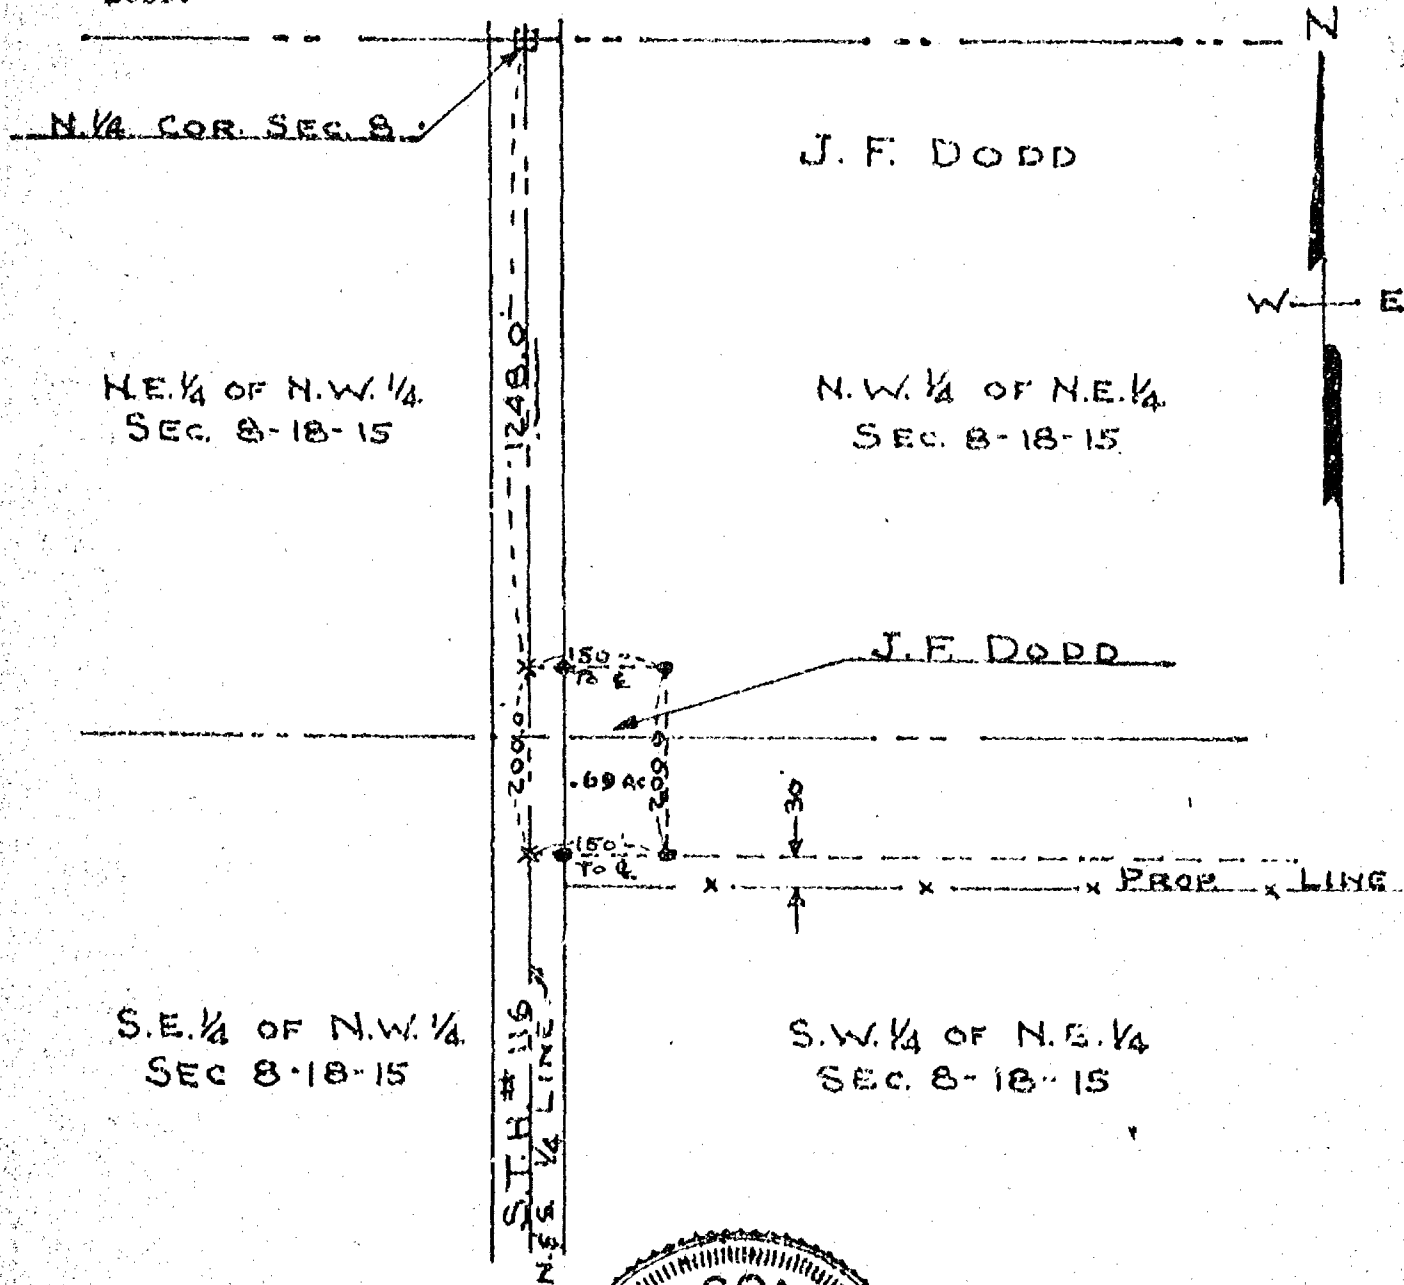


Scale 1" = 200'
Iron Stakes Shown Thus




Survey & Platting Corp.
Oshkosh, Wis.
T.E. Stearns - County Surveyor
Sept. 1, 1959 Job # C-42


Survey Map Showing Property Lines & Present And Purposed Shore Lines
Also Purposed Fill Area, All In Gov't. Lot # 1, Sec. 8-18-15, Town
Of Omro, Winnebago County, Wis.

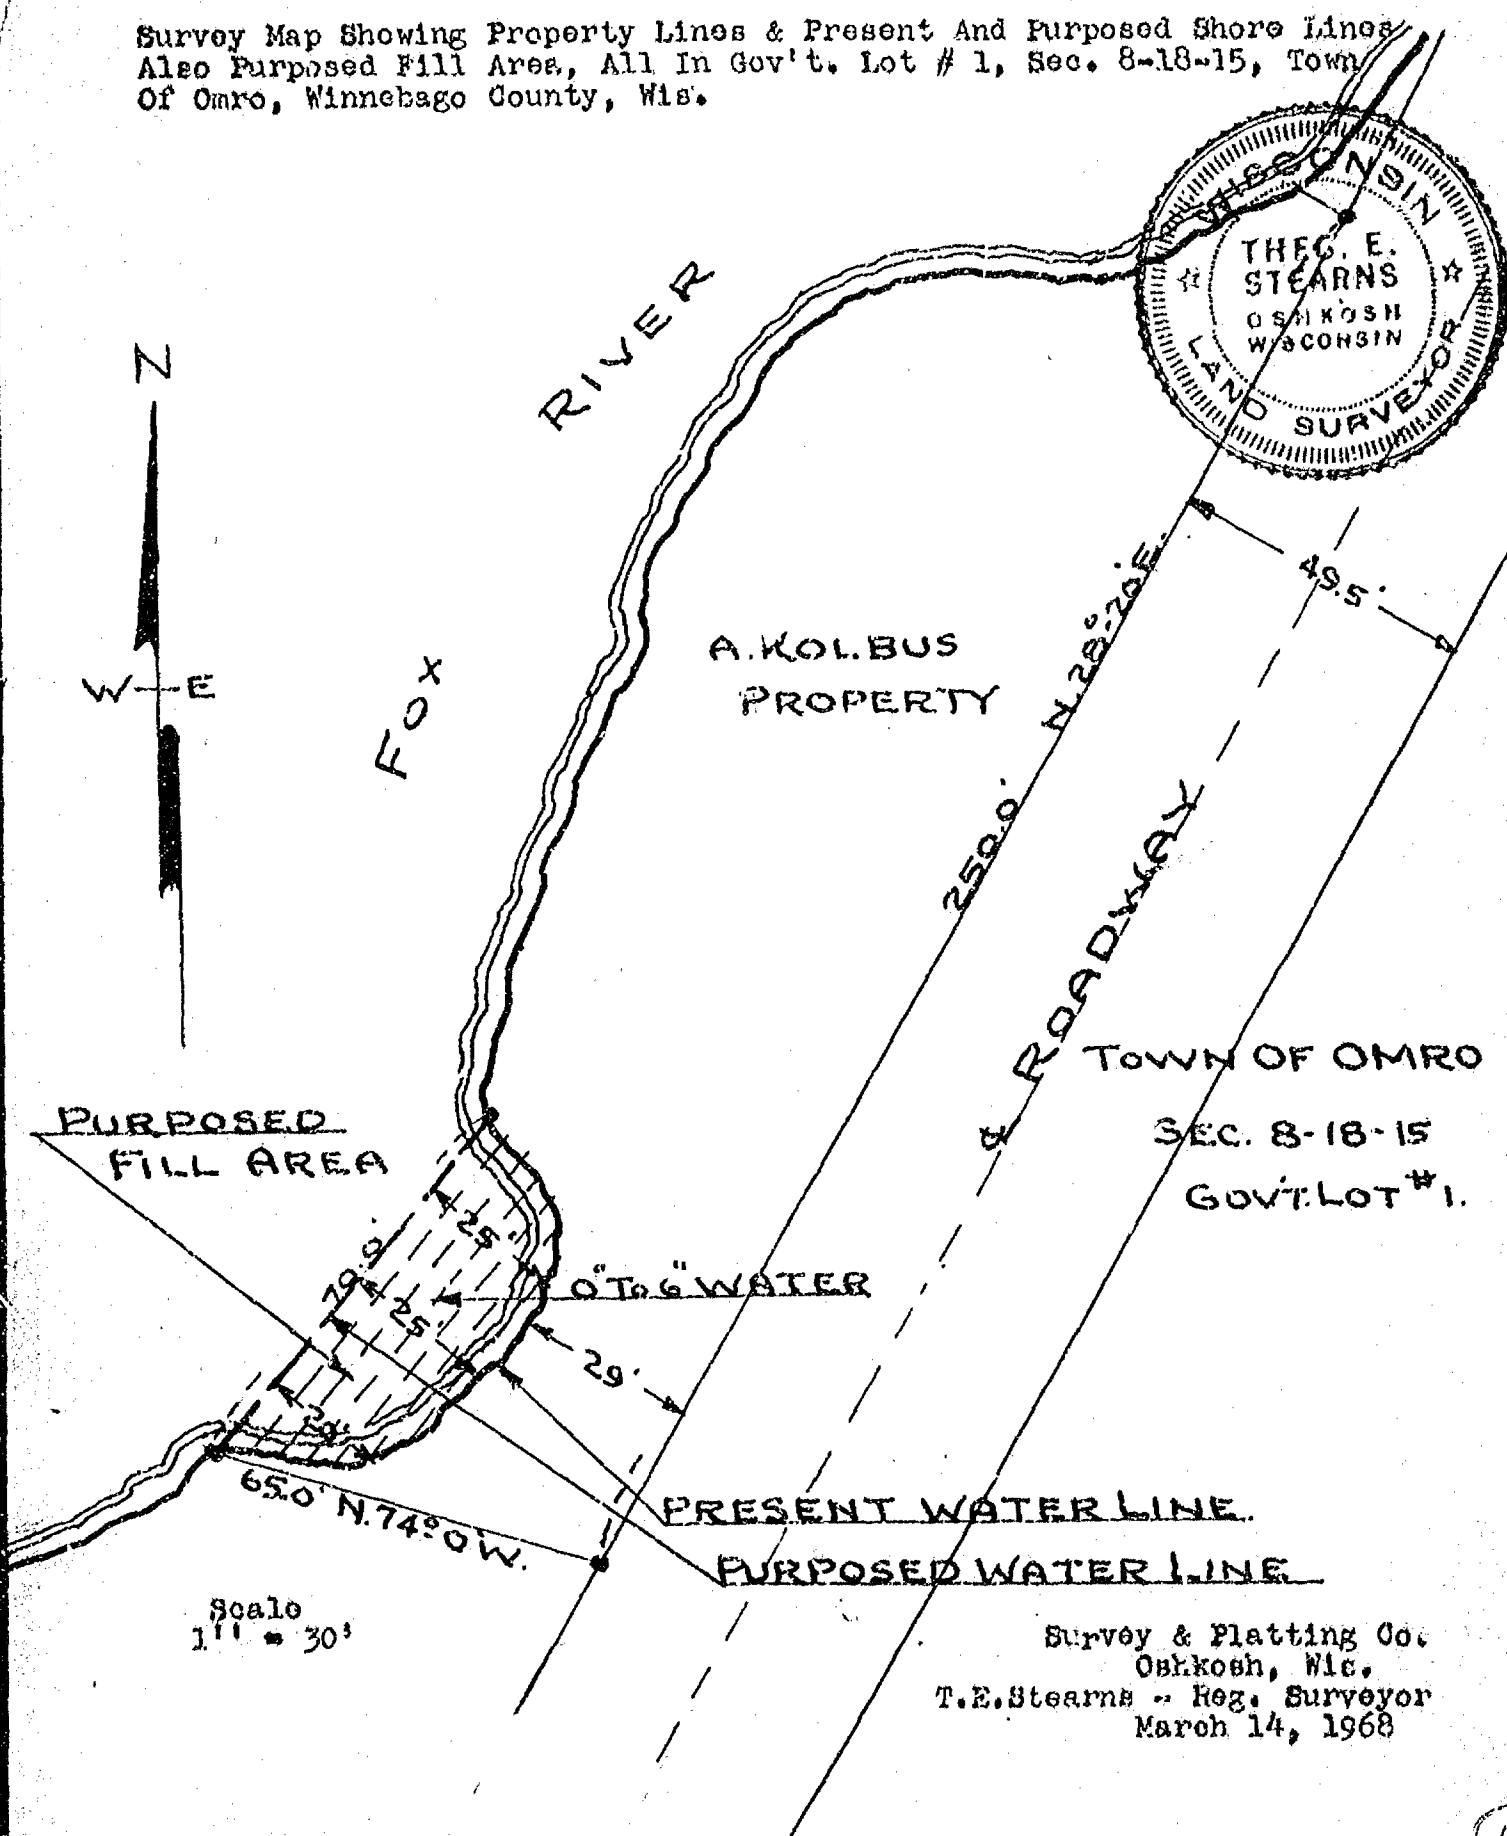


5

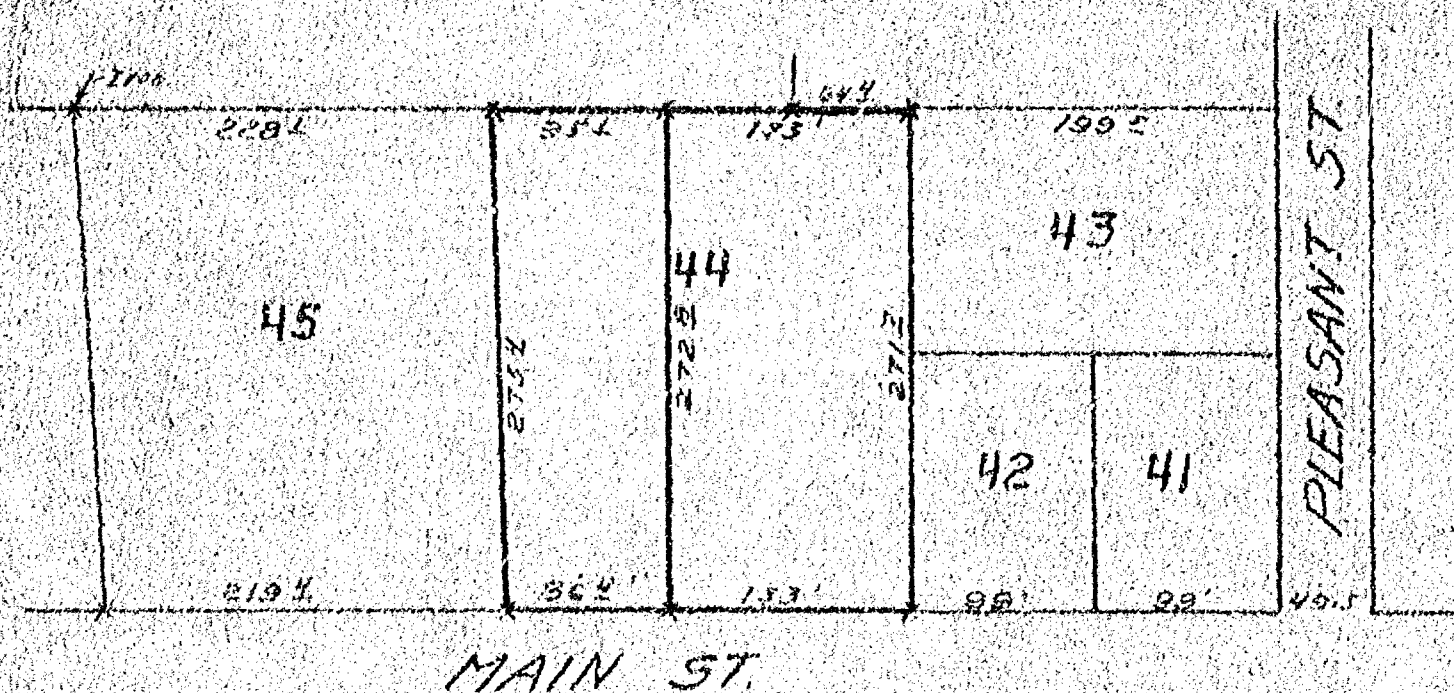

OUTLOT 44
 N.E. 1/4 SEC. 18, T18N R15E
 OMRO, WIS.

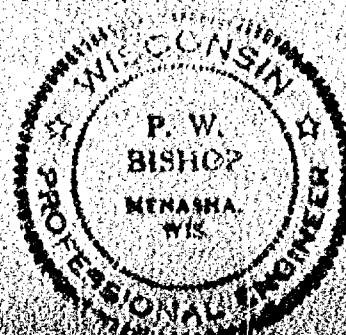

P. CRANE SURVEY	
OMRO, WIS.	
McMANIS ENGINEERING CO.	
MUNICIPAL ENGINEERS AND ARCHITECTS	
OMRO, WIS.	GRANT BAY, WIS.
1/10/00	P.W.B.

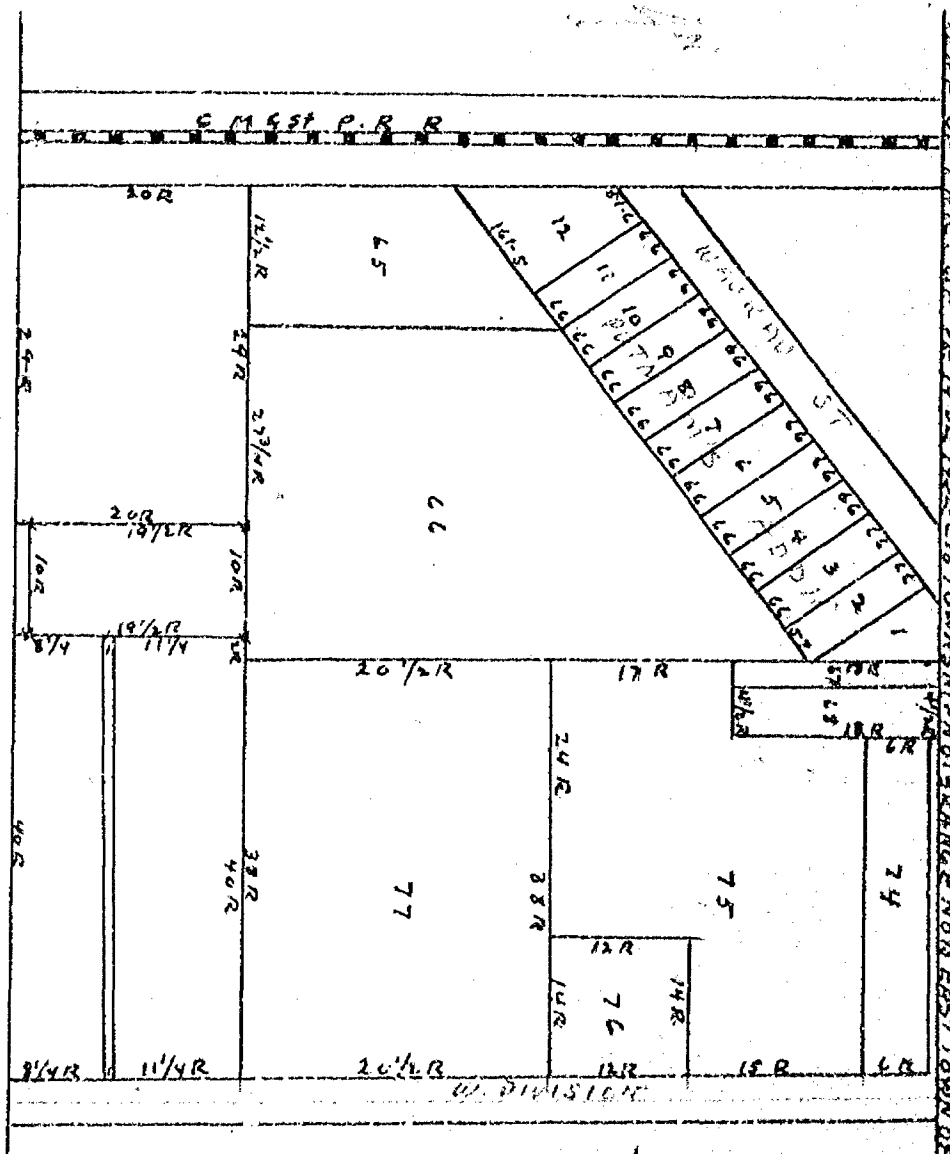


I Surveyed the small piece of land in S.E. 1/4 S.E. 1/4 Sec 18 as shown on above map according to the Deed shown me by H C Reitz the owner of the land adjoining I set iron stakes as shown marked in Red Ink Began Aug 15th 1921 Completed Aug 15th 1921 W W Goold Co Surveyor
 W W Goold Chainman
 Elmer Reitz

CITY OF OSHKOSH ENGINEERING DEPARTMENT	DRAWN	SURVEY OF LAND IN S.E. 1/4 S.E. 1/4 SEC 18 TOWNSHIP NO 15 EAST. 10N OF CMRO WIS
	SCALE	

MAP OF WESTERN ADDN TO OMRO & ORIGINAL PLAT OF OMRO

Scale 1/2 300'
Copied from Field Book Notes
of G.A. Randall
April 7, 1936
By Geo. Osterberg

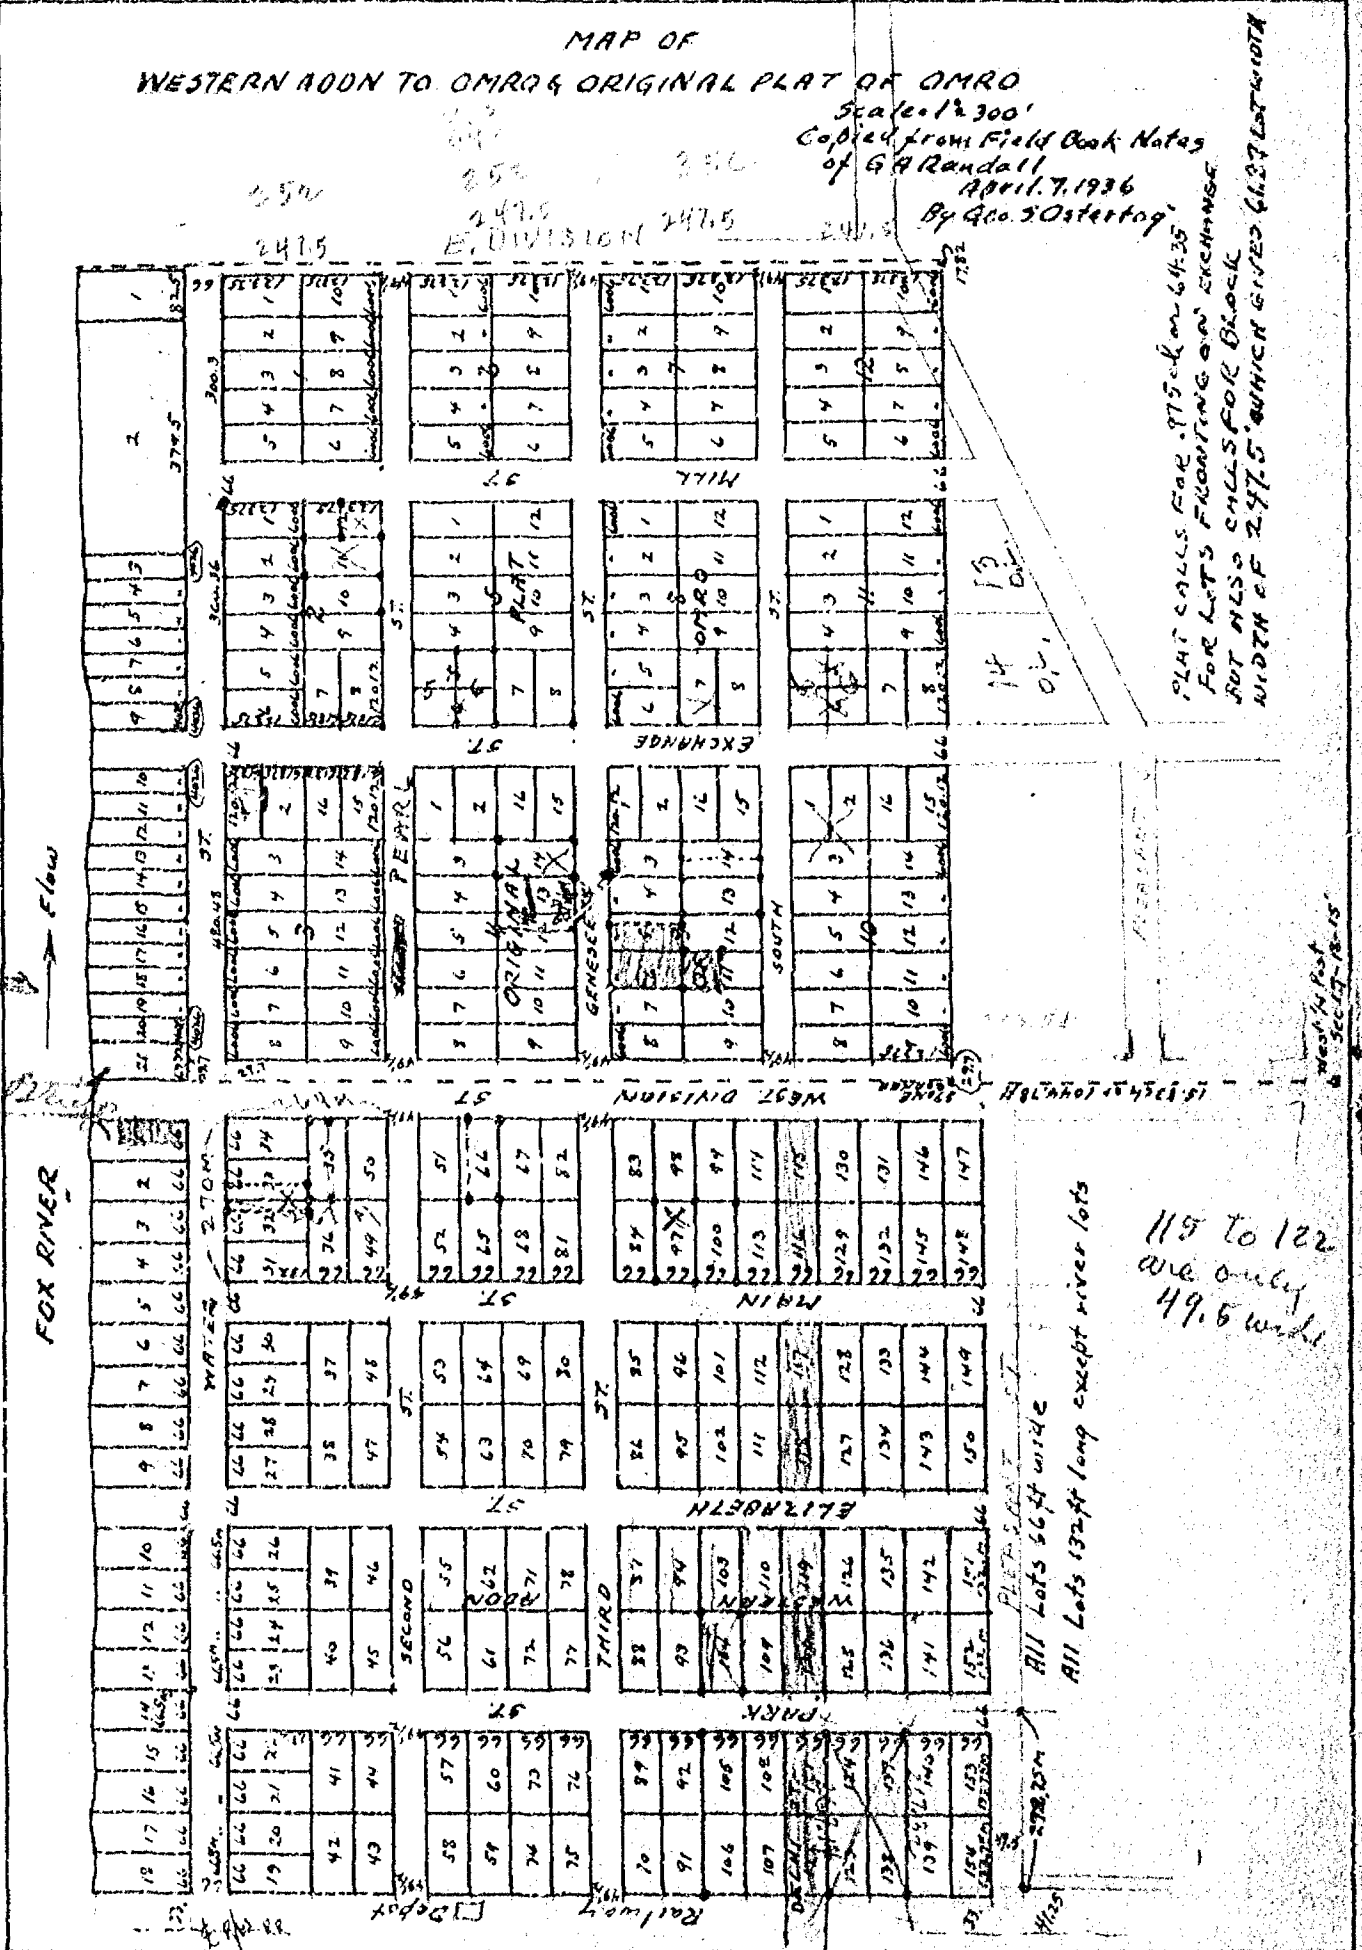

PLAT CALLS FOR .975 AC. OR 64.35
FOR LOTS FRONTING ON EXCHANGE
BUT ALSO CALLS FOR BLACK
WIDTH OF 2.475 WHICH GIVES 64.37 LOT WIDTH

All Lots 66 ft wide
All Lots 132 ft long except river lots

115 to 122
are only
49.6 wide

18-18-15

N 1/2 COCKER SEC 9-8-15

16185 EAST

EAST LINE SEC 9
APPROX. LOCATION

SURVEY
SHOWING LOCATION ROADS
TO F.M. McKEOUGH ET AL PROPERTY
SEC. 9 T29 N R 15 E
F.M. WOLVERTON REGISTERED SURVEYOR
SCALE 1" = 300' JUNE 7 1959



1478 30' N
1441 30' S
1413 30' S
X UNIT

Description on Reverse
Side

W. YOUNG SOUTH LINE

10011837.0 FEET
EAST 1/4 LINE

2ND CANAL
1755' EAST

CANAL OR DITCH


24508
EAST
2" 1200

25788
EAST
Begin of
12' Road
Near Thorough

26498 East
Meander line

W. YOUNG WEST LINE

Fence North

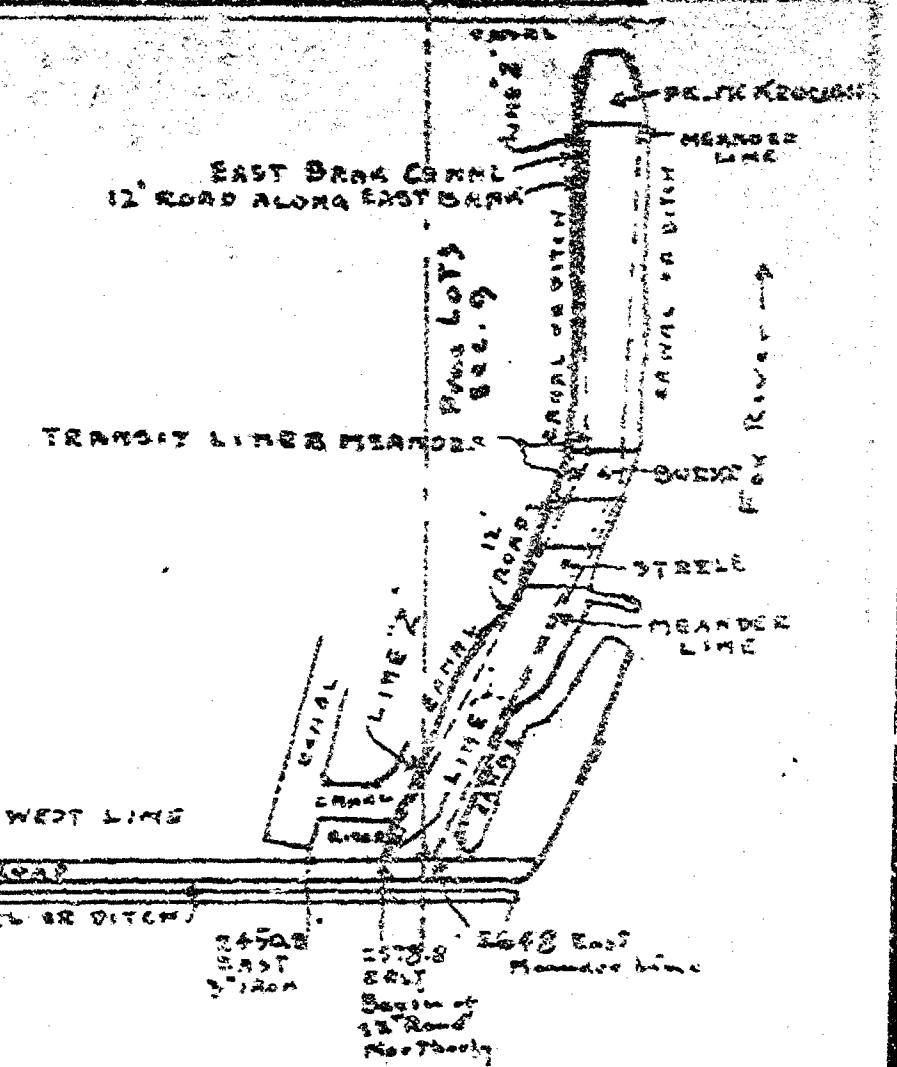


WINNEBAGO COUNTY CERTIFIED SURVEY MAP NO.
Part of the SW $\frac{1}{4}$ of Sec. 8, T.18N., R.15E., 3rd Ward, City of Onro,
Winnebago County, Wisconsin.

LEGEND:

- Existing irons found
- Berntsen monument
- 1"x30" iron pipe weighing 1.13 lbs. per lineal ft.

CURVE DATA:
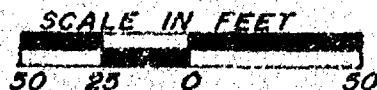
$$\begin{aligned}\Delta &= 149.48' 10'' \\ R. &= 510.44' \\ C. &= 131.51' \\ L. &= 131.88'\end{aligned}$$


Calvin W. Hawksworth S-1290
Wl. Reg. Land Surveyor
September 22, 1989

CITY OF OMRO PLANNING COMMITTEE CERTIFICATE

This Certified Survey Map of part of the SW $\frac{1}{4}$ of Sec. 8, T.18N., R.15E., 3rd Ward, City of Omo, is hereby approved.

Authorized signature

Date

Sheet 1 of 2 sheets

SI/4 CON
SEC. 8-18-15

SEC. LINE #

SAYLER SURVEY, INC.

LAND
SURVEYORS' WINNECONNE, WI.

FB: 54
P 113

Stock No. 26273

WINNEBAGO COUNTY CERTIFIED SURVEY MAP NO.
Part of the SW $\frac{1}{4}$ of Sec. 8, T.18N., R.15E., 3rd Ward, City of Onro,
Winnebago County, Wisconsin

SURVEYOR'S CERTIFICATE

I, Calvin W. Hawksworth, registered land surveyor, hereby certify;
That I have surveyed, divided and mapped the parcel of land located
in the SW $\frac{1}{4}$ of Sec. 8, T.18N., R.15E., 3rd Ward, City of Onro, Winne-
bago County, Wisconsin, described as follows: Beginning at a point on
the East line of the SW $\frac{1}{4}$ of said Sec. 8 that is 1786.75 ft.,
N.00°45'19"E. of the South $\frac{1}{4}$ corner of said Sec. 8. From that point
running N.78°52'16"W., 107.78 ft., thence N.50°31'27"W., 114.10 ft. to
the southerly right of way line of S.T.H. "116", thence N.44°58'33"E.,
119.22 ft., thence 131.88 ft. along the arc of a curve whose chord
bears N.37°34'28"E., 131.51 ft., thence N.74°24'45"E., 34.47 ft. to
the East line of the SW $\frac{1}{4}$ of said Sec. 8, thence S.00°45'19"W., 291.19
ft. to the said point of beginning. Being a parcel of land of 0.741
acres, more or less. Reserving therefrom the easterly 33.00 ft.
presently used for road purposes. Subject to all easements and restric-
tions of record.

That I have made such survey, land division and map by the
direction of Gary Yakes, Att., 141 N. Sawyer, Oshkosh, Wi., 54901;
that such map is a true and correct representation of the exterior
boundaries of the land surveyed.

That I have fully complied with the provisions of Sec. 236.34 of
the Wisconsin Statutes and the City of Onro Subdivision Ordinance in
surveying, dividing and mapping the same.

Calvin W. Hawksworth
Calvin W. Hawksworth S-1290
Wisconsin Registered Land Surveyor
September 22, 1989



OWNER'S CERTIFICATE

As owner, I hereby certify that I caused the land described on this
certified survey map to be surveyed, divided and mapped as represented
hereon.

WITNESS the hand and seal of said owner this _____ day of
_____, 1989.

Marjorie E. Tomasek
631 Hawthorne Dr.
Onro, Wi.

STATE OF WISCONSIN) ss
WINNEBAGO COUNTY)

Personally came before me this _____ day of _____
1989, the above named owner to me known to be the person who executed
the foregoing instrument and acknowledged the same.

Notary Public, _____ Wi.


My commission expires _____.

Sheet 2 of 2 sheets
SAYLER SURVEY, INC. WINNECONNE, WI.

Stock No. 26273

WINNEBAGO COUNTY CERTIFIED SURVEY MAP NO. 1948
 Part of the SE $\frac{1}{4}$ of the NW $\frac{1}{4}$ of Sec. 8, T.18N., R.15E., Town of Omro,
 Winnebago County, Wisconsin.

Bearings are referenced to the E-W $\frac{1}{4}$ Sec. line, Sec. 8-18-15, assumed
 to bear N.89°41'21"E.

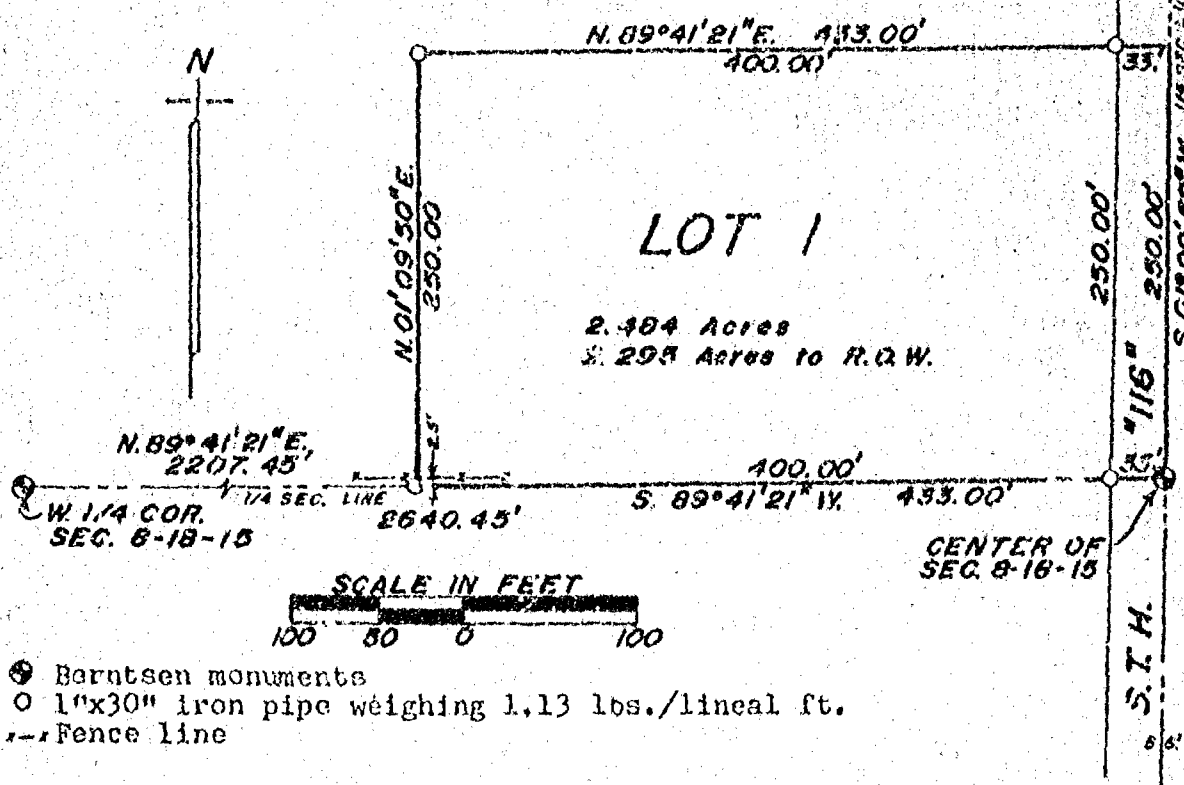

SURVEYOR'S CERTIFICATE


I, Robert H. Saylor, registered land surveyor, hereby certify:

That I have surveyed, divided and mapped the parcel of land located in part of the SE $\frac{1}{4}$ of the NW $\frac{1}{4}$ of Sec. 8, T.18N., R.15E., Town of Omro, Winnebago County, Wisconsin, described as follows: Beginning at a point on the Southerly line of the NW $\frac{1}{4}$ of said Sec. 8 that is 2207.45 ft., N.89°41'21"E. of the West $\frac{1}{4}$ corner of said Sec. 8. From that point running N.01°09'50"E., 250.00 ft., thence N.89°41'21"E., 433.00 ft. to the East line of the NW $\frac{1}{4}$ of said Sec. 8, thence S.01°09'50"W., 250.00 ft. to the Southerly line of said NW $\frac{1}{4}$, thence S.89°41'21"W. along said Southerly line, 433.00 ft. to the said point of beginning. Being a parcel of land of 2.484 acres, more or less. Subject to all restrictions and easements of record.

That I have made such survey, land division and map by the direction of Gerald Garvens, 4665 Hwy. 116, Omro, WI.; 54963; that such map is a true and correct representation of the exterior boundaries of the land surveyed.

That I have fully complied with the provisions of Sec. 236.34 of the Wisconsin Statutes and the Winnebago County Subdivision Ordinance in surveying, dividing and mapping the same.

Robert H. Saylor
 Robert H. Saylor S-1894
 Wisconsin Registered Land Surveyor
 November 11, 1988.

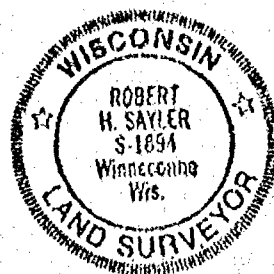

Sheet 1 of 2 sheets

SAYLER SURVEY, INC. LAND SURVEYORS WINNECONNE, WI.

FB 56
 R 59

Stock No. 26273

WINNEBAGO COUNTY CERTIFIED SURVEY MAP NO. 1948
Part of the SE $\frac{1}{4}$ of the NW $\frac{1}{4}$ of Sec. 8, T.18N., R.15E., Town of Onro,
Winnebago County, Wisconsin.

OWNER'S CERTIFICATE

As owner(s), I(we) hereby certify that I(we) caused the land described on this Certified Survey Map to be surveyed, divided and mapped as represented hereon.

Henry R. Bartelt
Henry R. Bartelt, owner
4401 Hwy. 116
Onro, WI. 54963

Owner

John H. Wallace
Agent

STATE OF WISCONSIN) 35
WINNEBAGO COUNTY)

Personally came before me this 11th day of November, 1988, the above named owner(s)---agent--- to me known to be the person(s) who executed the foregoing instrument and acknowledged the same.

Quene J. Haedt
Notary Public, Onro WI.

My commission expires October 16, 1992.

WINNEBAGO COUNTY PLANNING COMMITTEE CERTIFICATE

This certified survey map of part of the SE $\frac{1}{4}$ of the NW $\frac{1}{4}$ of Sec. 8, T.18N., R.15E., Town of Onro, is hereby approved.

December 16, 1988
Date

Quene J. Haedt
Authorized signature

Robert H. Saylor
Robert H. Saylor S-1894
November 11, 1988
Wisconsin Registered Land Surveyor



Sheet 2 of 2 sheets

SAYLER SURVEY, INC. WINNECONNE, WI.


Registrar's Office
Winnebago County, WI.
Received For Record This 11th
Day Of November AD. 1988
At 11:10 O'Clock A.M.
Filed In Vol. 1 Of C.S.M.
On Page 1048
Theresa J. H. H. H.
Register Of Deeds

714309

Plat of Survey

PART OF THE SE 1/4 OF THE NW 1/4 OF SEC. 8, T.18N., R.15E., TOWN OF OMRO, WINNEBAGO CO., WI.


ADDITION TO C.S.M. NO. 1948
DOC. NO. 714309

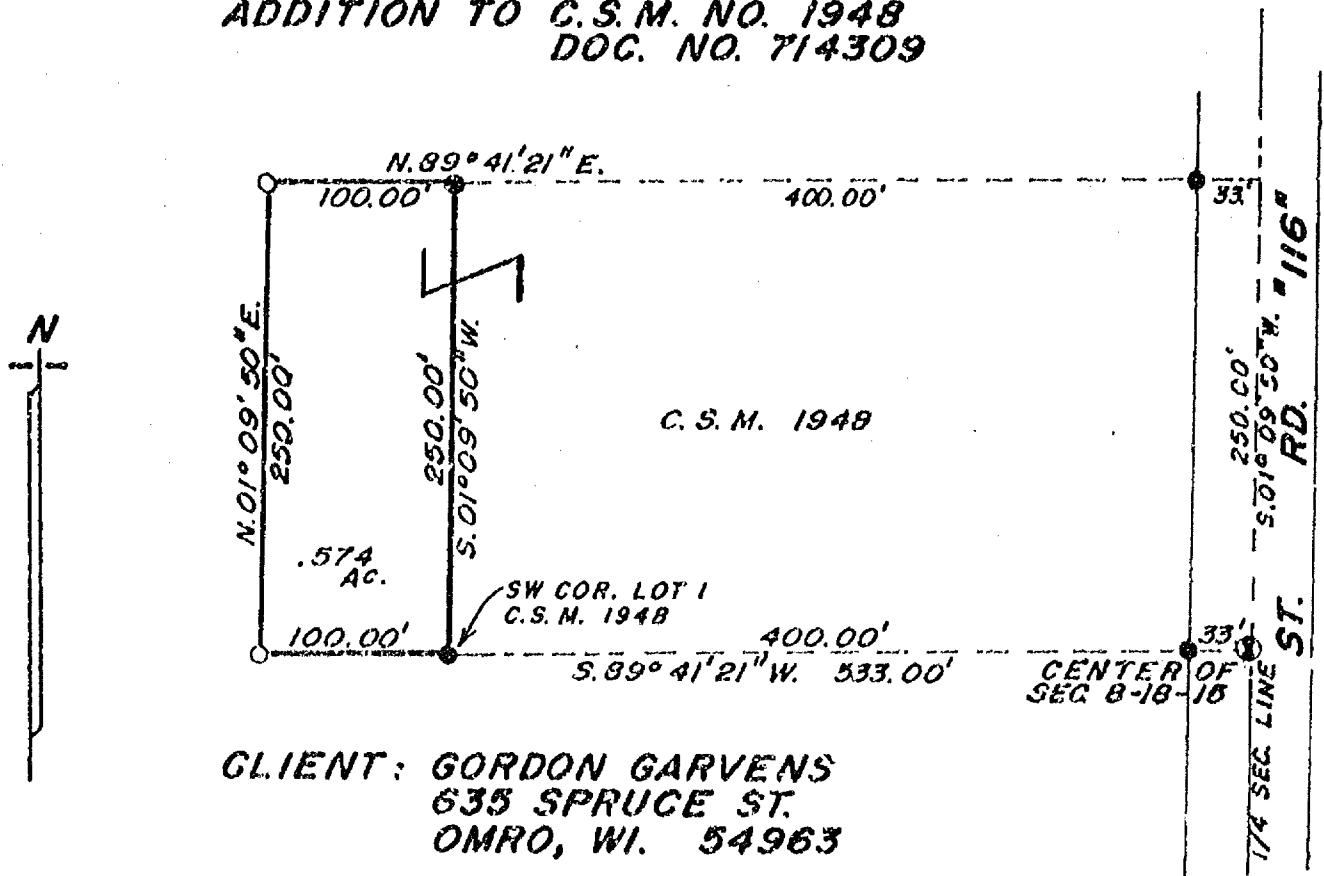

CLIENT: GORDON GARVENS
635 SPRUCE ST.
OMRO, WI. 54963

LEGAL DESCRIPTION:

All that part of the SE 1/4 of the NW 1/4 of Sec. 8, T.18N., R.15E. in the Town of Omro, Winnebago County, Wisconsin, described as follows: Beginning at the Southwest corner of Lot 1 of Certified Survey Map No. 1948, Doc. No. 714309, Winnebago County Records. From that point continuing S. 89° 41' 21" W., 100.00 ft., thence N. 01° 09' 50" E., 250.00 ft., thence N. 89° 41' 21" E., 100.00 ft., thence S. 01° 09' 50" W., 250.00 ft. to the said point of beginning. Being a parcel of land of 0.574 acres. Subject to all easements and restrictions of record. Said parcel is an addition to an existing parcel.

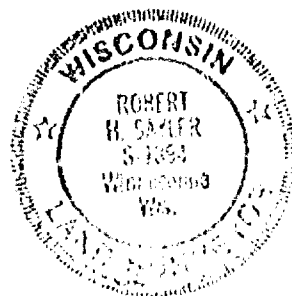

LEGEND

- ⊙ = Existing monuments
- = 2" x 30" iron pipe set
- = 1" x 30" iron pipe set
- ⊙ = reference caps or RR spikes
- ⊙ = Bernier or Harrison monuments
- x--x = fence
- () = recorded as
- = stone monument

SURVEYORS CERTIFICATE

I, hereby certify that I have surveyed the property as shown, according to official records and that the plat above drawn is an accurate and correct representation of said survey. JANUARY 22, 1993

Robert H. Sawyer

Wisconsin Registered Land Surveyor S-1894


Sawyer
Survey, Inc.

139A WEST MAIN, BOX 262, WINNECONNE, WI 54986

SCALE 1 IN. = 100 FT.
PROJECT NO. S-002630
FIELD BOOK 56 PAGE 59

CERTIFIED SURVEY MAP NO. _____


GRAPHIC SCALE: 1" = 100'

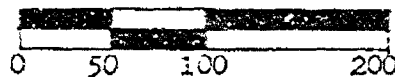


BEING PART OF THE SOUTHWEST $\frac{1}{4}$ OF THE NORTHEAST $\frac{1}{4}$ OF SECTION 8, TOWN 18 NORTH,
RANGE 15 EAST, TOWN OF OMRO, WINNEBAGO COUNTY, WISCONSIN.

THE OWNER OF THE PROPERTY IS ED NIGBOR

NORTH IS REFERENCED TO THE NORTH-SOUTH $\frac{1}{4}$
LINE OF SECTION 8, TOWN OF OMRO, WINNEBAGO
COUNTY, WISCONSIN, WHICH IS ASSUMED TO BEAR
N01°-05'-52"E.

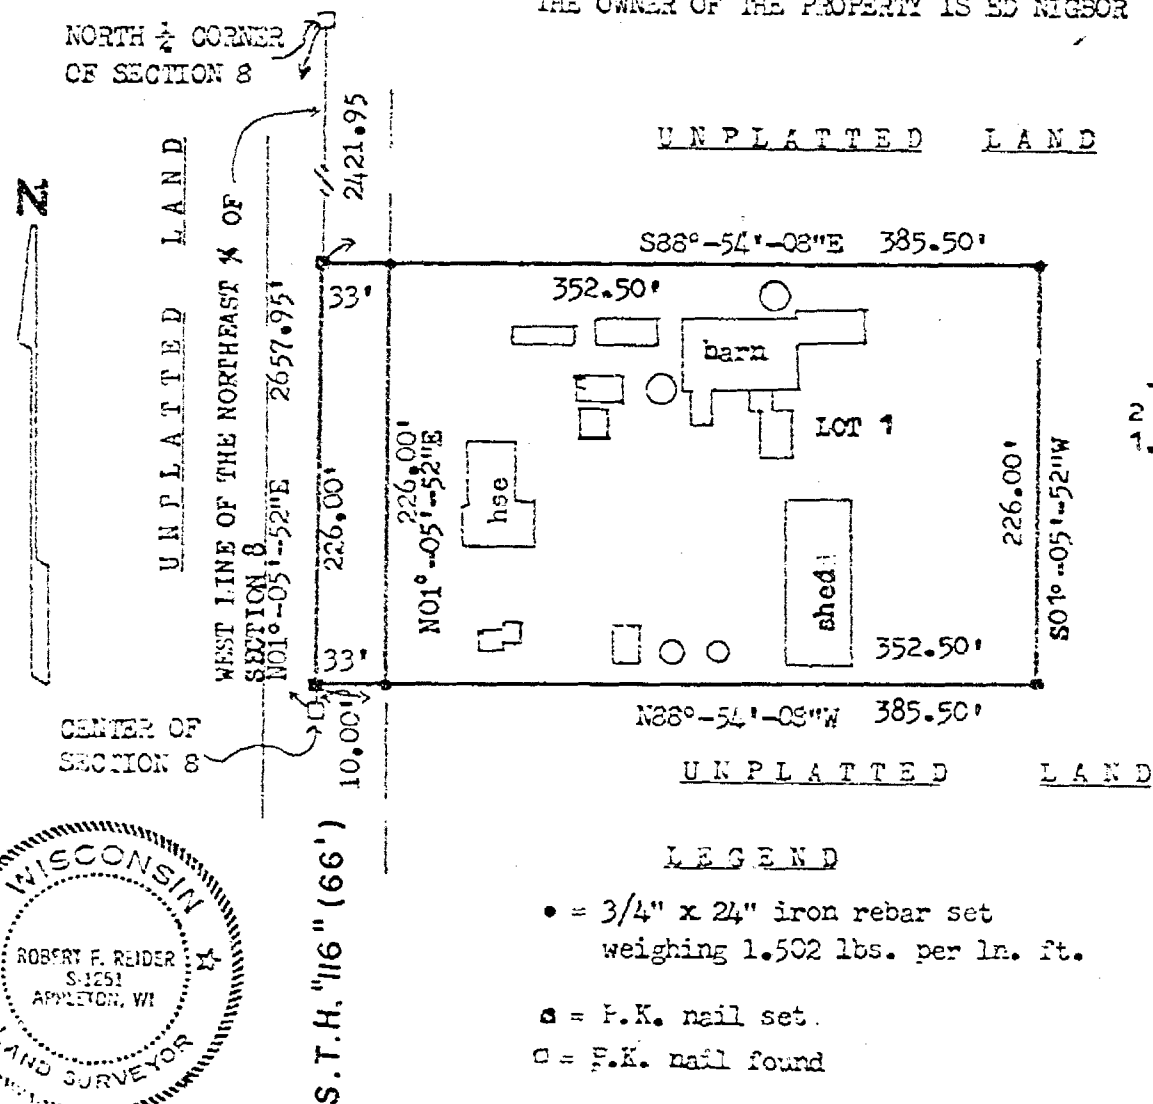**LEGEND**

- = 3/4" x 24" iron rebar set
weighing 1.502 lbs. per ln. ft.
- = P.K. nail set.
- = P.K. nail found

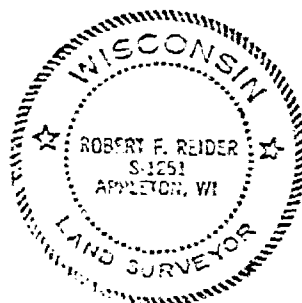

Robert F. Reider 4-29-93
ROBERT F. REIDER RLS 1251 DATED
CARON LAND SURVEYING CO., INC.
1837 W. WISCONSIN 54913-1297
A933.75 (ec-ms SAE 4-27-93)


CERTIFIED SURVEY MAP NO. _____**SURVEYOR'S CERTIFICATE:**

I, ROBERT F. REIDER, REGISTERED WISCONSIN LAND SURVEYOR, CERTIFY THAT I HAVE SURVEYED, DIVIDED AND MAPPED PART OF THE SOUTHWEST 1/4 OF THE NORTHEAST 1/4 OF SECTION 8, TOWNSHIP 18 NORTH, RANGE 15 EAST, TOWN OF OMRO, WINNEBAGO COUNTY, WISCONSIN, BOUNDED AND DESCRIBED AS FOLLOWS: COMMENCING AT THE NORTH 1/4 CORNER OF SAID SECTION 8; THENCE S01-05-52W, 2421.95 FEET ALONG THE WEST LINE OF THE NORTHEAST 1/4 OF SECTION 8 TO THE POINT OF BEGINNING; THENCE S88-54-08E, 385.50 FEET; THENCE S01-05-52W, 266.00 FEET; THENCE N88-54-08W, 385.50 FEET TO THE WEST LINE OF THE NORTHEAST 1/4 OF SECTION 8; THENCE N01-05-52E, 226.00 FEET ALONG SAID WEST LINE TO THE POINT OF BEGINNING.

THAT I HAVE MADE SUCH SURVEY UNDER THE DIRECTION OF ED NIGBOR, 4376 S.T.H. "116", OMRO, WISCONSIN 54963.

THAT THIS MAP IS A CORRECT REPRESENTATION OF THE EXTERIOR BOUNDARY LINES OF THE LANDS SURVEYED.

THAT I HAVE FULLY COMPLIED WITH THE PROVISIONS OF CHAPTER 236.34 OF THE WISCONSIN STATUTES AND THE SUBDIVISION ORDINANCES OF WINNEBAGO COUNTY.

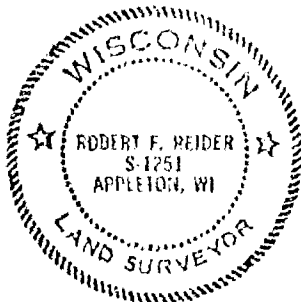

Robert F. Reider 4-30-93
 ROBERT F. REIDER, RLS-1251 DATED
 CAROW LAND SURVEYING CO., INC.
 1837 W. WISCONSIN AVE. P.O. BOX 1297
 APPLETON, WISCONSIN 54912-1297
 A933.75 (EC-MS SAW 4-27-93)

OWNER'S CERTIFICATE:

AS OWNER(S) I (WE) HEREBY CERTIFY THAT I (WE) CAUSED THE LAND DESCRIBED ON THIS CERTIFIED SURVEY MAP TO BE SURVEYED, DIVIDED AND MAPPED AS REPRESENTED. I (WE) ALSO CERTIFY THAT THIS MAP REQUIRES THE APPROVAL OF THE WINNEBAGO COUNTY PLANNING AND ZONING COMMITTEE.

WITNESS THE HAND AND SEAL OF SAID OWNER(S) THIS _____ DAY OF _____, 1993.

IN THE PRESENCE OF:

 EDMUND J. NIGBOR

 WITNESS

STATE OF WISCONSIN)
)SS
 COUNTY OF WINNEBAGO)

PERSONALLY CAME BEFORE ME THIS _____ DAY OF _____, 1993. THE ABOVE NAMED PERSON(S) TO ME KNOWN TO BE THE PERSON(S) WHO EXECUTED THE FOREGOING INSTRUMENT AND ACKNOWLEDGED THE SAME.

 NOTARY PUBLIC

MY COMMISSION EXPIRES: _____

CERTIFIED SURVEY MAP NO. _____**TREASURER'S CERTIFICATE:**

I HEREBY CERTIFY THAT THERE ARE NO UNPAID TAXES OR UNPAID SPECIAL ASSESSMENTS NOW DUE ON ANY OF THE LANDS INCLUDED IN THIS CERTIFIED SURVEY MAP.

COUNTY TREASURER_____
DATED_____
TOWN TREASURER_____
DATED**COUNTY PLANNING AND ZONING COMMITTEE APPROVAL:**

PURSUANT TO THE WINNEBAGO COUNTY SUBDIVISION ORDINANCE, ALL REQUIREMENTS FOR APPROVAL HAVE BEEN FULFILLED.

THIS CERTIFIED SURVEY MAP WAS APPROVED ON THIS _____ DAY OF

_____, 1993.

CHAIRPERSON, WINNEBAGO COUNTY PLANNING AND ZONING COMMITTEE**TOWN BOARD APPROVAL**

THIS CERTIFIED SURVEY MAP WAS APPROVED BY THE TOWN BOARD OF THE TOWN OF OMRO ON THIS _____ DAY OF _____, 19____.

CHAIRPERSON_____
CLERK
Robert F. Reider

4-30-93

ROBERT F. REIDER, RLS-1251 DATED
CAROW LAND SURVEYING CO., INC.
1837 W. WISCONSIN AVE. P.O. BOX 1297
APPLETON, WISCONSIN 54912-1297
A933.75

SHEET 3 OF 3 SHEETS

WINNEBAGO COUNTY CERTIFIED SURVEY MAP No. 3078

Part of the SE1/4 of the NW1/4 of Sec. 8, T.18N., R.15E., Town of Omro, Winnebago County, Wisconsin

ADDN. TO EXISTING PARCEL TAX No.

SURVEYOR'S CERTIFICATE:

I, Robert H. Saylor, Wisconsin Registered Land Surveyor, hereby certify:

That I have surveyed, combined and mapped the parcel of land located in part of the SE1/4 of the NW1/4 of Sec. 8, T.18N., R.15E., Town of Omro, Winnebago County, Wisconsin, described as follows: Beginning at a Berntsen Monument at the Center of said Sec. 8. From that point running S.89°41'21"E., 533.00 ft., thence N.01°09'50"E., 250.00 ft., thence N.89°41'21"E., 533.00 ft., thence S.01°09'50"W., 250.00 ft. to the said point of beginning. Being a parcel of land of 3.059 acres. Reserving therefrom that portion lying within the right of way of State Road "116" presently used for road purposes. Subject to all easements and restrictions of record.

That I have made such survey, land combination and map by the direction of Gordon Garvens, 635 Spruce Street, Omro, Wisconsin 54963; that such map is a true and correct representation of the exterior boundaries of the land surveyed.

That I have fully complied with the provisions of Sec. 236.34 of the Wisconsin Statutes and Winnebago County Subdivision Ordinance in surveying, combining and mapping the same.

WINNEBAGO COUNTY PLANNING COMMITTEE CERTIFICATE:

This Certified Survey Map of part of the SE1/4 of the NW1/4 of Sec. 8, T.18N., R.15E., Town of Omro, Winnebago County, Wisconsin is hereby approved.

Date Dec 20, 1994

Authorized Signature
Jeanette Diakoff


Robert H. Saylor
Robert H. Saylor S-1894
Wisconsin Registered Land Surveyor
October 19, 1994



LEGEND

- BERNTSEN MONUMENT
- EXISTING IRON PIPE
- () RECORDED AS

BEARINGS ARE REFERENCED TO THE
SOUTH LINE OF THE NW1/4 OF SEC. 8,
ASSUMED BEARING:
S.89°41'21"E.

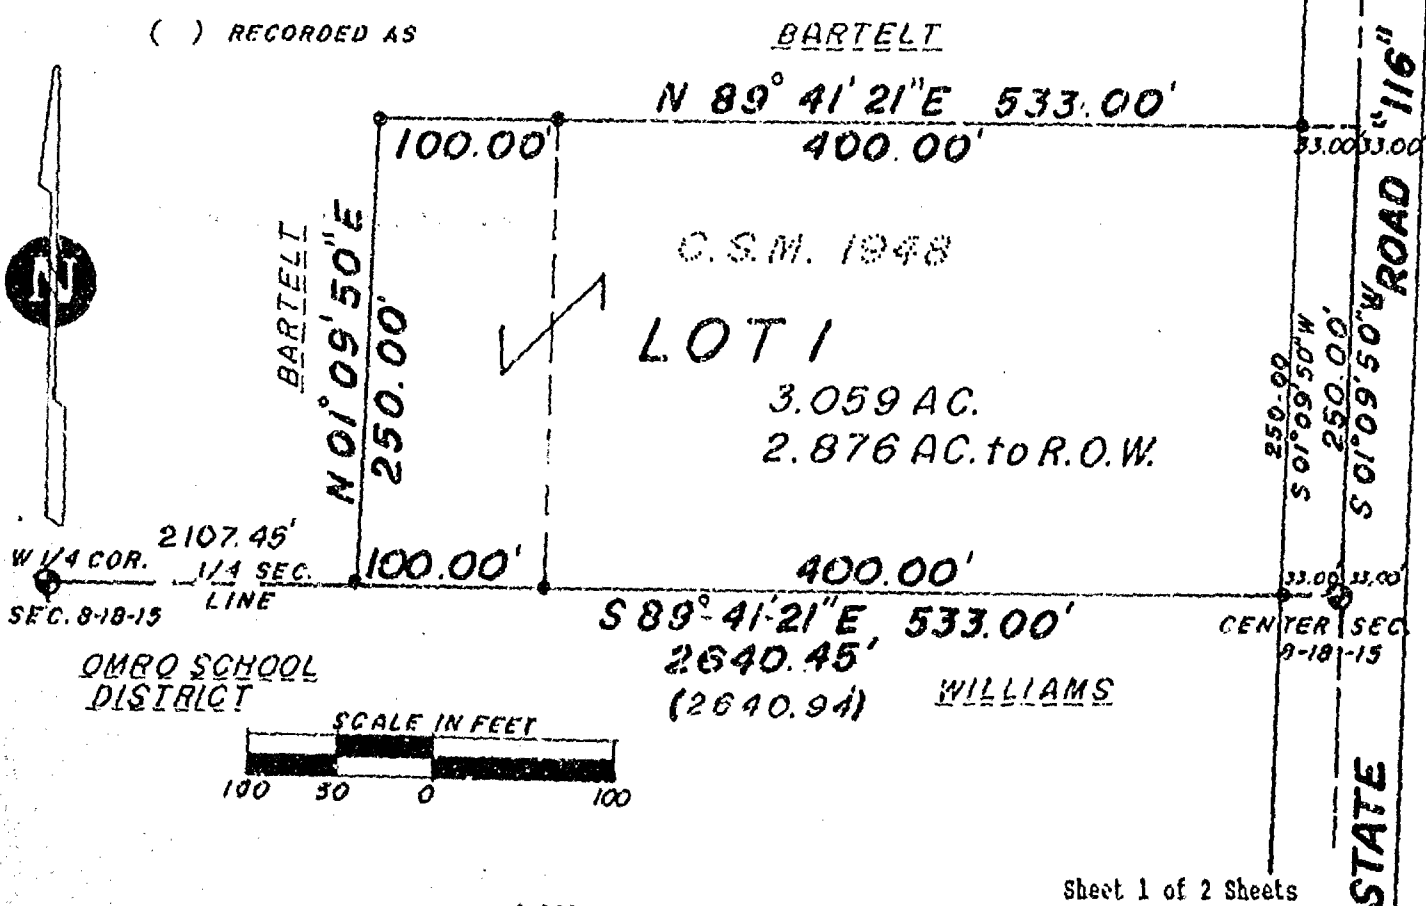

Sheet 1 of 2 Sheets

SAYLER SURVEY, INC

LAND SURVEYORS

WINNECONNE, WI

F.B.56P.59

Master

016 . 0234
0237
0241
0243

WINNEBAGO COUNTY CERTIFIED SURVEY MAP No. 3078

Part of the SE1/4 of the NW1/4 of Sec. 8, T.18N., R.15E., Town of Omro, Winnebago County, Wisconsin
TAX No.

CERTIFICATE OF COUNTY TREASURER:

STATE OF WISCONSIN)

WINNEBAGO COUNTY) SS

I, Mary E. Krueger-Deputy being the duly elected, qualified and acting Treasurer of the County of Winnebago, do hereby certify that the records in my office show no unredeemed tax sales and no unpaid taxes or special assessments as of December 16, 1994 affecting the lands included in this Certified Survey Map.

Date

12/16/94

Authorized Signature

Mary E. Krueger-Deputy

TOWN TREASURER CERTIFICATE:

STATE OF WISCONSIN)

WINNEBAGO COUNTY) SS

I, Sandra Remer, being the duly elected, qualified and acting Treasurer of the Town of Omro, do hereby certify that in accordance with the records in my office, there are no unpaid taxes or unpaid special assessments as of 12-15, 1994 on any of the land included in this Certified Survey Map.

12-15-94

Town Treasurer

Sandra K. Remer

OWNER'S CERTIFICATE:

As owner(s), I(we) hereby certify that I(we) caused the land described on this Certified Survey Map to be surveyed, combined and mapped as represented hereon.

Gordon Garvens

635 Spruce Street

Omro, Wisconsin 54963

4665 Hwy. "116"

Omro, WI. 54963

3014 Bradley Rd.

Omro, WI. 54963

Henry Bartelt

8201-40th St. N. Lot 52 Pinellas Park, Fla. 34665

Esther Bartelt

8201-40th St. N., Lot 52 Pinellas Park, Fla. 34665

STATE OF FLORIDA

COUNTY OF PINELLAS PARK SS

Personally came before me this 5TH day of DECEMBER, 1994, the above named persons to me known to be the persons who executed the foregoing instrument and acknowledged the same.

Notary Public, Fla.

My commission expires 3-22-98



GERALD M. CARUSO

COMMISSION # CC 358434

EXPIRES MAR 22, 1998

STATE OF WISCONSIN)

WINNEBAGO COUNTY) SS

Personally came before me this 11th day of November, 1994, the above named person(s) to me known to be the person(s) who executed the foregoing instrument and acknowledge the same.

Notary Public

Omro

WI



my commission expires 10-6-1996

Robert H. Saylor

S-1894

Wisconsin Registered Land Surveyor

October 19, 1994

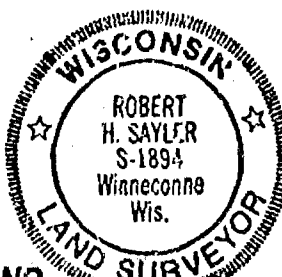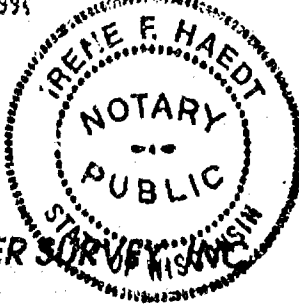

SAYLER SURVEYORS

LAND SURVEYORS

WINNECONNE, WI

Register's Office

Winnebago County, Wis.

Received for record this 22nd

day of Dec, A.D., 1994

at 10:00 o'clock AM and

filed in Vol. 1 of C.S.M

on page 3078

Marjorie Nakam

Register of Deeds

894519

F.B. Saylor P. Aug 12 00

AFFIDAVIT

Part OF THE SE1/4 OF THE NW1/4 OF SEC. 8, T.18N., R. 15E.,
TOWN OF OMRO, WINNEBAGO CO., WI.

ISSUED TO: GORDON GARVENS ET AL

FOR: CORRECTION TO C.S.M. NO. 3078

I, Robert H. Sayler, registered land surveyor, hereby
certify:

That on October 19, 1994, I surveyed, mapped and
recorded Certified Survey Map No. 3078 of Winnebago County
Records. In the fourth line of the Surveyor's Certificate it
reads---From that point running S.89 41'21"E., 533.00 ft.

It should read N.89 41'21"W., 533.00 ft.

The above change should also be noted on above Certified
Survey Map.

Robert H. Sayler
Robert H. Sayler S-1894
Wi. Registered Land Surveyor
February 28, 1995



This instrument was drafted by Robert H. Sayler

NOTARY PUBLIC:
STATE OF WISCONSIN)
WINNEBAGO COUNTY) SS

Personally came before me this 28th day of
February, 1995, the above named Robert H.
Sayler, to me known to be the person who executed the
foregoing instrument and acknowledged the same.

Irene F. Haedt
Notary Public, Omro WI.

My commission expires 10-6-1996



Register's Office
Winnebago County, Wis.
Received for record
this 1st Day of
March
A.D. 19 95 at
10:02 o'clock AM
Ann W. Wiegand
REGISTER OF DEEDS

C.S.M. 3078

898819

SAYLER SURVEY, INC
P.O. Box 252

LAND
SURVEYORS

WINNECONNE, WI
54986

F.B. P. 10

Part of the SE1/4 of the NW1/4 of Sec. 8, T.18N., R.15E., Town of Onro, Winnebago County, Wisconsin
ADDN. TO EXISTING PARCEL TAX NO.

I, Robert H. Sayler, Wisconsin Registered Land Surveyor, hereby certify:

That I have made such survey, land combination and map by the direction of Gordon Carvens, 635 Spruce Street, Onro, Wisconsin 54963; that such map is a true and correct representation of the exterior boundaries of the land surveyed.

WINNEBAGO COUNTY PLANNING COMMITTEE CERTIFICATE:

Robert H. Sayler
Robert H. Sayler S-1
Wisconsin Registered Land Surveyor
October 19, 1954

S-1894

Wisconsin Registered Land Surveyor
October 19, 1994

Authorized Signature

● BERTSEN MONUMENT
● EXISTING IRON PIPE
() RECORDED AS

BEARINGS ARE REFERENCED TO THE
SOUTH LINE OF THE NW1/4 OF SEC. 8,
ASSUMED BEARING:
S. 89° 41' 21" E.

AFFIDAVIT
DOC NO.
898819

BARTLET

N 89° 41' 21" E 533.00'
400.00'

C.S.M. 1948

LOT 1

3.059 AC.

2.876 AC. to R.O.W.

W 1/4 COR. 2107.45'
SEC. 8-18-15 1/4 SEC
LINE

OMRO SCHOOL
DISTRICT

9° 41' 21" E 533.00
2640.45
(2640.94) WILLIA

WILLIAMS

SCALE IN FEET

Sheet 1 of 2 Sheets

SAYLER SURVEY, INC

LAND SURVEYORS

WINNECONNE, WI

F.B.56P.59

Master

WINNEBAGO COUNTY CERTIFIED SURVEY MAP No.

Part of the SE1/4 of the NW1/4 of Sec. 9, T.18N., R.15E., Town of Omro, Winnebago County, Wisconsin
TAX No.

CERTIFICATE OF COUNTY TREASURER:

STATE OF WISCONSIN)
WINNEBAGO COUNTY) SS

I, _____ being the duly elected, qualified and acting Treasurer of the County of Winnebago, do hereby certify that the records in my office show no unredeemed tax sales and no unpaid taxes or special assessments as of _____, 19____ affecting the lands included in this Certified Survey Map.

Date

Authorized Signature

TOWN TREASURER CERTIFICATE:

STATE OF WISCONSIN)
WINNEBAGO COUNTY) SS

I, Sandra Renner, being the duly elected, qualified and acting Treasurer of the Town of Omro, do hereby certify that in accordance with the records in my office, there are no unpaid taxes or unpaid special assessments as of _____, 19____ on any of the land included in this Certified Survey Map.

Town Treasurer

OWNER'S CERTIFICATE:

As owner(s), I(we) hereby certify that I(we) caused the land described on this Certified Survey Map to be surveyed, combined and mapped as represented hereon.

Gordon J. Carvens

Gordon Carvens
635 Spruce Street
Omro, Wisconsin 54963

Donald M. Carvens

4665 Hwy. "116"
Omro, Wi. 54963

Gary Gurnert

3011/2 Bradley Rd.
Omro, Wi. 54963

Henry Bartelt

Henry Bartelt
8201-40th St. N. Lot 52 Pinellas Park, Fla. 34665

Esther Bartelt

Esther Bartelt
8201-40th St. N., Lot 52 Pinellas Park, Fla. 34665

STATE OF FLORIDA
COUNTY OF PINELLAS PARK SS
Personally came before me this 5TH day of DECEMBER, 1994, the above named persons to me known to be the persons who executed the foregoing instrument and acknowledged the same.

Gerald M. Caruso

Notary Public, Fla.
My commission expires 3-22-98

STATE OF WISCONSIN)
WINNEBAGO COUNTY) SS

Personally came before me this 11th day of November, 1994, the above named person(s) to me known to be the person(s) who executed the foregoing instrument and acknowledge the same.

James F. Haedt

Notary Public Omro WI

GERALD M. CARUSO
COMMISSION # CC 358434
EXPIRES MAR 22, 1998

my commission expires 10-6-1996

Robert H. Saylor

Robert H. Saylor S-1894
Wisconsin Registered Land Surveyor
October 19, 1974



SAYLER SURVEYING

LAND SURVEYORS

WINNECONNE, WI

F.B. P.

Doc # 894519

Register's Office

Winnebago County, Wis.

Received for record this 22nd

day of Dec A.D., 1994

at 10:00 o'clock A M. and

filed in Vol. 1 of CSM

on page 3078

Sheet 7 of 7 Sheets
Register of Deeds