


17-18-15

NO.	SURVEYED FOR	SURVEYOR	DATE	PLAT NO.	CERTIFIED MAP NO.	SURVEYS		SURVEY LOCATION
						VOL.	PAGE	
		Bishop	2-23-70			1	72	17 T18N RISE
28	Alaric	Hawksworth	6-13-77			1	63	17 T18N RISE
32	H. W. W.	Sayler	3-16-77			1	122	17 T18N RISE NE 1/4
40	Shannon	Hawksworth	12-19-77			1	211	17 T18N RISE NE 1/4
43	Schneider	Sayler	6-24-77			1	210	17 T18N RISE NE 1/4
44	McDonald	Hawksworth	9-23-77			1	211	17 T18N RISE NE 1/4
45	Alaric	Sayler	3-14-78		513522	1	322	17 T18N RISE
46	R. Carlson	Hawksworth	5-1-78					17 T18N RISE
	Scott Peck	Chomis	9-16-75					17 T18N RISE NW 1/4
	H. Mahaner	Sayler	5-21-75					17 T18N RISE SW 1/4
	G. Hellwig	Sayler	11-25-70					17 T18N RISE NE 1/4
	Fox River Camp	Dorohue						17 T18N RISE
	Hellwig Plat	Sayler						17 T18N RISE
		K. H. H.	8-31-79					17 T18N RISE NW 1/4
	D. Dier	Hawksworth	5-15-79					17 T18N RISE NW 1/4
		Rocking	6-7-79					17 T18N RISE NE 1/4
	Wagner & Wallace	Wagner	8-9-70					17 T18N RISE
	Richfield Invt.	Sayler	8-26-76					17 T18N RISE
	E. O. H. Realty	Carson						17 T18N RISE
	G. Hillwig &	Sayler	3-7-77					17 T18N RISE
	E. Peck	Hawksworth	6-5-79					17 T18N RISE
	City of Omro	Chomis	3-31-75					17 T18N RISE NE 1/4
	M. Dean	Starns	4-20-79					17 T18N RISE SE 1/4
	T. Dierksen	Sayler	8-9-74					17 T18N RISE NE 1/4
	E. Secker	Sayler	8-11-76					17 T18N RISE
	Humes Plat		7-23-1850					17 T18N RISE
	City of Omro	Sayler	3-20-70			1	53	17 18 15 NW 1/4

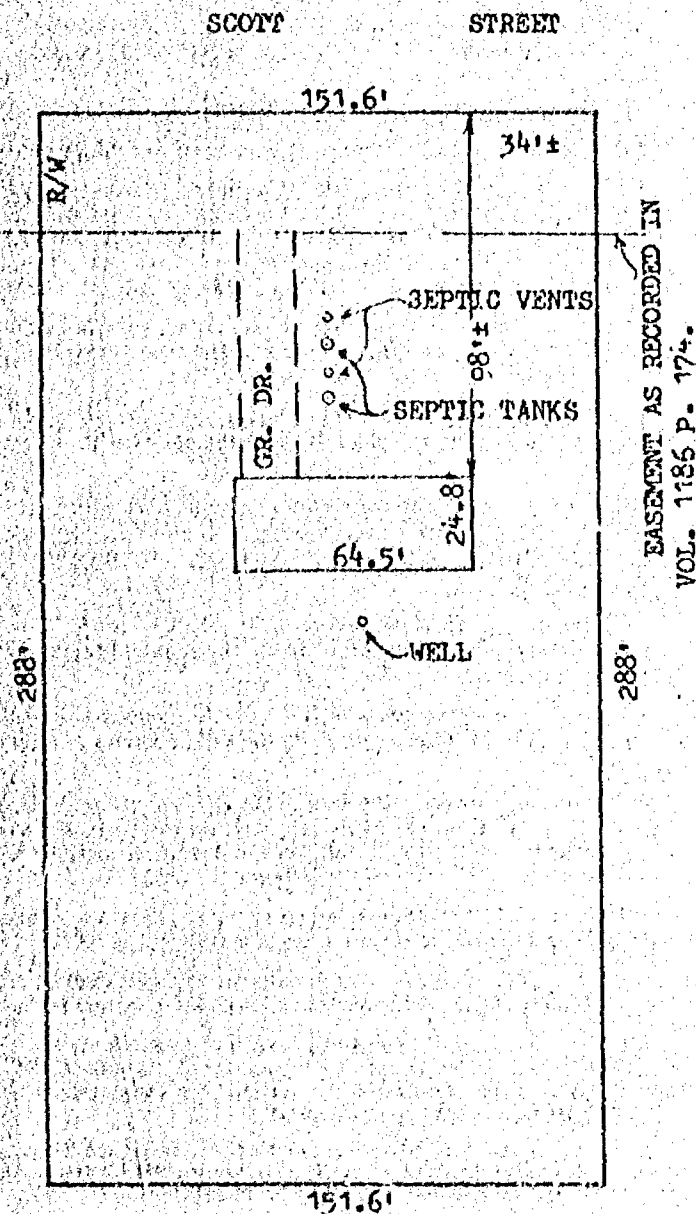


The West One Hundred Fifty-one and Six-tenths (151.6) feet of the East Four Hundred Fifty-five and Zero-tenths (455.0) feet of the North Two Hundred Eighty-eight and Zero-tenths (288.0) feet of the North East 1/4 of the SOUTH EAST 1/4 of Section Seventeen (17) Township Eighteen (18) North, of Range Fifteen (15) East, in the town of Omro, Winnebago County, Wisconsin.

JAMES A. & CHERYL A. BECK: SCOTT RD.

TRI-LEVEL HOUSE WITH ATTACHED GARAGE.

NO BUILDING ENCROACHMENTS PRESENT

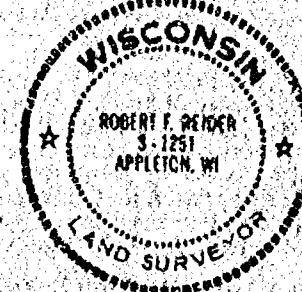

Robert F. Reider

I, ROBERT F. REIDER

certify that this mortgage inspection was made by me or under my direction and control of the described property on, OCTOBER 7, 1988, according to the official records and that this drawing is a true representation of the principal building lines thereon and is accurate to the best of my knowledge and belief. Oshkosh Savings & Loan in agreement with Carow Land Surveying Co., Inc. has waived parts of Administrative Code A-E S.01 (3 through 7). THIS IS NOT A BOUNDARY SURVEY NOR INTENDED TO BE. THIS MORTGAGE INSPECTION IS MADE FOR THE EXCLUSIVE USE OF: Oshkosh Savings & Loan.

REVISIONS	Oshkosh Savings & Loan P.O. Box 80, Oshkosh, Wis. 54902		
	CAROW LAND SURVEYING CO., INC. P.O. BOX 1297 1837 W. WISCONSIN AVE. • APPLETON, WI 54912		
DRAWN BY FR, AG APP'D	DV DATE 10-11-88	SCALE 1"=50'	DRAWING NO. 8810.19

Chapter A-E 5

MINIMUM STANDARDS FOR PROPERTY SURVEYS

A-E 5.01 Minimum standards for property surveys. A-E 5.02 U.S. public land survey monument record.

A-E 5.01 Minimum standards for property surveys. (1) Scope. The minimum standards of this section apply to every property survey performed in this state except that,

(a) Where other standards for property surveys are prescribed by statute, administrative rule or ordinance, then such standards shall govern; and

(b) The land surveyor and his or her client or employer may agree in a signed statement to exclude any land surveying work from the requirements of this section except the preparation of a U.S. Public Land Survey Monument Record, providing any map prepared by the land surveyor for the client or employer includes a note which states that an agreement to exclude work from the requirements of this section has been made, the names of the parties making the agreement and a description in plain language of the requirements not complied with.

(2) PROPERTY SURVEY, DEFINITION. In this section, "property survey" means any land surveying which includes as one of its principal purposes describing, monumenting, locating the boundary lines of or mapping one or more parcels of land. The term includes the restoration, perpetuation or reestablishment of a U.S. public survey corner.

(3) BOUNDARY LOCATION. Every property survey should be made in accordance with the records of the register of deeds as nearly as is practicable. The surveyor shall acquire data necessary to retrace record title boundaries such as deeds, maps, certificates of title, and center line and other boundary line locations. The surveyor shall analyze the data and make a careful determination of the position of the boundaries of the parcel being surveyed. The surveyor shall make a field survey, traversing and connecting monuments necessary for location of the parcel and coordinate the facts of such survey with the analysis. The surveyor shall set monuments marking the corners of such parcel unless monuments already exist at such corners.

(4) DESCRIPTIONS. Descriptions defining land boundaries written for conveyance or other purposes shall be complete, providing definite and unequivocal identification of lines or boundaries. The description must contain necessary ties to adjoining together with data of dimensions sufficient to enable the description to be mapped and retraced and shall describe the land surveyed by government lot, recorded private claim, quarter-quarter section, section, township, range and county, and by metes and bounds commencing with some corner marked and established by the U.S. public land survey; or if such land is located in a recorded subdivision or recorded addition thereto, then by the number or other description of the lot, block or subdivision thereof which has been previously tied to a corner marked and established by the U.S. public land survey.

Register, August, 1902, No. 320

Note: Items not underlined have been waived.

WISCONSIN ADMINISTRATIVE CODE

A-E 6

(5) Maps. A map shall be drawn for every property survey showing information developed by the survey and including the following elements:

(a) The map shall be drawn to a convenient scale;

(b) The map shall be referenced as provided in s. 57.61, Stats.;

(c) The map shall show the exact length and bearing of the boundaries of the parcels surveyed. Where the boundary lines show bearings, lengths or locations which vary from those recorded in deeds, abutting plats, or other instruments there shall be the following note placed along such lines, "recorded as (show recorded bearing, length or location)";

(d) The map shall show and describe all monuments necessary for the location of the parcel and shall indicate whether such monuments were found or placed;

(e) The map shall identify the person for whom the survey was made, the date of the survey, and shall describe the parcel as provided in (4), above;

(f) The map shall bear the stamp or seal and signature of the land surveyor under whose direction and control the survey was made with a statement certifying that the survey is correct to the best of his knowledge and belief.

(6) MEASUREMENTS. (a) Measurements shall be made with instruments and methods capable of attaining the required accuracy for the particular problem involved.

(b) The minimum accuracy of linear measurements between points shall be 1 part in 3,000 on all property lines of boundary or interior survey.

(c) In a closed traverse the sum of the measured angles shall agree with the theoretical sum by a difference not greater than 30 seconds per angle, or the sum of the total angles shall not differ from the theoretical sum by more than 120 seconds, whichever is smaller.

(d) Any closed traverse depicted on a property survey map shall have a latitude and departure closure ratio of less than 1 in 3,000.

(e) Bearings or angles on any property survey map shall be shown to the nearest minute; distances shall be shown to the nearest 1/100th foot.

(7) MONUMENTS. The type and position of monuments to be set on any survey shall be determined by the nature of the survey, the permanency required, the nature of the terrain, the cadastral features involved, and the availability of material.

History: C. Register, June, 1914, No. 223, eff. 7-1-14; am. (5) (c) and (8) (c), Register, June, 1925, No. 234, eff. 7-1-25; am. (1) (b), Register, January, 1902, No. 313, eff. 2-1-02; am. (1) (b) and (c) and rec. (2), Register, August, 1902, No. 320, eff. 9-1-02.

A-E 5.02 U.S. public land survey monument record. (1) With monument record required. A U.S. public land survey monument record shall be prepared as part of any land survey which includes or requires the perpetuation, restoration or reestablishment of a U.S. public land survey corner, and, either,

Register, August, 1902, No. 320

Plat of Survey

PART OF THE SW 1/4 OF THE SE 1/4 OF SEC. 17, T.18N, R.15E,
IN THE TOWN OF OMRO, WINNEBAGO COUNTY, WISCONSIN



OWNER: ROBERT H. BRAHMER
3870 BRADLEY RD.
OMRO, WI 54963

NOTE: Parcel is subject to Winnebago County Subdivision
Ordinance and Town of Omro Zoning Ordinance.

AREA: 2.366 AC.

DESCRIPTION:

Part of the SW 1/4 of the SE 1/4 of Sec. 17, T.18N., R.15E., in
the Town of Omro, Winnebago County, Wisconsin, described as
follows: Beginning at the NE corner of Lot 1 of Certified
Survey Map No. 1592, Winnebago County Records. From that
point running N.89°33'16"E. 1030.72 ft., thence S.00°00'39"E.
100.00 ft., thence S.89°33'16"W. 1030.72 ft., thence
N.00°00'39"E. 100.00 ft. to the said point of beginning.
Being a parcel of land of 2.366 acres more or less.
Subject to all easements and restrictions of record.

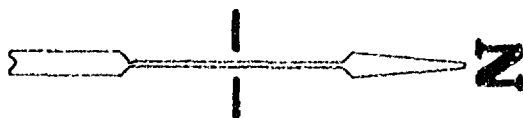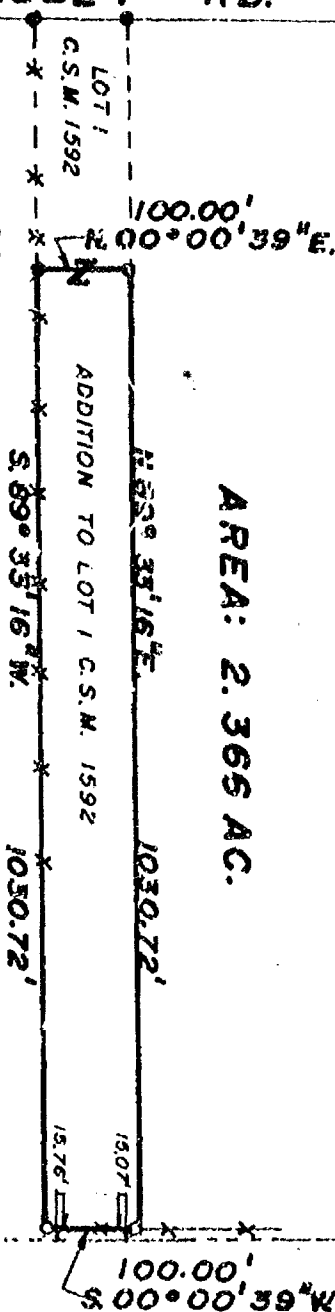

LEGEND

- = Existing monuments
- = 2" x 30' iron pipe set
- = 1" x 30' iron pipe set
- = reference caps or R.R. spikes
- ⊙ = Bernisen or Harrison monuments
- X--Y = fence
- () = recorded as
- = stone monument



SURVEYORS CERTIFICATE

I, hereby certify that I have surveyed the property
as shown, according to official records and that the plat
above drawn is an accurate and correct representation of
said survey. SEPT 9, 1988

Robert H. Saylor
Wisconsin Registered Land Surveyor S-1894

Saylor
Survey, Inc.

119A WEST MAIN, BOX 232, WINNECONNE, WI 54988

SCALE 1" = 200'
PROJECT NO. S-001892
FIELD BOOK 49 PAGE 134

Plat of Survey

PART OF THE E1/2 OF THE SW1/4 OF SEC. 17, T.18N., R.15E.,
IN THE TOWN OF OMRO, WINNEBAGO COUNTY, WISCONSIN

CLIENT: GERALD FREES
834 TOWER LANE
OMRO, WI 54963

DESCRIPTION:

Located in part of the E1/2 of the SW1/4 of Sec. 17,
T.18N., R.15E., in the Town of Omro, Winnebago County, WI,
described as follows: Beginning at the S1/4 corner of
said Sec. 17. From that point running S.89°43'36"W.
1334.36 ft., thence N.00°04'51"W. 1439.78 ft., thence
S.89°59'21"E. 1336.65 ft., thence S.00°00'39"W. 1433.16
ft. to the said point of beginning. Being a parcel of
land of 44.04 acres more or less. Subject to all
easements and restrictions of record.

44.04 AC.

42.96 AC. TO R.O.W.



1439.78' (40' LINE)
N.00°04'51"W.

SEC. LINE

S.89°43'36"W.

1301.36'

1334.36'

S1/4 COR.
SEC. 17-18-15

6.6

1/4 SEC. LINE

ROAD

S.00°00'39"W.

BRADLEY

LEGEND

- = Existing monuments
- = 2" x 30" iron pipe set
- ◊ = 1" x 30" iron pipe set
- ⊙ = reference caps or R.R. spikes
- ⊗ = Bernsen or Harrison monuments
- X-X = fence
- () = recorded as
- = stone monument



SURVEYORS CERTIFICATE

I, hereby certify that I have surveyed the property
as shown, according to official records and that the plat
above drawn is an accurate and correct representation of
said survey. NOVEMBER 2, 1987

Calvin W. Hawksworth
Wisconsin Registered Land Surveyor S-1290

Sayler
Survey, inc.

139A WEST MAIN, BOX 262, WINNECONNE, WI 54986

SCALE 1" = 200'

PROJECT NO. S-001858

FIELD BOOK 55 PAGE 27


Plat of Survey

PART OF THE NE 1/4 OF THE SW 1/4 OF SEC. 17, T.18N., R.15E., IN THE TOWN OF OMRO, WINNEBAGO CO., WI.

DESCRIPTION:

Part of the NE 1/4 of the SW 1/4 of Sec. 17, T.18N. R.15E., Town of Omro, Winnebago County, Wisconsin, described as follows: Beginning at a point on the East line of the SW 1/4 of said Sec. 17 that is 1220.21 ft., S.00°00'39"W. of the Northeast corner of the SW 1/4 of said Sec. 17. From that point running N.89°59'21"W., 557.40 ft., thence N.05°25'49"E., 443.23 ft., thence S.89°59'21"E., 515.54 ft. to the East line of the SW 1/4 of Sec. 17, thence S.00°00'39"W. along said East line 441.25 ft. to the said point of beginning. Being a parcel of land of 5.43 acres, more or less. Subject to all restrictions and easements of record.

1/4 Sec. Line
N.E. COR.
SW 1/4 OF
SEC. 17-18-15

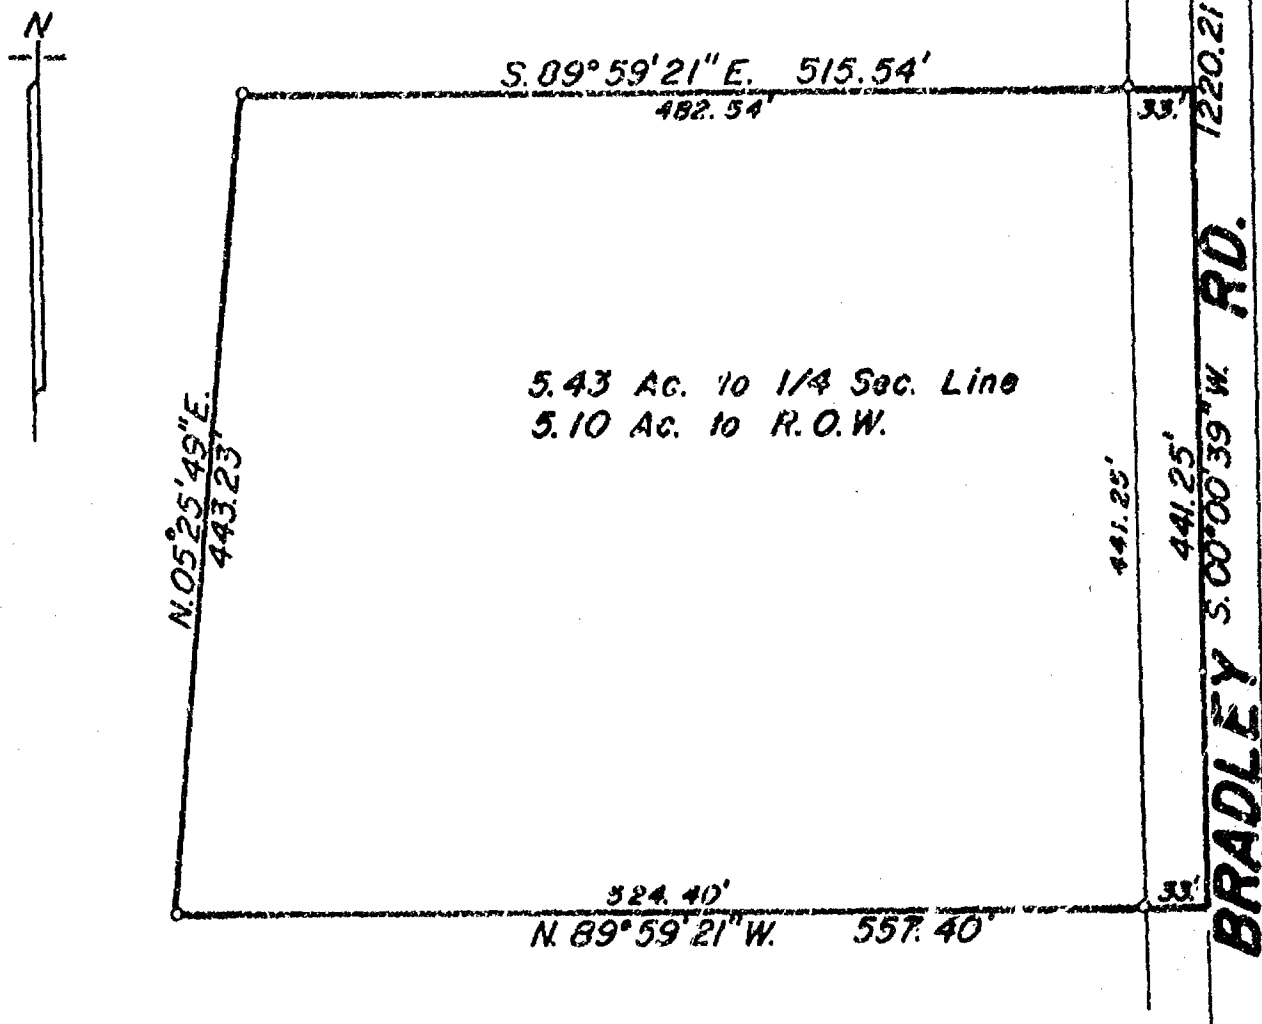

5.43 Ac. 1/4 Sec. Line
5.10 Ac. 1/4 R.O.W.

CLIENT: ROBERT H. & MARY M. BRAIMER
3870 BRADLEY RD.
OMRO, WI. 54963

LEGEND

- = Existing monuments
- = 2" x 30" iron pipe set
- = 1" x 30" iron pipe set
- ⊙ = reference caps or R.R. spikes
- ⊕ = Bernsten or Harrison monuments
- X-X = fence
- () = recorded as
- = stone monument



SURVEYOR'S CERTIFICATE

I, hereby certify that I have surveyed the property as shown, according to official records and that the plat above drawn is an accurate and correct representation of said survey. OCTOBER 9, 1987

Calvin W. Hawksworth

Wisconsin Registered Land Surveyor S-1290

Sayler
Survey, Inc.

138A WEST MAIN, BOX 252, WINNECONNE, WI 54988

SCALE 1 in. = 100 ft.
PROJECT NO. S-001849
FIELD BOOK 53 PAGE 25

661825

Register's Office
Winnebago County, Wis.
Received for record this *12th*
day of *Sept*... A.D., 19*86*
at *1:38* o'clock *P*. M. and
recorded in Vol. *1*.. of *C.S.M*
on page *159.2*
Ernestine Dahms
Register of Deeds

Seyler

dy
6

Stock No. 26273


WINNEBAGO COUNTY CERTIFIED SURVEY MAP NO. 1592
 Part of the SW $\frac{1}{4}$ of the SE $\frac{1}{4}$ of Sec. 17, T.18N., R.15E., in the Town of
 Omro, Winnebago County, Wisconsin

WINNEBAGO COUNTY PLANNING COMMITTEE CERTIFICATE

This Certified Survey Map of part of the SW $\frac{1}{4}$ of the SE $\frac{1}{4}$ of Sec. 17,
 T.18N., R.15E., in the Town of Omro, is hereby approved.

September 12, 1986
 Date

Carol Owens
 Authorized signature

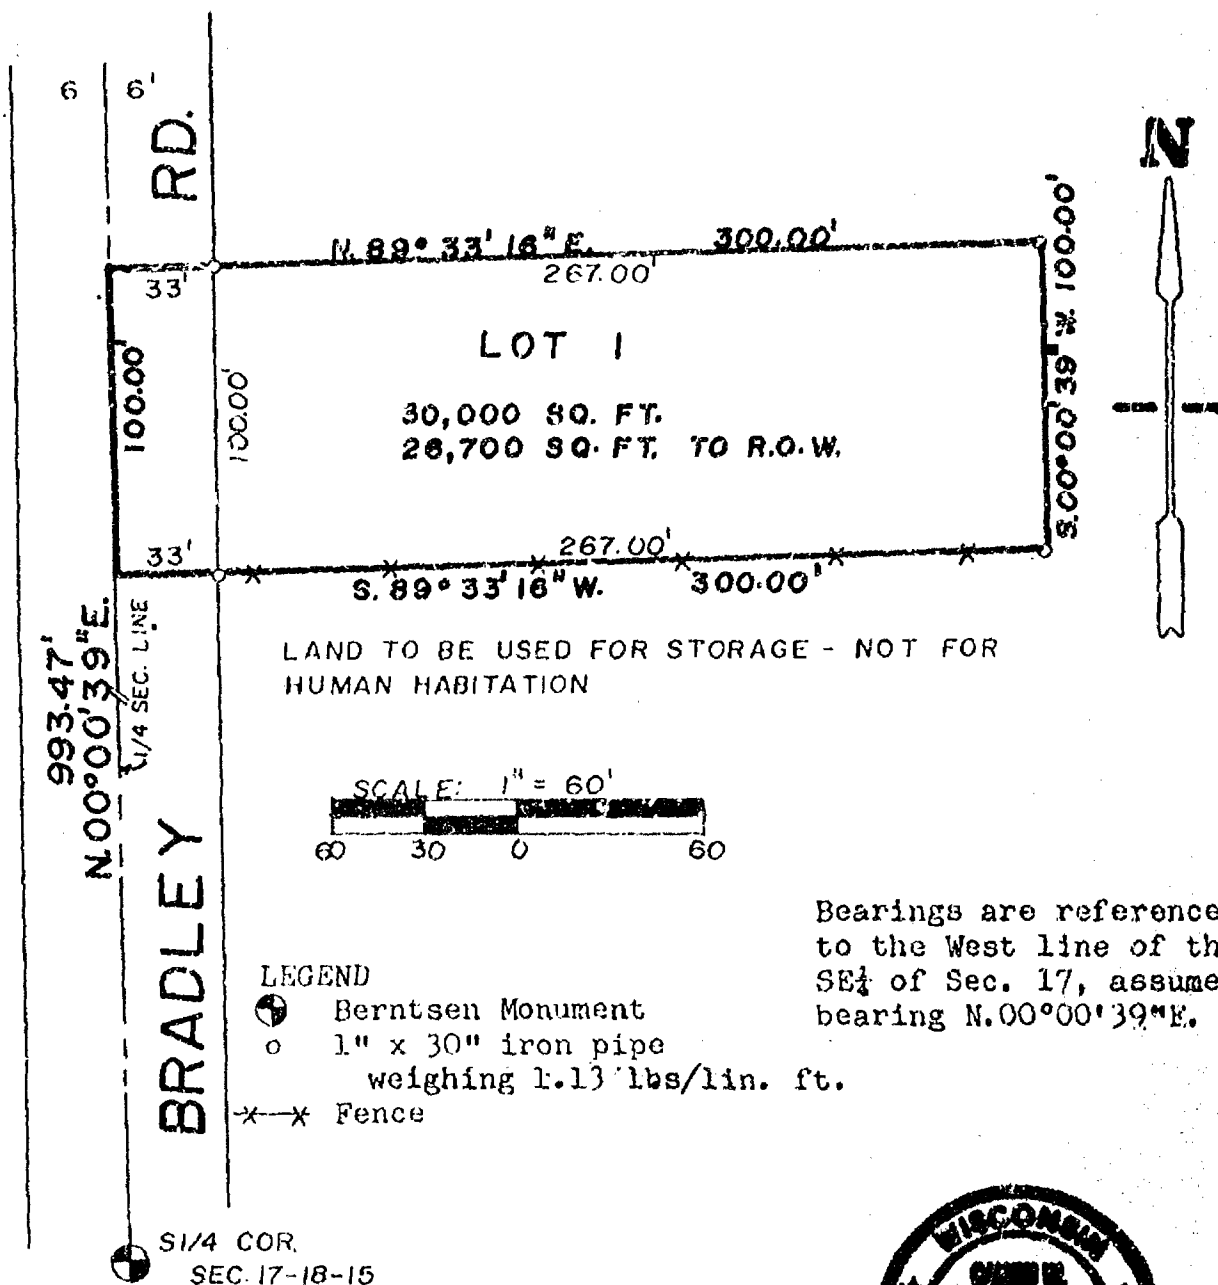

Bearings are referenced
 to the West line of the
 SE $\frac{1}{4}$ of Sec. 17, assumed
 bearing N. 00° 00' 39" E.

LEGEND

- ⊙ Berntsen Monument
- 1" x 30" iron pipe
weighing 1.13 lbs/lin. ft.
- x-x- Fence



Calvin W. Hawksworth
 Calvin W. Hawksworth 5-1290
 Wisconsin Registered Land Surveyor
 September 5, 1986

Sheet 1 of 2 sheets

FB 49 PG. 134

SAYLER SURVEY, INC. LAND SURVEYORS WINNECONNE, WI

Stock No. 26273

WINNEBAGO COUNTY CERTIFIED SURVEY MAP NO. 1592Part of the SW $\frac{1}{4}$ of the SE $\frac{1}{4}$ of Sec. 17, T.18N., R.15E., in the Town of Omro, Winnebago County, WisconsinSURVEYOR'S CERTIFICATE

I, Calvin W. Hawksworth, registered land surveyor, hereby certify:

That I have surveyed, divided and mapped the parcel of land located in part of the SW $\frac{1}{4}$ of the SE $\frac{1}{4}$ of Sec. 17, T.18N., R.15E., in the Town of Omro, Winnebago County, Wisconsin described as follows: Beginning at a point that is 993.47 ft. N.00°00'39"E. of the S $\frac{1}{4}$ corner of said Sec. 17. From that point running N.00°00'39"E. 100.00 ft., thence N.89°33'16"E. 300.00 ft., thence S.00°00'39"W. 100.00 ft., thence S.89°33'16"W. 300.00 ft. to the said point of beginning. Being a parcel of land of 30,000.00 sq. ft. more or less. Land to be used for storage and not for human habitation. Subject to all easements and restrictions of record.

That I have made such survey, land division and map by the direction of Robert F. Brahmer, 3870 Bradley Rd., Omro, WI 54963; that such map is a true and correct representation of the exterior boundaries of the land surveyed.

That I have fully complied with the provisions of Sec. 236.34 of the Wisconsin Statutes and the Winnebago County Subdivision Ordinance in surveying, dividing and mapping the same.



Calvin W. Hawksworth
Calvin W. Hawksworth S-1290
Wisconsin Registered Land Surveyor
September 5, 1986

OWNER'S CERTIFICATE

As owner(s), I (we) hereby certify that I (we) caused the land described on this certified survey map to be surveyed, divided and mapped as represented hereon.

WITNESS the hand and seal of said owner(s) this 8th day of September, 1986.

In presence of:

James F. Heert
Witness

Robert W. Brahmer
Owner
3870 Bradley Rd.
Omro, WI 54963

STATE OF WISCONSIN)
WINNEBAGO COUNTY)SS

Personally came before me this 8th day of September, 1986, the above named owner(s) to me know to be the person(s) who executed the foregoing instrument and acknowledged the same.

Dorothy L. Proehl
Notary Public, Winnebago, WI

My commission expires June 24, 1992.

DOROTHY L. PROEHL
NOTARY PUBLIC
STATE OF WISCONSIN

Zoning

FORM NO. 985-A


WISCONSIN

Stock No. 26273

WINNEBAGO COUNTY CERTIFIED SURVEY MAP NO. 1272
Located in part of the NE $\frac{1}{4}$ of Section 17, T.18N., R.15E., City
of Omro, Winnebago County, Wisconsin.

A DIVISION OF LOT 1 OF C.S.M. NO. 1072, DOC. NO. 583021

Calvin W. Hawksworth
Calvin W. Hawksworth S-1290
Wisconsin Registered Land Surveyor
June 26, 1984.

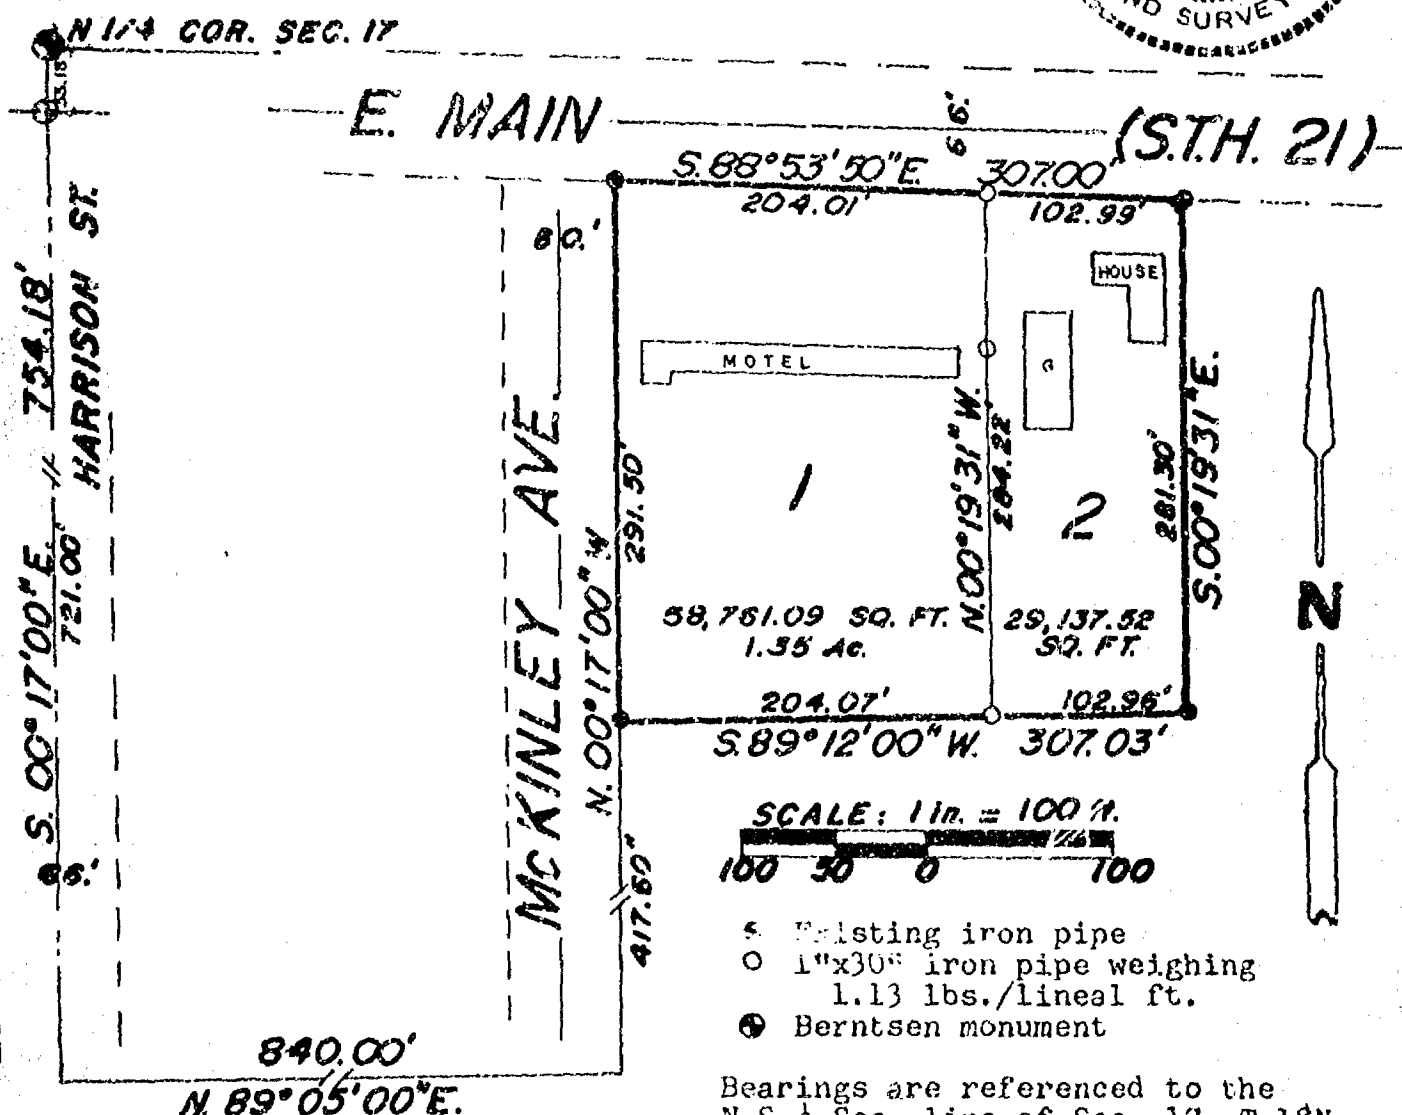

OMRO CITY PLANNING COMMITTEE CERTIFICATE

This Certified survey map of part of the Northeast $\frac{1}{4}$ of Sec. 17, T.18N., R.15E., City of Omro, is hereby approved.

July 2, 1984
Date approved

Harold Lind
Authorized Representative

Sheet 1 of 2 sheets

SAYLER SURVEY, INC.

LAND
SURVEYORS

P.S. 43 P.9-31
WINNECONNE, WI.

WINNEBAGO COUNTY CERTIFIED SURVEY MAP NO. 1272.
Located in part of the NE $\frac{1}{4}$ of Section 17, T.18N., R.15E., City
of Omro, Winnebago County, Wisconsin.

Calvin W. Hawksworth
Calvin W. Hawksworth S-1290
Wisconsin Registered Land Surveyor
June 26, 1984

Sheet 2 Of 2 sheets

614000

Register's Office
Winnebago County, Wis.
Received for record this 3rd
day of July A.D., 1954
at 1:40 o'clock P M. and
recorded in Vol. 1 of C.S.M.
on page 1272
Marjorie A. Johnson
Register of Deeds

Payler

80
6.00

Zoning

CERTIFIED SURVEY MAP NO. 1024

PART OF THE EAST 1/2 OF THE NORTHEAST 1/4 OF THE NORTHEAST 1/4 OF SECTION 17, TOWN 18 NORTH, RANGE 15 EAST, CITY OF CRO, WINNEBAGO COUNTY, WISCONSIN

For: City of Omro
Omro, Wisconsin




TANG. = N 30°24'55"E
I = 300°00'00"
RAD. = 60.00'
CH = N 0°24'55"E
CH DIST = 60.00'
ARC = 314.16'
TANG. = S 29°35'05"E

NORTH REFERENCE:
NORTH IS REFERENCED TO
THE EAST LINE OF THE
NORTHEAST 1/4 WHICH IS
RECORDED AS


N 0°-24'-55" E

UNPLATTED LANDS

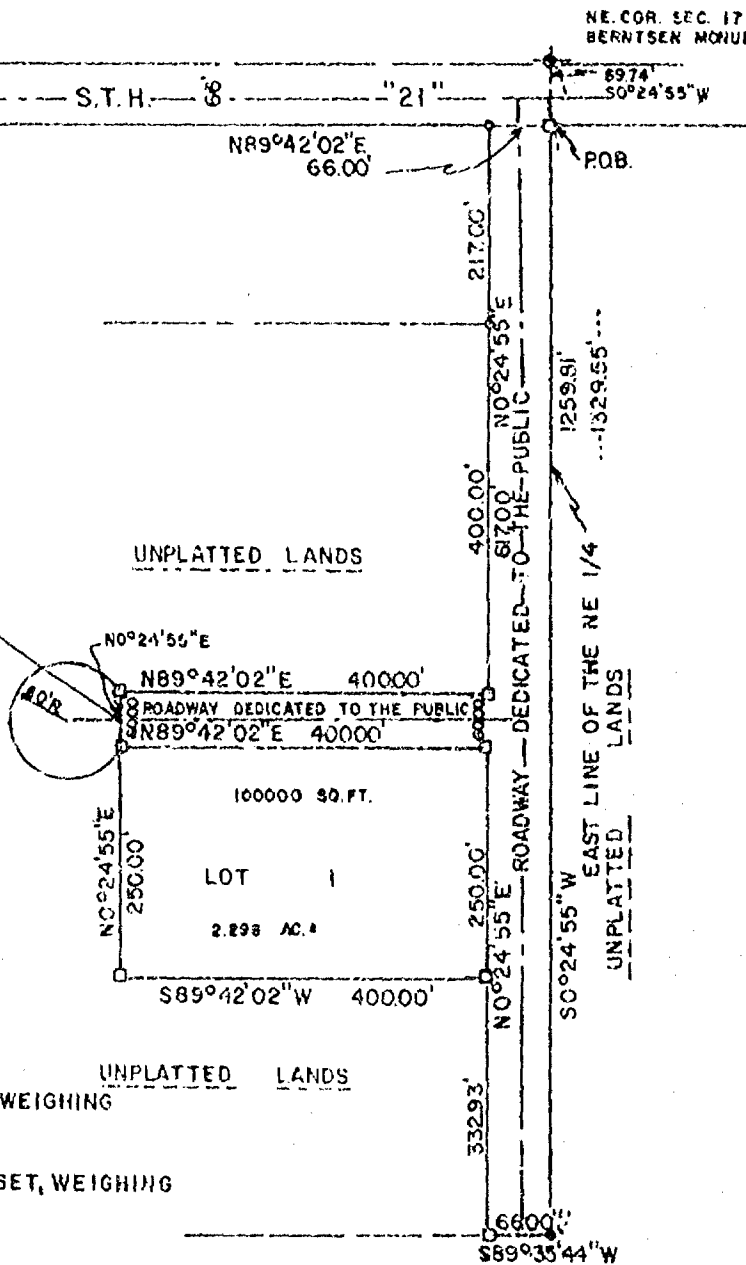

LEGEND

- 3/4" x 24" STEEL REBAR SET, WEIGHING 1.502 LBS PER FOOT
- 1-1/4" x 30" STEEL REBAR SET, WEIGHING 4.303 LBS PER FOOT
- EXIST 3/4" STEEL REBAR
- EXIST 1-1/4" STEEL REBAR

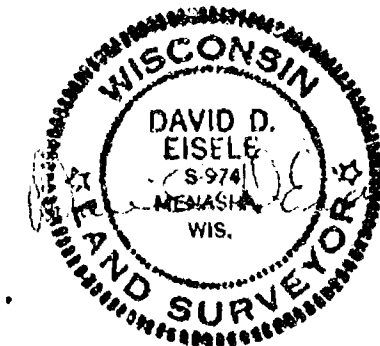

Prepared By:
Martenson & Eisele, Inc.
1919 American Court
Neenah, Wisconsin
Phone 414 731-0381

MAY 20, 1980

CERTIFIED SURVEY MAP NO. 1024

SURVEYOR'S CERTIFICATE:

I, David D. Eisele, Land Surveyor, do hereby certify that I have surveyed, divided and mapped for the City of Omro, Part of the East 1/2 of the Northeast 1/4 of the Northeast 1/4 of Section 17, Town 18 North, Range 15 East, City of Omro, Winnebago County, Wisconsin, more fully described as follows:

Commencing at the Northeast corner of Section 17; thence S 0°-24'-55" W along the East line of the Northeast 1/4 69.74 feet to the point of beginning; thence continuing S 0°-24'-55" W along said East line, 1259.81 feet; thence S 89°-35'-44" W, 66.00 feet; thence N 0°-24'-55" E, 332.93 feet; thence S 89°-42'-02" W, 400.00 feet; thence N 0°-24'-55" E, 250.00 feet; thence along the arc of a curve to the right 314.16 feet, said curve having a radius of 60.00 feet and a chord dist. of 50.00 feet, which bears N 0°-24'-55" E; thence N 89°-42'-02" E, 400.00 feet; thence N 0°-24'-55" E, 617.00 feet to a point on the South line of S.T.H. "21"; thence N 89°-42'-02" E along said South line 66.00 feet to the point of beginning. Property is subject to all easements and restrictions of record. And that I have fully complied with Chapter 236.34 of the Wisconsin Statutes in surveying, dividing, and mapping the same, and with the City of Omro Subdivision ordinances.

Given under my hand this 10 day of May, 1982.

David D. Eisele
David D. Eisele, Reg. Land Surveyor S-974

CERTIFICATE OF OWNERS

As owners we, the undersigned, hereby certify that we caused the land above described to be surveyed, divided, dedicate and mapped all as shown on this map.

Date: June 3rd day of June, 1982

David Chase
Mayor, City of Omro

James Schell
Clerk, City of Omro

State of Wisconsin)
Winnebago County) S3

Personally came before me on the 15 day of June, 1982, the above named owners to me known to be the persons who executed the foregoing instrument and acknowledge the same.

John A. Vonderheide
Notary Public-Winnebago County, WI


My Commission Expires 10/28/84

APPROVALS

Approved by the City Council of the City of Omro, Winnebago County, Wisconsin, this 3rd day of June, 1982

David Chase
Mayor

James Schell
City Clerk

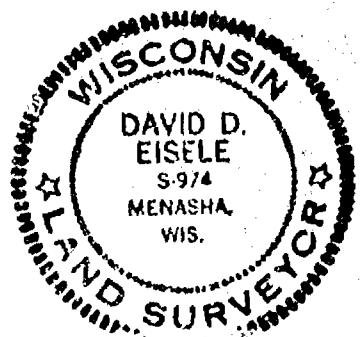

CERTIFIED SURVEY MAP NO. 1024

Approved by the City of Onro Planning Commission this 16 day of June, 1982.

Ernest Chase
Planning Commission Chairman

TREASURER'S CERTIFICATE

I hereby certify that there are no unpaid taxes or unpaid special assessments on any of the lands shown hereon.

James Skel
City Treasurer


Rich W. Bradley
County Treasurer

6-3-82
Date

6/16/82
Date

576775

Register's Office
Winnebago County, Wis. to
Received for record this 16
day of June A.D. 1982
at 9:30 o'clock A M. and
recorded in Vol. 1024 of Survey
page 1024.
Margaret Dahme
Register of Deeds

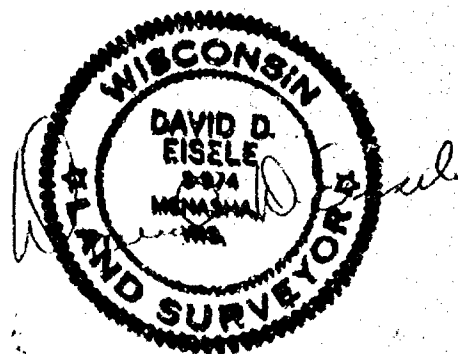

May 20, 1980

City of Onro



Chg
800

Plat of Survey

PART OF OUTLOT 12 AND PART OF OUTLOT 15 OF OUTLOTS SOUTH
OF THE FOX RIVER IN THE CITY OF OMRO, SECTION 17, T.18N.,
R.15E., WINNEBAGO COUNTY, WISCONSIN

CLIENT:

Raymond Fraleigh
232 East Larrabee
Omro, WI 54963

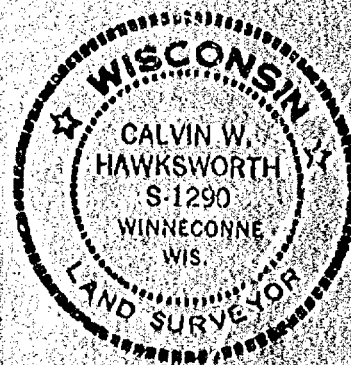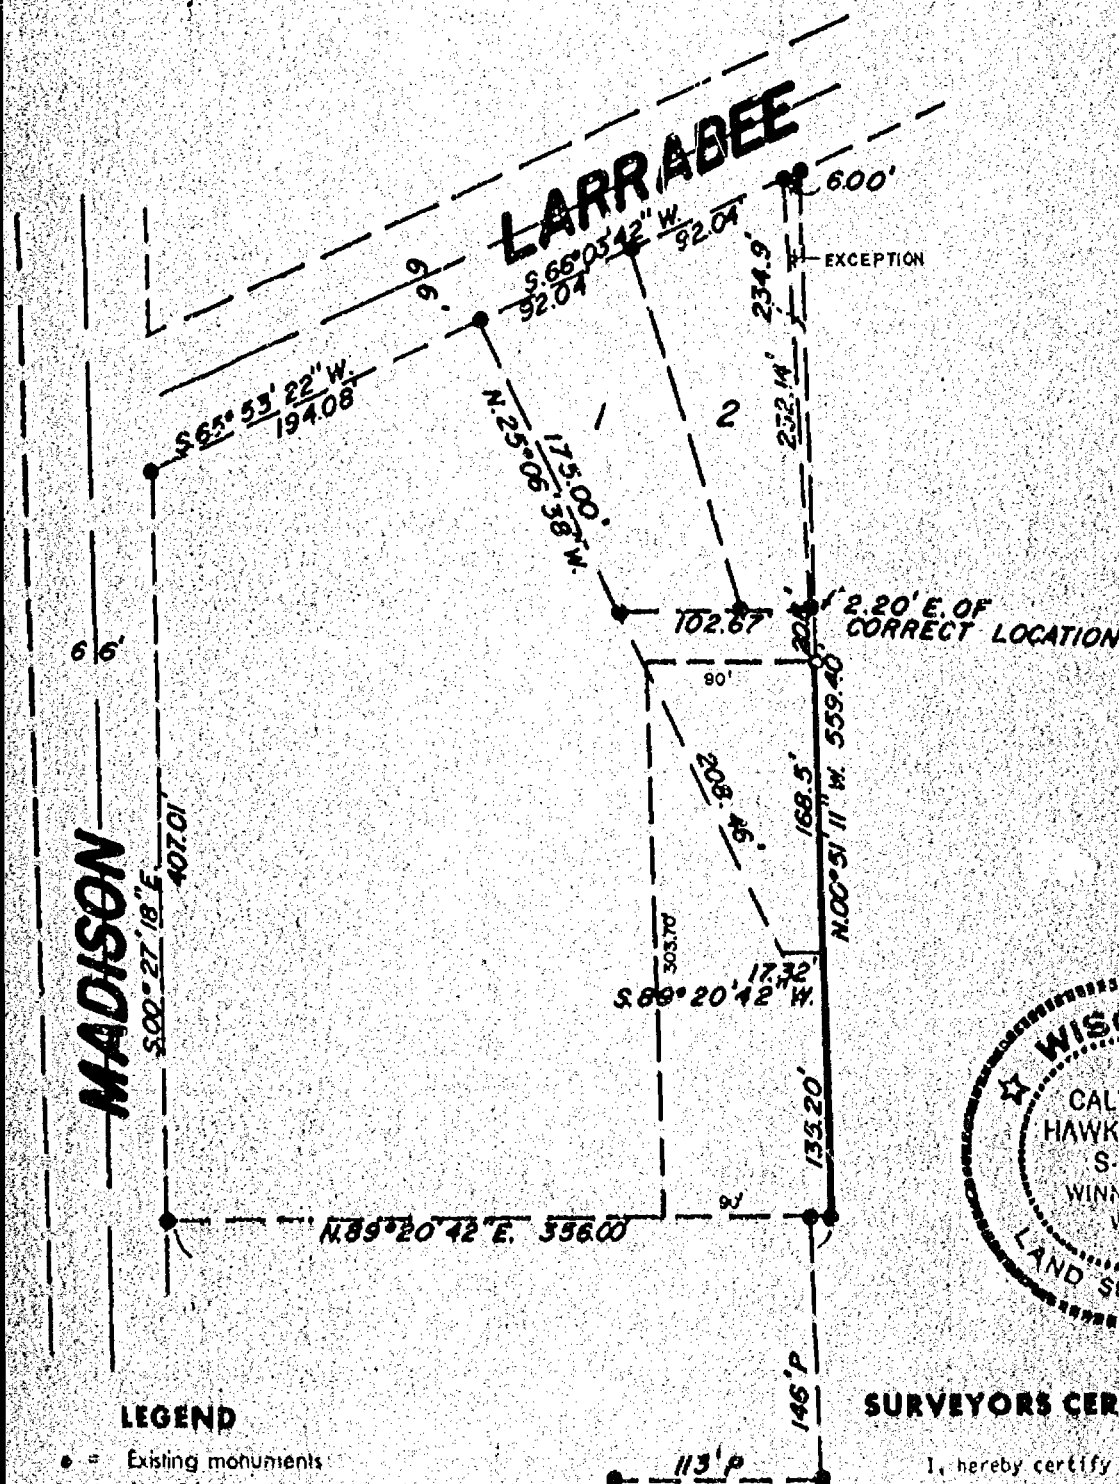

SURVEYORS CERTIFICATE

I, hereby certify that I have surveyed the property
as shown, according to official records and that the plat
above drawn is an accurate and correct representation of
said survey. JUNE 22, 1982

Calvin W. Hawksworth
Wisconsin Registered Land Surveyor S-1290

LEGEND

- = Existing monuments
- = 2" x 30" iron pipe set
- = 1" x 30" iron pipe set
- = reference caps or RR spikes
- ⊙ = Bernsten or Harrison monuments
- X-X = fence
- () = recorded as
- = stone monument


SAYLER SURVEY, INC.
LAND SURVEYORS
WINNECONNE, WI 54986

SCALE 1 in. = 100 ft.
PROJECT NO. S-001295
FIELD BOOK 45 PAGE 5

Stock No. 26273

WINNEBAGO COUNTY CERTIFIED SURVEY MAP NO.
Located in part of the Northeast 1/4 of Section 17, T.18N., R.15E.,
City of Omro, Winnebago County, Wisconsin

Calvin W. Hawksworth
Calvin W. Hawksworth S-1290
Wisconsin Registered Land Surveyor
July 19, 1982

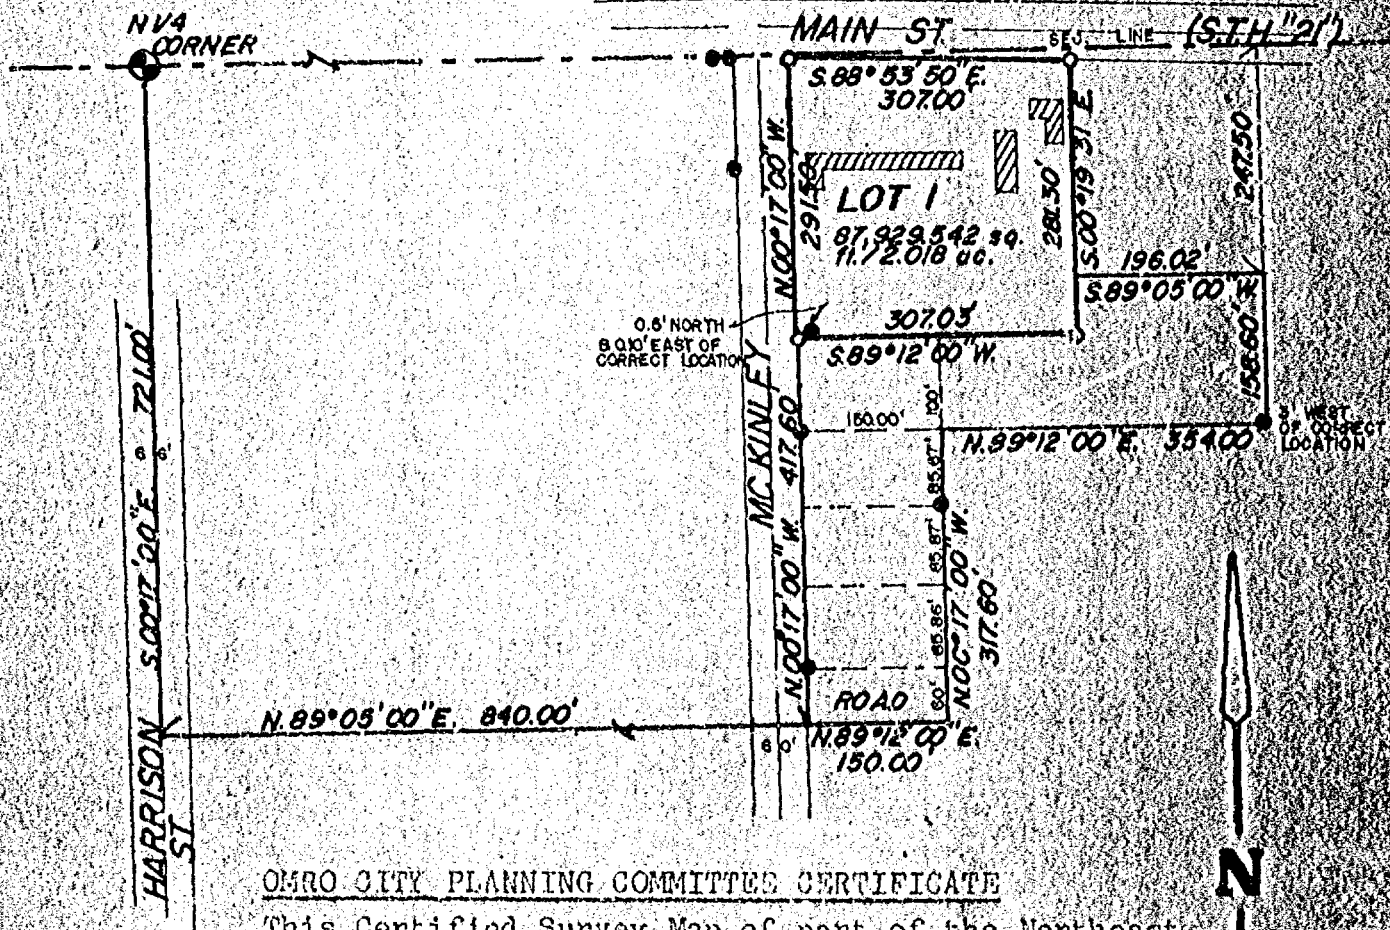

OMRO CITY PLANNING COMMITTEE CERTIFICATE

This Certified Survey Map of part of the Northeast 1/4 of Section 17, T.18N., R.15E., City of Omro, is hereby approved.

Date Approved _____

Authorized Representative _____

SCALE: 1" = 200'

LEGEND

- EXISTING IRON PIPE
- 1" x 30" IRON PIPE SET WEIGHING 1.13 LBS./LIN. FT.
- ⊙ BERNYSEN MONUMENT

BEARINGS ARE REFERENCED TO THE
NORTH-SOUTH 1/4 LINE OF SEC. 17,
T.18N., R.15E., ASSUMED BEARING
S.00°17'00" E.

Stock No. 26273

WINNEBAGO COUNTY CERTIFIED SURVEY MAP NO.

Located in part of the Northeast $\frac{1}{4}$ of Section 17, T.18N., R.15E.,
City of Omro, Winnebago County, Wisconsin

SURVEYOR'S CERTIFICATE

I, Calvin W. Hawksworth, registered land surveyor, hereby
certify:

That I have surveyed and mapped the parcel of land located
in part of the Northeast $\frac{1}{4}$ of Section 17, T.18N., R.15E., City
of Omro, Winnebago County, Wisconsin, described as follows:
Beginning at an iron pipe that is 721.00 ft. S.00°17'00"E.;
840.00 ft. N.89°05'00"E. and 417.60 ft. N.00°17'00"W. of the
North $\frac{1}{4}$ corner of said Section 17. From that point running
N.00°17'00"W. 221.50 ft.; thence S.88°53'50"E. 307.00 ft.;
thence S.00°19'31"E. 281.30 ft.; thence S.89°12'00"W. 307.03
ft. to the point of beginning. Being a parcel of land of
2.018 acres, more or less.

That I have made such survey and map by the direction of
Mr. and Mrs. Gerald Hellywig, 1014 East Main Street, Omro, WI
54963; that such map is a true and correct representation of
the exterior boundaries of the land surveyed.

That I have fully complied with the provisions of Sec.
236.34 of the Wisconsin Statutes and the Winnebago County
Subdivision Ordinance in surveying and mapping the same.



Calvin W. Hawksworth
Calvin W. Hawksworth S-1290
Wisconsin Registered Land Surveyor
July 19, 1982

OWNER'S CERTIFICATE

As owner(s), I (we) hereby certify that I (we) caused the
land described on this Certified Survey Map to be surveyed and
mapped as represented hereon.

WITNESS the hand and seal of said owner(s) this 20 day
of July, 1982.

In presence of:

Witness

Owner(s)

Address

City

State

Zip

STATE OF WISCONSIN } SS
WINNEBAGO COUNTY }


Personally came before me this 20th day of July,
1982 the aboved named to be the person(s) who executed the fore-
going instrument and acknowledged the same.

Notary Public

My commission expires 9-8-85

WINNEBAGO COUNTY CERTIFIED SURVEY MAP NO. 220

Part of the NW $\frac{1}{4}$ of the NE $\frac{1}{4}$ of Sec. 17, T.18N., R.15E., City of Omro.

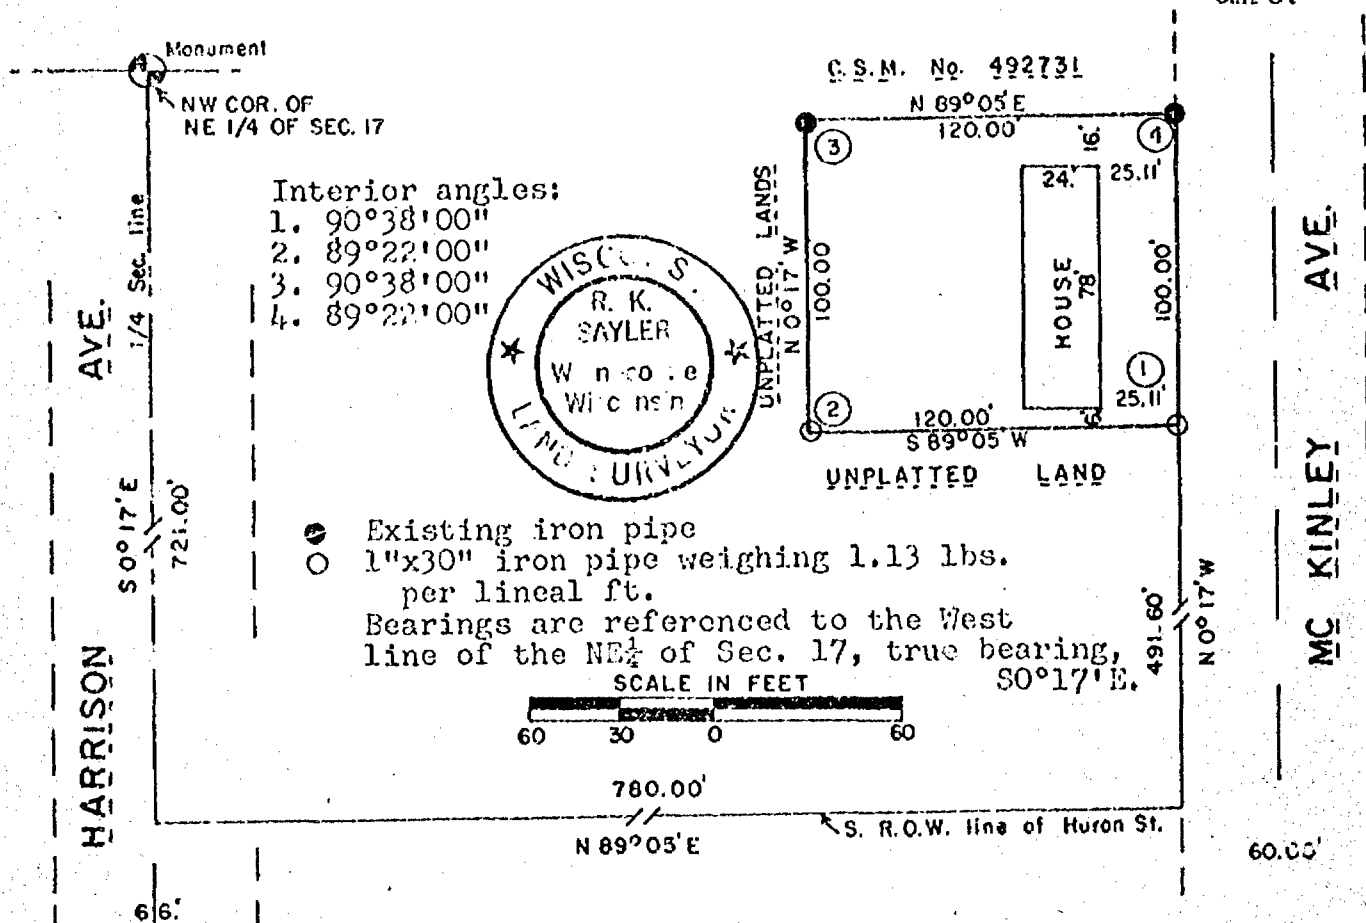

I, R. K. Saylor, Wisconsin registered land surveyor, (3-417) hereby certify:

That I have surveyed and mapped the parcel of land located in the NW $\frac{1}{4}$ of the NE $\frac{1}{4}$ of Sec. 17, T.18N., R.15E. in the City of Omro, Winnebago County, Wisconsin, described as follows: Beginning at an iron pipe on the Westerly R.O.W. line of Mc Kinley Ave. that is 721.00 ft., S0°17'E and 780.00 ft., N89°05'E and 491.60 ft., N0°17'W of the NW corner of the NE $\frac{1}{4}$ of said Sec. 17. From that point running S89°05'W, 120.00 ft., thence N0°17'W, 100.00 ft., thence N89°05'E, 120.00 ft. to the Westerly R.O.W. line of Mc Kinley Avenue, thence S0°17'E along said R.O.W. line, 100.00 ft. to the said point of beginning. Being a parcel of land of 12,000.00 sq. ft. in area, more or less.

That said map is a true representation of the exterior boundaries of the land surveyed; that I have fully complied with the provisions of Sec. 236.34 of the Wisconsin Statutes in surveying and mapping the same.

I further certify that I have inspected and approved the monument at the North $\frac{1}{4}$ corner of Sec. 17, T.18N., R.15E. in its proper location as shown on this map.

R. K. Saylor
Surveyor
June 24, 1977

Note: Map redrawn September 6, 1977 to eliminate City Planning Commission Certificate which is not applicable at this time.

OWNER'S CERTIFICATE


As owner(s), I(we) hereby certify that I(we) caused the land described on this map to be surveyed and mapped as represented hereon.

Mary Ann Schneider
Owner(s)
July 30, 1977
Date

WINNEBAGO COUNTY CERTIFIED SURVEY MAP NO. 271.

Part of the NW $\frac{1}{4}$ of the NE $\frac{1}{4}$ of Sec. 17, T.18N., R.15E., City of Onro.

EXISTING LOT

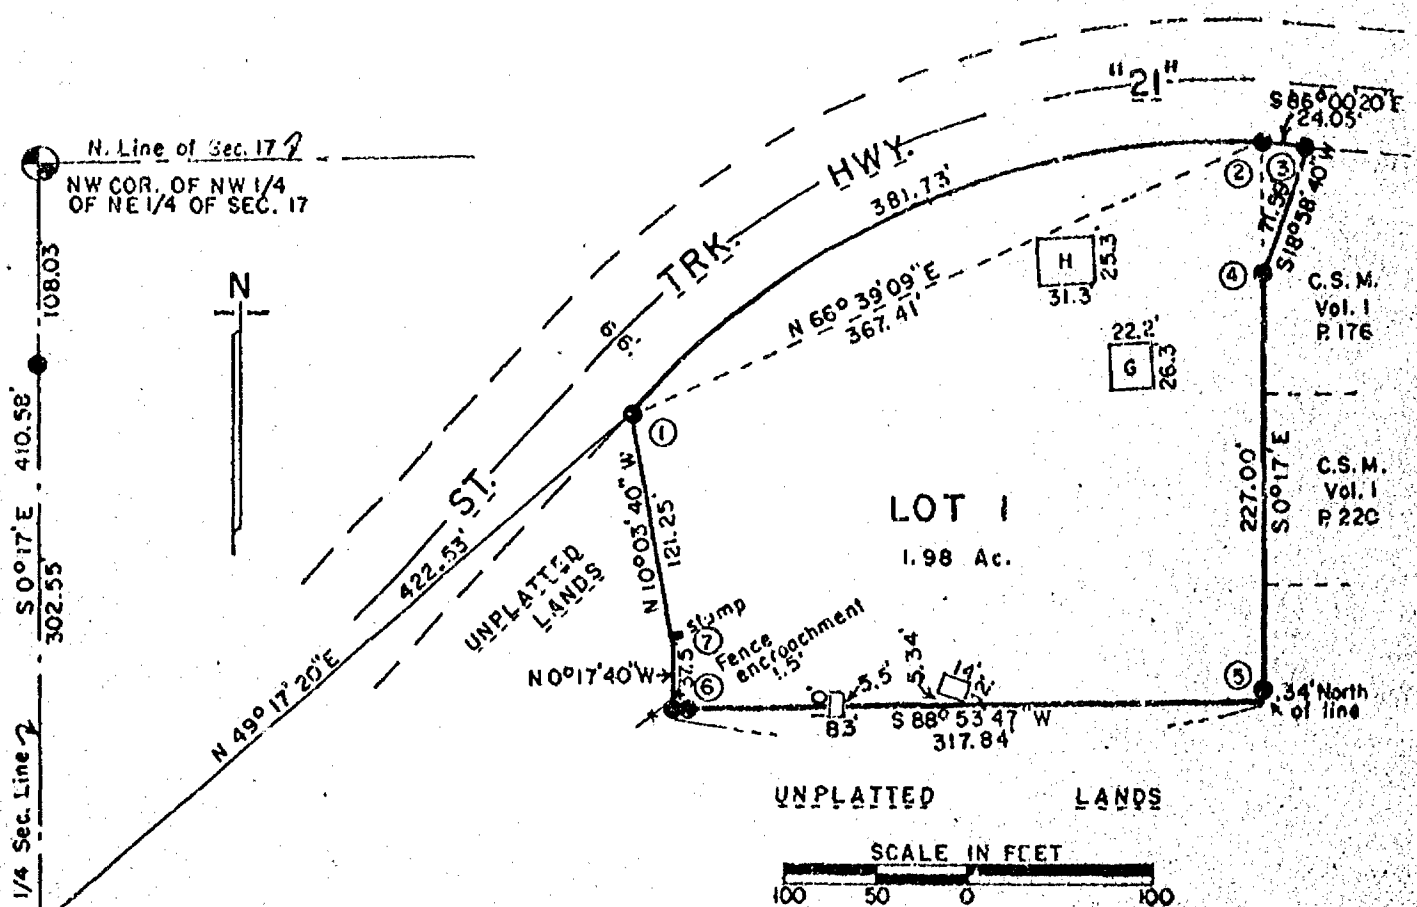

Interior angles


1. 103°17'11"
2. 152°39'29"
3. 75°01'00"
4. 199°15'40"
5. 90°49'13"
6. 89°11'27"
7. 189°46'00"
- 900°00'00"

- ⊕ Perntsen monument
 - Existing fence
 - Existing iron pipe
- Bearings are referenced to the West line of the NE $\frac{1}{4}$ of Sec. 17, true bearing, 50°17'E.

Calvin W. Hawksworth
 Calvin W. Hawksworth S-1290
 Wisconsin Registered Land Surveyor
 December 19, 1977.

CURVE DATA

- R. = 400.08'
- C. = 367.41'
- Δ = 54°40'02"

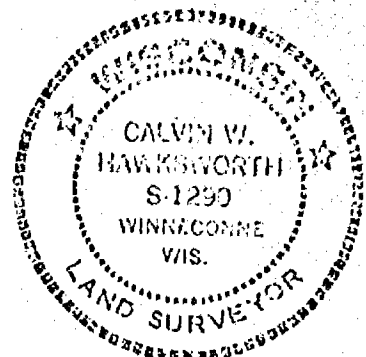

Sheet 1 of 2 sheets

WINNEBAGO COUNTY CERTIFIED SURVEY MAP NO. 271.

Part of the NW $\frac{1}{4}$ of the NE $\frac{1}{4}$ of Sec. 17, T.18N., R.15E., City of Omro.

I, Calvin W. Hawksworth, registered land surveyor, hereby certify:

That I have surveyed and mapped the parcel of land located in part of the NW $\frac{1}{4}$ of the NE $\frac{1}{4}$ of Sec. 17, T.18N., R.15E. in the City of Omro, Winnebago County, Wisconsin, described as follows: Beginning at an iron pipe on the Southerly R.O.W. line of St. Trk. Hwy. "21" that is 410.58 ft., S0°17'E and 422.53 ft., N49°17'20"E of the NW corner of the NW $\frac{1}{4}$ of the NE $\frac{1}{4}$ of said Sec. 17. From that point running 381.73 ft., along the arc of a curve whose chord bears N66°39'09"E, 367.41 ft., thence S86°00'20"E, 24.05 ft., thence S18°58'40"W, 71.59 ft., thence S0°17'E, 227.00 ft., thence S88°53'47"W, 317.84 ft., thence N0°17'40"W, 37.50 ft., thence N10°03'40"W, 121.25 ft. to the said point of beginning. Being a parcel of land of 1.98 acres, more or less. Subject to all easements and restrictions of record.

That I have made such survey and map by the direction of W.J. Sharrow, 11209 SE 64th, Renton, Washington, 98055; that such map is a true and correct representation of the exterior boundaries of the land surveyed.

That I have fully complied with the provisions of Sec. 236.34 of the Wisconsin Statutes in surveying and mapping the same.



Calvin W. Hawksworth
Calvin W. Hawksworth S-1290
Wisconsin Registered Land Surveyor
December 19, 1977.

OWNER'S CERTIFICATE OF DEDICATION

As owner(s) I(we) hereby certify that I(we) caused the land described on this Certified Survey Map to be surveyed, mapped and dedicated as represented hereon.

WITNESS the hand and seal of said owner(s) this 9th day of January, 1978.

In presence of:

Uta Kayish

W. J. Sharrow
Owner(s)
11209 SE 64th
Address
Renton, Washington
City-State

STATE OF ^{Washington} WISCONSIN) SS
WINNEBAGO COUNTY)

King Personally came before me this 9th day of January, 1978, the above named W. J. Sharrow to me known to be the person(s) who executed the foregoing instrument and acknowledged the same.

Boysen
Notary Public, ^{Wisc.} wa.

My commission expires 10-16-78.


William Meyer

Zoning

17 18-15

WINNEBAGO COUNTY CERTIFIED SURVEY MAP NO. 635

Lot 1 and the North $\frac{1}{2}$ of Lots 2 and 4 of Block L of EASTERN ADDITION to the City of Omro.

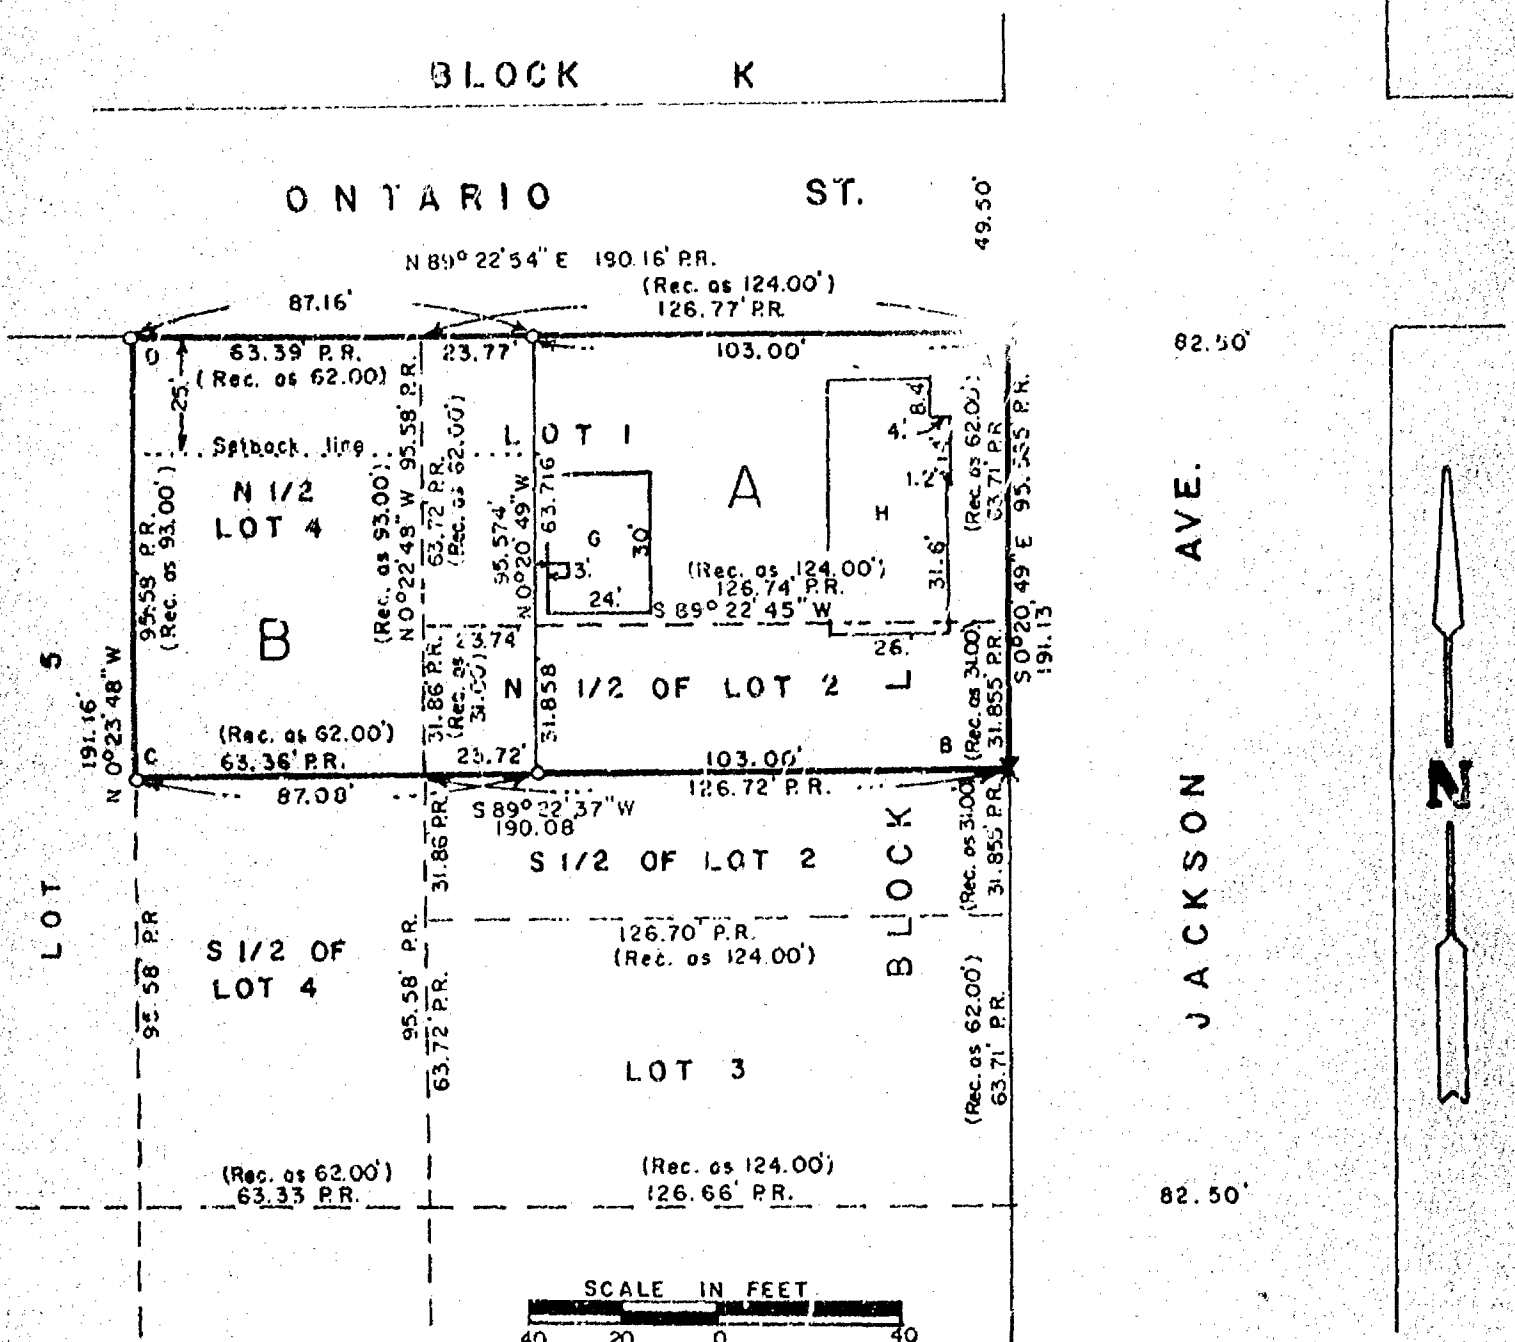

Area of A = 9,843.474 sq. ft.
Area of B = 8,326.457 sq. ft.

Interior angles

- A. 89°43'43"
- B. 90°16'34"
- C. 89°46'25"
- D. 90°13'18"
- 360°00'00"

X Cross cut in concrete
o 1"x30" iron pipe weighing 1.13 lbs./lineal ft.

PR Pro rated dimensions

Bearings are referenced to the N-S $\frac{1}{4}$ line of Sec. 17, T.18N., R.15E., true bearing, S0°17'E.



Calvin W. Hawksworth
Calvin W. Hawksworth S-1290
Wisconsin Registered Land Surveyor
June 13, 1979

Sheet 1 of 2 sheets

WINNEBAGO COUNTY CERTIFIED SURVEY MAP NO. 635Lot 1 and the North $\frac{1}{2}$ of Lots 2 and 4 of Block L of EASTERN ADDITION to the City of Omro.

I, Calvin W. Hawksworth, registered land surveyor, hereby certify:

That I have surveyed, divided and mapped the parcels of land located in Block L of EASTERN ADDITION to the City of Omro, Winnebago County, Wisconsin, described as follows:

LOT A


The East 103.00 ft. of Lot 1 and the East 103.00 ft. of the North $\frac{1}{2}$ of Lot 2 of Block L of EASTERN ADDITION to the City of Omro, Winnebago County, Wisconsin.

LOT B

Lot 1, the North $\frac{1}{2}$ of Lot 2 and the North $\frac{1}{2}$ of Lot 4 of EASTERN ADDITION to the City of Omro, Winnebago County, Wisconsin, excepting therefrom the East 103.00 ft. of Lot 1 and the East 103.00 ft. of the North $\frac{1}{2}$ of Lot 2.

That I have made such survey, land division and map by the direction of Dale Davis, 305 Jackson Ave., Omro, Wisconsin; 54963; that such map is a true and correct representation of the exterior boundaries of the land surveyed.

That I have fully complied with the provisions of Sec. 236.34 of the Wisconsin Statutes and Ordinance No. 222 of the City of Omro in surveying and mapping the same.

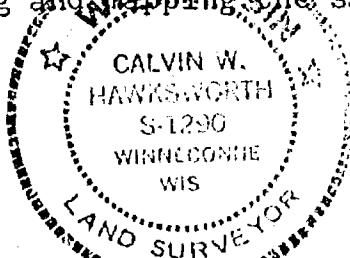

Calvin W. Hawksworth
Calvin W. Hawksworth S-1290
Wisconsin Registered Land Surveyor
June 13, 1979.

OWNER'S CERTIFICATE

As owner(s) I (we) hereby certify that I (we) caused the land described on this Certified Survey Map to be surveyed, divided and mapped as represented hereon.

WITNESS the hand and seal of said owner(s) this 23 day of July, 1979.

In presence of:

Dale A. Davis
Witness

Dale A. Davis
Owner(s)
305 Jackson Ave.
Address
Omro, WI 54963
City-State Zip

STATE OF WISCONSIN) SS
WINNEBAGO COUNTY)

Personally came before me this 23 day of July, 1979, 1979, the above named Dale A. and Phyllis M. Davis to be the person(s) who executed the foregoing instrument and acknowledged the same.

Donna L. Smith
Notary Public,

My commission expires 10-4-81.

CITY OF OMRO PLAN COMMISSION CERTIFICATE

This Certified Survey Map of Lot 1 and the North $\frac{1}{2}$ of Lots 2 and 4 of Block L of EASTERN ADDITION, City of Omro, is hereby approved.

8-6-79
Date

Calvin W. Hawksworth
Authorized representative

53849M

Register's Office
Winnebago County, Wis. *d*
Received for record this *15*
day of *Aug*, A.D. 19*79*
at *7:06* o'clock *A.M.* and
recorded in Vol. *1* Survey *Maps*
on page *635*

Lorraine C. Preyer,
Dep. Register of Deeds


Wallace

Chg.
2⁰⁰

WINNEBAGO COUNTY CERTIFIED SURVEY MAP NO. 307

Part of Outlot 12 of OUTLOTS SOUTH OF THE FOX RIVER in the City of Omro, Sec. 17, T.18N., R.15E.

- Existing iron pipe found
 - 1"x30" iron pipe weighing 1.13 lbs. per lineal ft.
- Bearings are referenced to the N-S $\frac{1}{4}$ line of Sec. 17, T.18N., R.15E., true bearing, $50^{\circ}17'E$.

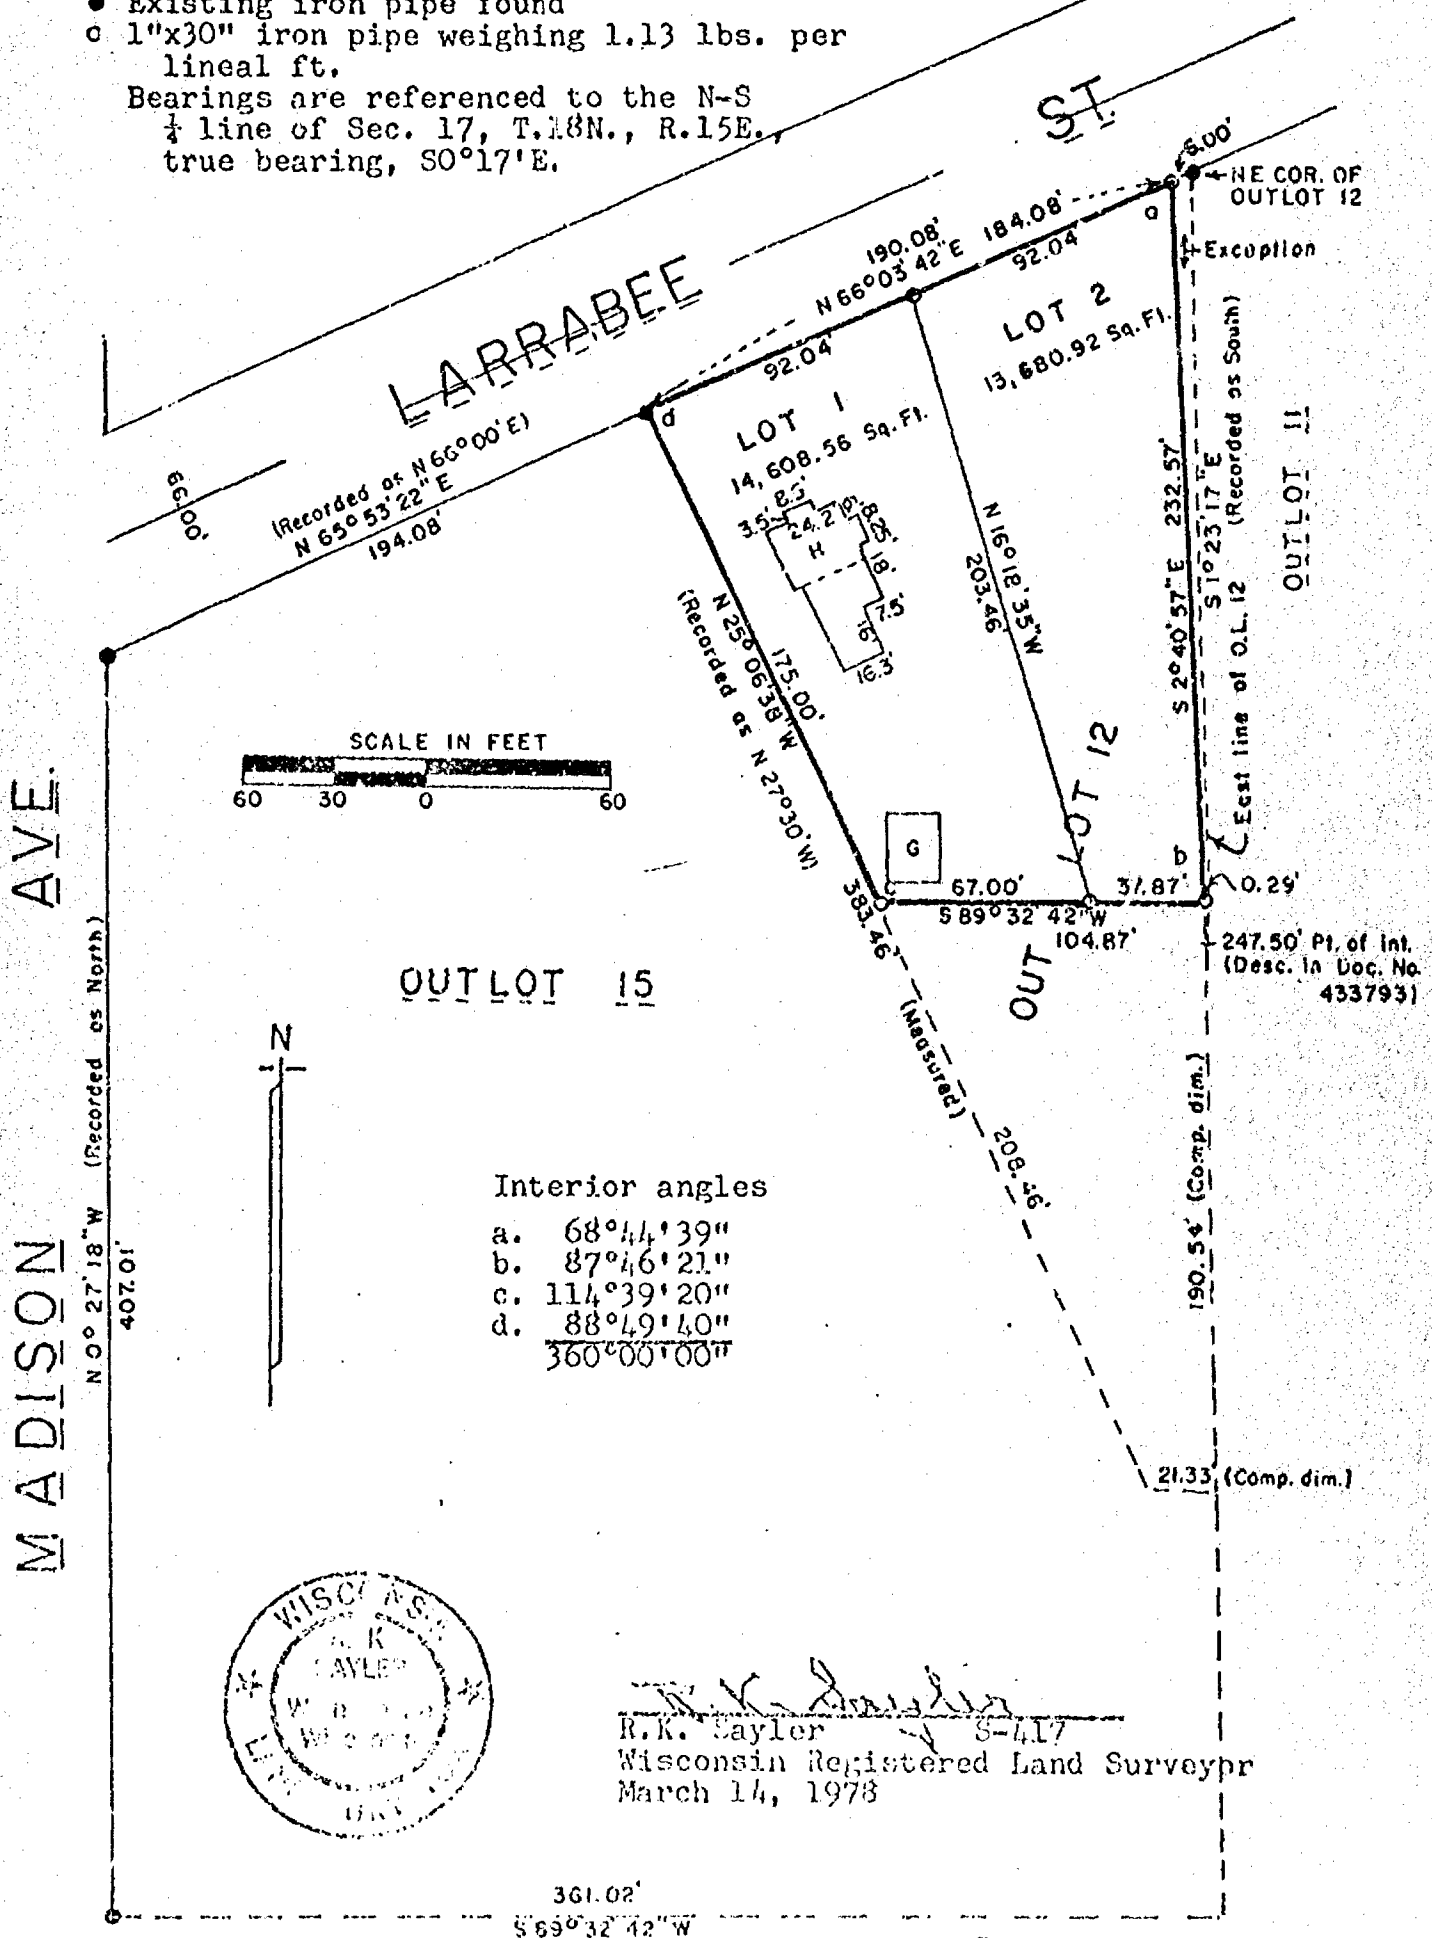

R.K. Saylor
R.K. Saylor
Wisconsin Registered Land Surveyor
March 14, 1978

WINNEBAGO COUNTY CERTIFIED SURVEY MAP NO. 307.

Part of Outlot 12 of OUTLOTS SOUTH OF THE FOX RIVER in the City of Omro, Sec. 17, T.18N., R.15E.

I, R.K. Saylor, registered land surveyor, hereby certify:
That I have surveyed, divided and mapped the parcels of land located in part of Outlot 12 of the plat of OUTLOTS SOUTH OF THE FOX RIVER in the City of Omro in Sec. 17, T.18N., R.15E., Winnebago County, Wisconsin, described as follows: Beginning at an iron pipe that is 6.00 ft., S66°03'42"W of the NE corner of Outlot 12. From that point running S2°40'57"E, 232.57 ft., thence S89°32'42"W, 104.87 ft., thence N25°06'38"W, 175.00 ft. to the Southerly line of Larrabee Street, thence N66°03'42"E along the Southerly line of Larrabee Street, 184.08 ft. to the said point of beginning.

That I have made such survey, land division and map by the direction of Hellwig Realty, 156 E. Main St., Omro, Wisconsin, 54963; that such map is a true and correct representation of the exterior boundaries of the land surveyed.

That I have fully complied with the provisions of Sec. 236.34 of the Wisconsin Statutes in surveying and mapping the same.



R. K. Saylor
R. K. Saylor S-417
Wisconsin Registered Land Surveyor
March 14, 1978

OWNER'S CERTIFICATE

As owners, we hereby certify that we caused the land described on this Certified Survey Map to be surveyed, divided and mapped as represented thereon.

WITNESS the hand and seal of said owners this 11 day of April, 1978.

In presence of:

Wab A. Davis
Witness

Michael Davis
Michael Davis
Mary Davis
Mary Davis
240 E. Larrabee St.
Address
Omro, WI
City-State

STATE OF WISCONSIN) SS
WINNEBAGO COUNTY)

Personally came before me this 11TH day of APRIL, 1978, the above name MICHAEL + MARY DAVIS, to me known to be the persons who executed the foregoing instrument and acknowledged the same.

John R. Hoeft
Notary Public
OMRO, Wisconsin

My commission expires 10/18/81.

OMRO CITY PLANNING COMMITTEE CERTIFICATE

This Certified Survey Map of part of Outlot 12 of the plat of OUTLOTS SOUTH OF THE FOX RIVER in the City of Omro, is hereby approved.

4-5-78
Date

Edmund Shefferson
Authorized representative

~ 513522

Register's Office
Winnebago County, Wis.
Received for record this *1st* th
day of *April* A.D. 19 *78*
at *9:40* o'clock A.M.
recorded in Vol. *1* of *S. Maps*
on page *392*

Lorraine C. Hagler,
Deputy Register of Deeds


88-00

Plat of Survey

THE WEST 62.0 FT. OF THAT PART OF OUTLOT 8, SOUTH OF FOX RIVER, ACCORDING TO THE PLAT OF OUTLOTS IN THE S.E. 1/4 OF THE N.W. 1/4 OF SECTION 17, T18N, R15E, IN THE FIRST WARD, CITY OF OMRO, LYING EAST OF A LINE DESCRIBED AS FOLLOWS; COMMENCING AT THE N.E. CORNER OF SAID LOT, THENCE WEST ALONG THE NORTH LINE OF SAID LOT TO AN ANGLE IN THE NORTHERLY LINE OF SAID LOT, THENCE SOUTH 68°05'00" WEST 34.60 FT., THE PLACE OF BEGINNING OF THE ABOVE MENTIONED LINE, THENCE SOUTH PARALLEL WITH THE EAST LINE AND EXTENDED EAST LINE OF SAID LOT.

AUGUST 31, 1979

SURVEY NO. 71-S

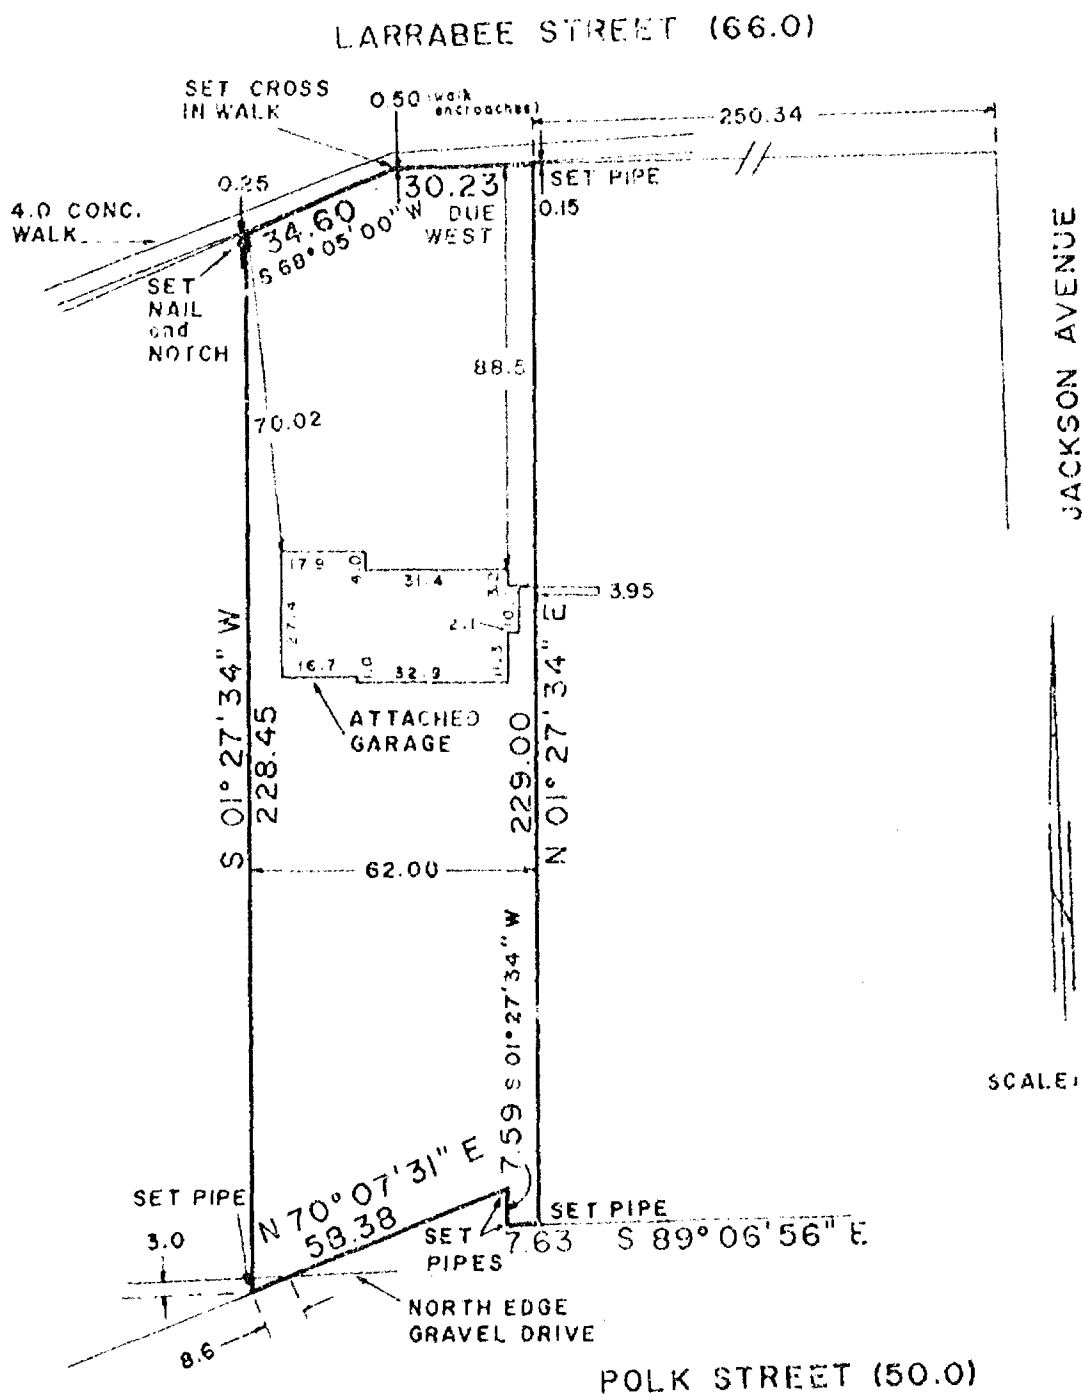

I Certify that I have surveyed the above described property (Property), and the above map is a true representation thereof and shows the size and location of the Property, its exterior boundaries, the location and dimensions of all visible structures thereon, boundary fences, apparent easements and roadways and visible encroachments, if any. This survey is made for the exclusive use of the present owners of the Property, and also those who purchase, mortgage, or guarantee the title thereto, within one (1) year from date hereof.



national survey & engineering

POST OFFICE BOX 2963
OSHKOSH, WISCONSIN 54901

Reinhard W. Roehlig
SURVEYOR



EXTENSION OF SCOTT PARK BULKHEAD LINE BEING IN THE N.1/2 NW.1/4 SEC.17 T.18N. R.15E. CITY OF OMRO, WINNEBAGO COUNTY, WISC.


NO. CHORD BEARING CHORD DIST. CENTRAL ANGLE ARC DIST. RADIUS
A-B S15°49'-52" W. 19.39' 116°27'-05" 23.17' 11.40'
C-D S68°17'-23" E. 116.10' 48°18'-28" 119.61' 141.86'

CURVE DATE



FOX

RIVER

LEGEND
— EDGE OF FOX RIVER
— SURVEY LINE
— BULKHEAD LINE
— 1" IRON PIPE
— R.R. SPIKE
SCALE - 1" = 60'
DATE - SEPT. 8, 1975
HIGH WATER LINE BASED ON HISTORICAL
FLOOD ELEVATION 752.3'-751.9'
ALL ELEV. ON U.S.G.S. DATUM.

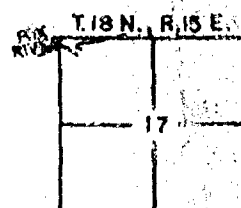

L-75

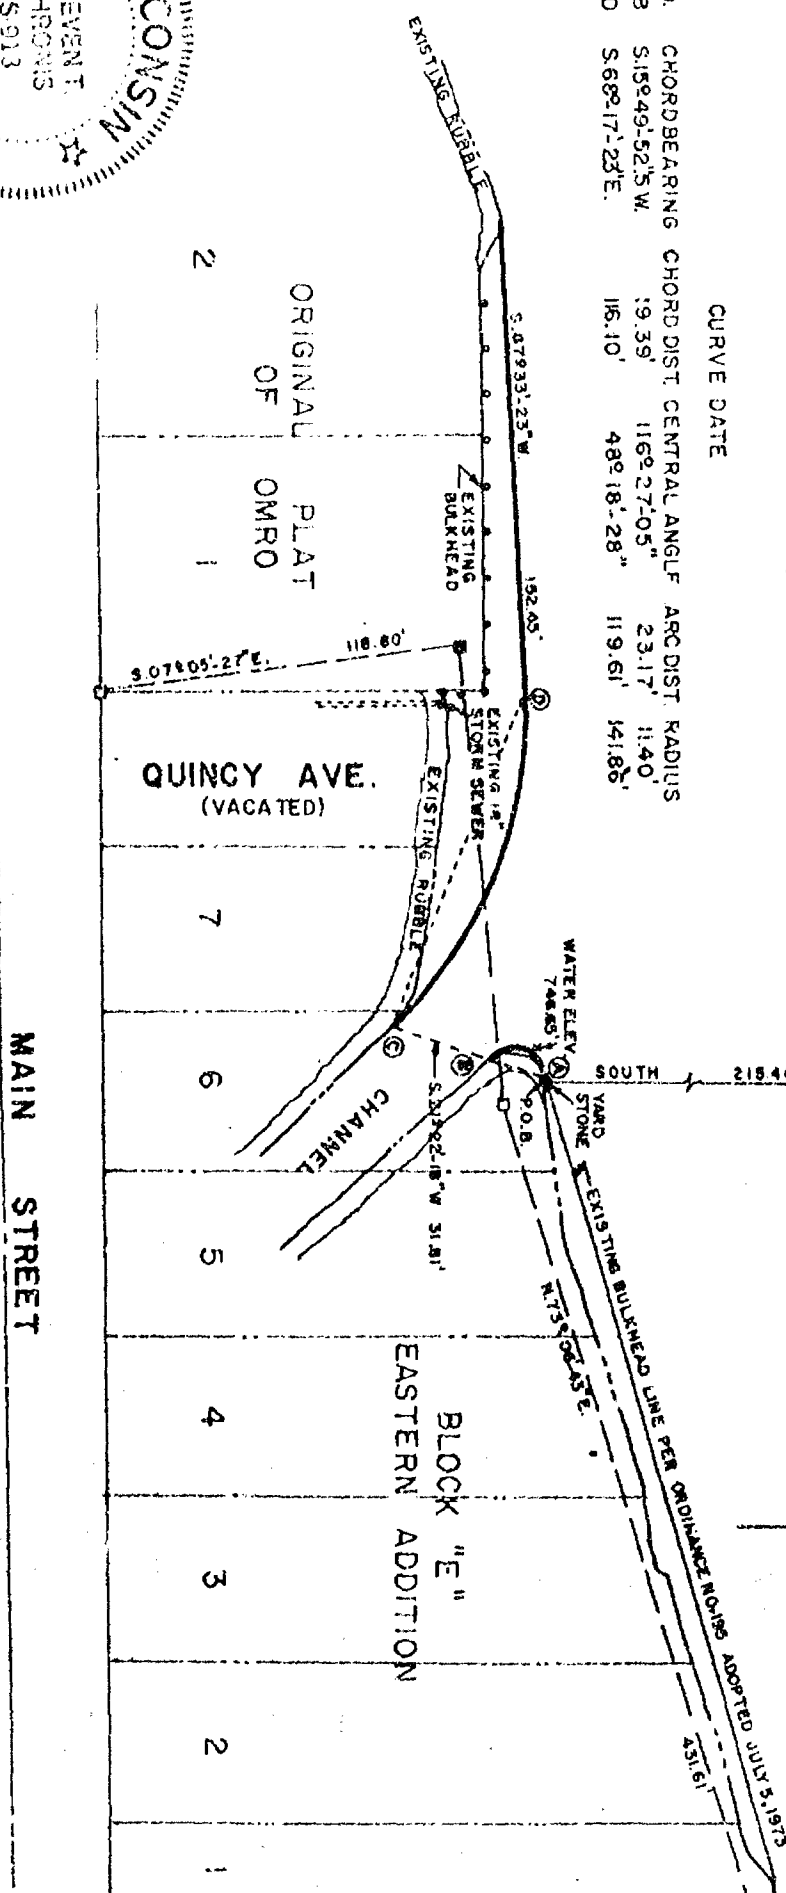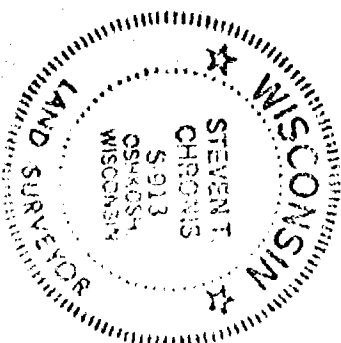

AERO-METRIC ENGINEERING, INC.
PHOTOGRAMMETRIC ENGINEERS
LAND SURVEYORS
OSHKOSH, WISCONSIN


Steven T. Chronis
WIS. REGISTERED LAND SURVEYOR 5-913
NOTEBOOK 17 PAGE 1-2

DESCRIPTION OF PROPOSED BULKHEAD LINE

17 18 15 7


A Bulkhead Line being in the North Half (N 1/2) of the Northwest Quarter (NW 1/4) of Section Seventeen (17), Township Eighteen (18) North, Range Fifteen (15) East, City of Omro, Winnebago County, Wisconsin, being described by: Commencing at the North Quarter (1/4) corner of said Section 17 as recorded in Volume 1 page 3 of Certified Survey Maps, thence South 215.40 feet, thence West 1252.70 feet to a yard stone being the point of termination of A Bulkhead Line established by Ordinance No. 195 approved July 5, 1973 and being the true point of beginning of this description, running thence Southerly 23.17 feet along the Arc of a curve to the left having a Radius of 11.40 feet and the chord of which bears S. 15°-49'-52.5" W. 19.39 feet to a point on the ordinary High Water mark of the Fox River, thence S. 21°-22'-18" W. 31.81 feet across a channel to a point on the ordinary High Water mark of the Fox River, said course being used for descriptive purposes only in connecting the two points on the ordinary High Water mark of the Fox River and is not a part of the Bulkhead Line, thence Westerly 119.61 feet along the Arc of a curve to the left having a radius of 141.86 feet and the chord of which bears N. 68°-17'-23" W. 116.10 feet, thence S. 87°-33'-23" W. 152.45 feet to a point on the ordinary High Water Mark of the Fox River and the point of termination.

RICHFIELD INVESTMENT CORPORATION

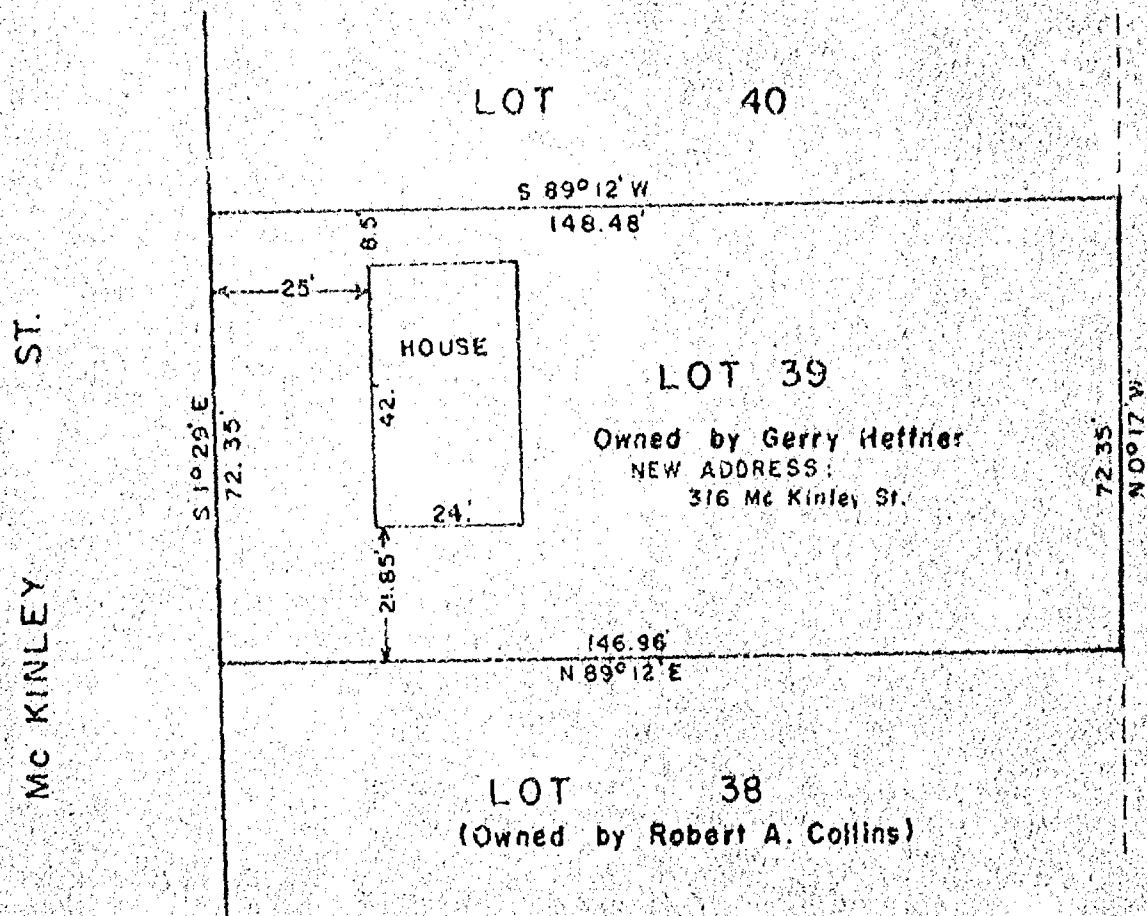

I hereby certify that according to the records at Ohio City Hall, Gerry Heffner owns Lot 39 of HEDWIG PLAT in the City of Ohio, Winnebago County, Wisconsin. The address re-issued is 316 McKinley St.

R. K. Saylor
Surveyor

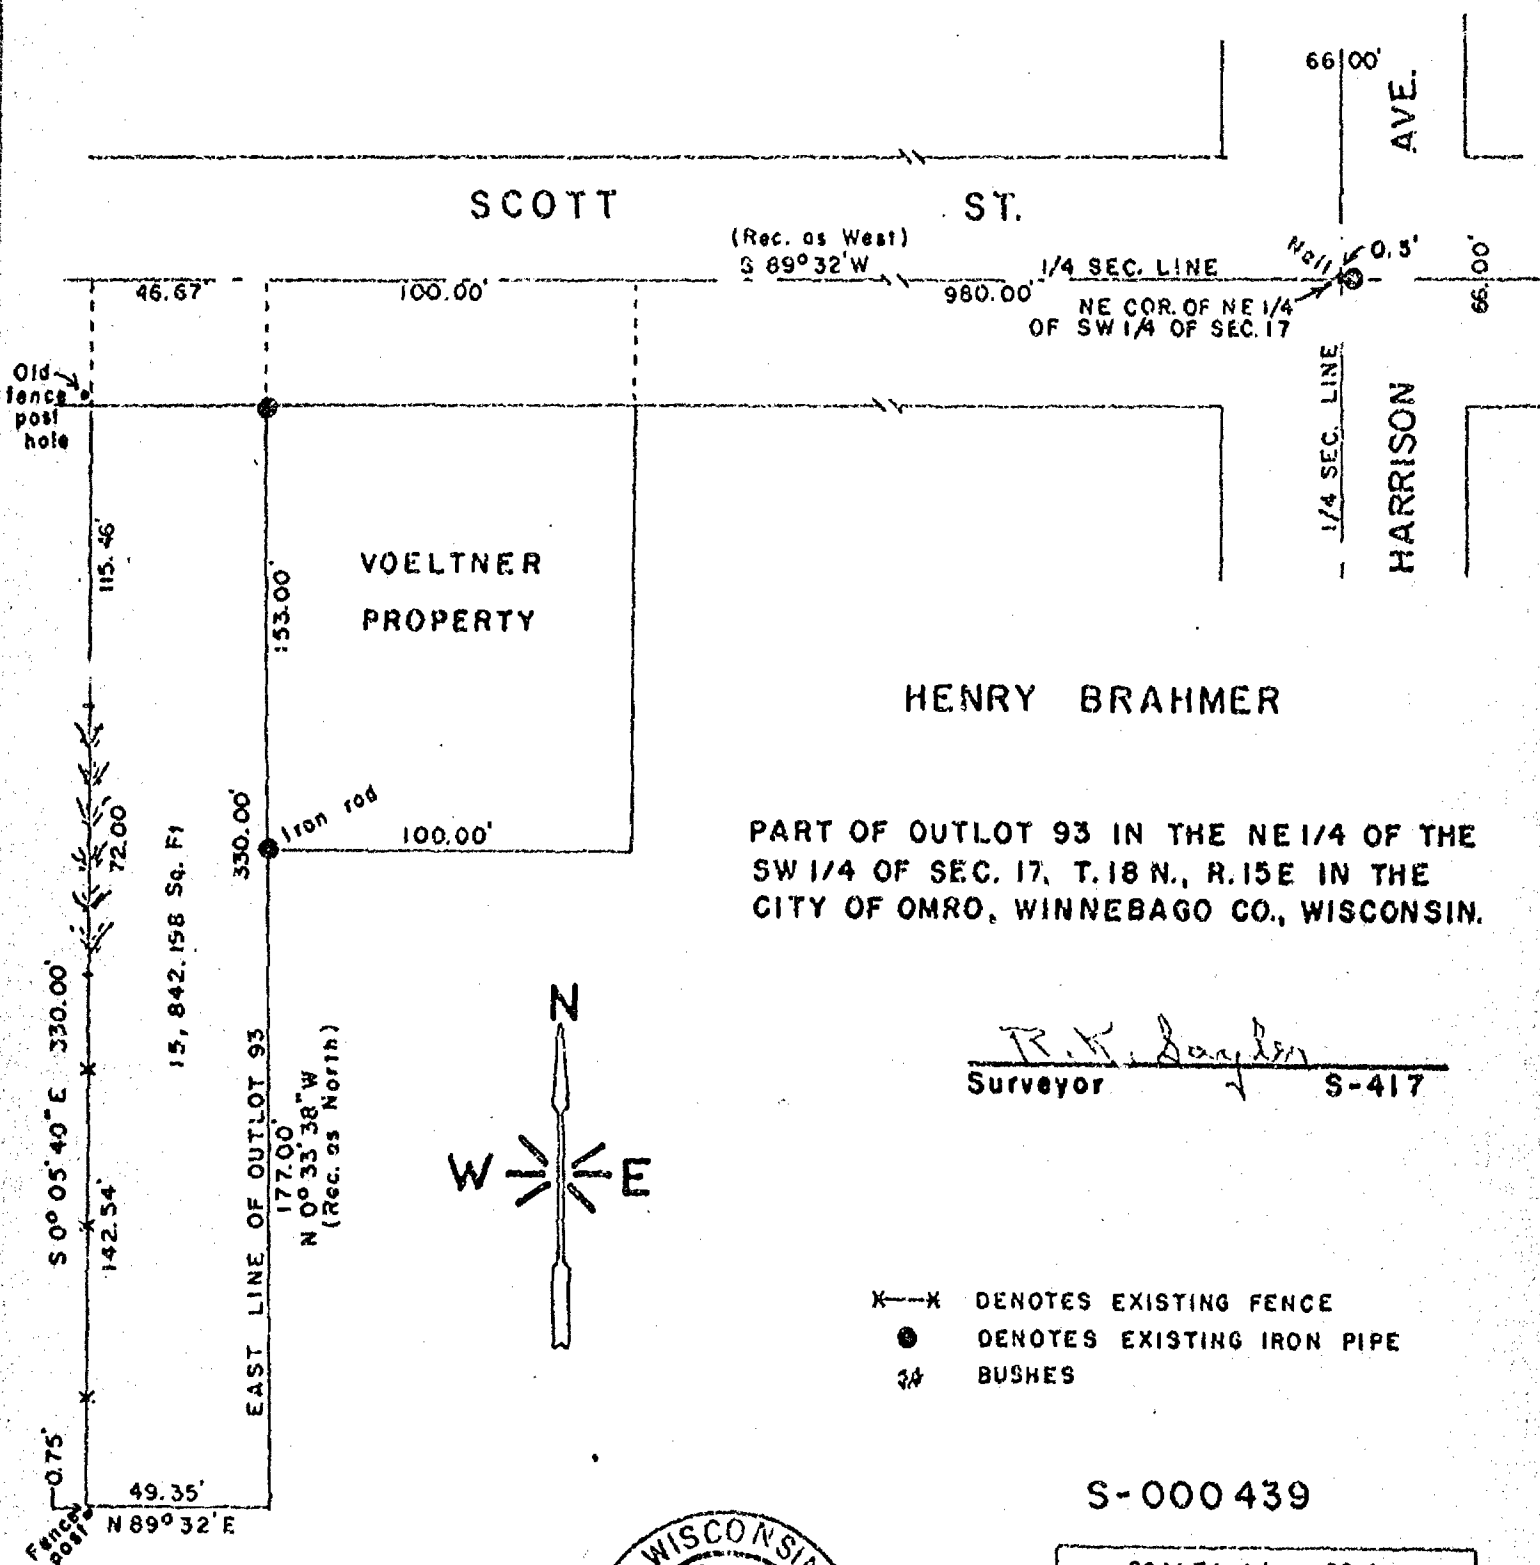

HENRY BRAHMER

PART OF OUTLOT 93 IN THE NE 1/4 OF THE SW 1/4 OF SEC. 17, T.18 N., R.15 E IN THE CITY OF OMRO, WINNEBAGO CO., WISCONSIN.

R. K. Saylor
Surveyor S-417

- X—X DENOTES EXISTING FENCE
- DENOTES EXISTING IRON PIPE
- 3/4 DENOTES BUSHES

S-000 439

SCALE: 1 in. = 50 ft.
MAY 21, 1975
BK. 28 P. 128

ROBERT C. CARLSON

LOT 4 OF BLK. N OF EASTERN ADDITION TO THE
CITY OF OMRO, WINNEBAGO COUNTY, WISCONSIN.

Calvin W. Hawksworth
W.R.L.S. 3-1290


BLOCK I

E. ONTARIO ST.

49.50'



AVE.

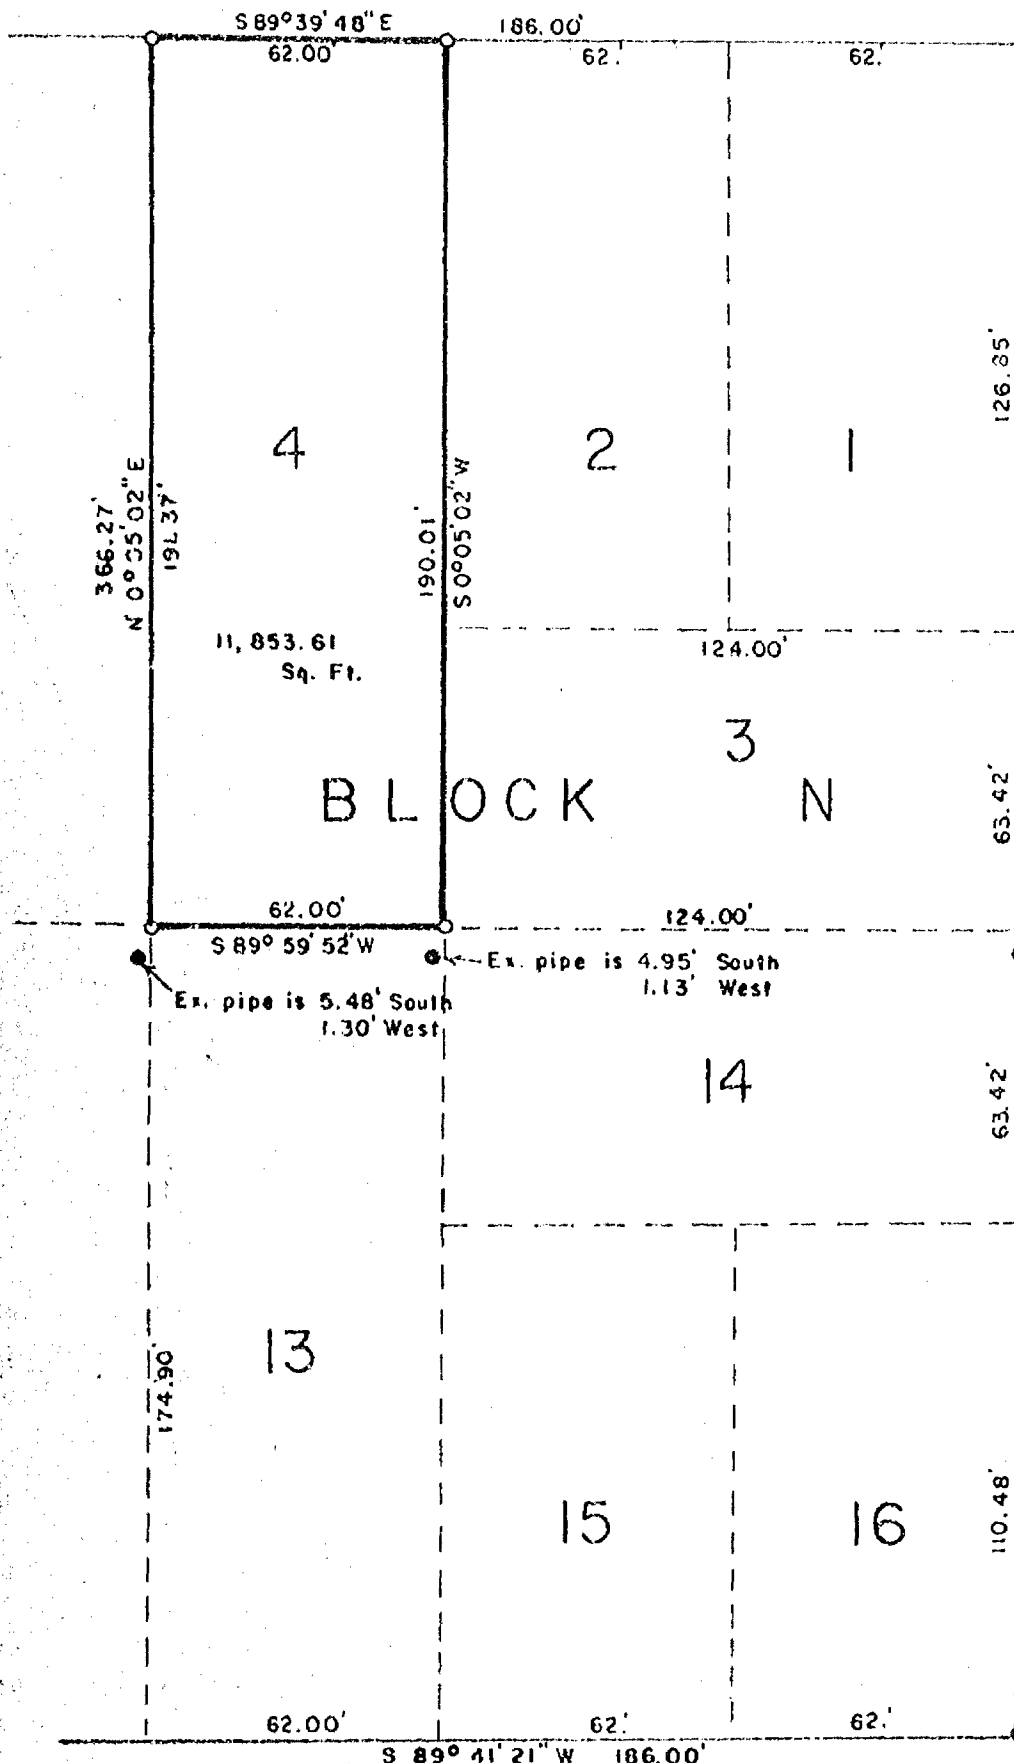

- EX. I.P. FOUND
- 1" IRON PIPE SET

Note: Lots pro-rated for overage.

HARRISON

LARRABEE ST.

S-000832

R.K. Saylor, Inc.

Scale: 1" = 40 ft.


May 1, 1970

OK. 37 P. 4-5-6

Plat of Survey

LOT 1 AND THE N 1/2 OF LOTS 2 & 4 OF BLOCK L OF EASTERN
ADD'N. TO THE CITY OF OMRO, WINNEBAGO COUNTY, WISCONSIN.

OWNER: DALE DAVIS
303 JACKSON AVE.
OMRO, WISCONSIN

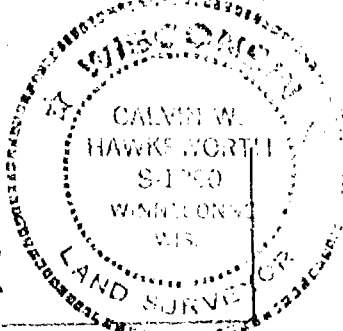

BLOCK

K


AVE.

ONTARIO

ST.

49.50'

82.50'

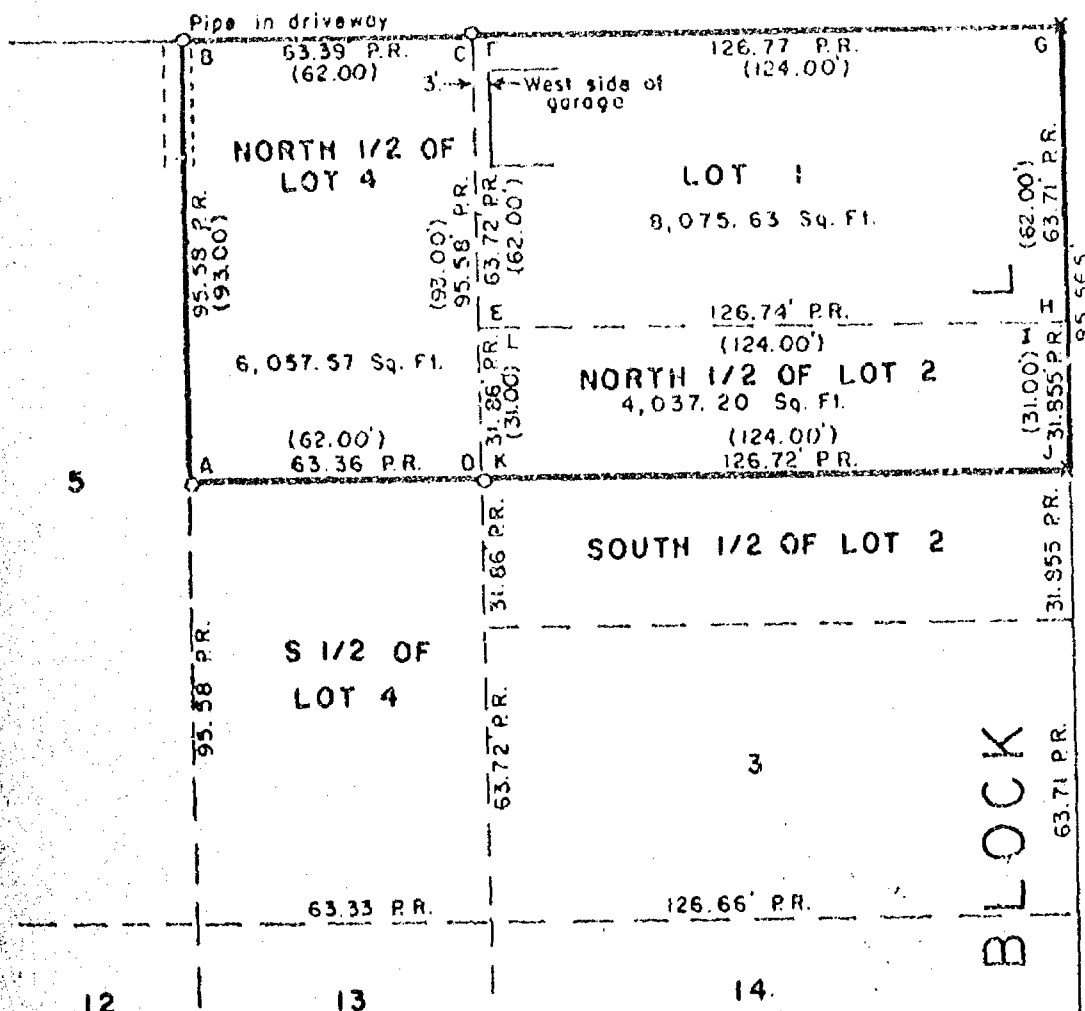

JACKSON

BLOCK

Interior angles:

- A. 89°46'25"
- B. 90°13'18"
- C. 89°45'42"
- D. 90°14'35"
- E. 89°45'33"
- F. 90°14'18"
- G. 89°43'43"
- H. 90°16'26"
- I. 89°43'34"
- J. 90°16'34"
- K. 89°45'25"
- L. 90°14'27"

LEGEND

- = Existing monuments
- = 2 x 30" iron pipe set
- = 1" x 30" iron pipe set
- = reference caps or RR spikes
- ⊙ = Bernitsen or Harrison monuments
- X-X = fence
- () = recorded as
- 13 = stone monument
- X = cross cut in concrete

SURVEYORS CERTIFICATE

I, hereby certify that I have surveyed the property as shown, according to official records and that the plat above drawn is an accurate and correct representation of said survey.

MAY 13, 1979

Calvin W. Hawksworth

Wisconsin Registered Land Surveyor

S-1290




R. K. SAYLER, INC.
LAND SURVEYORS
WINNECONNE, WI 54986

SCALE 1 in. = 40 ft.

PROJECT NO. S-000975

FIELD BOOK 39 PAGE 13

WINNEBAGO COUNTY CERTIFIED SURVEY MAP NO. 1096
Part of Outlot 4 in OUTLOTS SOUTH OF THE FOX RIVER, Section 17,
T.18N., R.15E., City of Omro, Winnebago County, Wisconsin

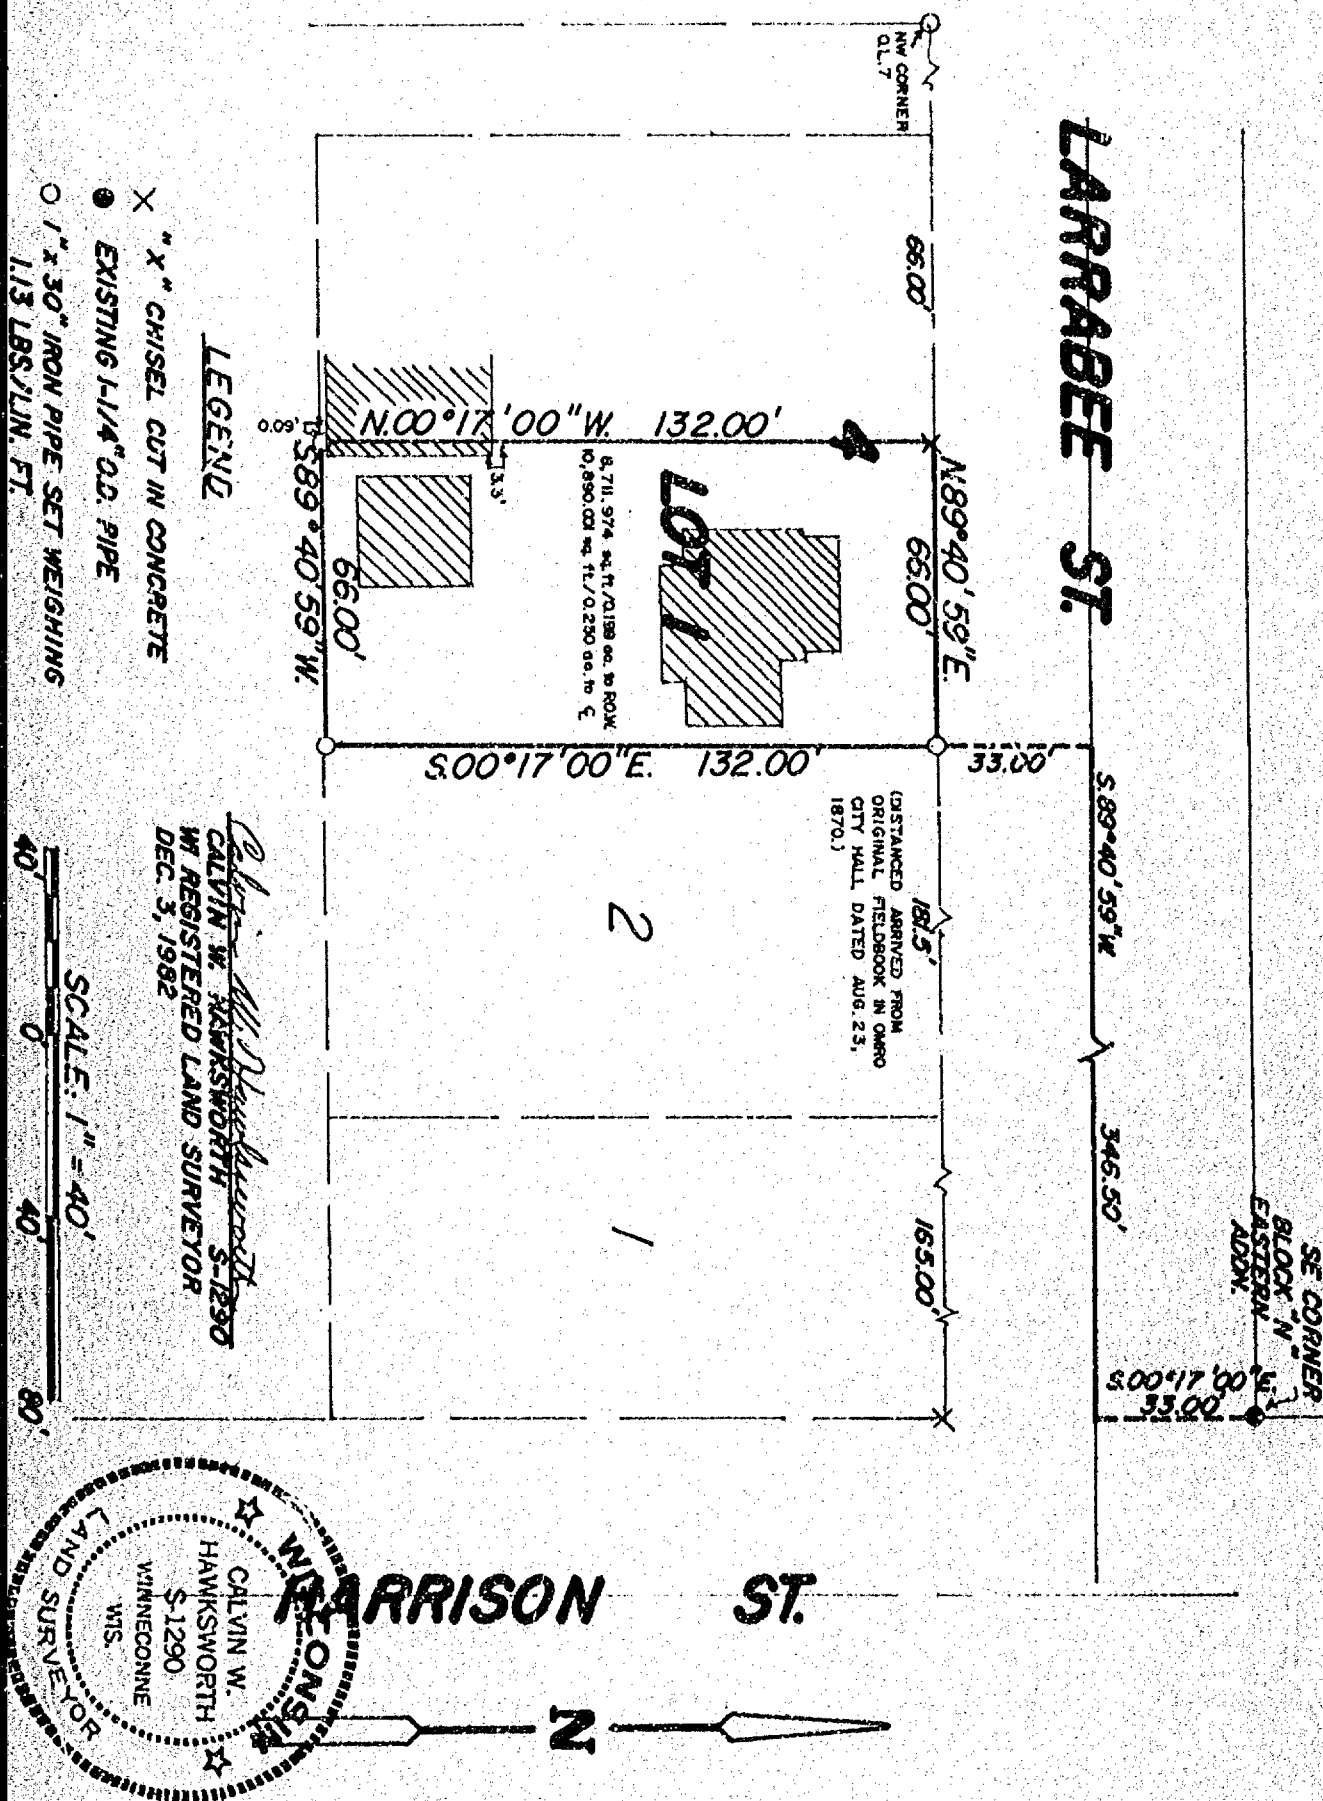

Stock No. 26273

WINNEBAGO COUNTY CERTIFIED SURVEY MAP NO. 1096
Part of Outlot 4 in OUTLOTS SOUTH OF THE FOX RIVER, Section 17,
T.18N., R.15E., City of Omro, Winnebago County, Wisconsin.


SURVEYOR'S CERTIFICATE

I, Calvin W. Hawksworth, registered land surveyor, hereby certify:

That I have surveyed and mapped the parcel of land located in part of Outlot 4 in OUTLOTS SOUTH OF THE FOX RIVER, Section 17, T.18N., R.15E., City of Omro, Winnebago County, Wisconsin, described as follows: Beginning at a point that is 33.00 ft. S.00°17'00"E. and 346.50 ft. S.89°40'59"W. and 33.00 ft. S.00°17'00"E. of the Southeast corner of Block "N", Eastern Addition. From that point running S.00°17'00"E. 132.00 ft., thence S.89°40'59"W. 66.00 ft., thence N.00°17'00"W. 132.00 ft., thence N.89°40'59"E. 66.00 ft. to the point of beginning. Being a parcel of land of 0.129 acres, more or less.

That I have made such survey and map by the direction of Rendell J. and Nancy Potratz, 560 East Larrabee, Omro, WI 54963; that such map is a true and correct representation of the exterior boundaries of the land surveyed.

That I have fully complied with the provisions of Sec. 236.34 of the Wisconsin Statutes and the City of Omro, Subdivision Control Ordinance No. 222 in surveying and mapping the same.

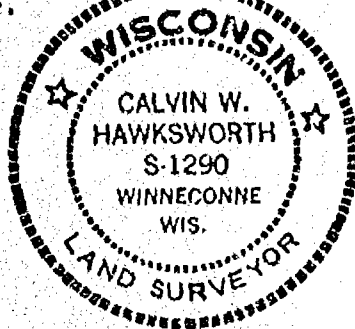

Calvin W. Hawksworth
Calvin W. Hawksworth S-1290
WI Registered Land Surveyor
December 3, 1982

OWNER'S CERTIFICATE

As owners, we hereby certify that we caused the land described on this Certified Survey Map to be surveyed and mapped as represented hereon.

WITNESS the hand and seal of said owners this 22nd day of December, 1982.

In presence of:

Charles G. Schmitz
Witness

Rendell Potratz Nancy Potratz
Owners Rendell & Nancy Potratz
560 E. Larrabee St.
Street Address

Omro Wis 54963
City State

STATE OF WISCONSIN } SS
WINNEBAGO COUNTY }

Personally came before me this 22 day of December, 1982, the above named Rendell and Nancy Potratz, to me known to be the persons who executed the foregoing instrument and acknowledged the same.

James S. Schmitz
Notary Public

My commission expires Aug 15, 1985

SHEET 2 of 3 SHEETS

SAYLER SURVEY, INC., 330 Birch St., Box 252, Winneconne, WI 54986

Stock No. 26273


WINNEBAGO COUNTY CERTIFIED SURVEY MAP NO. 1296
 Part of Outlot 4 in OUTLOTS SOUTH OF THE FOX RIVER, Section 17,
 T.18N., R.15E., City of Omro, Winnebago County, Wisconsin

CITY OF OMRO PLANNING COMMITTEE CERTIFICATE

This Certified Survey Map of part of Outlot 4 in OUTLOTS
 SOUTH OF THE FOX RIVER, Section 17, T.18N., R.15E., City of
 Omro, Winnebago County, Wisconsin, is hereby approved.

Feb 11, 1983
 Date Approved

Garland Chase
 Authorized Representative

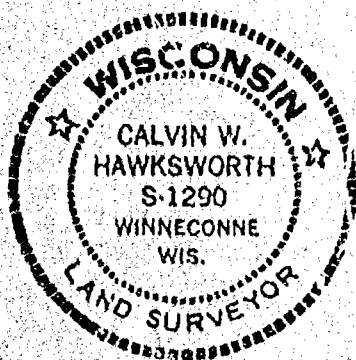

Calvin W. Hawksworth
 Calvin W. Hawksworth S-1290
 WI Registered Land Surveyor
 December 3, 1982

586102

Recorder's Office
 Winnebago County, Wis.
 Received for record this 15th
 day of Feb. A.D. 1983
 at 2:04 o'clock P.M., and
 recorded in Vol. 1 of SM
 at page 1096
Marjorie Johnson
 Register of Deeds

SHEET 3 of 3 SHEETS

✓
 SAYER SURVEY, INC., 330 Birch St., Box 252, Winneconne, WI 54986

Pd
 801

WINNEBAGO COUNTY CERTIFIED SURVEY MAP NO. 221
 Part of Outlot 94 South of the Fox River in the City of Omro.

- Existing iron pipe found
- 1"x30" iron pipe weighing 1.13 lbs. per lineal ft. Rods are 5/8"x24" re-bars weighing 1.043 lbs. per lineal ft.

• Berntsen monument

Bearings are referenced to the N-S & Sec. line of Sec. 17, T.18N., R.15E., true bearing, $90^{\circ}17'E$.

I, Calvin W. Hawksworth, registered land surveyor, hereby certify:

That I have surveyed and mapped the West line of that part of Outlot 94 South of the Fox River lying North of Maplewood Road in the City of Omro, Winnebago County, Wisconsin, described as follows:- Beginning at an iron pipe that is 99.00 ft., $90^{\circ}17'E$ and 132.00 ft., $S89^{\circ}43'W$ of the NW corner of the NE 1/4 of Sec. 17, T.18N., R.15E. From that point running $NO^{\circ}17'W$, 265.59 ft., more or less to the water's edge of the Fox River.

That said map is a true and correct representation of the line surveyed.

That I have fully complied with the provisions of Sec. 236.34 of the Wisconsin Statutes in surveying and mapping the same.

Calvin W. Hawksworth
 Surveyor S-1290

August 8, 1977

OWNER'S CERTIFICATE

I, John G. Mc Donald, hereby certify that I caused the land described on this map to be surveyed and mapped as represented hereon.



Date 9-22-77

John G. Mc Donald
 John G. Mc Donald, owner
 711 Maplewood Rd.
 Omro, Wisconsin

CITY OF OMRO PLANNING COMMISSION CERTIFICATE

This ~~Notified~~ Survey ~~APPLICABLE~~ Outlot 94 South of the Fox River in the City of Omro, is hereby approved.


City of Omro Planning Commission

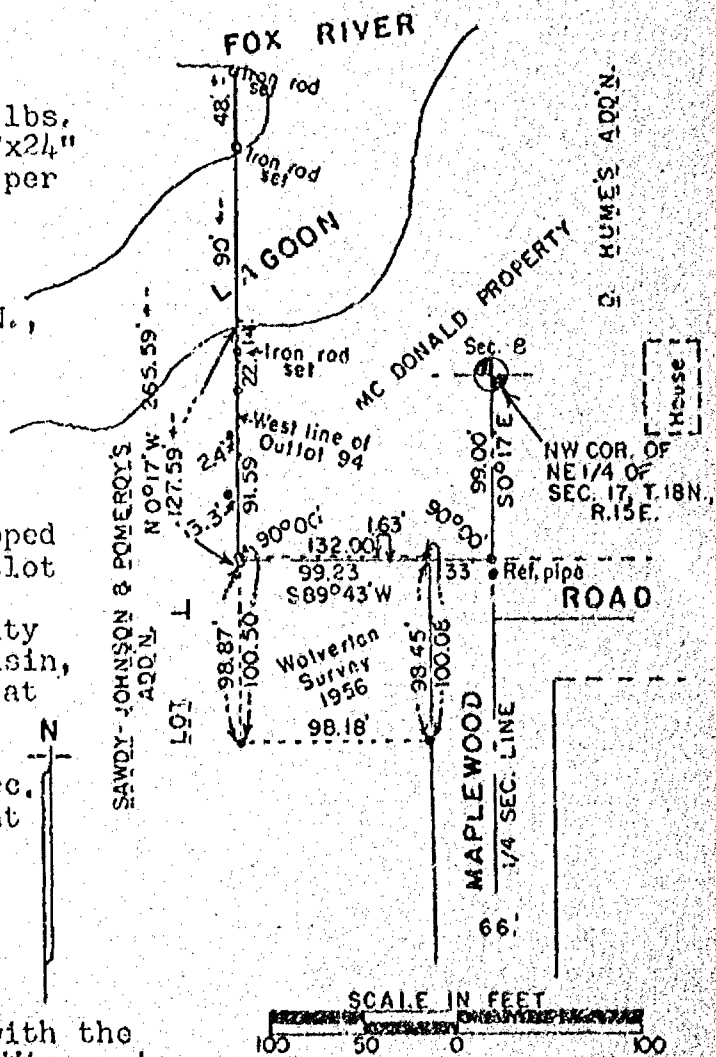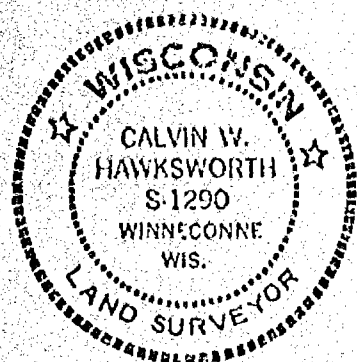


17 18 15 3



E.C. LINE
OF
F.

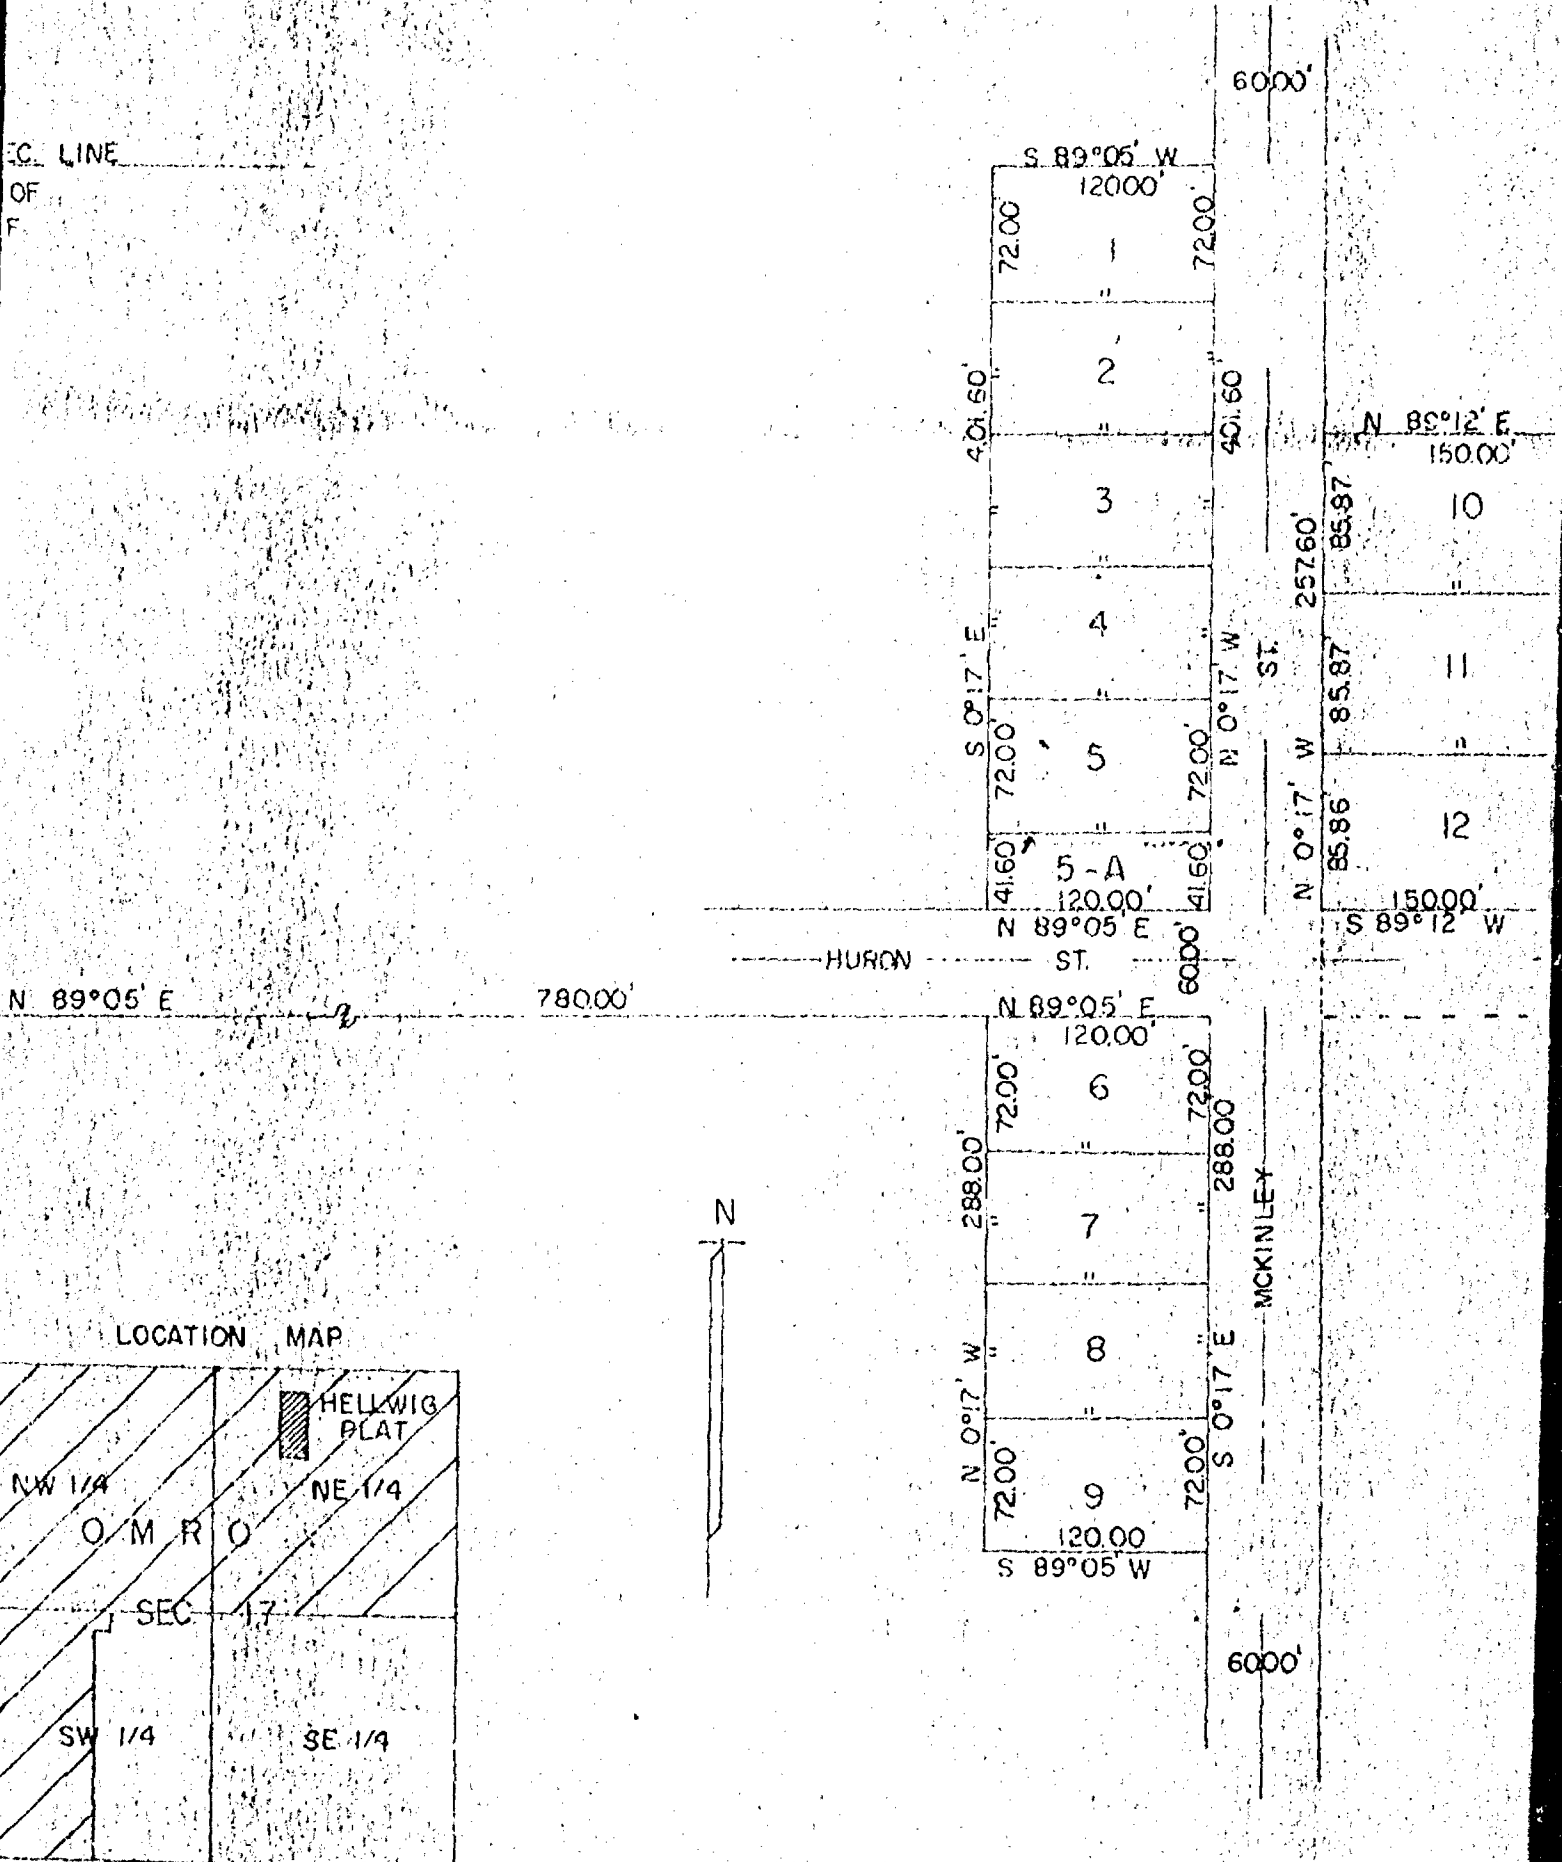

LOCATION MAP

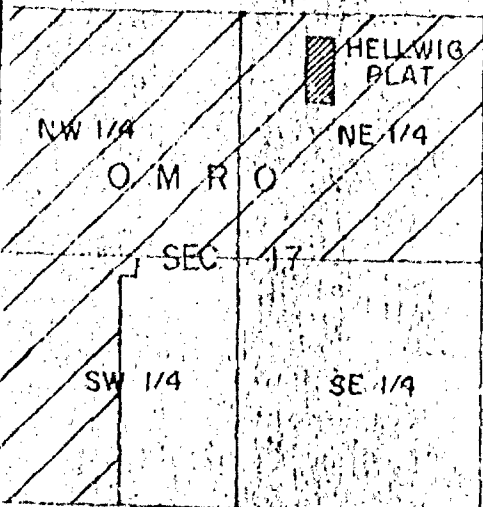


Map of Survey

THE SOUTH 145.00 FT. OF THE NORTH 891.00 FT. OF THE WEST 660.00 FT. OF THE N.W. 1/4 OF THE N.E. 1/4 OF SECTION 17, T18N, R15E, IN THE VILLAGE OF OMRO, WINNEBAGO COUNTY, WISCONSIN.


JUNE 7, 1979

SURVEY NO. 50-S

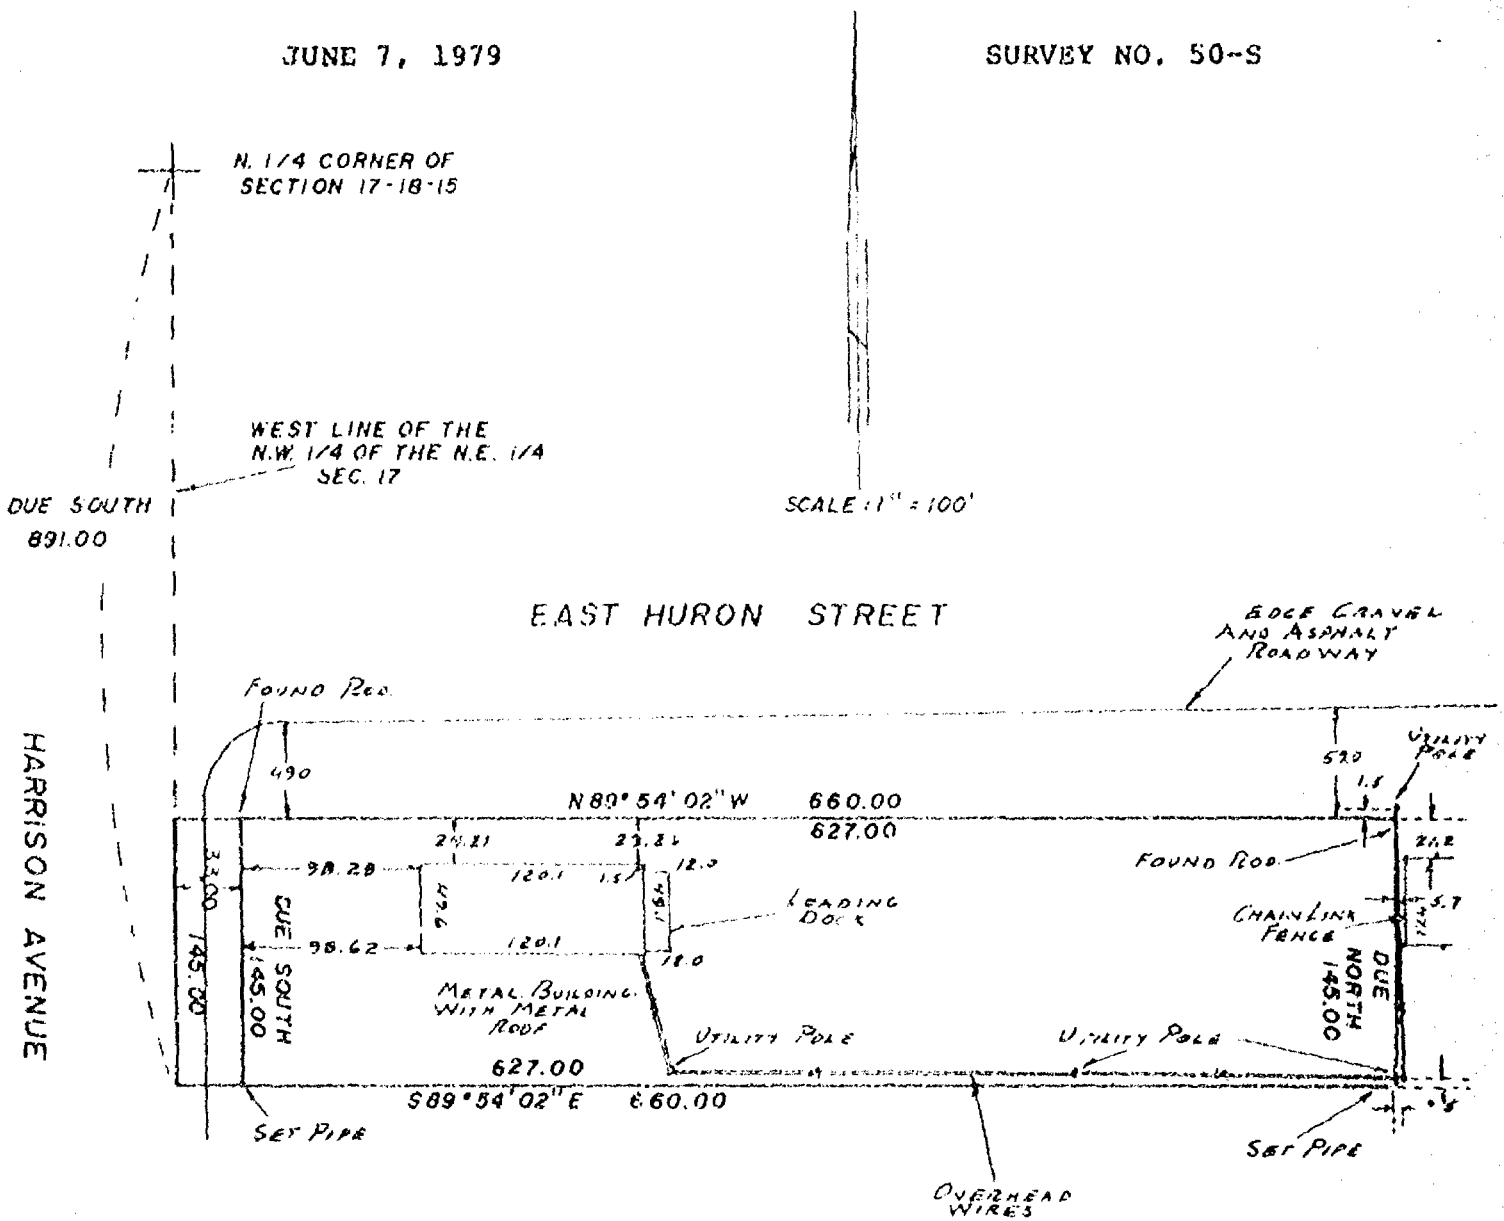

I Certify that I have surveyed the above described property (Property), and the above map is a true representation thereof and shows the size and location of the Property, its exterior boundaries, the location and dimensions of all visible structures thereon, boundary fences, apparent easements and roadways and visible encroachments, if any. This survey is made for the exclusive use of the present owners of the Property, and also those who purchase, mortgage, or guarantee the title thereto, within one (1) year from date hereof.

Michael J. Frechly
SURVEYOR

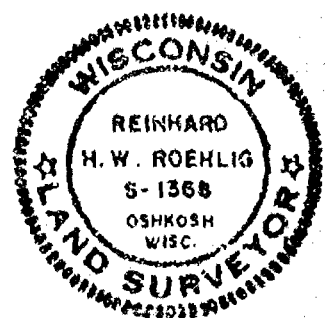

 **national survey & engineering**
POST OFFICE BOX 2963
OSHKOSH, WISCONSIN 54901

21024-1

GERALD HELLWIG TO MIDWESTERN DEVELOPMENT CO.

I, R. K. Sayler, Registered Land Surveyor, hereby certify:
That I have surveyed and mapped the parcel of land located
in part of the NE 1/4 of Sec. 17-18-15, in the City of Omro,
Winnebago County, Wisconsin, described as follows:

Beginning at a point located 721.00 feet S. 0° 17' E. AND 840.00 feet
N. 89° 05' E. of the Northwest corner of the NE 1/4 of said Sec. 17;
from that point running N. 0° 17' W. 317.60 feet, thence N. 89° 12' E.
504.00 feet, thence S. 0° 00' W. 457.30 feet, thence S. 89° 12' W.
352.05 feet, thence S. 0° 17' E. 320.00 foot, thence S. 89° 12' W.
150.00 foot, thence N. 0° 17' W. 460.00 foot to the said point of
beginning.


Being a parcel of land of 6.6 acres, more or less.
That such plat correctly represents all exterior boundaries of
the land surveyed.
That I have fully complied with the provisions of S.236.34 of
the Wis. Statutes in surveying and mapping the same.

Dated: 12/9/70.

(s) R. K. Sayler
Surveyor S-417

SCALE: 1 in. = 200 ft.
SURVEYED: November 25, 1970

• EXISTING IRON PIPE
01" x 24" IRON PIPE WEIGHING 1.15 LBS/LINEAL FOOT
BEARINGS ARE REFERENCED TO THE U.S.G.S. SURVEY AND
U.S.C. & G.S. STANDARD DISC STAMPED "OMRO 1954"

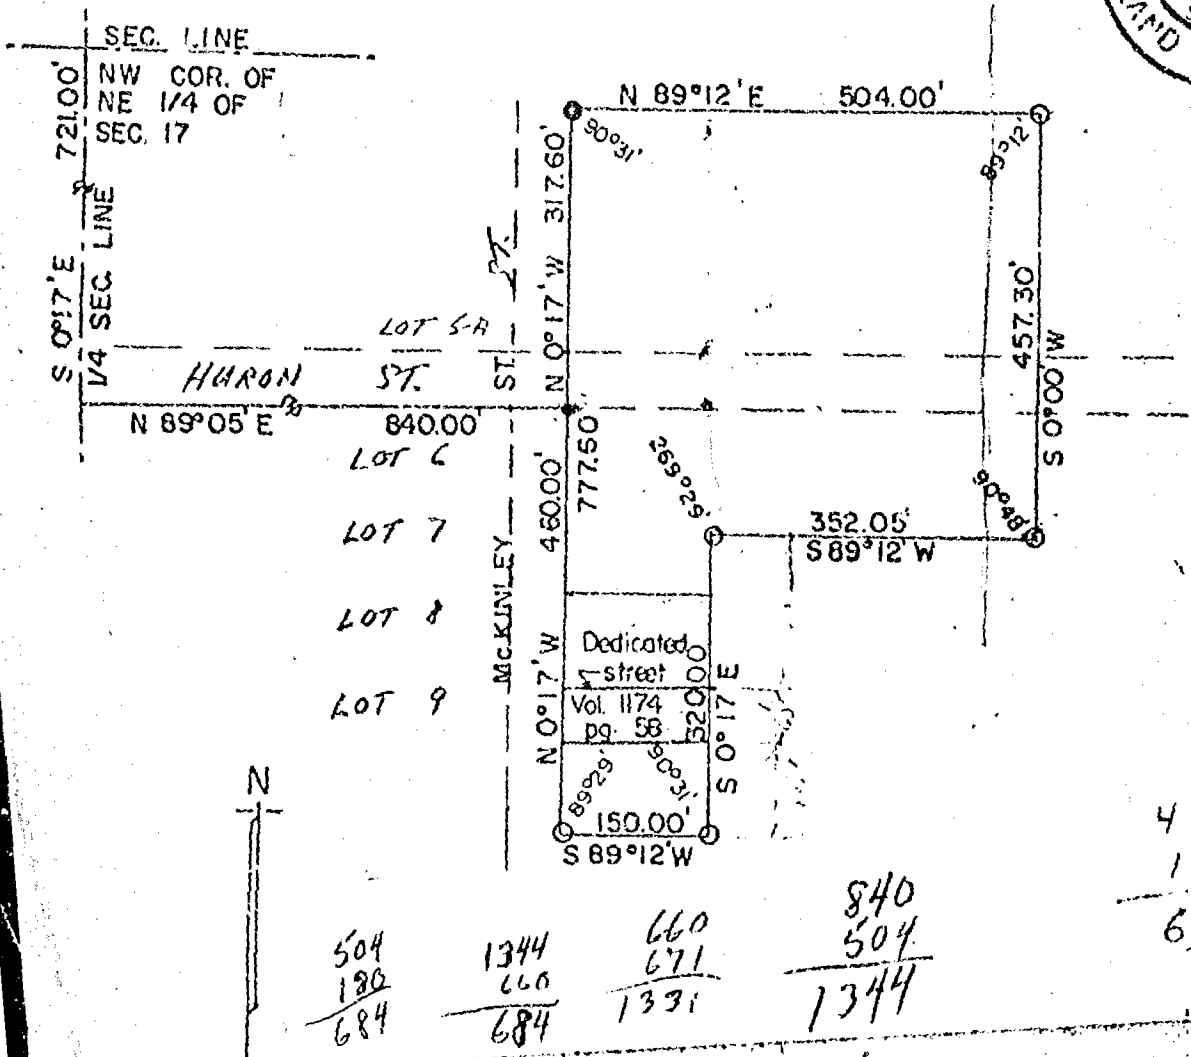

352.05
150.00
502.05

1181
290
891
721
460
1181
457.3
160.0
617.3

504
130
684
1344
660
671
1331
840
504
1344


671.32
180.00
491.32

352.05
150.00
502.05

- (above) 1. Is the NWNE 1344' wide E-W?
(743/595) 2. Is the NWNE 1331.32' wide E-W?
1a. Was Hellwig's parcel 671.32' wide E-W?
2a. Was Hellwig's parcel 684' wide E-W?
3. Did Hellwig buy a strip 11' or 24' wide
in NENE?

WINNEBAGO COUNTY CERTIFIED SURVEY MAP NO. 176.

Part of the NW $\frac{1}{4}$ of the NE $\frac{1}{4}$ of Sec. 17, T.18N., R.15E. in the City of Omro.

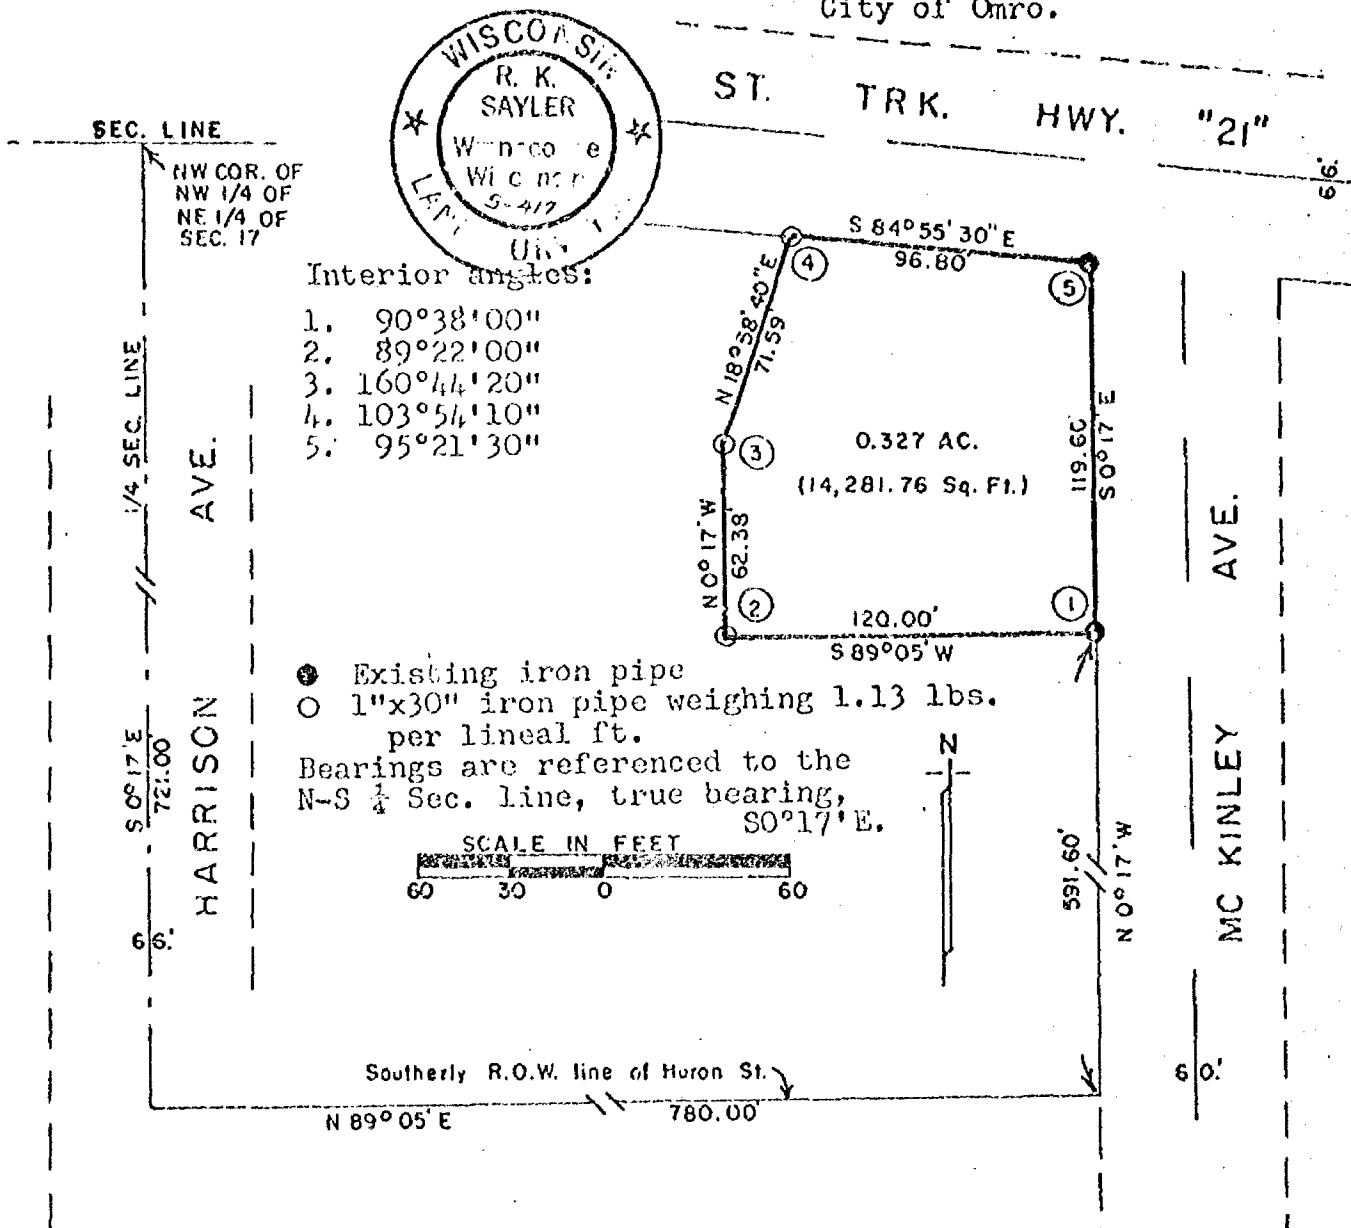

I, R.K. Saylor, registered land surveyor, hereby certify:


That I have surveyed and mapped the parcel of land located in part of the NW $\frac{1}{4}$ of the NE $\frac{1}{4}$ of Sec. 17, T.18N., R.15E., in the City of Omro, Winnebago County, Wisconsin, described as follows:-

Beginning at an iron pipe on the Westerly R.O. W. line of Mc Kinley ST. that is 721.00 ft., SO°17'E and 780.00 ft., N89°05'E and 591.60 ft., NO°17'W of the NW corner of the NW $\frac{1}{4}$ of the NE $\frac{1}{4}$ of said Sec. 17. From that point running S89°05'W, 120.00 ft., thence NO°17'W, 62.38 ft., thence N18°58'40"E, 71.59 ft., to the Southerly R.O.W. line of St. Trk. Hwy. "21", thence S84°55'30"E along said R.O.W. line 96.80 ft. to the Westerly R.O.W. line of Mc Kinley St., thence SO°17'E along said Westerly R.O.W. line, 119.60 ft. to the said point of beginning. Being a parcel of land of 0.327 acres, (14,281.76 sq. ft.) more or less.

That I have made such survey and map by the direction of Gerald E. & Marjorie M. Hellwig, 1014 E. Main St., Omro, Wisconsin, 54963; that such map is a correct representation of the exterior boundaries of the land surveyed.

That I have fully complied with the provisions of Sec. 236.34 of the Wisconsin Statutes in surveying and mapping the same.

R.K. Saylor
Surveyor S-417
March 16, 1977.

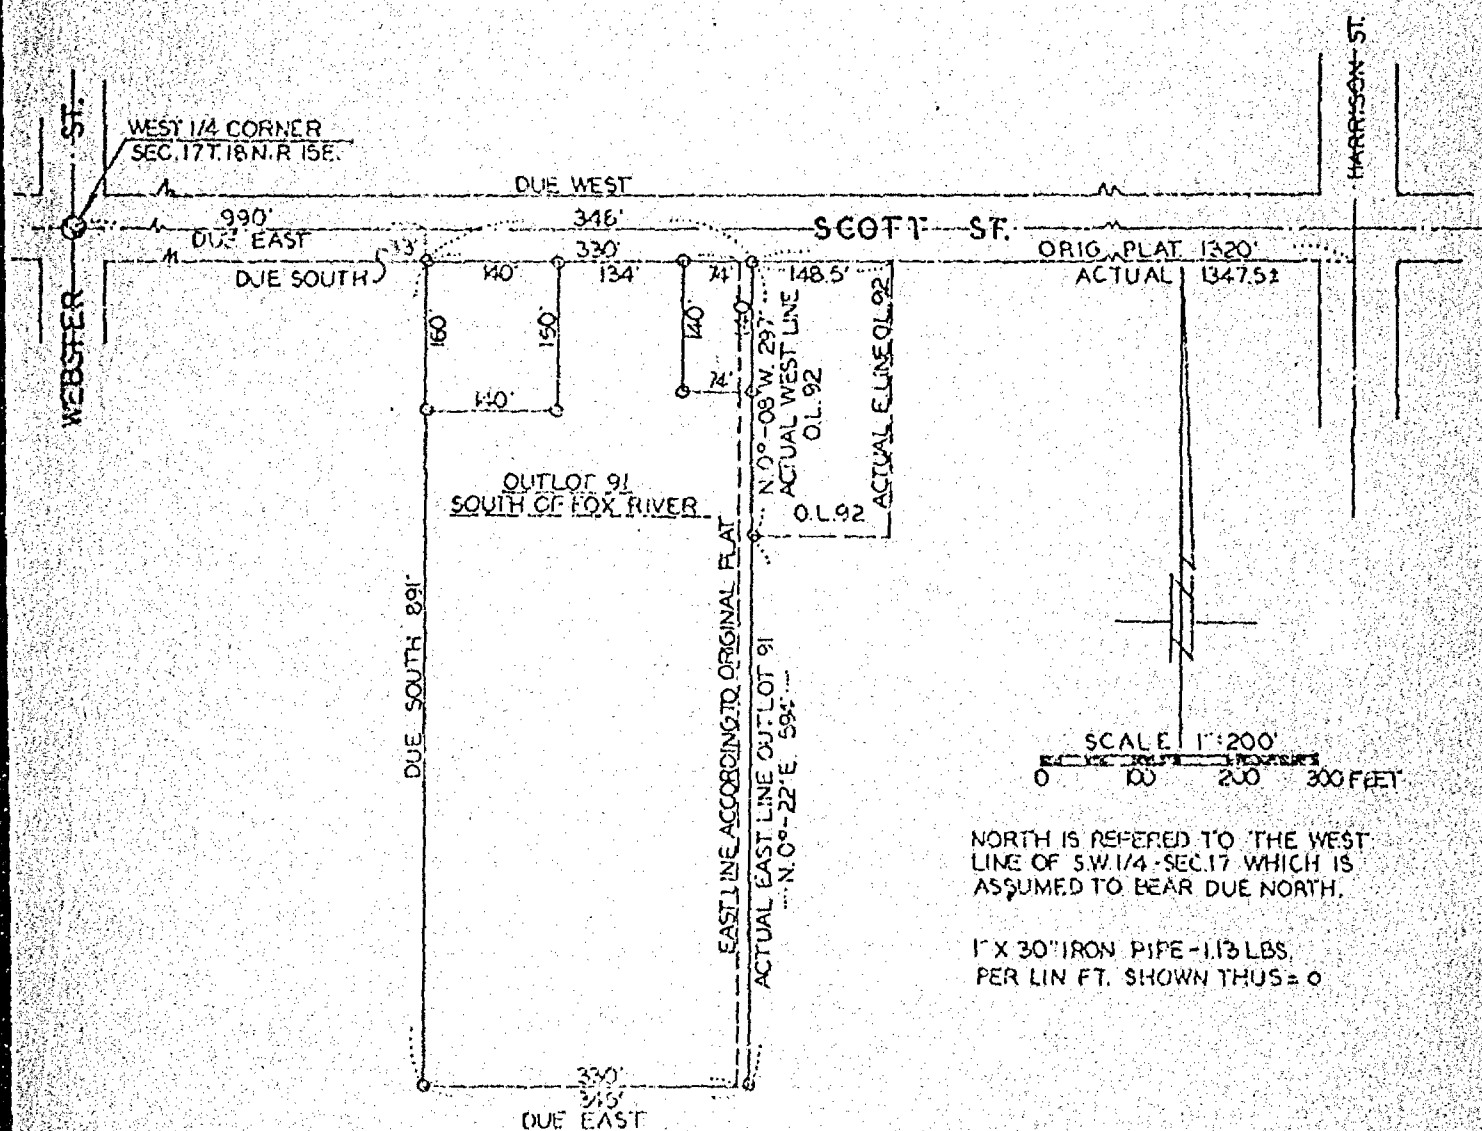

CERTIFIED SURVEY MAP


State of Wisconsin)
) ss.
 Winnebago County)

I, Paul W. Bishop, Land Surveyor, do hereby certify that I have surveyed Cutlot 91 south of the Fox River in the City of Omro, Winnebago County, Wisconsin described as follows:

Commencing at the West quarter corner of Section Seventeen (17), Township 18 North, Range 15 East in the City of Omro; thence due East along the centerline of Scott Street 990 ft.; thence due South 33 ft. to the Northwest corner of Cutlot 91 which is the point of beginning; thence South along the West line of said Cutlot 91, 891 ft. to the Southwest corner of said Cutlot 91; thence East along the South line of said Cutlot 91, 345 ft. to the Southeast corner of said Cutlot 91; thence North $0^{\circ}22'$ East, along the East line of said Cutlot 91, 345 ft. to the Southwest corner of Cutlot 92; thence North $0^{\circ}08'$ West along the West line of Cutlot 92, 297 ft. to the South line of Scott Street; thence due West 318 ft. to the point of beginning, and that I have complied with Chapter 236.34, of the Wisconsin Statutes in surveying and mapping the same.

Given under my hand this 23rd day of February, 1970

Paul W. Bishop
 Paul W. Bishop, Land Surveyor, 23-190

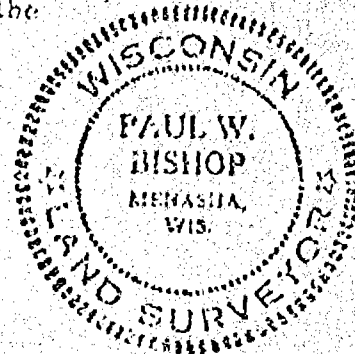


OMRO BASEBALL PARK DESCRIPTION

A tract of land in the Northwest Quarter (NW 1/4) of the Northeast Quarter (NE 1/4) of Section Seventeen (17), Township Eighteen (18) North, Range Fifteen (15) East, City of Omro, Winnebago County, Wisconsin, containing 4.059 acres and being described by: Commencing at the North Quarter Corner of said Section 17; thence South 661.00 feet along the West Line of the Northeast Quarter (NE 1/4) of said Section 17 to its intersection with the North Line of Huron Street; thence S. $89^{\circ}-54'-02''$ E., 165.00 feet along the North Line of Huron Street to the true point of beginning; thence continue S. $89^{\circ}-54'-02''$ E., 495.00 feet along the North Line of Huron Street; thence North 364.00 feet; thence N. $89^{\circ}-54'-02''$ W., 298.73 feet; thence South 12.00 feet; thence N. $89^{\circ}-54'-02''$ W., 31.27 feet; thence South 4.50 feet; thence N. $89^{\circ}-54'-02''$ W., 142.93 feet to a point on the Southeasterly Right-of-Way Line of East Main Street, (S.T.H. "21"); thence S. $43^{\circ}-48'-07''$ W., 31.88 feet along the Southeasterly Line of East Main Street, (S.T.H. "21"); thence South 324.45 feet to the true point of beginning.

STC/maf
5/27/75

17 18 15 14

SEC. LINE 2
NW COR. OF
NW 1/4 OF
NE 1/4 OF
SEC. 17

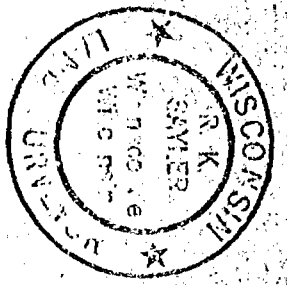


GERALD E. & MARJORIE M. HELLWIG

PART OF THE NW 1/4 OF THE NE 1/4 OF SEC. 17, T.18N., R.15E.
IN THE CITY OF OMRO, WINNEBAGO COUNTY, WISCONSIN.

90°17'E 1/4 SEC. LINE
721.00'

HARRISON AVE.

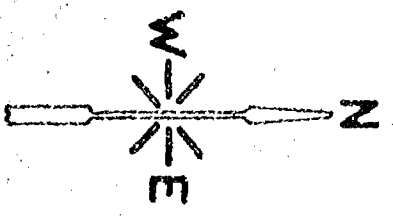

• DENOTES EXISTING IRON PIPE FOUND
o DENOTES IRON PIPE SET


R. K. Sawyer
Surveyor S-417

S-000687
Scale: 1 in. = 100 ft.
MARCH 7, 1977
EX. 35 P. 17

HURON

N 89° 05' E 780.00'

ST.

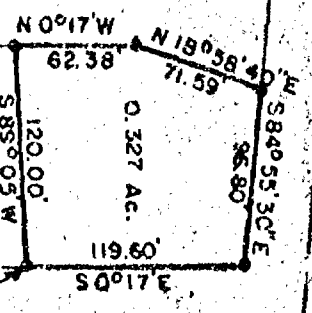

PREVIOUS SURVEY

60' 41.6' 72' 72' 72' 72' 72' 130.0'

MC KINLEY

AVE.

ST. TRK. HWY. 21

MAY 13 1977

Description For Parcel # 1

Description For Parcel # 2

[illegible]

Iron Stakes Show




Survey & Platting Co.
Oshkosh, Wis.
T.E.Stearns - Reg. Surveyor
Dec. 10, 1971

Scale
1" = 100'

290

No 579 Lots 31, 32, 33 & 34 Western Addn Omro Sec 17-18-15-
 Surveyed for Stone Gummey & others

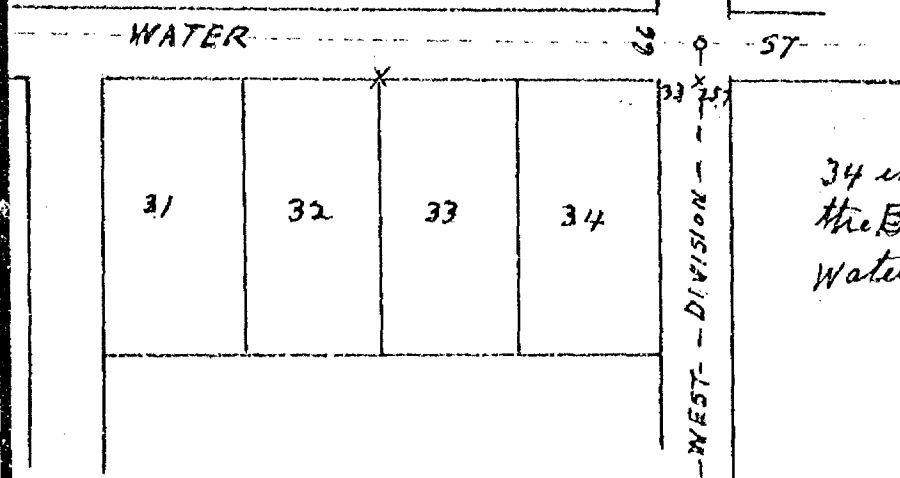

34 inches Overplus over
 the Blo ck. abutting on
 Water st.

Surveyed November 11th 1893
 H. W. Lea Ch.,
 County Surveyor

CITY OF OSHKOSH
 ENGINEERING DEPARTMENT

DRAWN

SCALE

Survey For E. Hellwig:

That Part Of The West 1/2 Of The N.E.1/4 Of The N.E.1/4 Of Sec. 17-18-15,
Town Of Omro, Winnebago County, Wis. Described As Follows:

Description For Parcel # 1


The East 350.0 ft. Of The West 408.0 ft. Of The North 350.0 ft. Of The
W.1/2 Of The N.E.1/4 Of The N.E.1/4 Of Sec. 17-18-15. Said Parcel Contains
2.81 Acres More Or Less.

Description For Parcel # 2

The East 120.0 ft. Of The West 528.0 ft. Of The North 250.0 ft. Of The
W.1/2 Of The N.E.1/4 Of The N.E.1/4 Of Sec. 17-18-15. Said Parcel Contains
0.69 Acres More Or Less.

Description For Parcel # 3

The East 150.0 ft. Of The West 678.0 ft. Of The North 250.0 ft. Of The
W.1/2 Of The N.E.1/4 Of The N.E.1/4 Of Sec. 17-18-15. Said Parcel Contains
0.86 Acres More Or Less.

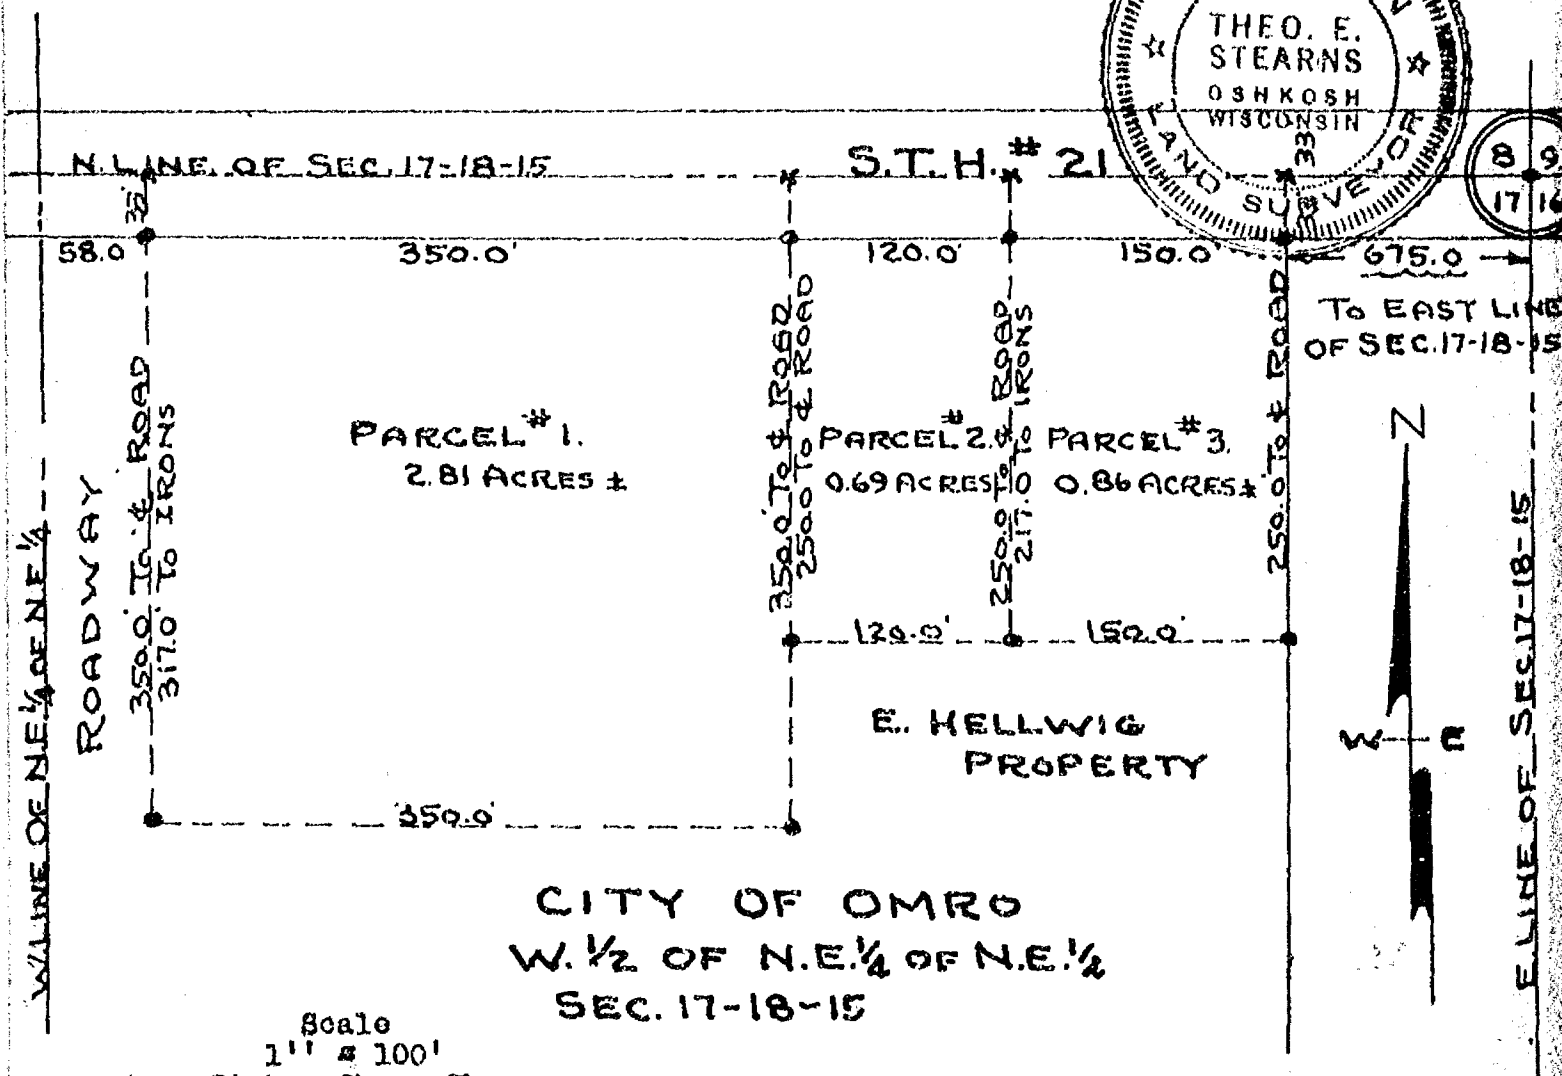

Scale
1" = 100'

Iron Stakes Shown Thus - •

State Law: 4 Parcels Of Land Under 1.5 Acres
May Be Sold In 5 Years.

Survey & Platting Co.
Oshkosh, Wis.
T.E. Stearns - Reg. Surveyor
July 23, 1966

Survey For Thomas Beck:

Description For Parcel # 1


That Part Of The N.E.1/4 Of The S.E.1/4 Of Sec. 17-18-15, Town Of Omro, Winnebago County, Wis. Described As Follows: The West 196.2 ft. Of The East 1140.2 ft. Of The North 222.0 ft. Of The N.E.1/4 Of The S.E.1/4 Of Sec. 17-18-15. Said Parcel Contains 1.0 Acre More Or Less.

Description For Parcel # 2

That Part Of The N.E.1/4 Of The S.E.1/4 Of Sec. 17-18-15, Town Of Omro, Winnebago County, Wis. Described As Follows: The West 151.6 ft. Of The East 455.0 ft. Of The North 288.0 ft. Of The N.E.1/4 Of The S.E.1/4 Of Sec. 17-18-15. Said Parcel Contains 1.0 Acre More Or Less.

Description For Parcel # 3

That Part Of The N.E.1/4 Of The S.E.1/4 Of Sec. 17-18-15, Town Of Omro, Winnebago County, Wis. Described As Follows: The East 196.2 ft. Of The North 222.0 ft. Of The N.E.1/4 Of The S.E.1/4 Of Sec. 17-18-15. Said Parcel Contains 1.0 Acre More Or Less.

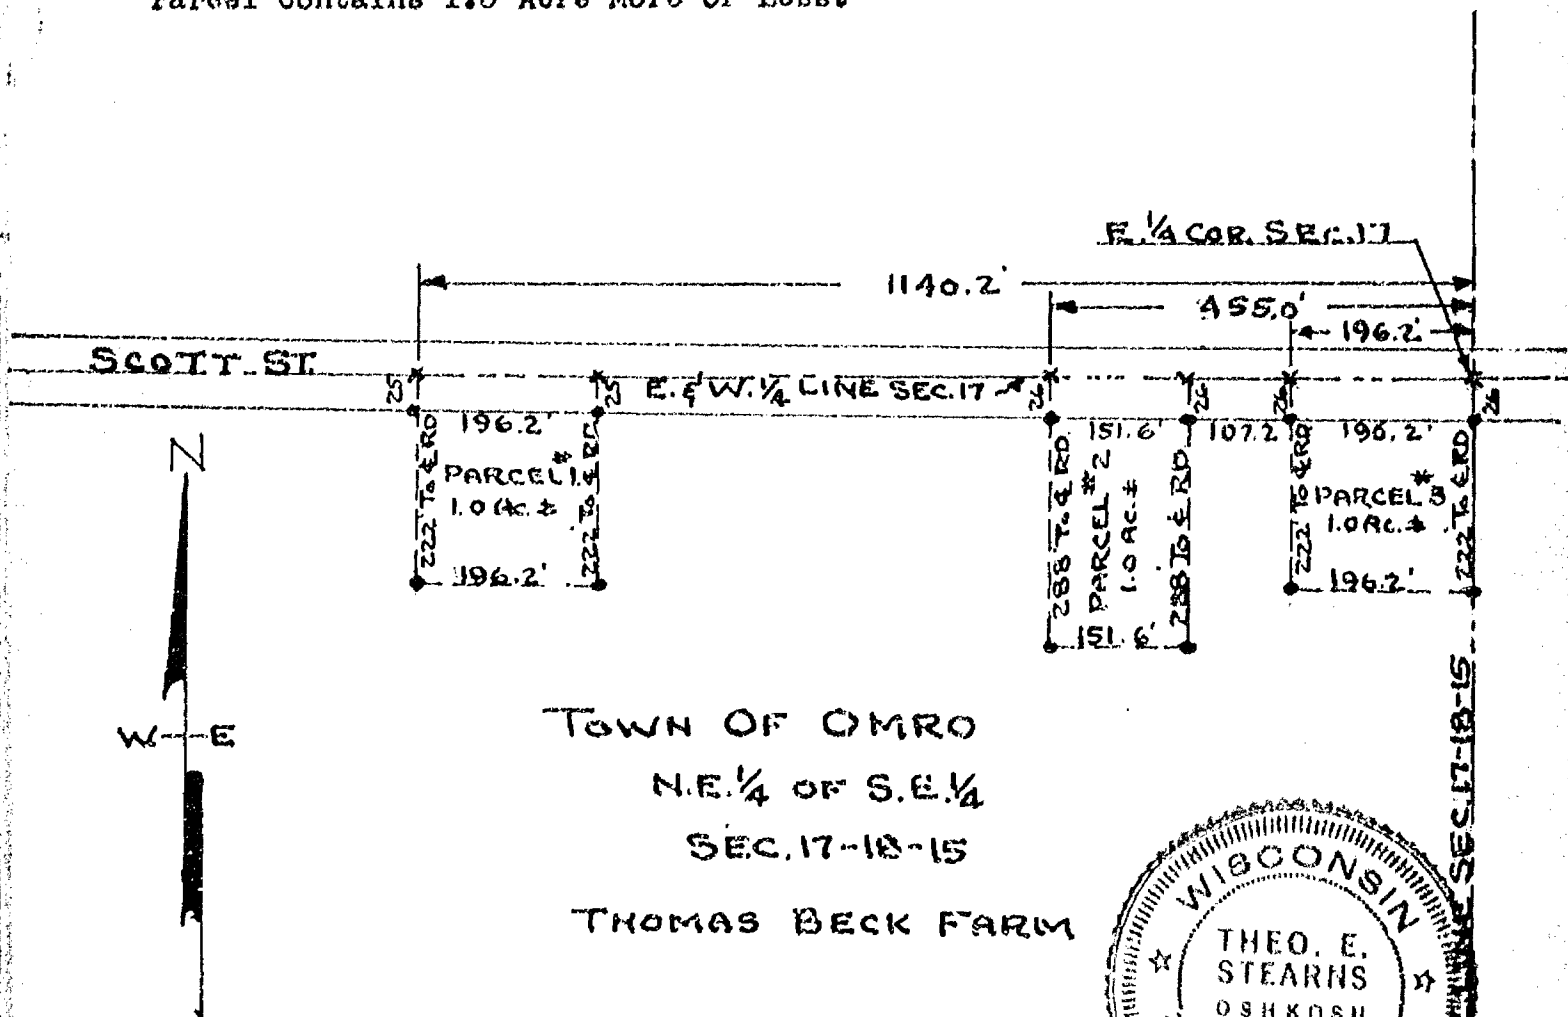

Scale

1" = 200'

Iron Stakes Shown Thus - •

State Law: Four Parcels Of Land Of 1.5 Acres
Or Less May Be Sold In Five Years.



Survey & Platting Co.
Oshkosh, Wis.
T.E. Stearns - Reg. Surveyor
May 6, 1967

⑦

SURVEY FOR ROBT BRAND.

OF E 1/2 LOT 8, W 1/2 LOT 9, W. LINE LOT 5

TOWN OF OMRO PLAT OF HIGH POINT

F. M. W. 1/2
G. S. Oster
H. Beggs


July 29

From E. h. lot 4 East there seems
to be about 0.1 per 100'

See Plats # 65


SURVEY FOR RICHIE
E 1/2 LOT 110
4/30/42

CHECK & ADDITIONAL
SIDE LINE STAKED
7/5/03

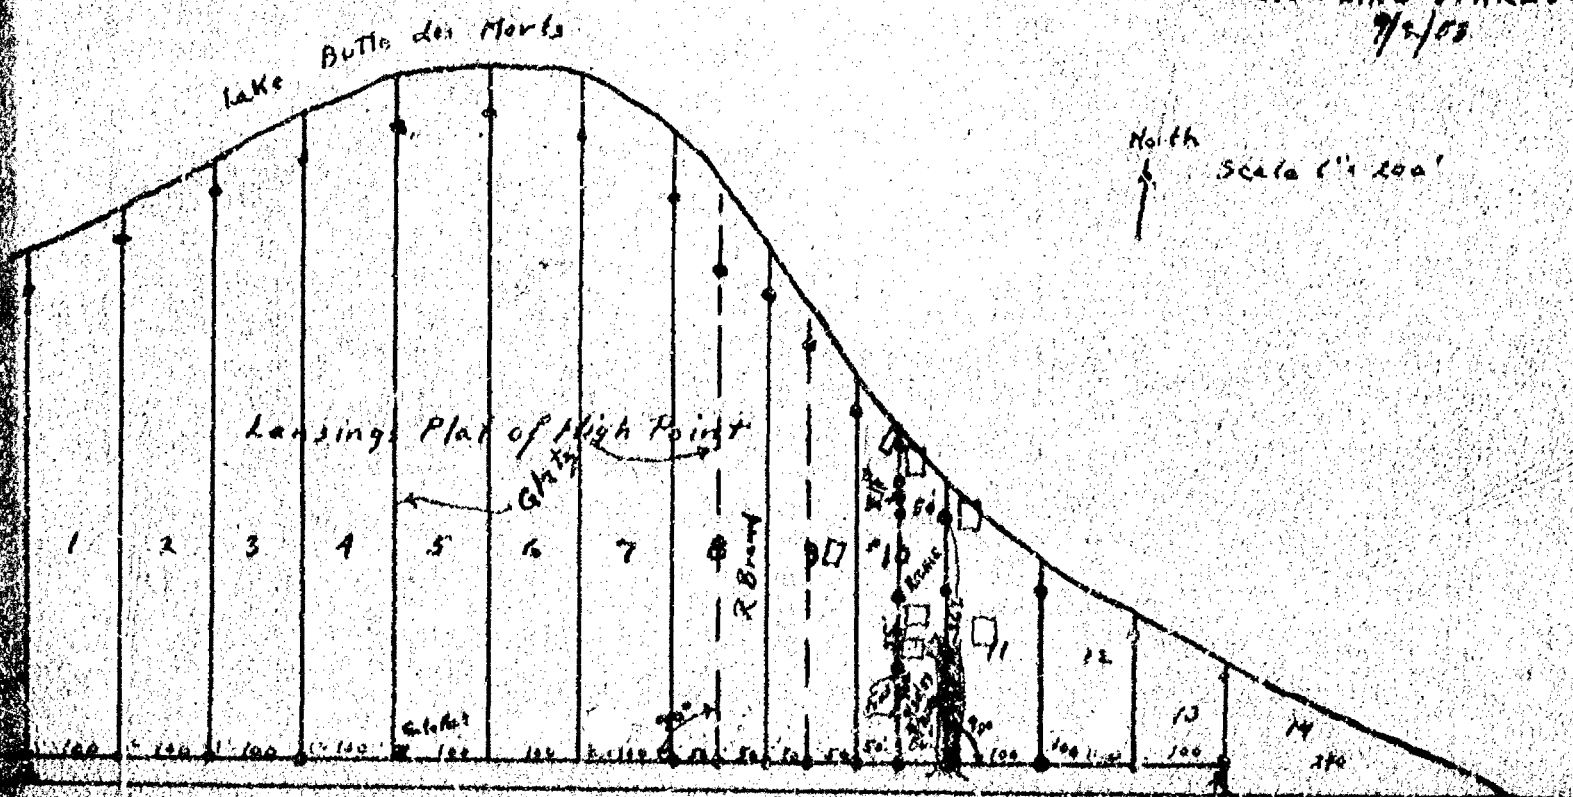

No 584 Village of Oshkosh
Survey for S. Leighton

Var. 40° E

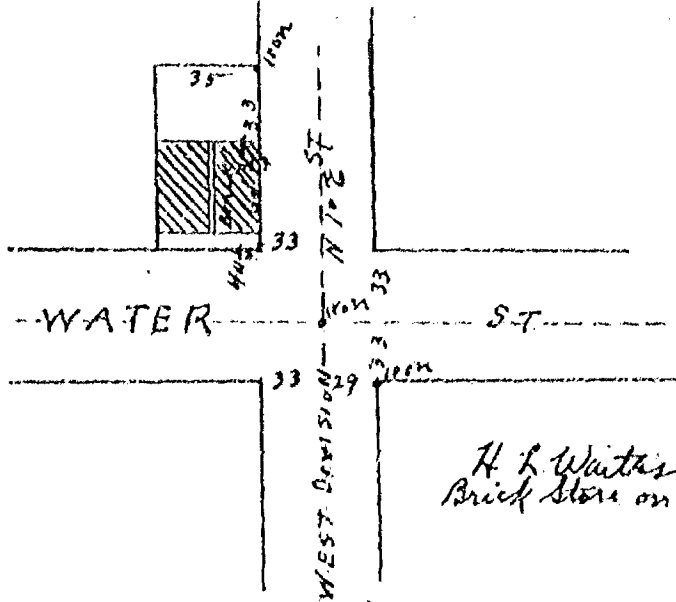

Chairman
Myron Price
Geo Price

H. L. Waiter's
Brick Store on corner

Recorded by G. H. Burgess


Surveyed March 23, 1894
J. W. Leach,
County Surveyor

CITY OF OSHKOSH
ENGINEERING DEPARTMENT

DRAWN

SCALE

17-58-15

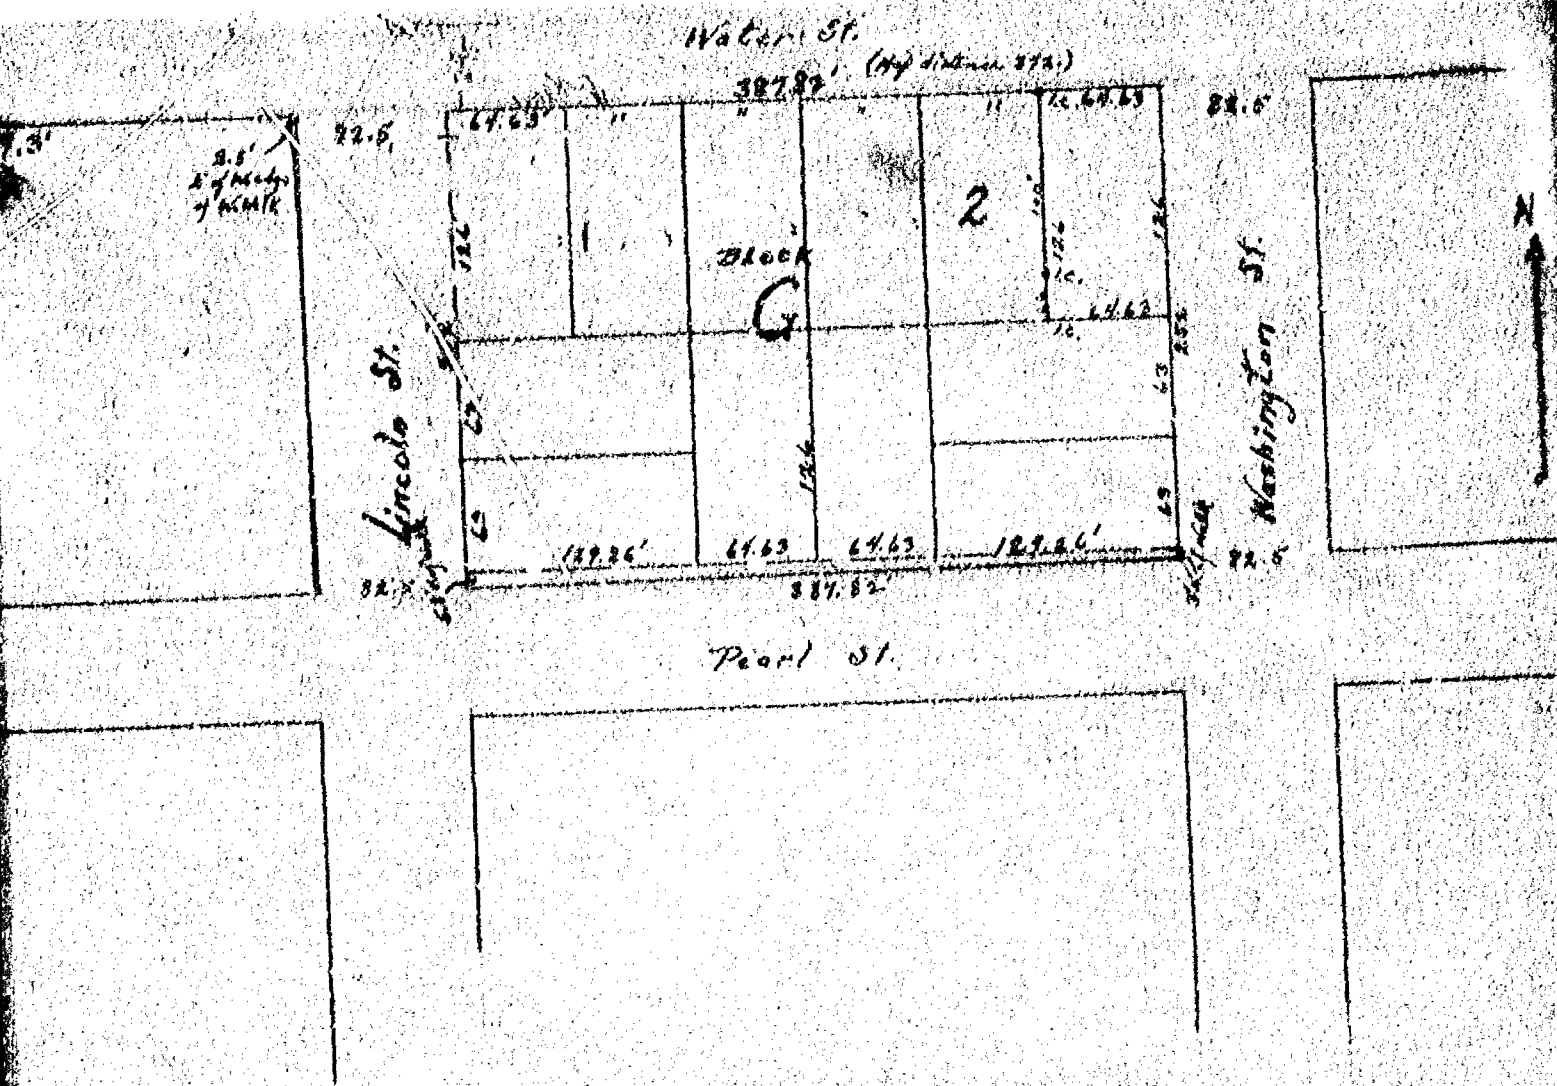

Survey of E. line of Lot 2 - Block G.

Village of Omro, Wis.

Scale 1"=100' T.F. Wolverton Surveyor Aug. 10, 1935

FOX RIVER

124	7	6	5	4	3	2	1	231
62	62	62	62	62	62	62	62	62

WATER ST.

62	62	62	62	62	62	62	62	62
124	6	5	4	3	2	1	124	62
62	62	62	62	62	62	62	62	62

PEARL

62	62	62	62	62	62	62	62	62
124	6	5	4	3	2	1	124	62
62	62	62	62	62	62	62	62	62

GENESEE

62	62	62	62	62	62	62	62	62
124	6	5	4	3	2	1	124	62
62	62	62	62	62	62	62	62	62

PLEASANT

62	62	62	62	62	62	62	62	62
124	6	5	4	3	2	1	124	62
62	62	62	62	62	62	62	62	62

62	62	62	62	62	62	62	62	62
124	6	5	4	3	2	1	124	62
62	62	62	62	62	62	62	62	62

ST.


CAVITY TO KINGS 120

HARRY M. SCHMITT
ABSTRACT CO.
OSHKOSH, WIS.

SCALE 1" = 200'
VOL. 1 PG. 48

EASTERN ADDITION TO
PLAT OF OMRO

11-18-15

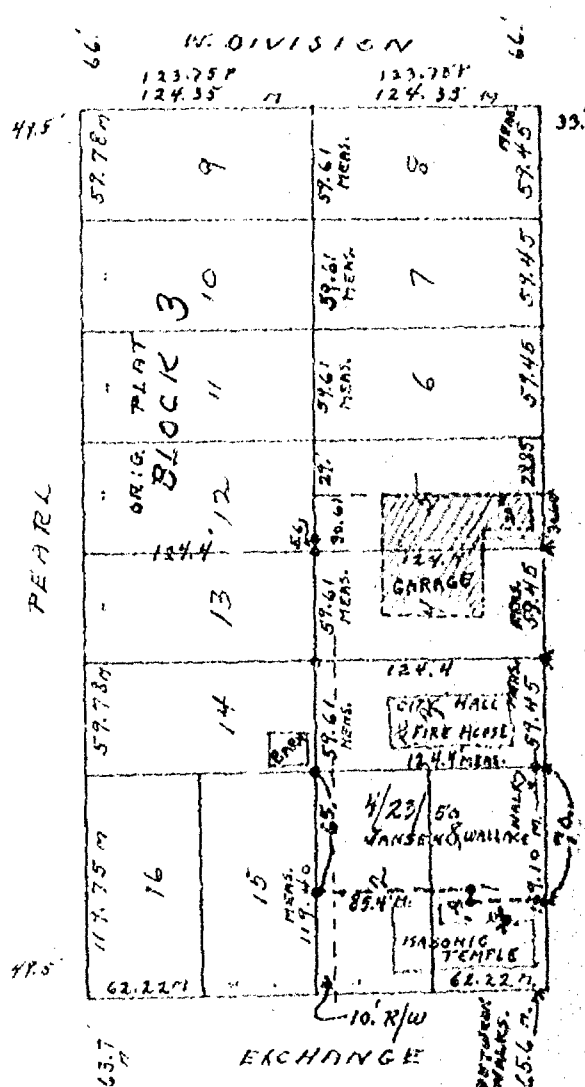

To
BRIDGE

(480.78' Block -
(475.80' 3/4)

SURVEY FOR
JANSEN & WALLACE
BEGIN AT N.W. COR. LOT 1 BL. 3
ORIGINAL PLAT OF OMRO., THENCE E. 70',
S. 39', W. 5', S. TO S. LINE LOT 2 BL. 3, W. TO
S.W. COR. LOT 2, N. TO BEGINNING.

4/23/50 RFW-HK

MILL ST.

CITY OF OSHKOSH
ENGINEERING DEPARTMENT


DRAWN
8/9/40
SCALE
100' = 1"

SURVEY LOT 4 & LOCATION OF
BLDG. ON E. N. LOT 5 - BLOCK 3
ORIG. PLAT - OMRO.
R.F.W. 18-15


BUCKOWEITZ

DEED CALLED FOR
LOT 1 & E. 100' OF LOT 2
BUT I FIND A CONC. BLDG. ABOUT
40 YEARS OLD OCCUPYS 37.5'
OF LOT 2 WITH CLEARANCE
AND AS IT FITS POSSESSION
LINES OF PARCEL W. OF IT
I STAKED IT OUT AT 37.5'
OWNER TO FILE NOTICE OF
SUCH POSSESSION TO CORRECT
HIS DEED.

REW. 10/26/40

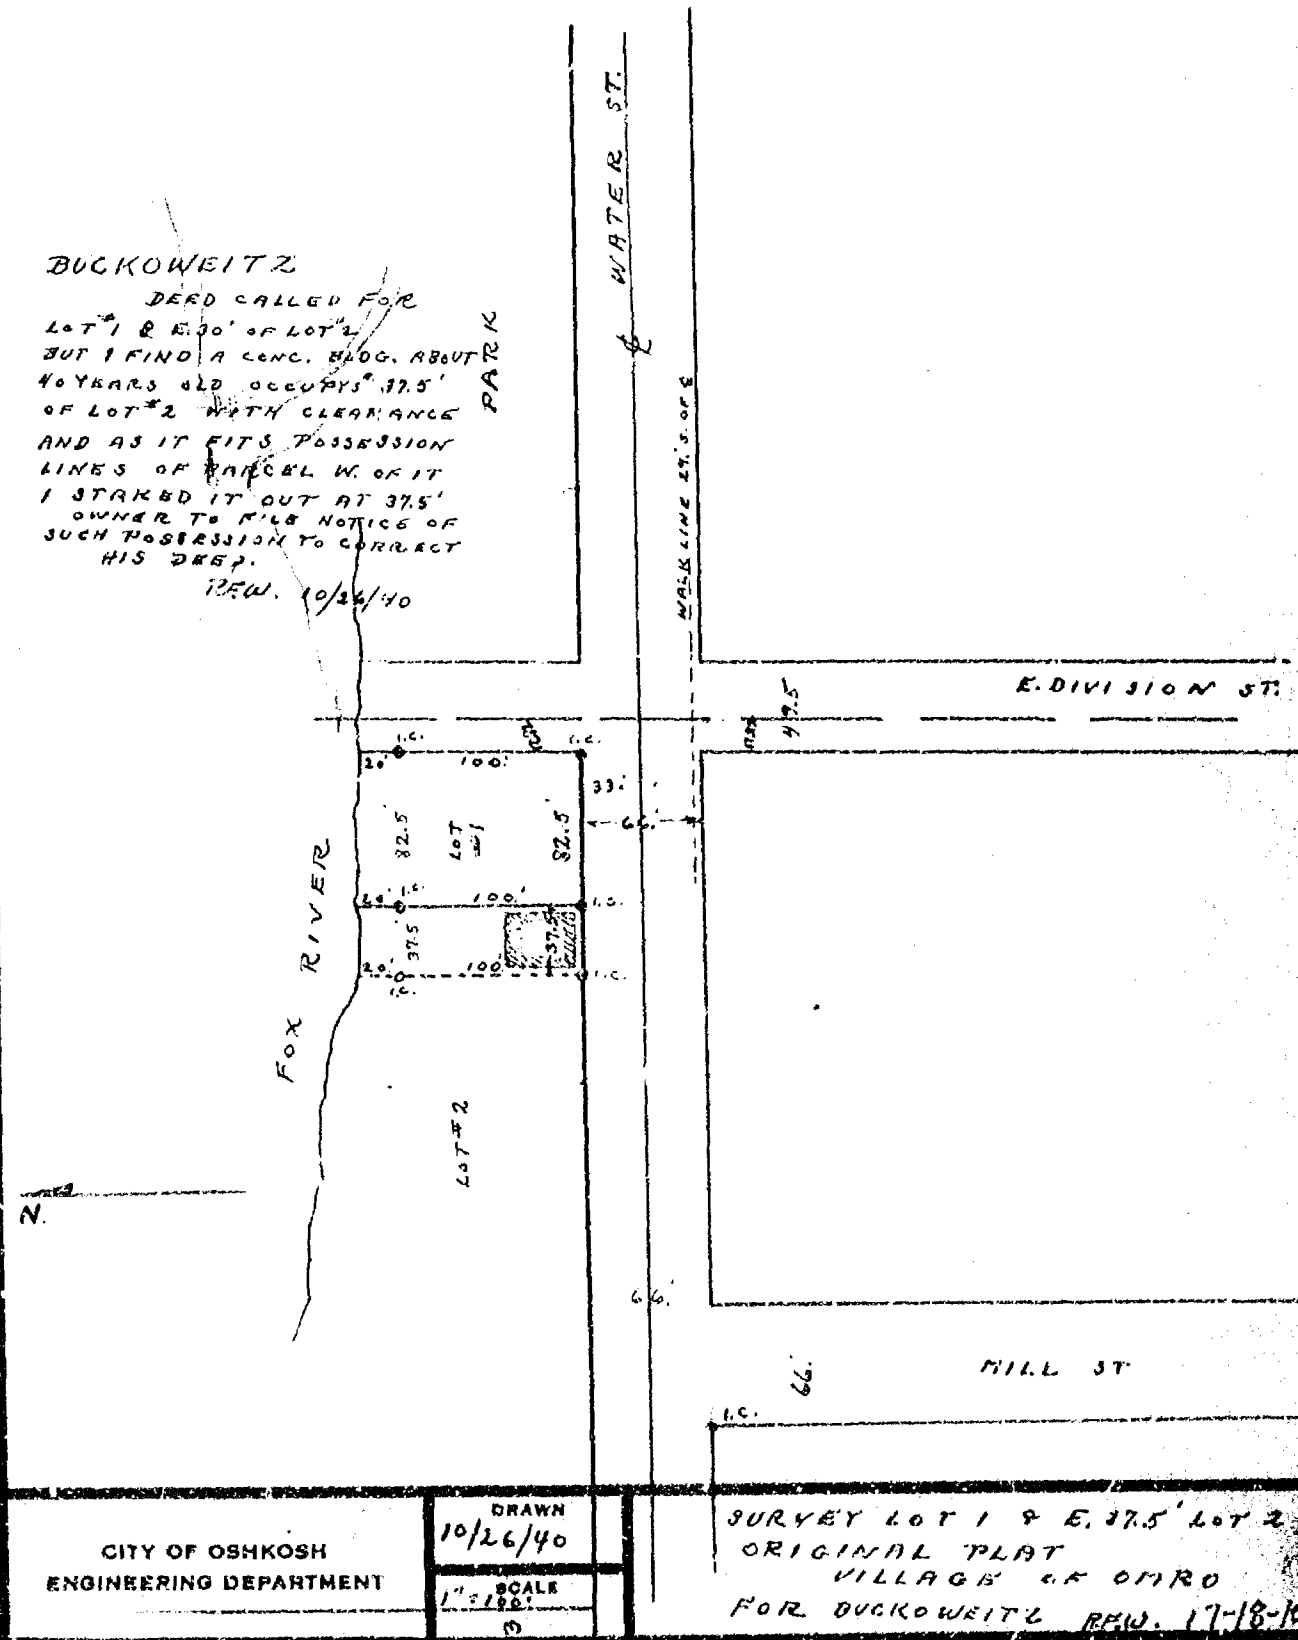

5. 88. LOT 12
ORIGINAL PLAT
AS. ANDREWS
R.F.W.

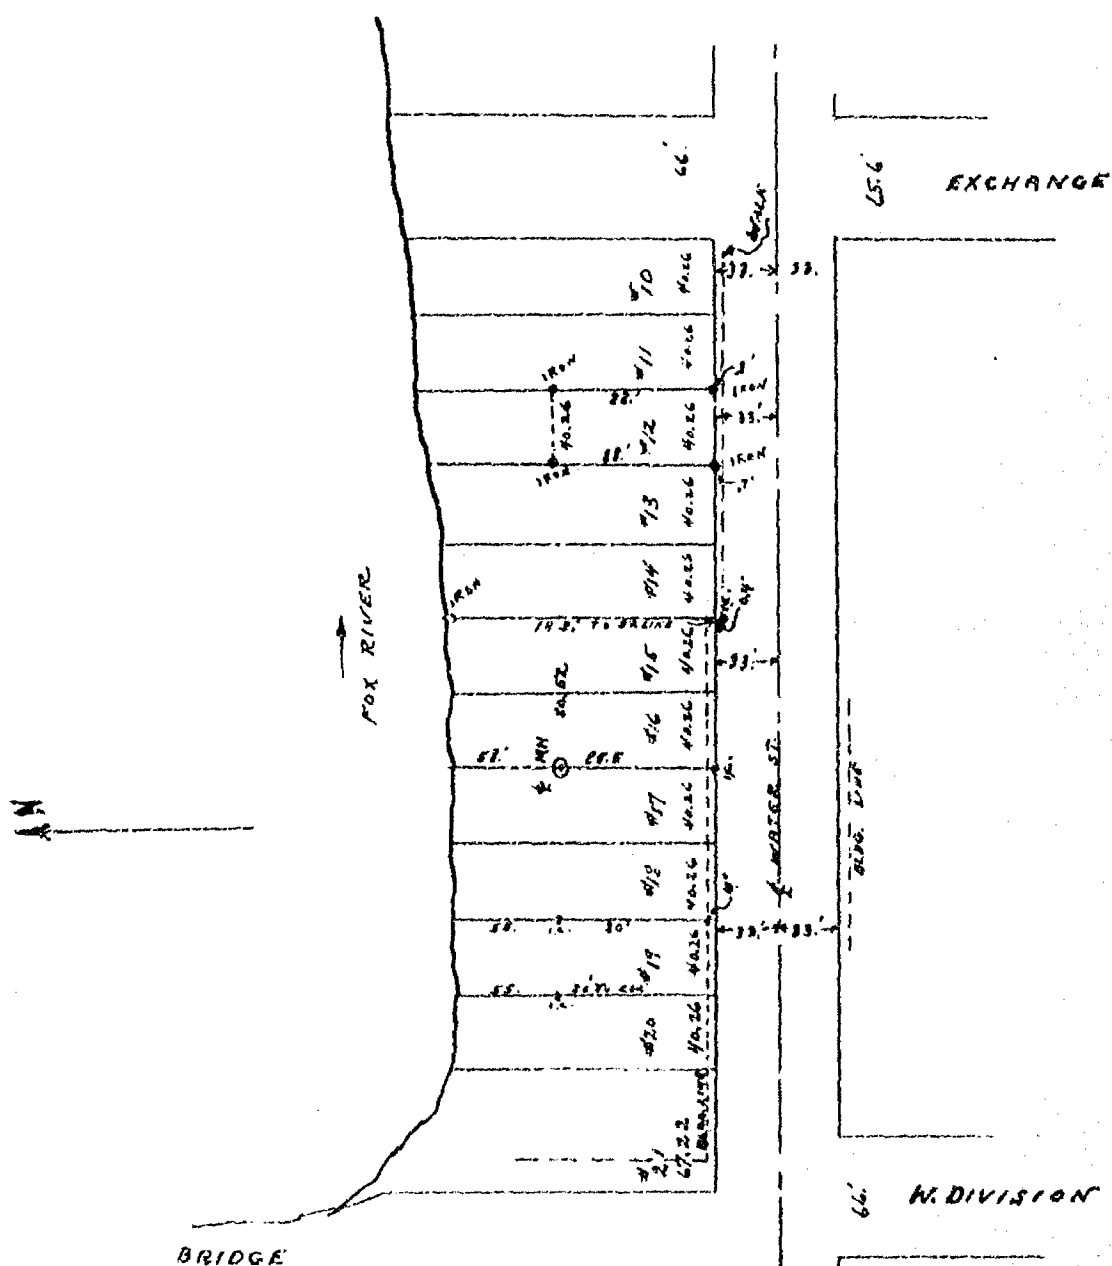

CITY OF OSHKOSH
ENGINEERING DEPARTMENT
R.F. WOLVERTON
F. QUINN

DRAWN


2/24/45

SCALE

1st 100

SURVEY LOTS 15 & 16
ORIGINAL PLAT OF OMRO
FOR DEEP ROCK GAS STATION

17-18-15

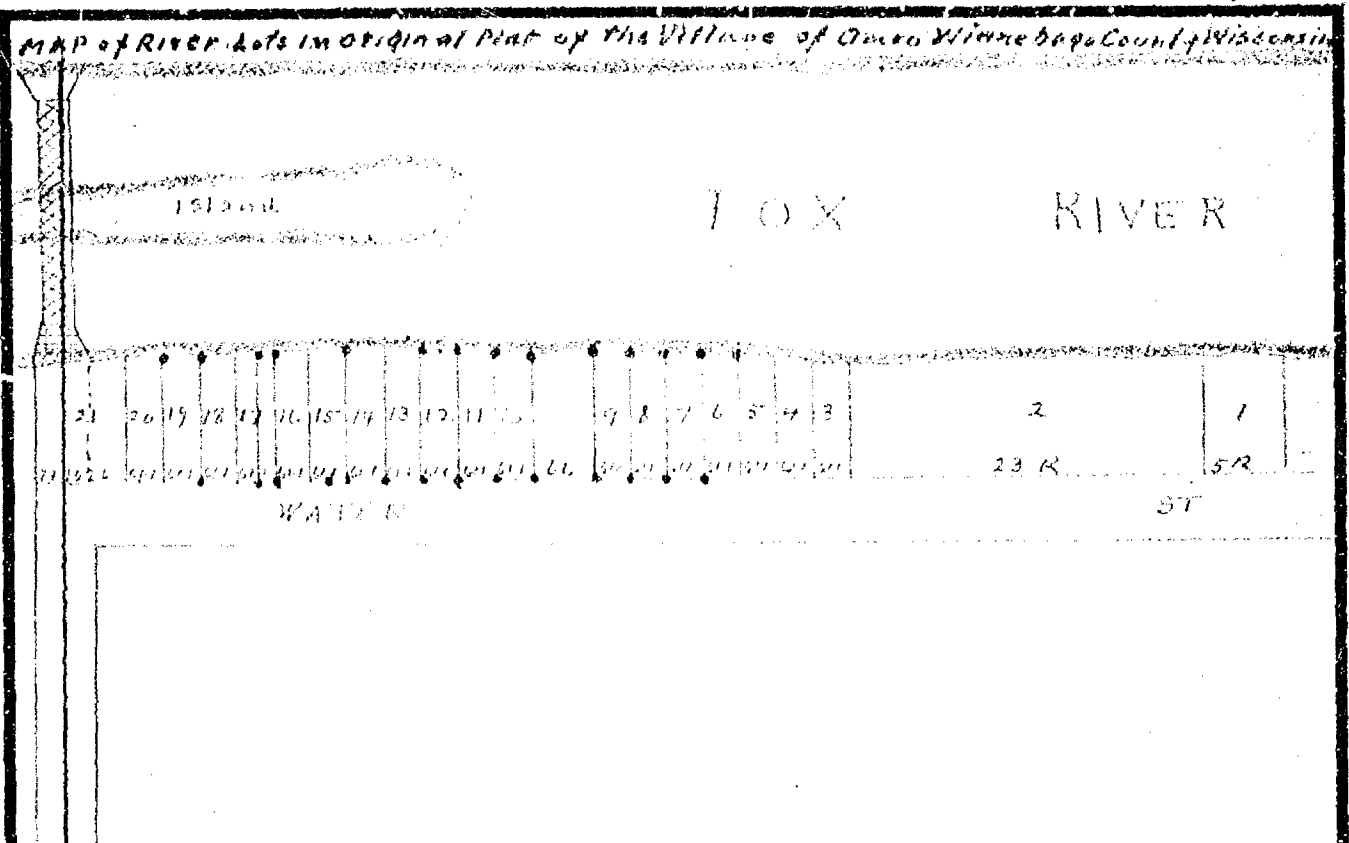


I Began at the center of Water and West Division Streets where I found an iron stake set for center of streets I then ran out the Lots as shown on the above map and set iron stakes as shown marked in Red Ink thus (o) this work was done by me according to the Recorded of August 14th 1849 Began May 19th 1910 Completed.
 May 19th 1910 W W Goold Co Surveyor
 W W Goold Chainman
 Frank Krohn

CITY OF OSHKOSH ENGINEERING DEPARTMENT	DRAWN	MAP OF RIVER LOTS IN ORIGINAL PLAT OF THE VILLAGE OF OMRO WINNEBAGO COUNTY WISCONSIN
	SCALE	

Survey of Out Lot 64 in Village of Omro Wis

(a) Iron stakes set by W.W. Gould Co Surveyor

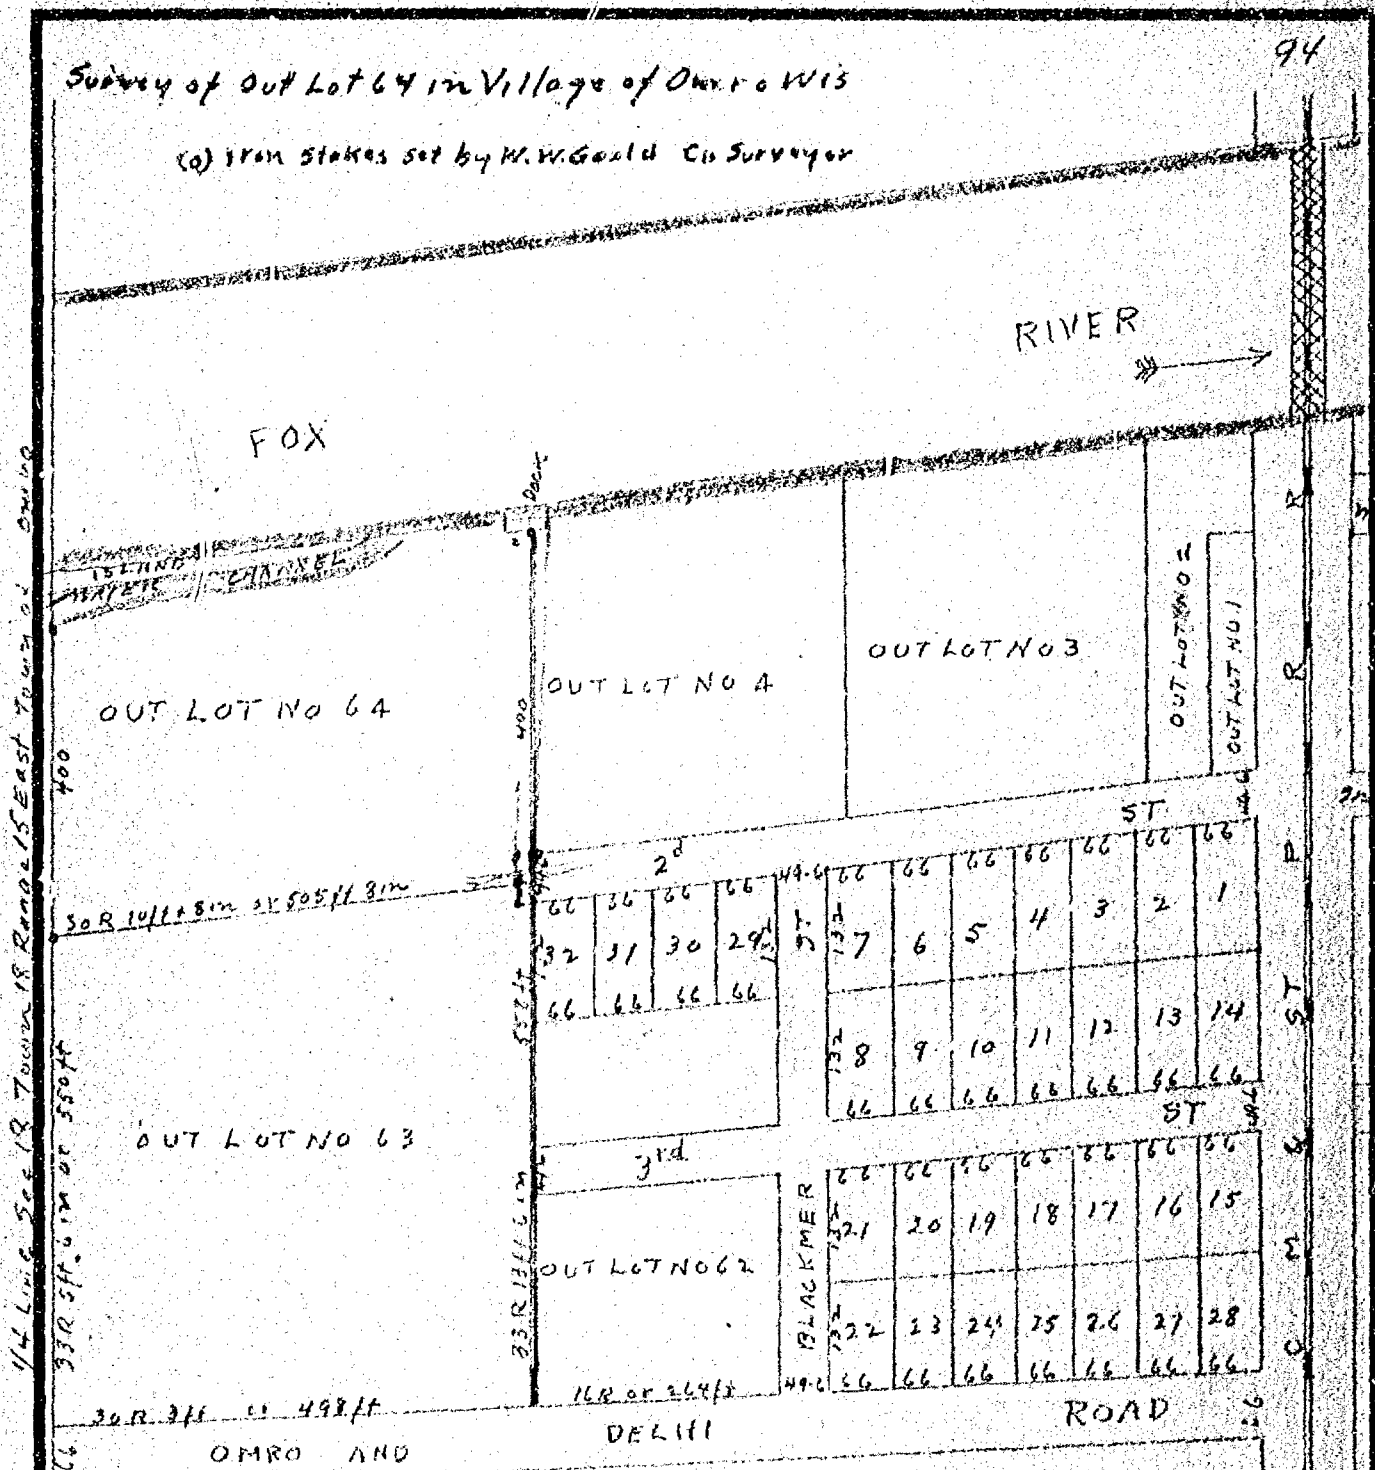

I Began on the 1/4 line in Sec 18 in the center of the Omro and Delhi Road and established the SW and SE corner of out Lot 64 according to the Deed of out Lot 63 from N B Blackmer and wife to William H Morey Dated Oct 7th 1868 I then ran out Lot 64 and set iron stakes as shown on the above map marked in Red Ink thus (a) Began July 31st 1911 Completed July 31st 1911 W W Gould Co Surveyor

W W Gould Chairman
Dan Cady

CITY OF OSHKOSH
ENGINEERING DEPARTMENT


DRAWN

SCALE

1" = 200'

SURVEY OF OUT LOT 64 IN VILLAGE OF OMRO WIS.

17-18-15

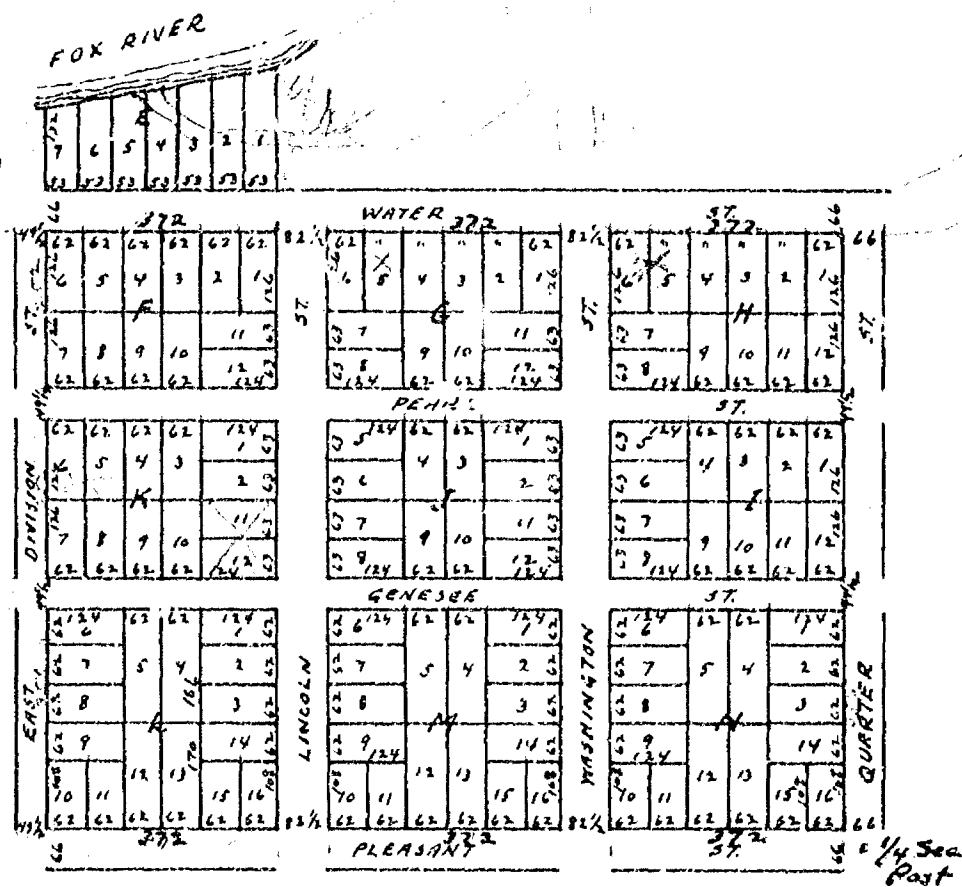

MAP OF
EASTERN ADON TO OHIO
G.A. Randall
Surveyor
Scale 1/2" = 1/2 mile
Copied April 8, 1936
From Field Book Notes

Adon to Ohio
G.A. Randall
Surveyor

Description
Omro Development Corp.


That part of Sec. 17-18-15 described as follows;
Commencing at the North West corner of the North East $\frac{1}{4}$ of Sec.
17-18-15, thence South along the Quarter Sec. line 891.0 feet,
thence East at a 90 angle 660.0 feet to an iron stake, this being
the place of beginning; thence North parallel with the Quarter Sec.
line 594.0 feet, thence East at a 90 angle 557.0 feet, thence South
parallel with the Quarter Sec. line 594.0 feet, thence West 557.0 feet
to the place of beginning, said Parcel being 7.6 Acres.

No 550

269

in Sec 17-18-15 E
Survey of lot 8 Blk 3 Original Plat of Omro

Var. $11^{\circ}15' E$

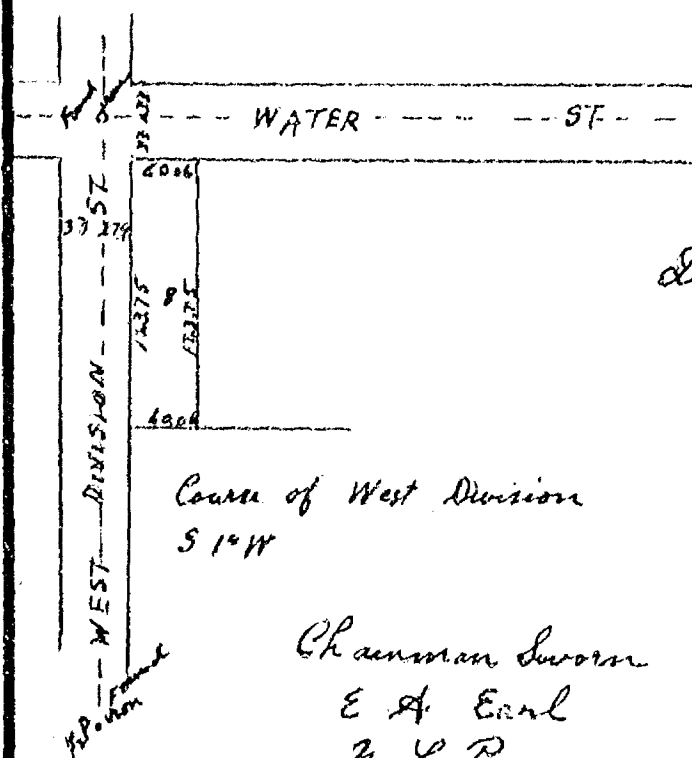

Dug & found Iron in Water &
West Division St

Course of West Division
S 1° W


Chairman Sworn
E A Earl
M L Pierce

Surveyed May 6th 1891
H W Leach
County Surveyor

CITY OF OSHKOSH
ENGINEERING DEPARTMENT

DRAWN

SCALE

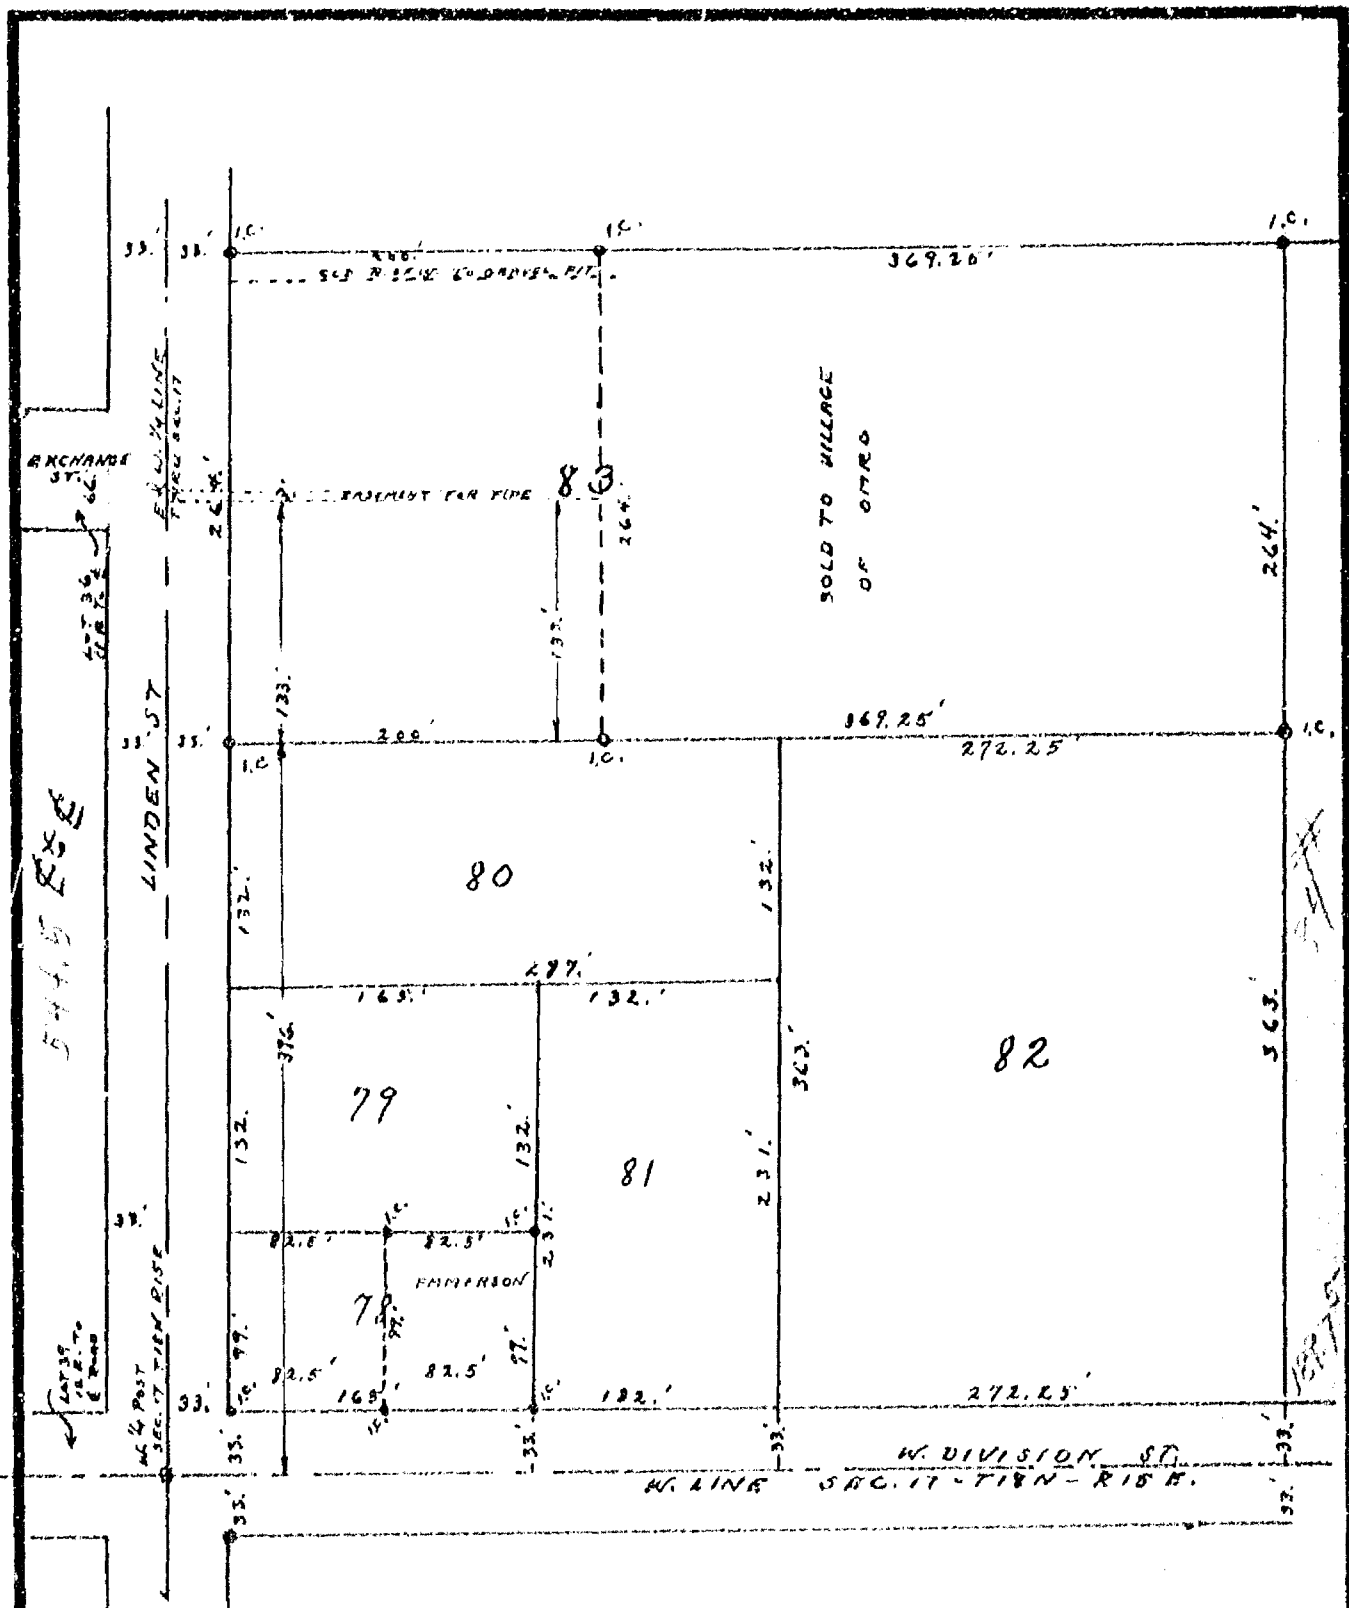

N — NOTATION THE ORIGINAL PLAT
 EQU MEASURES ARE FROM
 W. LINE SEC. 17.
 N. & S. MEASURES ARE FROM
 S. LINE OF LINDEN ST. OR S. S. OF
 EQU. LINE

CITY OF OSHKOSH
 ENGINEERING DEPARTMENT

RENG

DRAWN

5/16/41

SCALE

1" = 100'

OUTLOT # 83 EXCEPTING THE N. 200'
 THERE FROM TO VILLAGE OF OIRO FOR
 WATER WORKS N.E. 1/4 of S.W. 1/4 SEC. 17
 TOWN OF OIRO
 3 1/2 FRONT & REAR OF OUTLOT 78 9/10/41

SURVEY FOR
OMRO DEVELOPMENT CORP.

LINE SEC 17-18-15

NW COR OF NE 1/4 SEC 17

S.T.H. #21

NW 1/4 OF NE 1/4
SEC. 17-18-15

ROADWAY

ROADWAY

660.0 To E ROAD

660.0 To E ROAD

PARCEL #1
0.65 ACRES

HARRISON AVE.

Huron St



Scale
1" = 100'

IRON STAKES SHOWN THUS -

17-18

SURVEY FOR:-
OMRO DEVELOPMENT CORP.

N. LINE SEC. 17-18-15

N.W. COR. OF N.E. 1/4 SEC. 17

S.T.H. # 21

N.W. 1/4 OF N.E. 1/4
SEC. 17-18-15

445.5

N.E. 1/4 LINE

33 33

66

165.0

332.0

16.5

132.0

165.0 To E. RD
132.0

PARCEL "1"
0.45 ACRES

215.5

215.5

132.0
165 To E. RD

495.0

ROADWAY


660.0 To E. ROAD

60

170.0


660.0 To E. ROAD

33 33

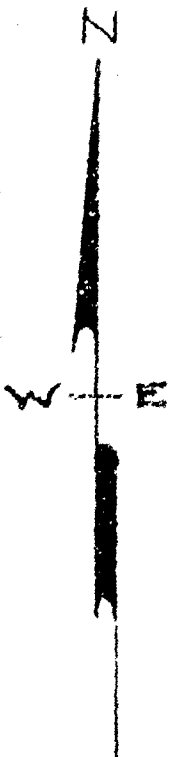

SCALE
1" = 100'

IRON STAKES SHOWN THUS - o

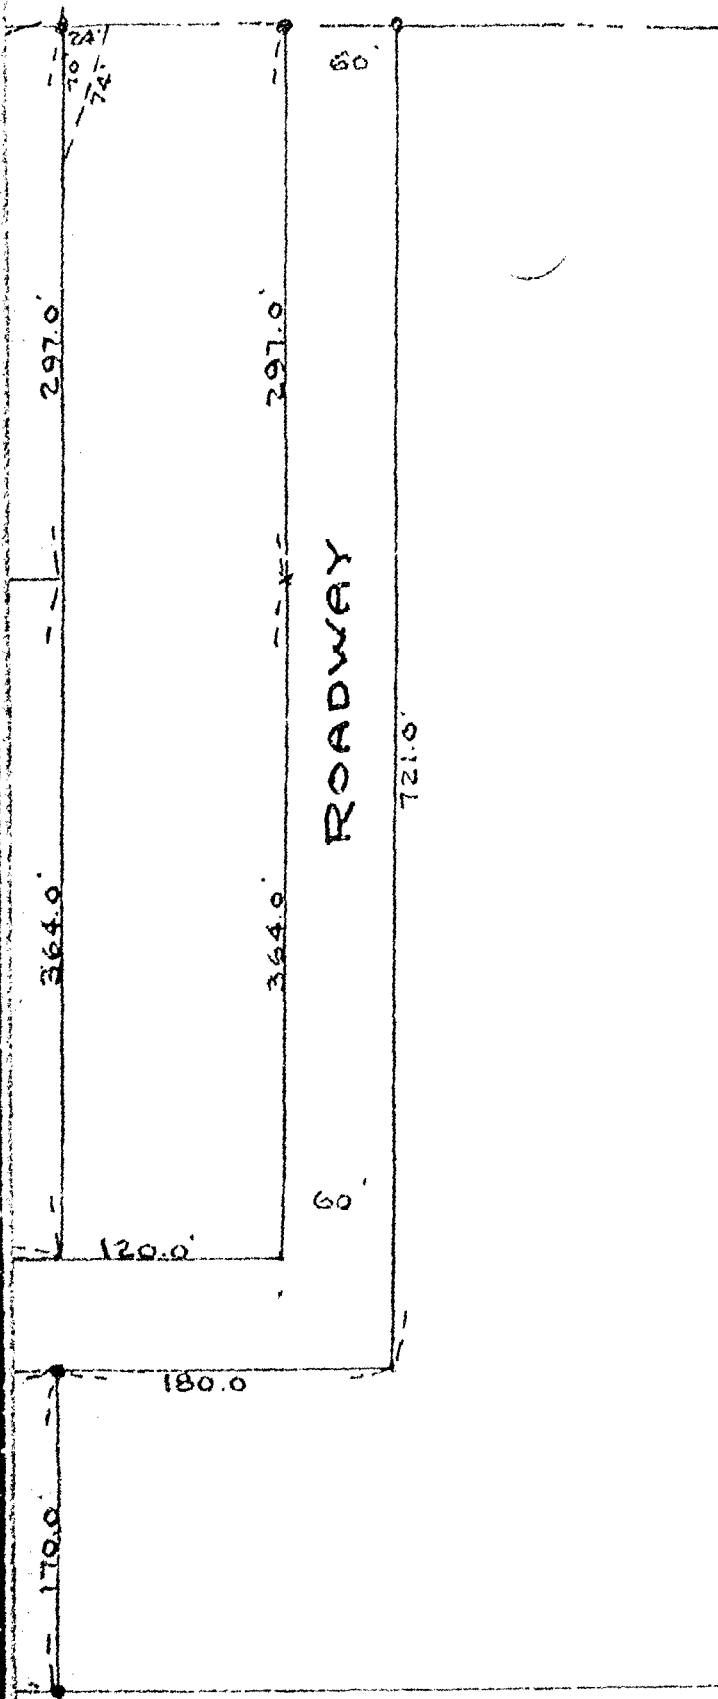

SURVEY AND PLATTING Co.

OSHKOSH, WIS.

T.E. STEARNS - REG. SURVEYOR

AUG. 7, 1967.

17-18-15

(5)