


SURVEY OF LAND IN SE 1/4 SE 1/4 SEC 18 TOWNSHIP NO 18 RANGE NO 15 EAST TOWN OF OMRO WIS.

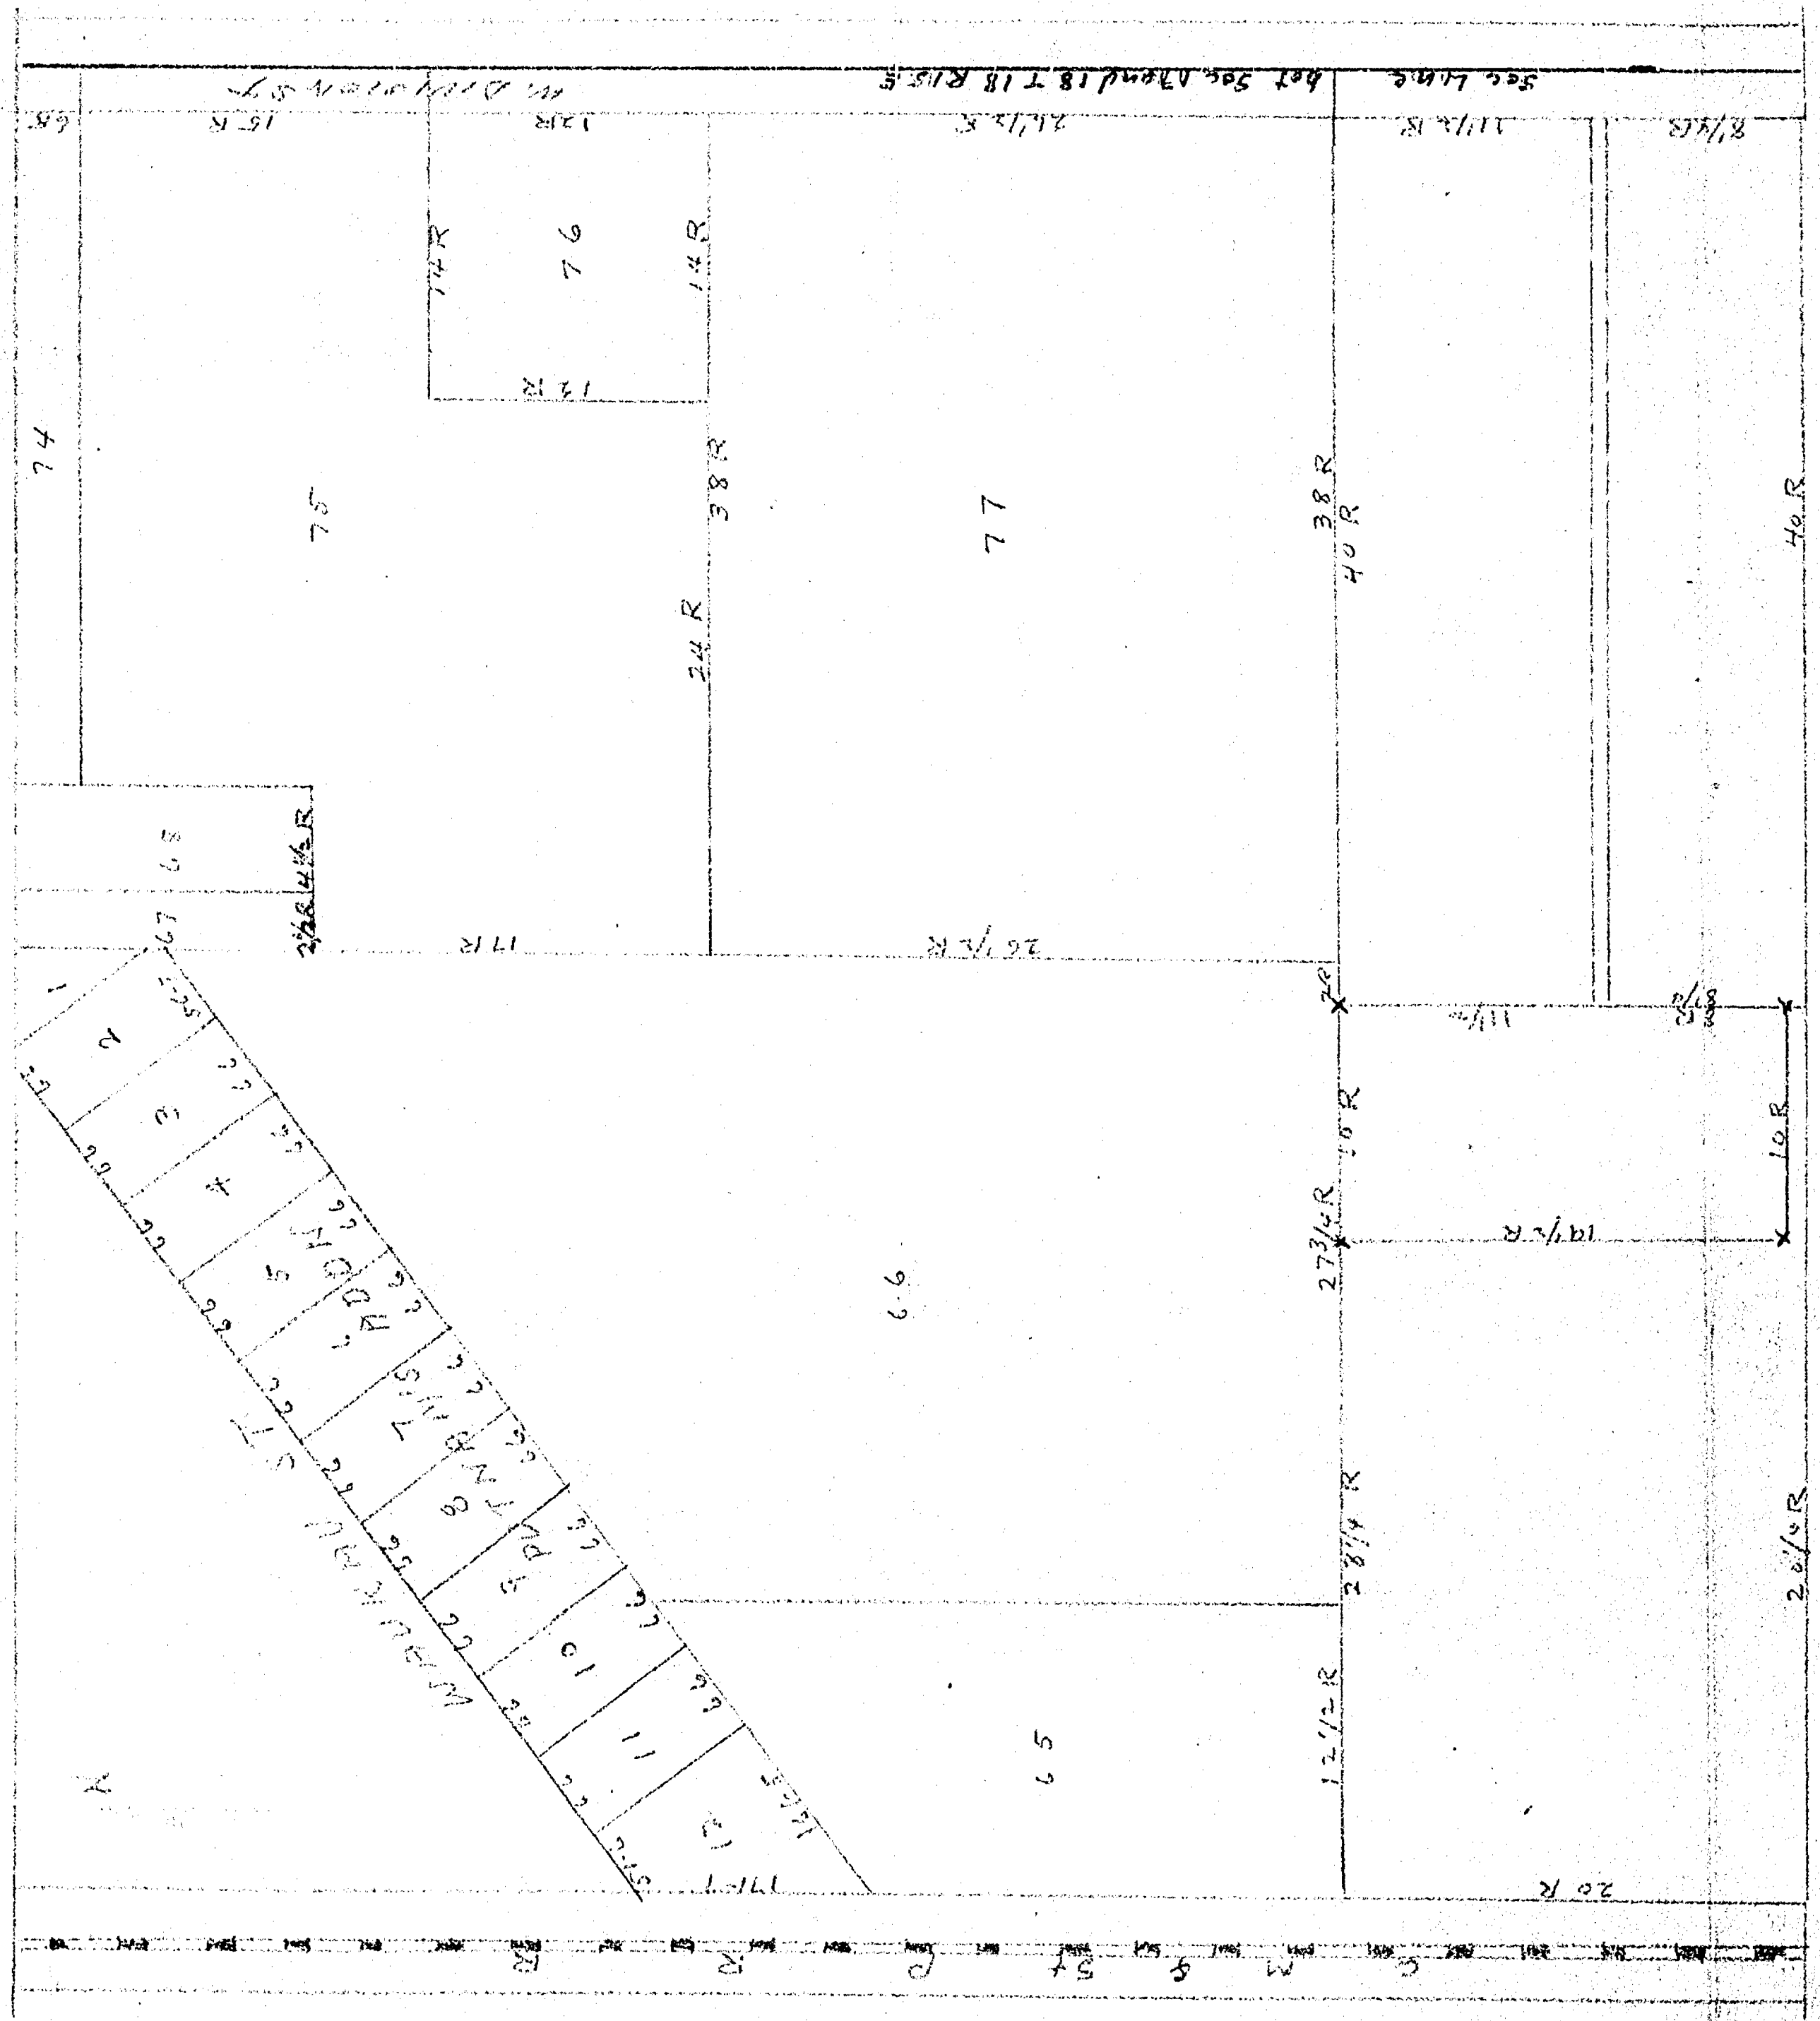

I Surveyed out this small Piece of land in SE 1/4 SE 1/4 Sec 18 as shown on above map according to the Deed shown me by H C Reitz the owner of the land adjoining I set Iron stakes as shown on above map marked In Red Ink as instructed by H C Reitz and Deed shown me Began Aug 15th 1921 Completed Aug 15th 1921  
W W Goold Co Surveyor  
W W Goold Chainman  
Elmer Reitz

CITY OF OSHKOSH  
ENGINEERING DEPARTMENT

DRAWN  
SCALE

SURVEY OF LAND IN S E 1/4 S E 1/4 SEC 18  
TOWNSHIP NO 18 RANGE NO 15 EAST TOWN OF  
OMRO WIS

85-18-15

262



N. E.  $\frac{1}{4}$

U  
D  
I  
D  
U

PARCEL "A"  
4.65 ACRES ±

U D I D J

NW 1/4

一、二、三、四、五

40x

DUE E. & W. LINE // 8-18-12  
SURVEY AND PLATTING CO.  
OSHKOSH, WIS.  
T.E. STEARNS-REG. SURVEYOR  
MAY 2, 1964.

IRON STAKES SHOWN THUS - •



CROSS SECTION OF THE FOX RIVER  
IN THE CITY OF OMRO, WIS.

WATER EL. 1000' UPSTREAM = 747.85  
WATER EL. 1000' DOWNSTREAM = 747.65

FOX RIVER

WATER EL. 747.75

DREDGE AREA

CHANNEL

LILLY PADS

MARSH

IMMEDIATE BANK 748.5

5 IN. 27 1991

750.5


749.0

760.00

SCALE: 1" = 160' HORIZ.  
1" = 5' VERT.

MAY 28, 1976

STEVEN T. CHRONIS  
WISCONSIN REG. LAND SURVEYOR 5-918

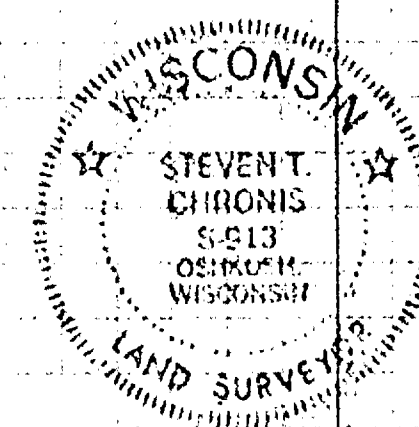

TUBE NO. 32

KUPFEL & ESSER CO.  
MADE IN U.S.A.

KUPFEL & ESSER CO.  
MADE IN U.S.A.

KUPFEL & ESSER CO.  
MADE IN U.S.A.


KUPFEL & ESSER CO.  
MADE IN U.S.A.

KUPFEL & ESSER CO.  
MADE IN U.S.A.

18-18-15

WE



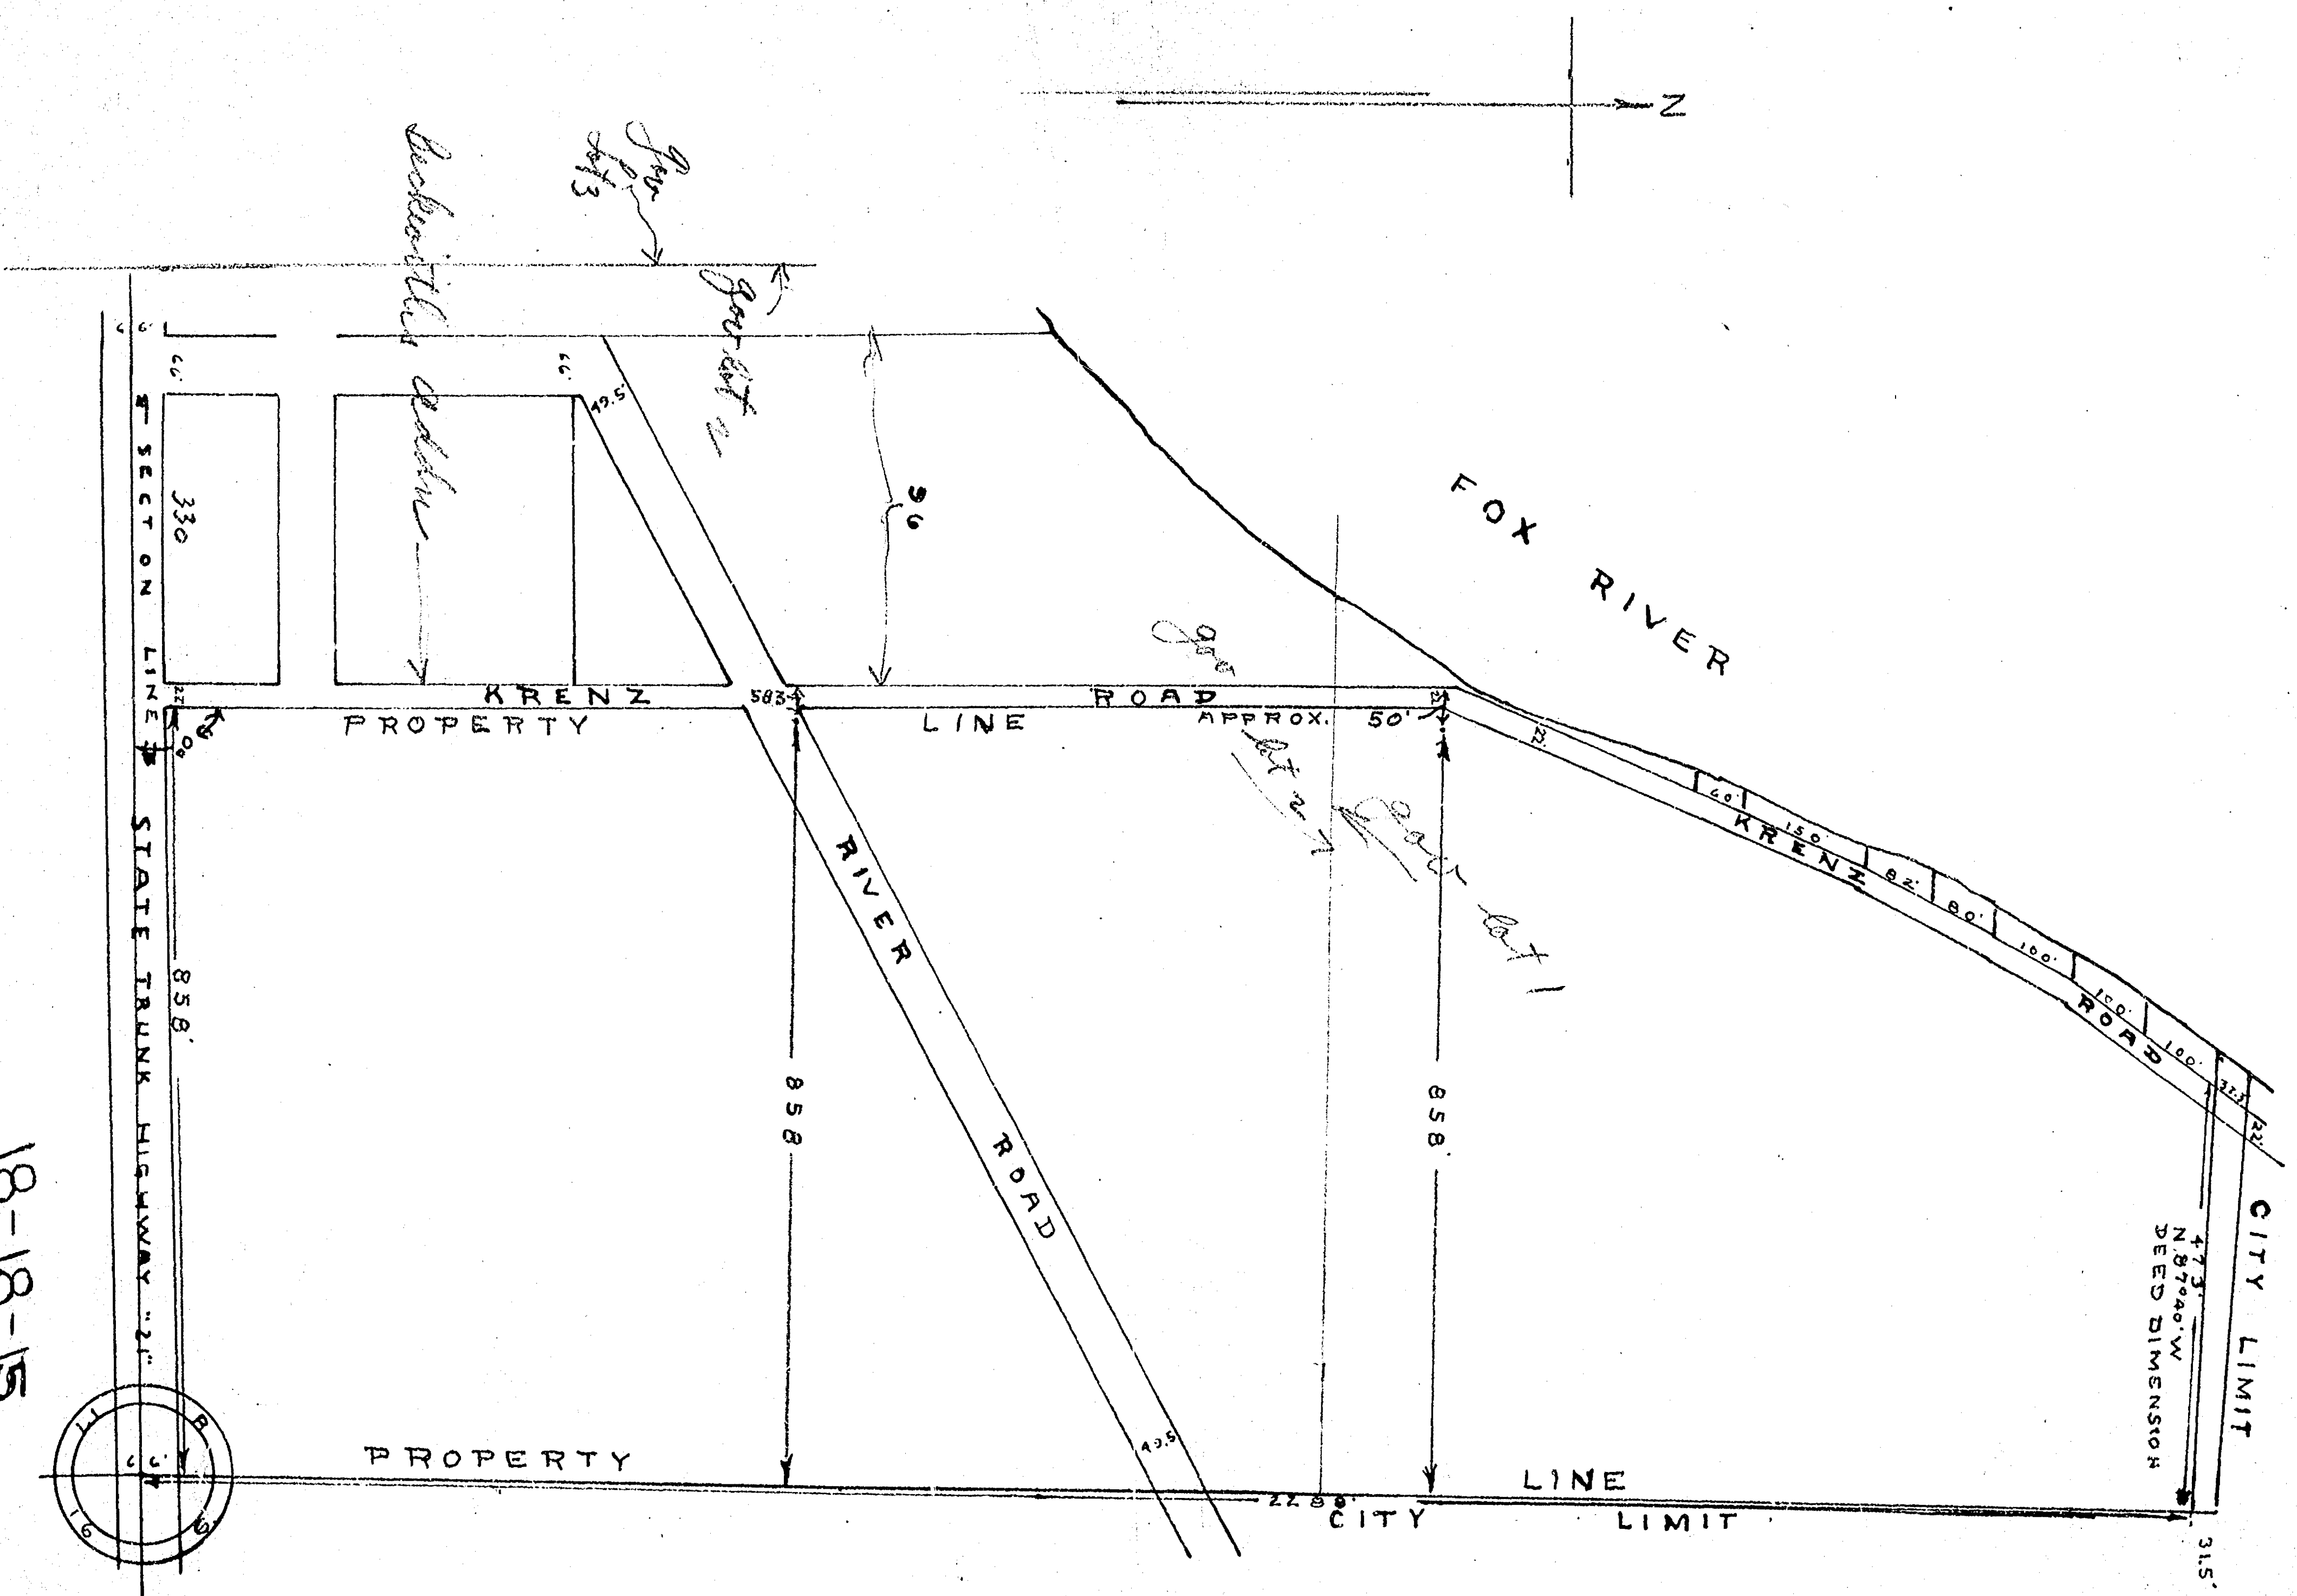

18-18-15

18-18-15