

18-18-15

UNTY

18-18-75

SURVEYED FOR	SURVEYOR	R.L.S. NO.	DATE	CERTIFIED SURVEYS			NO.	SURVEY LOCATION
				MAP NO	VOL	PAGE		
Herm. S. Larsen	Hawthornth		2-17-81					Lot 15, Franks 2nd Add
Richard Schelle	"	"	10-31-80					OUTLOT 41 - Plat of outlots
Hilling Realty	"	"	8-29-80					OUTLOT 41, 42
D. J. Stohr	"	"	6-26-80					Lot 3, Blk 6, Original plat
Tyson Blake	"	"	5-11-81					Lot 10, 11 Johnsons 2nd Add
Catherine Hipon	"	"	5-13-80					Block 90 Original Plat
R. Greaser	"	"	7-24-81	570194	1		963	OUTLOT 9
J. Kabolke	"	"	6-3-81					LOT 6, BLOCK 6
	"	"	7-1-81					Lot 7, Blackmans add
Russ Young	Reider		11-19-81					Johnson 2nd Add


SECTION _____ TOWNSHIP _____ RANGE _____

Stock No. 26273

WINNEBAGO COUNTY CERTIFIED SURVEY MAP NO. 1892
 Part of Gov't Lot 6 of the Fractional SE $\frac{1}{4}$ of the SW $\frac{1}{4}$ of Sec. 8, T.18N.,
 R.15E., in the Third Ward, City of Omro, Winnebago County, Wisconsin



Calvin W. Hawksworth
 Calvin W. Hawksworth S-1290
 Wisconsin Registered Land Surveyor
 April 8, 1988

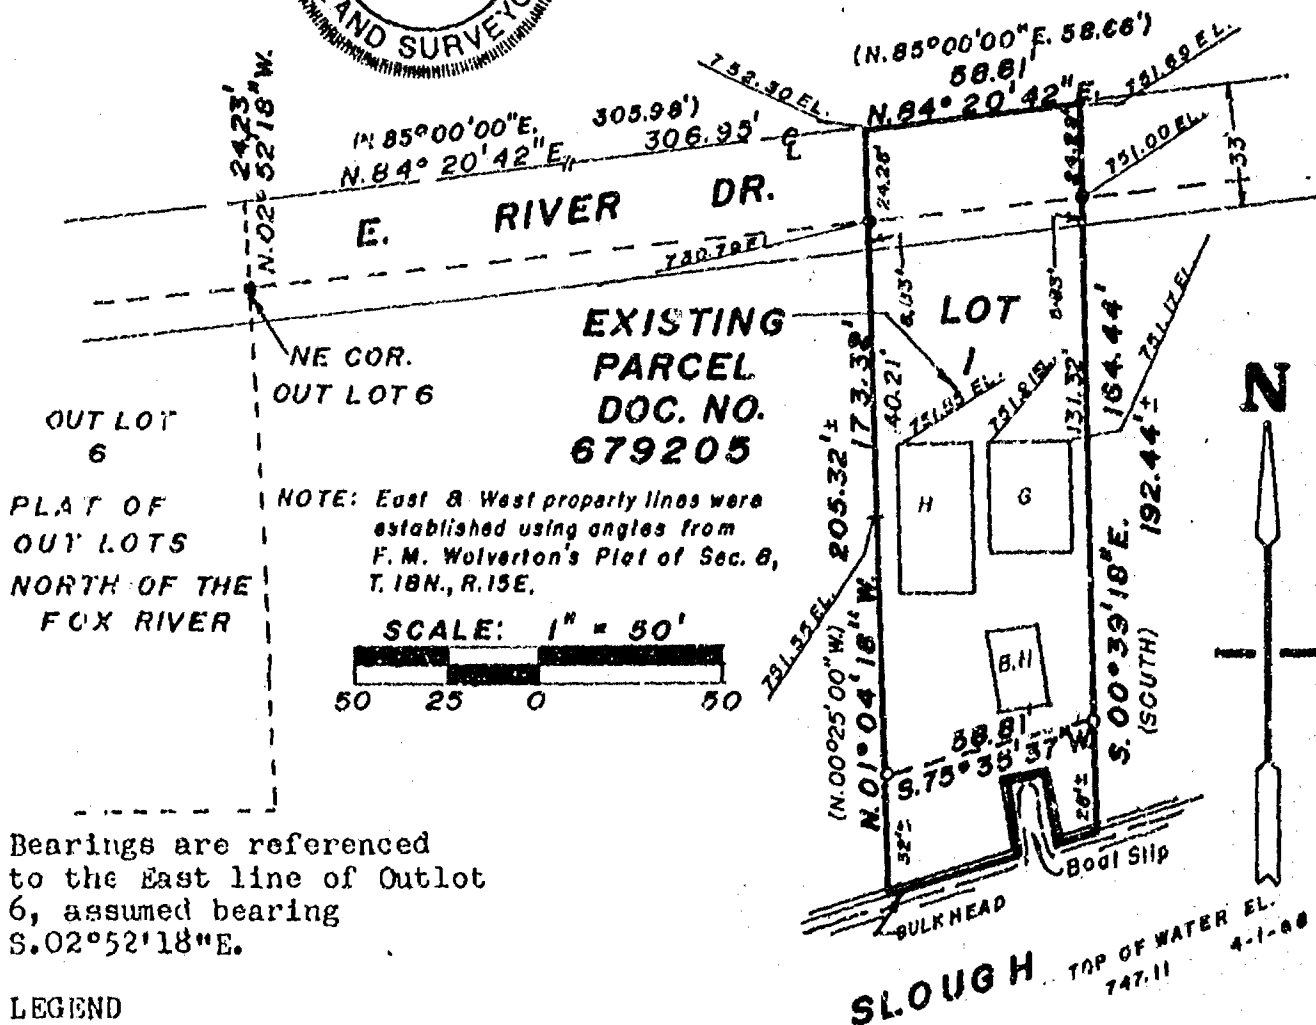

Bearings are referenced
 to the East line of Outlot
 6, assumed bearing
 S.02°52'18"E.

LEGEND

- Existing Iron Pipe
- 1" x 30" iron pipe
weighing 1.13 lbs./
lin. ft.
- () Recorded as

B.M. = Top of Hydrant at NW cor. of River
 Dr. & Hawthorne EL. 752.94 per
 Director of Public Works
 100 Year Flood Elev. 751.79

CITY OF OMRO PLANNING COMMITTEE CERTIFICATE

This Certified Survey Map of part of Gov't Lot 6, of the Fractional
 SE $\frac{1}{4}$ of the SW $\frac{1}{4}$ of Sec. 8, T.18N., R.15E., in the Third Ward, City of
 Omro, Winnebago County, Wisconsin, Jerry R. and Julie A. Tritt owners
 is hereby approved.

S-3-88
 Date

[Signature]
 Planning Committee Representative

Sheet 1 of 2 sheets

FB.57 PG. 39

SAYLER SURVEY, INC. LAND SURVEYORS WINNECONNE, WI

Stock No. 26273

WINNEBAGO COUNTY CERTIFIED SURVEY MAP NO. 1842
 Part of Gov't Lot 6 of the Fractional SE $\frac{1}{4}$ of the SW $\frac{1}{4}$ of Sec. 8, T.18N.,
 R.15E., in the Third Ward, City of Omro, Winnebago County, Wisconsin

SURVEYOR'S CERTIFICATE

I, Calvin W. Hawksworth, registered land surveyor, hereby certify:
 That I have surveyed, divided and mapped the parcel of land located in
 part of Gov't Lot 6 of the Fractional SE $\frac{1}{4}$ of the SW $\frac{1}{4}$ of Sec. 8, T.18N.,
 R.15E., in the Third Ward, City of Omro, Winnebago County, Wisconsin,
 described as follows: Beginning at a point on the center line of East
 River Dr. that is 24.23 ft. N.02°52'18"W. and 306.95 ft. N.84°20'42"E.
 (Rec. as 305.98 ft. N.85°00'00"E.) of the NE corner of Outlot 6 of the
 PLAT OF OUTLOTS NORTH OF THE FOX RIVER. From that point running
 N.84°20'42"E. 58.61 ft. (Rec. as N.85°00'00"E. 58.66 ft.), thence
 S.00°39'18"E. (Rec. as South) 164.44 ft. to a meander line of a body of
 water know as "The Slough", thence S.75°35'37"W. along said meander
 line 58.81 ft., thence N.01°04'18"W. (Rec. as N.00°25'00"W.) 173.32 ft.
 to the said point of beginning. Including all the land lying between
 the meander line and the water's edge of "The Slough". Being a parcel
 of land of 11,523.651 sq. ft. more or less. Subject to all easements
 and restrictions of record.

That I have made such survey, land division and map by the direction
 of Jerry R. and Julie A. Tritt, 612 E. River Dr., Omro, WI 54963;
 that such map is a true and correct representation of the exterior
 boundaries of the land surveyed.

That I have fully complied with the provisions of Sec. 236.34 of
 the Wisconsin Statutes and the City of Omro Subdivision Ordinance in
 surveying, dividing and mapping the same.



Calvin W. Hawksworth
 Calvin W. Hawksworth S-1290
 Wisconsin Registered Land Surveyor
 April 8, 1988

OWNER'S CERTIFICATE

As owner(s), I (we) hereby certify that I (we) caused the land
 described on this certified survey map to be surveyed, divided and
 mapped as represented hereon.

Jerry R. Tritt
 Owner
Julie A. Tritt
 Owner
 612 E. River Dr.
 Omro, WI 54963
 STATE OF WISCONSIN)
 WINNEBAGO COUNTY) SS

DOROTHY L. PROEH
 NOTARY PUBLIC
 STATE OF WISCONSIN

Personally came before me this 12TH day of April,
 1988, the above named owner(s) to me known to be the person(s) who
 executed the foregoing instrument and acknowledged the same.

Dorothy L. Proeh
 Notary Public Winneconne, WI
 My commission expires 6-24-1990.

Sheet 2 of 2 sheets

SAYLER SURVEY, INC.

139A W. Main

Winneconne, WI

700803

Register's Office
Winnebago County, Wis.
Received for record this 10th
day of May, A.D., 1988
at 8:45 o'clock A.M. and
recorded in Vol. 1 of S.M.
on page 1842
Mary Jane Dahm
Register of Deeds


Sally Loney

Aug 6

WINNEBAGO COUNTY CERTIFIED SURVEY MAP NO. 1826
Part of Gov't Lot 5, of Sec. 8, T.18N., R.15E., in the City of Omro,
Winnebago County, Wisconsin

A circular seal for a Wisconsin Land Surveyor. The outer ring contains the text "WISCONSIN" at the top and "LAND SURVEYOR" at the bottom, separated by two five-pointed stars. The inner circle contains the text "CALVIN W. HAWKSWORTH", "S-1290", and "Winneconne Wis." in three lines.

SCALE: 1" = 50'

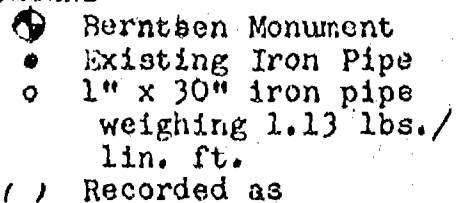

Planning Committee Representative

FB.57 PG.35

SAYLER SURVEY, INC. LAND SURVEYORS WINNECONNE, WI

Stock No. 26273

WINNEBAGO COUNTY CERTIFIED SURVEY MAP NO. 1826
 Part of Gov't Lot 5, of Sec. 8, T.18N., R.15E., in the City of Omro,
 Winnebago County, Wisconsin

SURVEYOR'S CERTIFICATE

I, Calvin W. Hawksworth, registered land surveyor, hereby certify:
 That I have surveyed, divided and mapped the parcel of land located in part of Gov't Lot 5, of Sec. 8, T.18N., R.15E., in the City of Omro, Winnebago County, Wisconsin, described as follows: Beginning at an iron pipe that is 1859.45 ft. S.00°47'08"W. (Rec. as 1859.12 ft. S.01°00'00"W.) and 26.75 ft. S.89°12'52"E. (Rec. as 24.75 ft. S.89°00'00"E.) and 79.43 ft. N.78°43'55"E. (Rec. as 180.00 ft. N.78°50'00"E.) of the Center of said Sec. 8. From that point running N.11°10'00"W. 30.60 ft. (Rec. as N.21°10'00"W. 30.45 ft.), thence N.67°30'15"E. 114.90 ft. (Rec. as 117.15 ft.), thence S.22°22'00"E. 131.15 ft. to a meander line of the Fox River, thence S.71°51'10"W. along said meander line 138.36 ft., thence N.11°10'00"W. 92.46 ft. to the said point of beginning. Including all the land lying between the meander line and the water's edge of the Fox River. Being a parcel of land of 16,683.711 sq. ft. more or less. Subject to all easements and restrictions of record.

That I have made such survey, land division and map by the direction of James H. and Gwendolyn J. Bartels, 716 E. River Dr., Omro, WI 54963; that such map is a true and correct representation of the exterior boundaries of the land surveyed.

That I have fully complied with the provisions of Sec. 236.34 of the Wisconsin Statutes and the City of Omro Subdivision Ordinance in surveying, dividing and mapping the same.



Calvin W. Hawksworth
 Calvin W. Hawksworth S-1290
 Wisconsin Registered Land Surveyor
 March 23, 1988

OWNER'S CERTIFICATE

As owner(s), I (we) hereby certify that I (we) caused the land described on this certified survey map to be surveyed, divided and mapped as represented hereon.

James H. Bartels
 Owner
Gwendolyn J. Bartels
 Owner
 716 E. River Dr.
 Omro, WI 54963

DOROTHY L. PROEHL
 NOTARY PUBLIC
 STATE OF WISCONSIN

STATE OF WISCONSIN) SS
 WINNEBAGO COUNTY)

Personally came before me this 23rd day of March, 1988, the above named owner(s) to me known to be the person(s) who executed the foregoing instrument and acknowledged the same.

Dorothy L. Proehl
 Notary Public Winneconne WI
 My commission expires 6-24-1990.

Sheet 2 of 2 sheets

SAYLER SURVEY, INC.

139A W. Main

Winneconne, WI

698916

Register's Office
Winnebago County, Wis
Received for record this 11th
day of April A.D., 1988
at 9:25 o'clock AM. and
recorded in Vol. 1 of SSM
on page 1826

Ernesto Salinas
Register of Deeds

Saylen Sumner
by
1

679321

Register's Office
Winnebago County, Wis.
Received for record this ^{6th}
day of ^{May} ~~May~~ A.D., 1987
at ^{9:02} ~~7:02~~ o'clock ^A ~~A~~ M. and
recorded in Vol. ¹ ~~1~~ of ^{CSM} ~~CSM~~
on page ¹⁷⁰² ~~1702~~

W. J. J. J. J.
Register of Deeds


Sayler Swaney *Chg*
808

Stock No. 26273

WINNEBAGO COUNTY CERTIFIED SURVEY MAP NO. 1702
 Part of Outlots 16, 17 and 18 of the plat of OUTLOTS SOUTH OF THE FOX
 RIVER in the City of Curo, Sec. 17, T.18N., R.15E., Winnebago County, WI



Calvin W. Hawksworth
 Calvin W. Hawksworth S-1290
 Wisconsin Registered Land Surveyor
 April 13, 1987

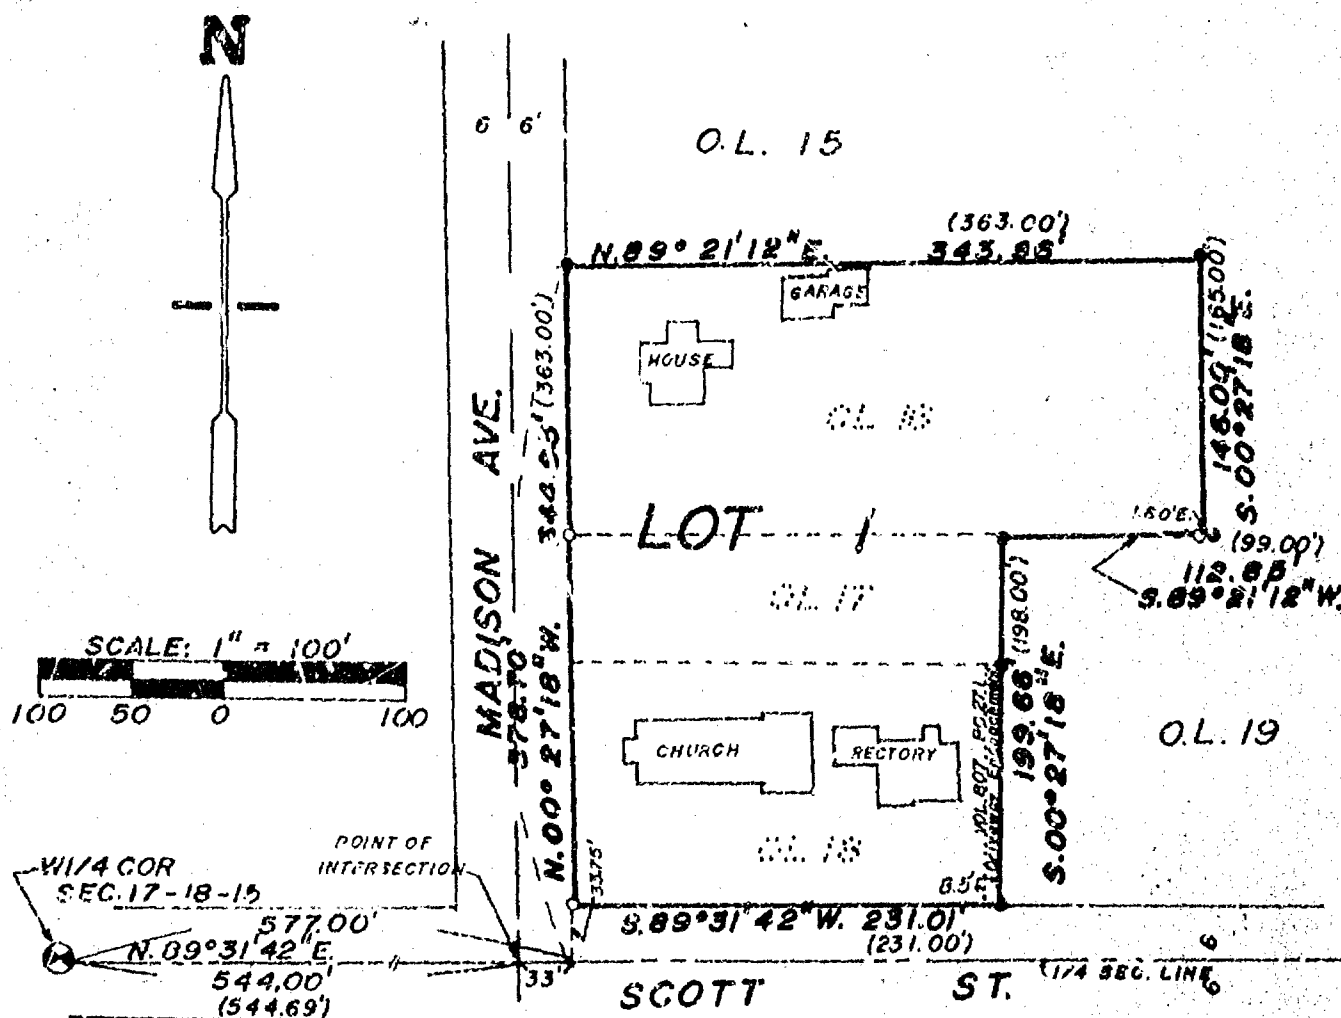

LEGEND

- ⊕ Berntsen Monument
- Existing Iron Pipe
- 1"X30" iron pipe weighing 1.13 lbs. per lin./ft.
- () Recorded as

Bearings are referenced to the
 East - West $\frac{1}{4}$ line of Sec. 17,
 assumed bearing N. 89° 31' 42" E.

Sheet 1 of 3 sheets

FB. 45 PG. III

SAYLER SURVEY, INC. LAND SURVEYOR WINNECONNE, WI

Stock No. 26273

WINNEBAGO COUNTY CERTIFIED SURVEY MAP NO. 1702

Part of Outlots 16, 17 and 18 of the plat of OUTLOTS SOUTH OF THE FOX RIVER in the City of Omro, Sec. 17, T.18N., R.15E., Winnebago County WI

SURVEYOR'S CERTIFICATE

I, Calvin W. Hawksworth, registered land surveyor hereby certify:

That I have surveyed, divided and mapped the parcel of land known as Outlot 16, 17 and 18 of the plat of OUTLOTS SOUTH OF THE FOX RIVER in the City of Omro, Sec. 17, T.18N., R.15E., Winnebago County, Wisconsin described as follows: Beginning at an iron pipe that is 544.00 (Rec. as 544.69') N.89°31'42"E. to the intersection of Madison Ave. and Scott St. and 33.00 ft. N.89°31'42"E. and 33.75 ft. N.00°27'18"W. of the W. cor. of said Sec. 17. From that point running N.00°27'18"W. 344.95 ft. (Rec. as 363.00 ft.), thence N.89°21'12"E. 343.86 ft. (Rec. as 363.00 ft.), thence S.00°27'18"E. 146.00 ft. (Rec. as 165.00 ft.), thence S.89°21'12"E. 112.85 ft. (Rec. as 99.00 ft.), thence S.00°27'18"E. 199.66 ft., (Rec. as 198.00 ft.), thence S.89°31'42"W. 231.01 ft. (Rec. as 231.00 ft.) to the said point of beginning. Being a parcel of land of 2.209 acres more or less. Subject to all easements and restrictions of record.

That I have made such survey, land division and map by the direction of St. Marys Congregation, 233 East Scott, Omro, WI 54963; that such map is a true and correct representation of the exterior boundaries of the land surveyed.

That I have fully complied with the provision of Sec. 236.34 of the Wisconsin Statutes and the City of Omro Subdivision Ordinance in surveying, dividing and mapping the same.



Calvin W. Hawksworth
 Calvin W. Hawksworth S-1290
 Wisconsin Registered Land Surveyor
 April 13, 1987

CITY OF OMRO PLANNING COMMITTEE CERTIFICATE

This Certified Survey Map of part of Outlots 16, 17 and 18 of the plat of OUTLOTS SOUTH OF THE FOX RIVER in the City of Omro, Sec. 17, T.18N., R.15E., is hereby approved.

5-4-87
 Date

Paul D. Johnson
 Authorized Representative

Sheet 2 of 3 sheets

SAYLER SURVEY, INC.

139A West Main

Winneconne, WI

WINNEBAGO COUNTY CERTIFIED SURVEY MAP NO. 1702

CORPORATE OWNER'S CERTIFICATE

IN WITNESS WHEREOF the said ST MARYS CONGREGATION has caused these presents to be signed by +Adam J. Maida, its president and countersigned by _____, its secretary at _____, Wisconsin.
In presence of: _____

President

STATE OF WISCONSIN)
BROWN COUNTY) SS

WI

Calvin W. Hawksworth S-1290
Wisconsin Registered Land Surveyor
April 13, 1987



Winneconne, WI


CERTIFIED SURVEY MAP NO. 1688

BEING A REDIVISION OF OUTLOT 40 SOUTH OF THE FOX RIVER ACCORDING TO THE PLAT OF OUTLOTS AND OF LOT 2 OF CERTIFIED SURVEY MAP NO. 1490, IN THE N.E. 1/4 OF SECTION 18, T18N, R15E, IN THE SECOND WARD, CITY OF OMRO, WINNEBAGO COUNTY, WISCONSIN.


- 0 ——— DENOTES 1 INCH DIAMETER IRON PIPE FOUND.
- 0 ——— DENOTES 1 INCH DIAMETER IRON PIPE, 24 " LONG, WEIGHING NOT LESS THAN 1.13 LBS PER LINEAL FOOT SET.

ALL DIMENSIONS SHOWN ARE MEASURED TO THE NEAREST HUNDREDTH OF A FOOT.

BEARINGS ARE REFERENCED TO THE WEST R.O.W. OF WEBSTER STREET, SAID
LINE HAVING AN ASSUMED BEARING OF SOUTH 00-17-52 WEST.

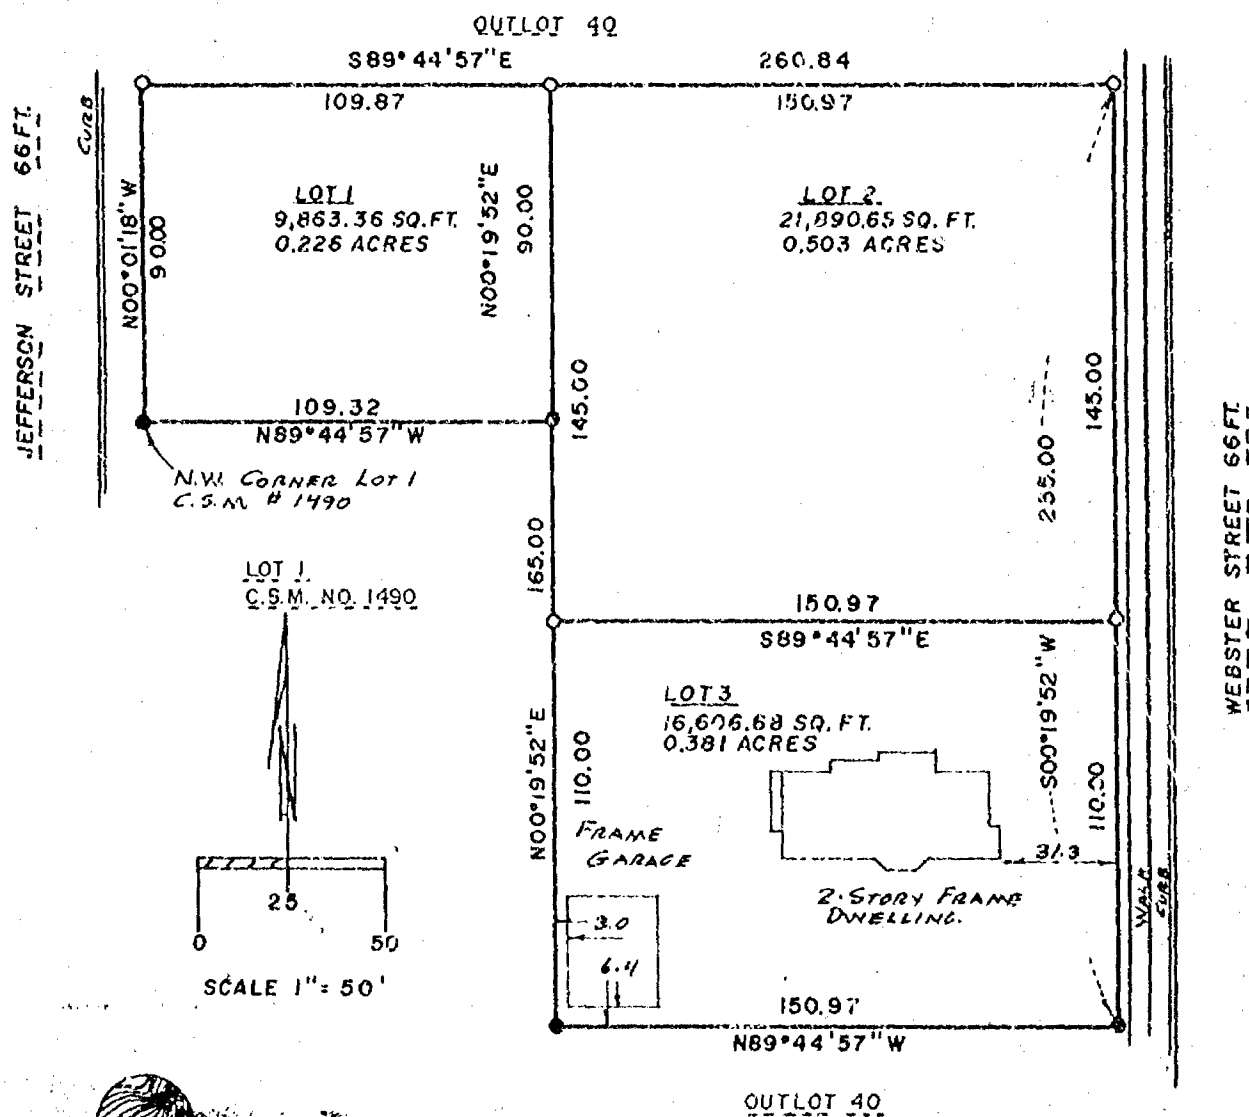

national survey & engineering
2530 WEST 20TH AVENUE
P.O. BOX 2963
OSHKOSH, WISCONSIN 54903
(414) 426-2800

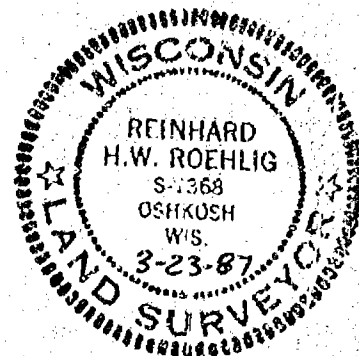

CERTIFIED SURVEY MAP NO. 1688

BEING A REDIVISION OF OUTLOT 40 SOUTH OF THE FOX RIVER ACCORDING TO THE PLAT OF OUTLOTS AND OF LOT 2 OF CERTIFIED SURVEY MAP NO. 1490, IN THE N.E. 1/4 OF SECTION 18, T18N, R15E, IN THE SECOND WARD, CITY OF OMKO, WINNEBAGO COUNTY, WISCONSIN.

SURVEYOR'S CERTIFICATE
STATE OF WISCONSIN
WINNEBAGO COUNTY)

I, REINHARD ROEHLIG, Wisconsin land surveyor do hereby certify;

THAT I have surveyed and mapped a part of Outlot 40 South of the Fox River and Lot 2 of Certified Survey Map no. 1490, Second Ward, City of Omro, Winnebago County, Wisconsin, which is bounded and described as follows:

Commencing at the N.W. corner of Lot 1 in Certified Survey Map No. 1490, thence North 00-01-18 West along the East line of Jefferson Street 90.00 ft., thence South 89-44-57 East 260.84 ft. to a point on the West line of Webster Street, thence South 00-19-52 West along said line 255.00 ft., to the S.E. corner of Lot 2 in said Certified Survey Map, thence North 89-44-57 West 150.97 ft. to the S.W. corner of Lot 2, thence North 00-19-52 East along the West line of said lot 165.00 ft. to the N.W. Corner of said Lot, thence North 89-44-57 West along the North line of Said Lot 1 aforesaid 109.32 ft. to the point of beginning.


THAT I have made this survey, land division and map by the direction of LEE R. KRUEGER, owner of said land.

THAT such map is a correct representation of all the exterior boundaries of the land surveyed and the land division thereof made.

THAT I have fully complied with the provisions of Chapter 236 of the Wisconsin Statutes and the Land Subdivision Ordinance of The City of Omro.

3-23-87
Date

Reinhard Roehlig (SEAL)
Reinhard Roehlig Registered
Land Surveyor S-1368

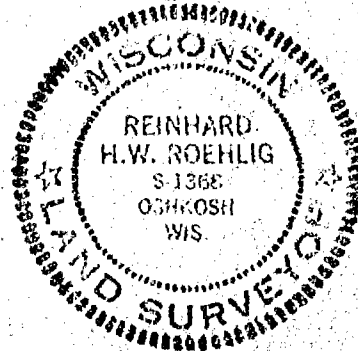

CERTIFIED SURVEY MAP NO. 1688

BEING A REDIVISION OF OUTLOT 40 SOUTH OF THE FOX RIVER ACCORDING TO THE PLAT OF OUTLOTS AND OF LOT 2 OF CERTIFIED SURVEY MAP NO. 1490, IN THE N.E. 1/4 OF SECTION 18, T18N, R15E, IN THE SECOND WARD, CITY OF OMRO, WINNEBAGO COUNTY, WISCONSIN.

OWNER'S CERTIFICATE

AS OWNER I hereby certify that I caused the land described on this map to be surveyed, divided and mapped as represented on this map in accordance with the City of Omro Subdivision Ordinance.

WITNESS the hand and seal of said owner this.....day of 1987.

In The Presence Of:

Golden Chase

Lee R. Krueger
LEE R. KRUEGER

STATE OF WISCONSIN)

:SS

WINNEBAGO COUNTY)

PERSONALLY came before me this *6th* day of *April*... 1987 the above named Lee R. Krueger to me known to be the person who executed the foregoing instrument and acknowledged the same.

Janet Schettl
Notary Public, Winnebago County, State of Wisconsin

My Commission Expires *Dec 13, 1989*

CITY OF OMRO PLANNING COMMISSION CERTIFICATE

THIS Certified Survey Map of a part of Lot 40 South of the Fox River according to Plat of Outlots and part of Lot 2 in Certified Survey Map No. 1470, Lee R. Krueger owner, is hereby approved.

4-6-87
Date

Paul Johnson
Planning Committee Representative

THIS INSTRUMENT WAS DRAFTED BY REINHARD ROEHLIG.

677083

Register's Office
Winnebago County, Wis.
Received for record this *9th*
day of *April* A.D. 1987
at *10:00* o'clock *A.* M. and
recorded in Vol. *1* of *C.S.M.*
on page *1688*
Margaret Johnson
Register of Deeds



Chg.
8.02

John Birmingham

670606


Register's Office
Winnebago County, Wis.
Received for record this 8th
day of Jan. A.D., 1987
at 1:00 o'clock P.M. and
recorded in Vol. 1 of CSM
on page 1646
Marilyn Dahmed
Register of Deeds

Sayler

Chy
6 Jan

Stock No. 26273

WINNEBAGO COUNTY CERTIFIED SURVEY MAP NO. 1646
 Located in part of the NE $\frac{1}{4}$ of Sec. 17, T.18N., R.15E., City of Omro,
 Winnebago County, Wisconsin.
 A DIVISION OF LOT 2 OF VOL. 1 OF C.S.M. 1500

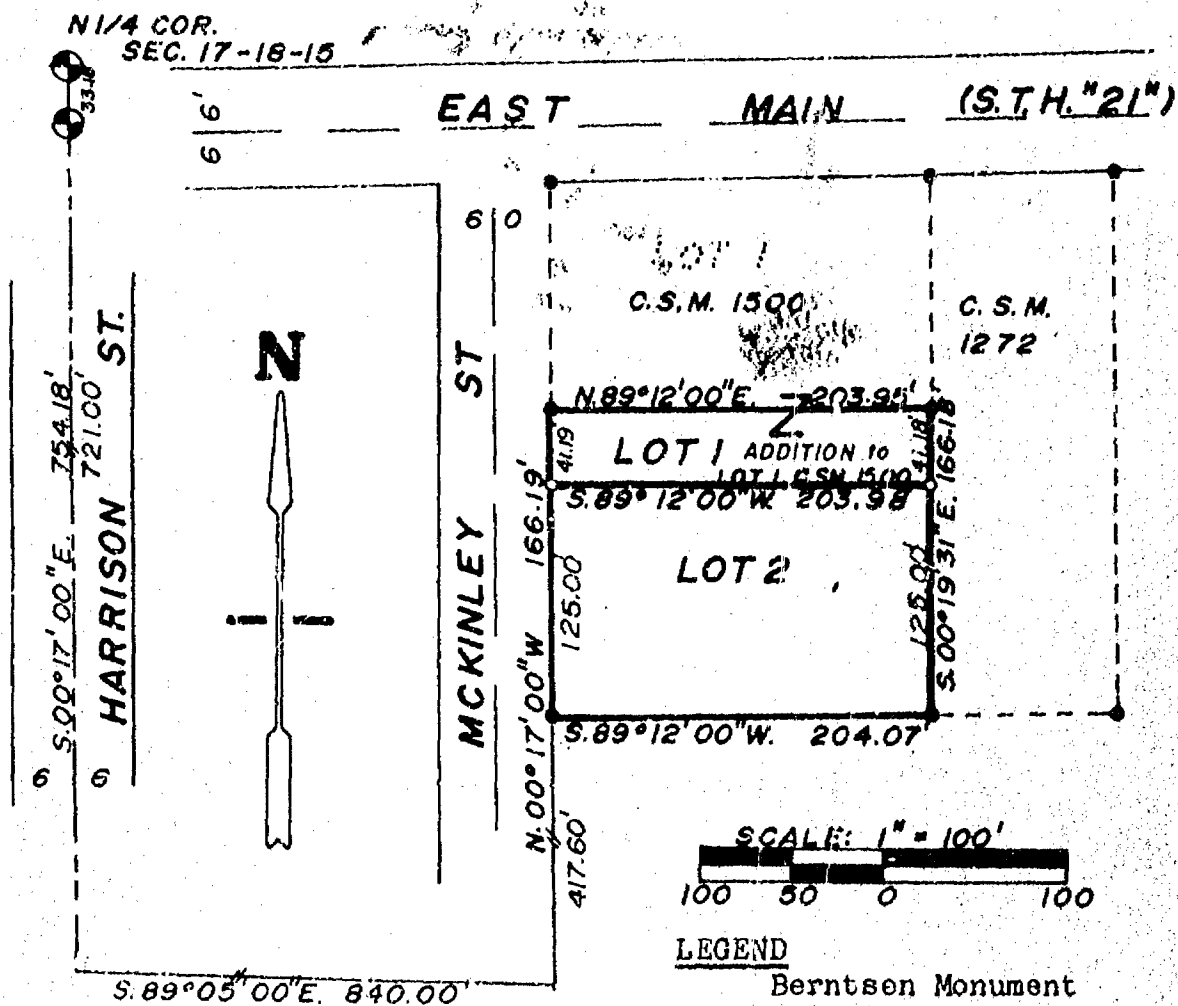

AREA:

LOT 1 = 8,398.89 SQ. FT.

LOT 2 = 25,502.34 SQ. FT.

Bearings are referenced to the N-S $\frac{1}{4}$ Sec. line
 of Sec. 17, T.18N., R.15E., assumed bearing,
 S.00°17'00"E.

Robert H. Saylor

Robert H. Saylor S-1894
 Wisconsin Registered Land Surveyor
 December 19, 1986



OMRO CITY PLANNING COMMITTEE CERTIFICATE

This Certified survey map of part of the NE $\frac{1}{4}$ of Sec. 17, T.18N.,
 R.15E., City of Omro, is hereby approved.

Paul D. Johnson
 Authorized Representative

1-5-87
 Date approved

Sheet 1 of 2 sheets

FB.45 PG. 11

SAYLER SURVEY, INC. LAND SURVEYORS WINNECONNE, WI

Stock No. 26273

WINNEBAGO COUNTY CERTIFIED SURVEY MAP NO. 1646Located in part of the NE $\frac{1}{4}$ of Sec. 17, T.18N., R.15E., City of Omro, Winnebago County, Wisconsin.

A DIVISION OF LOT 2 OF VOL. 1 OF C.S.M. 1500

SURVEYOR'S CERTIFICATE

I, Robert H. Saylor, registered land surveyor, hereby certify:

That I have surveyed, divided and mapped the parcel of land recorded as LOT 2 OF VOL. 1 OF C.S.M. 1500, located in part of the NE $\frac{1}{4}$ of Sec. 17, T.18N., R.15E., City of Omro, Winnebago County, Wisconsin, described as follows: Beginning at an iron pipe that is 754.18 ft., S.00°17'00"E. and 840.00 ft., S.89°05'00"E. and 417.60 ft. N.00°17'00"W. of the N $\frac{1}{4}$ corner of said Sec. 17. From that point running N.00°17'00"W. 166.19 ft., thence N.89°12'00"E. 203.95 ft., thence S.00°19'31"E. 166.18 ft., thence S.89°12'00"W. 204.07 ft., to the said point of beginning. Subject to all easements and restrictions of record.

That I have made such survey, division and map by the direction of Richard J. Kempinger, 247 W. 16 Ave., Oshkosh, WI 54901; that such map is a true and correct representation of the exterior boundaries of the land surveyed.

That I have fully complied with the provisions of Sec. 236.34 of the Wisconsin Statutes and the City of Omro Subdivision Ordinance in surveying, dividing and mapping the same.



Robert H. Saylor
Robert H. Saylor S-1290
Wisconsin Registered Land Surveyor
December 19, 1986

OWNERS CERTIFICATE

As owner, I hereby certify that I caused the land described on this Certified Survey Map to be surveyed, divided and mapped as represented hereon.

WITNESS the hand and seal of said owner this 22 day of December, 1986.

In presence of:

Robert H. Saylor
Witness

Richard J. Kempinger
Owner
247 W. 16 Ave.
Oshkosh, WI 54901

STATE OF WISCONSIN)
WINNEBAGO COUNTY) SS

Personally came before me this 22 day of December, 1986 the above named to be the person who executed the foregoing instrument and acknowledge the same.

Dorothy L. Proehl
Notary Public Winneconne WI

DOROTHY L. PROEHL
NOTARY PUBLIC
STATE OF WISCONSIN

My commission expires June 27, 1990

Sheet 2 of 2 sheets


SAYLER SURVEY, INC.

139A W. Main

Winneconne, WI

zoning

WINNEBAGO COUNTY CERTIFIED SURVEY MAP NO. 763
Outlot 10 and part of Outlot 9 in the plats of OUTLOTS NORTH
OF THE FOX RIVER, in the city of Omro, Winnebago County, Wisconsin

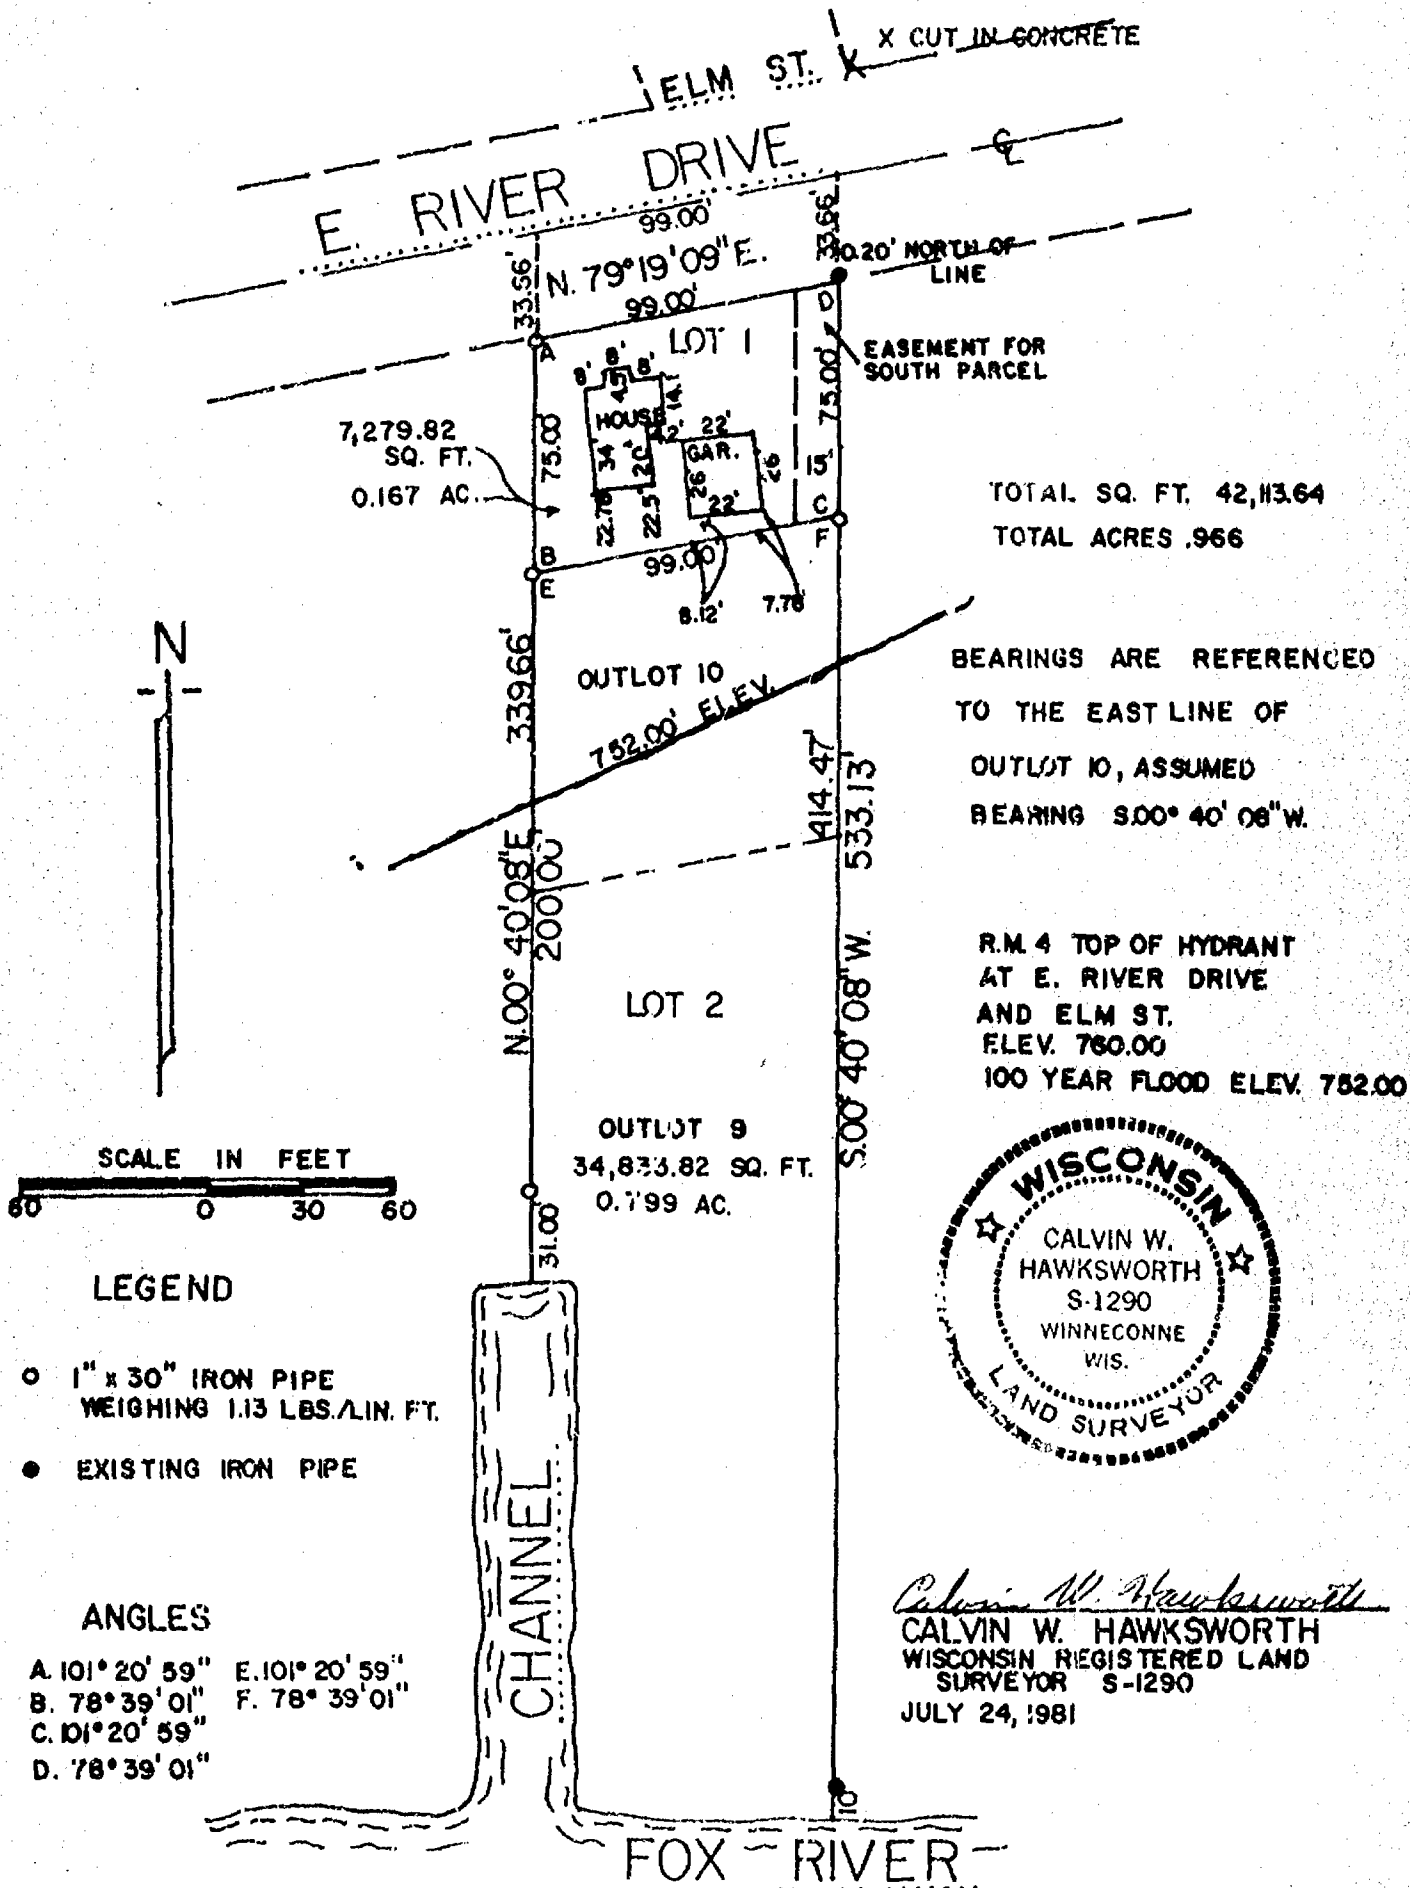

WINNEBAGO COUNTY CERTIFIED SURVEY MAP NO. 963
 Outlot 10 and part of Outlot 9 in the plats of OUTLOTS NORTH
 OF THE FOX RIVER, in the city of Omro, Winnebago County, Wisconsin

SURVEYOR'S CERTIFICATE

I, Calvin W. Hawksworth, registered land surveyor, hereby
 certify:

That I have surveyed and mapped the parcels of land located
 in Outlot 10 and part of Outlot 9 in the plats of OUTLOTS NORTH OF
 THE FOX RIVER, in the city of Omro, Winnebago County, Wisconsin,
 described as follows: Beginning at a point on the centerline of
 East River Drive and the N.W. corner of Outlot 10 in the plat of
 OUTLOTS NORTH OF THE FOX RIVER in the city of Omro, Winnebago County,
 Wisconsin. From that point running N.79°19'09"E. on the North line
 of said Outlot 10 and said centerline 99.00 feet; thence S.00°40'08"W.
 along the East line of said Outlot 533.13 feet to the North shore of
 the Fox River; thence Westerly and Northerly along the North shore of
 the Fox River and a channel to a point that is S.00°40'08"W. of the
 point of beginning; thence N.00°40'08"E., 339.66 feet to the point
 of beginning. Being a parcel of land of .966 acre, more or less.

That I have made such survey and map by the direction of
 Roger Jaeger, 214 East River Drive, Omro, Wisconsin, 54963; that
 such map correctly represents the exterior boundaries of the land
 surveyed.

That I have fully complied with the provisions of Sec. 236.34
 of the Wisconsin Statutes and the Winnebago County Certified Survey
 Map Ordinance in surveying and mapping the same.



Calvin W. Hawksworth
 Calvin W. Hawksworth S-1290
 Wisconsin Registered Land Surveyor
 July 24, 1981

OWNER'S CERTIFICATE

As owner I hereby certify that I caused the land described on
 this Certified Survey Map to be surveyed and mapped as represented
 hereon.

WITNESS the hand and seal of said owner this 30th day of
October, 1981.
 In presence of:

Witness

Owner

214 E. River Dr.

Address

Omro, WI 54963

City State Zip

30th day of October, 1981

Personally came before me this 30th day of October, 1981
 the above named Roger Jaeger to me known to be the
 person who executed the foregoing instrument and acknowledged the same.

Doraine C. Pregher
 Notary Public JN1

My commission expires July 26, 1982

CITY OF OMRO PLANNING COMMITTEE CERTIFICATE

This Certified Survey Map of Outlot 10 and part of Outlot 9 in
 the plat of OUTLOTS NORTH OF THE FOX RIVER, in the City of Omro, is
 hereby approved.

October 1, 1981

Date

Robert A. Chase
 Authorized representative
 City of Omro Planning Committee

570194

Register's Office
Winnebago County, Wis.
received for record this 11th
day of *Nov* A.D. 19 *81*
at *8:12* o'clock *AM*
recorded in Vol. *1* of *Summary*
on page *963* *made*
Gregoria. Ashmal
Register of Deeds

R. Jaeger

Rd
202

PLAT OF SURVEY


KNOWN AS 228 WEST RIVER DRIVE, BEING THE EAST 53.00 FT. OF THE WEST 65.5 FT. OF LOT 14 NORTH OF THE FOX RIVER, ACCORDING TO THE PLAT OF OUTLOTS, IN THE THIRD WARD, CITY OF OMRO, WINNEBAGO COUNTY, WISCONSIN, EXCEPTING THEREFROM THAT PORTION CONVEYED TO WINNEBAGO COUNTY FOR ROAD PURPOSES PER DEED RECORDED IN VOLUME 1271 ON PAGE 188.

MARCH 25, 1987

SURVEY FOR LINDA CRAIG

SURVEY NO. 1824-S

- ——— DENOTES 1" DIAMETER IRON PIPE FOUND AS SHOWN.
- ——— DENOTES 1" DIAMETER, 24" LONG IRON PIPE SET.

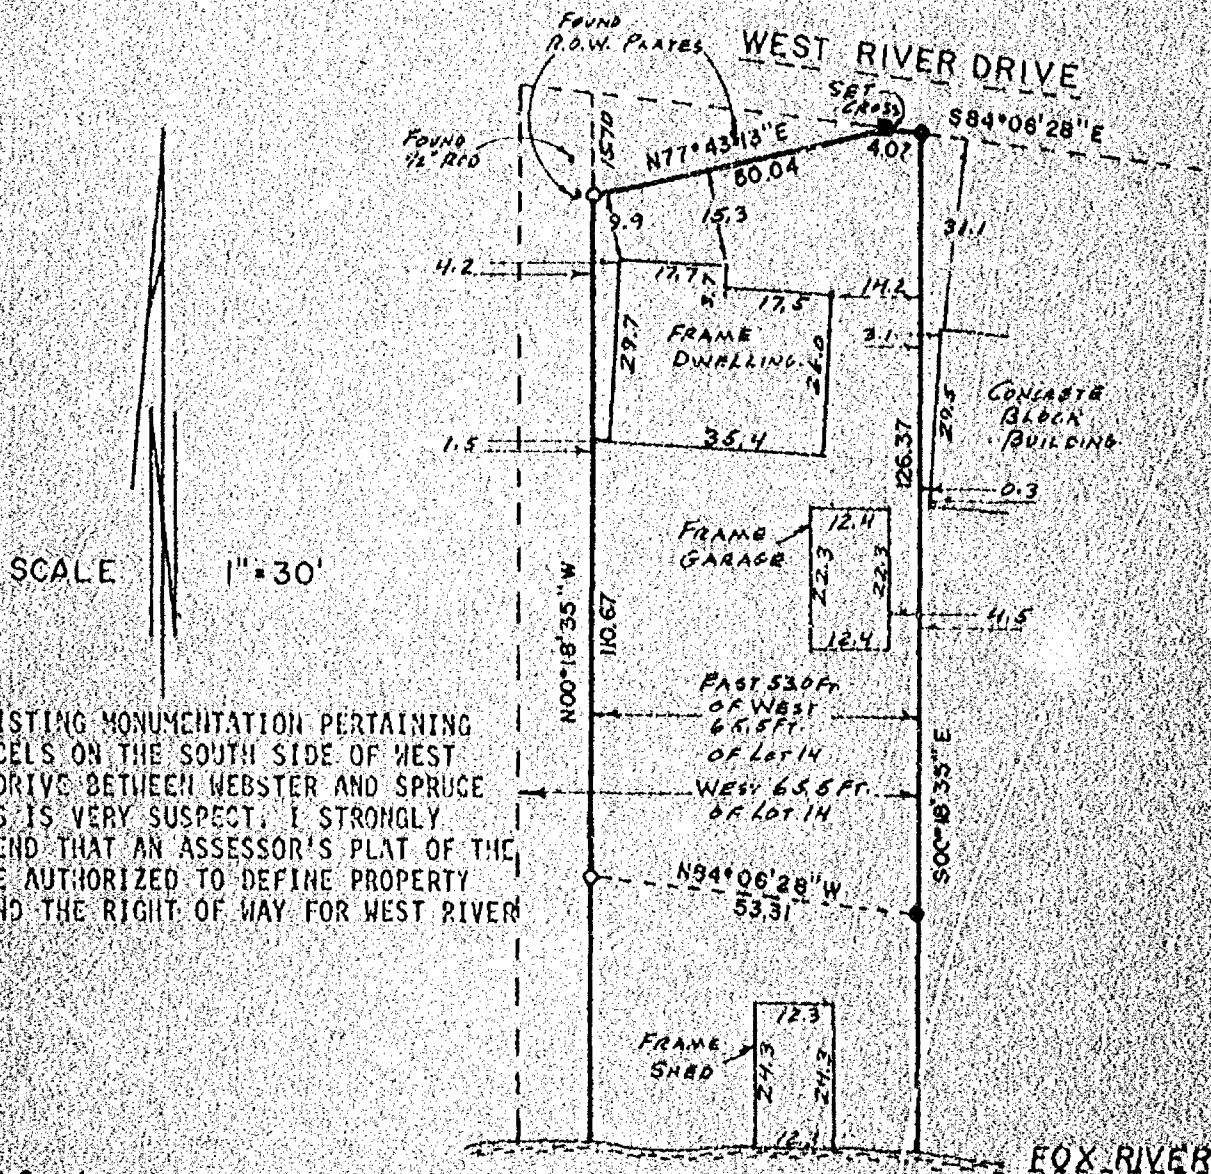

I Certify that I have surveyed the above described property (Property), and the above map is a true representation thereof and shows the size and location of the Property, its exterior boundaries, the location and dimensions of all visible structures thereon, boundary fences, apparent easements and roadways and visible encroachments, if any. This survey is made for the exclusive use of the present owners of the Property, and also those who purchase, mortgage, or guarantee the title thereto, within one (1) year from date hereof.



national survey & engineering

2530 WEST 20TH AVENUE / P.O. BOX 2963
OSHKOSH, WISCONSIN 54903
(414) 426-2800



Plat of Survey

THE NORTH $\frac{1}{2}$ OF LOT 6 AND THE WEST 18.82 FT. OF THE NORTH $\frac{1}{2}$ OF LOT 5
OF BLOCK 2 OF THE ORIGINAL PLAT OF OMRO, FIRST WARD, CITY OF OMRO,
WINNEBAGO COUNTY, WISCONSIN


CLIENTS:

Don & Mary Jungwirth (Winneconne Auto Parts, Inc.)
Omro, WI 54963

Lawrence Barth
220 East Main
Omro, WI 54963

ANGLES

A. $90^{\circ}03'02''$ C. $90^{\circ}03'02''$
B. $89^{\circ}56'50''$ D. $89^{\circ}56'58''$

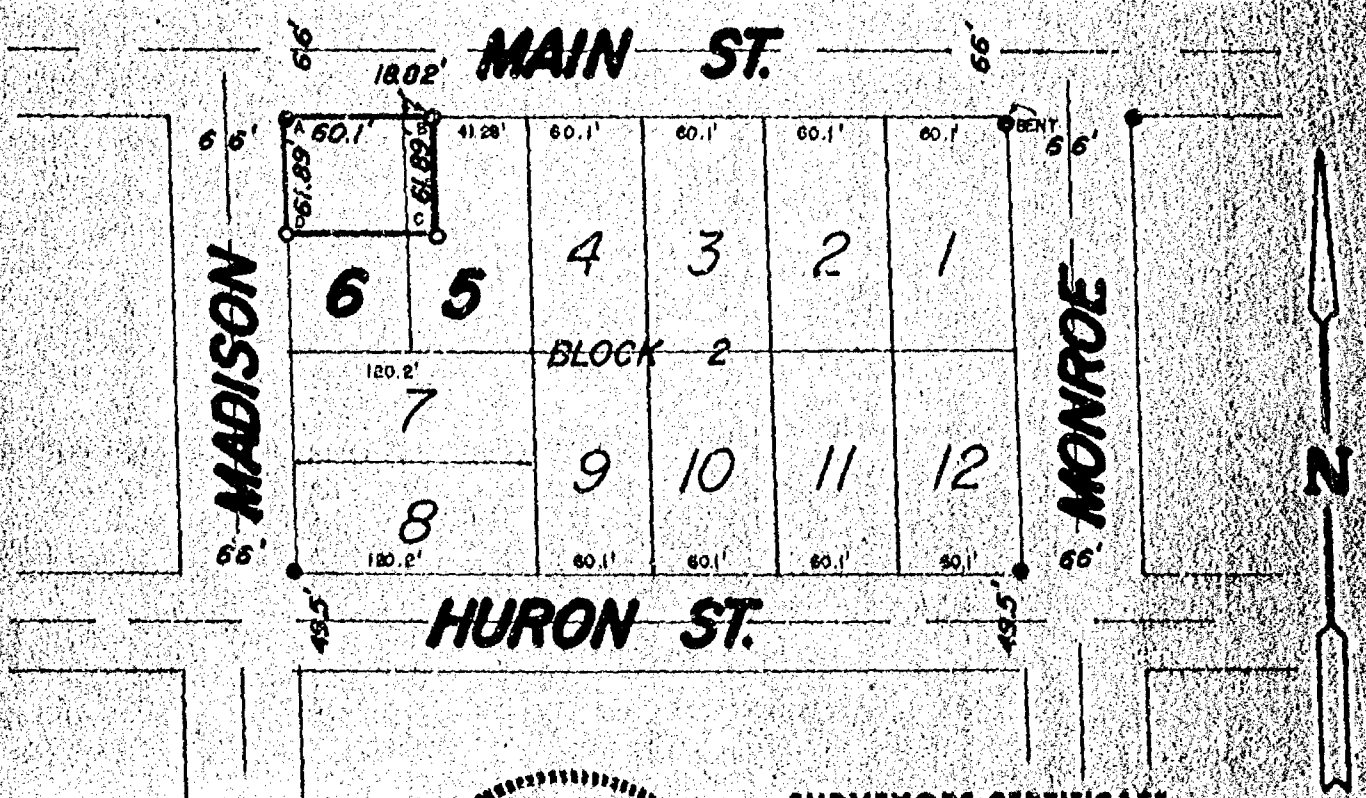

LEGEND

- = Existing monuments 1-1/2" ab. iron pipe
- = 2" x 30" iron pipe set
- = 1" x 30" iron pipe set
- ⊙ = reference caps or RR. spikes
- ⊕ = Bernitsen or Harrison monuments
- X-X = fence
- () = recorded as
- = stone monument



SURVEYORS CERTIFICATE

I, hereby certify that I have surveyed the property as shown, according to official records, and that the plat above drawn is an accurate and correct representation of said survey, JUNE 18, 1982

Calvin W. Hawksworth
Wisconsin Registered Land Surveyor S-1290

SAYLER SURVEY, INC.
LAND SURVEYORS
WINNECONNE, WI 54986

SCALE 1" = 100'
PROJECT NO. S-001294
FIELD BOOK 45 PAGE 3-4

PLAT OF SURVEY


KNOWN AS 406 EAST ONTARIO STREET. BEING LOT 6 AND THE NORTH 1/2 OF LOT 7
IN BLOCK "L" OF THE EASTERN ADDITION TO THE PLAT OF OMRO, VILLAGE OF
OMRO, FIRST WARD, CITY OF OMRO, WINNEBAGO COUNTY, WISCONSIN.

AUGUST 15, 1983

SURVEY FOR OSHKOSH SAVINGS
APPLICANT: MICHAEL LEE
(MONUMENT WAIVER ON FILE)

SURVEY NO. 1284-M

ONTARIO STREET

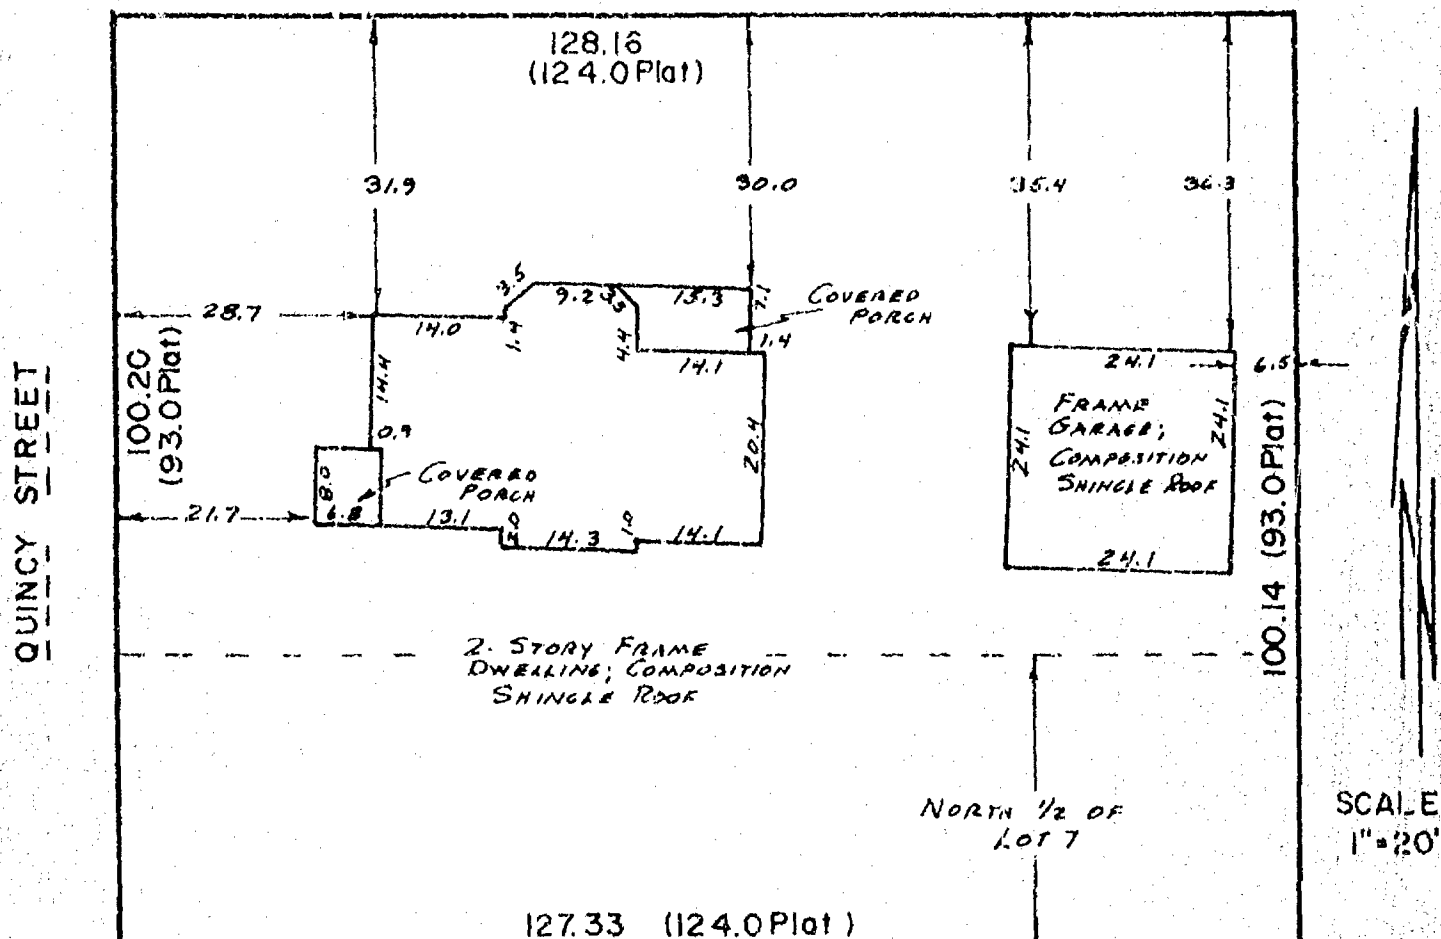


I Certify that I have surveyed the above described property (Property), and the above map is a true representation thereof and shows the size and location of the Property, its exterior boundaries, the location and dimensions of all visible structures thereon, boundary, fences, apparent easements and roadways and visible encroachments, if any. This survey is made for the exclusive use of the present owners of the Property, and also those who purchase, mortgage, or guarantee the title thereto, within one (1) year from date hereof.



Robert J. Survey & Engineering, Inc.

417 NORTH SAWYER STREET / P.O. BOX 2963
OSHKOSH, WISCONSIN 54903
(414) 426-2800

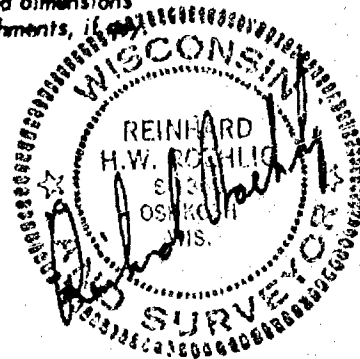


PLAT OF SURVEY

KNOWN AS 341 ADAMS STREET, BEING LOT 119 IN THE WESTERN ADDITION TO THE TOWN
PLAT OF OMRO, IN THE SECOND WARD, CITY OF OMRO, WINNEBAGO COUNTY, WISCONSIN.

SEPTEMBER 21, 1983

SURVEY FOR OSHKOSH SAVINGS
APPLICANT: JOHN REINERT

SURVEY NO. 1307-S

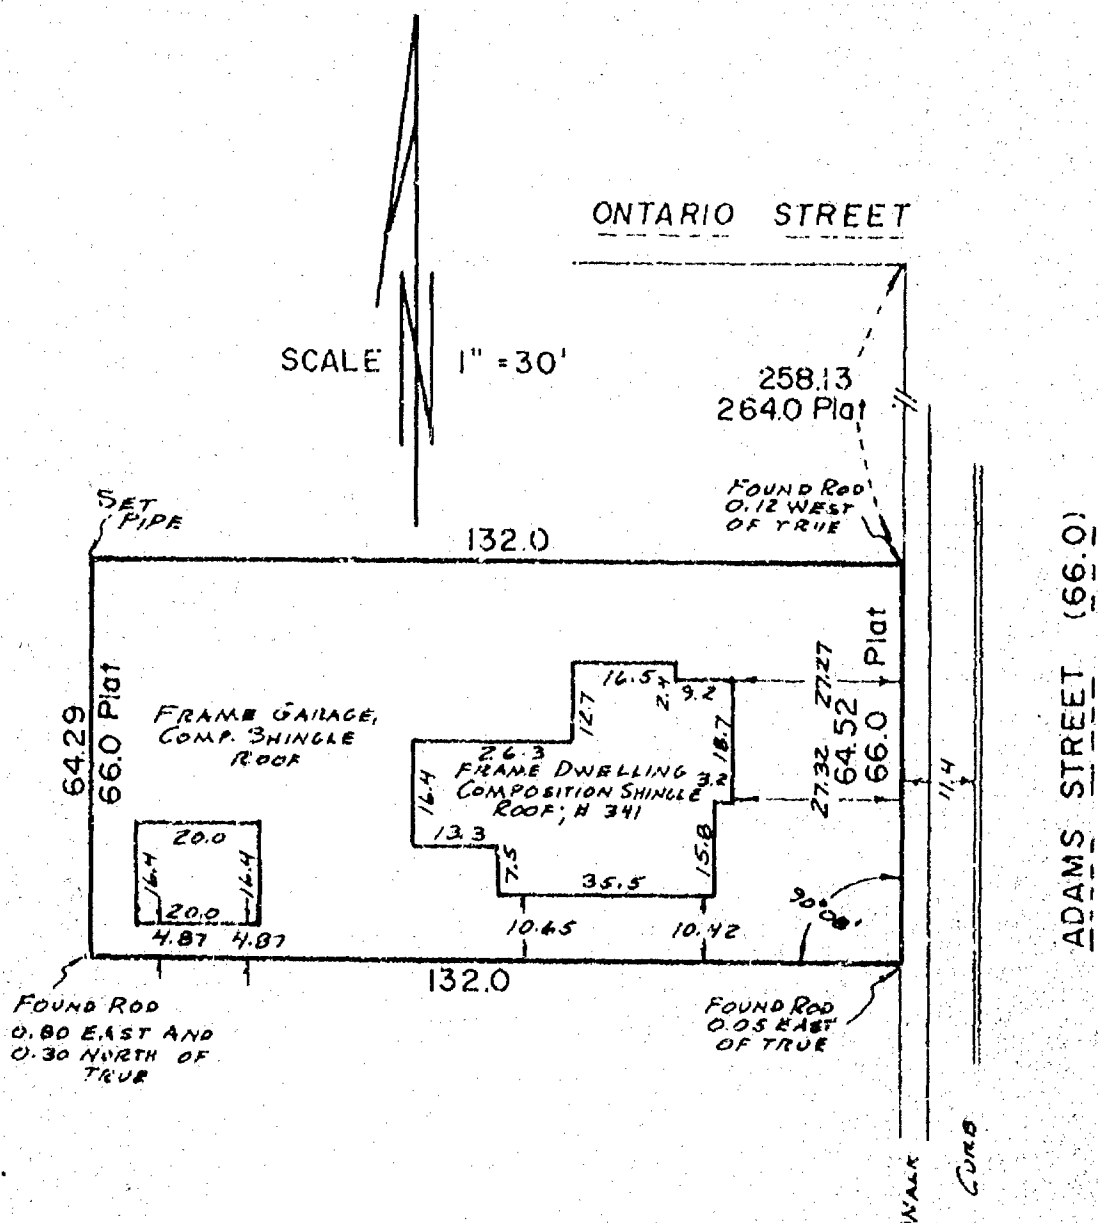

I Certify that I have surveyed the above described property (Property), and the above map is a true representation thereof and shows the size and location of the Property, its exterior boundaries, the location and dimensions of all visible structures thereon, boundary, fences, apparent easements and roadways and visible encroachments, if any.

This survey is made for the exclusive use of the present owners of the Property, and also those who purchase, mortgage, or guarantee the title thereto, within one (1) year from date hereof.




national survey & engineering
417 NORTH SAWYER STREET / P.O. BOX 2963
OSHKOSH, WISCONSIN 54903
(414) 426-2800



Plat of Survey

Beginning at a point that is 50.02 feet, N.00°00'00"E. and 138.02 feet, N.81°48'00"E. from the NW corner of Lot 7, BLACKMERS 1ST ADDITION, City of Omro, Winnebago County, Wisconsin.

From that point running N.66°07'48"E., 45.24 feet, thence N.85°55'34"E., 169.83 feet, thence S.81°48'00"W., 212.95 feet to the point of beginning. Being a parcel of land of 0.03 acre, more or less.

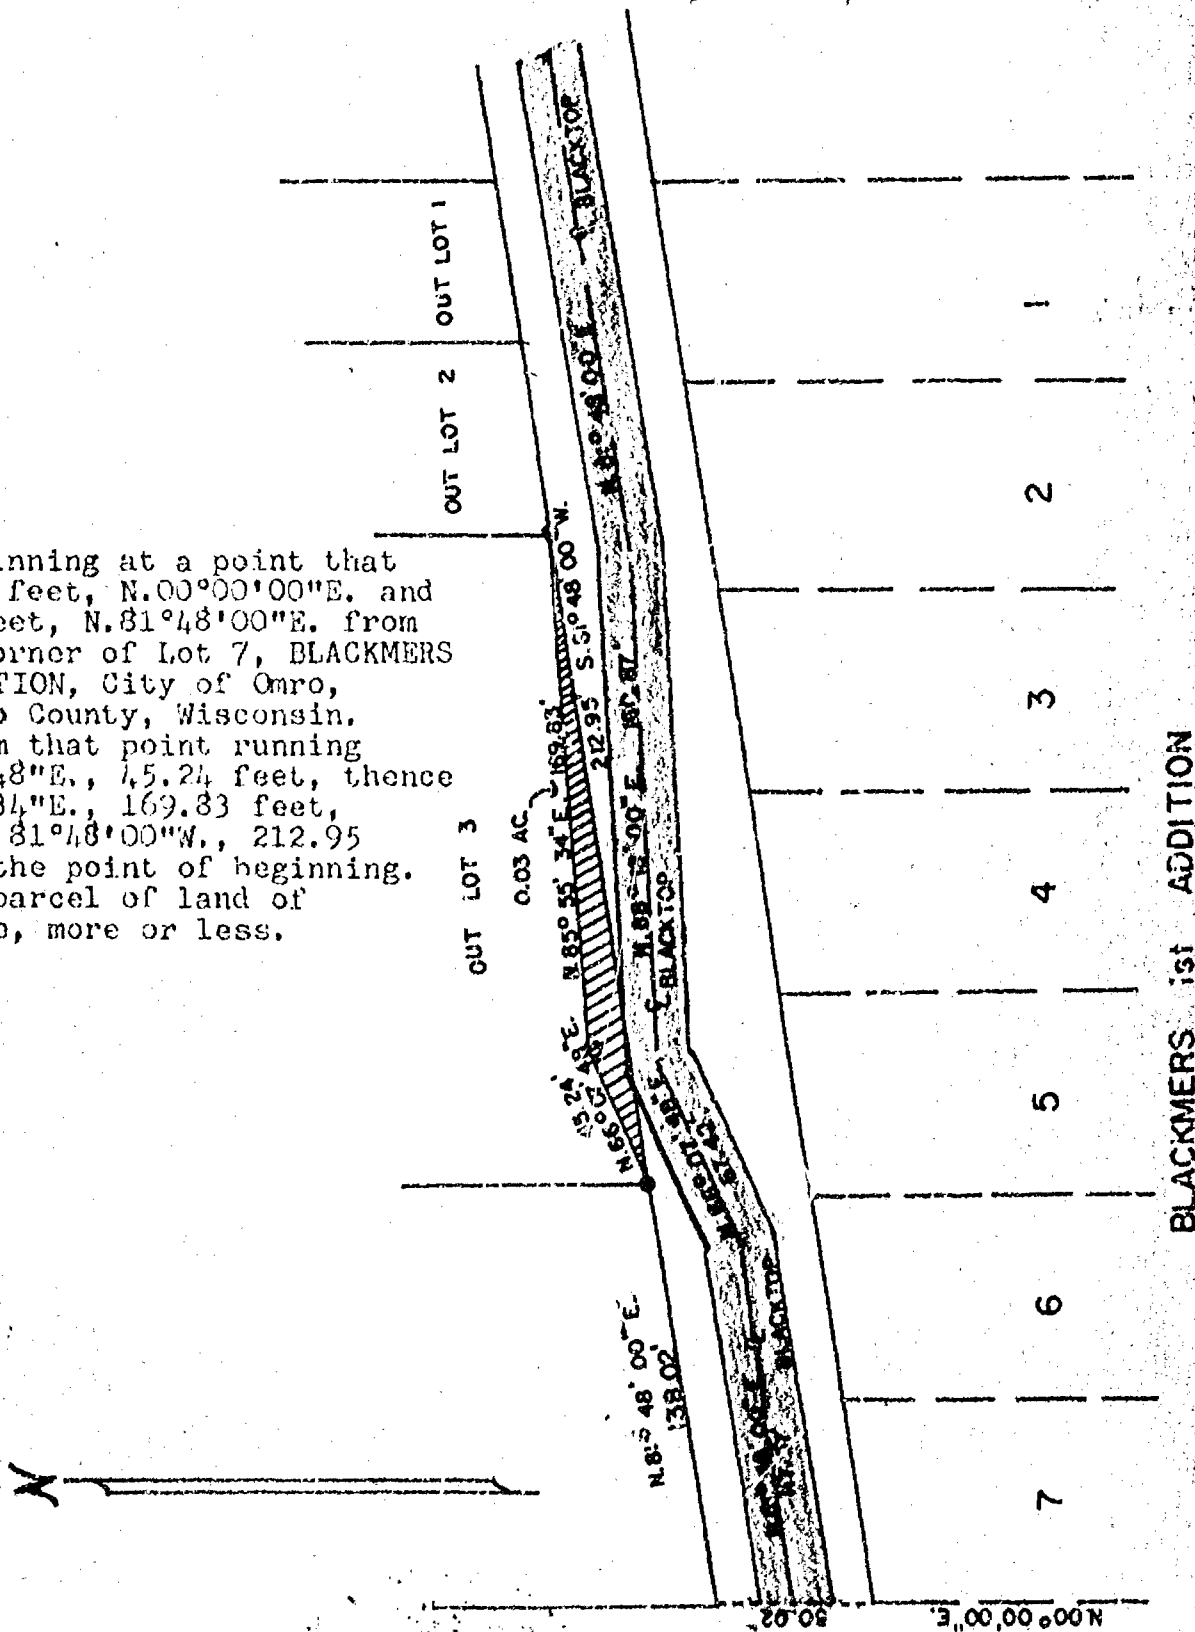

LEGEND

- = Existing monuments
- = 2" x 30" iron pipe set
- = 1" x 30" iron pipe set
- ⊙ = reference caps or RR spikes
- ⊙ = Bernier or Harrison monuments
- X-X = fence
- () = recorded as
- = stone monument



SURVEYORS CERTIFICATE

I, hereby certify that I have surveyed the property as shown, according to official records and that the plat above drawn is an accurate and correct representation of said survey. JULY 1, 19 81

Calvin W. Hawksworth

Wisconsin Registered Land Surveyor S-1290



R. K. SAYLER, INC.
LAND SURVEYORS
WINNECONNE, WI 54986

SCALE 1" = 60'
PROJECT NO. S-001220
FIELD BOOK 39 PAGE 159


Omro

Plat of Survey

LOT 6, BLOCK SIX (6) OF THE ORIGINAL PLAT OF OMRO IN THE CITY OF OMRO, WINNEBAGO COUNTY, WISCONSIN.

CLIENT:
Lawrence Kowalke
230 Monroe Avenue
Omro, WI 54963

N

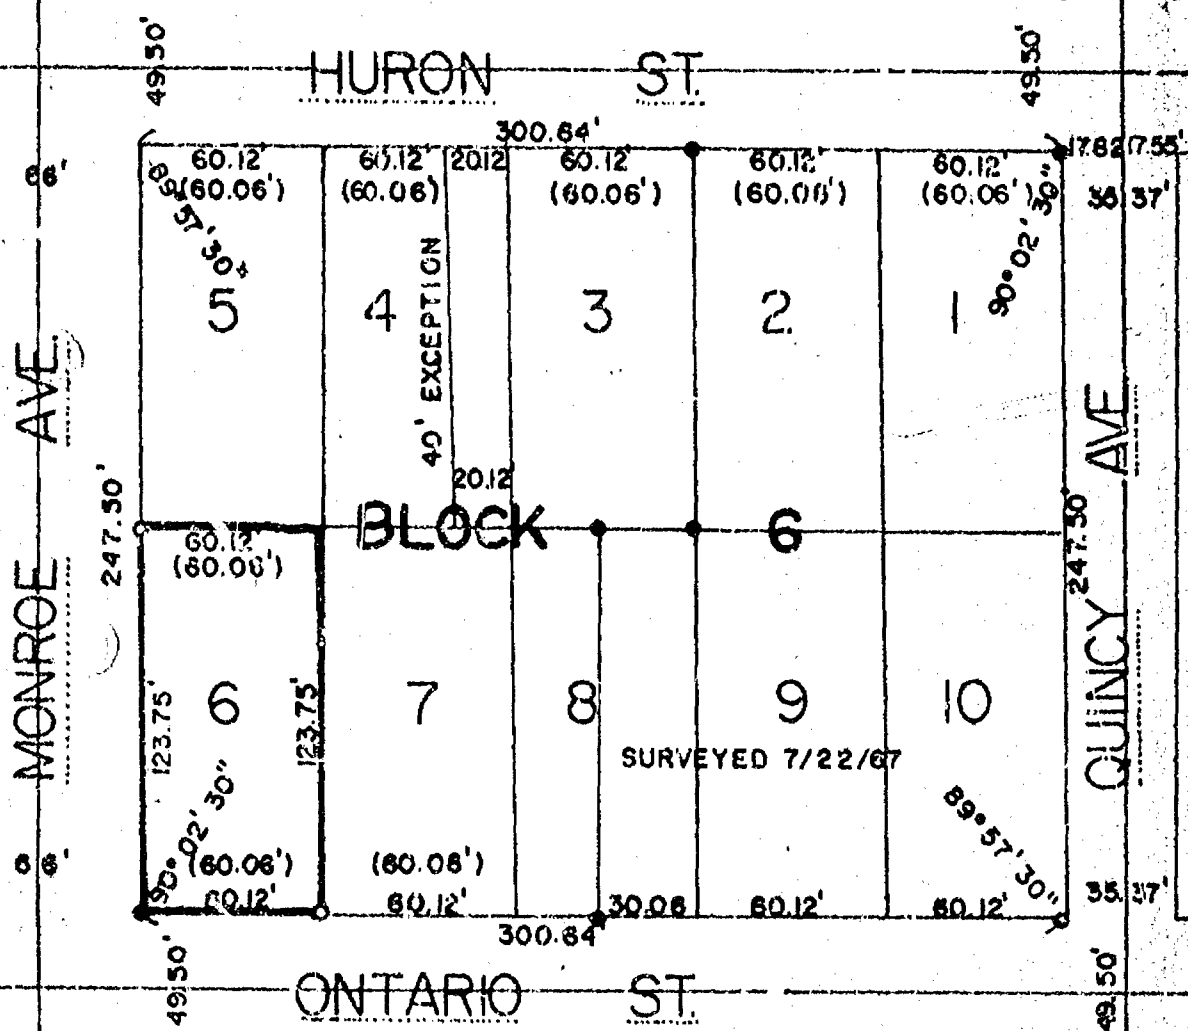

LEGEND

- = Existing monuments
- = 2" x 30" iron pipe set
- = 1" x 30" iron pipe set
- = reference caps or RR spikes
- ⊙ = Bernsen or Harrison monuments
- X—X = fence
- () = AS MEASURED 7/22/67
- = stone monument



SURVEYORS CERTIFICATE

I, hereby certify that I have surveyed the property as shown, according to official records and that the plat above drawn is an accurate and correct representation of said survey. JUNE 3, 1981

Calvin W. Hawksworth

Wisconsin Registered Land Surveyor S-1290

S

S


R. K. SAYLER, INC.
LAND SURVEYORS
WINNECONNE, WI 54986

SCALE 1" = 60'
PROJECT NO. S-001209
FIELD BOOK 42 PAGE 93


Winnebago

The North 30.00 feet of Lots 9 & 10 and the South $\frac{1}{2}$ of
Lots 7 & 8 in Block 9 of the ORIGINAL PLAT OF THE CITY OF
OMRO, Winnebago County, Wisconsin.

CLIENT: Catherine Heffron
312 S. Webster Ave.
Omro, Wisconsin 54963

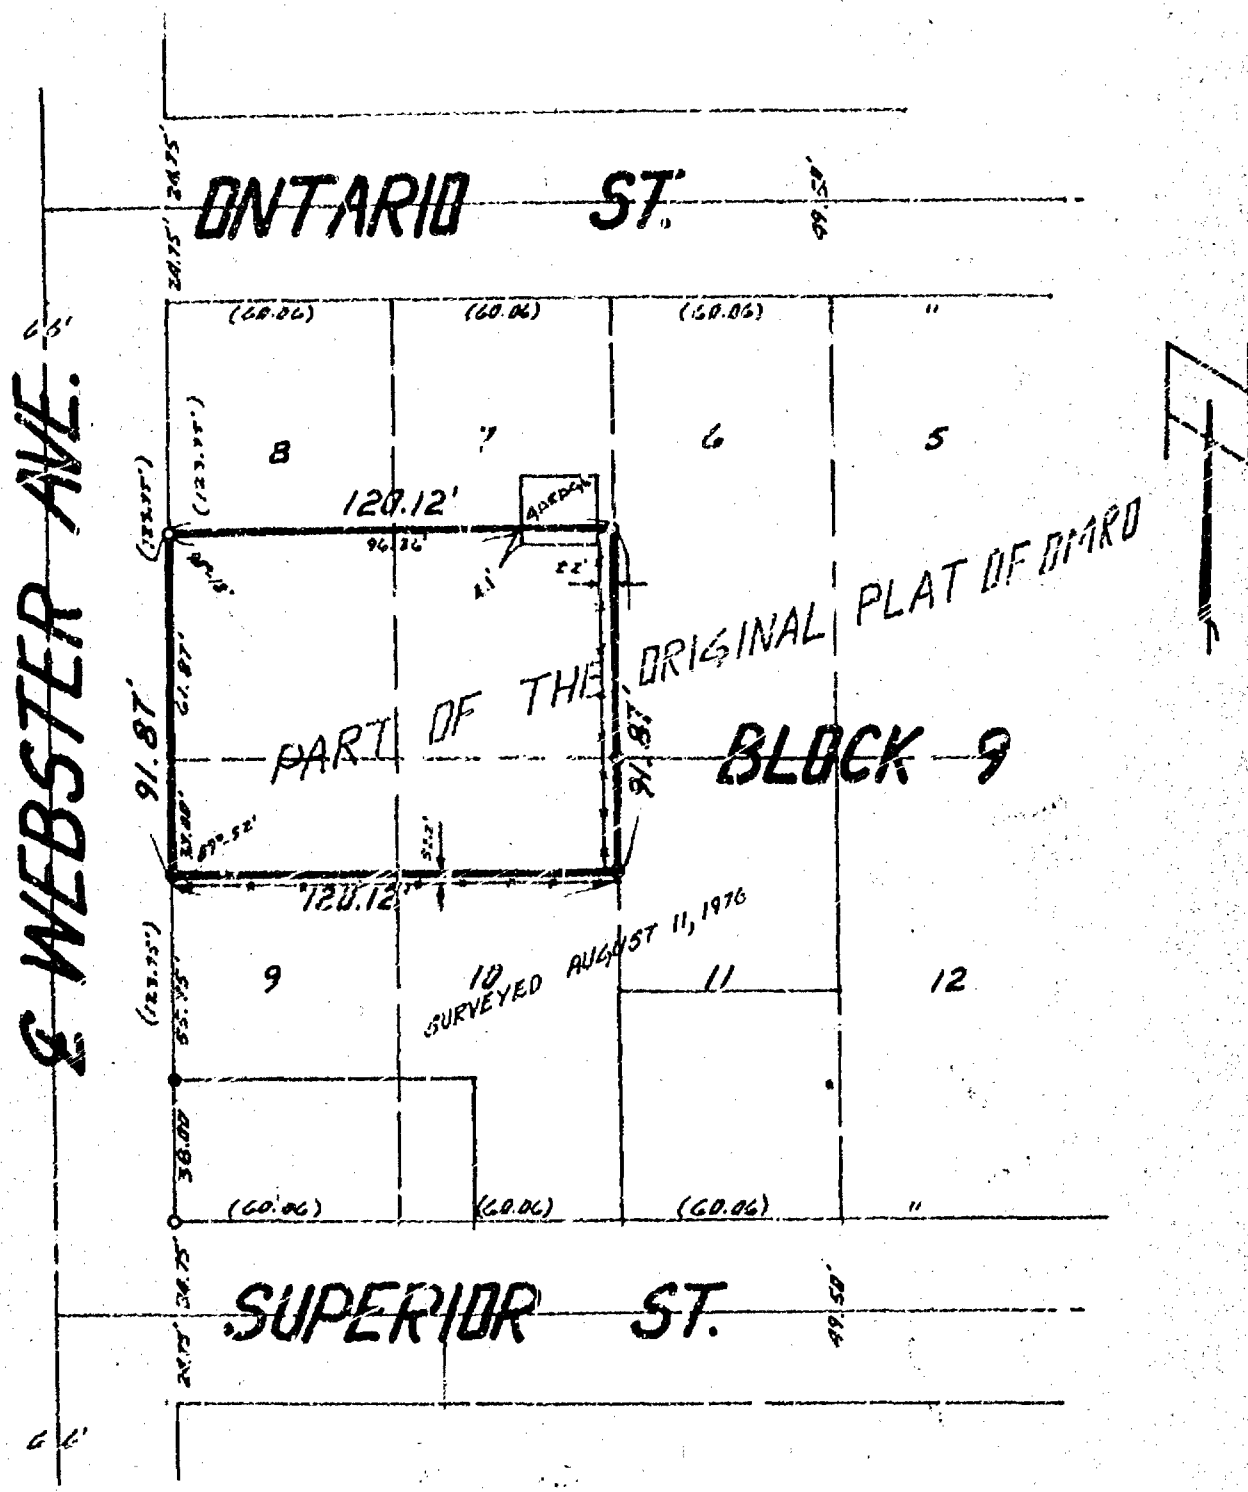

- = Existing monuments
- = 2' x 30" iron pipe set
- ◊ = 1' x 30" iron pipe set
- ⊙ = reference caps or R.R. spikes
- ⊕ = Bernitsen or Harrison monuments
- X--X = fence
- () = recorded pt.
- = stone monument

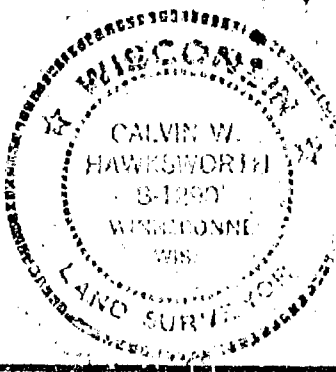

I, hereby certify that I have surveyed the property as shown, according to official records and that the plat above drawn is an accurate and correct representation of said survey. May 13, 1980

Colin W. Hachbaum S-1290
Wisconsin Registered Land Surveyor

S

S

R. K. SAYLER, INC.
LAND SURVEYORS
WINNECONNE, WI 54986



SCALE 1" = 50'
PROJECT NO. S-701089
FIELD BOOK 39 PAGE 123

Omro

Plat of Survey

Lots 10 & 11, Block G, JOHNSON'S 2ND ADDITION to the City of Omro, Winnebago County, Wisconsin.

CLIENT:
Lawson Blake
421 Walnut St.
Omro, WI 54963

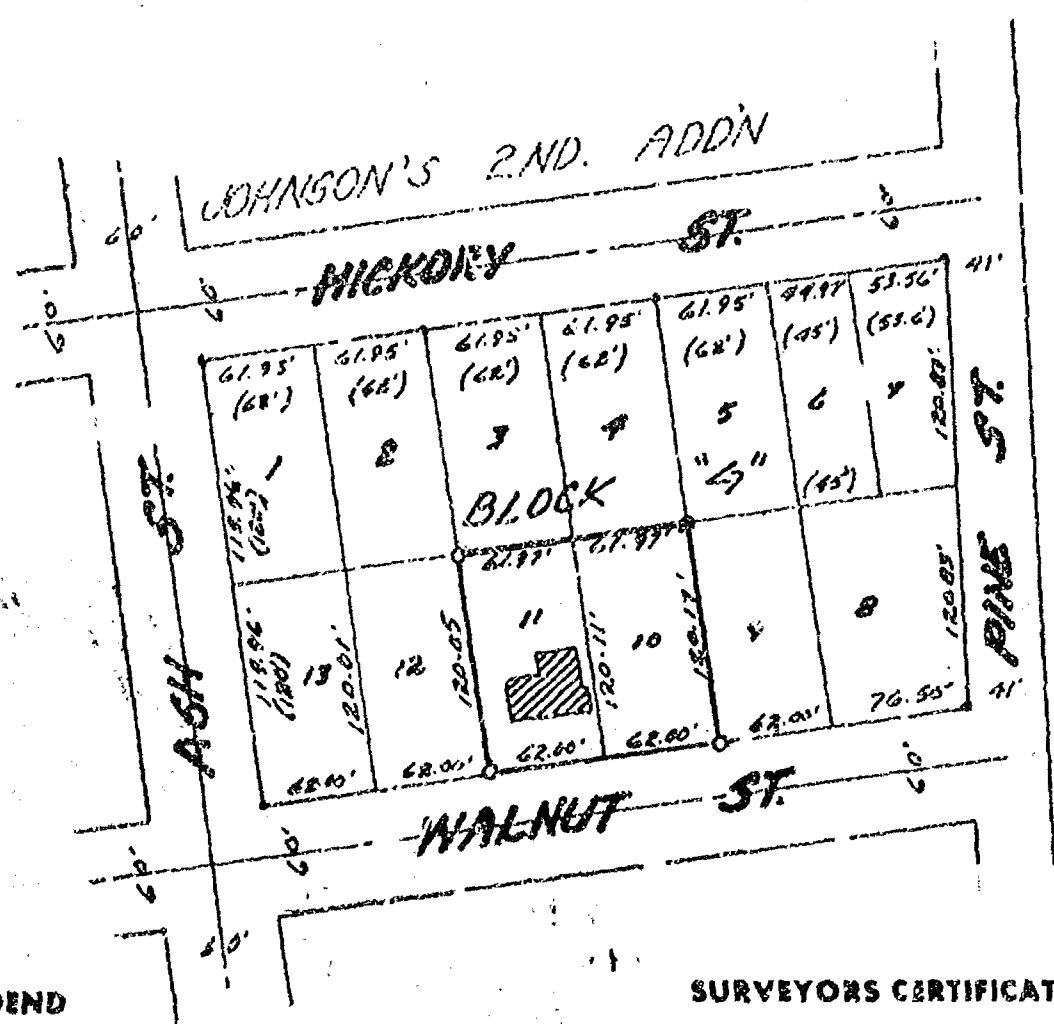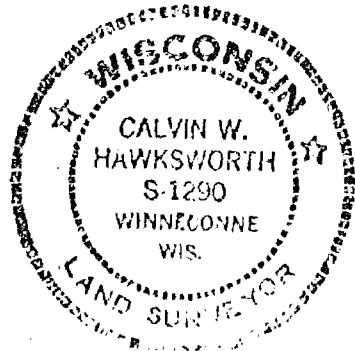

LEGEND

- = Existing monuments
- = 2" x 30" iron pipe set
- = 1" x 30" iron pipe set
- = reference caps or RR spikes
- ⊙ = Bernsten or Harrison monuments
- X-X = fence
- () = recorded as
- = stone monument

SURVEYORS CERTIFICATE

I, hereby certify that I have surveyed the property as shown, according to official records and that the plat above drawn is an accurate and correct representation of said survey. May 11, 1981

Calvin W. Hawksworth

Wisconsin Registered Land Surveyor S-1290



R. K. SAYLER, INC.
LAND SURVEYORS
WINNEBAGO, WI 54986

SCALE: 1"=100'
PROJECT NO. 1001201
FIELD BOOK 42 PAGE 62-60

OMRO

Winnebago


Plat of Survey

LOCATION OF THE EAST LINE OF STORBE PROPERTY, THE SAME BEING THE EAST LINE OF LOT 3, BLOCK SIX (6) OF THE ORIGINAL PLAT OF OMRO IN THE CITY OF OMRO, WINNEBAGO COUNTY, WISCONSIN.

CLIENT: David Stobbe
320 E. Huron
Omro, Wisconsin
54963


DRAFTED BY:

Joseph B. Schnitzler

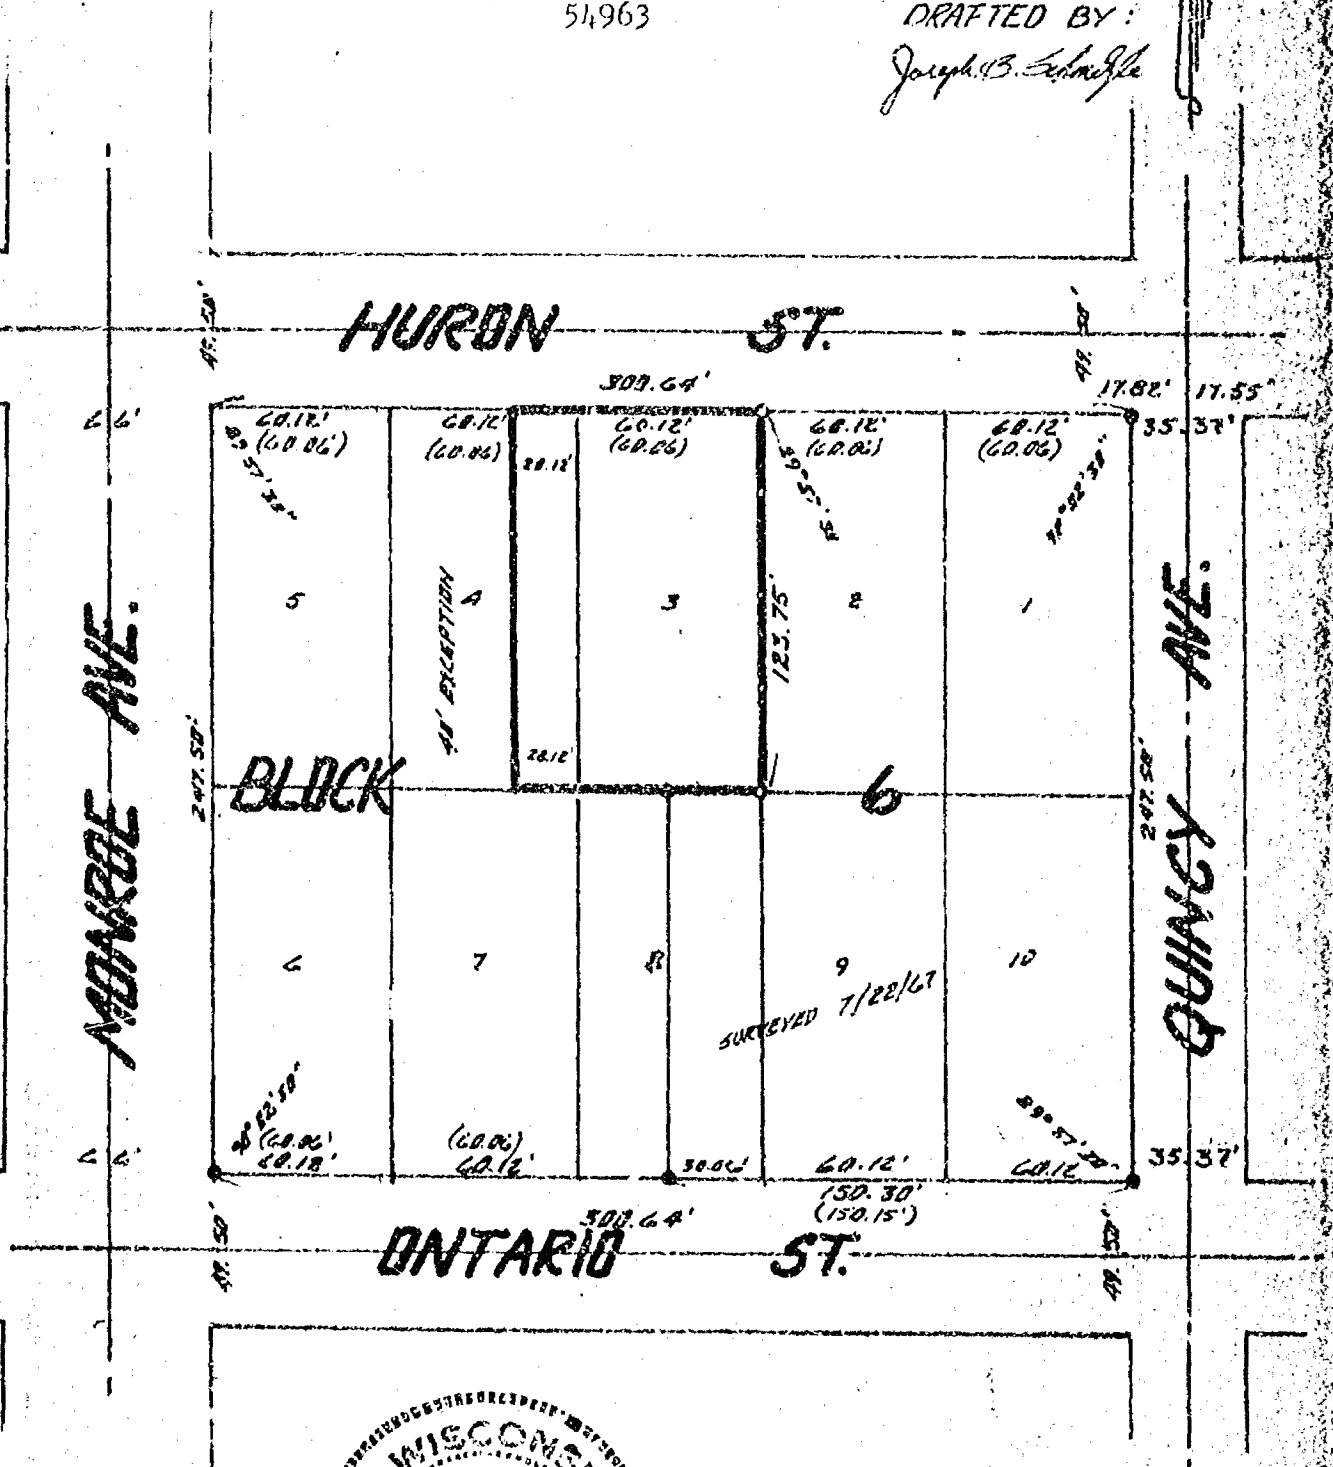

LEGEND

- = Existing monuments
- = 2" x 30" iron pipe set
- = 1" x 30" iron pipe set
- = reference caps or R.R. spikes
- = Bernisen or Harrison monuments
- X-X = fence
- () = AS MEASURED 7/22/67
- = stone monument

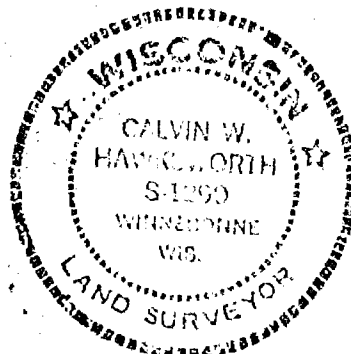

SURVEYORS CERTIFICATE

I, her, by certify that I have surveyed the property as shown, according to official records and that the plat above drawn is an accurate and correct representation of said survey. June 26, 19 80

Calvin W. Hawksworth

Wisconsin Registered Land Surveyor S-1290



R. K. SAYLER, INC.
LAND SURVEYORS
WINNECONNE, WI 54986

SCALE 1" = 40'
PROJECT NO. S-001109
FIELD BOOK 41 PAGE 133




Winn. Co.

Omro

Plat of Survey

Document No. 469218: Vernus C. Larson & Muriel F. Larson

Lot 15 and the E $\frac{1}{2}$ of that part of the right of way (now abandoned) of Milwaukee, St. Paul and Pacific Railroad Co. lying Westerly of and adjacent to said Lot 15 and between the extended North and South line of said Lot 15, all in FRANK'S SECOND ADDITION TO OMRO, in the third ward, City of Omro, Winnebago County, Wisconsin.

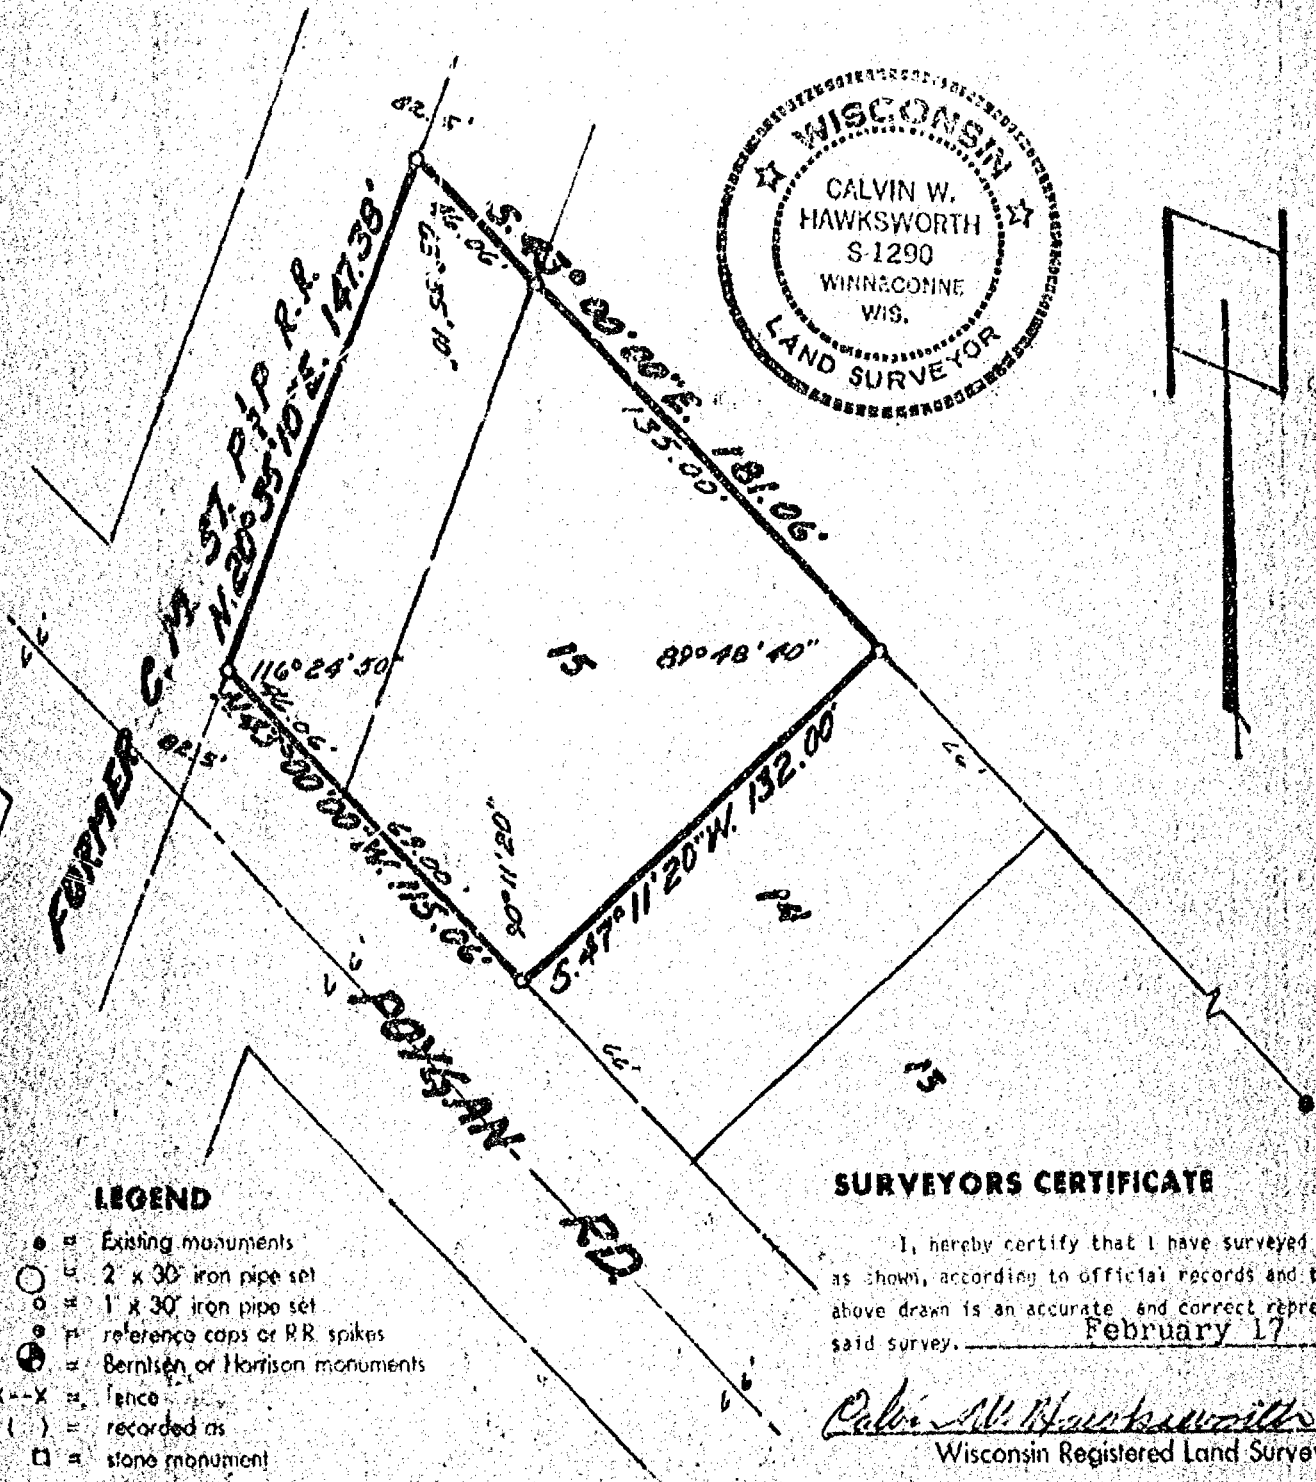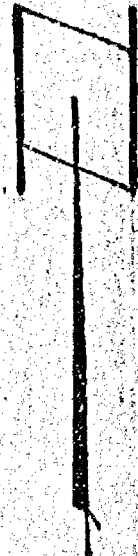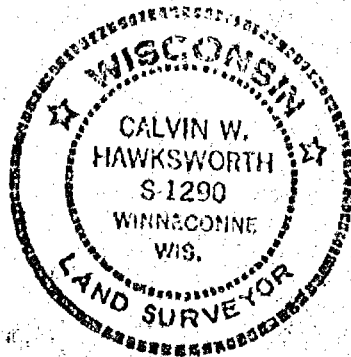

R. K. SAYLER, INC.
LAND SURVEYORS
WINNEBAGO, WI 54986

SCALE 1" = 50'
PROJECT NO. S-001180
FIELD BOOK 42 PAGE 39/40


Survey For E. Mulder: - J. Wallace Atty.

Description For Parcel # 1

The South 60.0 ft. Of Lot # 34, Lying East Of Lot # 33 And Its Extended North Line, Also The Northerly 6.0 ft. Of Lot # 6, All In Wilson's Add., City Of Omro, Wis.



WILSON'S ADD.

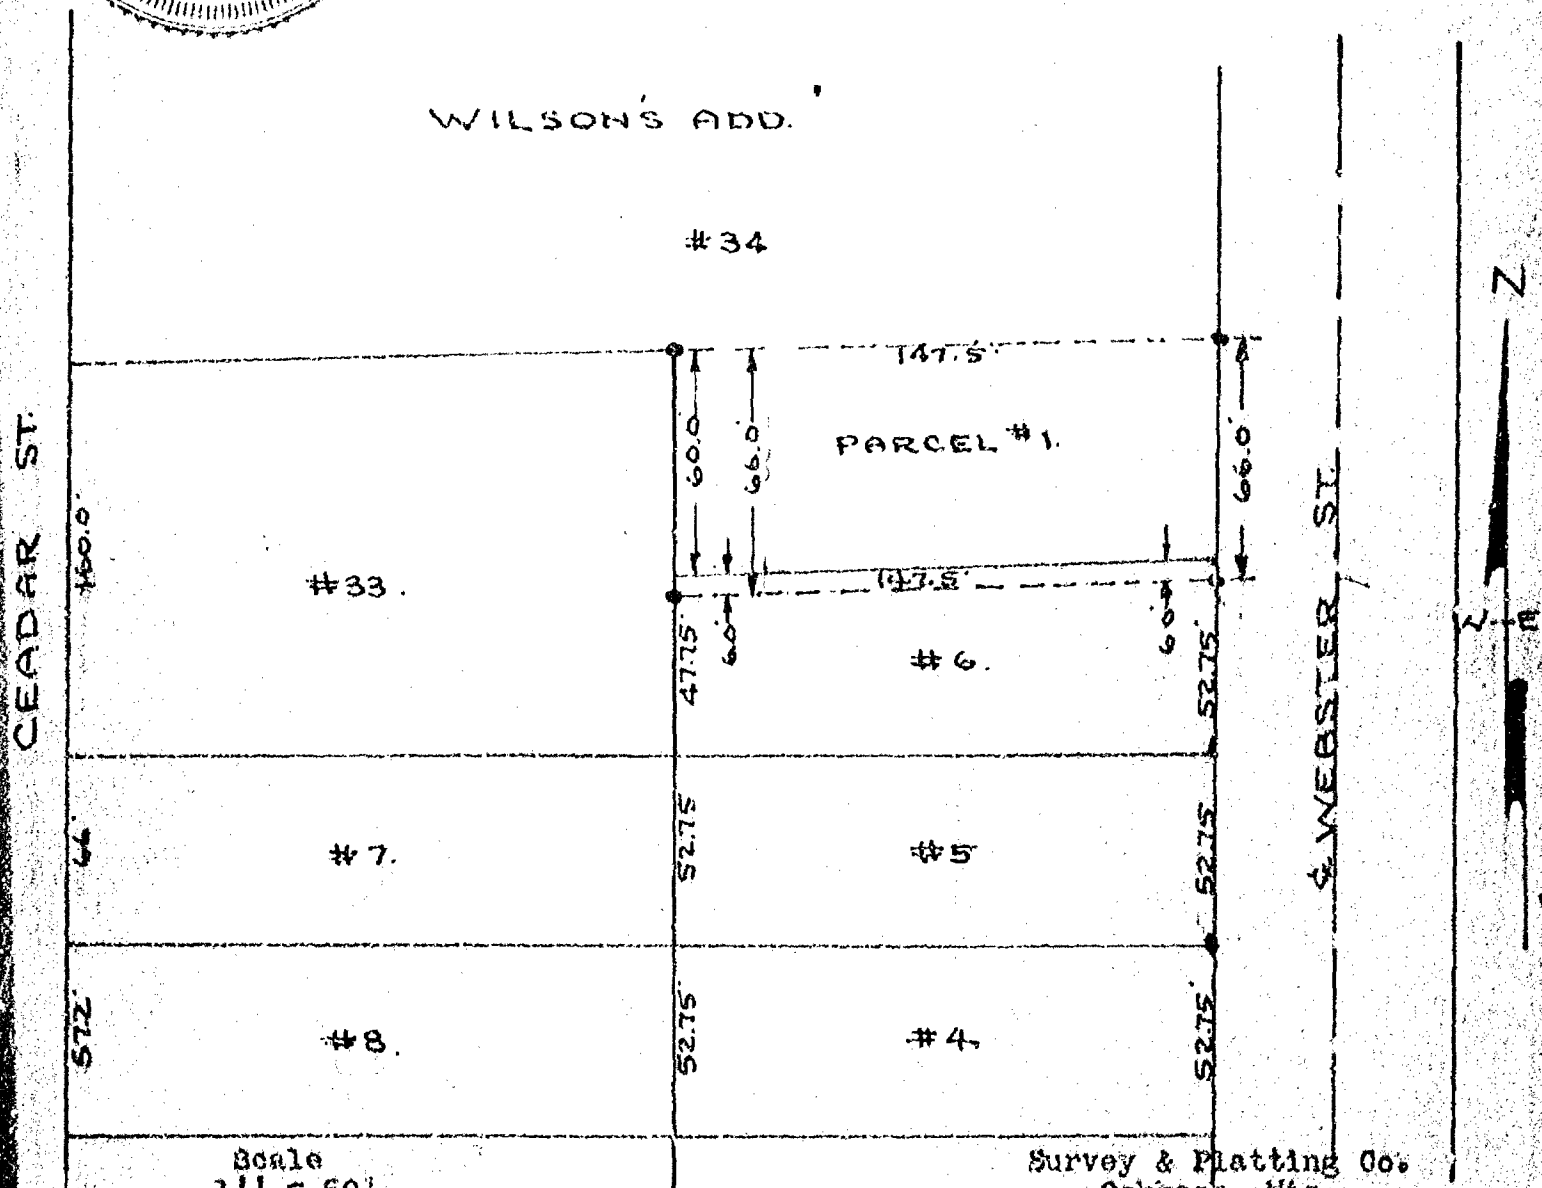

Scale
1" = 50'
Iron Stakes Shown Thus - •

Survey & Platting Co.
Oshkosh, Wis.
T.E. Stearns - Reg. Surveyor
Sept. 11, 1969

7-18-15

5

Survey For Frank Kalata:

Description For Parcel # 2

That Part Of The N.E.1/4 Of The S.E.1/4 Of Sec. 7-18-15, City Of Omro, Winnebago County, Wis. Described As Follows: Commencing At The Intersection Of The Centerline Of C.T.H. 'F' & The East Line Of Sec. 7-18-15, Thence N. 43° 0' W. Along The Centerline Of Said Highway, 1632.0 ft. To The Place Of Beginning; Thence N. 47° 0' E., A Distance Of 180.0 ft., Thence S. 43° 0' E. Parallel To Said Highway 80.0 ft., Thence S. 47° 0' W., 100.0 ft. To Centerline Of Said Highway, Thence N. 43° 0' W. To The Place Of Beginning. Said Parcel Contains 0.33 Acres More Or Less.

Description For Parcel # 3

That Part Of The N.E.1/4 Of The S.E.1/4 Of Sec. 7-18-15, City Of Omro, Winnebago County, Wis. Described As Follows: Commencing At The Intersection Of The Centerline Of C.T.H. 'F' & The East Line Of Sec. 7-18-15, Thence N. 43° 0' W. Along The Centerline Of Said Highway 1477.0 ft. To The Place Of Beginning; Thence N. 47° 0' E. A Distance Of 180.0 ft., Thence S. 43° 0' E., Parallel To Said Highway 80.0 ft., Thence S. 47° 0' W., 180.0 ft. To Centerline Of Said Highway, Thence N. 43° 0' W. To The Place Of Beginning. Said Parcel Contains 0.33 Acres More Or Less.

OUT LOTS # 49 / 50 - NORTH OF FOX RIVER

CITY OF OMRO

N.E. 1/4 OF S.E. 1/4
SEC. 7-18-15

S.E. 1/4 OF N.E. 1/4

Scale
1" = 100'

Iron Stakes Shown Thus - •

Survey & Platting Co.
Oshkosh, Wis.
T.E. Stearns - Reg. Surveyor
July 3, 1965
REV. SEPT. 17, 1970



Survey & Platting Co.
Oshkosh, Wis.
T.E. Stearns - Reg. Surveyor

Sept. 23, 1970

Survey For Frank Kalata:

Description For Parcel # 4

That Part Of Outlot #49 In The N.E.1/4 Of The S.E.1/4 Of Sec. 7-18-15, City Of Omro, Winnebago County, Wis. Bounded AND Described As Follows:
Commencing At The Intersection Of The Centerline Of C.T.H. 'F' & The East Line Of Sec. 7-18-15, Thence N.43°0'W. Along The Centerline Of Said Highway, 1472.0 ft. To The Place Of Beginning: Thence N.47°0'E. A Distance Of 180.0 ft. Thence N.43°0'W., 80.0 ft., Thence S.47°0'W., 180.0 ft. To The Centerline Of Said Highway, Thence S.43°0'E., 80.0 ft. To The Place Of Beginning. Said Parcel Contains 0.33 Acres More Or Less Except That Portion Used For Highway Purposes.

Description For Parcel # 5

That Part Of Outlot # 49 In The N.E.1/4 Of The S.E.1/4 Of Sec. 7-18-15, City Of Omro, Winnebago County, Wis. Bounded & Described As Follows:
Commencing At The Intersection Of The Centerline Of C.T.H. 'F' & The East Line Of Sec. 7-18-15, Thence N.43°0'W. Along The Centerline Of Said Highway, 1632.0 ft. To The Place Of Beginning: Thence N.47°0'E. A Distance Of 180.0 ft. Thence N.43°0'W., 80.0 ft., Thence S.47°0'W., 180.0 ft. To The Centerline Of Said Highway, Thence S.43°0'E., 80.0 ft. To The Place Of Beginning. Said Parcel Contains 0.33 Acres More Or Less Except That Portion Used For Highway Purposes.

Description For Parcel # 6

That Part Of The N.E.1/4 Of The S.E.1/4 & The S.E.1/4 Of The N.E.1/4 & Also Part Of Outlots # 49 & 50 In Outlots North Of The Fox River, All In Sec. 7-18-15, City Of Omro, Winnebago County, Wis. Bounded & Described As Follows:
Commencing At The Intersection Of The Centerline Of C.T.H. 'F' & The East Line Of Sec. 7-18-15, Thence N.43°0'W. Along The Centerline Of Said Highway 1712.0 ft. To The Place Of Beginning: Thence N.47°0'E. A Distance Of 180.0 ft. Thence N.43°0'W., 80.0 ft., Thence S.47°0'W., 180.0 ft. To The Centerline Of Said Highway, Thence S.43°0'E., 80.0 ft. To The Place Of Beginning. Said Parcel Contains 0.33 Acres More Or Less Except That Portion Used For Highway Purposes.

Description For Parcel # 7

That Part Of The N.E.1/4 Of The S.E.1/4 & The S.E.1/4 Of The N.E.1/4 & Also Part Of Outlots # 49 & 50 In Outlots North Of The Fox River, All In Sec. 7-18-15, City Of Omro, Winnebago County, Wis. Bounded & Described As Follows:
Commencing At The Intersection Of The Centerline Of C.T.H. 'F' & The East Line Of ~~###~~ Sec. 7-18-15, Thence N.43°0'W. Along The Centerline Of Said Highway 1792.0 ft. To The Place Of Beginning: Thence N.47°0'E. A Distance Of 180.0 ft., Thence N.43°0'W., 80.0 ft., Thence S.47°0'W., 180.0 ft. To The Centerline Of Said Highway, Thence S.43°0'E., 80.0 ft. To The Place Of Beginning. Said Parcel Contains 0.33 Acres More Or Less Except That Portion Used For Highway Purposes.

Survey For Frank Kalata:

Description For Frank Kalata - Parcel # 1

That Part Of Sec. 7-18-15, City Of Omro, Winnebago County, Wis. Described As Follows: That Part Of The S.W. $\frac{1}{4}$ Of The N.E. $\frac{1}{4}$ Of Sec. 7-18-15 Described As Follows: Commencing At The Intersection Of The Centerline Of C.T.H. 'F' And The East Line Of Sec. 7-18-15, Thence N. $43^{\circ}0'W$. Along The Centerline Of Said Highway, 2032.0 ft. To The Place Of Beginning: Thence N. $47^{\circ}0'E$. A Distance Of 180.0 ft., Thence N. $43^{\circ}0'W$. Parallel To Said Highway, 100.0 ft., Thence S. $47^{\circ}0'W$. 180.0 ft. To Centerline Of Said Highway, Thence S. $43^{\circ}0'E$. Along Said Centerline Of Highway 100.0 ft. To The Place Of Beginning. Said Parcel Contains 0.41 Acres More Or Less.

C. GOODWIN

PARCEL # 2.
0.68 AC.

PARCEL # 1.
0.41 AC.

CITY OF OMRO

S.W. $\frac{1}{4}$ OF N.E. $\frac{1}{4}$
SEC. 7-18-15

Description For Merle Kurtz - Parcel # 2
That Part Of Sec. 7-18-15 In The City Of Omro, Winnebago County, Wis. Described As Follows: That Part Of The S.W. $\frac{1}{4}$ Of The N.E. $\frac{1}{4}$ Of Sec. 7-18-15 Described As Follows: Commencing At The Intersection Of The Centerline Of C.T.H. 'F' & The East Line Of Sec. 7-18-15, Thence N. $43^{\circ}0'W$. Along The Centerline Of Said Highway, 2132.0 ft. To The Place Of Beginning: Thence N. $47^{\circ}0'E$. A Distance Of 180.0 ft., Thence N. $43^{\circ}0'W$. Parallel To Said Highway 165.0 ft., Thence S. $47^{\circ}0'W$. 180.0 ft. To Centerline Of Said Highway, Thence S. $43^{\circ}0'E$ Along Said Centerline Of Highway 165.0 ft. To The Place Of Beginning. Said Parcel Contains 0.68 Acres More Or Less.

Scale
1" = 100'
Iron Stakes Shown Thus -

Survey & Platting Co.
Oshkosh, Wis.
T.E. Stearns - Reg. Surveyor
Oct. 12, 1964



E. LINE OF SEC. 7-18-15


Survey For Registered Homes:

Description For Lot # 19

All Of Lot # 19 In The North Side Add., City Of Omro, Wis.

Description For Lot # 20

All Of Lot # 20 In The North Side Add., City Of Omro, Wis.

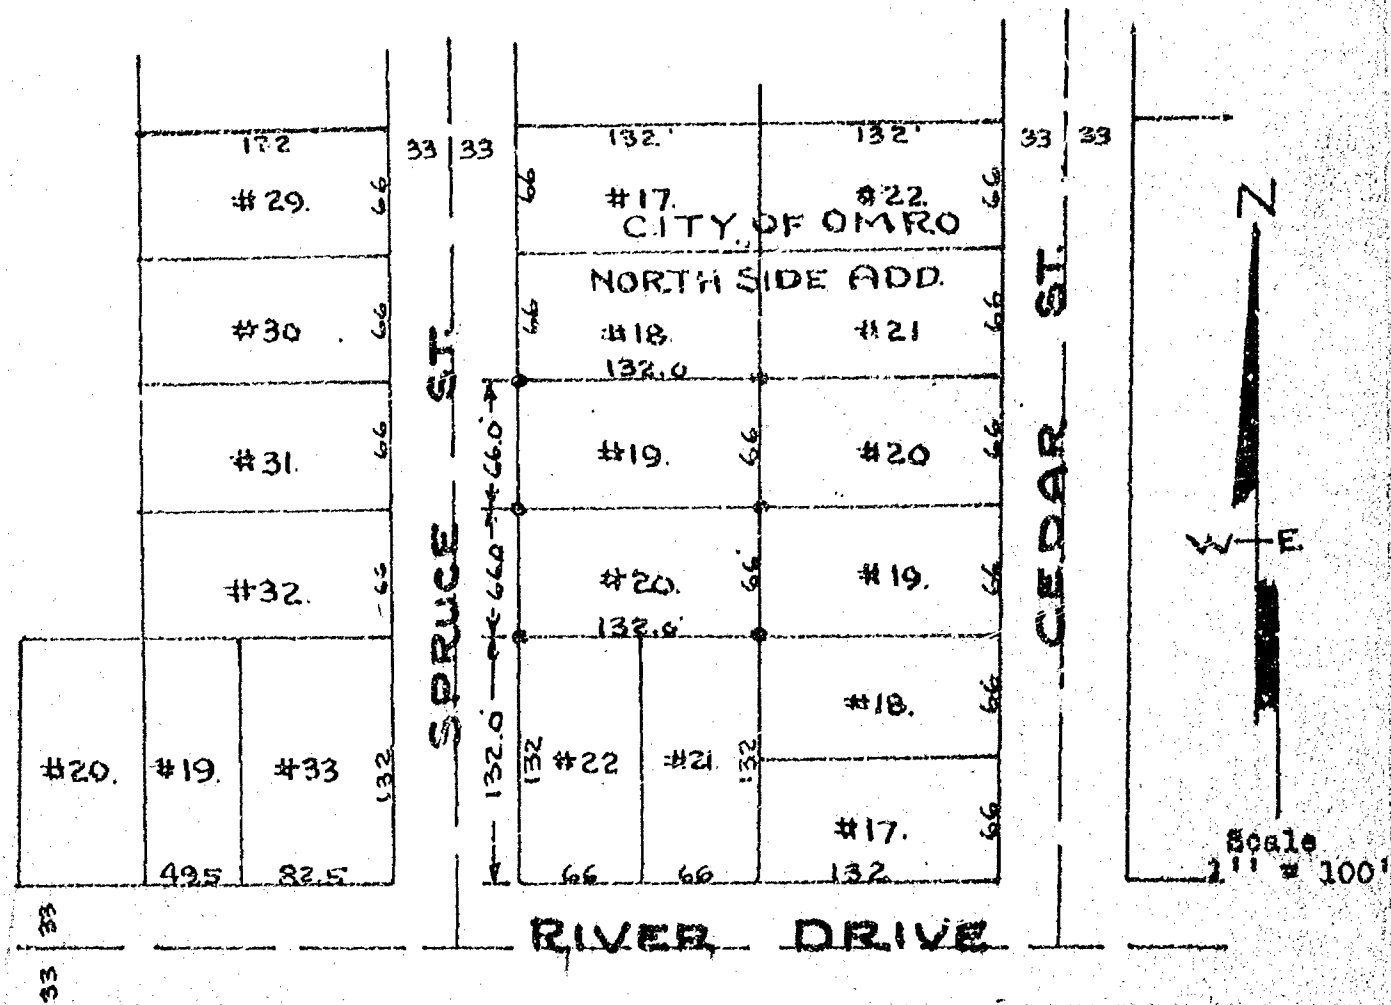


Iron Stakes Shown Thus - •

Survey & Platting Co.
Oshkosh, Wis.
T.E. Stearns - Reg. Surveyor
Aug. 26, 1972




7-13-15

5

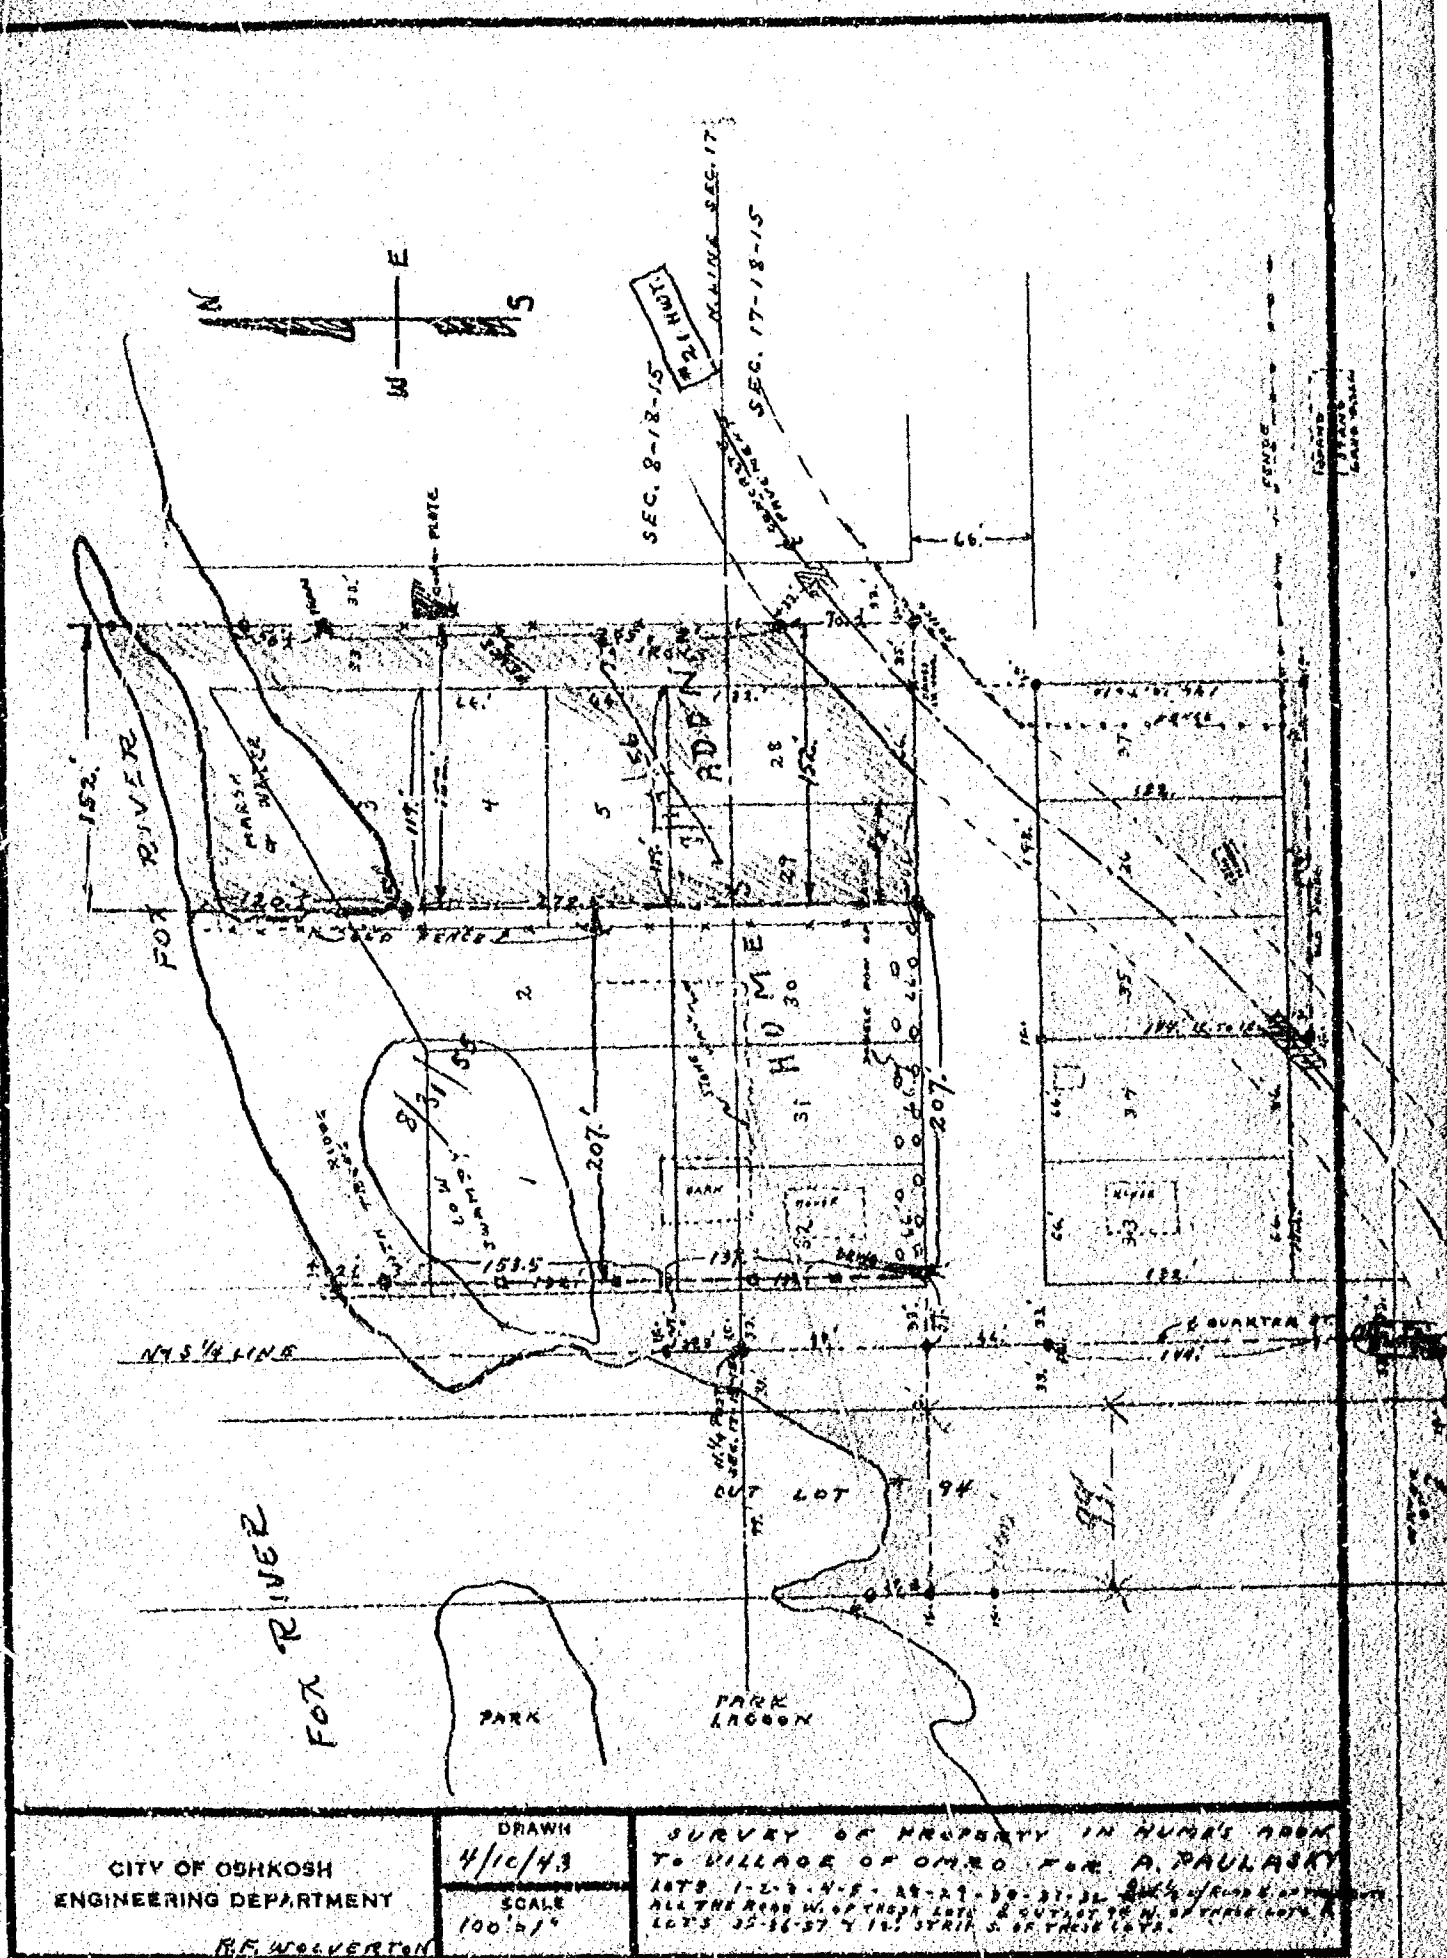

SURVEY OF LOT 3 BLOCK 1 JOHNSONS FIRST ADDITION TO THE VILLAGE OF OSHKOSH WISCONSIN 1915

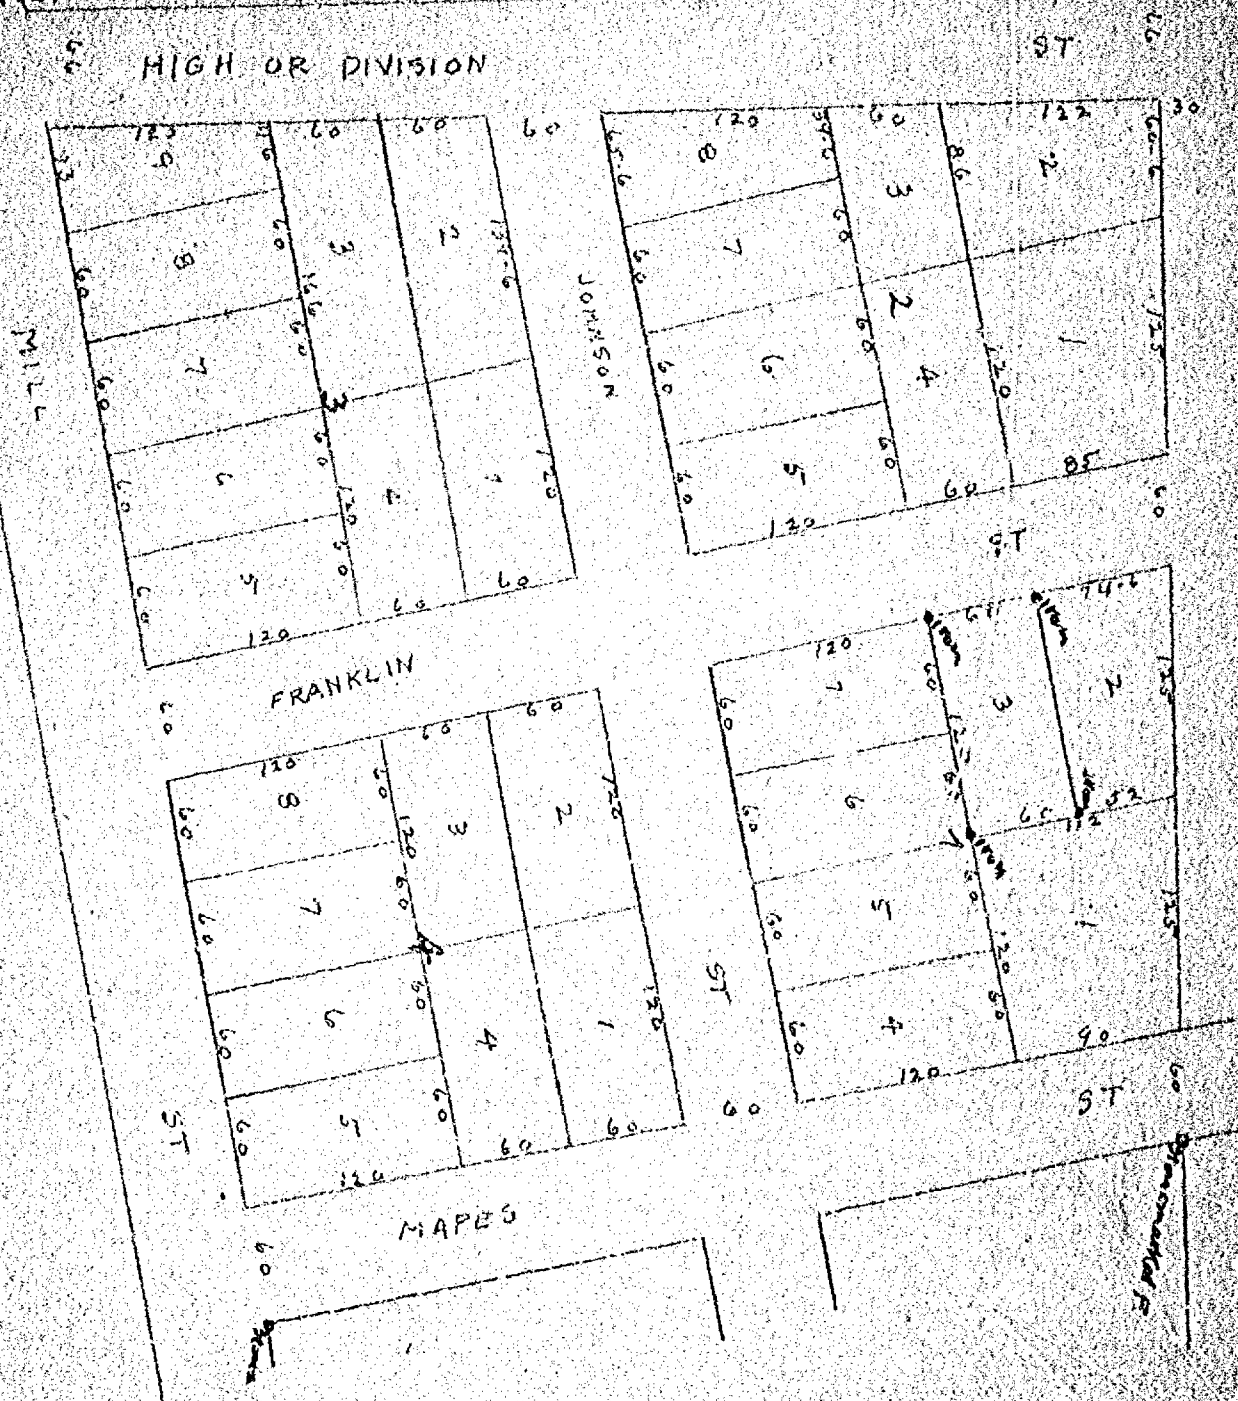

I found stones set as shown on above map and from those stones I surveyed out Lot 3 of Block 1 according to the Record Plat and set iron stakes as shown on above map marked in Red Ink Began April 14th Completed April 14th 1915.

W W Gould Co Surveyor
W W Gould Chainman
Earl Bronson

CITY OF OSHKOSH ENGINEERING DEPARTMENT	DRAWN	SURVEY OF LOT 3 BLOCK 1 JOHNSONS FIRST ADDITION TO THE VILLAGE OF OSHKOSH WISCONSIN
	SCALE 1" = 100'	

Survey For First National Bank: House In Cairo

Description of Lot:

All of Lot # 7 And The East 16.0 ft. Of The South 103.0 ft. And The East 10.0 ft. Of The North 17.0 ft. Of Lot # 6, Also The South 10.0 ft. Of Vacated Birch St. And The Adjoining West 5.0 ft. Of Vacated Pine St. All In Johnson's 2nd. Addn To Omro, In The Village Of Omro, & Now In The 3rd. Ward Of The City Of Omro.


CERTIFICATE

To All Parties Interested In Title To Premises Surveyed.

I Hereby Certify That I Have Surveyed The Above Described Property, A Copy Of Which Is Set Forth Hereon, That The Survey Accurately Locates The Building On The Property & That There Are No Encroachments On The Property Or From The Property Onto Another Property Except As May Be Reflected On Survey.

Dated: April 26, 1968

T.E. Stearns - Reg. Surveyor #359

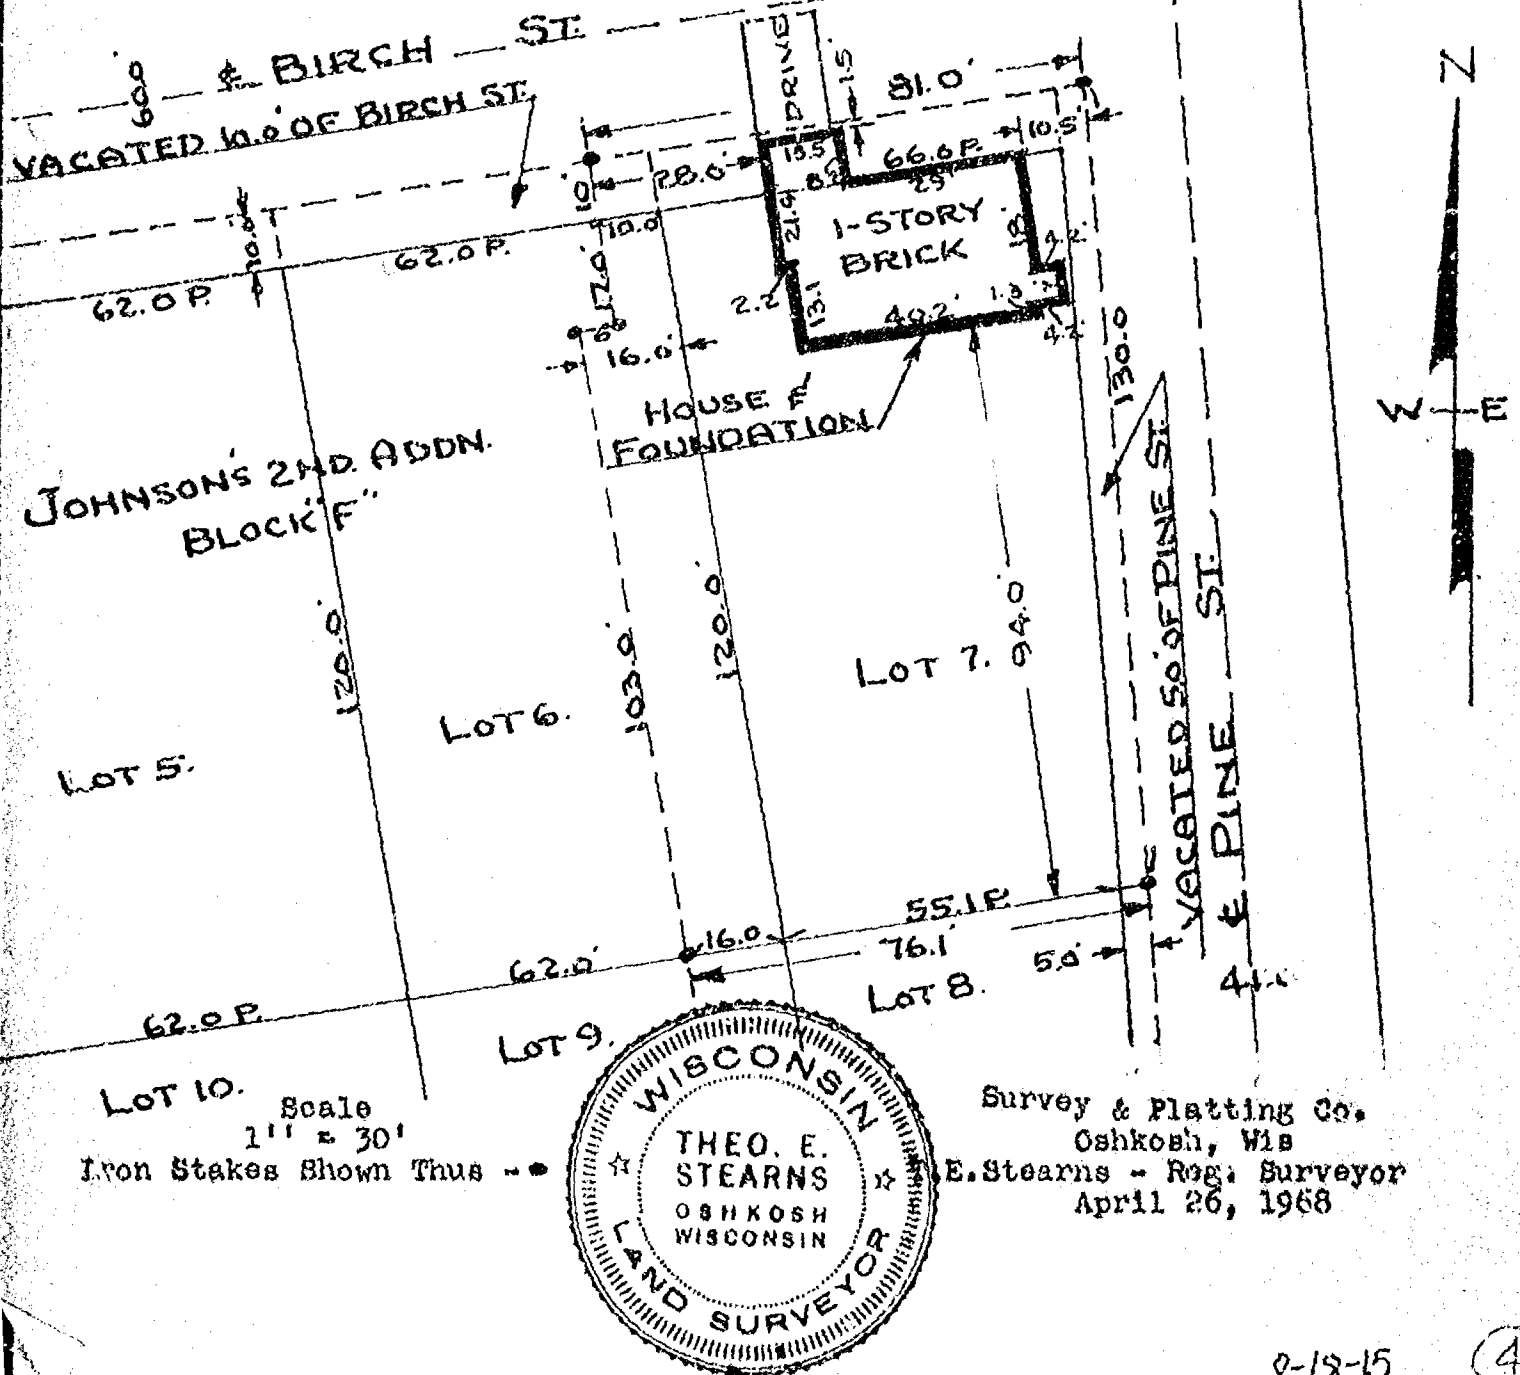

Lot Description:

The map depicts several land parcels with the following details:

- Parcels:** Labeled 1, 2, 3, 4, 5, and 6.
- Block D:** Indicated between parcels 1 and 2.
- Johnson's Addn.:** Located near parcel 1.
- G. Smith:** Located near parcel 4.
- Streets:** QUINCY ST (top), BIRCH ST (bottom), and ASH ST (right).
- Dimensions:** Various measurements are provided along the boundaries, such as 109.0, 80.7, 54.0, 62.0, 120.0, 88.5, 20.0, 62.0, 120.0, 120.0, 122.2, 61.5, 82.5, 62.0, 109.0, and 80.7.
- North Arrow:** Points towards the upper right.
- Surveyor Seal:** Circular seal for THEO. E. STEARNS, LAND SURVEYOR, OSHKOSH WISCONSIN.


7-18-15

⑤

Survey For John J. Verburt: - % R. Janson Att'.

Description For Parcel # 1

Commencing At The South West Corner Of Lot #1 In Frank's Third Addn., City Of Oshkosh, Wis., Thence East Along The South Line Of Lot # 1, A Distance Of 132.0 ft. To The Place Of Beginning; Thence North, Parallel With The West Line Of Lot # 1, 247.5 ft., Thence East, Parallel With The South Line Of Lot # 1, 41.5 ft., Thence South, Parallel With The West Line Of Lot # 1, 55.0 ft., Thence East, Parallel With The South Line Of Lot # 1, 61.0 ft., Thence South, Parallel With The West Line Of Lot # 1, 192.5 ft., Thence West Along The South Line Of Lot # 1, 102.6 ft. To The Place Of Beginning.

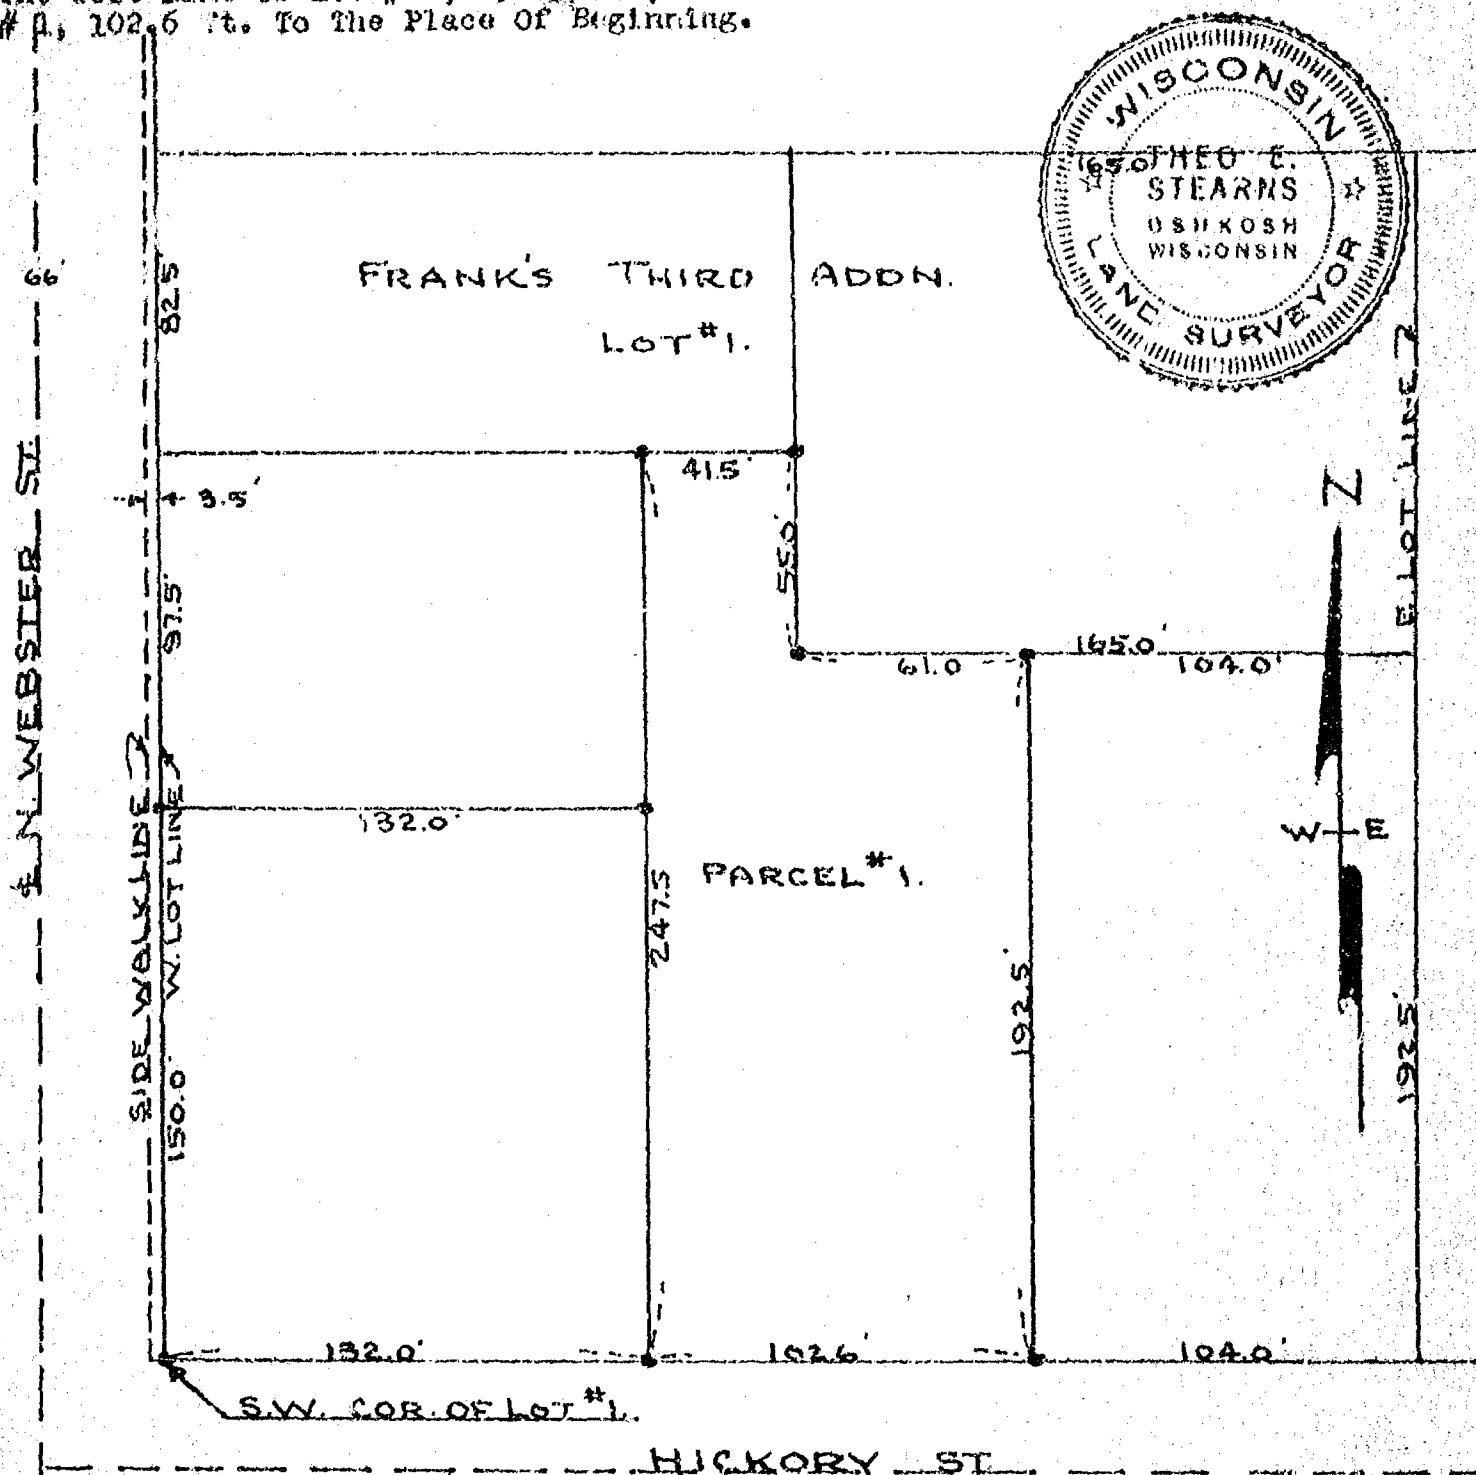


Scale
1" = 50'
Iron Stakes Shown True - •

Survey & Platting Co.
Oshkosh, Wis.
T.E. Stearns - Reg. Surveyor
Oct. 1, 1969

8-13-15

(5)

LOT #1 FRANKS 3RD ADDN.

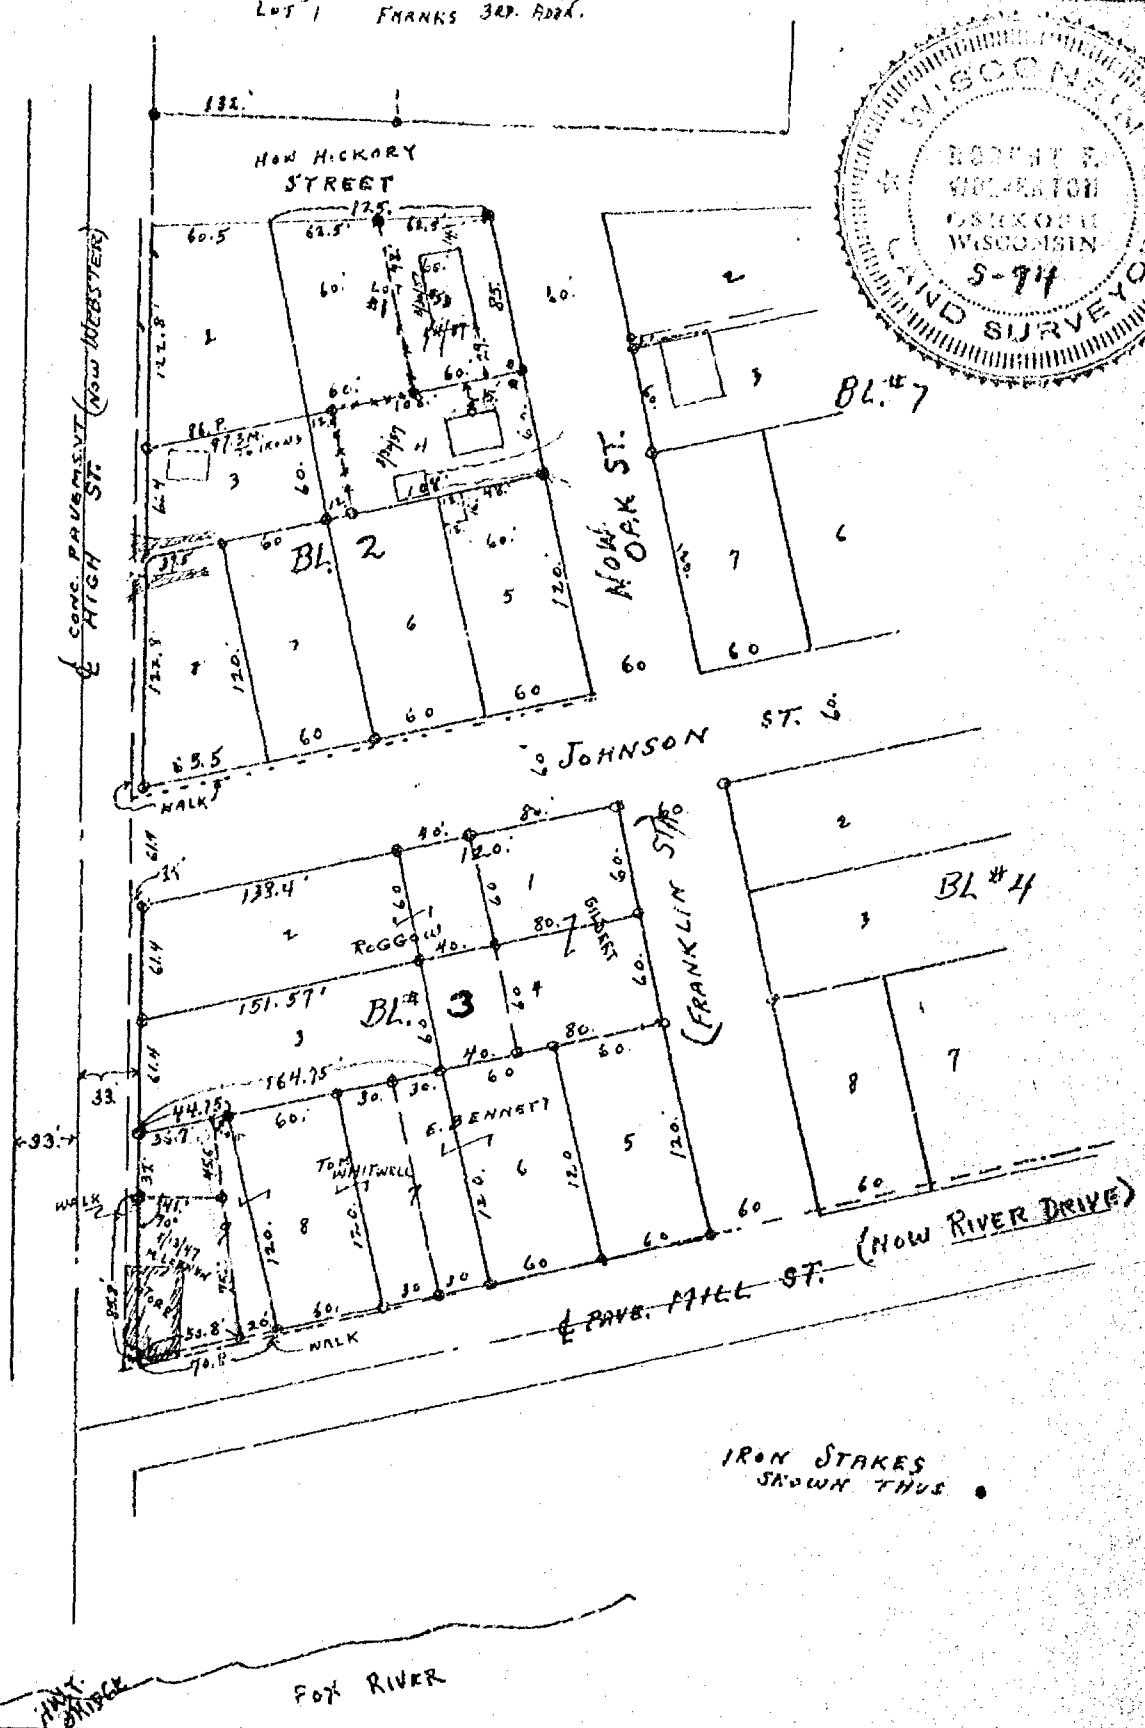


CITY OF OSHKOSH ENGINEERING DEPARTMENT R. P. WOLVERTSON CO. SURVEYOR	DRAWN 1956	(SUBDN. OF LOT #9 BL #3) JOHNSON'S ADDN. (ELY. 1/2 OF LOT #1 BL #2 4/4/51) JOHNSON'S ADDN.
	SCALE 1"=100'	

CITY OF OMRO 8-18-15


Survey For Ed. Kintaop - Kolbus Realty Co.

Description For Parcel # 1

A Parcel Of Land In The N.E. 1/4 Of Sec. 18-18-15, City Of Omro, Wis. Being Part Of Outlot # 49, Bounded & Described As Follows:
Beginning At The North East Corner Of Outlot # 49, Being Also The West Line Of Purposed New Washington St, Thence West Along The North Line Of O.L. #49, Being Also The South Line Of Larrabee St., 131.0 ft. To The Place Of Beginning Thence South, Parallel With The East Line Of O.L. # 49, 132.0 ft., Thence West, Parallel With The North Line Of O.L. # 49, 80.0 ft., Thence North, Parallel With The East Line Of O.L. #49, 132.0 ft. To The North Line Of O.L. #49, Thence East Along The North Line Of O.L. #49, 80.0 ft. To The Place Of Beginning.

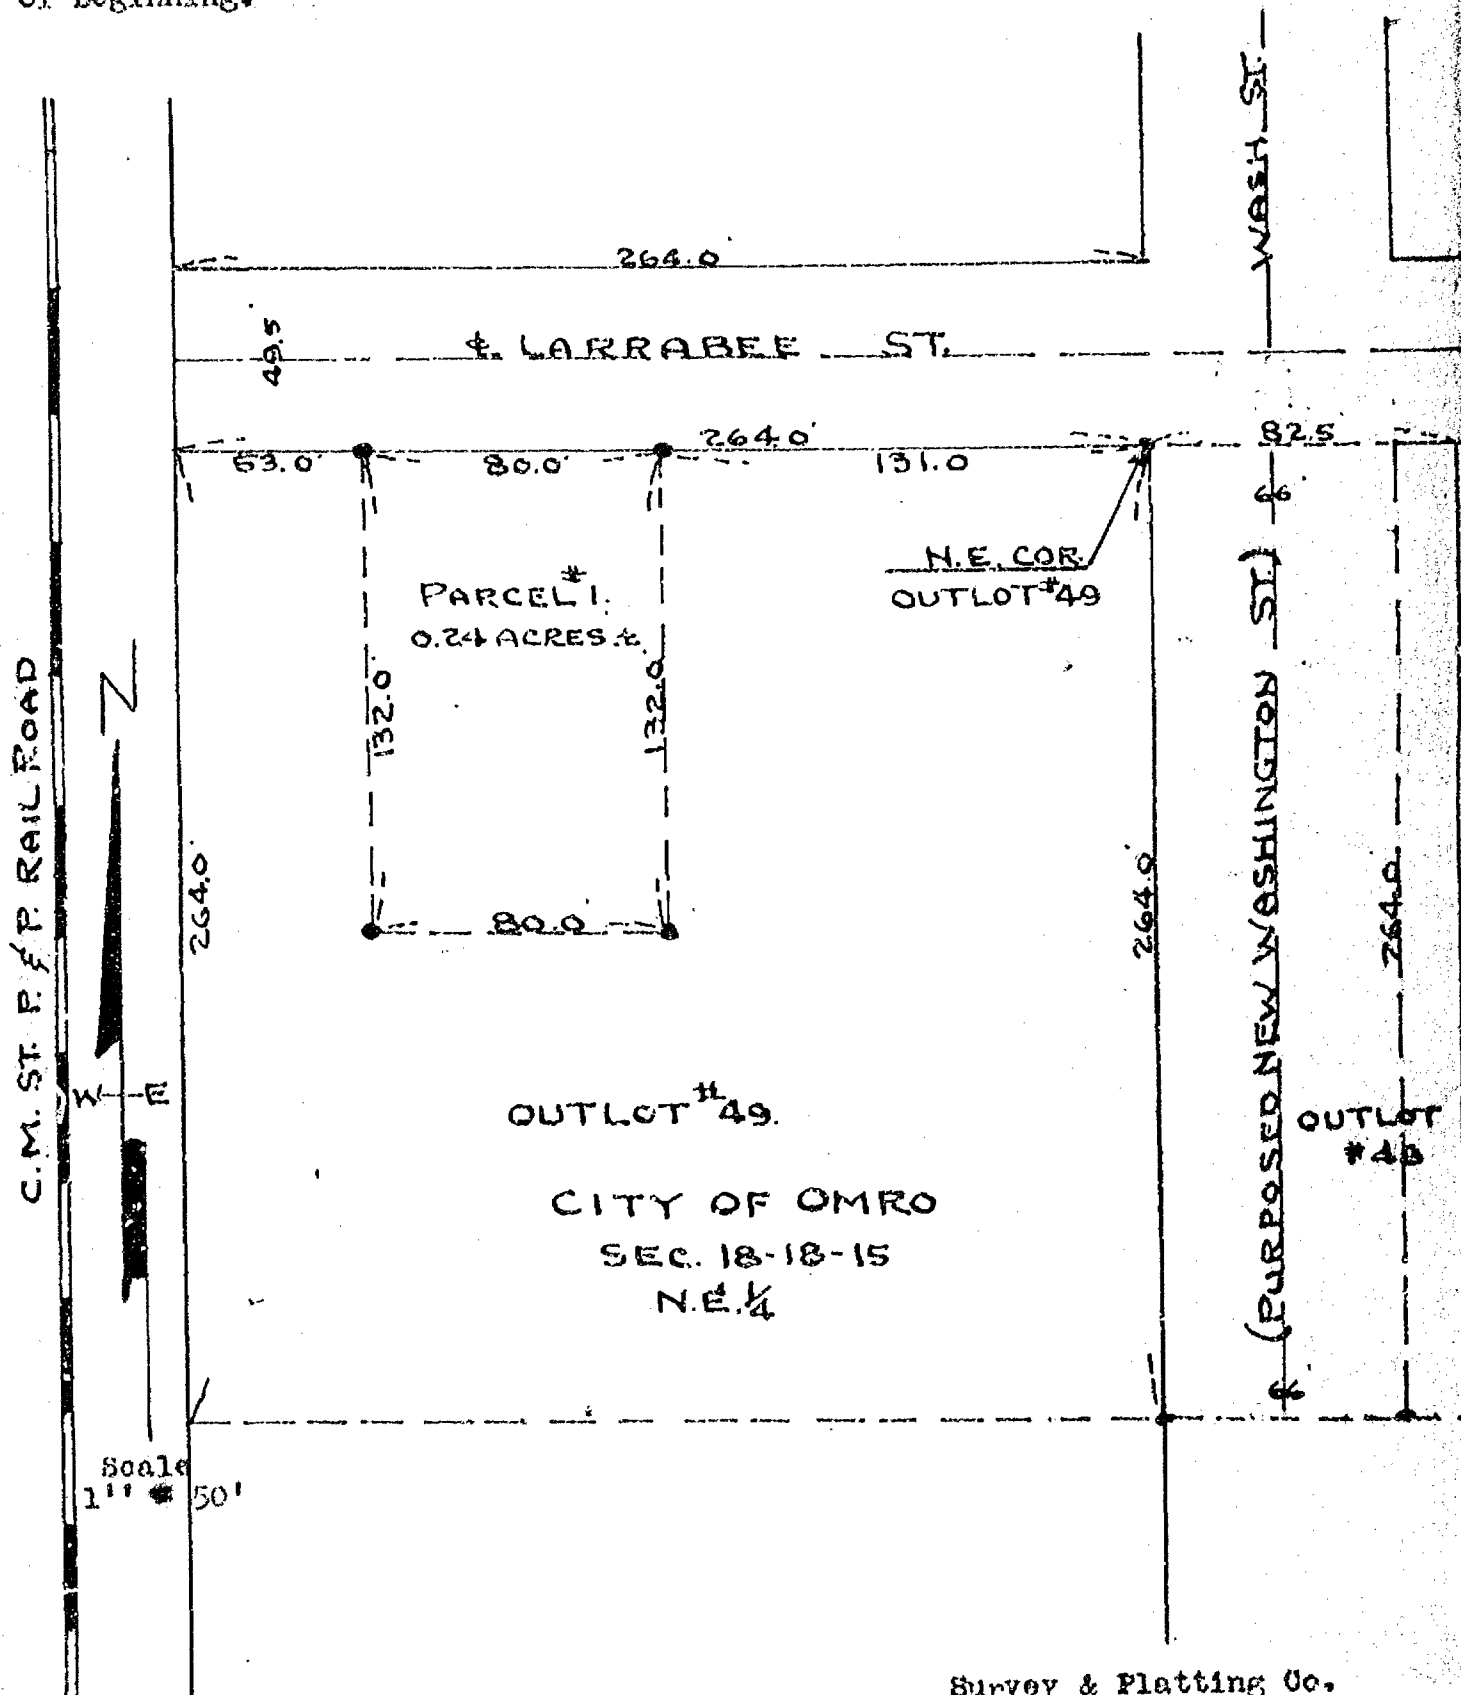

Iron Stakes Shown Thus - *

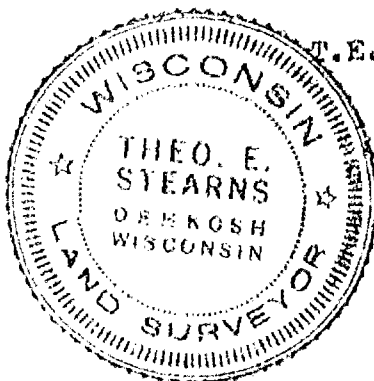

Survey & Platting Co.
Oshkosh, Wis.
T.E. Stearns - Reg. Surveyor
July 27, 1974


Survey For Elmer Wagner:

Description For Parcel # 2

That Part Of Outlot # 67 In The Plat Of Outlots, All In The N.E. 1/4 Of The S.E. 1/4 Of Sec. 18-18-15, City Of Omro, Bounded & Described As Follows: Commencing At The South West Corner Of Outlot # 67, Thence Due East, 41.7 ft., Thence N. 0° 0' E., 142.5 ft., Thence S. 62° 20' W., 49.6 ft., Thence Due South To The Place Of Beginning.


Description For Parcel # 3

All Of Lot # 1 In Putnams Add., Also That Part Of Outlot # 67 In The Plat Of Outlots, Described As Follows: Commencing At The Northwest Corner Of Lot # 9 In The Sunset Court Plat, Thence S. 30° 20' W. A Distance Of 132.0 ft., Thence S. 62° 20' W., A Distance Of 49.6 ft., Thence Northwesterly To The Place Of Beginning, All Being In The City Of Omro.

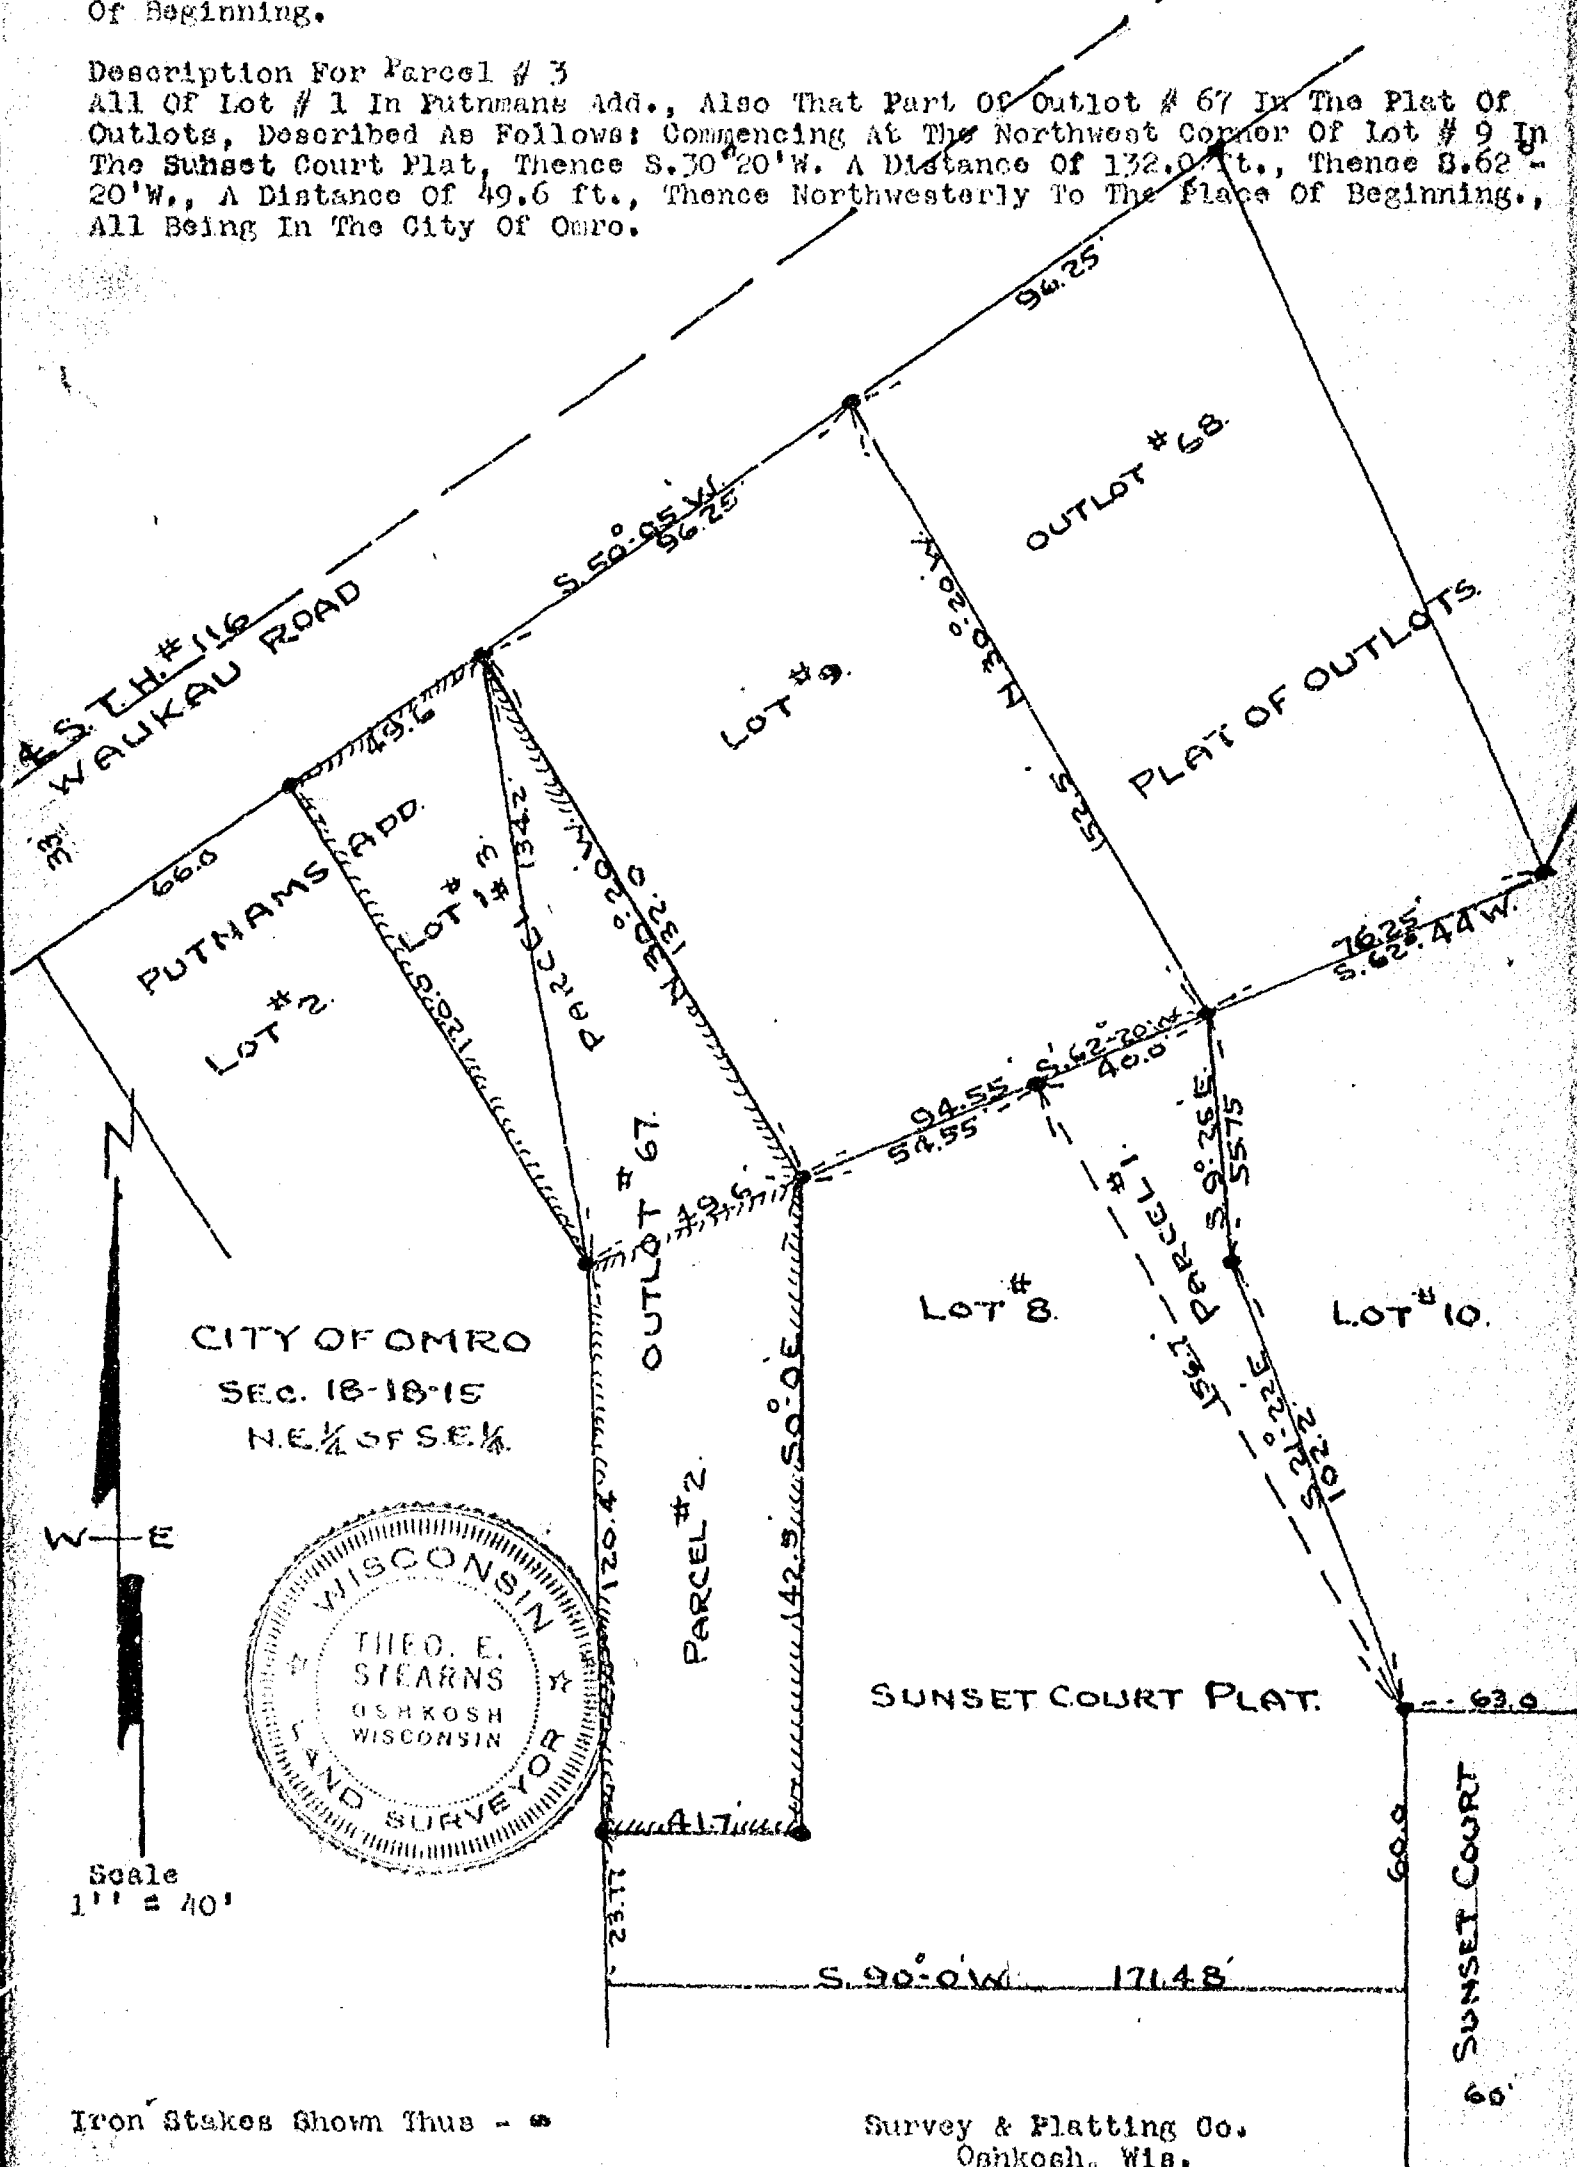

Iron Stakes Shown Thus - X


Survey & Platting Co.
Oshkosh, Wis.
T.E. Stearns - Reg. Surveyor
May 13, 1974

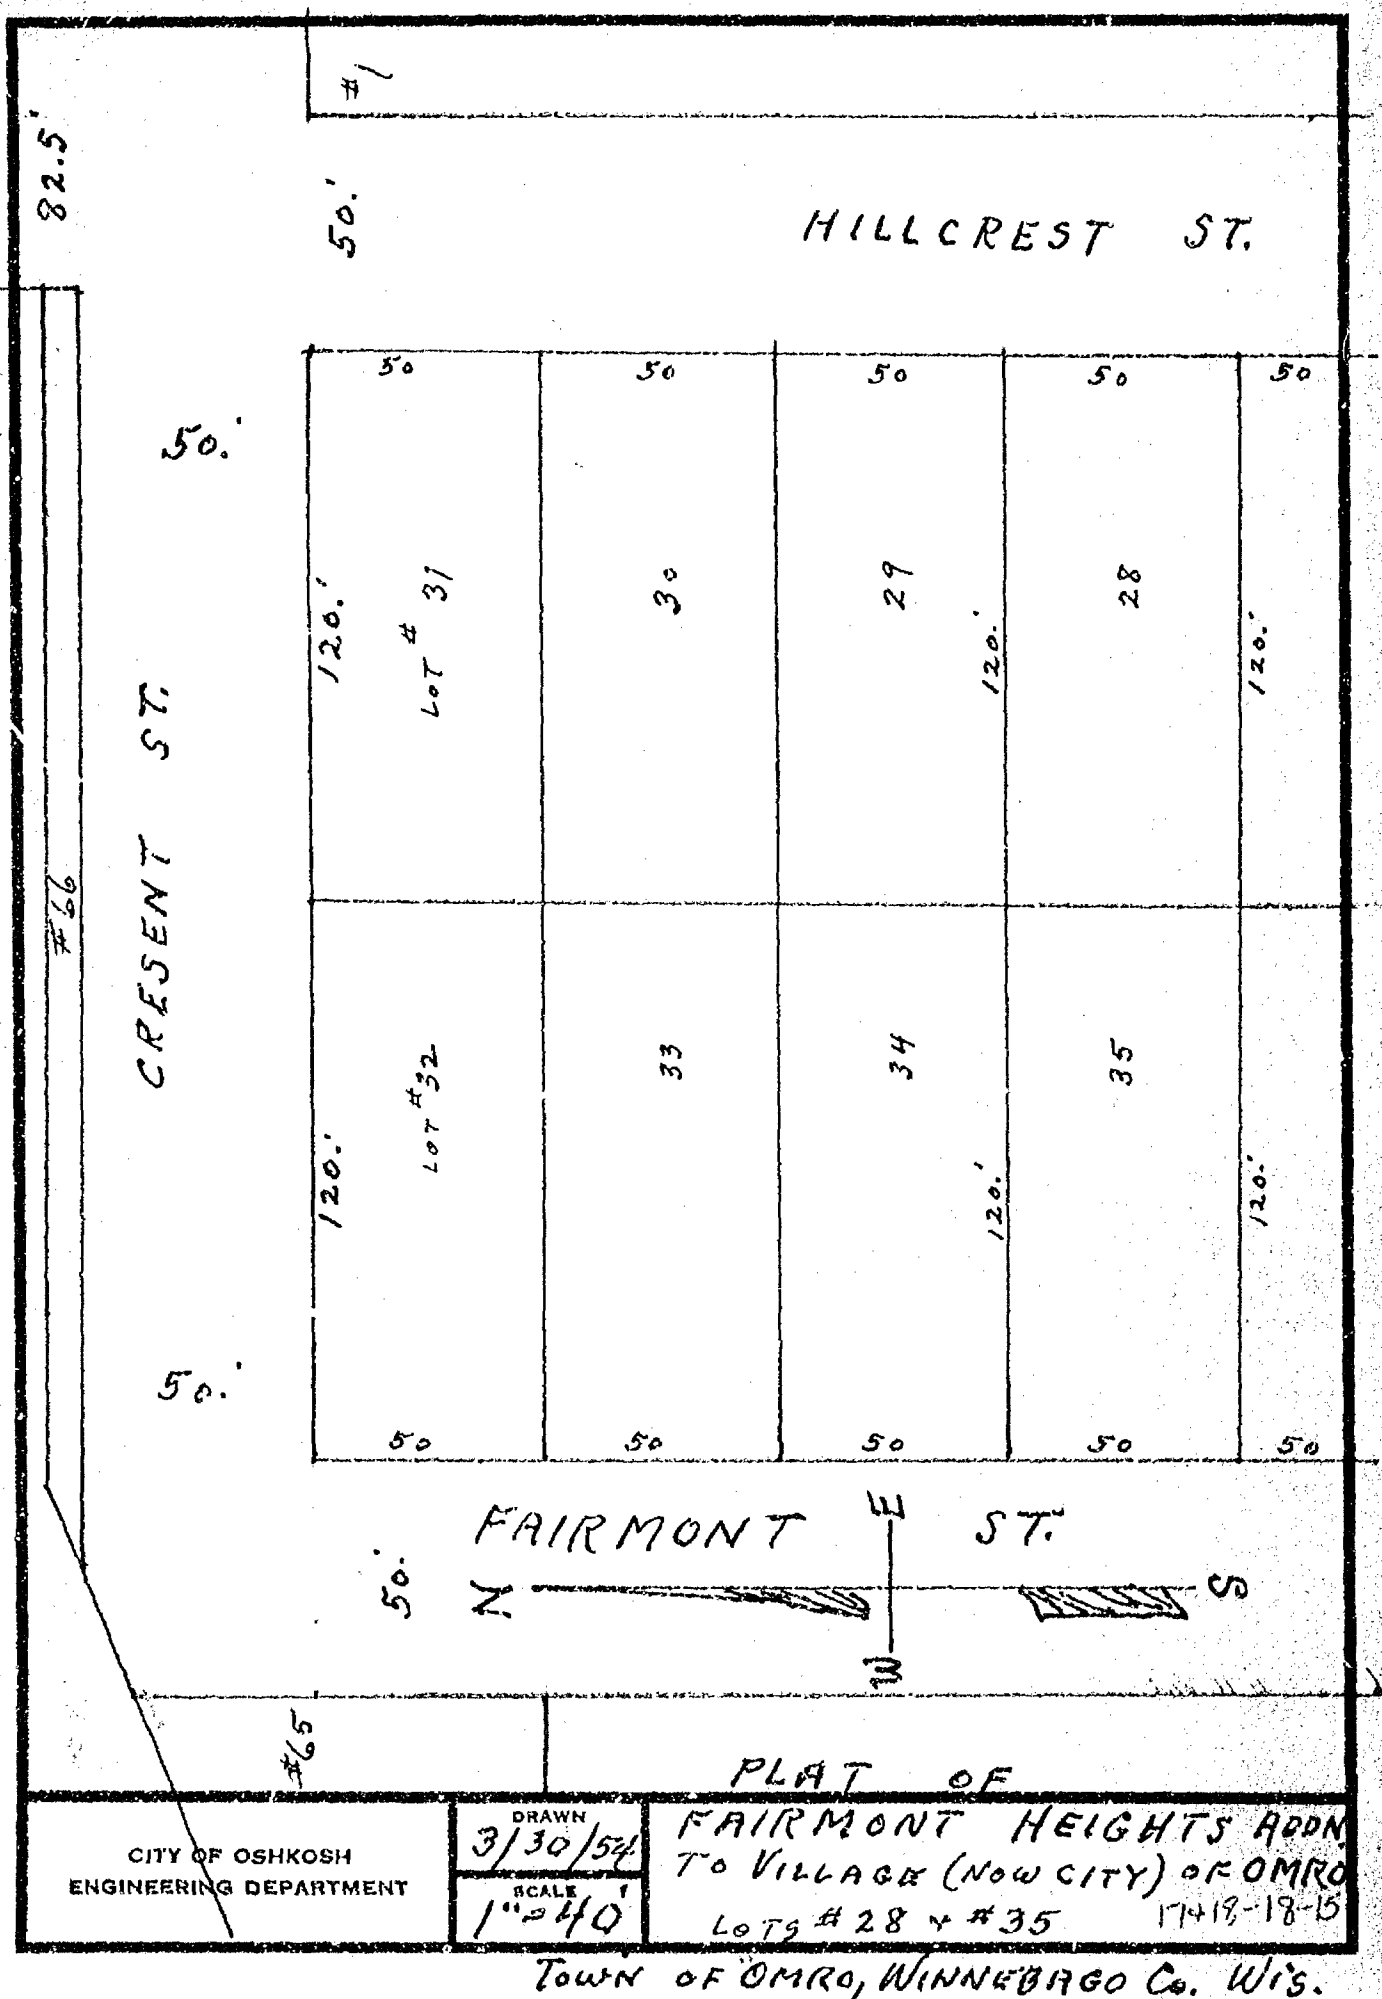

Survey For Mr. B. Koeneman - John Freund Realtor

Description For Parcel # 1

The West 154.0 ft. Of The North 157.0 ft. Of Out Lot # 89 In The Plat
Of Out Lots South Of The Fox River, City Of Omro, Wis.

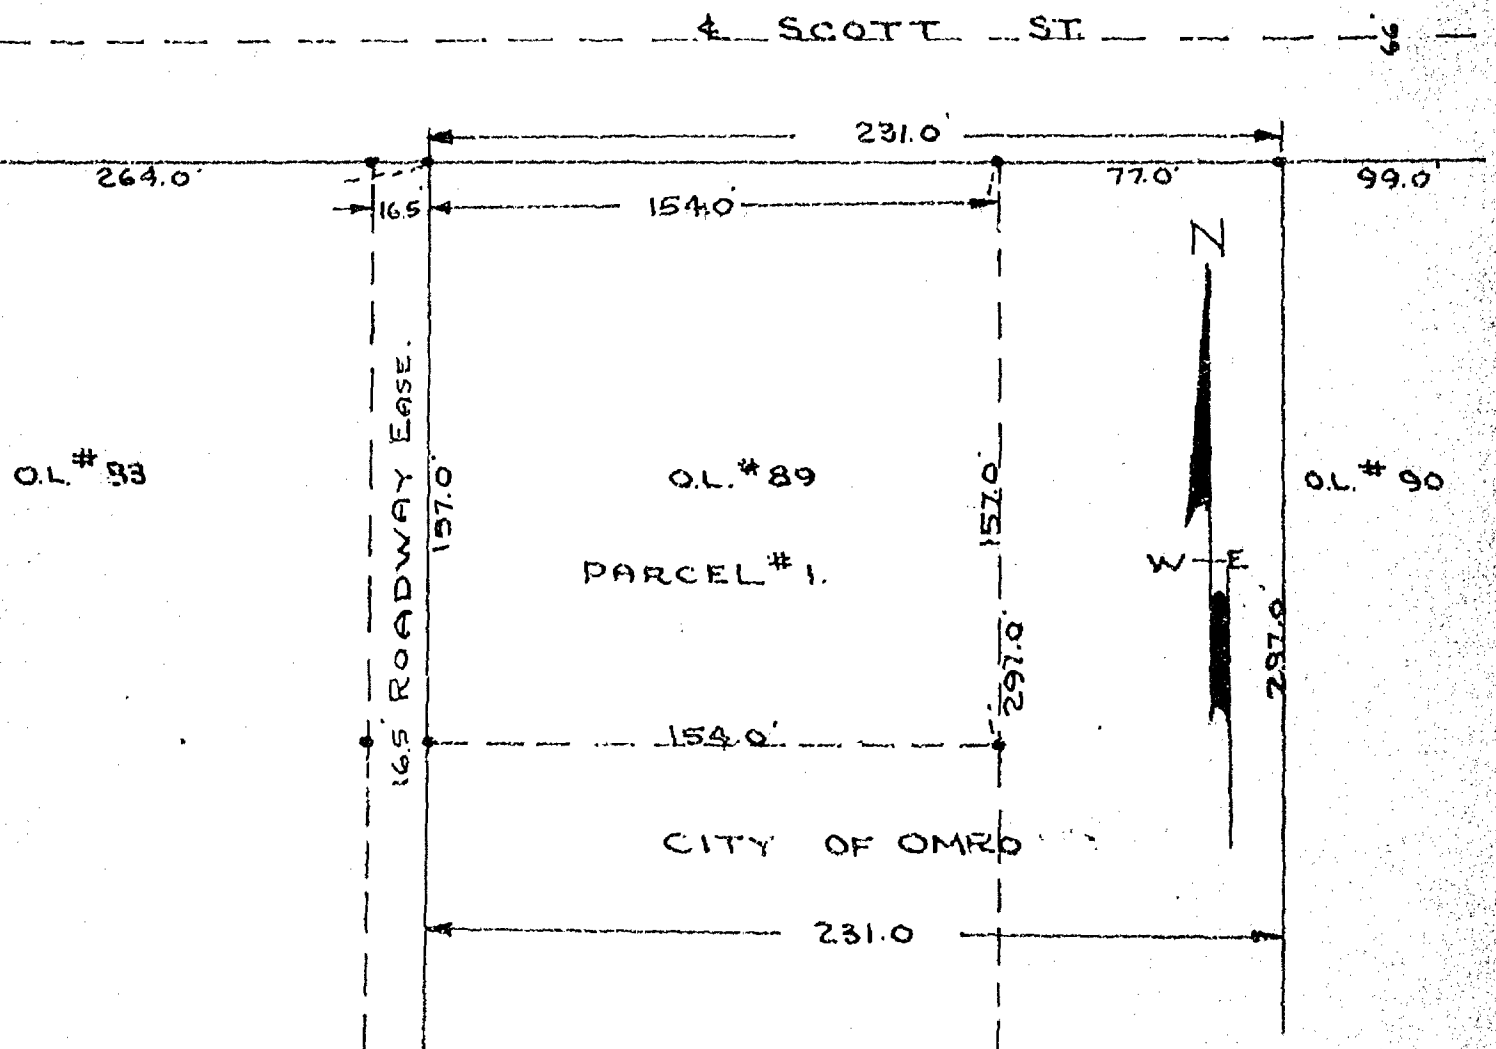

Scale
1" = 50'

Iron Stakes Shown Thus - •

Survey & Platting Co.
Oshkosh, Wis.
T.E. Stearns - Reg. Surveyor
Sept. 18, 1968

18-19-15

(5)

Survey For Oshkosh Savings & Loan Co. - J. A. Ploetz Home

Description of Property:


The South 75.0 ft., Front & Rear, Of The North 207.0 ft. Of Out Lot # 7, According To Plat Of Out Lots, South Of The Fox River, In Village Of Omro, Recorded In Winnebago County Registry In Vol. # 4 Of Plats On Page # 24, Now In First Ward, City Of Omro.

CERTIFICATE

I, Theo. E. Stearns, Registered Surveyor In Wis., Do Hereby Certify That I Have Surveyed The Property & The Location Of The House & Foundation On The Property As Described Above According To Official Records, And That The Plat Map Drawn Is A Correct Representation Of Said Survey.

Date: Aug. 27, 1965

Theo. E. Stearns
Reg. Surveyor No. B-359

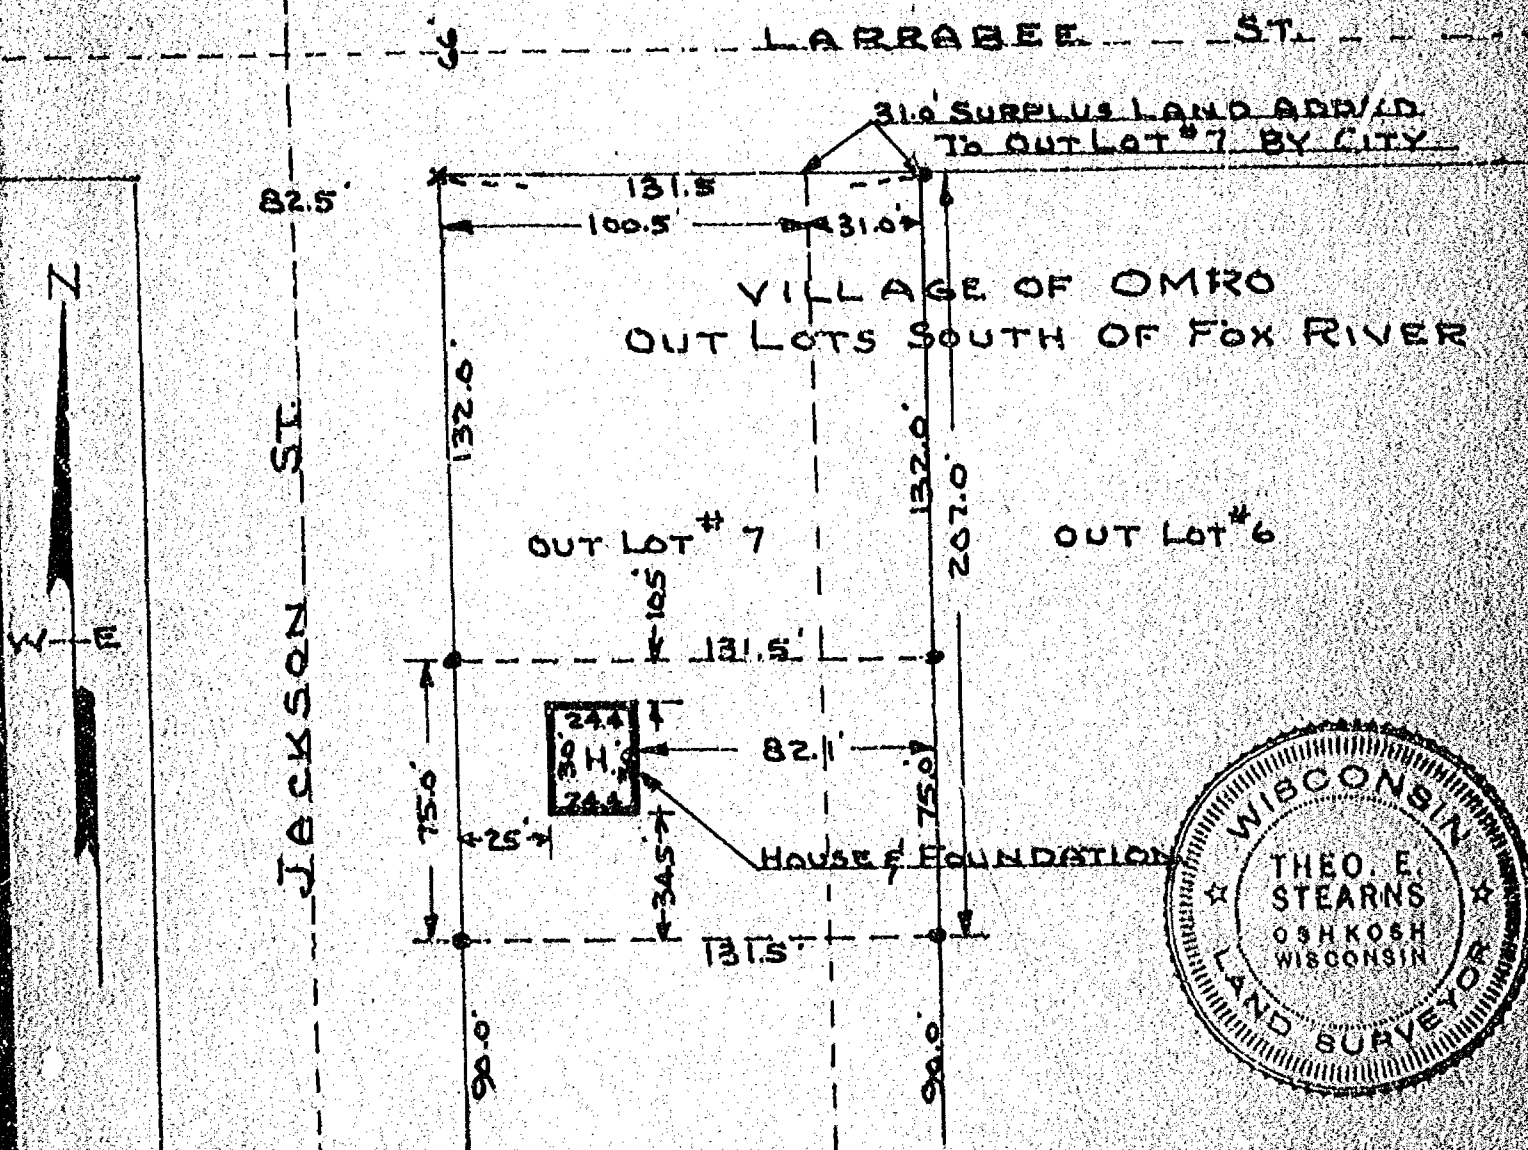

Scale
1" = 50'
Iron Stakes Shown Thus - •

Survey & Platting Co.
Oshkosh, Wis.
T.E. Stearns - Reg. Surveyor
Aug. 27, 1965


18-18-15

(5)

Survey & Description For Clarence Bloede:

Description For Outlot # 6 South Of Fox River:

Commencing At A Point On The East Line Of Jackson St. Where The South Line Of Larrabee St. Intersects The East Line Of Jackson St. Also Being The North West Corner Of Outlot # 7 South Of The Fox River, City Of Oshkosh, Thence Due East Along The South Line Of Larrabee St. A Distance Of 131.5 ft. To The Place Of Beginning; Thence Due South 561.0 ft. To An Iron Stake, Thence Due East Parallel With Larrabee St. 114.0 ft. To An Iron Stake, Thence Due North To A Point On The South Line Of Larrabee St. A Distance Of 561.0 ft., Thence Due West 114.0 ft. To The Place Of Beginning.

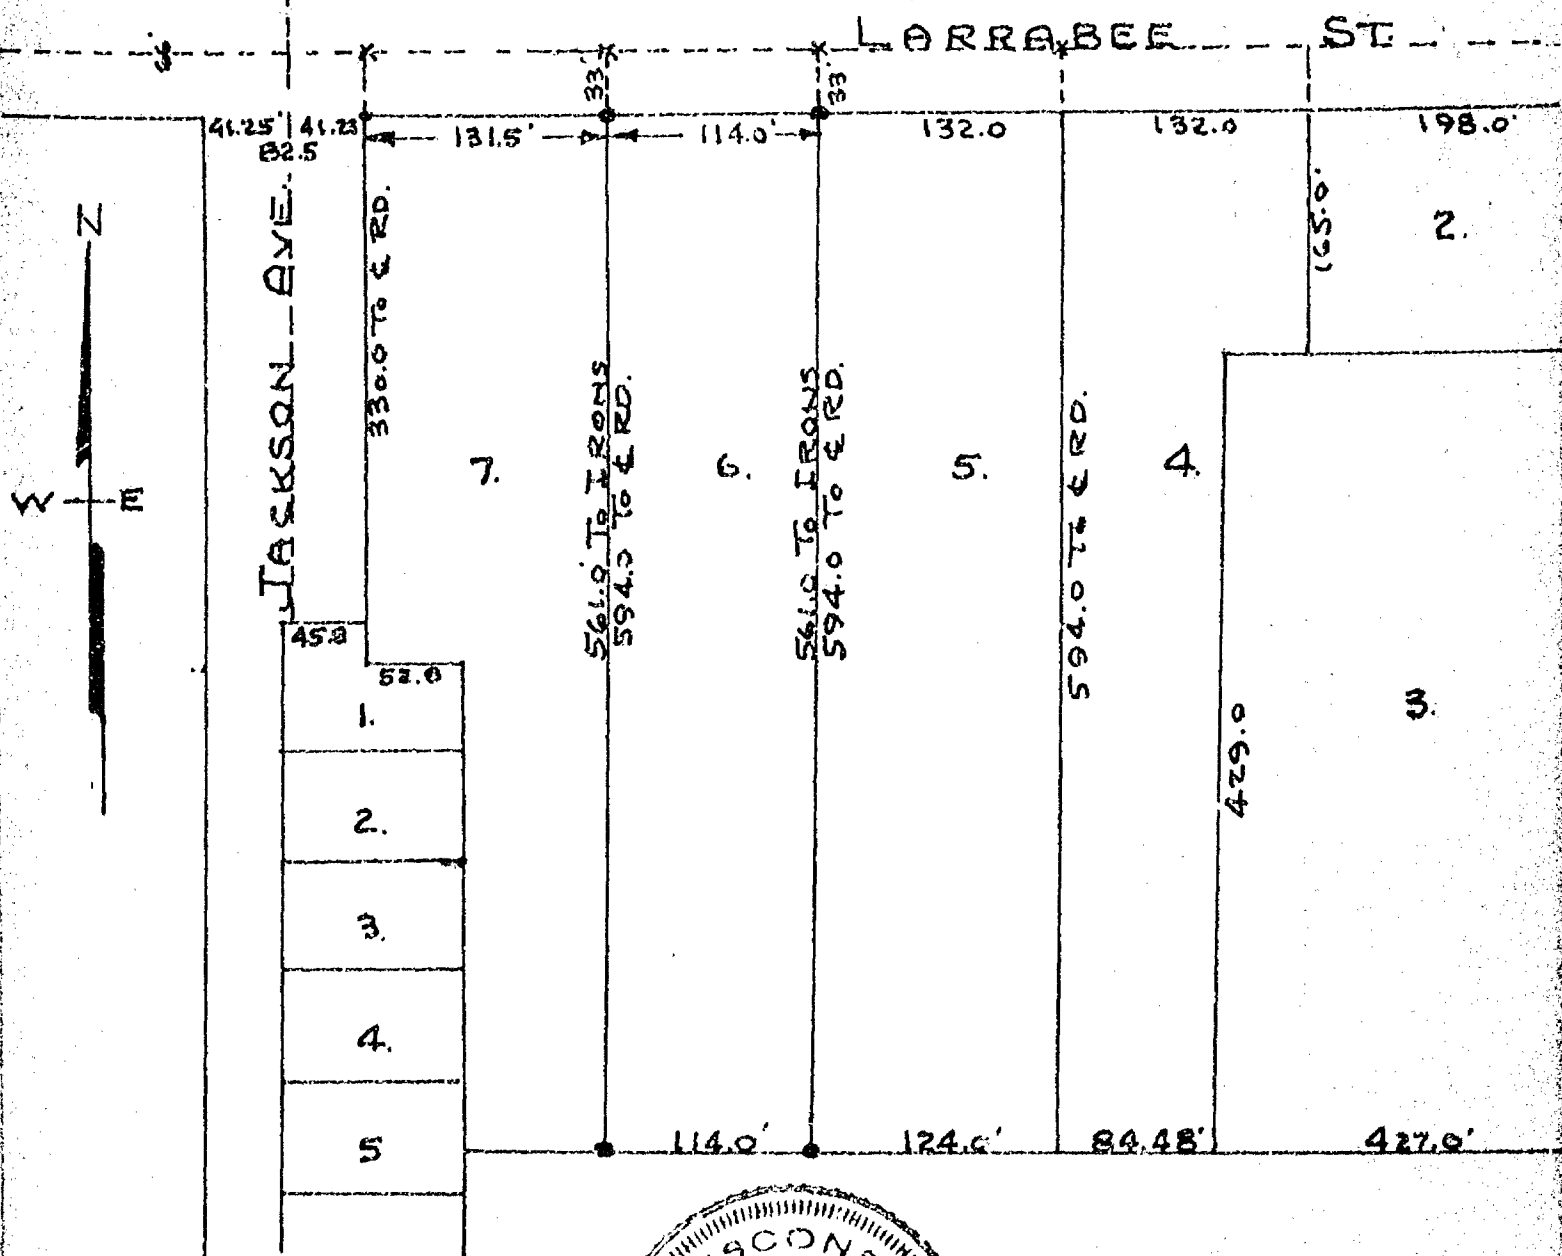

Scale
1" = 100'
Iron Stakes Shown Thus *




Survey & Flattig Co.
Oshkosh, Wis.
T.E. Stearns - Reg. Surveyor
May 25, 1962

18-18-15

6

Map of Part of Western Addition to Village of Omro.
Survey of Pabst Brewing Co Property in Village of Omro Wis.

75-A

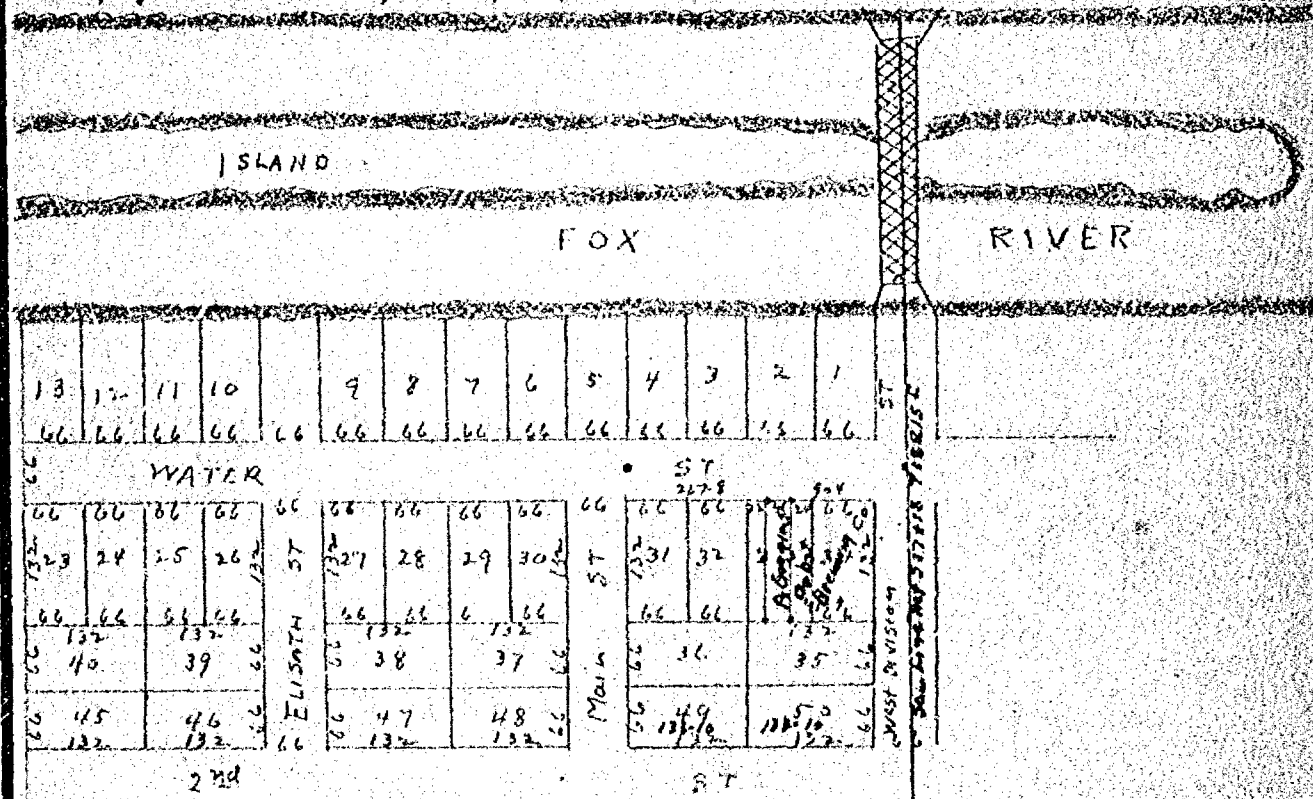


I Began at the center of Water and West Division Streets at an iron stake set for center of Streets I found this Block contained a surplus of 3 ft 8 inches East and West I divided up the property by proportional measurement and set iron stakes where they could be set and side walk I drilled a hole at the corner of the property as shown on above map marked in Red Ink thus (o) Began May 27th 1910 Completed May 27th 1910 W W Goold Co Surveyor

W W Goold Chainman
T Lightfoot

Red Figures my Measurement
Black Figures as Recorded Plat shows it

CITY OF OSHKOSH ENGINEERING DEPARTMENT	DRAWN	MAP OF PART OF WESTERN ADDITION TO VILLAGE OF OMRO SURVEY OF PABST BREWING CO PROPERTY IN VILLAGE OF OMRO WIS.
	SCALE 1" = 200'	

12
MAP OF BLOCKS 3-4-9 ORIGINAL PLAT IN VILLAGE OF OMRO WIS.

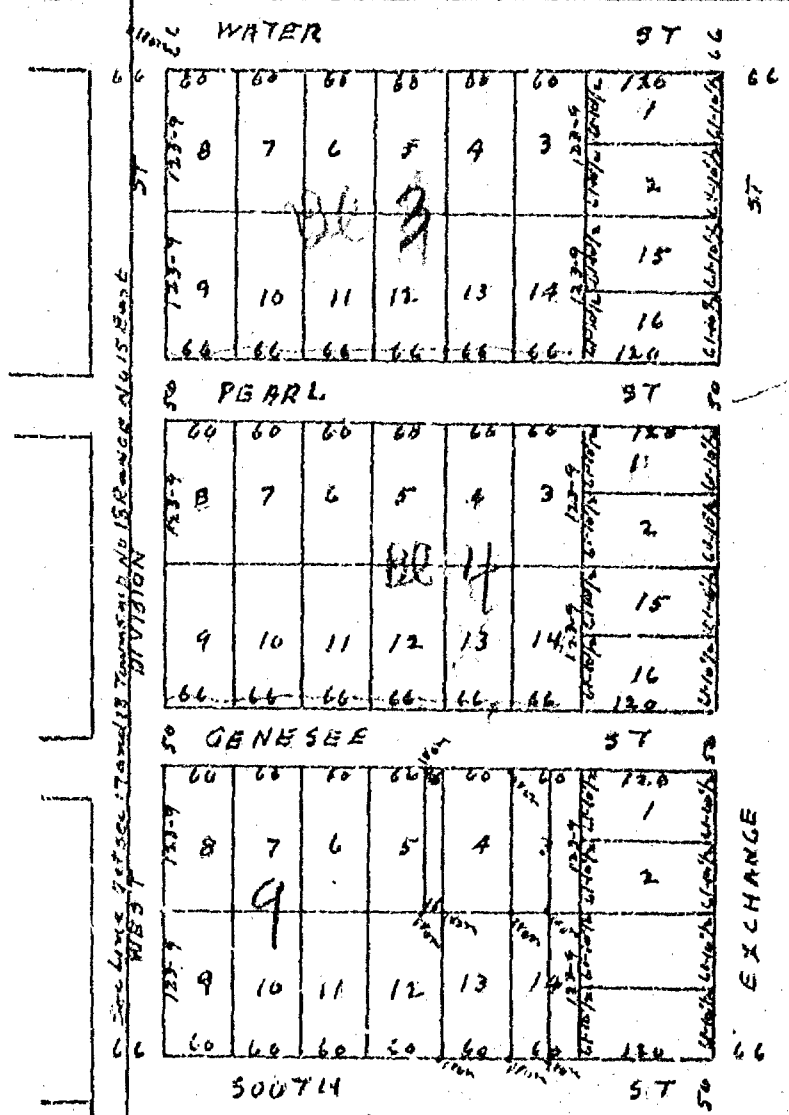

I found a stake set in the center of West Division and Water 6 feet I then lined up West Division Street on east line and from this line I turned East on south side of Genesee St and surveyed out Lot 4 and 15 ft of the East side of Lot 5 of Block 9 Original Plat of the Village of Omro and set iron stakes as shown on the within map marked in Red Ink Began May 13th Completed May 13th 1918

W W Gould Co Surveyor

W W Gould Chairman

Chas Kinneman

On Sept 2d 1918 I surveyed Out Lot 13 and W 1/2 Lot 14 Block 9 and set iron stakes as shown on the within map marked in Red Ink Began Sept 2d Completed 2d 1918

W W Gould Co Surveyor

W W Gould

Chas Kinneman Chairman


CITY OF OSHKOSH
ENGINEERING DEPARTMENT

DRAWN

SCALE

SURVEY OF LOT 4 BLOCK 9 ORIGINAL PLAT
OF THE VILLAGE OF OMRO WISCONSIN

Survey of Out Lot 28 in Village of Oiro Wisconsin 23

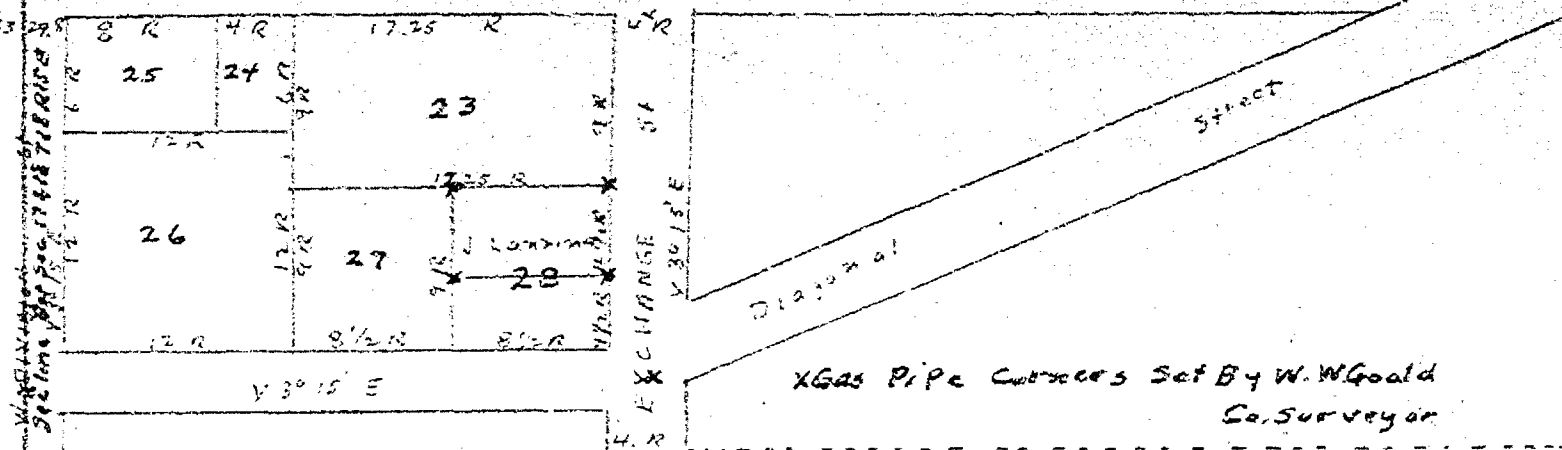

Found an iron stake set in center of Road for 1/4S Bet Sec 17 & 18 T 18 R 15 E verified by Filo Berch & John Lannin so I accepted this as the corner as Govt Bearings were entirely obliterated the stake being so far beneath the surface I set over and around it a 1 1/2 gas pipe 3 1/2 ft long drove it down level with the ground I then measured East 8.23 chs and set gas pipe and took Bearings soft maple 12 N 38° 30' W 36 ft Catholic church N 51° E 64 1/2 ft Bearings for 1/4S soft maple 8 N 41° 30' E 47 ft Hard Maple 10 N 47 1/2 ft from 1/4S I ran North in center of Division St at 11.25 chs I set gas pipe in center of Road No Bearings East from this stake 8.23 chs I drove gas pipe in center of Exchange St I then went to center of West Division & Water Sts I dug down 2 ft in the ground and found an iron stake that had been set on Sec line by some surveyor it was in the center of car track and under a tie it being so far below the surface I set to mark the spot for future use first a 20 penny spike in the tie directly over the stake and on each side of tie I drove an iron bolt 3 ft long down level with the tie the Bolts has a flat crotch on each one covered them over with 6 inches of gravel placed a wooden stake over them that came to the surface and took Bearings corner of Brick Building N 27° 40' E 43 ft & 10 inches Brick building N 46° W 42 ft I then measured East in center of Water St 8.23 chs and drove an iron pin in center of car track No Bearings I then measured south in center of Exchange St 71 Rods to south limits of Original Play at this point I drove an iron pin in center of St I then surveyed out Lot 28 as shown on above Plat and set for corner a 1 1/4 inch gas pipe 3 ft long drove them down 2 1/2 ft in the ground left 6 inches out of ground as shown marked in Red Ink thus X
 Began Aug 22d 1907 Completed Aug 27th 1907 W W Gould Co Surveyor


W & Gould Chairman
 John Lannin

SURVEY OF OUT LOT 28 IN VILLAGE OF OIRO WISCONSIN

DRAWN

SCALE

CITY OF OSHKOSH
 ENGINEERING DEPARTMENT

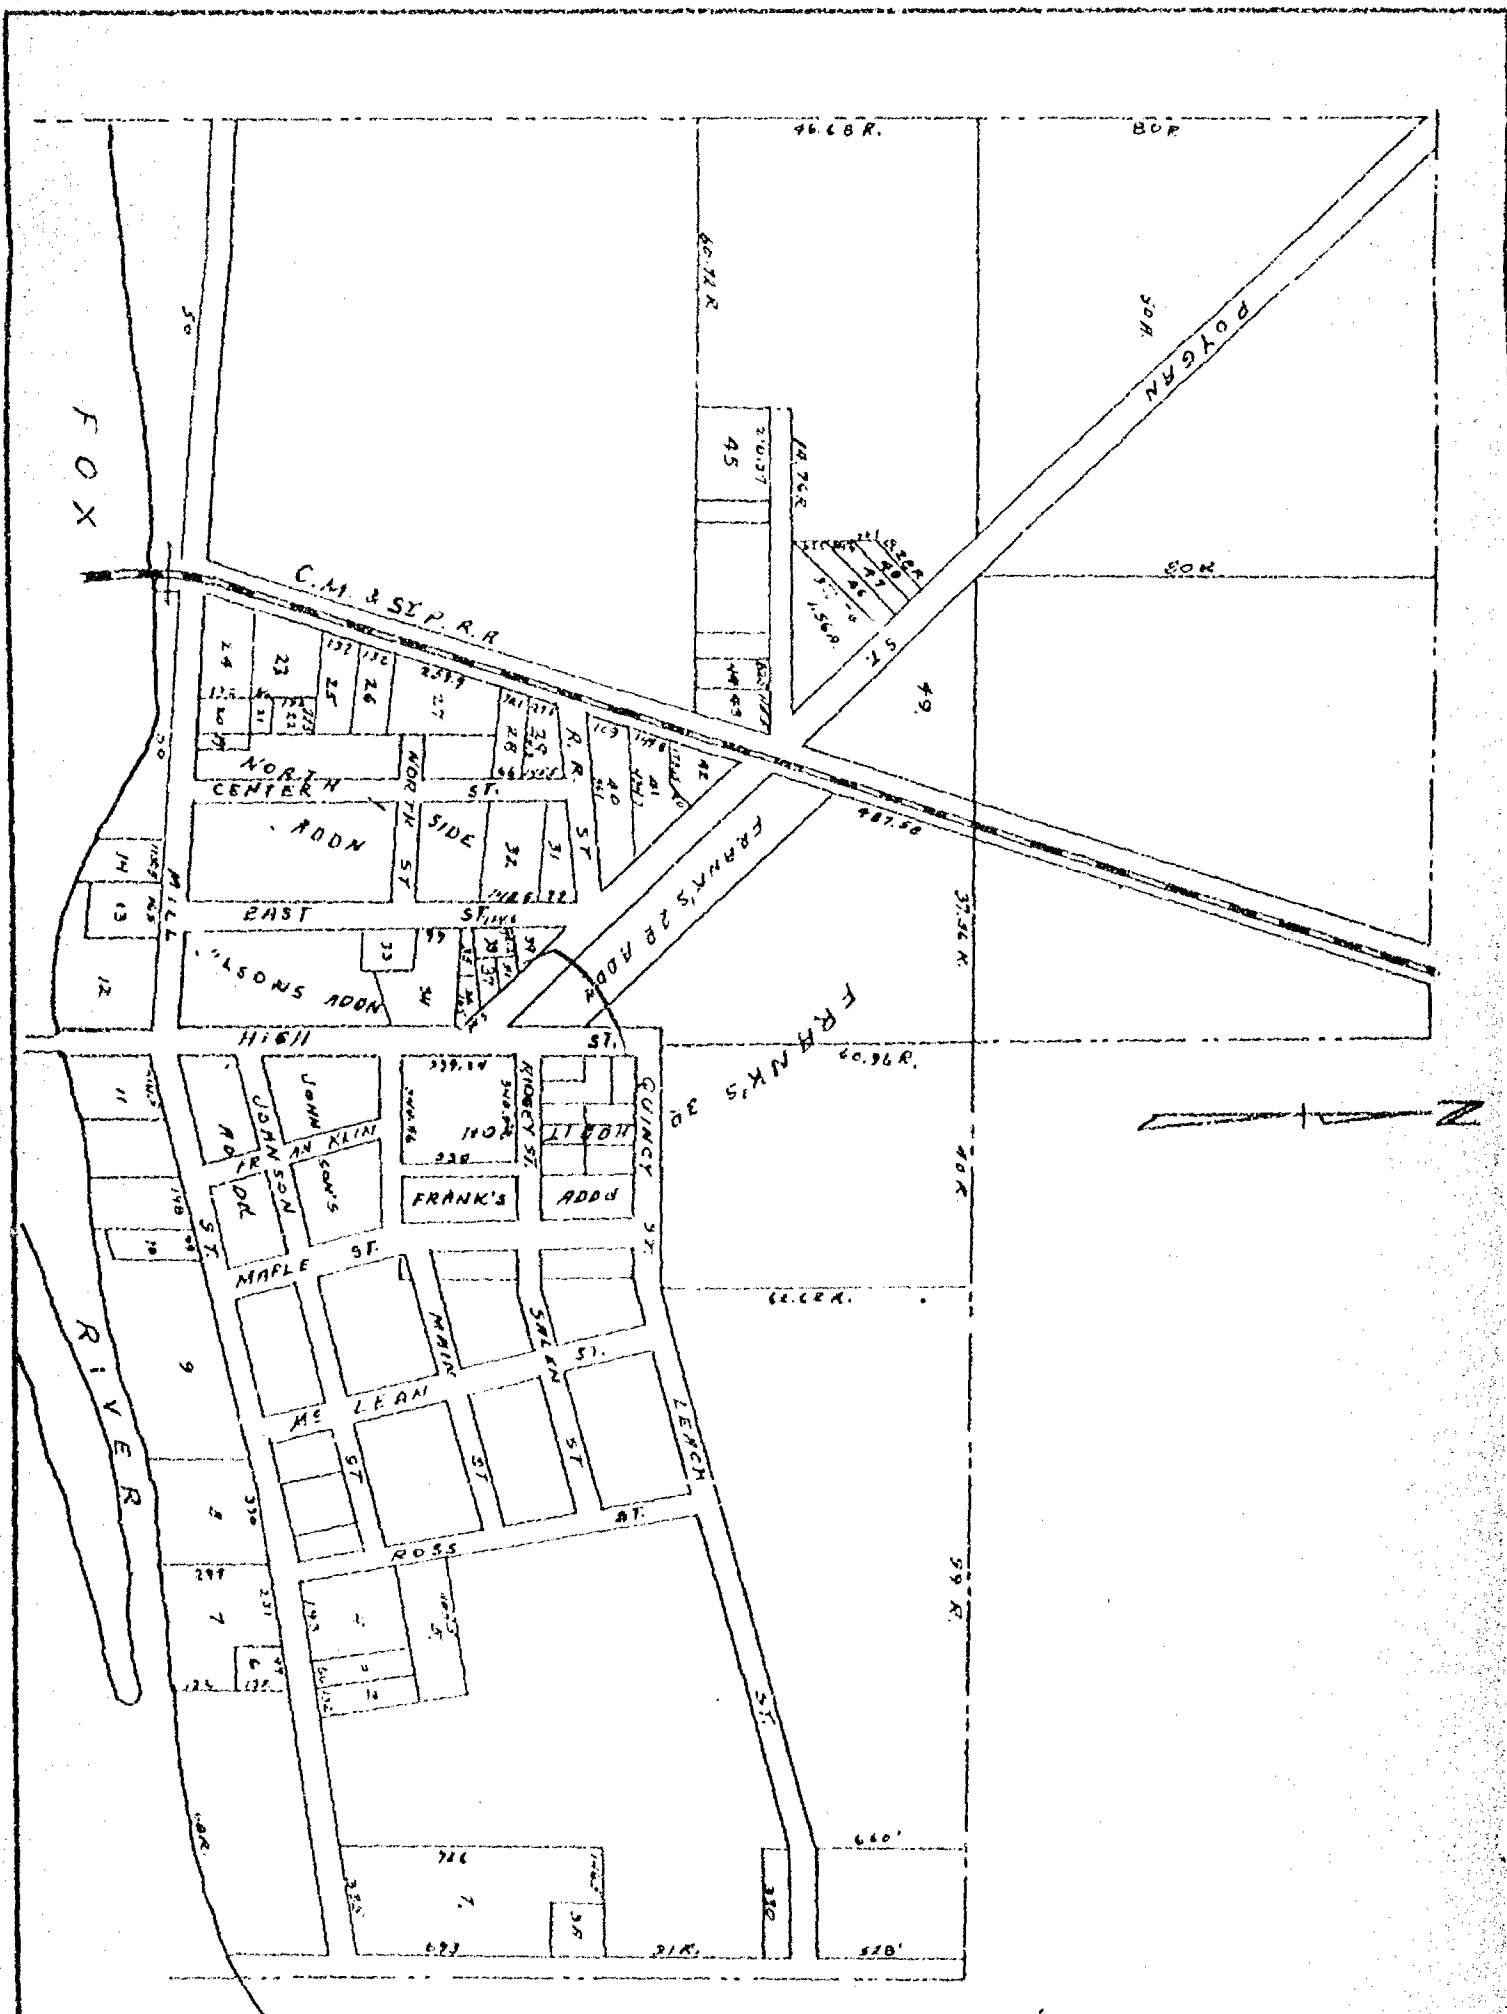

HARRY M. SCHMITT
ABSTRACT CO.

OSHKOSH, WIS.


Scale 1"=60'.

4 PLATS 24

PART NORTH OF FOX RIVER OF PLAT OF
OUTLOTS IN THE VILLAGE OF OMRO

18-18-15

SURVEY OF OUTLOTS AND LAND IN THE VILLAGE OF OMRO, WINNEBAGO CO. ILL. 1877

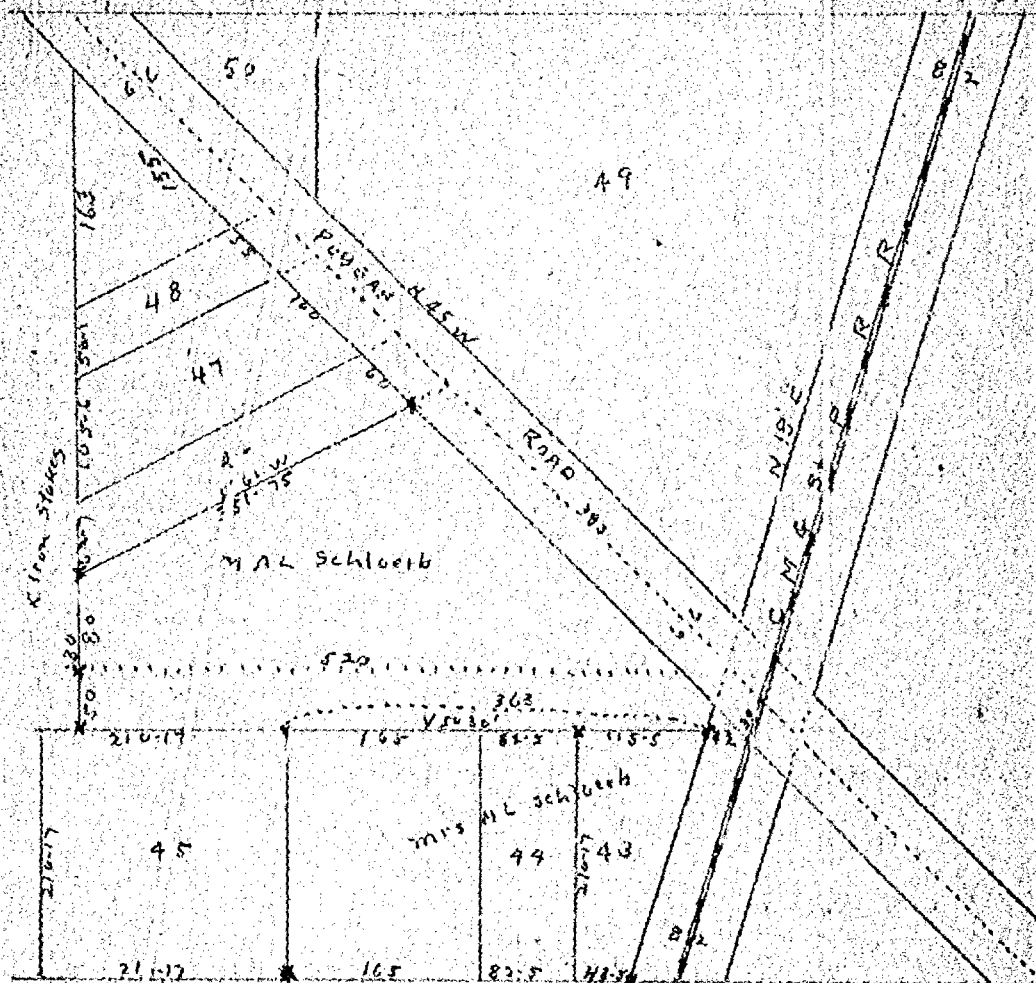

Being employed by Mrs A L Schloerb to survey out the land in the above map I surveyed out the out Lots by the Recorded Plat and the land adjoining according to the Deeds shown me by Mrs A L Schloerb and set Iron stakes as shown on the within map marked in Red Ink Began May 10th 1920 Completed May 19th 1920

W W Goold Co Surveyor
W W Goold Chairman
L L Dunham

CITY OF OSHKOSH
ENGINEERING DEPARTMENT

DRAWN

SCALE

SURVEY OF OUT LOTS AND LAND IN THE
VILLAGE OF OMRO WINNEBAGO CO WIS.

18-19-15

I Measured out Lot 56 all around and found it as shown in figures on the within map I then measured out the small piece of land of Lot 50 lying in the S W corner this was done according to instructions of G K Whitney for the purpose of getting a correct Description and measurement to a Deed and Abstract this land being owned by Mrs Emily Whitney of Omro Wis I drew a map and gave it to G K Whitney on Sept 7th 1909 at Court House in Oshkosh Wis Began Sept 6th 1909 Completed Sept 6th 1909

W.W.Goold Co Surveyor
W.W.Goold Chainman
G.K.Whitney


CITY OF OSHKOSH
ENGINEERING DEPARTMENT


DRAWN

SCALE

SURVEY OF OUT LOT 56 AND PART OF OUTLOT 50
VILLAGE OF OMRO WIS.

19-19-09

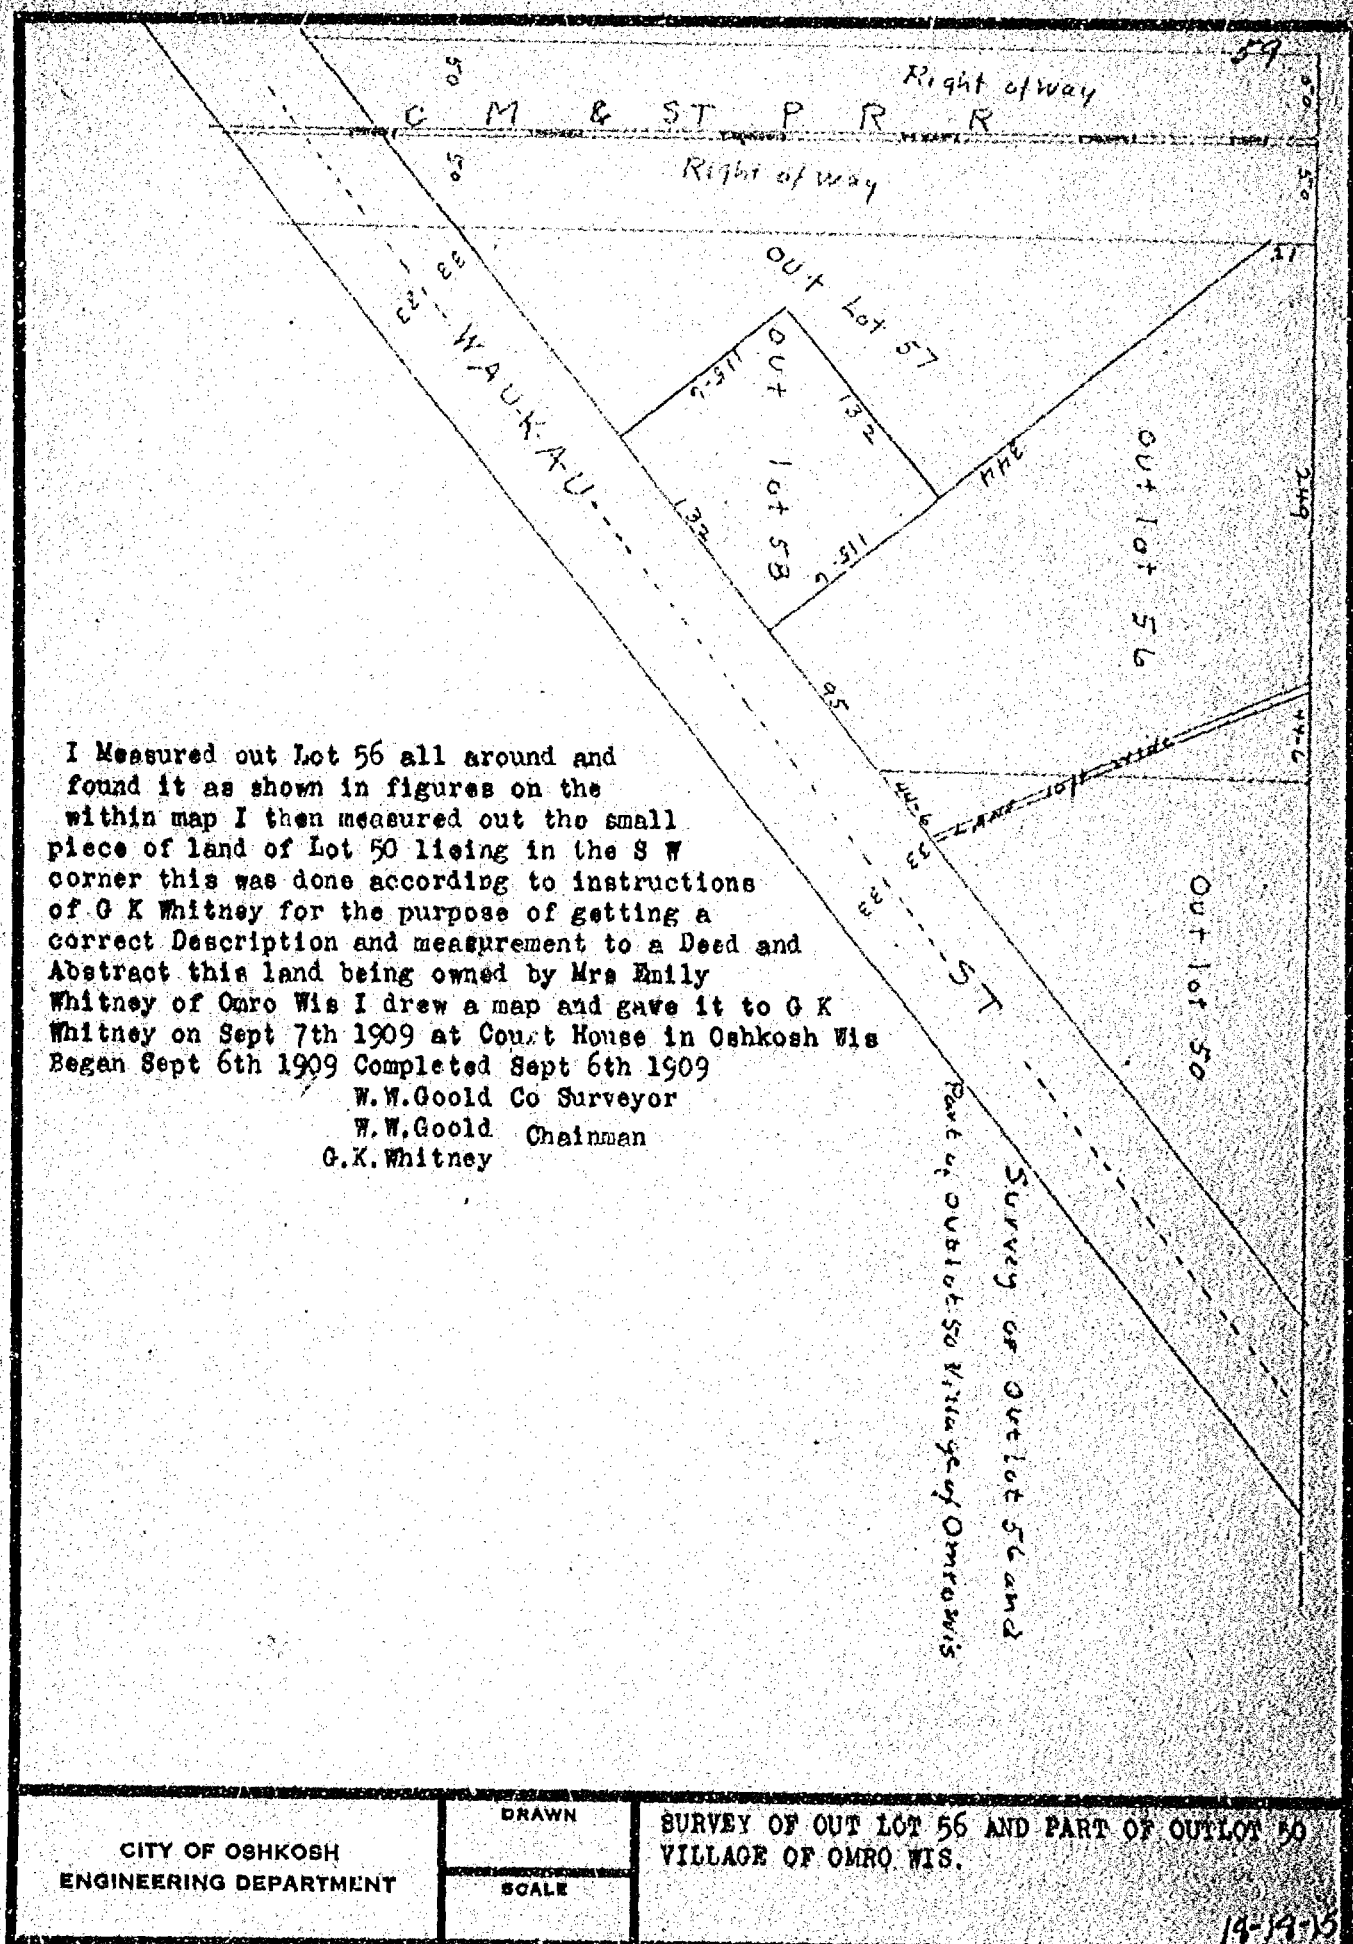

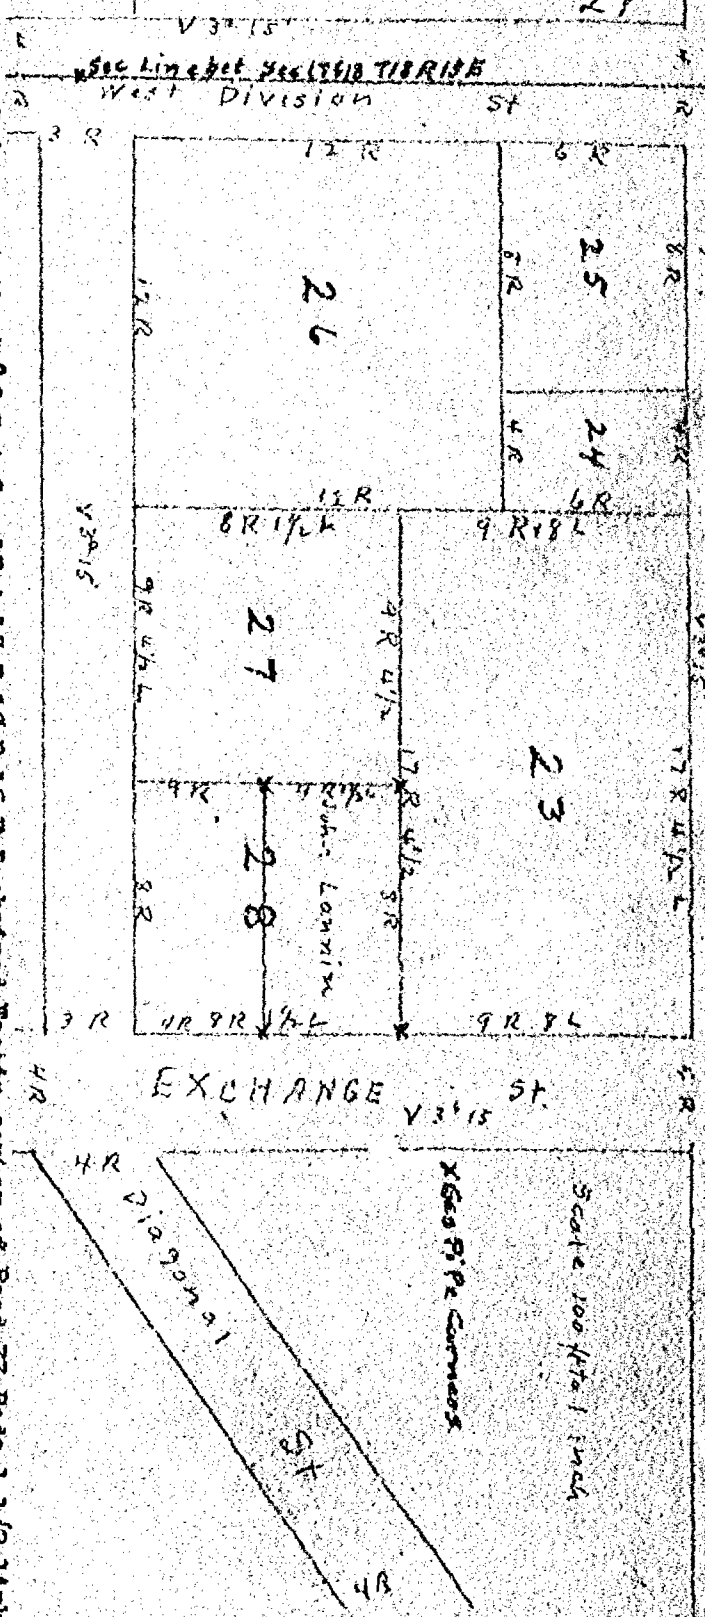


I Began at the $\frac{1}{4}$ Sec 17 & 18 T 18 R 15 E I entered Eastin corner of Road 33 Rods 1 1/2 links and set gas pipe in center of Road to establish the center of Exchange St 1 1/2 inches in diameter 3 ft drove it down level with the ground and took Bearings for future use Soft Maple N 41° 30' E 77 1/2 ft corner of Catholic church N 50° W 62 ft I then ran North in center of Exchange St 4 Rods and 10 links and drove an iron Bolt in center of Road to mark the spot I then went to center of West Division and Rater Street I found the iron stake that had been established for the center of the Streets I then measured East in center of Rater Street 33 Rods 1 1/2 links and ran south in center of Exchange Street 71 Rods to south line of Block 10 & 11 and drove an iron bolt to mark the spot I then measured south from this spot 9 Rods & 8 links this was what the Deed called for when land was conveyed by George Chalmers and wife to John Gallaher in 1868 of out lot 23 I then turned at Right angles and two Rods from center of Street I drove a gas pipe to mark the corner of lots 23 and 28 and from this stake I ran out lot 28 as shown on the above Plat and set gas pipe for corners as shown on the above Plat marked in Red Ink thus I Began Oct 28th 1907 Completed Oct 28th 1907 W H Gould Co Surveyor

Ed Chapman
John Lammie
Chairman

Survey of Out Lot 15 South of Fox River Village of Omro Wis.

131

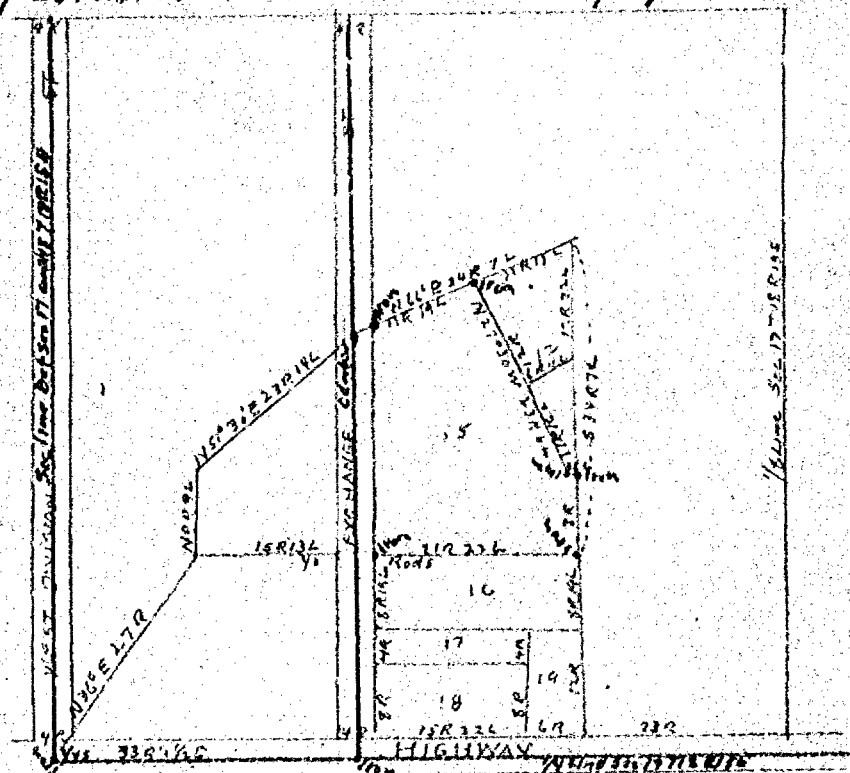

I Began at the 1/4 Sec 17 and 18 Town 18 Range 15 East thence East on 1/4 line 33 Rods 1 1/2 links to an iron stake thence North 22 Rods and 19 links thence East 2 Rods and set iron stake the South west corner thence East 21 Rods and 22 links and set iron stake thence North 8 Rods and set iron stake thence west 38 links and set iron stake thence North 27°30' W 23 Rods and 6 links and set iron stake on South side of Pleasant St thence South 63°30' W 11 Rods and 19 links and set iron stake on South line of Pleasant St thence South on East line of Exchange St 24 Rods and 17 links to Place of Beginning Began Oct. 24th 1912 Completed Oct 29th 1912 W W Gould Co Surveyor

W W Gould Chainman
F Lightfoot

CITY OF OSHKOSH
ENGINEERING DEPARTMENT

DRAWN


SCALE

1" = 20 Rods

SURVEY OF OUT LOT 15 SOUTH OF FOX RIVER
VILLAGE OF OMRO WIS.

SURVEY OF BLOCK 9 ORIGINAL PLAT
VILLAGE OF OMRO WINNEBAGO COUNTY WISCONSIN

22.1

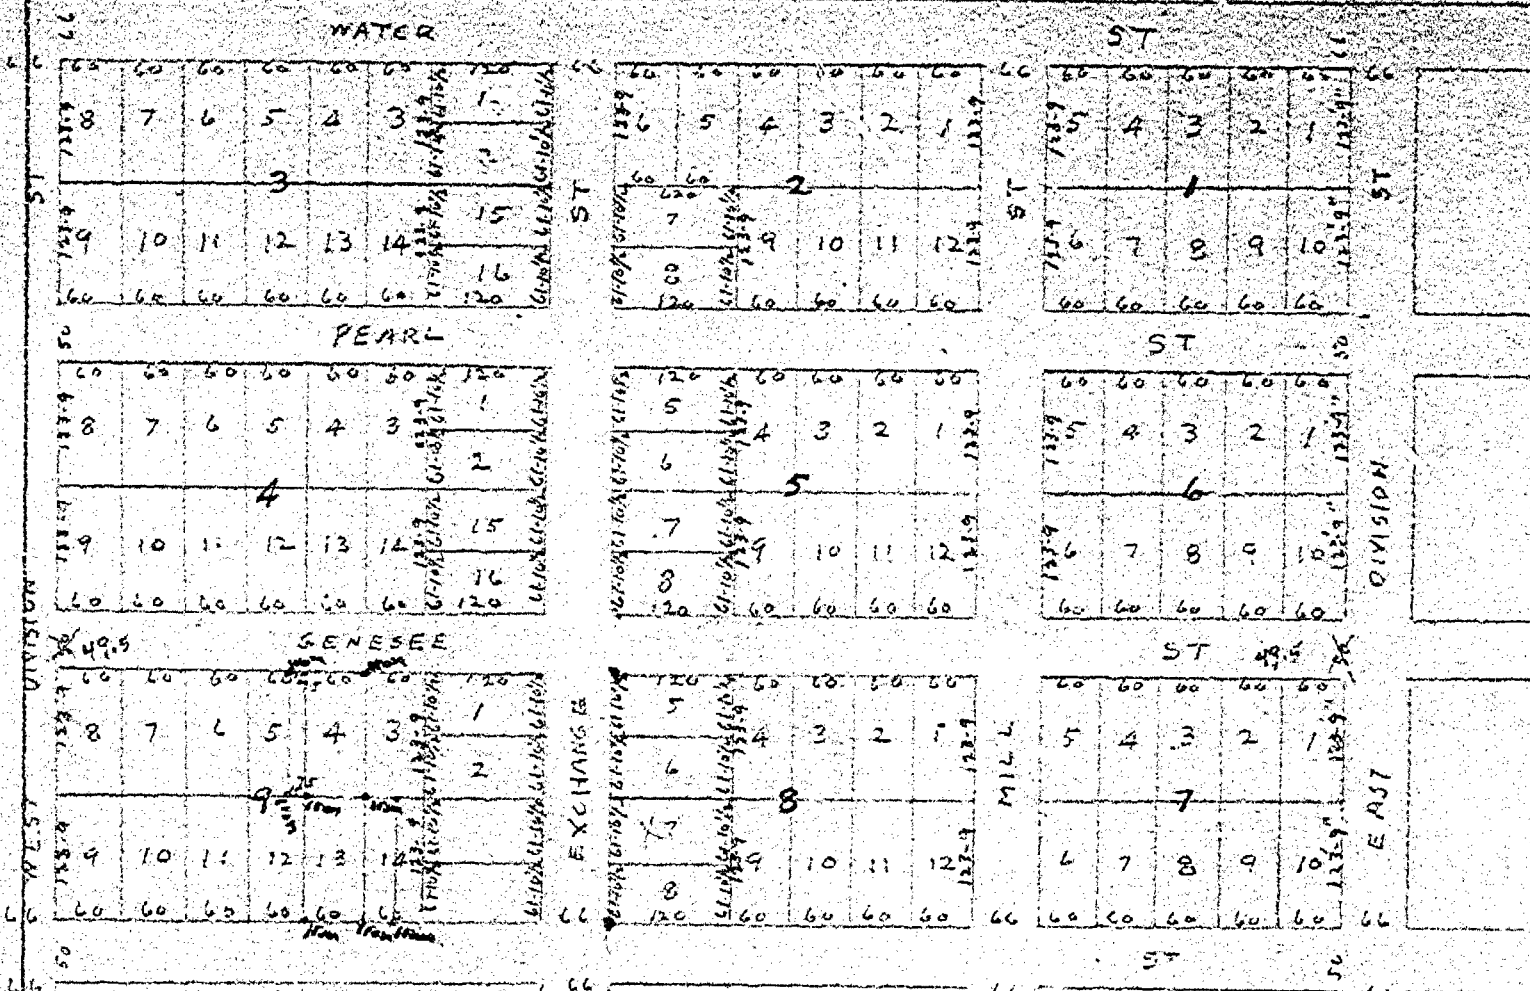

I found a iron stake set in the center of West Division and Water Streets I then lined up West Division Street on Sec line I then measured south on Sec line 628 ft to South line of Genesee Street then turned East and surveyed out Lot 4 and 15 ft of the East side of Lot 5 Block 9 of the Original Plat of the Village of Omro and set iron stakes as shown on the above map marked in Red Ink Began May 13th Completed 13th 1918 W W Goold Co Surveyor

W W Goold Chainman
Chas Kinneman

On Sept 2d 1918 I Surveyed out Lot 13 and W 1/2 of Lot 14 Block 9 and set iron stakes as shown on above map marked in Red Ink Began Sept 2d 1918 Completed Sept 2d 1918 W W Goold Co Surveyor
W W Goold Chainman
Chas Kinneman

SURVEY OF BLOCK 9 ORIGINAL PLAT VILLAGE
OF OMRO WINNEBAGO COUNTY WISCONSIN

CITY OF OSHKOSH
ENGINEERING DEPARTMENT


DRAWN
SCALE

Quit Claim Deed L.J. Schoenbechler And Jean M. Schoenbechler, His Wife To Madge D. Lockhart Decker.

Quit Claim Deed W.H. Peterson And Martha Peterson, Husband And Wife To Madge D. Lockhart Decker.

That Part Of Lot 9, North Of Fox River, According To PLAT OF OUTLOTS, In The Village Of Onro, As Recorded In Winnebago County Registry In Volume 4 Of Plats On Page 24, And Now In The Third Ward, City Of Onro, Described As Follows:


Commencing At The Point Of Intersection Of The West Line Of Lot 10, North Of Fox River, According To Said Plat Of Outlots With The Southerly Line Of Mill St., Thence South Along The West Line And The Extended West Line Of Said Lot 10, 200.0 ft., Thence Westerly Parallel With The Southerly Line Of Mill Street, 193.0 ft., To A Point Hereinafter Referred To As 'Point B', Thence Westerly Parallel With The Southerly Line Of Mill Street, 70.0 ft., To The Place Of Beginning, Thence Northerly Along A Line (Hereinafter Referred To As 'Line Y') To A Point On The Southerly Line Of Mill St., That Is 277.0 ft. Westerly Of The Point Of Intersection Of Said Southerly Line With The West Line Of Said Lot 10, Thence Easterly Along The Southerly Line Of Mill St. 79.0 ft., Thence Southerly Along A Line To Point Of Intersection With Aforementioned 'Point B', Thence Continuing Southerly Along The Extension Of Last Mentioned Line To The Northerly Shore Line Of Fox River, At Low Water Mark, Thence Westerly Along The Northerly Line Of Fox River, At Low Water Mark, To Point Of Intersection With The Extension Of Aforementioned 'Line Y', Thence Northerly Along The Extension Of Aforementioned 'Line Y' To The Place Of Beginning.

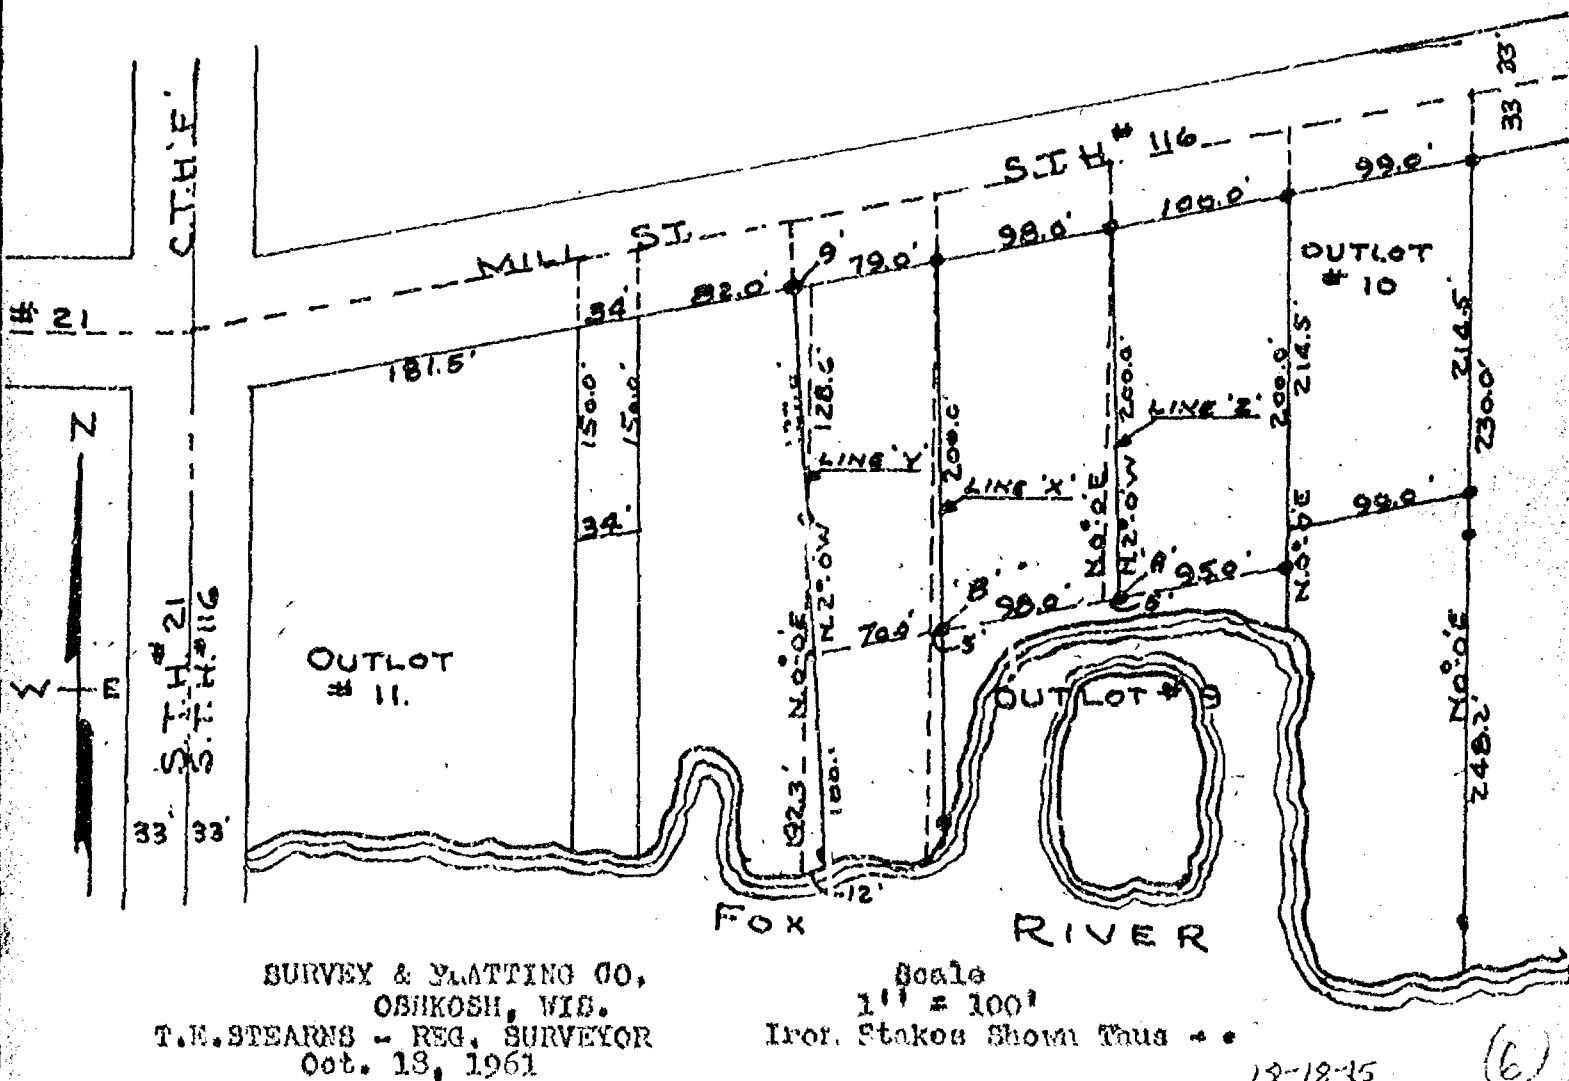

Parcel Retained By L.J. Schoenbechler & Joan M. Schoenbechler, His Wife:

That Part Of Lot # 9, North Of Fox River, According To PLAT OF OUTLOTS, In The Village Of Onro, As Recorded In Winnebago County Registry In Volume 4 Of Plats On Page 24, And Now In The Third Ward, City Of Onro, Described As Follows: Commencing At A Point Of Intersection Of The West Line Of Lot 10, North Of Fox River, According To Said Plat Of Outlots With The Southerly Line Of Mill St., Thence South Along The West Line, And Extended West Line, Of Said Lot 10, 200.0 ft., Thence Westerly Parallel With The Southerly Line Of Said Mill Street, 95.0 ft., The Place Of Beginning, Thence Northerly Along A Line (Hereinafter Referred To As 'Line 2') To A Point On The Southerly Line Of Mill St., That Is 100.0 ft. Westerly Of The Point Of Intersection Of Said Southerly Line With The West Line Of Said Lot 10, Thence Easterly Along The Southerly Line Of Mill St., 100.0 ft. To The Westerly Line Of Said Lot 10, Thence South Along The West Line, And The Extended West Line, Of Said Lot 10 To The Line Of That Portion Of Said Lot 9 Now Under Water, At Low Water Mark, Thence Westerly Along The Line Of That Portion Of Said Lot 9 Now Under Water, At Low Water Mark, To Point Of Intersection With The Extension Of Aforementioned 'Line 2', Thence Northerly Along The Extension Of Aforementioned 'Line 2' To Place Of Beginning.


Also All That Portion Of Said Lot 9 Heretofore Conveyed To L.J. Schoenbechler And Joan M. Schoenbechler, His Wife By Deed Recorded In Winnebago County Registry In Volume 532 On Page 42 Lying South Of The Northerly And Westerly Lines Of That Portion Of Said Lot Now Under Water, At Low Water Mark.

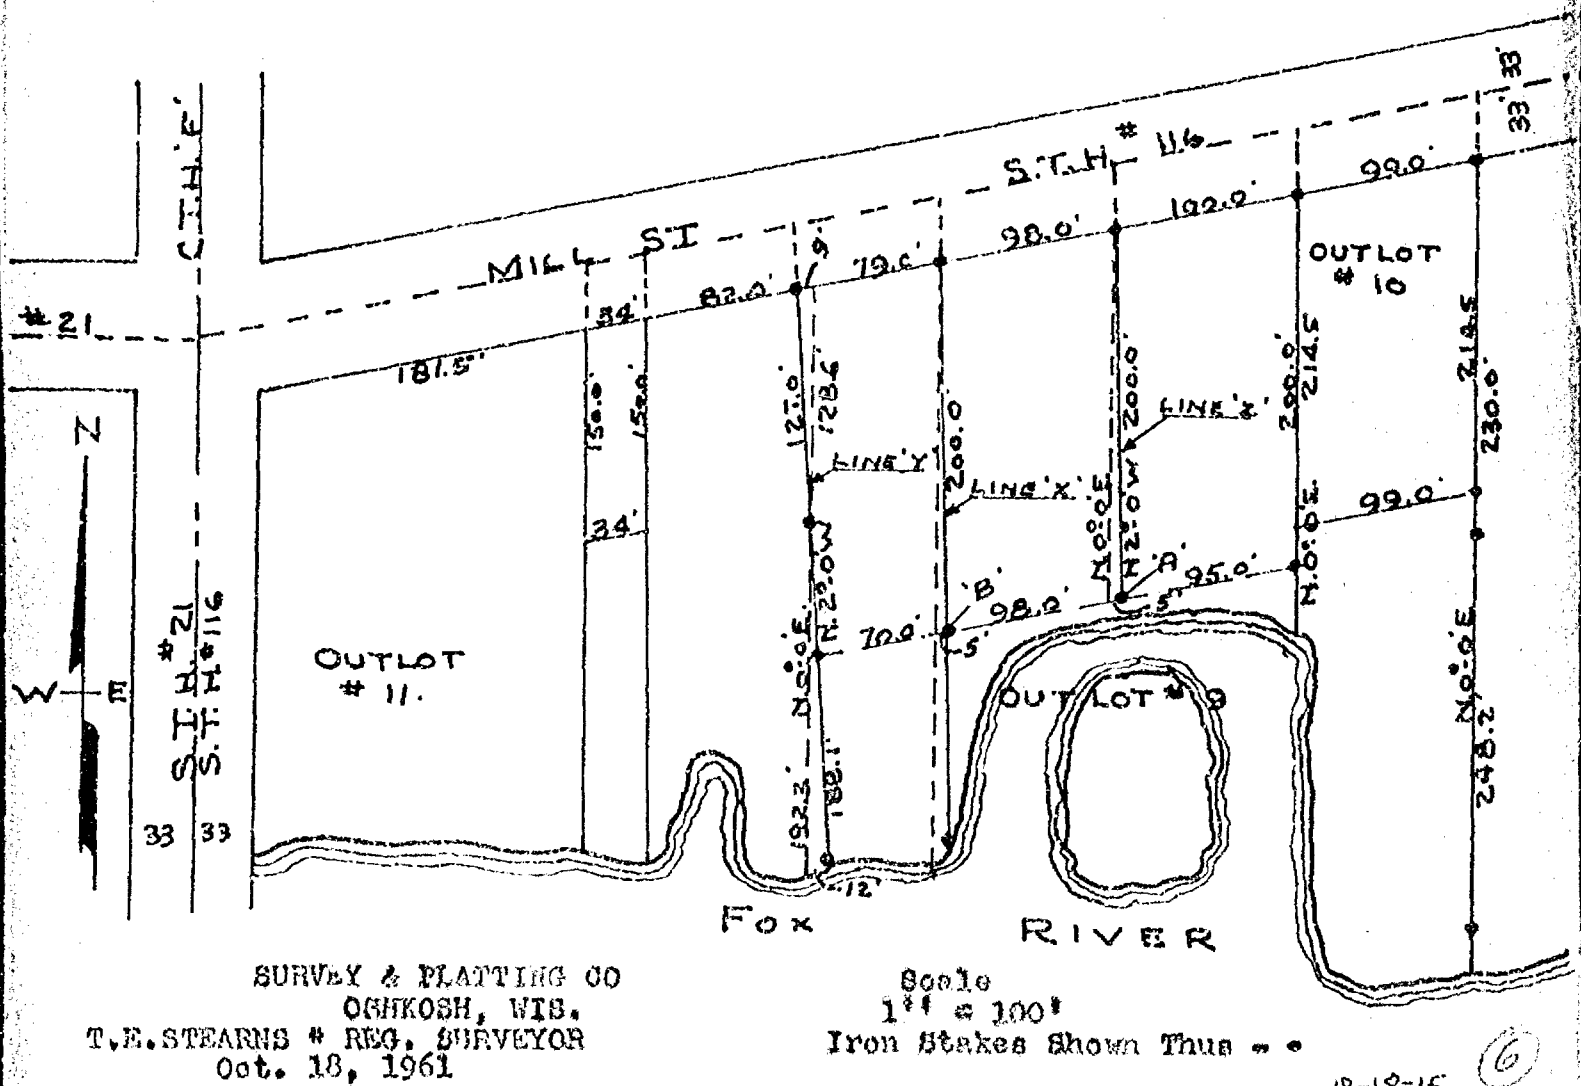

Parcel Retained By L.J. Schoenbechler & Jean M. Schoenbechler, His Wife:


That Part Of Lot # 9, North Of Fox River, According To PLAT OF OUTLOTS, In The Village Of Oaro, As Recorded In Winnebago County Registry In Volume 4 Of Plats On Page 24, And Now In The Third Ward, City Of Oaro, Described As Follows: Commencing At A Point Of Intersection Of The West Line Of Lot 10, North Of Fox River, According To Said Plat Of Outlots With The Southerly Line Of Mill St., Thence South Along The West Line, And Extended West Line, Of Said Lot 10, 200.0 ft., Thence Westerly Parallel With The Southerly Line Of Said Mill Street, 95.0 ft., The Place Of Beginning, Thence Northerly Along A Line (Hereinafter Referred To As 'Line Z') To A Point On The Southerly Line Of Mill St., That Is 100.0 ft. Westerly Of The Point Of Intersection Of Said Southerly Line With The West Line Of Said Lot 10, Thence Easterly Along The Southerly Line Of Mill St., 100.0 ft. To The Westerly Line Of Said Lot 20, Thence South Along The West Line, And The Extended West Line, Of Said Lot 20 To The Line Of That Portion Of Said Lot 9 Now Under Water, At Low Water Mark, Thence Westerly Along The Line Of That Portion Of Said Lot 9 Now Under Water, At Low Water Mark, To Point Of Intersection With The Extension Of Aforementioned 'Line Z', Thence Northerly Along The Extension Of Aforementioned 'Line Z' To Place Of Beginning.

Also All That Portion Of Said Lot 9 Heretofore Conveyed To L.J. Schoenbechler And Jean M. Schoenbechler, His Wife By Deed Recorded In Winnebago County Registry In Volume 532 On Page 42 Lying South Of The Northerly And Westerly Lines Of That Portion Of Said Lot Now Under Water, At Low Water Mark.

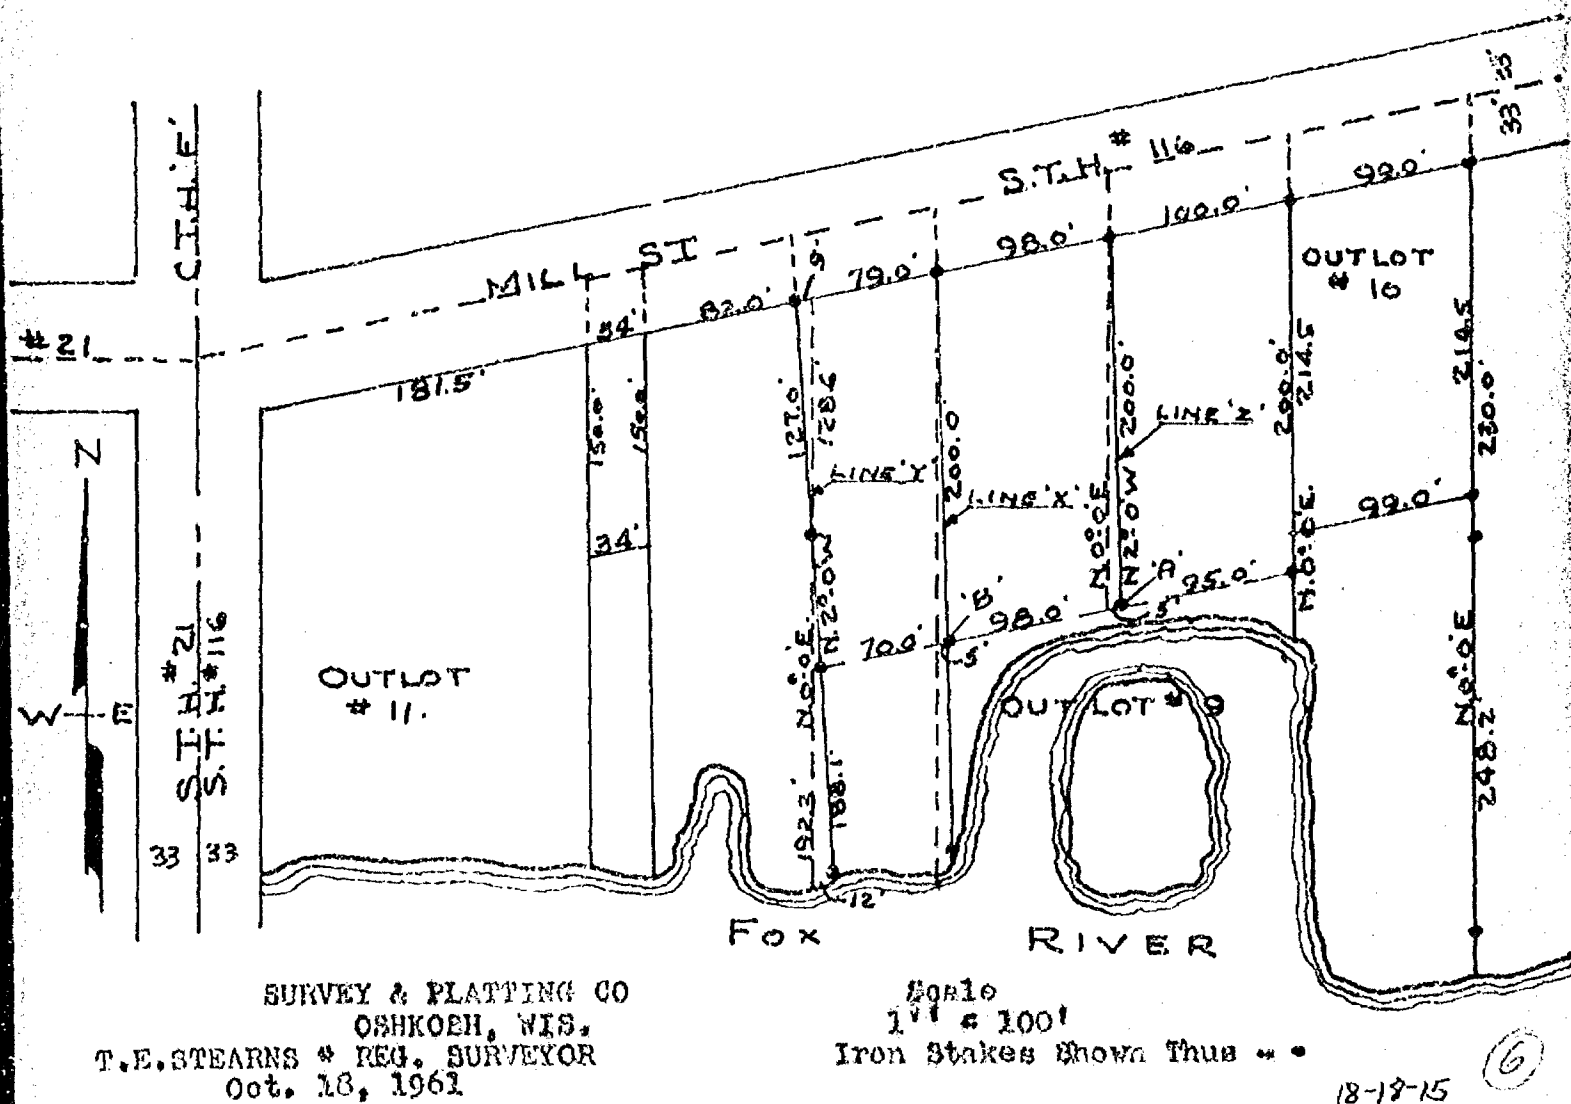

Warranty Deed L.J. Schoenbechler And Jean M. Schoenbechler, His Wife
To (NEW PURCHASERS).

That Part Of Lot 9, North Of Fox River, According To FLAT OF OUTLOTS, In
The Village Of Onro, As Recorded In Winnebago Registry In Volume 4 Of Plats
On Page 24, And Now In The Third Ward, City Of Onro, Described As Follows:
Commencing At The Point Of Intersection Of The West Line Of Lot 10, North
Of Fox River, According To Said Flat Of Outlots, With Southerly Line Of
Mill Street, Thence South Along The West Line, And Extended West Line, Of
Said Lot 10, 200.0 ft., Thence Westerly Parallel With The Southerly Line Of
Said Mill St., 95.0 ft., To A Point Hereinafter Referred To As 'Point A',
Thence Westerly Parallel With The Southerly Line Of Mill St., 98.0 ft.,
The Place Of Beginning, Thence Northerly Along A Line (Hereinafter Referred
To As 'Line X') To A Point On The Southerly Line Of Mill St. That Is 198.0 ft.
Westerly Of The Point Of Intersection Of Said Southerly Line With The West
Line Of Said Lot 10, Thence Easterly Along The Southerly Line Of Mill St.,
98.0 ft., Thence Southerly Along A Line To Point Of Intersection With Afore-
mentioned 'Point A', Thence Continuing Southerly Along The Extension Of Last
Mentioned Line To Line Of That Portion Of Said Lot 9 Now Under Water, At Low
Water Mark, Thence Westerly And Southerly Along The Line Of That Portion
Of Said Lot 9 Now Under Water, At Low Water Mark, To Point Of Intersection
With The Extension Of Aforementioned 'Line X', Thence Northerly Along The
Extension Of Aforementioned 'Line X' To Place Of Beginning.

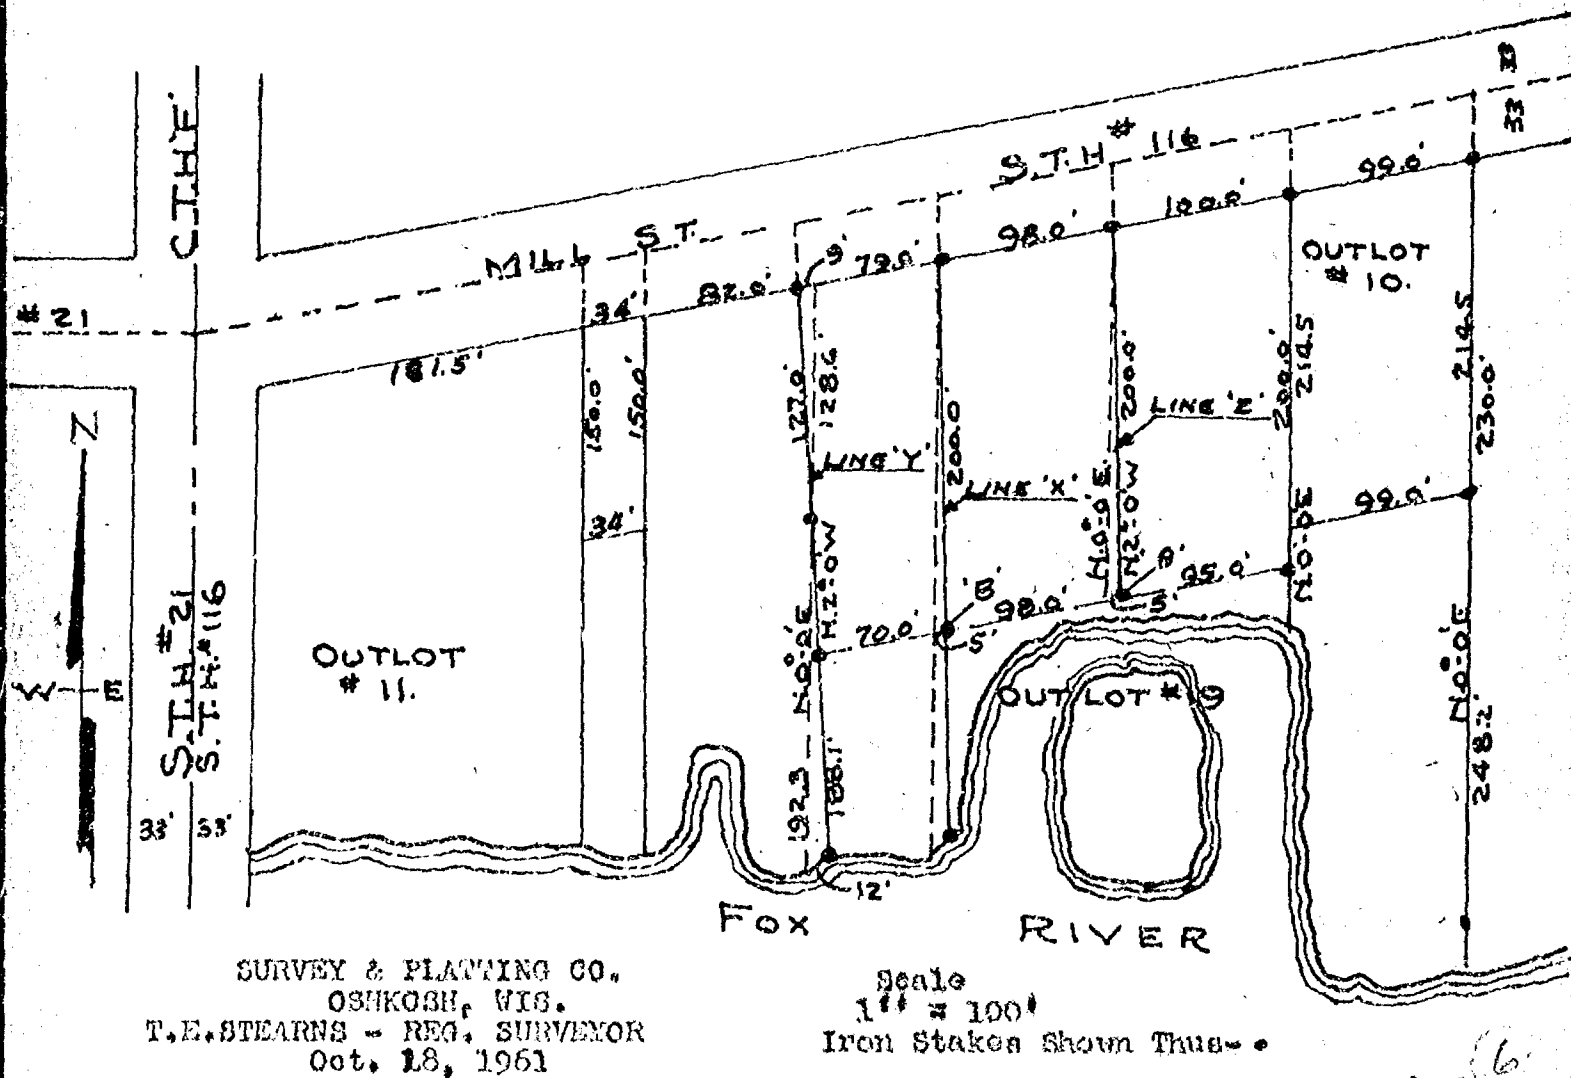


18-18-15

Quit Claim Deed Madge D. Lockhart Decker To W.H. Peterson And Martha Peterson, Husband And Wife.

That Part Of Lot 9, North Of Fox River, According To PLAT OF OUTLOTS, In The Village Of Onro, As Recorded In Winnebago County Registry In Volume 4 Of Plats On Page 24, & Now In The Third Ward, City Of Onro, Described As Follows:

Commencing At The Point Of Intersection Of The West Line Of Lot 10, North Of Fox River, According To Said Plat Of Outlots With The Southerly Line Of Mill Street, Thence South Along The West Line, and The Extended West Line Of Said Lot 10, 200.0 ft., Thence Westerly Parallel With The Southerly Line Of Mill St., 865.0 ft., The Place Of Beginning, Thence Northerly Along A Line (Hereinafter Referred To As 'Line Y') To A Point On The Southerly Line Of Said Mill St., That Is 277.0 ft. Westerly Of The Point Of Intersection Of Said Southerly Line With The West Line Of Said Lot 10, Thence Westerly Along The Southerly Line Of Mill St., To A Point That Is 34.0 ft. Easterly Of The Point Of Intersection Of Said Southerly Line With The East Line Of Lot 11, North Of Fox River, According To Said Plat Of Outlots, Thence South Parallel With The East Line Of Said Lot 11, 150.0 ft., Thence Westerly Parallel With The Southerly Line Of Mill St., 34.0 ft., To The East Line Of Said Lot 11, Thence South Along The East Line Of Said Lot 11 To The Northerly Shore Of Fox River, At Low Water Mark, Thence Easterly Along The Northerly Line Of Said Fox River To Point Of Intersection With The Extension Of Aforementioned 'Line Y', Thence Northerly Along The Extension Of Aforementioned 'Line Y' To The Place Of Beginning.

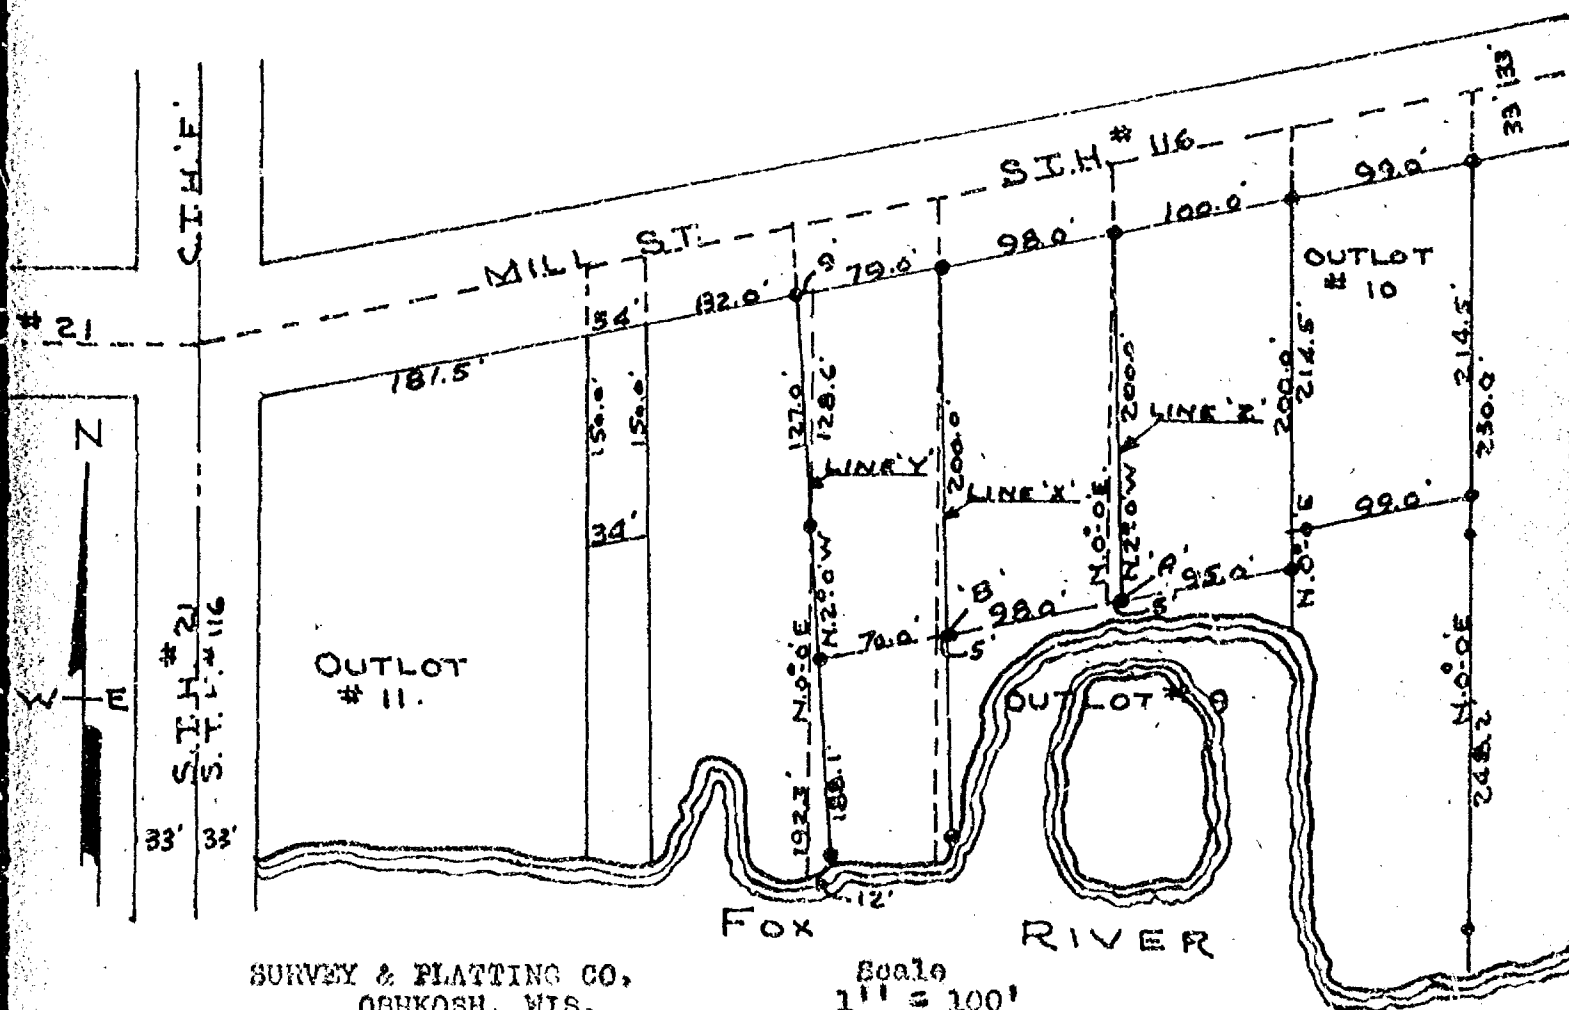

SURVEY & PLATTING CO.
OSHKOSH, WIS.
T.E. STEARNS - REG SURVEYOR
Oct. 18, 1961


Scale
1" = 100'
Iron Stakes Shown Thus - -

18-18-15 (6)


Survey For A.J. Caslane:

Description For Parcel # 1

All Of The North 1/2 Of Lots # 29 And 30 In The Western Addn. To The City Of Oshkosh.

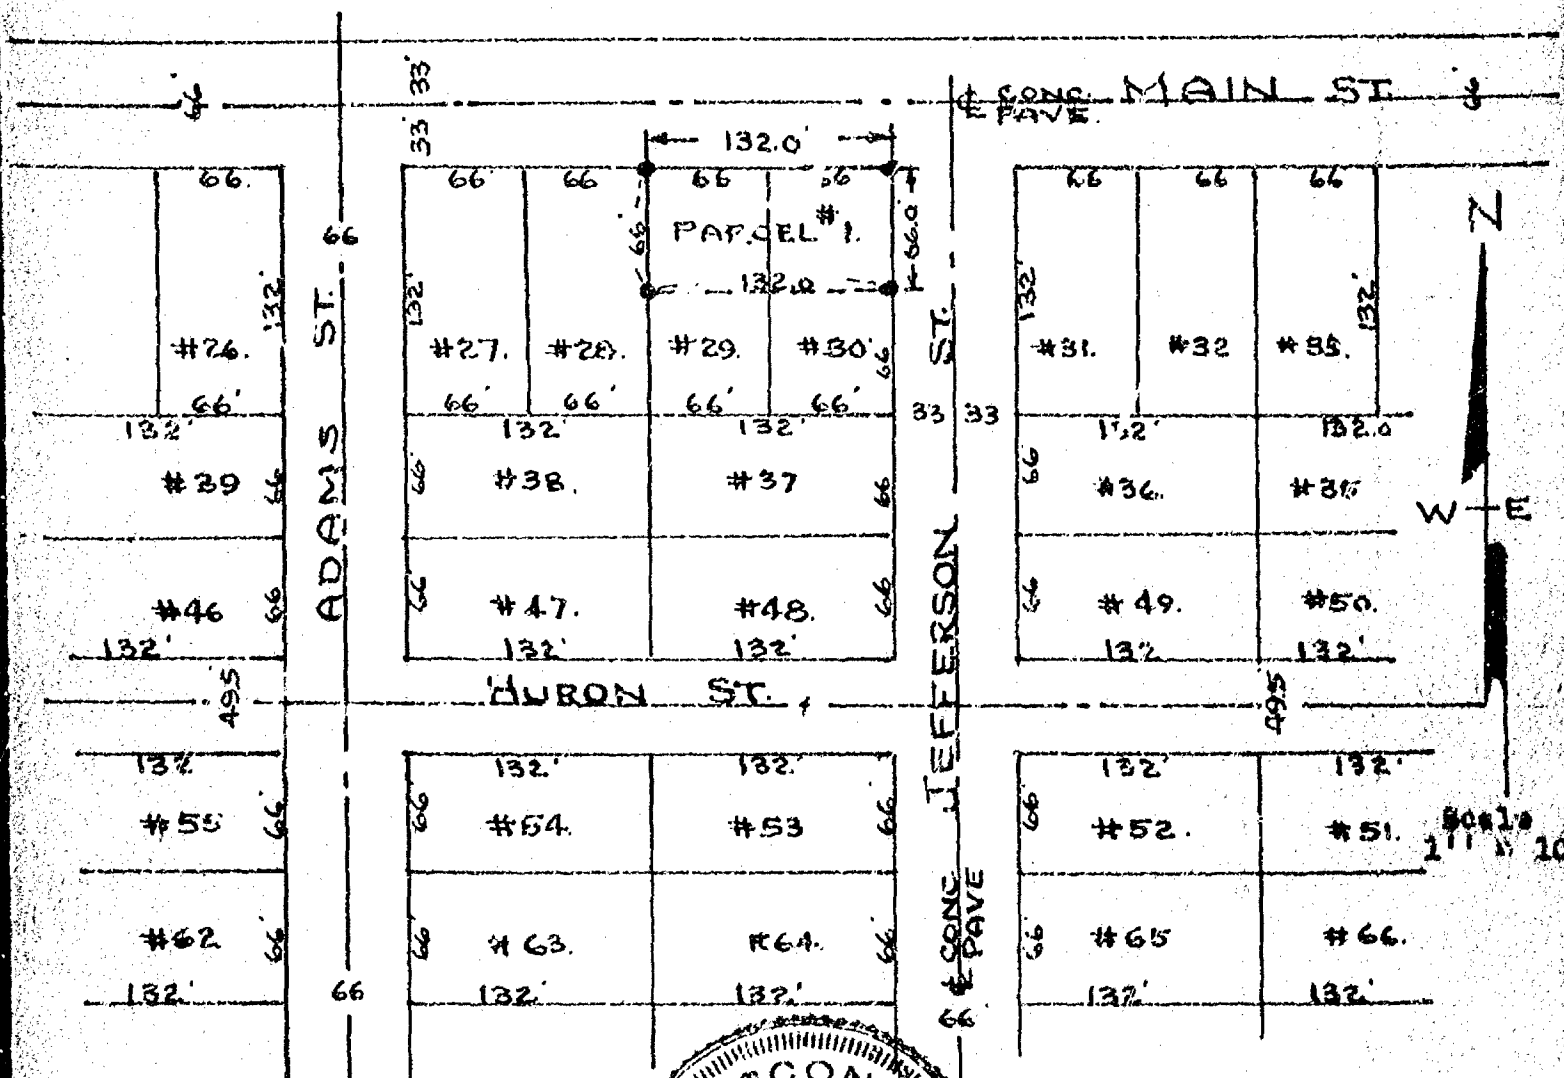

Iron Stakes Shown Thus - •

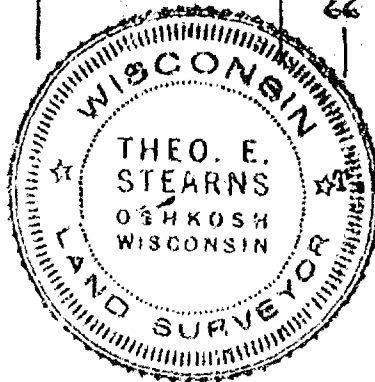

Survey & Platting Co.
Oshkosh, Wis.
E. Stearns - Reg. Surveyor
Aug. 7, 1971

18-18-15


(5)

Survey For Irwin Krueger:

Description For Parcel # 1

That Part Of The Plat Of Omro Outlots South Of The River In Omro Wis., Rounded & Described As Follows:

That Part Of Outlots # 12 & 15 Described As Follows: Commencing At The Northeast Corner Of Outlot # 12, Thence South Along The East Line Of Outlot # 12, 255.7 ft. To The Place Of Beginning: Thence Due West, Parallel With The South Line Of Outlot # 15, 90.0 ft., Thence South, Parallel With The East Line Of Outlot # 12, 300.0 ft. To The South Line Of Outlot # 15, Thence East Along The South Line Of Outlot # 15, 90.0 ft. To The Southeast Corner Of Outlot # 15, Thence North, Along The East Line Of Outlot # 12 & 15, 300.0 ft. To The Place Of Beginning.

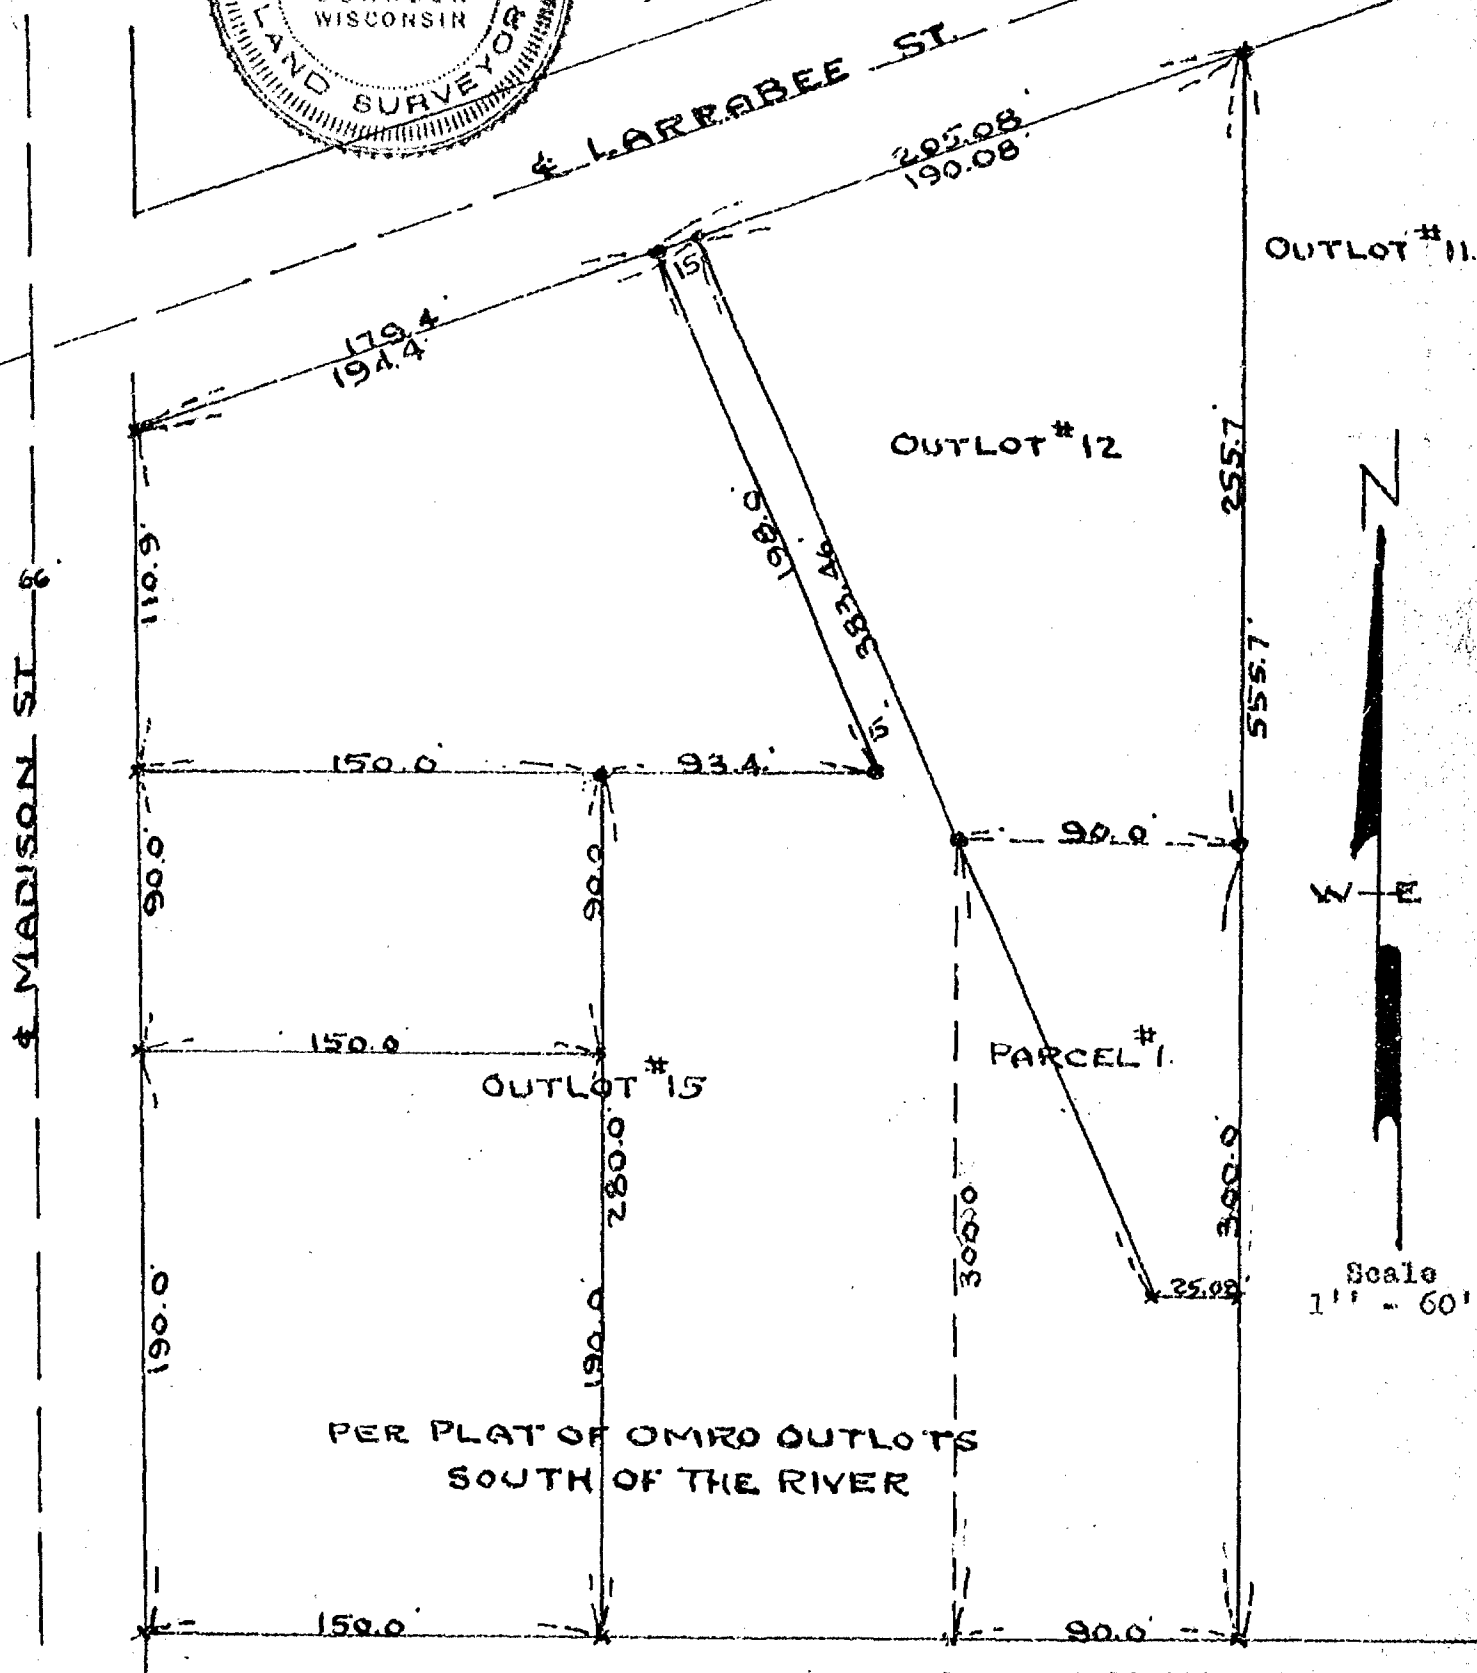


PER PLAT OF OMRO OUTLOTS
SOUTH OF THE RIVER

Iron Stakes Shown Thus -

Survey & Platting Co.
Oshkosh, Wis.
T.E. Stearns - Reg. Surveyor
Oct. 8, 1974

18-19-15 (5)

122

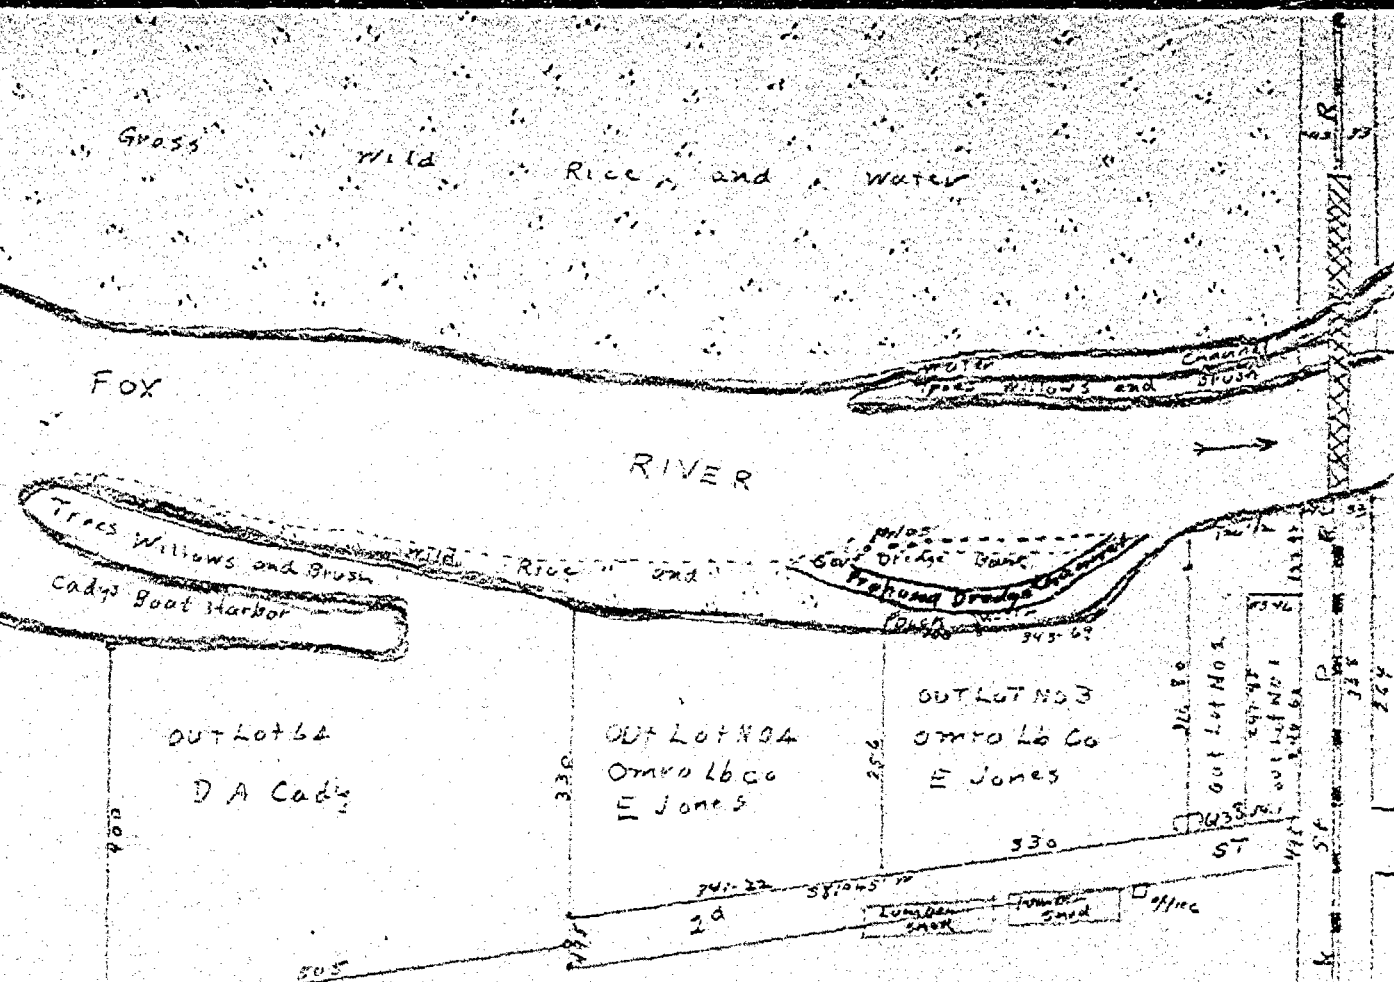

I began at the S^W corner of Out Lot 4 at an iron stake that I had set in 1911 and at the R R Limits and from those points I made this survey for the purpose of the location of a Dock on Fox River by the Omro Lbr Co and dredging to be done on Lot 3 of Blackmers First Addition to the Village of Omro this was done on the 15th of July 1912 and after consulting with the Govt Engineers at Oshkosh as to his wishes I Ret again on the 18th and made some further measurements and drew a map of this survey made and gave it to E Jones at his Office at Omro on July 19th 1912

W W Goold Co Surveyor
W W Goold Chairman
D A Cady

SURVEY OF FOX RIVER AND PART OF BLACKMERS
IN ADDITION TO OMRO WISCONSIN

BROWN

110


SCALE
1" = 200'

CITY OF OSHKOSH
ENGINEERING DEPARTMENT

18-8-15

SURVEY OF LOTS 40-41-44-45 IN WESTERN ADDITION
TO THE VILLAGE OF OMKO WINNEBAGO COUNTY WIS.
SURVEY OF OUT LOTS IN BLACKMERS 1ST ADDITION
VILLAGE OF OMKO.

250

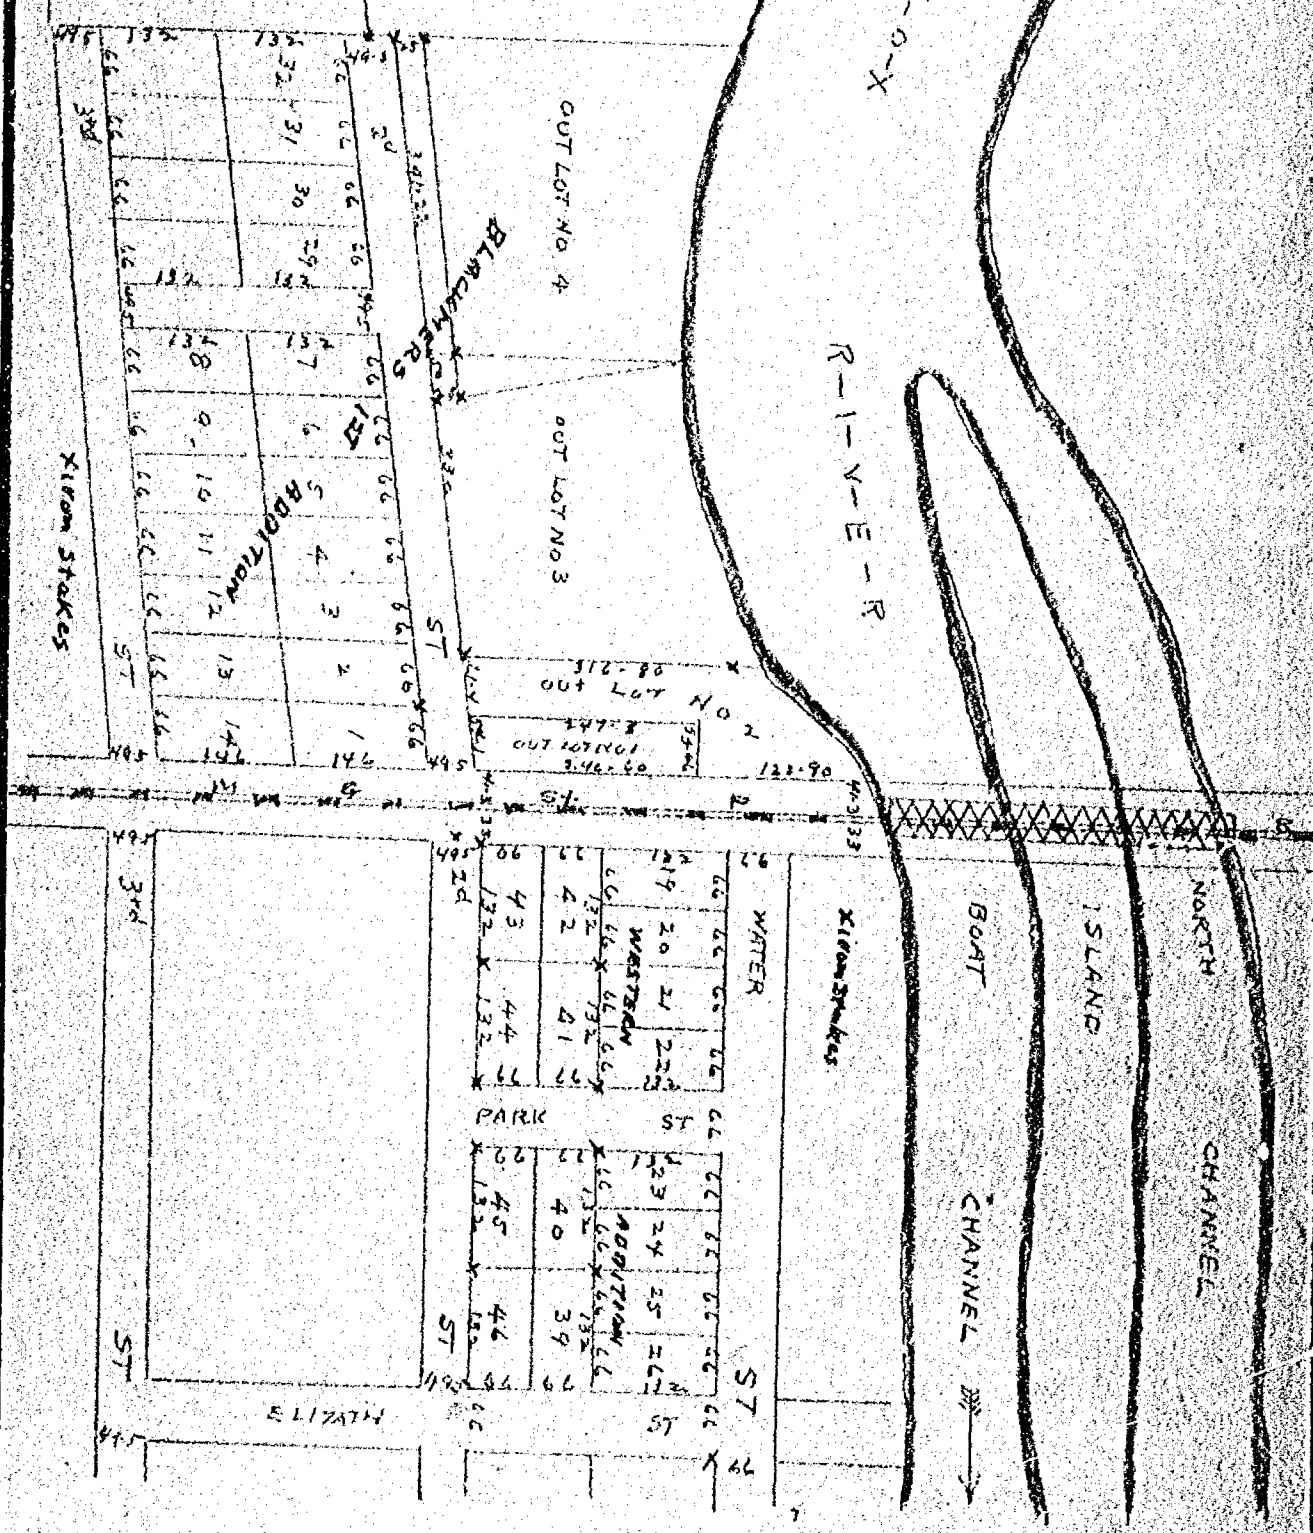


CITY OF OSHKOSH
ENGINEERING DEPARTMENT

DRAWN

SCALE
1" = 200'


SURVEY OF LOTS 40-41-44-45 IN WESTERN
ADDITION TO THE VILLAGE OF OMKO WINNEBAGO
COUNTY WIS.

1873-15

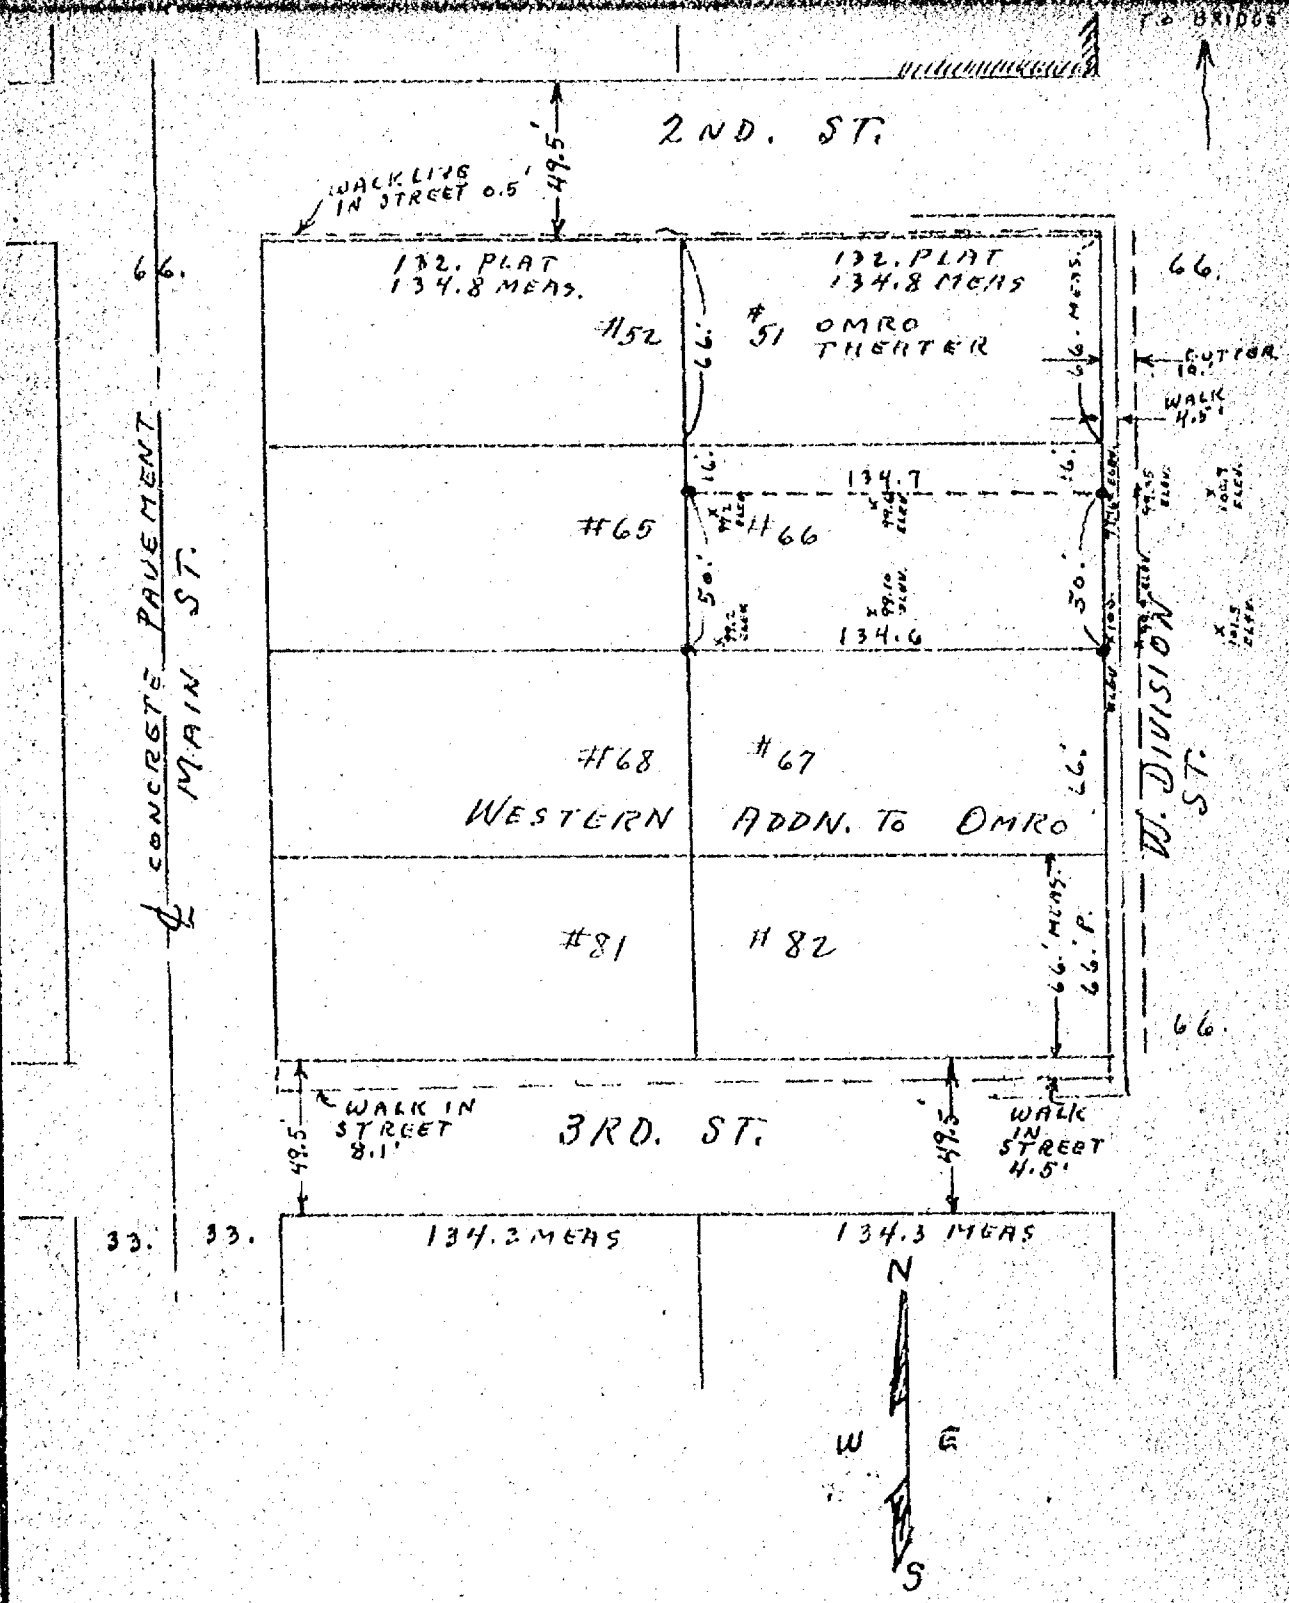


NOTE: THE ELEVATIONS SHOWN HERE ARE RELATIVE & ARE REFERRED TO THE WALK AT THE S.E. CORNER OF LOT #66 AS 100.

CITY OF OSHKOSH ENGINEERING DEPARTMENT R.F. WOLBERTON - HK	DRAWN 7/16/47 SCALE 1" = 60'	SURVEY S. 150' OF LOT #66 WESTERN ADDN. TO OMRO WINNEBAGO CO., WIS. FOR E. W. MILLER P.O. BOX 1085 MILWAUKEE 12-18-15 CITY OF OMRO
---	---	---

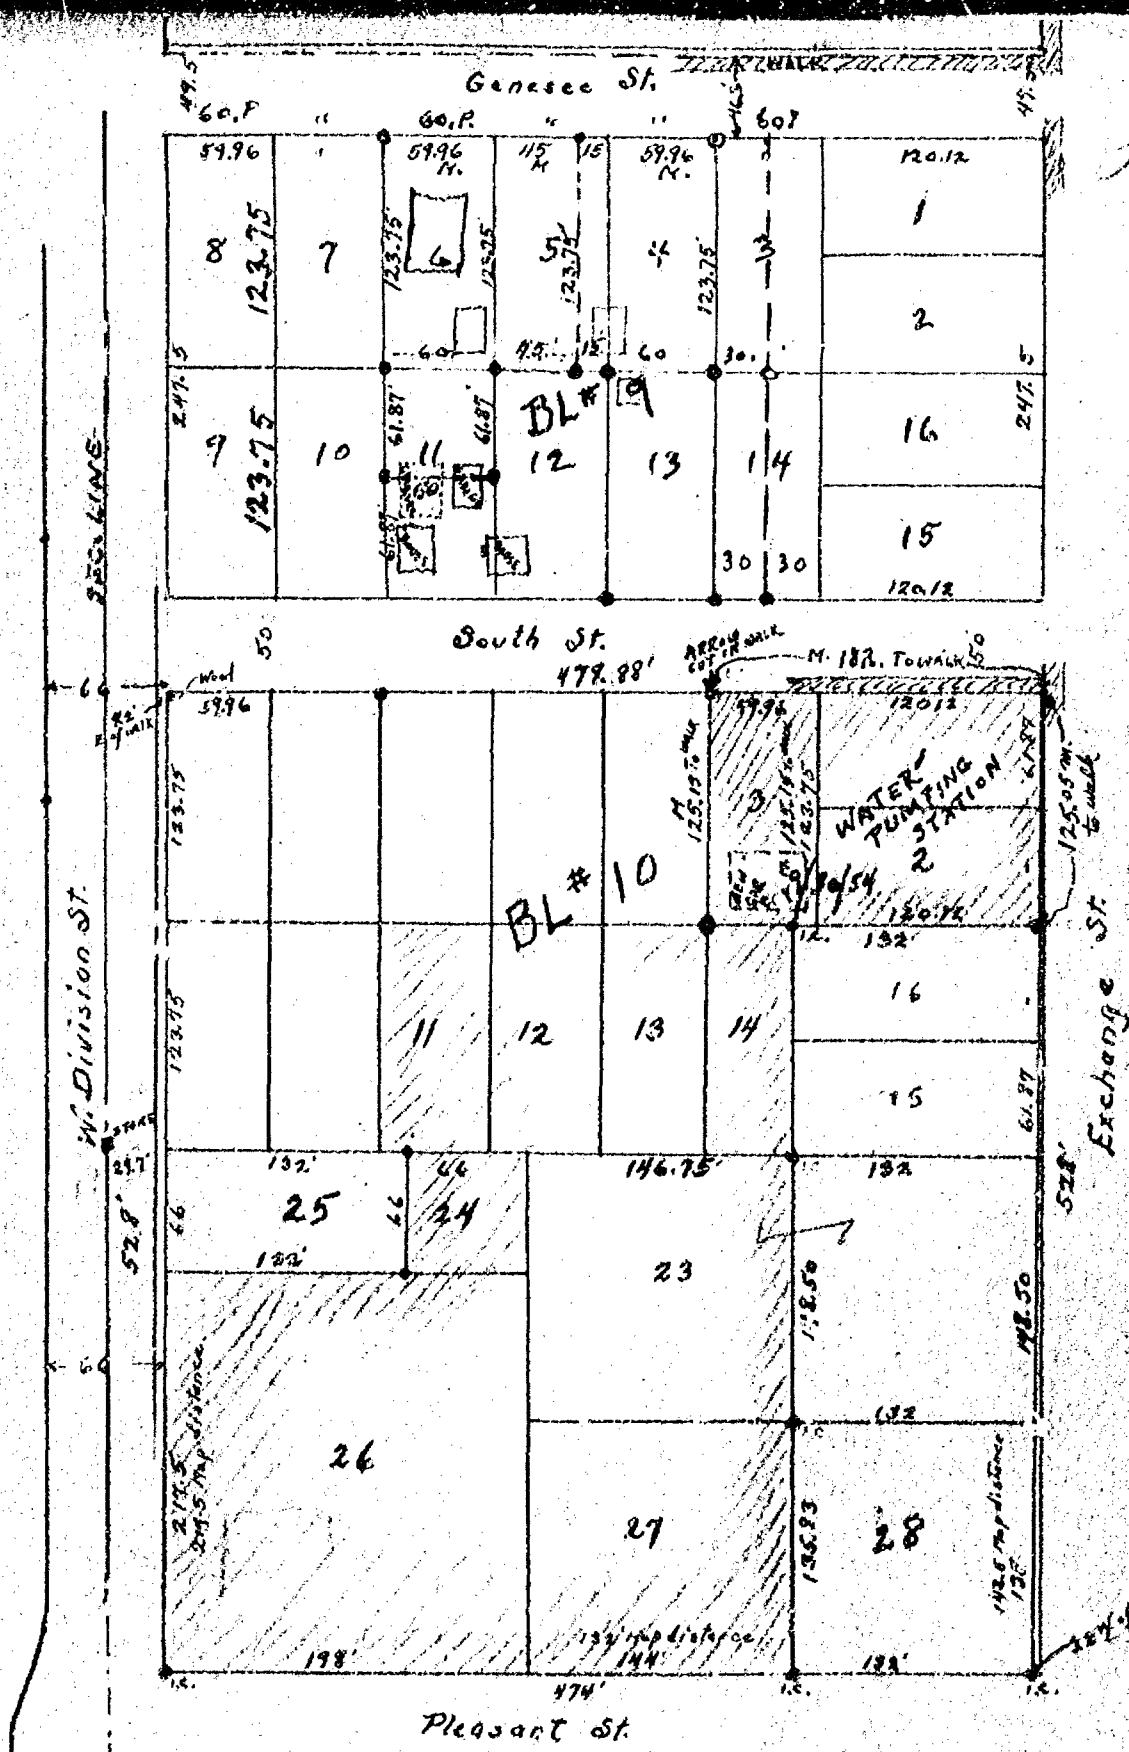

Gueld 1926
1818

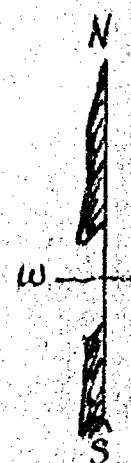

SURVEY OF LOT 61
LOT #5 EXC. E. 15'
& N. 1/2 OF LOT 11
ALL IN BL. 9 ORIGINAL PLAT
OF OMRO
FOR DR. SCHEN BECKLER
5/16/51 R.F. WOLVERTON CO. SURVEYOR

School Property - Village of Omro
Scale 1"=100'
R.F. Wolverson Surveyor

Aug. 16, 1938

17-18-15