

**PART OF THE SE 1/4 OF THE SE 1/4 OF SEC. 24,
T.18N., R.15E., TOWN OF OMRO, WINNEBAGO CO., WI.**

DESCRIPTIONS:

PARCEL 1

All that part of the SE 1/4 of the SE 1/4 of Sec. 24, T.18N., R.15E., in the Town of Omro, Winnebago County, Wisconsin, described as follows: Beginning at a point on the southerly line of the SE 1/4 of said Sec. 24 that is 616.00 ft., S. 88° 41' 57" W., of the Southeast corner of said Sec. 24. From that point running S. 88° 41' 57" W. along said Sec. line, 211.00 ft., thence S. 00° 26' 57" E., 216.00 ft., thence S. 88° 41' 57" W., 243.88 ft., thence N. 00° 26' 57" E., 252.23 ft., thence S. 88° 41' 57" W., 326.07 ft., thence S. 00° 26' 57" E., 200.00 ft., thence S. 88° 41' 57" W., 100.00 ft., thence S. 00° 26' 57" E., 216.00 ft. to the said point of beginning. Being a parcel of land of 8.695 acres, more or less. Reserving therefrom the southerly 33.00 ft. presently used for road purposes. Subject to all easements and restrictions of record.

PARCEL 2

All that part of the SE 1/4 of the SE 1/4 of Sec. 24, T.18N., R.15E., in the Town of Omro, Winnebago County, Wisconsin, described as follows: Beginning at a point on the Westerly line of the SE 1/4 of said Sec. 24 that is 1340.085 ft., S. 88° 41' 57" W., and 425.00 ft., N. 00° 26' 57" E., of the Southeast corner of said Sec. 24. From that point running N. 00° 26' 57" E., 339.77 ft., thence S. 88° 41' 57" W., 791.10 ft., thence S. 00° 26' 57" E., 243.24 ft., thence S. 88° 41' 57" W., 269.01 ft. to the said point of beginning. Being a parcel of land 9.317 acres, more or less. Subject to all easements and restrictions of record.

PARCEL 3

All that part of the SE 1/4 of the SE 1/4 of Sec. 24, T.18N., R.15E., in the Town of Omro, Winnebago County, Wisconsin, described as follows: Beginning at an iron pipe that is 1026.50 ft., N. 00° 26' 57" E., and 239.50 ft., S. 88° 41' 57" W., of the corner of said Sec. 24. From that point running S. 00° 26' 57" E., 110.50 ft., thence S. 88° 41' 57" W., 1049.50 ft., thence N. 00° 26' 57" E., 516.51 ft., thence S. 88° 41' 57" W., 1049.50 ft. to the said point of beginning. Being a parcel of land of 7.379 acres, more or less. Subject to all easements and restrictions of record.

PARCEL 4

All that part of the SE 1/4 of the SE 1/4 of Sec. 24, T.18N., R.15E., in the Town of Omro, Winnebago County, Wisconsin, described as follows: Beginning at an iron pipe on the East line of the SE 1/4 of said Sec. 24 that is 216.00 ft., N. 00° 26' 57" E., of the Southeast corner of said Sec. 24. From that point running N. 00° 26' 57" E., along said East line 1110.50 ft., thence S. 88° 41' 57" W., 200.00 ft., thence S. 00° 26' 57" E., 658.27 ft., thence N. 88° 41' 57" W., 226.57 ft., thence S. 00° 26' 57" E., 252.23 ft., thence S. 88° 41' 57" W., 226.57 ft., thence S. 00° 26' 57" E., 200.00 ft., thence N. 88° 41' 57" E., 416.00 ft. to the said point of beginning. Being a parcel of land of 7.379 acres, more or less. Subject to all easements and restrictions of record.


**CLIENT: ALBERT E. BLESER
4989 WASHINGTON
BUTTE DES MORTS, WI.
54927**

Robert H. Saylor
Robert H. Saylor S-1894
Wisconsin Registered Land Surveyor
April 19, 1991

REVISED JUNE 4, 1991
REVISED JULY 2, 1991



- BERNTSEN MONUMENT
- EXISTING IRONS
- 1" x 30" IRON PIPE SET

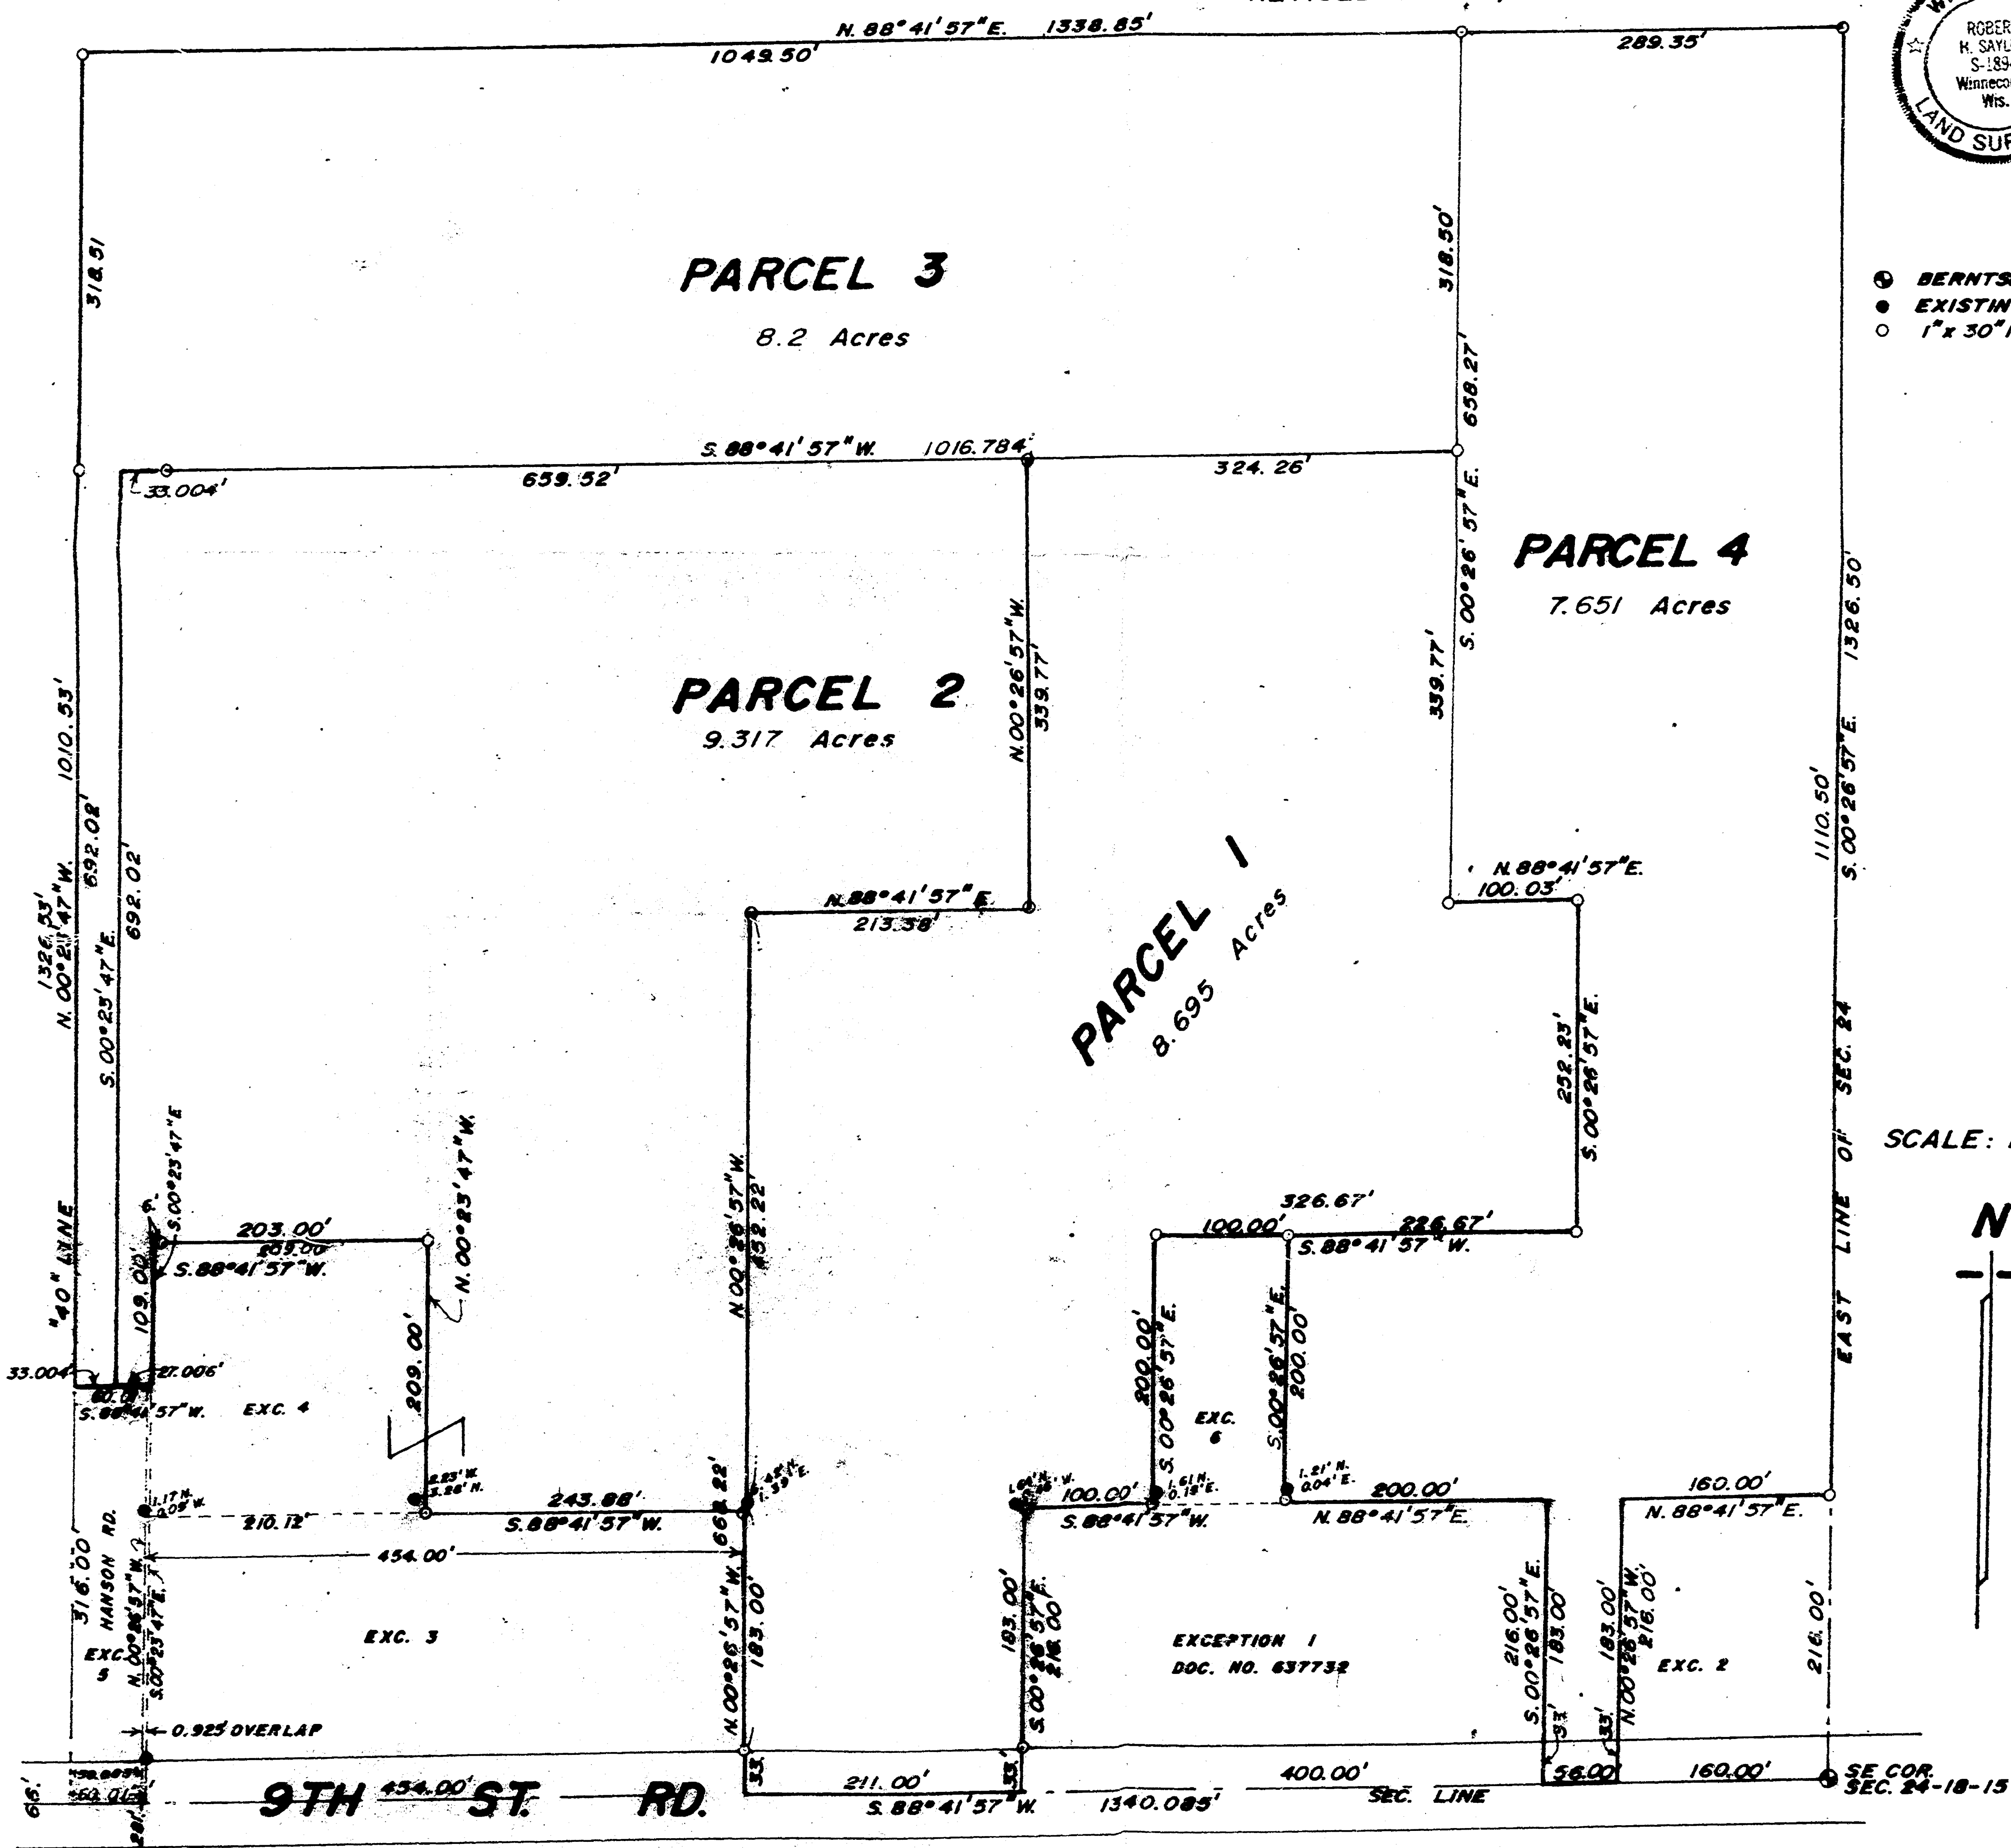

**NOTE: ROAD WIDTHS CANNOT BE CHANGED- ONLY BY TOWN ORDINANCE
EAST-WEST DISTANCE OF FORTY DESCRIBED AS 1341.00 FT. SEC. SUMMARY-1340.085'**

Sec 24 T18N R15E

S24

341. Last part of the SE1/4 of the SE1/4 of Sec. 24, T.13N., R.15E. in the Town of Orono, Washington County, Wisconsin, described as follows: Beginning at a point on the southerly line of said SE1/4 of said Sec. 24 that is 616.00 ft. S. 89° 41' 57"W. to the southeast corner of said Sec. 24. From that point running S. 89° 41' 57"W. along said sec. line 216.00 ft. thence 0° 26' 57"W. 216.00 ft. thence S. 89° 41' 53"W. 11.38 ft. thence 216.00 ft. thence 72.24 ft. thence N. 88° 41' 51"W. 891.15 ft. thence S. 89° 41' 51"W. 253.25 ft. thence S. 88° 41' 59"W. 326.67 ft. thence S. 89° 41' 57"W. 209.60 ft. thence S. 89° 41' 57"W. 180.60 ft. thence S. 89° 26' 57"E. 211.00 ft. to the said point of beginning being a parcel of land of 6.835 acres, more or less, reserving therefrom the southerly 33.00 ft. presently used for road purposes, subject to all easements and restrictions of record:

2. That part of the SE1/4 of the SE1/4 of Sec. 24, T.18N., R.15E. in the Town of Oroy, Winnebago County, Wisconsin, described as follows: Beginning at a point on the Westerly line of the SE1/4 of the SE1/4 of said Sec. 24 that is 1340.085 ft., S. 15° 41' 57" E. and 425.00 ft. to the N.E. corner of said Sec. 24. From that point running N. 60° 58' 02" E. 583.02 ft., thence N. 30° 41' 57" E., 883.78 ft., thence S. 60° 41' 57" E., 139.77 ft., thence S. 32° 41' 57" W., 781.1 ft., thence S. 80° 41' 57" W., 243.24 ft., thence S. 30° 41' 57" W., 259.01 ft. to the said point of beginning. Being a parcel of land 7.631 acres, more or less. Subject to all easements and restrictions of record.

CLIENT: ALBERT E. BLESER
4400 WASHINGTON
BETTE DES MORTS, WI
53007

all that part of the S&L¼ of the S&L¼ of Sec. 24, T.18N., R.15E., in the Town of Omro, Winnebago County, Wisconsin, described as follows: Beginning at an iron pipe that is 1326.50 ft. N. 0° 26' 57" W. and 289.35 ft. S 88° 41' 57" W. of the ~~word~~ corner of said Sec. 24. From that point running S. 00° 26' 57" E. 218.50 ft., thence S. 88° 41' 57" W. 1049.79 ft., thence N. 00° 23' 47" W. 348.51 ft., thence N. 88° 41' 57" E. 1049.50 ft., to the said point of beginning. Being a parcel of land of 7.674 acres, more or less. Subject to all easements and restrictions of record.


PARCEL 4: All that part of the SE1/4 of the SE1/4 of Sec. 24, T.18N., R.13E. in the Town of Garro, Winnebago County, Wisconsin, described as follows: Beginning at an iron pipe on the East line of the SE1/4 of said Sec. 24 that is 216.00 ft., N.00°26'57"W. of the Southeast corner of said Sec. 24. From that point running N.00°26'57"W. along said East line 1119.56 ft., thence S.88°41'57"E. 289.25 ft., thence S.00°26'57"E. 658.27 ft., thence N.93°41'57"E. 226.57 ft., thence S.00°26'57"E. 252.23 ft., thence S.88°41'57"E. 226.57 ft., thence S.90°26'57"E. 200.09 ft., thence N.86°41'59"E. 416.00 ft. to the said point of beginning. Being a parcel of land of 7.378 acres, more or less. Subject to all easements and restrictions of record.

Robert H. Saylor
Robert H. Saylor S-1394
Wisconsin Registered Land Surveyor
April 19, 1991

REVISED JUNE 4, 1991 REVISED OCTOBER 7, 1993
REVISED JULY 2, 1991



- BERNTSEN MONUMENT
- EXISTING IRONS
- 1" X 30" IRON PIPE SET

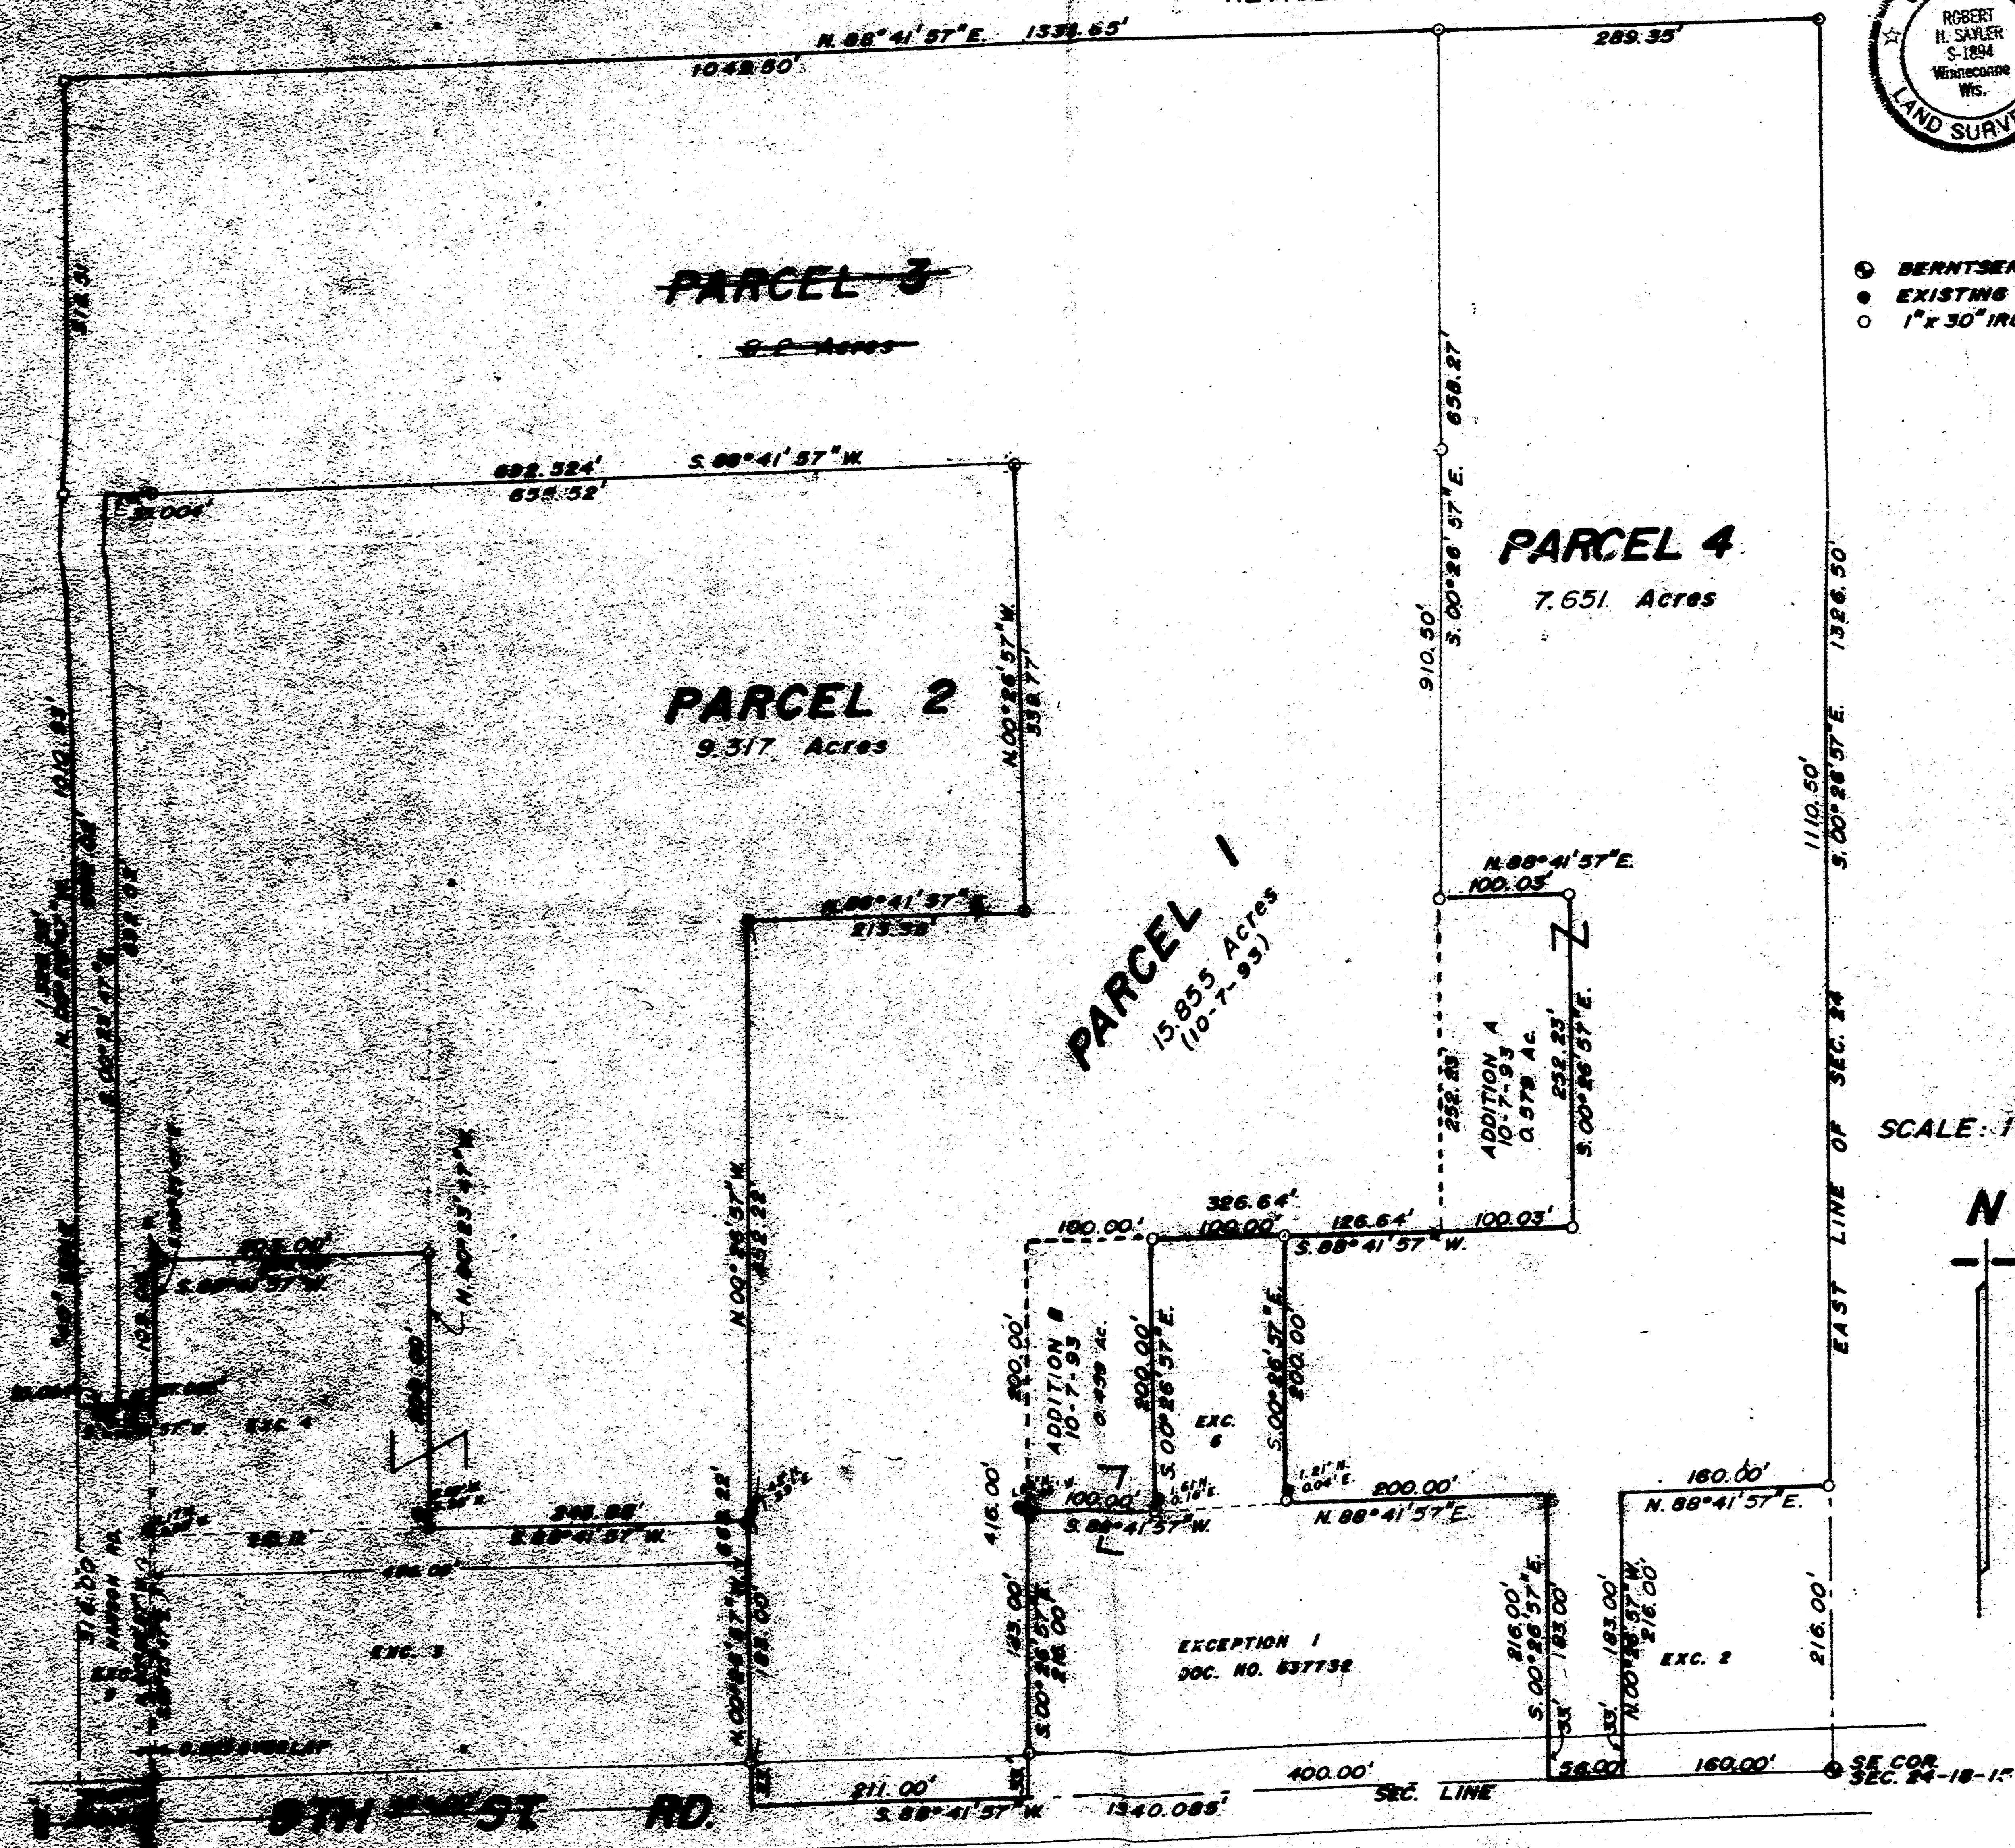

NOTE: ROAD WIDTHS CANNOT BE CHANGED- ONLY BY TOWN ORDINANCE
EAST-WEST DISTANCE OF FORTY DESCRIBED AS 1341.00 FT. SEC. SUMMARY- 1340.085'

SAYLER SURVEY, INC.

LAND SURVEYORS WINNECONNE, WI. S-002354 BK. 61 P. 31-34

Section 24 + 18 ~ R15E


**PLAT OF SURVEY
FOR
MONROE E. RABE, JR.**

DOC. NO. 458080

THE WEST 354 FEET OF THE EAST 1281 FEET
OF THE SOUTH 216 FEET OF THE SE1/4 OF THE
SE1/4, SECTION 24, T.18N., R.15E., EXCEPTING
THAT PORTION USED FOR ROAD PURPOSES

VOL. 1517, PAGE 513, DOC. NO. 411942

THE WEST 100 FEET, FRONT AND REAR,
OF THE EAST 927.0 FEET, OF THE SOUTH
216 FEET OF THE SE1/4 OF THE SE1/4 OF
SECTION 24, T.18N., R.15E., EXCEPTING
THAT PORTION USED FOR ROAD PURPOSES.
SUBJECT TO THE RIGHTS GRANTED BY EASEMENTS
RECORDED IN WINNEBAGO COUNTY, WISCONSIN,
REGISTRY IN VOL. 418 ON PAGE 391 AND IN
VOL. 1243 ON PAGE 463.

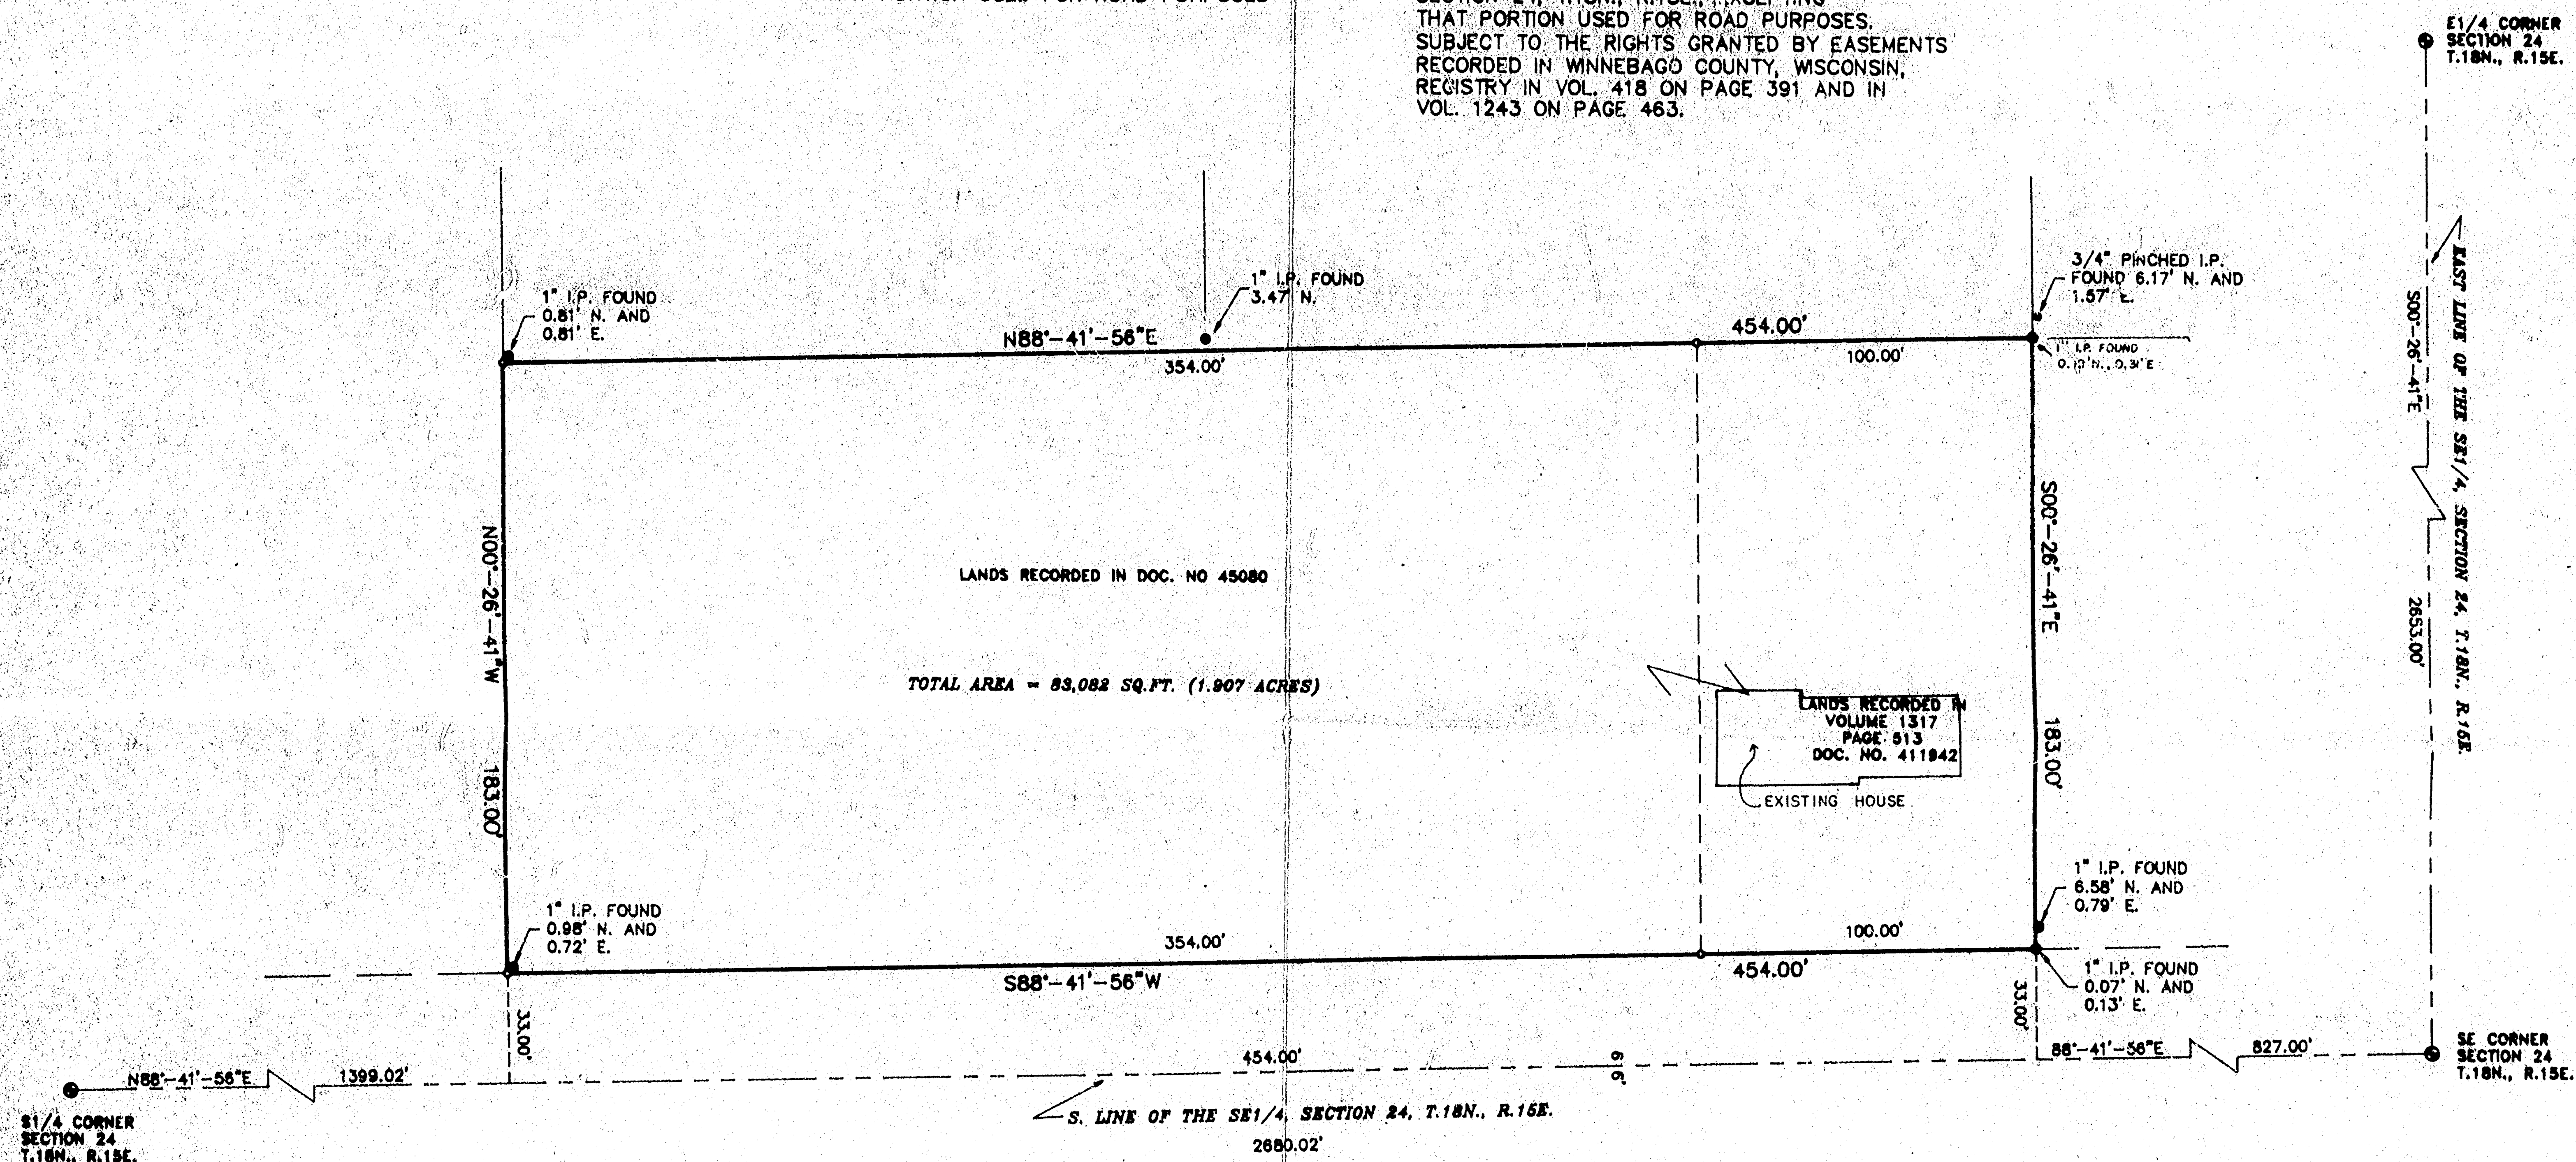

SURVEYORS CERTIFICATE


I, Lawrence C. Kriescher, Wisconsin Registered Land Surveyor of Asro-Metric Engineering, Inc., certify that I have surveyed the above described property and that the map shown above is a true and accurate representation thereof to the best of my knowledge and belief.

Dated this 25TH day of July, 1994.

Lawrence C. Kriescher
WISCONSIN REGISTERED LAND SURVEYOR
Lawrence C. Kriescher, S-1589



Only if the surveyor's signature or stamp is in RED is this an original copy. Anything other than an original copy may contain unauthorized alterations to the original. The surveyor accepts no responsibility for non-original copies of this document.

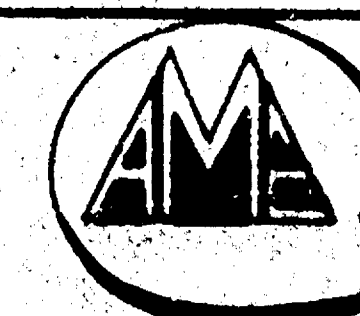

Aero-metric
ENGINEERING, INC.
CHILTON

LAND PLANNING & DESIGN DIVISION
PROPERTY SURVEYS & SUBDIVISION
LANDSCAPE ARCHITECTURE
LAND INFORMATION SYSTEM

DRAWN BY :	S.F.S.	DATE :	07-20-94
PROJECT NO. :	2940624	SCALE :	1"=40'
DRAWING NAME :	RABE		
NOTEBOOK :	PAGE :		D - 425

SEC. 24 T18N R15E