


FLOOD PLAIN SURVEY OF

LOTS 25, 26 AND 27 BLOCK 3
OF WAMPATUCK RESORT LOCATED
IN GOV.T LOT 4 FRACTIONAL
SECTION 9 T18N., R.16E TOWN OF
OSHKOSH, WINNEBAGO COUNTY,
WISCONSIN.

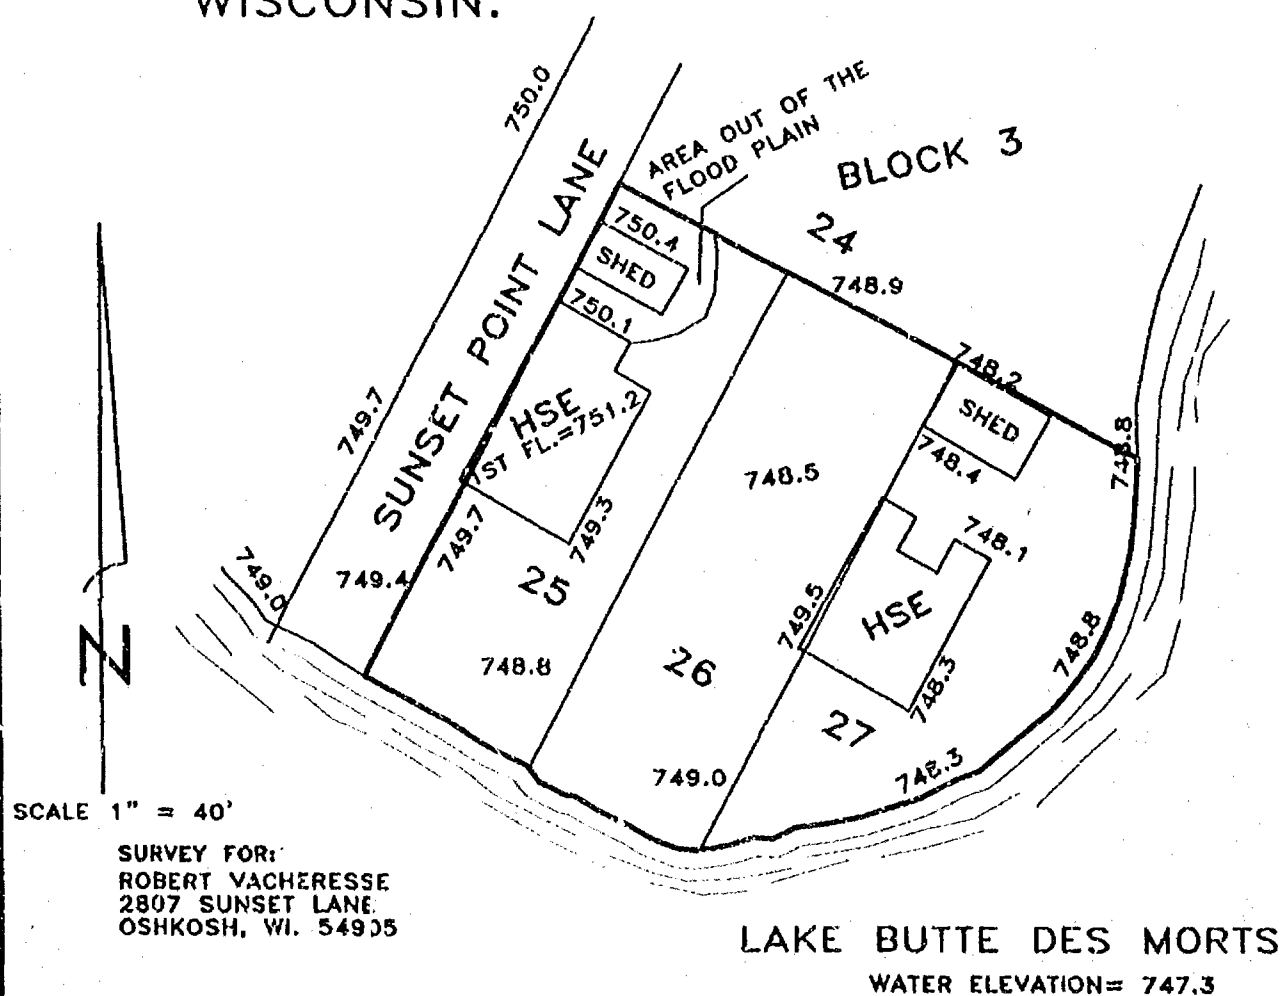

100 YEAR FLOOD ELEVATION = 749.9
ALL ELEVATIONS REFERENCED TO USGS DATUM
NOTE: THE RELATIONSHIP OF THE BUILDINGS TO THE
PROPERTY LINE AND THE SHORELINE ARE APPROXIMATE.



Lawrence C. Kriescher
6-23-00

L.C. KRIESCHER AND ASSOCIATES
5251 GRANDVIEW ROAD
LARSEN, WI. 54947
920-836-3576

BOUNDARY SURVEY
LAND DESIGN

PROJECT NO. 200308
FILE NO. VACH.DWG
DWG. NO. L-76

18/16

1 12 22 7 00 PM
REGISTERED OFFICE
WINNEBAGO COUNTY, WI
RECORDED IN
01/07/2007 03/11/2007
STATE OF WISCONSIN
REGISTERED IN 10120
RECORDS BY
FEE \$1.00
1 17 0001

Return
R.A. Smith and Associates, Inc.
2850 Universal Street
Oshkosh, WI 54904

Learned Smith

AFFIDAVIT
RE: HECKEN BOLLON SUBDIVISION, WINNEBAGO COUNTY

I, Reinhard Pochliq, Registered Wisconsin Land Surveyor hereby certify that:
HECKEN BOLLON on the plat of the above captioned recorded subdivision is changed to FLORA DE LAH COUL

R. Pochliq
Reinhard Pochliq, Registered
Land Surveyor S-1168

2-3-03
Date Signed

State of Wisconsin)

188

Winnebago County)

PERSONALLY came before me this 3rd day of Feb 2003 the
aforementioned Reinhard Pochliq, to be known to be the person who
executed the foregoing affidavit of correction and acknowledged the
same.

[Signature]
Notary Public, Winnebago
County, State of Wisconsin

My Commission Expires 7/1/05

THIS DOCUMENT WAS DRAFTED BY
Reinhard Pochliq

FLOOD PLAIN SURVEY

FOR GERALD J. & DIONE M. GUNTHER

OF
A PART OF GOVERNMENT LOTS 3 AND 4 OF FRACTIONAL
SECTION 9, T.18N., R.16E., TOWN OF ALGOMA
WINNEBAGO COUNTY, WISCONSIN


SURVEYOR'S CERTIFICATE

I, Craig A. Keach, Wisconsin Registered Land Surveyor of Aero-Metric, Inc., certify that I have surveyed the elevations shown on this map and this map is a true and accurate representation thereof to the best of my knowledge and belief.

Dated this 26th day of MARCH, 2002.

Craig A. Keach
WISCONSIN REGISTERED LAND SURVEYOR
Craig A. Keach, S-2333

SURVEYED FOR:
GERALD J. & DIONE M. GUNTHER
2606 SHORE HAVEN LANE
OSHKOSH, WI 54904

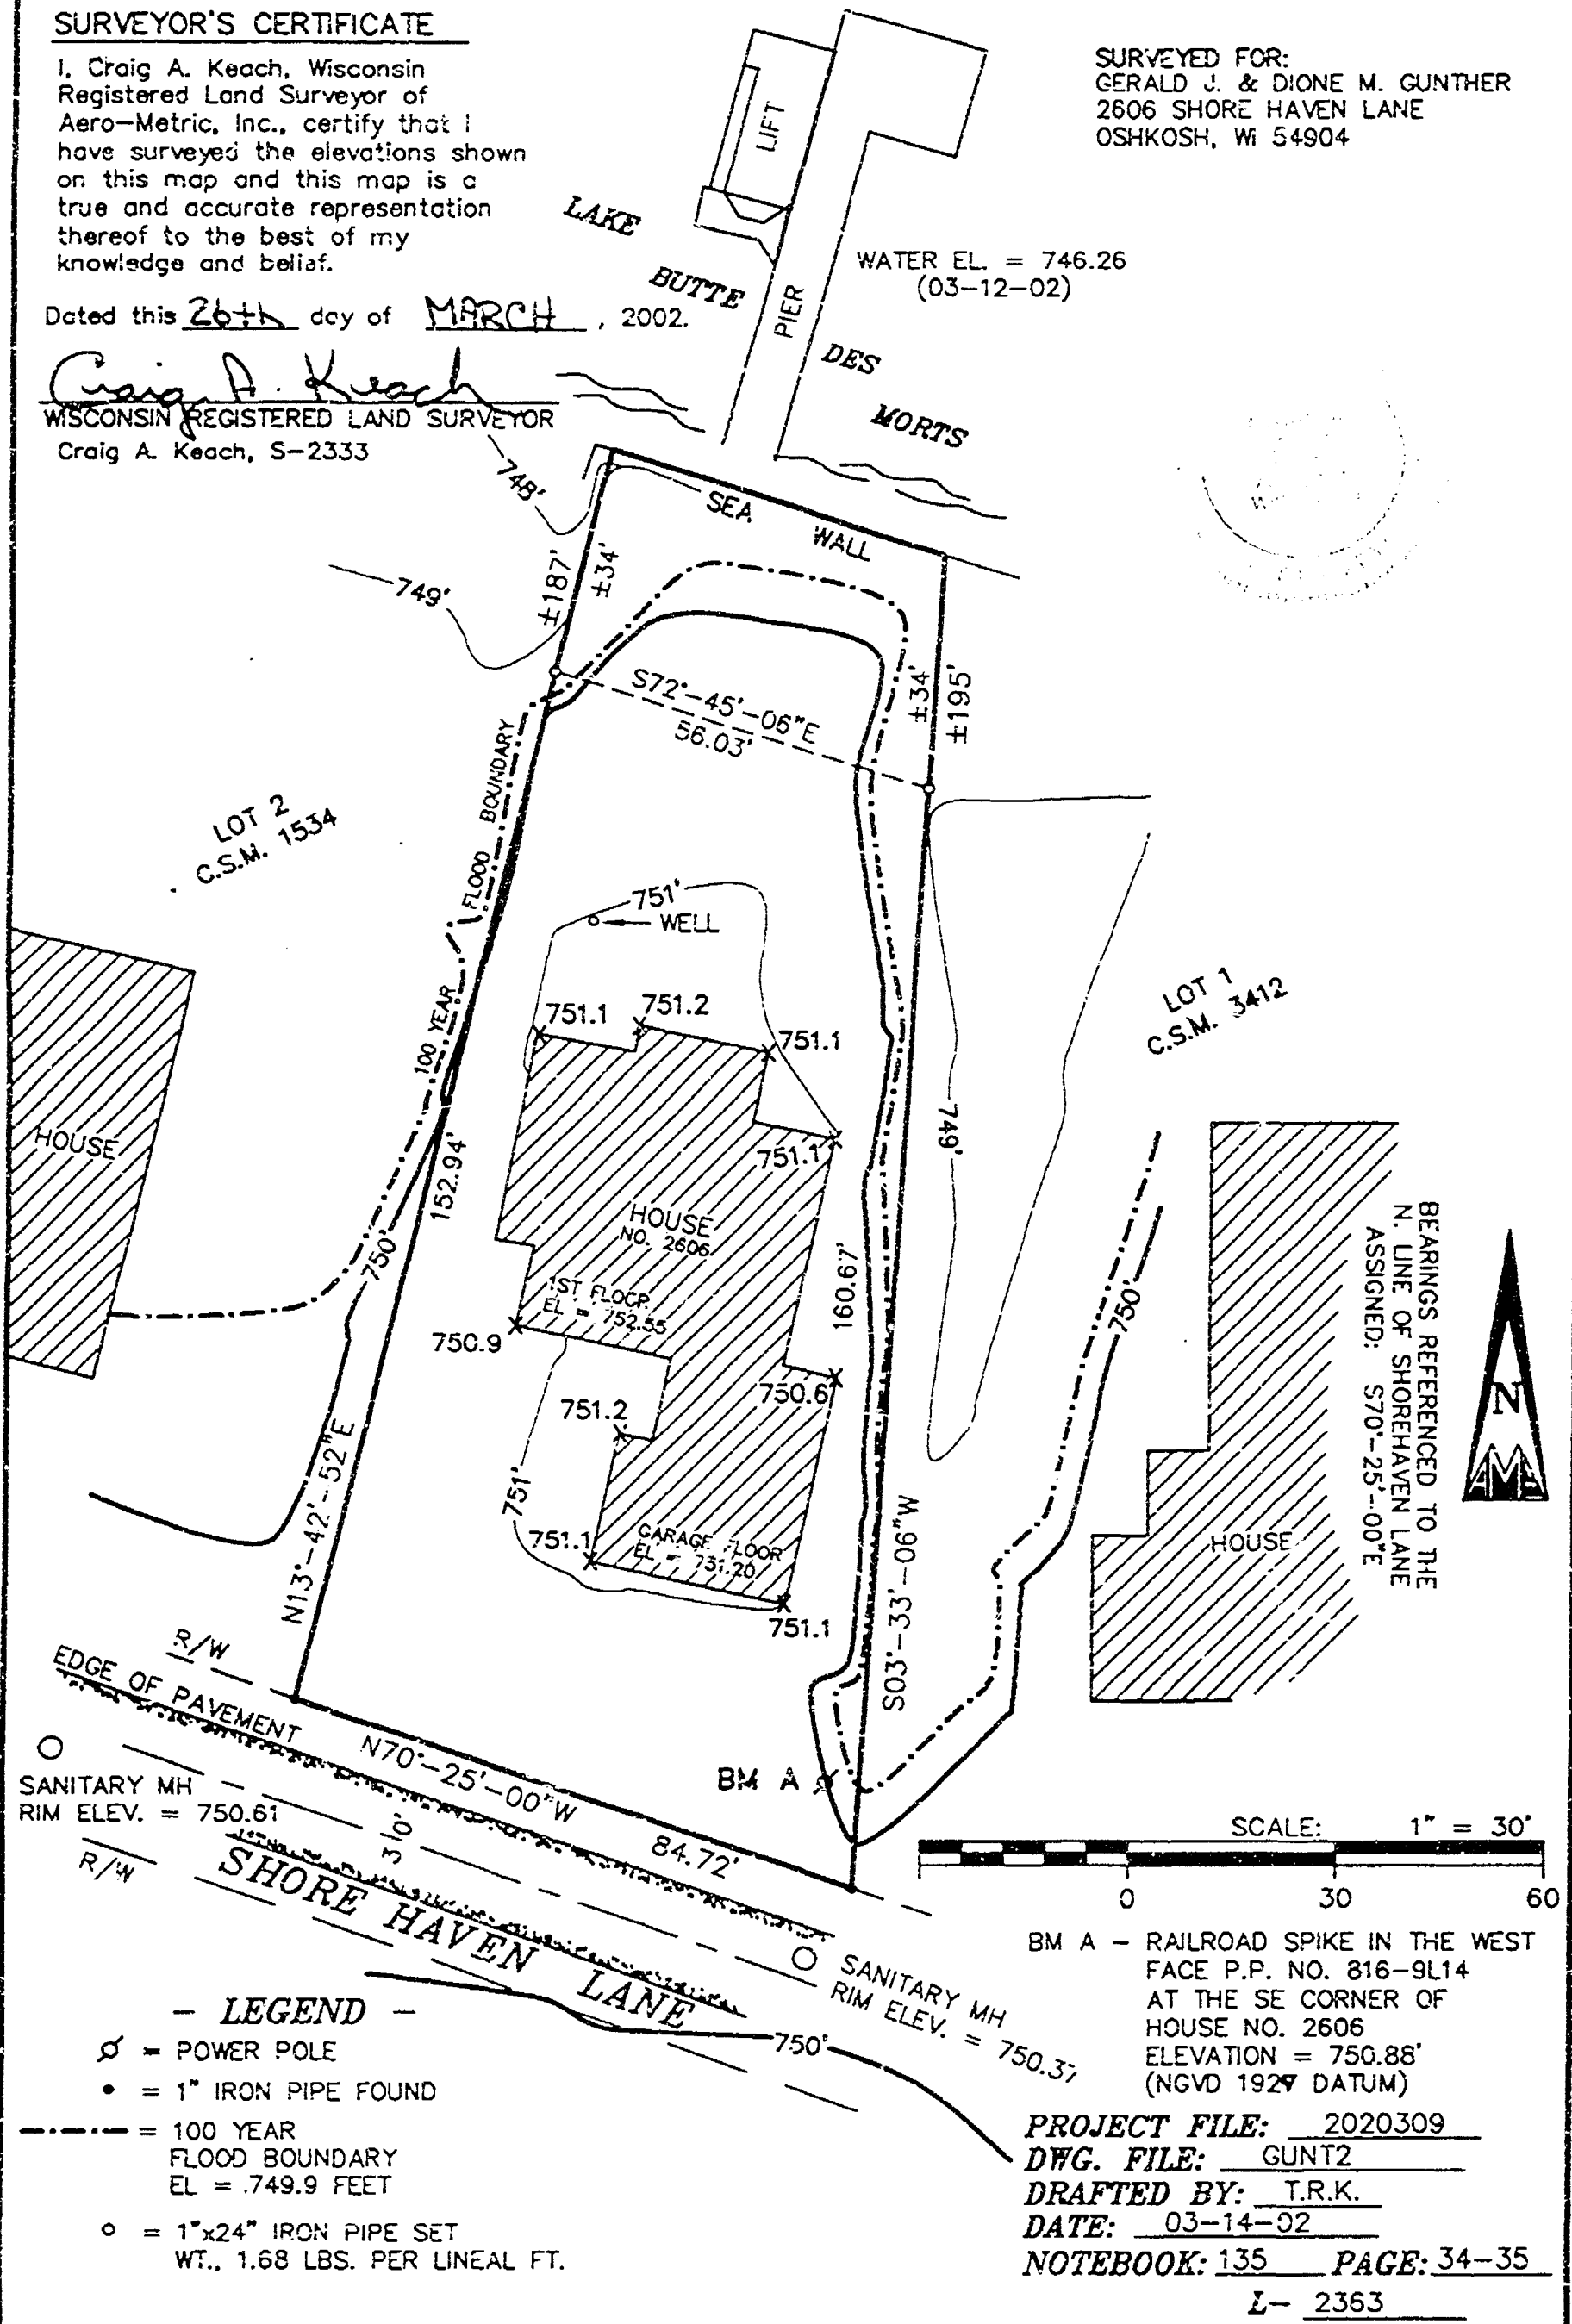

STATE OF WISCONSIN
WINNEBAGO COUNTY

CERTIFIED SURVEY MAP NO. 5003

OF
A PART OF GOVERNMENT LOTS 3 AND 4 OF FRACTIONAL
SECTION 9, T.18N., R.16E., TOWN OF ALGOMA
WINNEBAGO COUNTY, WISCONSIN

SURVEYED FOR
GERALD J. & DORIS M. GARDNER
7804 SHORE HAVEN LANE
OSHTOSI, WI 54904

WEATHER CROOKED TO
N1/4 CORNER
SECTION 9
T.18N., R.16E.

LEGEND

- 1" = 1' DIMENSION
- 1" = 1' DIMENSION
- 1" = 1' DIMENSION
- 1" = 1' DIMENSION

Cong. R. Krael
MARCH 26, 2002

SW CORNER
SECTION 9
T.18N., R.16E.
(PER MAP 1903)

AERO-METRIC

Aero-Metric, Incorporated

Land Planning & Design Division

800-678-7100 800-678-7101 FAX 800-678-7102

372 NORTH MAIN STREET ONEIDA, WISCONSIN 54901

PROJECT FILE 1000000000

DWG FILE 1000000000

DRAFTED BY 1000000000

DATE 03/14/02

NOTEBOOK 1000000000 PAGE 11/11

0001 1000000000 1-1000

STATE OF WISCONSIN) SS
WINNEBAGO COUNTY)

CERTIFIED SURVEY MAP NO. 5003

OF
A PART OF GOVERNMENT LOTS 3 AND 4 OF FRACTIONAL
SECTION 9, T.18N., R.16E., TOWN OF ALGOMA
WINNEBAGO COUNTY, WISCONSIN

SURVEYED FOR:
GERALD J. & DIONE M. GUNTHER
2606 SHORE HAVEN LANE
OSHKOSH, WI 54904

MEANDER CORNER TO
W1/4 CORNER
SECTION 9
T.18N., R.16E.

LEGEND

- = 1" IRON PIPE FOUND
- = 1"x24" IRON PIPE SET
WT., 1.68 LBS. PER LINEAL FT.
- ⊙ = COUNTY MONUMENT FOUND

WEST LINE SW1/4 SECTION 9

Craig A. Knech
MARCH 26, 2002

892.95'
N60°-01'-52"E


2389.36'

1496.41'

SW CORNER
SECTION 9
T.18N., R.16E.
(PK NAIL FND)

AERO-METRIC

Aero-Metric, Incorporated
Land Planning & Design Division
920-845-7708 800-472-5313 FAX (849-7709)
539 NORTH MADISON STREET CHILTON, WISCONSIN 53014

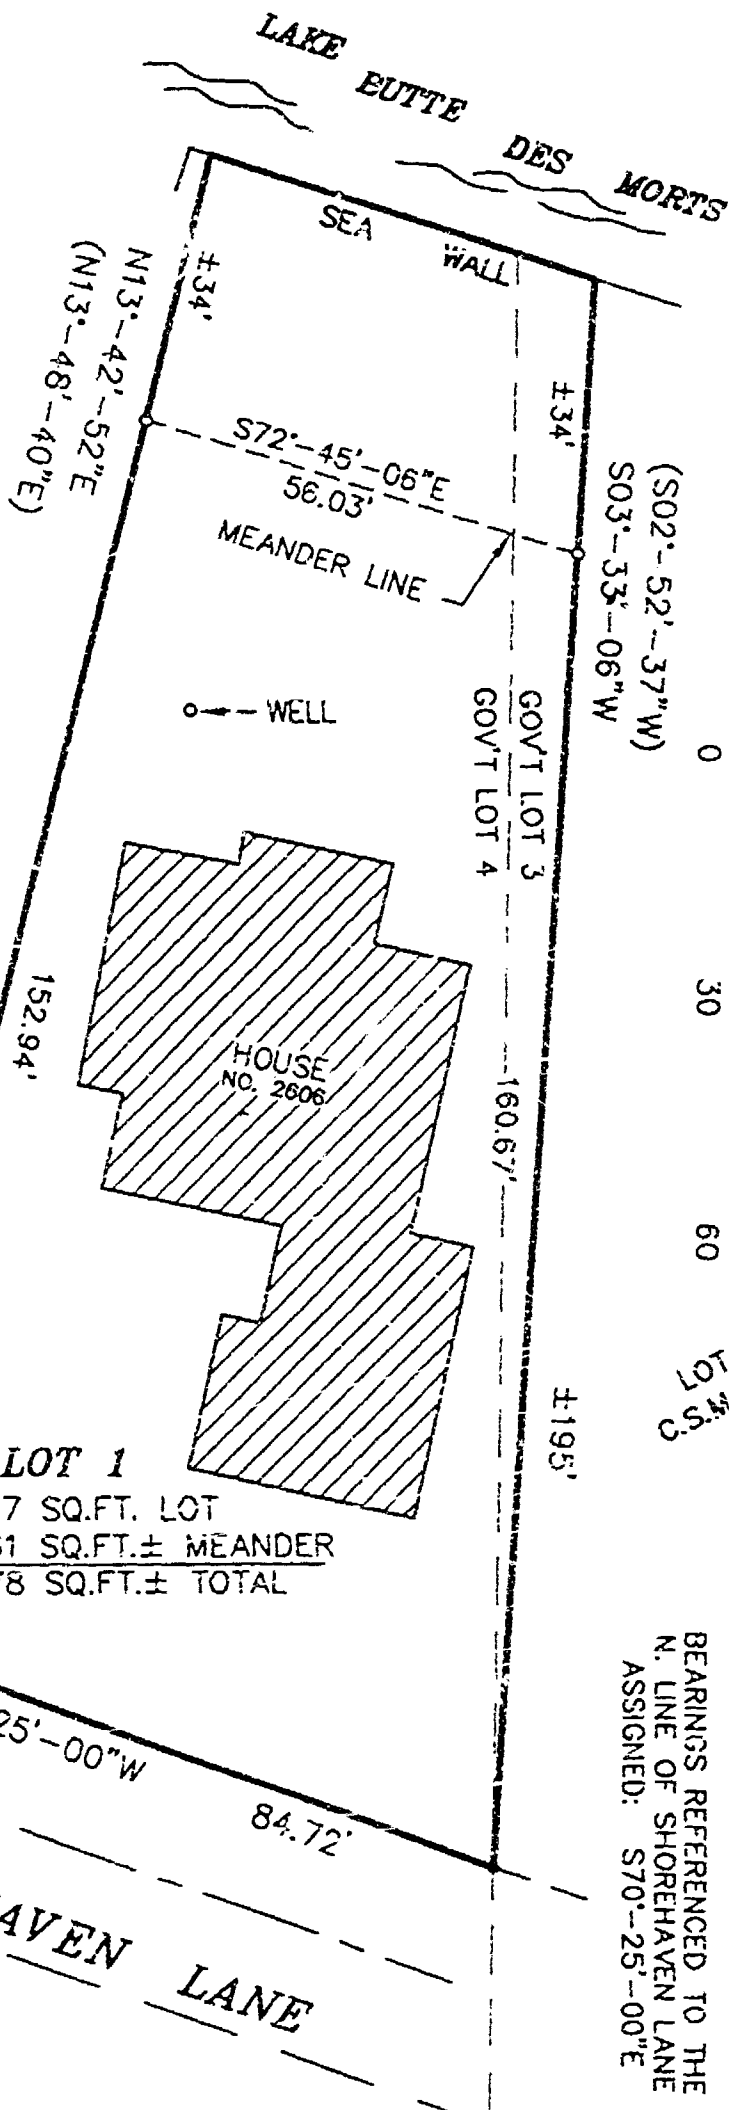

PROJECT FILE: 2020309
DWG. FILE: GUNT2
DRAFTED BY: T.R.K.
DATE: 03-14-02
NOTEBOOK: 135 PAGE: 34-35

SHEET 1 OF 3

L- 2364

STATE OF WISCONSIN) SS
WINNEBAGO COUNTY)

CERTIFIED SURVEY MAP NO. 5003

OF
A PART OF GOVERNMENT LOTS 3 AND 4 OF FRACTIONAL
SECTION 9, T.18N., R.16E., TOWN OF ALGOMA
WINNEBAGO COUNTY, WISCONSIN

SURVEYED FOR:
GERALD J. & DIONE M. GUNTHER
2606 SHORE HAVEN LANE
OSHKOSH, WI 54904

MEANDER CORNER TO
W1/4 CORNER
SECTION 9
T.18N., R.16E.

- LEGEND -

- = 1" IRON PIPE FOUND
- = 1"x24" IRON PIPE SET
WT., 1.68 LBS. PER LINEAL FT.
- ⊙ = COUNTY MONUMENT FOUND

WEST LINE SW1/4 SECTION 9

Craig A. Keach
MARCH 26, 2002


892.95'
N00°-01'-52"E
2389.36'
1496.41'

SW CORNER
SECTION 9
T.18N., R.16E.
(PK NAIL FND)

AERO-METRIC

Aero-Metric, Incorporated
Land Planning & Design Division

920-849-7708 800-472-5313 FAX (949-7709)
539 NORTH MADISON STREET CHILTON, WISCONSIN 53014

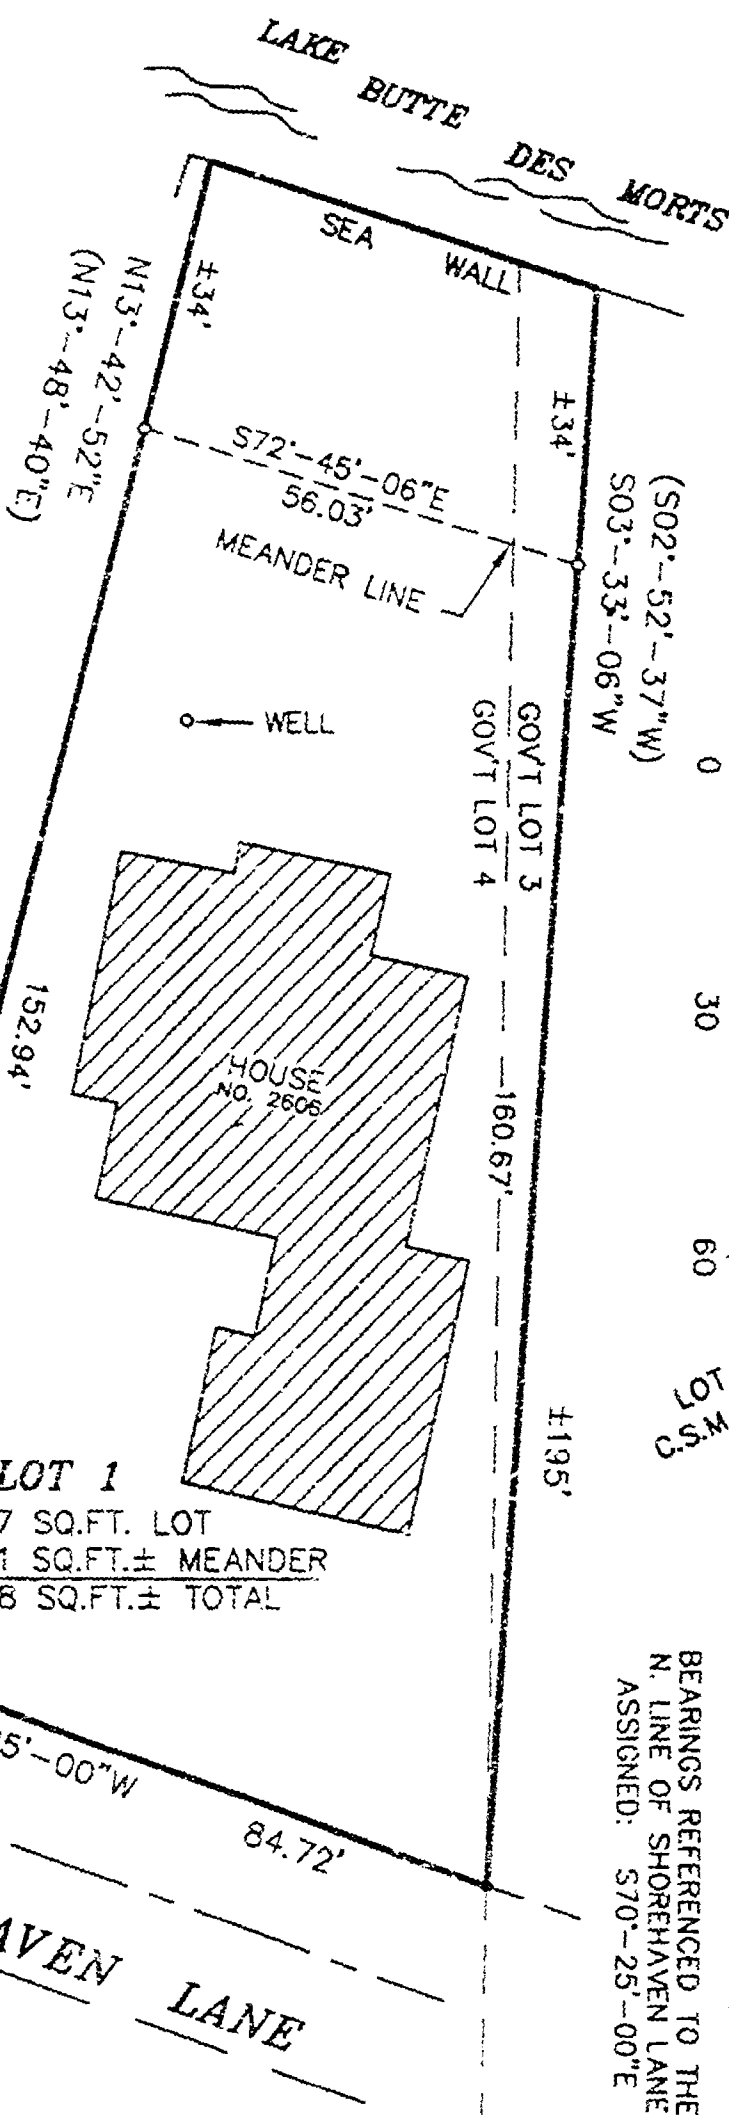

SCALE: 1" = 30'

BEARINGS REFERENCED TO THE
N. LINE OF SHOREHAVEN LANE
ASSIGNED: S70°-25'-00"E

PROJECT FILE: 2020309

DWG. FILE: GUNT2

DRAFTED BY: T.R.K.

DATE: 03-14-02

NOTEBOOK: 135 PAGE: 34-35

SHEET 1 OF 3

L- 2354

STATE OF WISCONSIN
WINNEBAGO COUNTY

CERTIFIED SURVEY MAP NO 5003

Sheet 2 of 3

SURVEYOR'S CERTIFICATE:

I, Craig A. Keach, Wisconsin Registered Land Surveyor of Aero Metric, Inc. certify that I have surveyed, divided and mapped under the direction of Gerald and Diane Gurdner a part of Government Lot Three (3) and Four (4), Fractional Section 16 (9), Township Englewood (18) North, Range Sixteen (16) East, Town of Algoma, Winnebago County, Wisconsin containing 12.578 square feet more or less of land and being described by

Commencing at the Southwest Corner of said Section 9, thence $1202^{\circ} 01' 52''$ E. 1426.41 feet along the West line of the SW 1/4 of said Section 9, thence $589^{\circ} 58' 08''$ E. 1785.93 feet to the Southeast Corner of Lot 2 of Certified Survey Map No. 1534 recorded as Document No. 853525 of Winnebago County Records, and the point of beginning, thence $113^{\circ} 47' 52''$ E. 157.94 feet (recorded as $113^{\circ} 48' 40''$ E. 153.00 feet) along the Easterly line of said Lot 2 to a point that is $013^{\circ} 47' 52''$ W. 34 feet more or less from the shore of Lake Butte Des Morts and the start of a meander line, thence $572^{\circ} 45' 05''$ E. 56.93 feet to a point that is $503^{\circ} 33' 00''$ W. 34 feet more or less from the shore of Lake Butte Des Morts and the termination of said meander line (said point also being on the West line of Lot 1 of Certified Survey Map No. 3412), thence $503^{\circ} 33' 00''$ W. (recorded as $502^{\circ} 52' 37''$ W.) 160.67 feet along said West line to a point on the Northerly line of Shore Haven Lane, thence $170^{\circ} 25' 00''$ W. 64.72 feet along said Northerly line to the point of beginning, being subject to any and all easements and restrictions of record.

That such is a correct representation of all exterior boundaries of the land surveyed.

That I have fully complied with the provisions of Chapter 236.34 of the Wisconsin Statutes and the Land Subdivision Ordinance of Winnebago County and the Town of Algoma in surveying and mapping the same.

Dated this 26th day of MARCH 2002

Craig A. Keach
Wisconsin Registered Land Surveyor, S-2333
Craig A. Keach

This Certified Survey Map is all of Tax Parcel No.'s 002-0051-02 and 002-0051-04.

The property owners of record are Gerald J. and Diane M. Gurdner.

This Certified Survey Map is contained wholly within the property described in the following recorded instruments: written deed as Document No. 852635 and 852636.

OWNER'S CERTIFICATE:

As owner, I hereby certify that I caused the land described on the Certified Survey Map to be surveyed, divided, mapped and dedicated as represented on this map.

Dated this 16 day of MAY 2002

In the presence of

John Thompson
John Thompson

Gerald J. Gurdner
Gerald J. Gurdner
Diane M. Gurdner
Diane M. Gurdner

STATE OF WISCONSIN
WINNEBAGO COUNTY

Personally came before me this 16 day of May, 2002, Gerald J. and Diane M. Gurdner and to me known to be the persons who executed the foregoing instrument and acknowledged the same.

Notary Public in and for Wisconsin
My Commission Expires 11-1-05

L-2384

(STATE OF WISCONSIN) 58
(WINNEBAGO COUNTY)

CERTIFIED SURVEY MAP NO. 5003

Sheet 3 of 3


A part of Government Lots 3 and 4 of Fractional Section 9, T. 16N. R. 16E. Town of Algoma, Winnebago County, Wisconsin.

WINNEBAGO COUNTY PLANNING & ZONING COMMITTEE:

This Certified Survey Map a part of Government Lots 3 and 4 of Fractional Section 9, Town of Algoma, Winnebago County, Wisconsin (Lots 3 and 4) and Deane M. Gunther, owners is hereby approved

May 20, 2002

Date

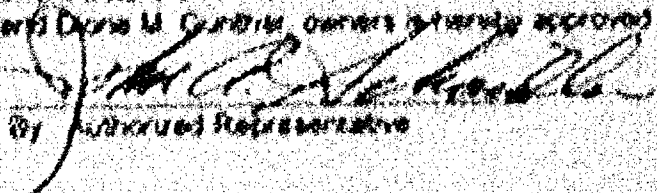By  authorized representative

COUNTY TREASURER'S CERTIFICATE:

I, being the duly elected, qualified and acting Treasurer of the County of Winnebago, do hereby certify that the records in my office show no unredeemed tax sales and no unpaid taxes or special assessments as of May 16, 2002 affecting the lands included in this Certified Survey Map

5/16/02

Date


County Treasurer

CERTIFICATE OF TOWN TREASURER:

I, being the duly elected, qualified and acting Town Treasurer of the Town of Algoma, do hereby certify that in accordance with the records in my office show no unpaid taxes or special assessments as of May 16, 2002 affecting the lands included in this Certified survey Map

5/16/02

Date


Town Treasurer

TOWN BOARD CERTIFICATE:

This Certified Survey Map has been reviewed and approved by the Town Board of the Town of Algoma

5-16-02

Date



Town Board Representative

CITY OF OSHKOSH PLANNING COMMISSION CERTIFICATE:

This Certified Survey Map of a part of Government Lots 3 and 4 of Fractional Section 9, T. 16N. R. 16E. Town of Algoma, Winnebago County, Wisconsin (Lots 3 and 4) and Deane M. Gunther, owners is hereby approved


5/16/02

Date

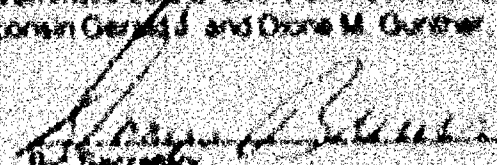
By Secretary

Dated this 26th day of MARCH 2002


Wisconsin Registered Land Surveyor, # 2333
Craig A. Kesch

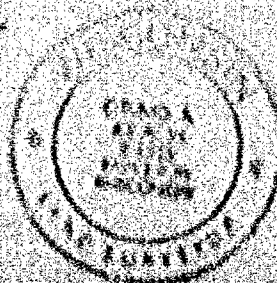

1-2354

1183182

REGISTER'S OFFICE
WINNEBAGO COUNTY, WI
RECORDED ON

05-21-2002 03:39 PM

15-1 P.5003
SUSAN WINNINGHOFF
REGISTER OF DEEDS

RECORDING FEE 17.00
TRANSFER FEE
OF PAGES 4

pd.

FLOOD PLAIN SURVEY

KNOWN AS 2708 SHOREHAVEN LANE, LOT 1 IN CERTIFIED SURVEY MAP NO. 3002 IN PART OF
TRACT MAP LOT 1 IN SECTION 8, T10N, R10E, TOWN OF ALGONA, WINNEBAGO COUNTY, WISCONSIN

JULY 18, 2003

FLOOD PLAIN MAP FOR DAM NUMBER

NO. 6081

100 YEAR FLOOD ELEVATION BASED ON U.S.G.S. DATUM


NOTE: 100 YEAR FLOOD ELEVATION FOR THIS
AREA IS 142.8 BASED ON U.S.G.S. DATUM

LAKE BUTTE DES MONTER

WATER ELEVATION 111.1



7-19-03

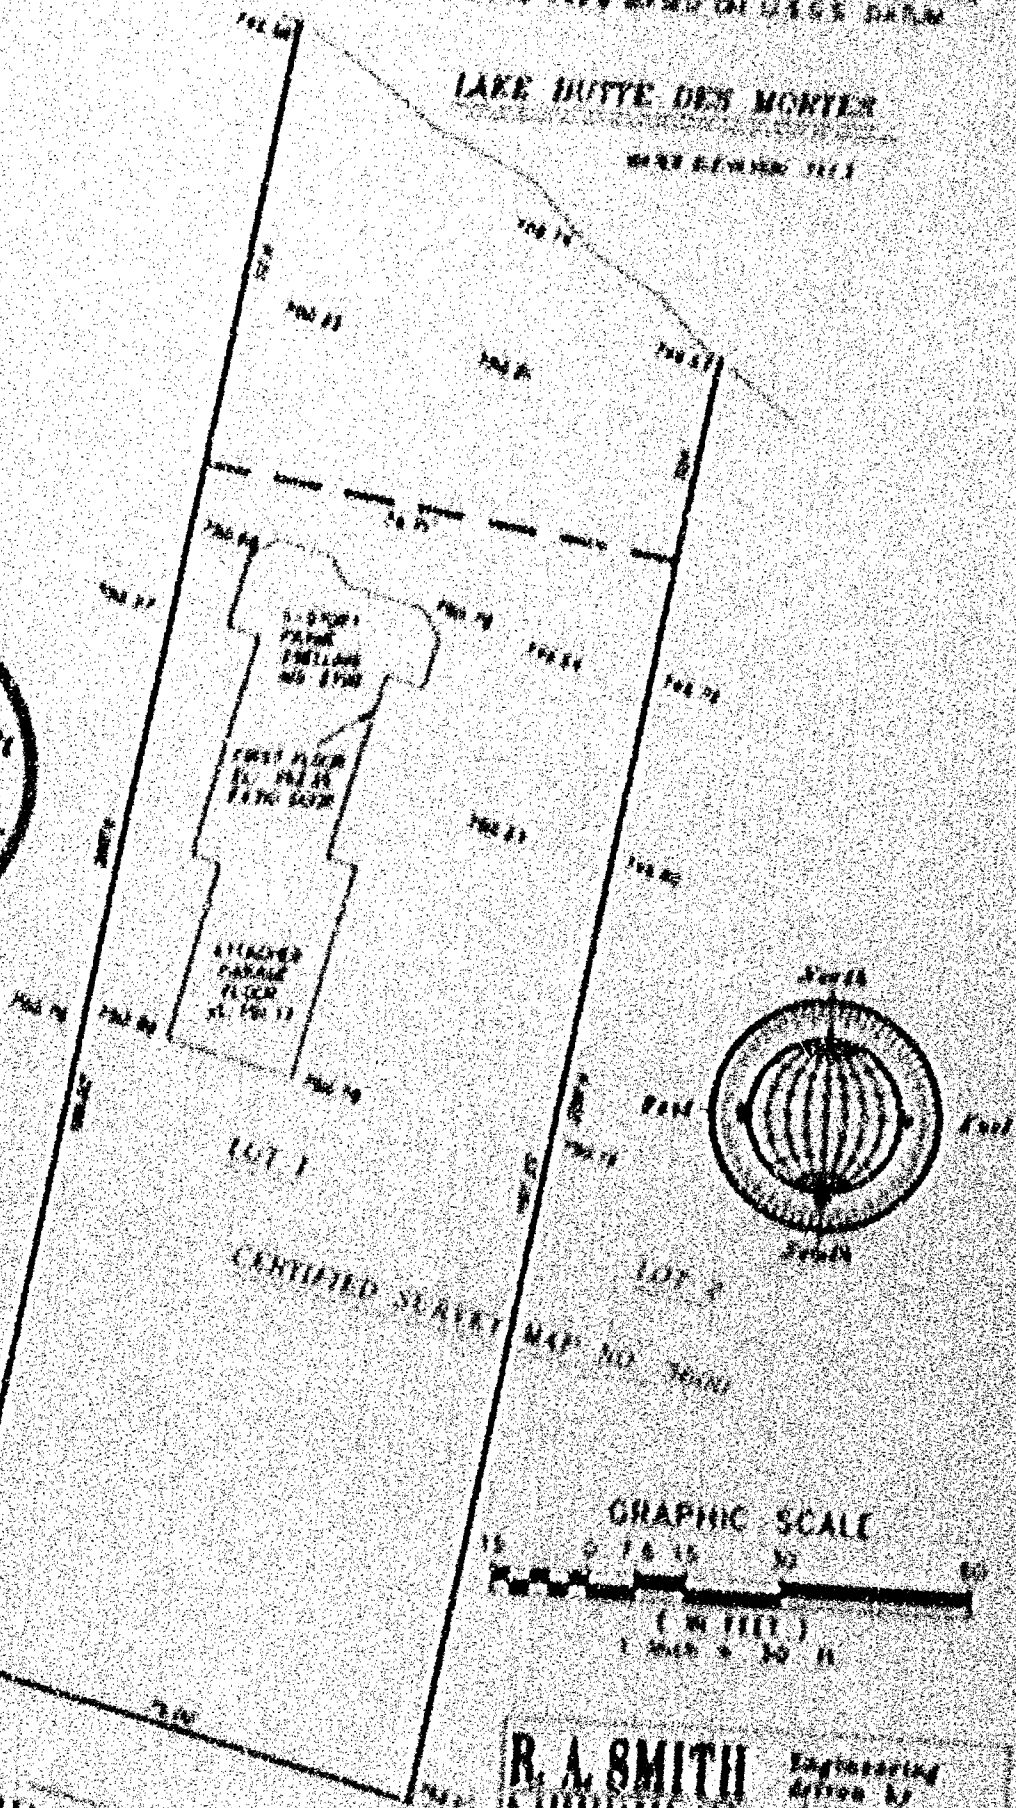

RECORD MAP, ALGONA, WISCONSIN
A. R. SMITH, ENGINEER
VOLUME 10, PAGE 11

SHOREHAVEN LANE

R. A. SMITH Engineering
FLOOD PLAIN
100 YEAR FLOOD ELEVATION
142.8
U.S.G.S. DATUM
JULY 18, 2003

FLOOD PLAIN SURVEY

KNOWN AS 2708 SHOREHAVEN LANE. LOT 1 IN CERTIFIED SURVEY MAP NO. 3600 IN PART OF FRACTIONAL LOT 4 IN SECTION 9, T18N, R16E, TOWN OF ALGOMA, WINNEBAGO COUNTY, WISCONSIN.

JULY 15, 2003

FLOOD PLAIN SURVEY FOR DAVID HANSEN

NO. 4091


747.30 DENOTES EXISTING ELEVATION BASED ON U.S.G.S. DATUM.

NOTE: 100 YEAR FLOOD ELEVATION FOR THIS AREA IS 749.8 BASED ON U.S.G.S. DATUM.

THE BUILDING AND ITS RELATIONSHIPS TO THE PROPER LINES AND SHORELINE AS SHOWN ARE APPROXIMATE.

LAKE BUTTE DES MORTES

WATER ELEVATION: 747.3

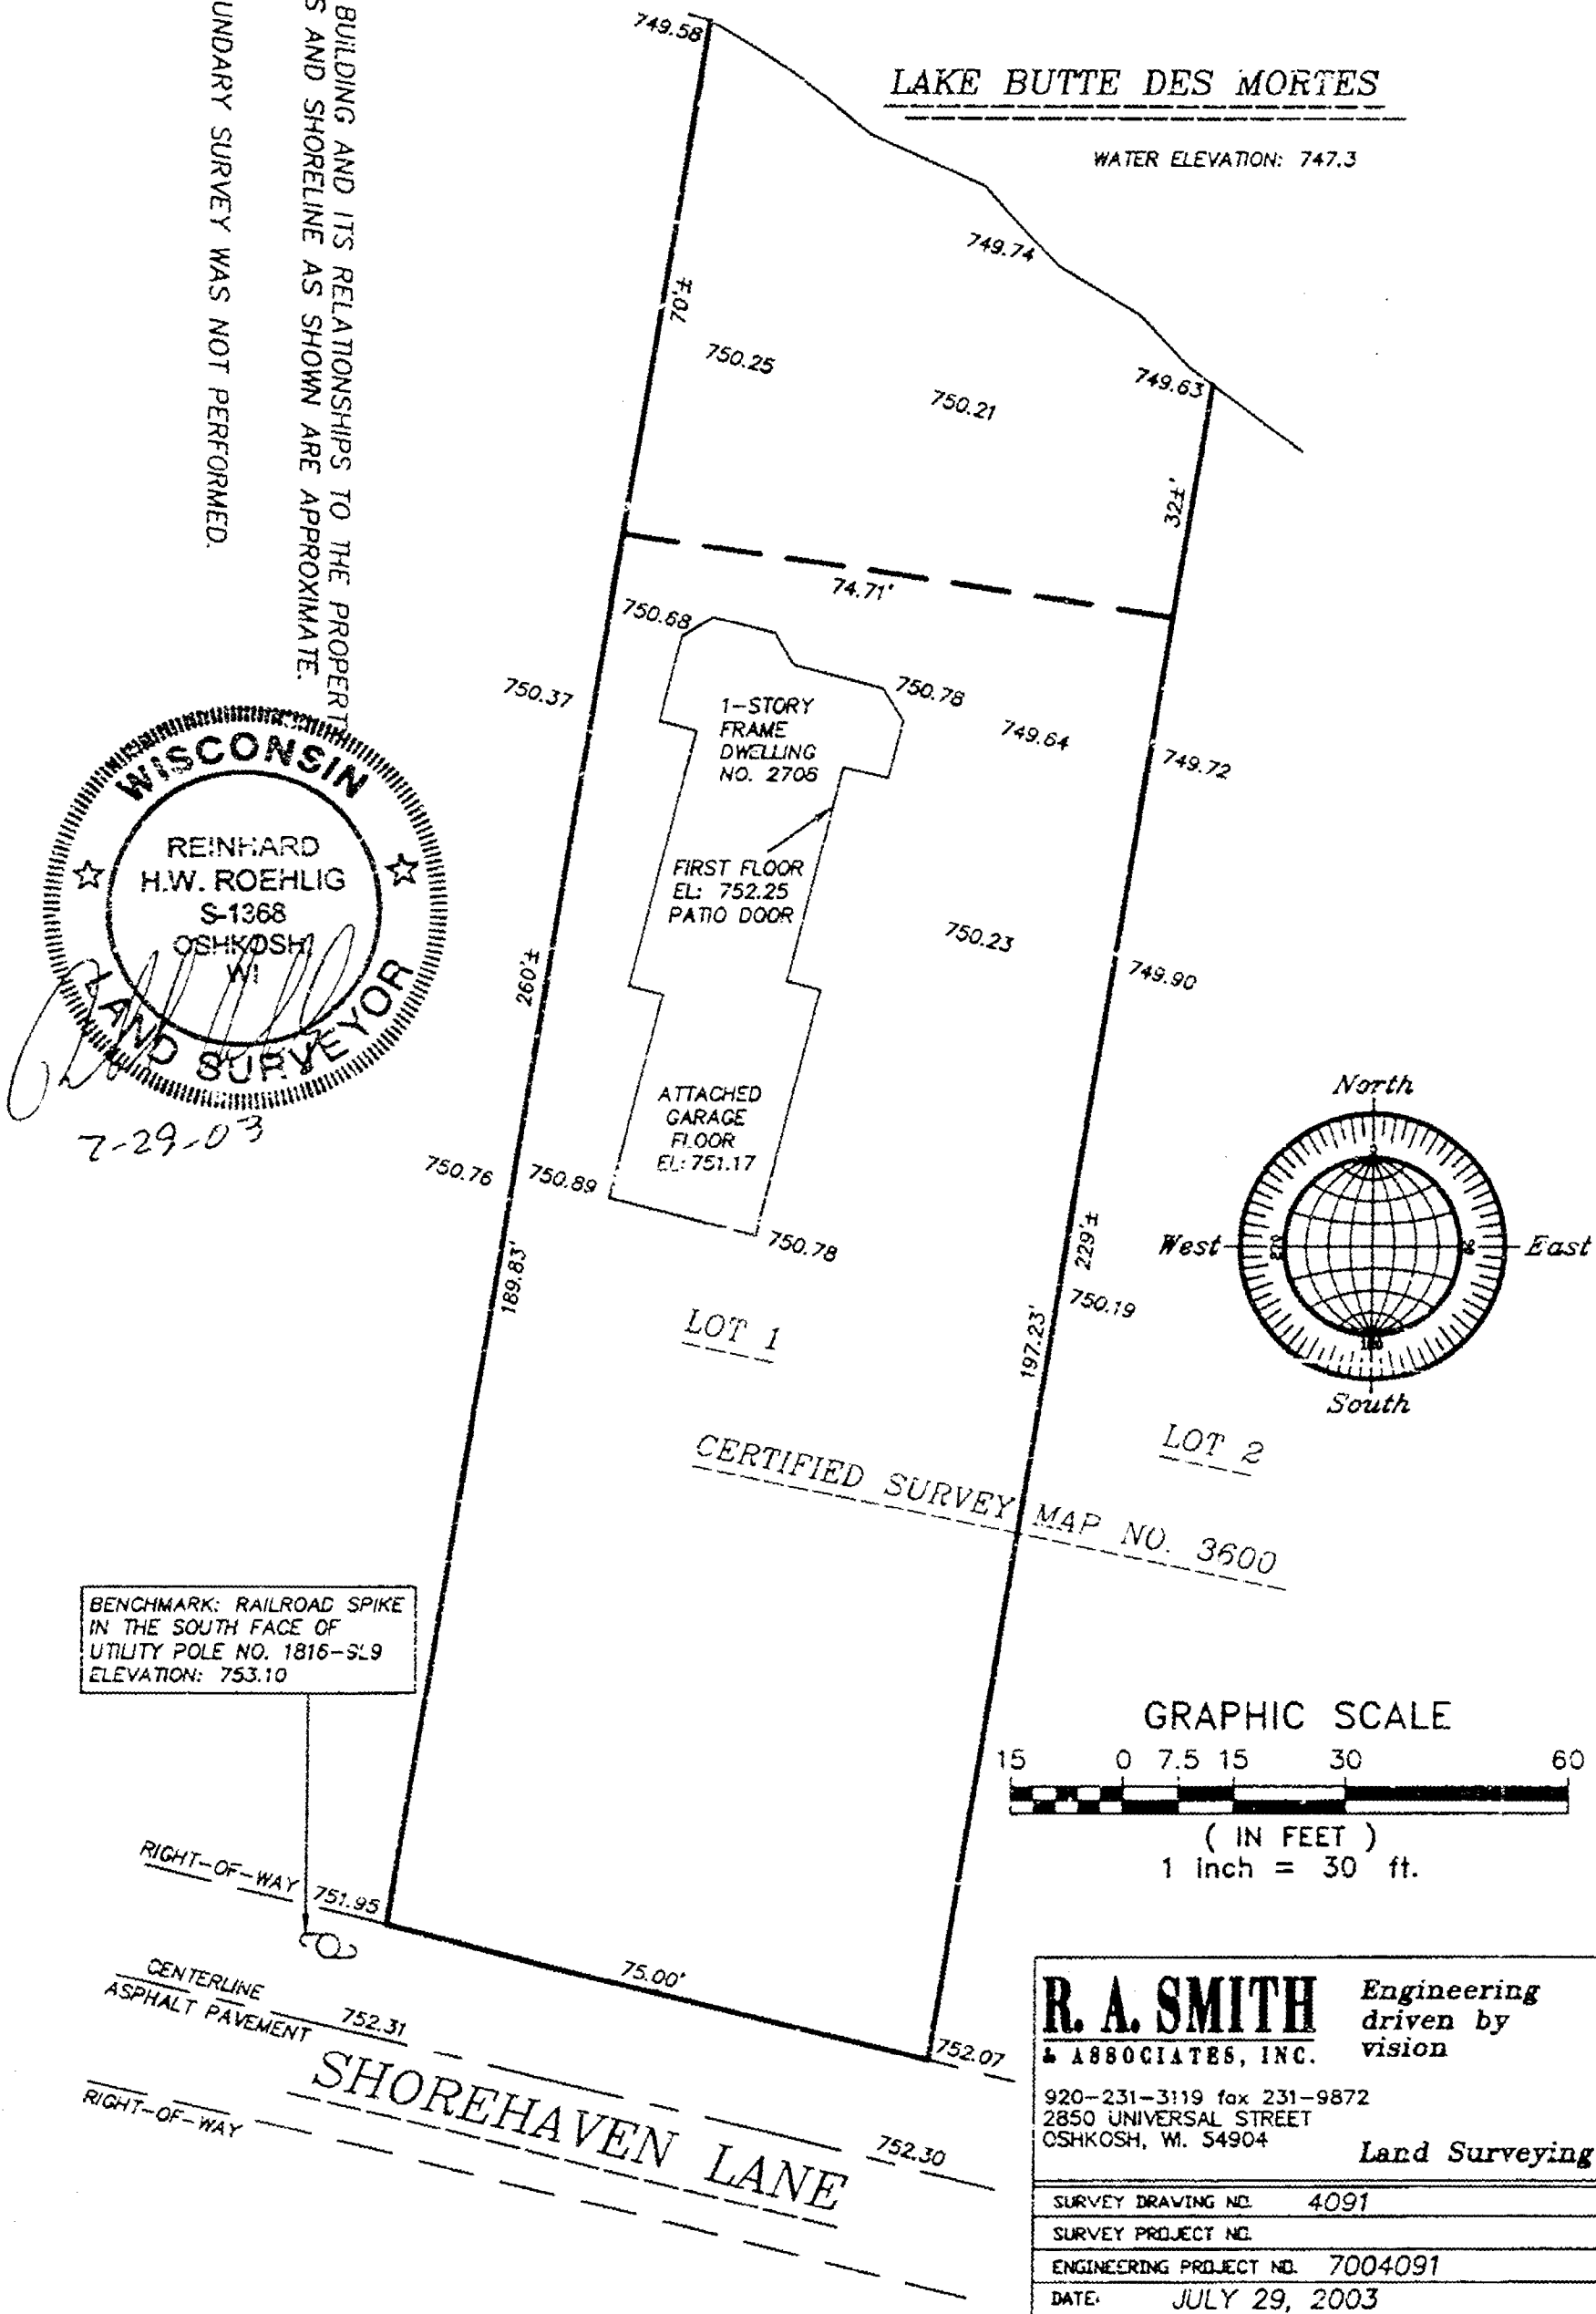

FLOOD PLAIN SURVEY

KNOWN AS 2708 SHOREHAVEN LANE. LOT 1 IN CERTIFIED SURVEY MAP NO. 3600 IN PART OF FRACTIONAL LOT 4 IN SECTION 9, T18N, R16E, TOWN OF ALGOMA, WINNEBAGO COUNTY, WISCONSIN.

JULY 15, 2003


FLOOD PLAIN SURVEY FOR DAVID HANSEN

NO. 4091

747.30 DENOTES EXISTING ELEVATION BASED ON U.S.G.S. DATUM.


NOTE: 100 YEAR FLOOD ELEVATION FOR THIS AREA IS 749.8 BASED ON U.S.G.S. DATUM.

THE BUILDING AND ITS RELATIONSHIPS TO THE PROPERTY LINES AND SHORELINE AS SHOWN ARE APPROXIMATE.
A BOUNDARY SURVEY WAS NOT PERFORMED.

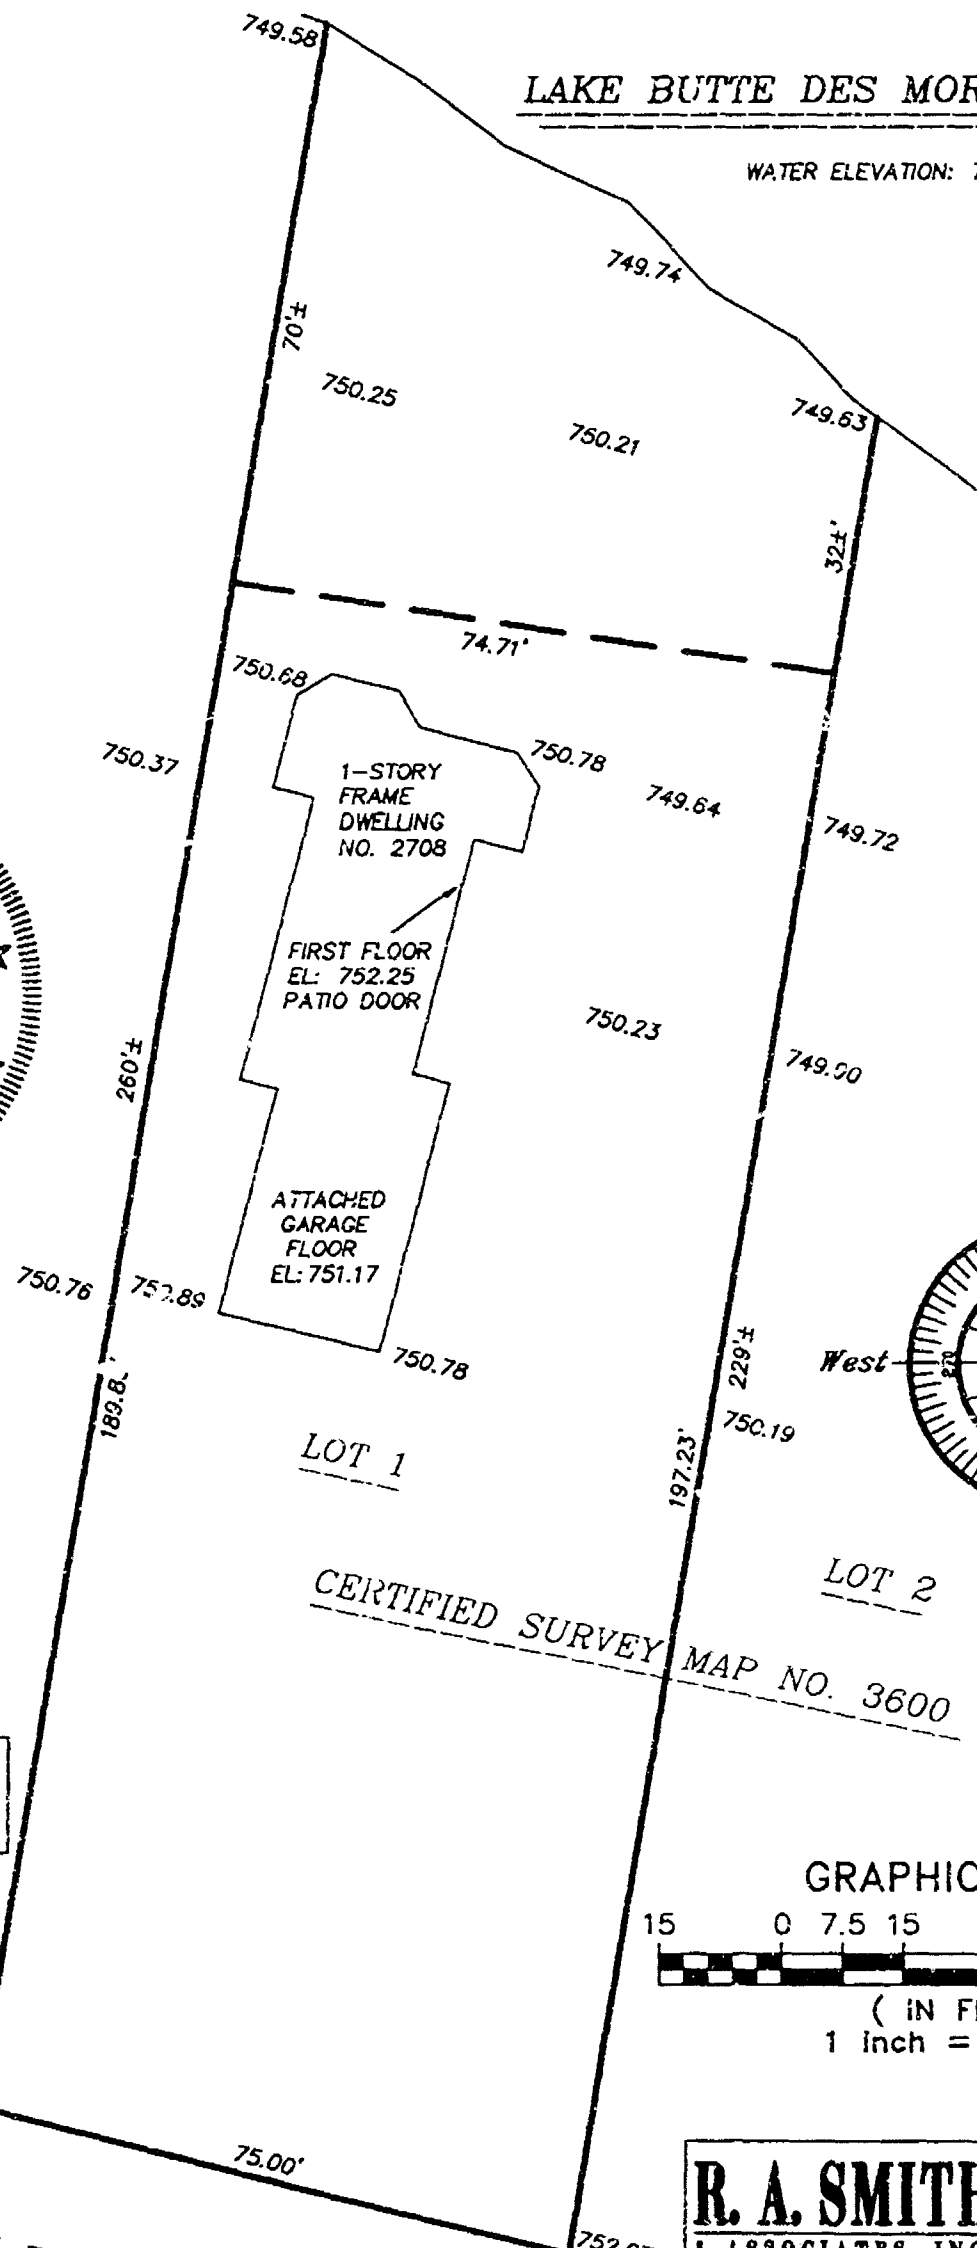

LAKE BUTTE DES MORTES

WATER ELEVATION: 747.3

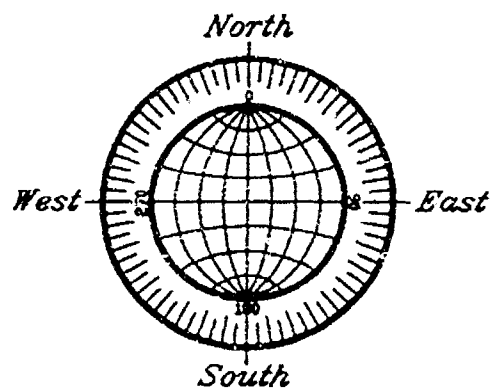

BENCHMARK: RAILROAD SPIKE IN THE SOUTH FACE OF UTILITY POLE NO. 1816-9L9 ELEVATION: 753.10

GRAPHIC SCALE



(IN FEET)

1 inch = 30 ft.

CENTERLINE ASPHALT PAVEMENT

SHOREHAVEN LANE

R. A. SMITH

Engineering driven by vision

& ASSOCIATES, INC.

920-231-3119 fax 231-9872
2850 UNIVERSAL STREET
OSHKOSH, WI. 54904

Land Surveying

SURVEY DRAWING NO.	4091
SURVEY PROJECT NO.	
ENGINEERING PROJECT NO.	7004091
DATE	JULY 29, 2003

1183182

REGISTER'S OFFICE
WINNEBAGO COUNTY, WI
RECORDED ON

05-21-2002 03:39 PM

UD-1 P.5003
SUSAN WINNINGHOFF
REGISTER OF DEEDS

RECORDING FEE 17.00
TRANSFER FEE
OF PAGES 4

pd.

MAY 26, 1995

TO: Drainage Inspector/Cartographer/Zoning Secretary

FM: Zoning Administrator

RE: Wetland Determination Map Updates

Rick/Diane/Lisa:

Please update the GIS for the following DNR wetland determinations:

1. SW SW Section 09, T 18N, R 16E, Town of ALGOMA

Diane: Update wetland layer to add/delete as appropriate. Tag each revised area with "revised by DNR interp. - use revision date on wetland paper map in red" After updating, determine the parcels affected by the wetland determination and attach a list of parcel numbers affected so that file 13 can be updated.

Lisa: Update File 13, file and microfiche DNR letter in each affected parcel.

Rick: File revised map with other maps

Maps filed 7/20/95 by Rick Hoefst

GIS Updated 5-26-95 by D. CULVER

File 13 Updated no parcels to by _____
be updated - D. CULVER

Verified by Zoning administrator R. J. H.

RECEIVED

Winnebago Co ZA

MAY 26 1985

FOR DNR USE ONLY
File copy changed
Base map changed

WINNEBAGO COUNTY PLANNING DEPT.

COMMENT SHEET FOR PUBLIC REVIEW OF WETLAND MAPS

Name of person commenting Tere Lecko
Mailing Address 905 Bayshore Drive Oshkosh
Phone number where you can be contacted during the day 414-424-4003
Municipality where wetland is located Town of Algoma, Winnebago

Maps prepared under the
auspices of:
Wisconsin Wetlands Inventory
DNR, WZ/6
P.O. Box 7921
Madison, WI 53707

DIRECTIONS: We need all of the location information below and your signature at the bottom of the reverse side before your comment can be considered. Fill out a separate sheet for each mapped wetland you think has an error, or for an omitted wetland.

Location of wetland T 18 R 16 section number 2 subscript(s) 11 (use subscript codes shown below)
section number 2 subscript(s) 11

Sample

Subscript Codes

Township 23R Range 2E

Enlargement of
Section 24

6	5	4	3	2	1
7	8	9	10	11	12
18	17	16	15	14	13
19	20	21	22	23	24
30	29	28	27	26	25
31	32	33	34	35	36

6	5	2	1
7	8	3	4
10	9	14	13
11	12	13	16

1 = NE 1/4 of the NE 1/4
2 = NW 1/4 of the NE 1/4
3 = SW 1/4 of the NE 1/4
4 = SE 1/4 of the NE 1/4
5 = NE 1/4 of the NW 1/4
6 = NW 1/4 of the NW 1/4
7 = SW 1/4 of the NW 1/4
8 = SE 1/4 of the NW 1/4
9 = NE 1/4 of the SW 1/4
10 = NW 1/4 of the SW 1/4
11 = SW 1/4 of the SW 1/4
12 = SE 1/4 of the SW 1/4
13 = NE 1/4 of the SE 1/4
14 = NW 1/4 of the SE 1/4
15 = SW 1/4 of the SE 1/4
16 = SE 1/4 of the SE 1/4

ANSWER ONLY THOSE SECTIONS WHICH APPLY:

SECTION 1: All or Part of a Mapped Wetland is NOT a Wetland.

USING A COLORED PEN OR PENCIL, DRAW THE AROUND THE AREA YOU THINK IS NOT WETLAND, AND WRITE YOUR INITIALS INSIDE IT. IF YOU THINK ONLY PART OF THE AREA IS NOT WETLAND, CIRCLE ONLY THAT PART.

- a. What is the classification code shown on the map? (e.g. E1K, T3K, SL) T3K
b. The wetlands were mapped using 1978-80 air photos. Check any changes which have been made to this area since 1978-80.

Installed new tile drains. Year _____
Closed out existing ditch. Year _____
No changes made since 1978-80.

Dug new ditch. Year _____
Area was filled in. Year _____

Other. Explain Drainage Area to Soil
no more cultural

- c. DESCRIBE AS COMPLETELY AS YOU CAN the land use of this area in the last 7 years. Include the type of vegetation present, cropping history, logging, filling, dredging, land clearing, grazing, etc.

A portion of the area mapped T3K is no longer wetland. Residential development to south of property has added drainage to east. High road & water system in T3K area.

Area to north of wetland is ag field, no longer used. Wetland has cattails, sedges, callows, Canadian blue stem, red osier dogwood. Tile was taken for sewer installation in 1978.

SECTION 2. Wetland Classification Code is Inaccurate

USING A COLORED PEN OR PENCIL, CIRCLE THE INACCURATE CLASSIFICATION AND WRITE YOUR INITIALS NEXT TO IT.

- What is the classification code shown on the map? (example: E1K1, S3K, ~~X~~)
- Describe the vegetation and land use of the area.

SECTION 3. Wetland Not Shown on the Map

USING A COLORED PEN OR PENCIL, DRAW THE WETLAND ON THE PRELIMINARY MAP WHERE YOU THINK IT SHOULD GO, AND WRITE YOUR INITIALS NEXT TO IT.

- Describe the vegetation and land use of the wetland:

Was an ag field - sedge, cattail, grass

I hereby certify that to the best of my knowledge the above answers are true and just.

Tim J. Locke
SIGNATURE OF PERSON COMMENTING

3/4/95
DATE

Thank you for taking the time to provide us with this information. If you have questions, contact your municipal zoning officer. PLEASE RETURN THIS COMMENT SHEET TO THE OFFICE OF YOUR CITY OR VILLAGE CLERK.

For DNR Use, Please do Not Write Below This Line

Brief Description of the area in question (vegetation, wetland classification, ditches, etc.) as it appears on the aerial photo, and how the map should be changed.

LL Comment Reviewed by

05-16-95 Date Reviewed

5-30-86 Air Photo Date

T3 wetland will be shaded (M) to denote wetland

E1K1 added to map - reverted back to wetland

S3 E1K1 added to map in wetland very small E1K1 wetland

YES NO AVAILABLE

Marsh symbols on 7 1/2" USGS topographic map? Map name(s) *Oshkosh Quad*

Detailed soil survey available? (Drainage classes) of soils in wetlands:
very poorly ☒ poorly ☒ somewhat poorly ☒ moderately well ☒ excessively well

Name of soil series: *Moravian silt, Payson silt*

Sweep or Marsh on Border Survey?

Field Checked

By: *DNR - T. Locke*

Date: *5/95*

Shown as Wetland-Other Source

Name of Source: *1958 Wetland Inventory*

CONTACT DATE	FORM OF CONTACT	PERSON CONTACTED	DNR STAFF

FIELD CHECK DOCUMENTATION

- Change Made to Map as Requested
 - Requested by general public
 - Requested by DNR personnel

- Partial Change Made to Map
 - Wetland boundary changed
 - Classification changed

- Comment Cannot Be Processed
 - Insufficient information provided
 - Map was apparently misinterpreted
 - Comment does not pertain to map accuracy

- Correctly Mapped for Conditions
 - Classification of wetland has changed; no change made to reviewed map. Comment filed for future update of inventory.
 - Area is a wetland according to No. of the operational definition.
 - Area does not meet definition of wetland.

- Land altered since date of photography; area no longer wetland; field verified.