


29-18-16

SURVEY INDEX, WINNEBAGO COUNTY, WISCONSIN

SURVEYED FOR	SURVEYOR	R.L.S. NO.	DATE	CERTIFIED SURVEYS			NO.	SURVEY LOCATION
				MAP NO	VOL	PAGE		
	Stearns	7-25-64	Homestead Ass. Plat					NE 1/4
H. Gunning	Carow	4-31-70						NE - NW
H. Enger	Reider	1-22-80						
H. Gunning	Carow	1-31-70						NE - NW
Willet & Co	Carow	4-21-70						NE - NW
H. Gunning	Reider	7-18-79						NE - NW
H. Kall	Rohlig	3-7-79		530743	1	540		SW - NW
H. Gunning	Reider	11-29-78		526936	1	492		NE - NW
Michael	Hawkes	5-26-78		517814	1	356		SW - SW
Michael	Hawkes	5-26-78		517813	1	355		SW - SW
J. Thordt	Rohlig	2-17-81						SE - NE
H. Gunning	Reider	11-4-81						NE - NW

SECTION 29 TOWNSHIP 18 RANGE 16

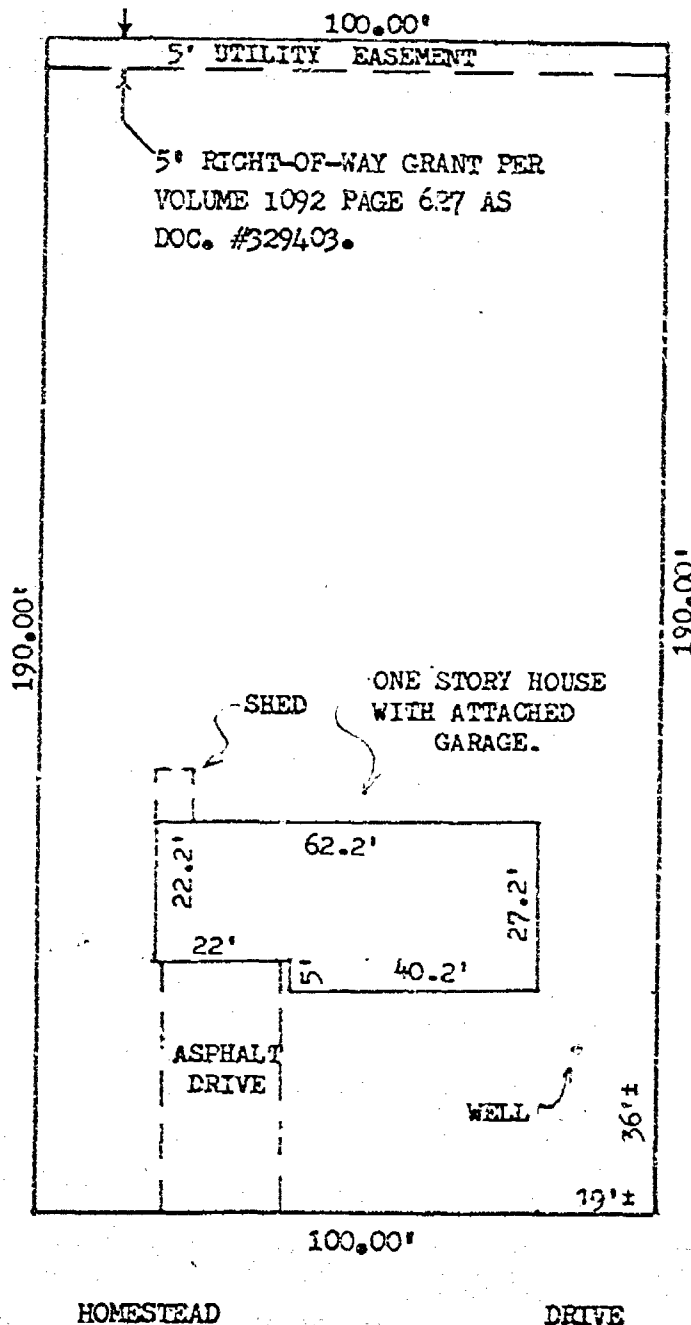

That part of the North East 1/4 of the NORTH EAST 1/4 of Section Twenty-nine (29) Township Eighteen (18) North, of Range Sixteen (16) East, in the Town of Algoma, Winnebago County, Wisconsin, described as follows, viz:-

Commencing at the Northeast corner of said North East 1/4; thence south, along the East line of said Section, One Hundred Sixty-five and Zero-tenths (165.0) feet; thence north Ninety (90) degrees west, Five Hundred Seventy-five and Zero-tenths (575.0) feet, the place of beginning; thence continuing north Ninety (90) degrees west, One Hundred and Zero-tenths (100.0) feet; thence due south, One Hundred Ninety and Zero-tenths (190.0) feet; thence south Ninety (90) degrees east, One Hundred and Zero-tenths (100.0) feet; thence due north, One Hundred Ninety and Zero-tenths (190.0) feet, to the place of beginning.

—ALICE KURZYNSKE—


2878 HOMESTEAD DRIVE

NO BUILDING ENCROACHMENTS PRESENT

NOTE: PROPERTY SUBJECT TO A WELL AGREEMENT
AS RECORDED ON VOLUME 1188 ON PAGE 119
AS DOC. #363527.

I, ROBERT F. REIDER

certify that this mortgage inspection was made by me or under my direction and control of the described property on, SEPTEMBER 19, 1988, according to the official records and that this drawing is a true representation of the principal building lines thereon and is accurate to the best of my knowledge and belief. IDL Mortgage Co. in agreement with Carow Land Surveying Co., Inc. has waived parts of Administrative Code A-E 5.02 (3 through 7). THIS IS NOT A BOUNDARY SURVEY NOR INTENDED TO BE. THIS MORTGAGE INSPECTION IS MADE FOR THE EXCLUSIVE USE OF: IDL Mortgage Co.

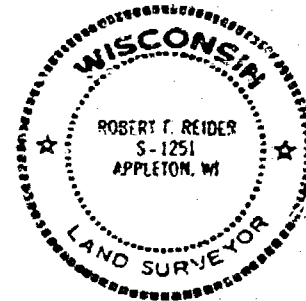

Robert F. Reider

REVISIONS	IDL MORTGAGE CO.		
9-21-88 -KO	P.O. BOX 1552, APPLETON, WISCONSIN 54913		
	CAROW LAND SURVEYING CO., INC., P.O. BOX 1297		
	1837 W. WISCONSIN AVE. • APPLETON, WI 54912		
	DRAWN BY KV dv	KO	SCALE 1"=30'
	APPD	/	DATE 9-19-88
			DRAWING NO. 889.43

Chapter A-E 5

MINIMUM STANDARDS FOR PROPERTY SURVEYS

A-E 5.01 Minimum standards for property surveys. A-E 5.02 U.S. public land survey monument record.

A-E 5.01 Minimum standards for property surveys. (1) Scope. The minimum standards of this section apply to every property survey performed in this state except that:

(a) Where other standards for property surveys are prescribed by statute, administrative rule or ordinance, then such standards shall govern; and

(b) The land surveyor and his or her client or employer may agree in a signed statement to exclude any land surveying work from the requirements of this section except the preparation of a U.S. Public Land Survey Monument Record, providing any map prepared by the land surveyor for the client or employer includes a note which states that an agreement to exclude work from the requirements of this section has been made, the names of the parties making the agreement and a description in plain language of the requirements not complied with.

(2) PROPERTY SURVEY, DEFINITION. In this section, "property survey" means any land surveying which includes as one of its principal purposes describing, monumenting, locating the boundary lines of or mapping one or more parcels of land. The term includes the restoration, perpetuation or reestablishment of a U.S. public survey corner.

(3) BOUNDARY LOCATION. Every property survey should be made in accordance with the records of the register of deeds as nearly as is practicable. The surveyor shall acquire data necessary to retrace record title boundaries such as deeds, maps, certificates of title, and center line and other boundary line locations. The surveyor shall analyze the data and make a careful determination of the position of the boundaries of the parcel being surveyed. The surveyor shall make a field survey, traversing and connecting monuments necessary for location of the parcel and coordinate the facts of such survey with the analysis. The surveyor shall set monuments marking the corners of such parcel unless monuments already exist at such corners.

(4) DESCRIPTIONS. Descriptions defining land boundaries written for conveyance or other purposes shall be complete, providing definite and unequivocal identification of lines or boundaries. The description must contain necessary ties to adjoining together with data of dimensions sufficient to enable the description to be mapped and retraced and shall describe the land surveyed by government lot, recorded private claim, quarter-quarter section, section, township, range and county, and by metes and bounds commencing with some corner marked and established by the U.S. public land survey; or if such land is located in a recorded subdivision or recorded addition thereto, then by the number or other description of the lot, block or subdivision thereof which has been previously tied to a corner marked and established by the U.S. public land survey.

Register, August, 1982, No. 320

Note: Items not underlined have been waived.

WISCONSIN ADMINISTRATIVE CODE

A-E 5

(5) MAPS. A map shall be drawn for every property survey showing information developed by the survey and including the following elements:

(a) The map shall be drawn to a convenient scale;

(b) The map shall be referenced as provided in s. 59.61, Stats.;

(c) The map shall show the exact length and bearing of the boundaries of the parcels surveyed. Where the boundary lines show bearings, lengths or locations which vary from those recorded in deeds, abutting plats, or other instruments there shall be the following note placed along such lines, "recorded as (show recorded bearing, length or location)";

(d) The map shall show and describe all monuments necessary for the location of the parcel and shall indicate whether such monuments were found or placed;

(e) The map shall identify the person for whom the survey was made, the date of the survey, and shall describe the parcel as provided in (4), above;

(f) The map shall bear the stamp or seal and signature of the land surveyor under whose direction and control the survey was made with a statement certifying that the survey is correct to the best of his knowledge and belief.

(6) MEASUREMENTS. (a) Measurements shall be made with instruments and methods capable of attaining the required accuracy for the particular problem involved.

(b) The minimum accuracy of linear measurements between points shall be 1 part in 3,000 on all property lines of boundary or interior survey.

(c) In a closed traverse the sum of the measured angles shall agree with the theoretical sum by a difference not greater than 30 seconds per angle, or the sum of the total angles shall not differ from the theoretical sum by more than 120 seconds, whichever is smaller.

(d) Any closed traverse depicted on a property survey map shall have a latitude and departure closure ratio of less than 1 in 3,000.

(e) Bearings or angles on any property survey map shall be shown to the nearest minute; distances shall be shown to the nearest 1/100th foot.

(7) MONUMENTS. The type and position of monuments to be set on any survey shall be determined by the nature of the survey, the permanency required, the nature of the terrain, the cadastral features involved, and the availability of material.

History: Cr. Register, June, 1974, No. 222, eff. 7-1-74; am. (5) (c) and (d) (e), Register, June, 1976, No. 234, eff. 7-1-76; am. (1) (b), Register, January, 1977, No. 313, eff. 2-1-82; am. (1) (b) and c. and recc. (2), Register, August, 1982, No. 320, eff. 9-1-82.

A-E 5.02 U.S. public land survey monument record. (1) When MONUMENT RECORD REQUIRED. A U.S. public land survey monument record shall be prepared as part of any land survey which includes or requires the perpetuation, restoration or reestablishment of a U.S. public land survey corner, and, either,

Register, August, 1982, No. 220


PLAT OF SURVEY

SITUATED ON CLAIRVILLE ROAD, BEING A PART OF THE S.W. 1/4 OF SECTION 29, T18N, R16E, IN THE TOWN OF ALGOMA, WINNEBAGO COUNTY, WISCONSIN, WHICH IS BOUNDED AND DESCRIBED AS FOLLOWS; COMMENCING AT THE WEST 1/4 CORNER OF SAID SECTION, THENCE SOUTH 00-33-13 EAST ALONG THE WEST LINE OF THE S.W. 1/4 OF SAID SECTION 0.64 FT TO THE POINT OF BEGINNING OF THE PARCEL TO BE DESCRIBED, THENCE SOUTH 89-35-25 EAST ALONG AN EXISTING FENCE LINE AND FENCE LINE EXTENDED 559.58 FT., THENCE SOUTH 01-55-48 EAST 414.57 FT., THENCE NORTH 89-41-58 WEST 569.52 FT. TO A POINT ON THE WEST LINE OF SAID S.W. 1/4, THENCE NORTH 00-33-13 WEST ALONG SAID LINE 415.36 FT. TO THE POINT OF BEGINNING. THE WEST 33.00 FT. OF SAID PARCEL IS RESERVED FOR PUBLIC ROADWAY PURPOSES. SAID PARCEL CONTAINS 5.0609 ACRES NET (TO RIGHT OF WAY LINE).

SEPTEMBER 16, 1988 SURVEY FOR HOMESTEAD REALTY SURVEY NO. 88-1275

- DENOTES 3/4 INCH DIAMETER IRON ROD, 24" LONG, WEIGHING NOT LESS THAN 1.13 LBS. PER LINEAL FOOT SET.
- ——— DENOTES 3/4 INCH DIAMETER IRON ROD FOUND.
- ——— DENOTES P.K. NAIL SET.

NOTE: THIS SURVEY REPLACES SURVEY NO. 88-1275 DATED JUNE 22, 1988.

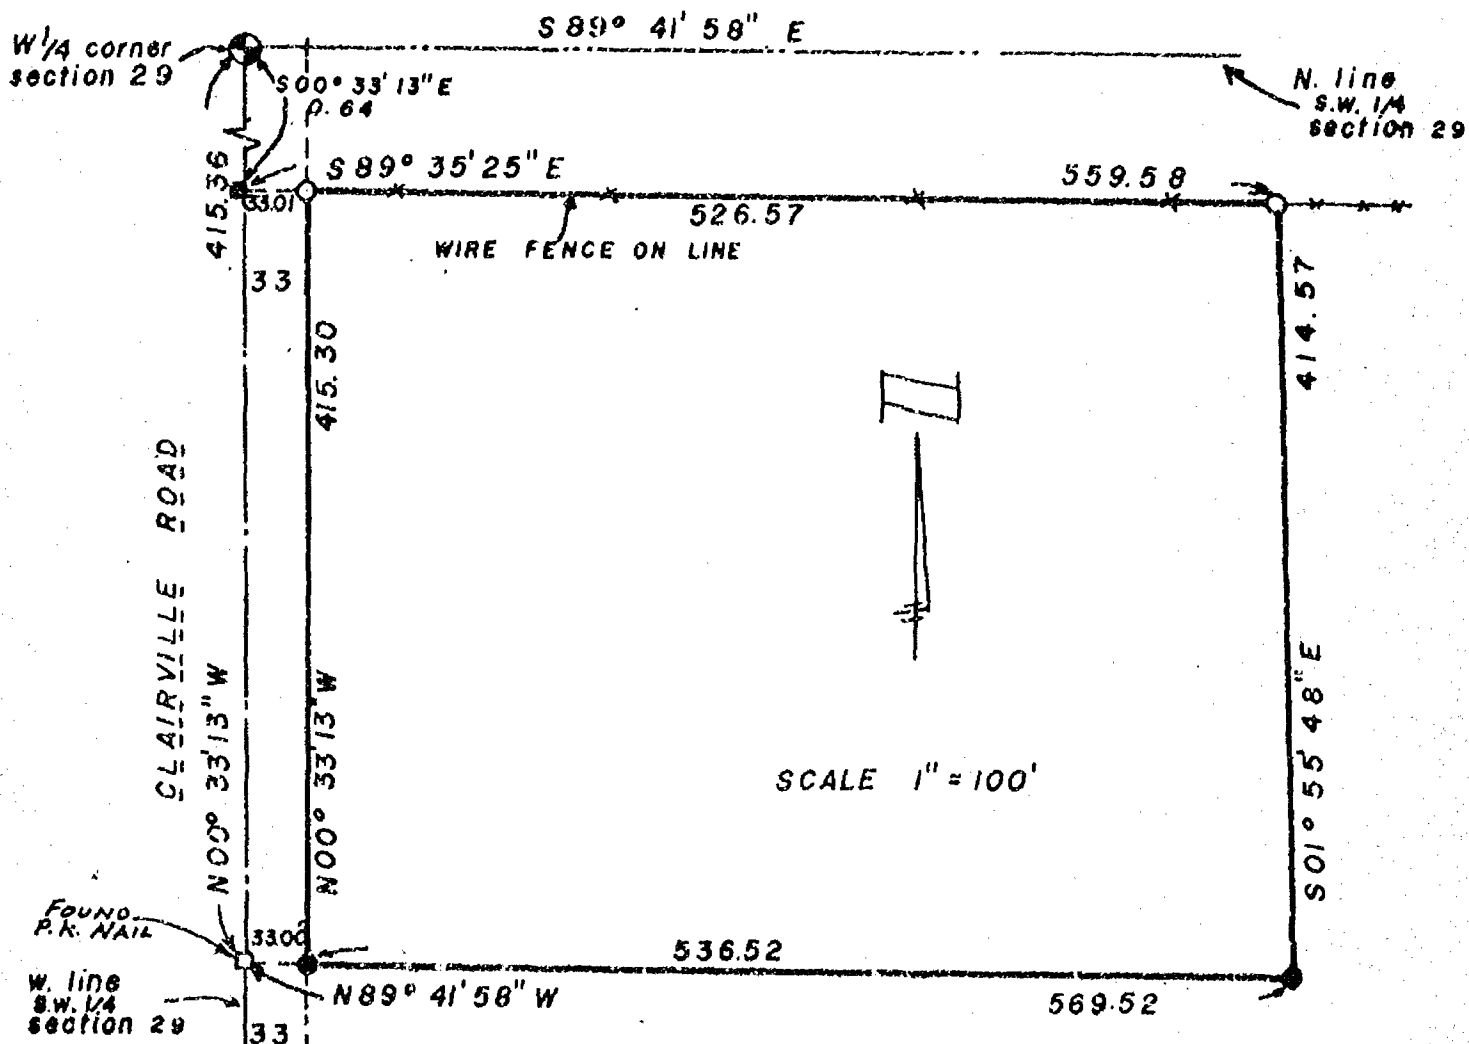


SURVEYOR'S CERTIFICATE

I, REINHARD H. W. RDEHLIO, Registered Land Surveyor No. S-1368, hereby certify: That I have surveyed the property described hereon and that the above map is a true representation thereof and shows the size and location of the property, its exterior boundaries, the location and dimensions of all visible structures thereon, fences, apparent easements, roadways and visible encroachments, if any. This survey is made for the exclusive use of the present owners of the property, and also those who purchase, mortgage, or guarantee the title thereto within one (1) year from the date hereon, and as to them I certify the accuracy of said survey and map.

SCHULER & ASSOCIATES

320 W. Northland Ave. 2530 W. 20th Ave.
Appleton, WI. 54912 Oshkosh, WI. 54904
(414) 734-9107 (414) 426-2800

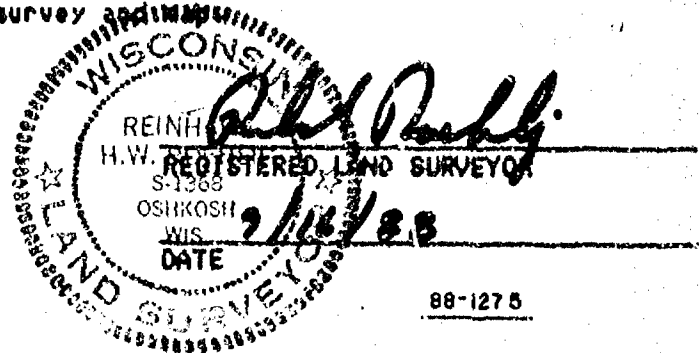

88-1275

Stock No. 26273

88-1368

SHEET 1 OF 3

CERTIFIED SURVEY MAP NO. 1939


BEING A PART OF THE S.W. 1/4 OF SECTION 29, T18N, R16E, IN THE TOWN OF ALGOMA, WINNEBAGO COUNTY, WISCONSIN.

○ ——— DENOTES 3/4 INCH DIAMETER IRON ROD, 24" LONG, WEIGHING NOT LESS THAN 1.13 LBS PER LINEAL FOOT SET.


● ——— DENOTES 3/4 INCH DIAMETER IRON ROD FOUND.

ALL DIMENSIONS SHOWN ARE MEASURED TO THE NEAREST HUNDREDTH OF A FOOT.

BEARINGS ARE REFERENCED TO THE WEST LINE OF THE S.W. 1/4 OF SECTION 29 WHICH HAS AN ASSUMED BEARING OF NORTH 00°33'13" WEST.

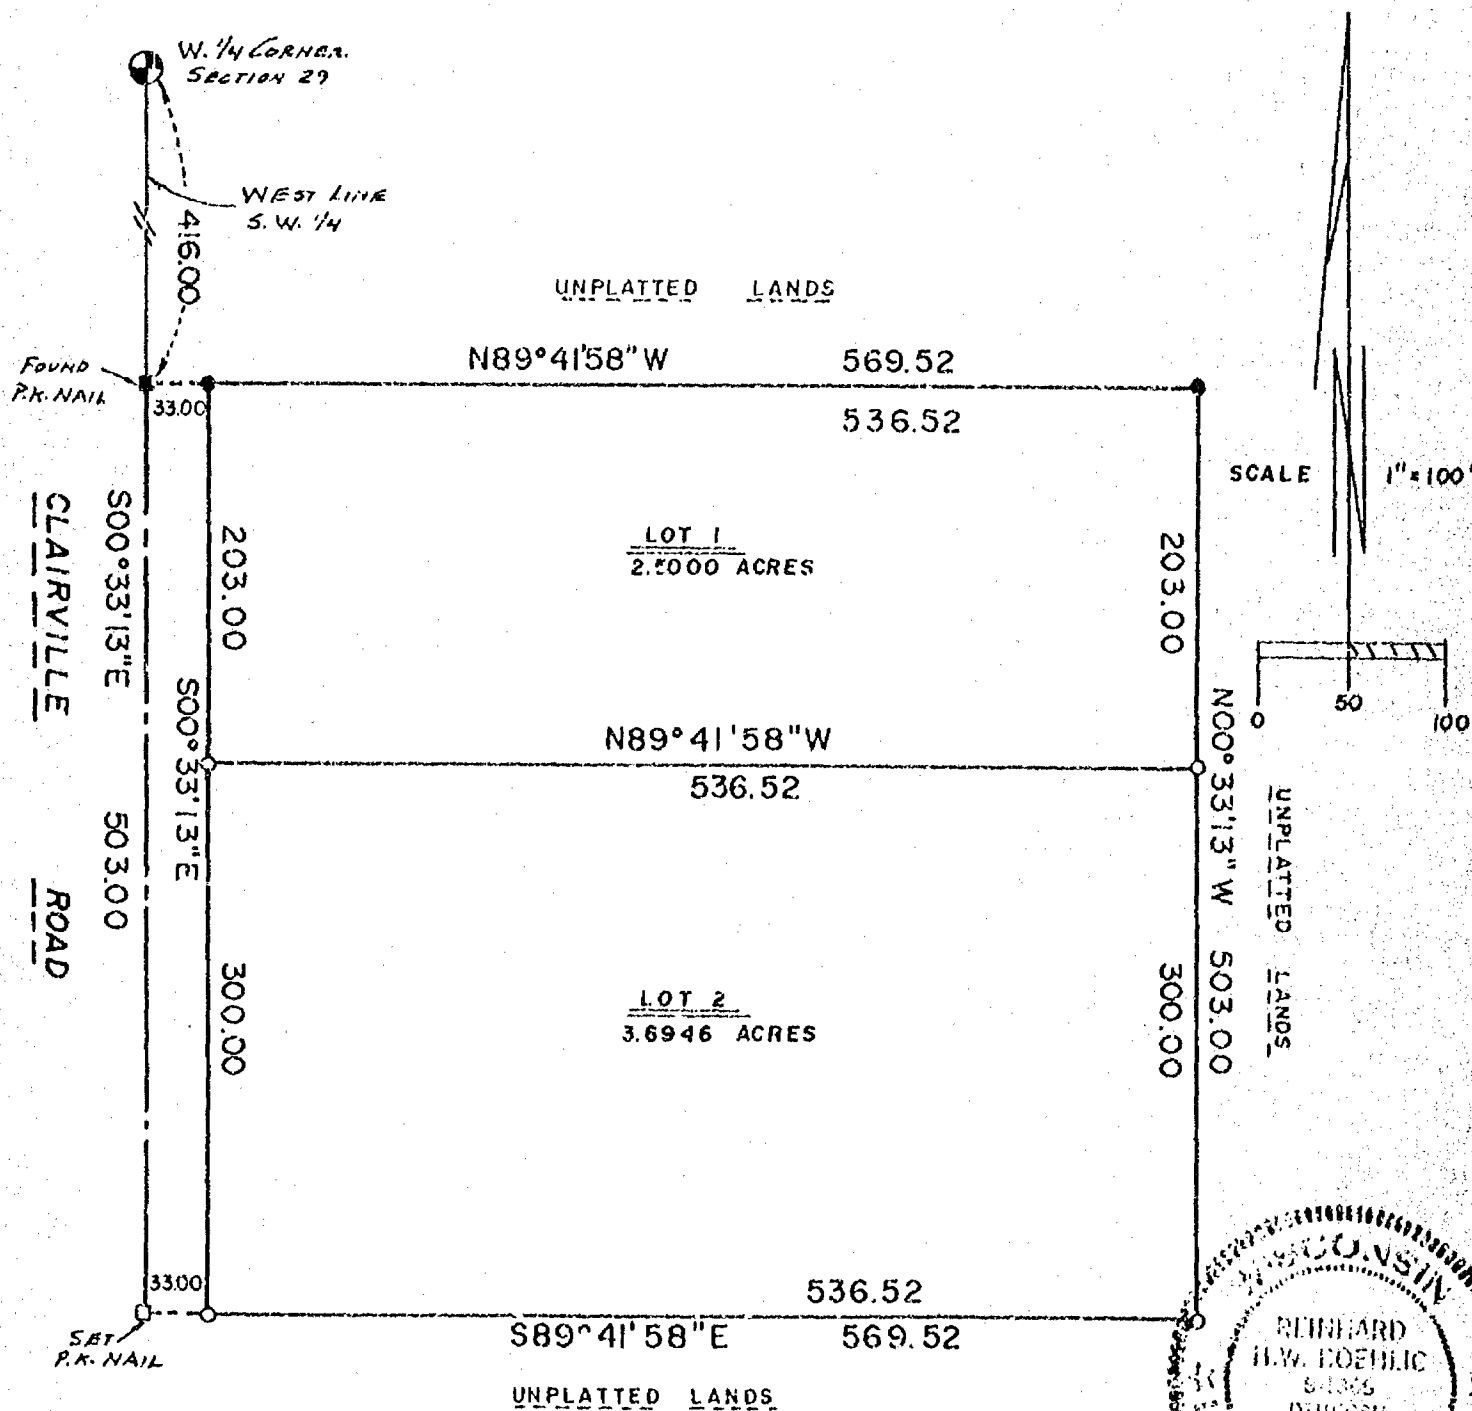**SCHULER & ASSOCIATES**

CONSULTING ENGINEERS & LAND SURVEYORS

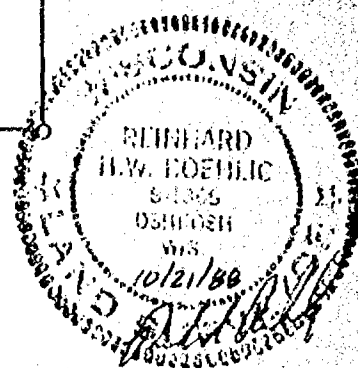320 W. NORTHLAND AVE.
2530 W. 20TH AVE.APPLETON, WIS. 54911 (414) 734-9107
OSHKOSH, WIS. 54904 (414) 426-2600

Stock No. 26273

88-1368

SHEET 2 OF 3CERTIFIED SURVEY MAP NO. 1929

BEING A PART OF THE S.W. 1/4 OF SECTION 29, T18N, R16E, IN THE TOWN OF
ALGOMA, WINNEBAGO COUNTY, WISCONSIN.

SURVEYOR'S CERTIFICATE
STATE OF WISCONSIN)

:SS

WINNEBAGO COUNTY)

I, REINHARD ROEHLIG, Wisconsin Land Surveyor do hereby certify;

THAT I have surveyed and mapped a part of the S.W. 1/4 of Section 29,
T18N, R16E, in the Town of Algoma, Winnebago County, Wisconsin, which
is bounded and described as follows:

Commencing at the W. 1/4 corner of said Section, thence South 00-33-13
East along the West line of said S.W. 1/4 aforesaid 416.00 ft. to the
point of beginning of the parcel to be described, thence continuing
South 00-33-13 East 503.00 ft., thence South 89-41-58 East 569.52 ft.,
thence North 00-33-13 West 503.00 ft., thence North 89-41-58 West
569.52 ft. to the point of beginning.

THAT I have made this survey and land division by the direction of
Kenneth W. Neubauer and Virginia V. Neubauer, his wife, Town of Algoma,
Winnebago County, owners of said land.

THAT such map is a correct representation of all the exterior
boundaries of the land surveyed and the land division thereof made.

THAT I have fully complied with the provisions of Chapter 236 of the
Wisconsin Statutes and the Land Subdivision Ordinance of the Winnebago
County.

Date

10/21/08

Reinhard Roehlig (SEAL)
Reinhard Roehlig, Registered
Land Surveyor S-1368



Stock No. 26273

88-1368

SHEET 3 OF 3

CERTIFIED SURVEY MAP NO. 1929

BEING A PART OF THE S.W. 1/4 OF SECTION 29, T18N, R16E, IN THE TOWN OF ALGOMA, WINNEBAGO COUNTY, WISCONSIN.

OWNER'S CERTIFICATE

AS OWNERS, We hereby certify that We caused the land described on this map to be surveyed, divided and mapped as represented on this map in accordance with the Winnebago County Subdivision Ordinance.

WITNESS the hands and seals of said owners this 24 day of October, 1988.

In The Presence Of:

Kenneth W. Neubauer
Kenneth W. Neubauer

Virginia V. Neubauer
Virginia V. Neubauer

STATE OF WISCONSIN)

:SS

WINNEBAGO COUNTY)

PERSONALLY came before me this 24 day of October, 1988 the above named Kenneth W. Neubauer and Virginia V. Neubauer, his wife, to me known to be the persons who executed the foregoing instrument, and acknowledged the same.

Robert P. Hertz
Notary Public, Winnebago County,
State of Wisconsin

My Commission Expires 10/21/91

WINNEBAGO COUNTY PLANNING COMMISSION CERTIFICATE

THIS Certified Survey Map of a part of the S.W. 1/4 of Section 29, T18N, R16E, Town of Algoma, Winnebago County, Wisconsin, Kenneth W. Neubauer and Virginia V. Neubauer, his wife, owners, is hereby approved.

October 25, 1988
Date


Carol Owens
Planning Committee Representative

THIS INSTRUMENT WAS DRAFTED BY REINHARD ROEHLIG.

711345

Register's Office
Winnebago County, Wis.
Received for record this 26th
day of Oct, A.D., 1988
at 1:34 o'clock P.M. and
recorded in Vol. 1 of CSM
on page 1929


Margaret A. Adams
Register of Deeds

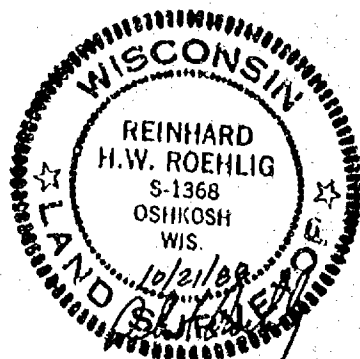

Plat of Survey

FLOOD PLAIN ELEVATIONS - LOCATED IN PART OF THE SW 1/4
OF THE SW 1/4 OF SEC. 29, T.18N., R.16E., IN THE TOWN OF
ALGOMA, WINNEBAGO COUNTY, WISCONSIN

CLIENT: FIRST FINANCIAL
1305 MAIN ST.
STEVENS POINT, WI 54481

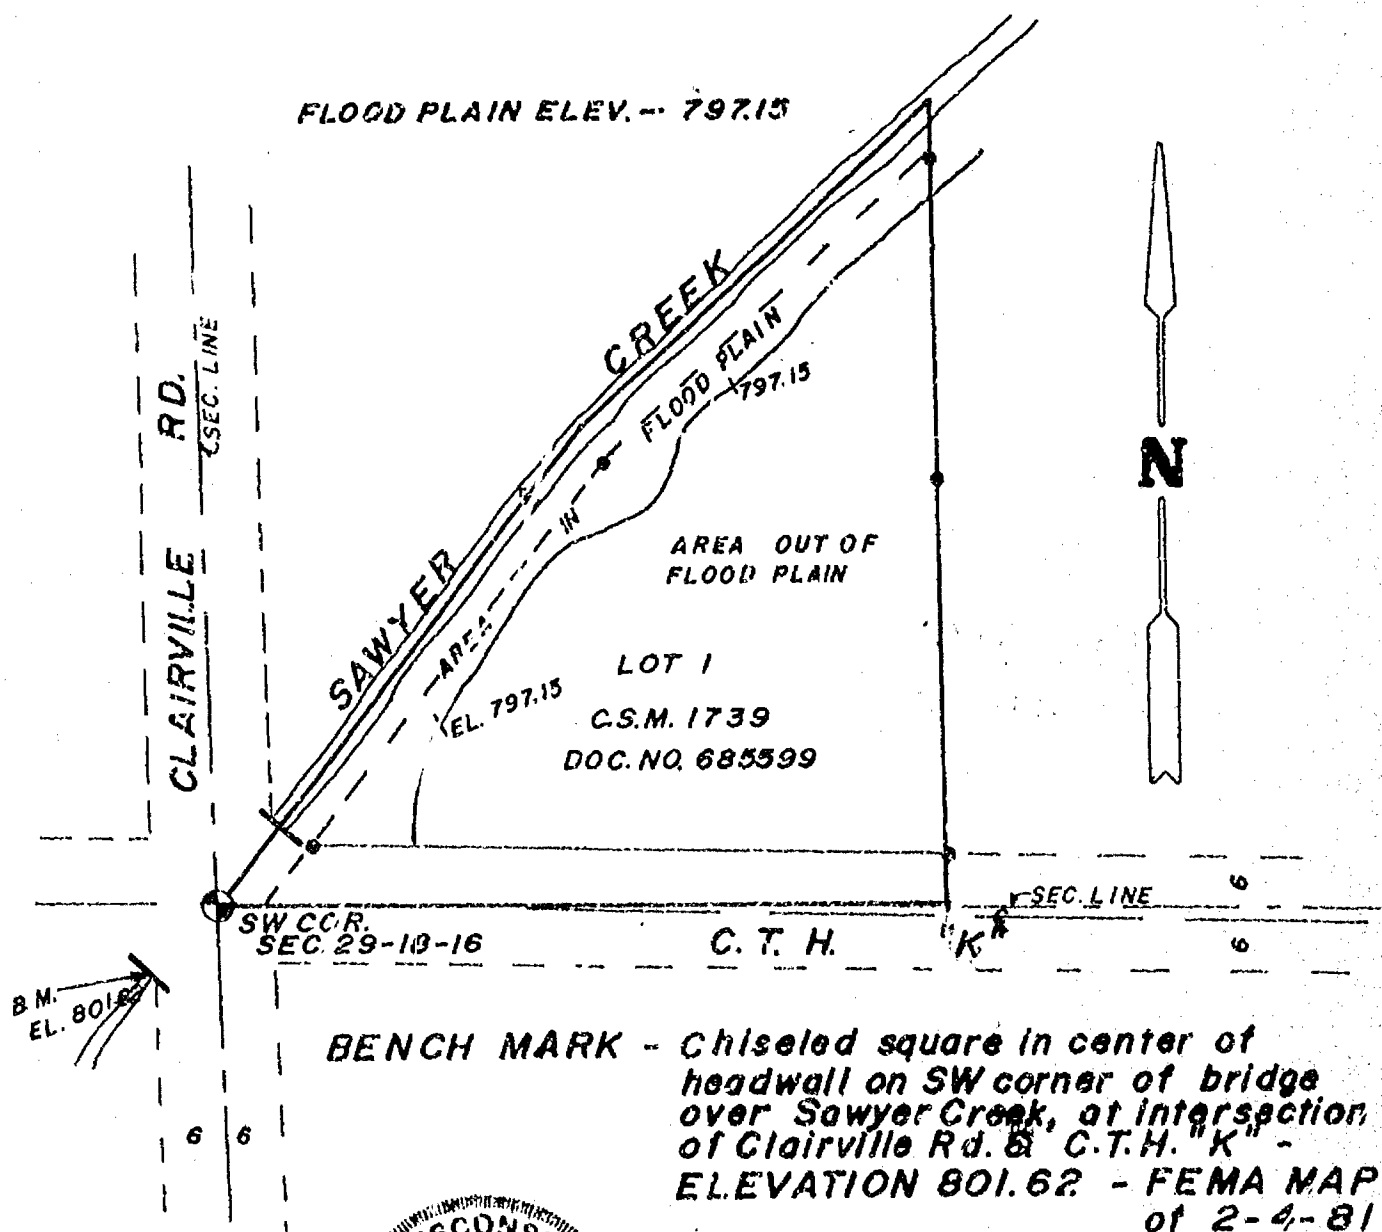

LEGEND

- = Existing monuments
- = 2" x 30" iron pipe set
- = 1" x 30" iron pipe set
- ⊙ = reference caps or R.R. spikes
- ⊙ = Bernsen or Harrison monuments
- x-x = fence
- () = recorded as
- = stone monument



SURVEYORS CERTIFICATE

I, hereby certify that I have surveyed the property as shown, according to official records and that the plat above drawn is an accurate and correct representation of said survey. SEPTEMBER 24, 1987

Robert H. Saylor

Wisconsin Registered Land Surveyor S-1834

Saylor
Survey, inc.

139A WEST MAIN, BOX 252,

WINNECONNE, WI 54988

SCALE 1" = 100'

PROJECT NO. ES-001844

FIELD BOOK PLAT PAGE


Stock No. 26273

WINNEBAGO COUNTY CERTIFIED SURVEY MAP NO. 1739Part of the SW $\frac{1}{4}$ of the SW $\frac{1}{4}$ of Sec. 29, T.18N., R.16E., in the Town of Algoma,
Winnebago County, WisconsinBearings are referenced to the South line of the SW $\frac{1}{4}$, Sec. 29, T.18N., R.16E.,
assumed bearing S.89°25'00"E.*Robert H. Saylor*

Robert H. Saylor S-1894

Wisconsin Registered Land Surveyor

July 23, 1987

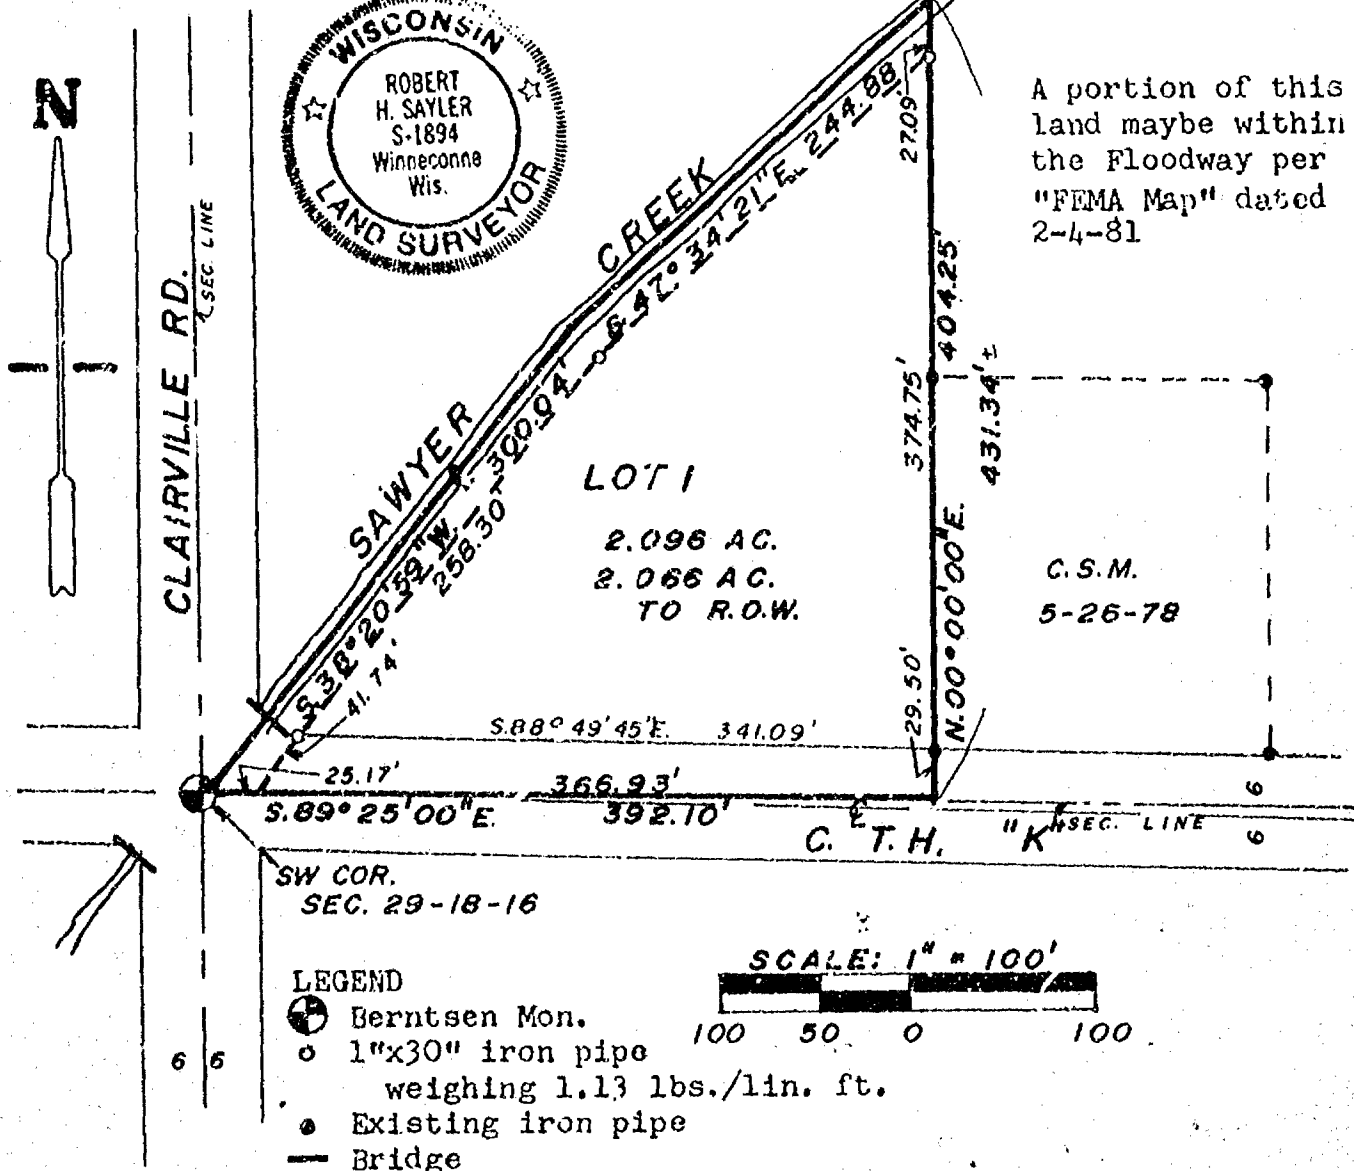

WINNEBAGO COUNTY PLANNING COMMITTEE CERTIFICATE

This certified survey map of part of the SW $\frac{1}{4}$ of the SW $\frac{1}{4}$ of Sec. 29, T.18N., R.16E., in the Town of Algoma, is hereby approved.

Date

July 28, 1987

Authorized Signature

Carol Owens

Sheet 1 of 2 sheets

Stock No. 26273

WINNEBAGO COUNTY CERTIFIED SURVEY MAP NO. 1739

Part of the SW $\frac{1}{4}$ of the SW $\frac{1}{4}$ of Sec. 29, T.18N., R.16E., in the Town of Algoma, Winnebago County, Wisconsin

SURVEYOR'S CERTIFICATE

I, Robert H. Saylor registered land surveyor, hereby certify:

That I have surveyed divided and mapped the parcel of land located in part of the SW $\frac{1}{4}$ of the SW $\frac{1}{4}$ of Sec. 29, T.18N., R.16E., in the Town of Algoma, Winnebago County, Wisconsin described as follows: Beginning at the SW corner of said Sec. 29. From that point running S.89°25'00"E. 392.10 ft., thence N.00°00'00"E. 404.25 ft. to a meander line of Sawyer Creek, thence S.47°34'21"W. 244.88 ft., thence S.38°20'59"W. 300.04 ft., thence N.89°25'00"W. 25.17 ft. to the said point of beginning. Including all the land lying between the meander line and the center line of Sawyer Creek. Subject to all easements and restrictions of record.

That I have made such survey, land division and map by the direction of Kenneth Neubauer, 1924 Clairville Rd., Oshkosh, WI 54904; that such map is a true and correct representation of the exterior boundaries surveyed.

That I have fully complied with the provisions of Sec. 236.34 of the Wisconsin Statutes and the Winnebago County Subdivision Ordinance in surveying, dividing and mapping the same.



Robert H. Saylor
Robert H. Saylor S-1894
Wisconsin Registered Land Surveyor
July 23, 1987

OWNER'S CERTIFICATE

As owner(s), I (we) hereby certify that I (we) caused the land described on this certified survey map to be surveyed, divided and mapped as represented hereon.

WITNESS the hand and seal of said owner(s) this 24th day of

July, 1987

In presence of:

Dorothy L. Proehl
Witness

DOROTHY L. PROEHL
NOTARY PUBLIC
STATE OF WISCONSIN

Kenneth W. Neubauer
Owner

Virginia V. Neubauer
Owner
1924 Clairville Rd.
Oshkosh, WI 54904

STATE OF WISCONSIN) SS
WINNEBAGO COUNTY)

Personally came before me this 24th day of July, 1987 the above named owner(s) to me known to be the person (s) who executed the foregoing instrument and acknowledged the same.

Dorothy L. Proehl My commission expires 6-24-1990.
Notary Public Winneconne WI

Sheet 2 of 2 sheets

SAYLER SURVEY, INC.

139A W. Main

Winneconne, WI

685599

Register's Office
Winnebago County, Wis.
Received for record this 29th
day of July, A.D. 1987
at 11:00 o'clock P.M. and
recorded in Vol. 1... of CSM
on page 1239.
Marjorie Dahm
Register of Deeds

Jaylen Luning chg
6

Stock No. 26273

WINNEBAGO COUNTY CERTIFIED SURVEY MAP NO.



Part of the SW $\frac{1}{4}$ of the SW $\frac{1}{4}$ of Sec. 29, T.18N., R.16E., in the Town of Algoma, Winnebago County, WisconsinBearings are referenced to the South line of the SW $\frac{1}{4}$, Sec. 29, T.18N., R.16E., assumed bearing S.89°25'00"E.*Robert H. Saylor*

Robert H. Saylor

S-1894

Wisconsin Registered Land Surveyor

June 30, 1987

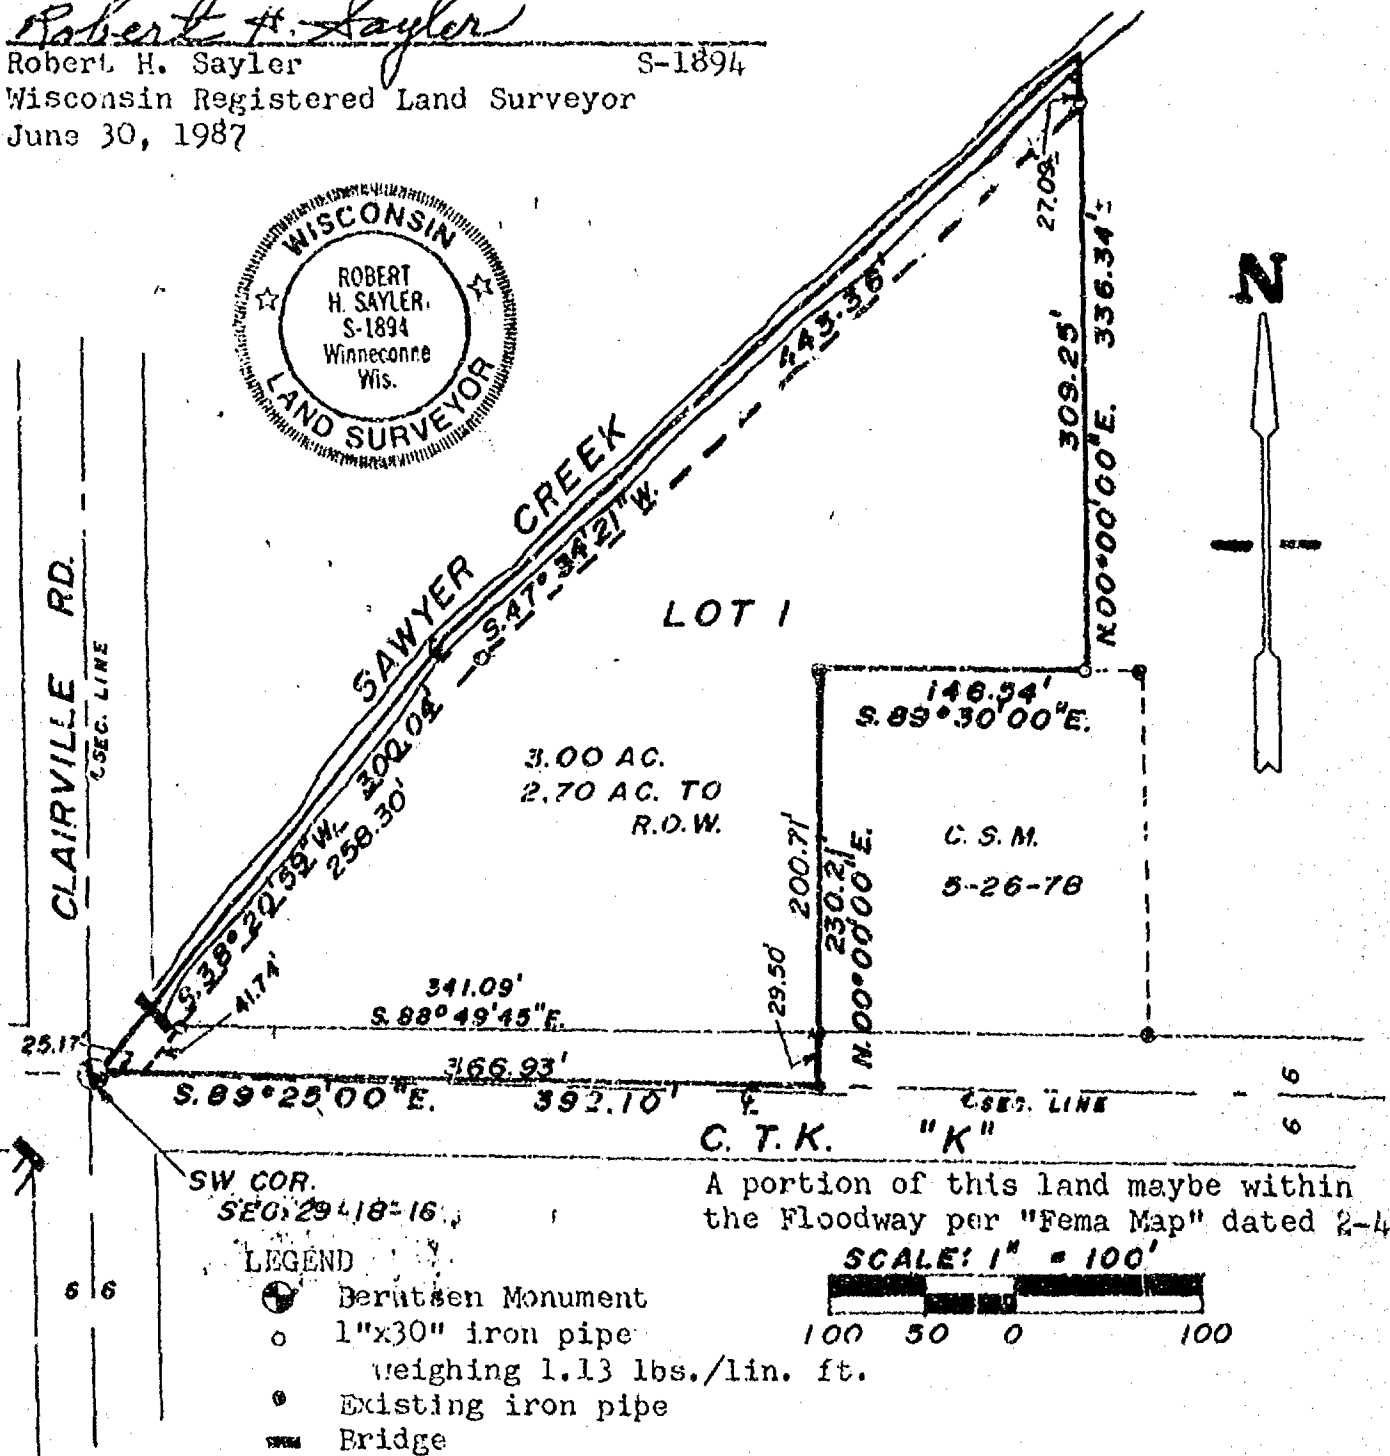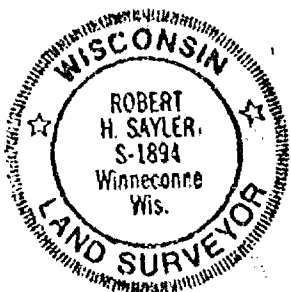

WINNEBAGO COUNTY PLANNING COMMITTEE CERTIFICATE

This certified survey map of part of the SW $\frac{1}{4}$ of the SW $\frac{1}{4}$ of Sec. 29, T.18N., R.16E., in the Town of Algoma, is hereby approved.

Date

Authorized Signature

Sheet 1 of 2 sheets

FB. 54 PG. 9

SAYLER SURVEY, INC. LAND SURVEYORS WINNECONNE, WI

Stock No. 26273

WINNEBAGO COUNTY CERTIFIED SURVEY MAP NO.

Part of the SW $\frac{1}{4}$ of the SW $\frac{1}{4}$ of Sec. 29, T.18N., R.16E., in the Town of Algoma, Winnebago County, Wisconsin

SURVEYOR'S CERTIFICATE

I, Robert H. Saylor registered land surveyor, hereby certify:

That I have surveyed, divided and mapped the parcel of land located in part of the SW $\frac{1}{4}$ of the SW $\frac{1}{4}$ of Sec. 29, T.18N., R.16E., in the Town of Algoma, Winnebago County, Wisconsin described as follows: Beginning at the SW corner of said Sec. 29. From that point running S.89°25'00"E 392.10 ft., thence N.00°00'00"E. 230.71 ft., thence S.89°30'00"E. 146.54 ft., thence N.00°00'00"E. 309.25 ft. to a meander line of Sawyer Creek, thence S.47°34'21"W. 443.36 ft., thence S.38°20'59"W. 300.04 ft., thence N.89°25'00"W. 25.17 ft. to the said point of beginning. Including all the land lying between the meander line and the center line of Sawyer Creek. Subject to all easements and restrictions of record.

That I have made such survey, land division and map by the direction of Kenneth Neubauer, 1924 Clairville Rd., Oshkosh, WI 54904; that such map is a true and correct representation of the exterior boundaries surveyed.

That I have fully complied with the provisions of Sec. 236.34 of the Wisconsin Statutes and the Winnebago County Subdivision Ordinance in surveying, dividing and mapping the same.



Robert H. Saylor
Robert H. Saylor S-1894
Wisconsin Registered Land Surveyor
June 30, 1987

OWNER'S CERTIFICATE

As owner(s), I (we) hereby certify that I (we) caused the land described on this certified survey map to be surveyed, divided and mapped as represented hereon.

WITNESS the hand and seal of said owner(s) this 1st day of

July, 1987.

In presence of:

Witness

DOROTHY L. PROEHL
NOTARY PUBLIC
STATE OF WISCONSIN

Kenneth W. Neubauer
Owner
Virginia V. Neubauer
Owner
1924 Clairville Rd.
Oshkosh, WI 54904

STATE OF WISCONSIN)
WINNEBAGO COUNTY)SS

Personally came before me this 1st day of July, 1987 the above named owner(s) to me known to be the person (s) who executed the foregoing instrument and acknowledged the same.


Dorothy L. Proehl My commission expires 6-24-90
Notary Public Winneconne, WI

Sheet 2 of 2 sheets

SAYLER SURVEY, INC.

139A W. Main

Winneconne, WI

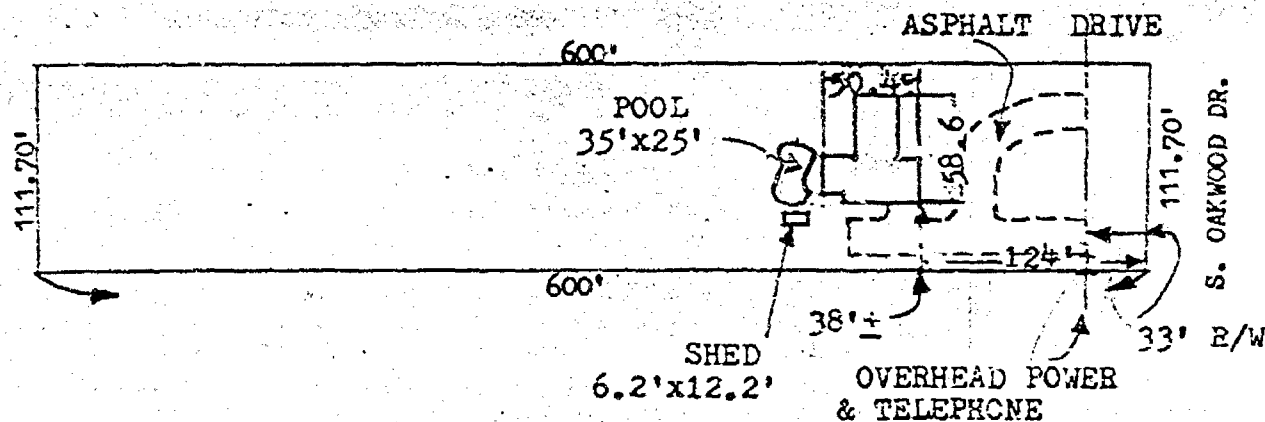

DESCRIPTION:


A PARCEL OF LAND BEING A PART OF THE SOUTHEAST $\frac{1}{4}$ OF THE NORTHEAST $\frac{1}{4}$, OF SECTION 29, TOWN 18 NORTH, RANGE 16 EAST, TOWN OF ALGOMA, WINNEBAGO COUNTY, WISCONSIN; MORE FULLY DESCRIBED AS FOLLOWS:

COMMENCING AT THE EAST $\frac{1}{4}$ CORNER OF SECTION 29; THENCE NORTH ALONG THE EAST LINE OF SAID NORTHEAST $\frac{1}{4}$, 111.70 FEET; THENCE N89°-25'W PARALLEL TO THE SOUTH LINE OF SAID NORTHEAST $\frac{1}{4}$, 600 FEET; THENCE SOUTH PARALLEL TO THE EAST LINE OF SAID NORTHEAST $\frac{1}{4}$, 111.70 FEET; TO THE SOUTH LINE OF THE NORTHEAST $\frac{1}{4}$; THENCE S89°-25'E ALONG THE SOUTH LINE OF SAID NORTHEAST $\frac{1}{4}$, 600 FEET, TO THE POINT OF BEGINNING.

DUDLEY: 1571 S. OAKWOOD DR.
OSHKOSH, WISCONSIN.

2 STORY HOUSE WITH ATTACHED GARAGE

NO BUILDING ENCROACHMENTS PRESENT

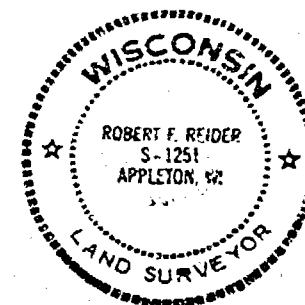

Robert F. Reider

I, ROBERT F. REIDER

certify that this mortgage inspection was made by me or under my direction and control of the described property on, AUGUST 22, 1986, according to the official records and that this drawing is a true representation of the principal building lines thereon and is accurate to the best of my knowledge and belief. Knutson Mortgage Corp., in agreement with Carow Land Surveying Co., Inc. has waived parts of Administrative Code A-E 5.01 (3 through 7). THIS IS NOT A BOUNDARY SURVEY NOR INTENDED TO BE. THIS MORTGAGE INSPECTION IS MADE FOR THE EXCLUSIVE USE OF: Knutson Mortgage & Financial Corp.

REVISIONS	Knutson Mortgage & Financial Corp. P.O. Box 1893, Appleton, Wis. 54913-1893		
	CAROW LAND SURVEYING CO., INC., P.O. BOX 1297 1837 W. WISCONSIN AVE. - APPLETON, WI 54912		
DRAWN BY	HY	SCALE	1"=100'
BY	KF-KO	DATE	8-22-86
APP'D	X	DRAWING NO.	868.208



PLAT OF SURVEY

A PART OF THE S.E. 1/4 OF THE N.E. 1/4 OF SECTION 29, T18N, R16E, IN THE TOWN OF ALGOMA, WINNEBAGO COUNTY, WISCONSIN, BOUNDED AND DESCRIBED AS FOLLOWS: BEGINNING AT A POINT ON THE EAST LINE OF THE S.E. 1/4 OF THE N.E. 1/4, 775.00 FT. NORTH OF THE S.E. CORNER OF SAID N.E. 1/4, BEING THE N.E. CORNER OF LANDS DEEDED TO SWEET BY DEED RECORDED IN VOLUME 1034 ON PAGE 560, THENCE NORTH ON SAID EAST LINE 258.00 FT., THENCE NORTH 89-25 WEST 153.70 FT., THENCE SOUTHWESTERLY ON THE WEST LINE OF LANDS DEEDED BY HORTON AND OTHERS TO GRANTOR BY DEED RECORDED IN VOLUME 1075 OF RECORDS ON PAGE 599 AT AN ANGLE OF 128-04 WITH THE LAST ABOVE DESCRIBED LINE TO A POINT WHERE A LINE DRAWN FROM THE POINT OF BEGINNING, BEARING SOUTH 89-33 WEST INTERSECTS THE LAST NAMED LINE, BEING THE NORTH LINE OF LANDS DEEDED TO SWEET BY DEED RECORDED IN VOLUME 1034 ON PAGE 560, EXTENDED WEST, THENCE EAST ON SAID LINE TO THE PLACE OF BEGINNING.

AUGUST 26, 1986


SURVEY FOR SPANBAUER REALTY

SURVEY NO. 1790-S

● ————— DENOTES 1" DIAMETER IRON PIPE FOUND AS SHOWN.

○ ————— DENOTES 1" DIAMETER, 24" LONG IRON PIPE SET.

() = RECORD DIMENSIONS WHERE DIFFERENT FROM FIELD MEASUREMENTS.

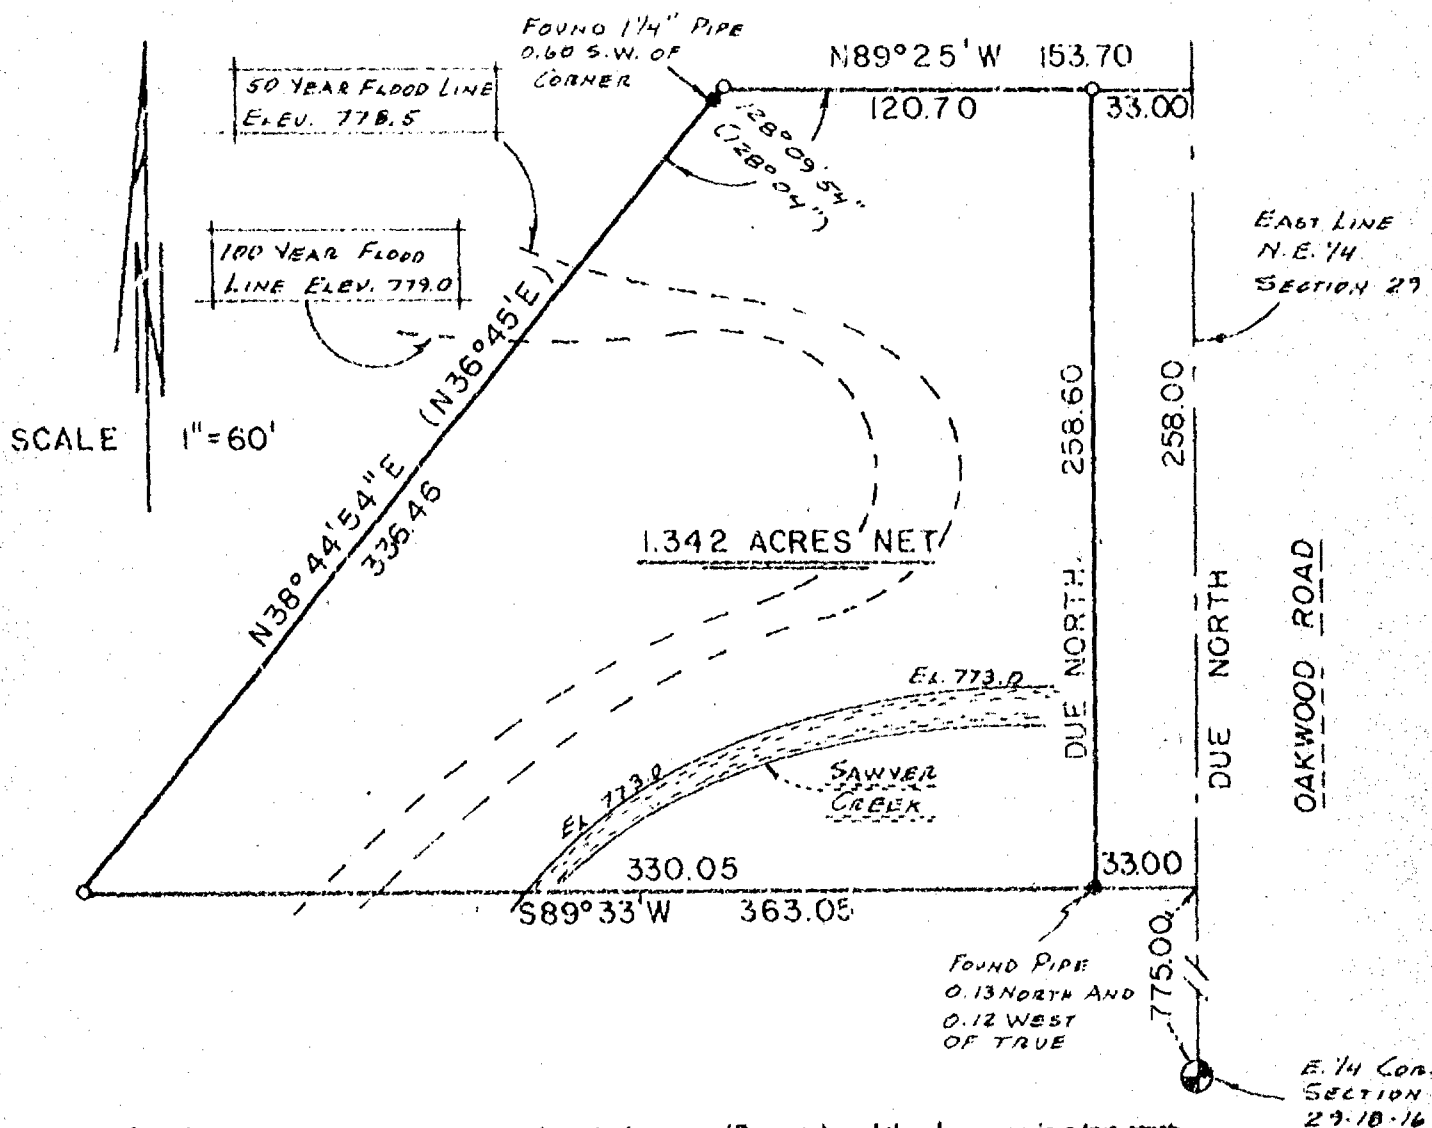


I Certify that I have surveyed the above described property (Property), and the above map is a true representation thereof and shows the size and location of the Property, its exterior boundaries, the location and dimensions of all visible structures thereon, boundary, fences, apparent easements and roadways and visible encroachments, if any.

This survey is made for the exclusive use of the present owners of the Property, and also those who purchase, mortgage, or guarantee the title thereto, within one (1) year from date hereof.



national survey & engineering

417 NORTH SAWYER STREET / P.O. BOX 2983
OSHKOSH, WISCONSIN 54903
(414) 426-2800

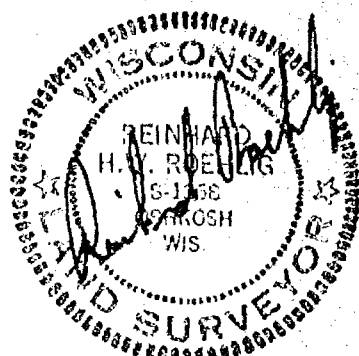

PLAT OF SURVEY

KNOWN AS 992 LINDEN OAKS DRIVE, BEING THE SOUTH 104.35 FT. OF THE NORTH 763.47 FT. OF THE EAST 208.71 FT. OF THE WEST 867.71 FT. OF THE N.E. 1/4 OF THE N.W. 1/4 OF SECTION 29, T18N, R16E, ALONG WITH THAT PORTION OF THE N.E. 1/4 OF THE N.W. 1/4 OF SAID SECTION BOUNDED AND DESCRIBED AS FOLLOWS; COMMENCING AT THE N.W. CORNER OF THE N.E. 1/4 OF THE N.W. 1/4 OF SECTION 29, THENCE EAST 659.00 FT. ALONG THE NORTH LINE OF SECTION 29 TO THE CENTERLINE OF A TOWN ROAD (LINDEN OAKS DRIVE), THENCE SOUTH 763.47 FT. ALONG SAID CENTERLINE TO THE POINT OF BEGINNING, THENCE CONTINUING SOUTH 104.35 FT. ALONG SAID CENTERLINE, THENCE EAST 208.71 FT., THENCE NORTH 104.35 FT., THENCE WEST 208.71 FT. TO THE POINT OF BEGINNING. SUBJECT TO ALL EASEMENTS AND RESTRICTIONS OF RECORD. SUBJECT TO INGRESS AND EGRESS RIGHTS GRANTED BY INSTRUMENT RECORDED AS DOCUMENT NO. 441697.

MAY 15, 1986

SURVEY FOR ATTORNEY
ROBERT WERTSCH AND
DENNIS ZIRBEL


SURVEY NO. 1746-B

● ————— DENOTES 1" DIAMETER IRON PIPE FOUND AS SHOWN.

▲ ————— DENOTES 3/4" DIAMETER IRON ROD FOUND AS SHOWN.

() = RECORD DIMENSIONS WHERE DIFFERENT FROM FIELD MEASUREMENTS.

NOTE: The above description, along with descriptions for adjoining lots, were apparently not derived by protracting the N.W. 1/4 of Section 29. The N.W. corner of the N.E. 1/4 of the N.W. 1/4 was apparently assumed to be the intersection of an existing fence line with the centerline of the 9th Avenue pavement.

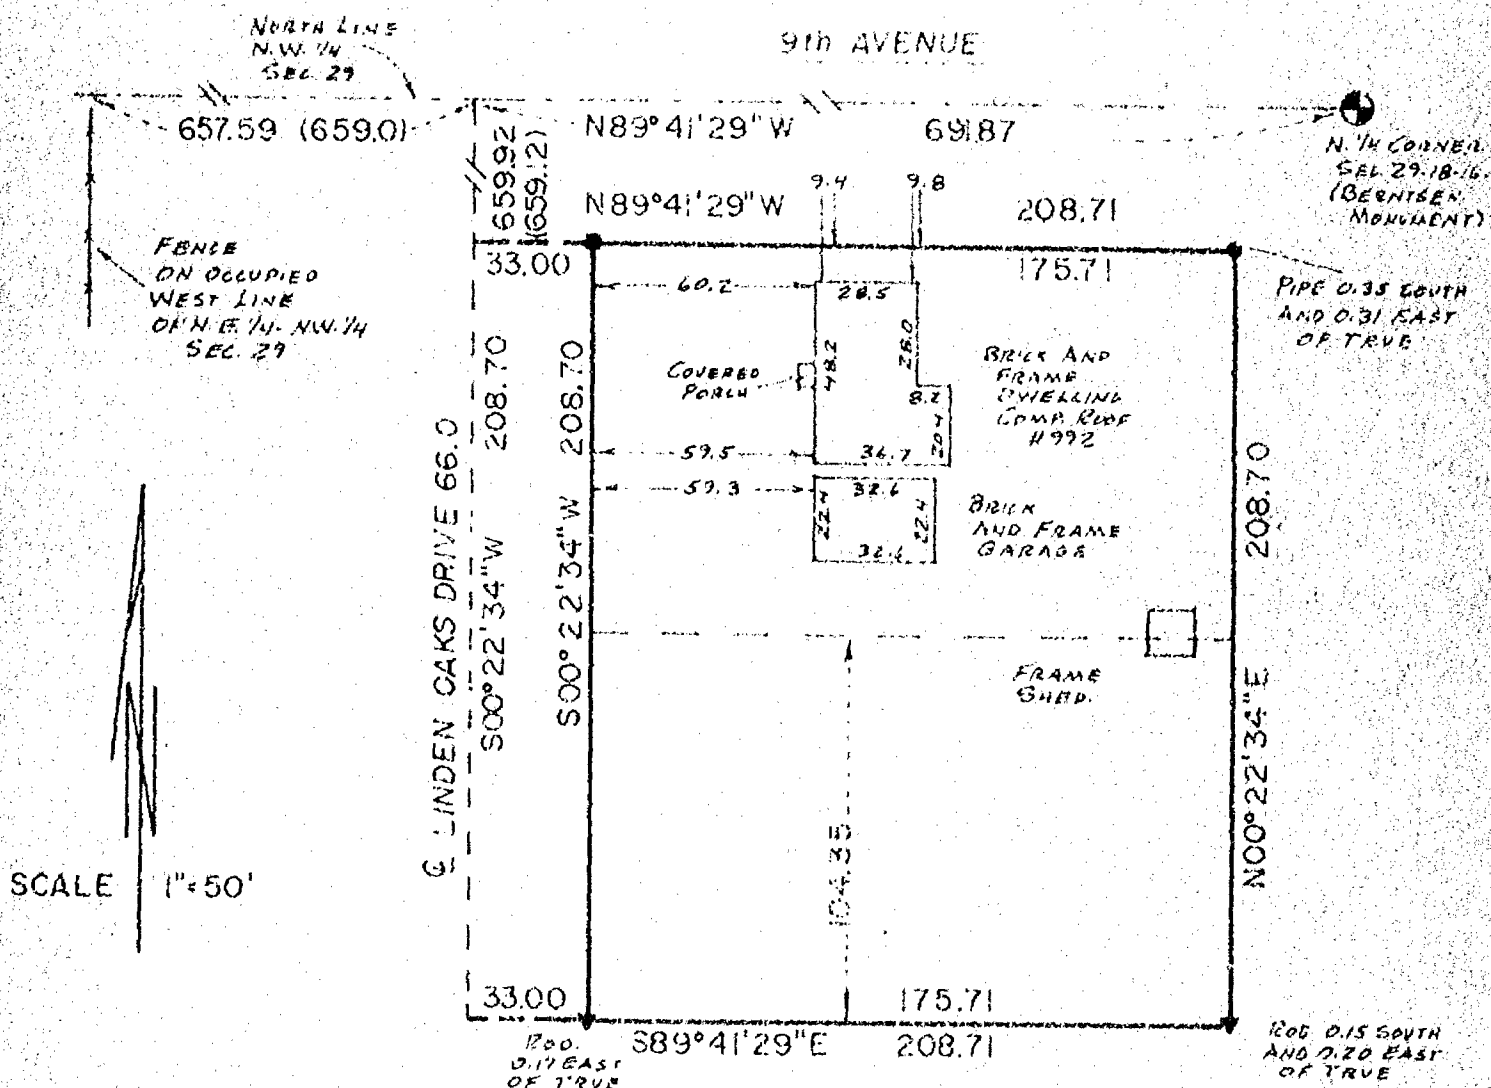

I Certify that I have surveyed the above described property (Property), and the above map is a true representation thereof and shows the size and location of the Property, its exterior boundaries, the location and dimensions of all visible structures thereon, boundary, fences, apparent easements and roadways and visible encroachments, if any. This survey is made for the exclusive use of the present owners of the Property, and also those who purchase, mortgage, or guarantee the title thereto, within one (1) year from date hereof.



National Survey & Engineering

617 NORTH SAWYER STREET / P.O. BOX 2963
OSHKOSH, WISCONSIN 54903
(414) 426-2800



PLAT OF SURVEY

KNOWN AS 2912 HOMESTEAD DRIVE, BEING THAT PORTION OF THE N.E. 1/4 OF THE N.E. 1/4 OF SECTION 29, T18N, R16E, TOWN OF ALGOMA, WINNEBAGO COUNTY, WISCONSIN DESCRIBED AS FOLLOWS: COMMENCING AT THE N.E. CORNER OF THE N.E. 1/4 OF THE N.E. 1/4 OF SAID SECTION 29, THENCE SOUTH 165.00 FT. THENCE WEST 775.00 FT. TO THE TRUE POINT OF BEGINNING, THENCE CONTINUING WEST 100.0 FT. THENCE DUE SOUTH 190.0 FT. THENCE EAST 100.0 FT. THENCE DUE NORTH 190.0 FT. TO THE PLACE OF BEGINNING.

AUGUST 2, 1984


SURVEY FOR OSHKOSH SAVINGS
APPLICANT: DALE FELIX

SURVEY NO. 1504-S

() = RECORD DIMENSIONS WHERE DIFFERENT FROM FIELD MEASUREMENTS.

• DENOTES 1 INCH DIAMETER IRON PIPE FOUND.

— DEVOTES WOOD RAIL FENCE.

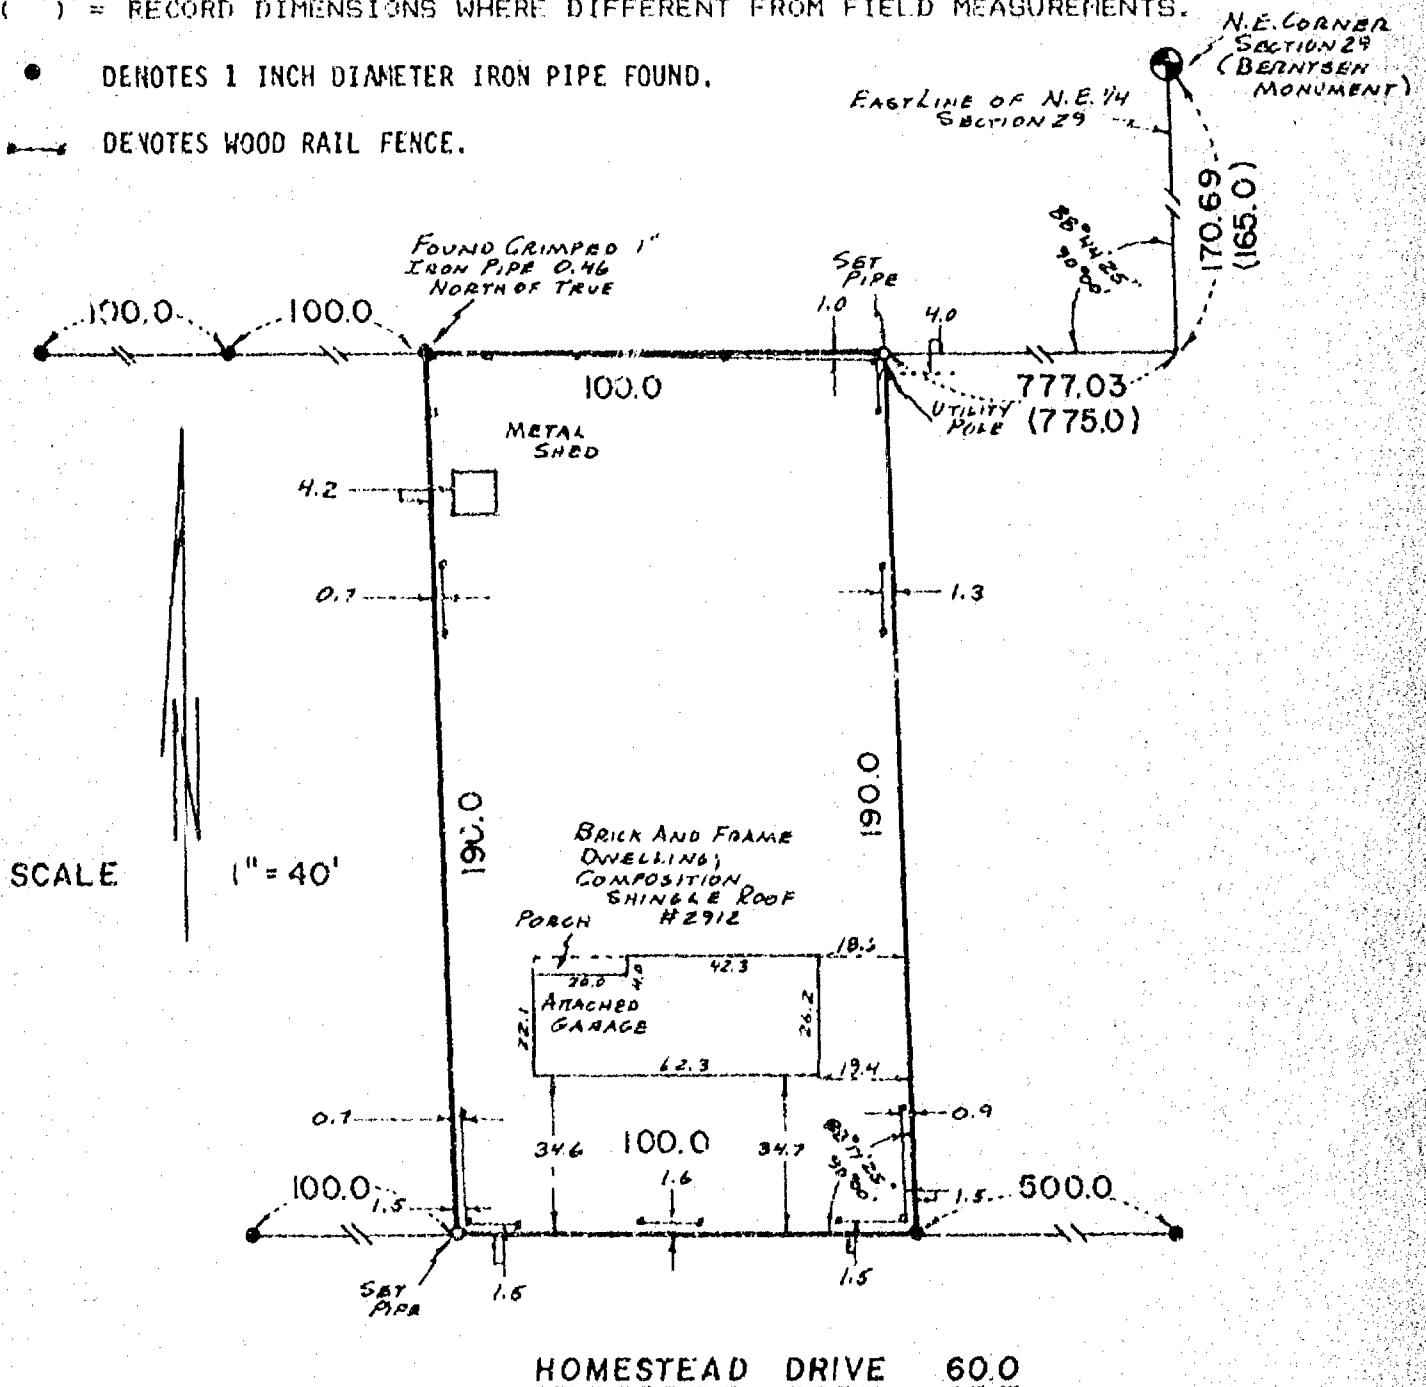


I Certify that I have surveyed the above described property (Property), and the above map is a true representation thereof and shows the size and location of the Property, its exterior boundaries, the location and dimensions of all visible structures thereon, boundary, fences, apparent easements and roadways and visible encroachments, if any. This survey is made for the exclusive use of the present owners of the Property, and also those who purchase, mortgage, or guarantee the title thereto, within one (1) year from date hereof.



national survey & engineering

417 NORTH SAWYER STREET / P.O. BOX 2963
OSHKOSH, WISCONSIN 54903
(414) 426-2800

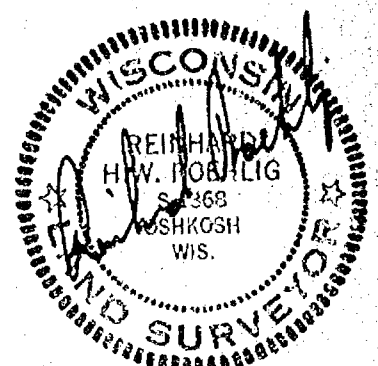

PLAT OF SURVEY

KNOWN AS 953-955 LINDEN OAKS DRIVE, BEING THE SOUTH 208.0 FT. OF THE NORTH 416.71 FT. OF THE EAST 241.59 FT. OF THE WEST 659.0 FT. OF THE N.E. 1/4 OF THE N.W. 1/4 OF SECTION 29, T14N, R14E, TOWN OF ALGOMA, WINNEBAGO COUNTY, WISCONSIN, SUBJECT TO RIGHTS GRANTED BY INSTRUMENT RECORDED IN WINNEBAGO COUNTY REGISTRY AS DOCUMENT NO. 441700.

JULY 24, 1984

SURVEY FOR OSHKOSH SAVINGS
APPLICANT: DAVID ZINK

SURVEY NO. 1491-M

() = RECORD DIMENSIONS WHERE DIFFERENT FROM FIELD MEASUREMENTS.

NOTE: Adjoining properties apparently were not established by protracting the N.W. 1/4 of Section 29. The N.W. corner of the N.E. 1/4 of the N.W. 1/4 was apparently assumed to be the intersection of an existing fence line at the occupied west line of the N.E. 1/4 of the N.W. 1/4 with the centerline of the 9th Avenue pavement. I established this property using existing monumentation for the parcel north of and adjacent to the above described property for North-South position and the existing monumented West line of Linden Oaks Drive for East-West position (the existing location of Linden Oaks Drive does not conform to the narrative in Document #441700 which establishes Linden Oaks Drive).

NORTH LINE
OF N.W. 1/4
SECTION 29

N. 1/4 CORNER
SECTION 29-18-16
BERNTSEN
MONUMENT


○ ----- DENOTES 3/4" DIAMETER IRON ROD FOUND.

○ ----- DENOTES 1" DIAMETER IRON PIPE SET.

N89°41'29"W

9th AVENUE

FENCE ALONG
OCCUPIED WEST
LINE OF N.E. 1/4
OF N.W. 1/4
SECTION 29
(FENCE BEARS
N00°36'W)

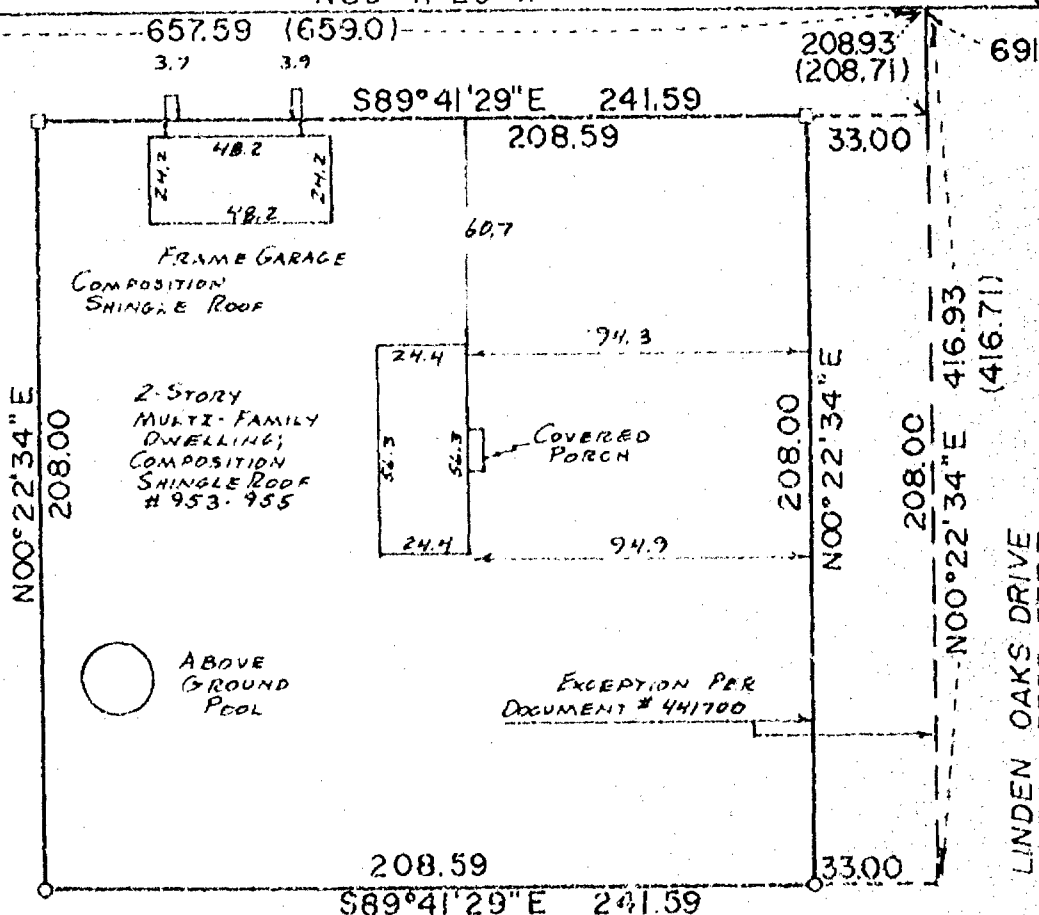

SCALE 1" = 50'


I Certify that I have surveyed the above described property (Property), and the above map is a true representation thereof and shows the size and location of the Property, its exterior boundaries, the location and dimensions of all visible structures thereon, boundary, fences, apparent easements and roadways and visible encroachments, if any.

This survey is made for the exclusive use of the present owners of the Property, and also those who purchase, mortgage, or guarantee the title thereto, within one (1) year from date hereof.



national survey & engineering

417 NORTH SAWYER STREET / P.O. BOX 2963
OSHKOSH, WISCONSIN 54903
(414) 426-2800

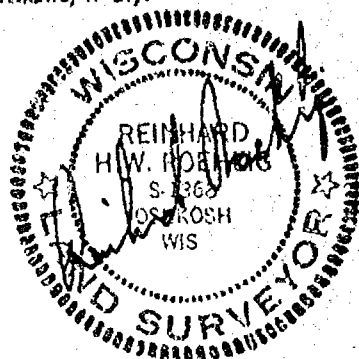

PLAT OF SURVEY


KNOWN AS 2899 WEST 9TH AVENUE. BEING THE WEST 264.0 FT. OF THE EAST 825.0 FT. OF THE NORTH 165.0 FT. OF THE N.E. 1/4 OF THE N.E. 1/4 OF SECTION 29, T18N, R14E, IN THE TOWN OF ALGOMA, WINNEBAGO COUNTY, WISCONSIN.

JULY 9, 1984

SURVEY FOR OSHKOSH SAVINGS
APPLICANT: GERALD SCHMIEDEL

SURVEY NO. 1485--S

0 ————— DENOTES 1 INCH DIAMETER IRON PIPE SET.

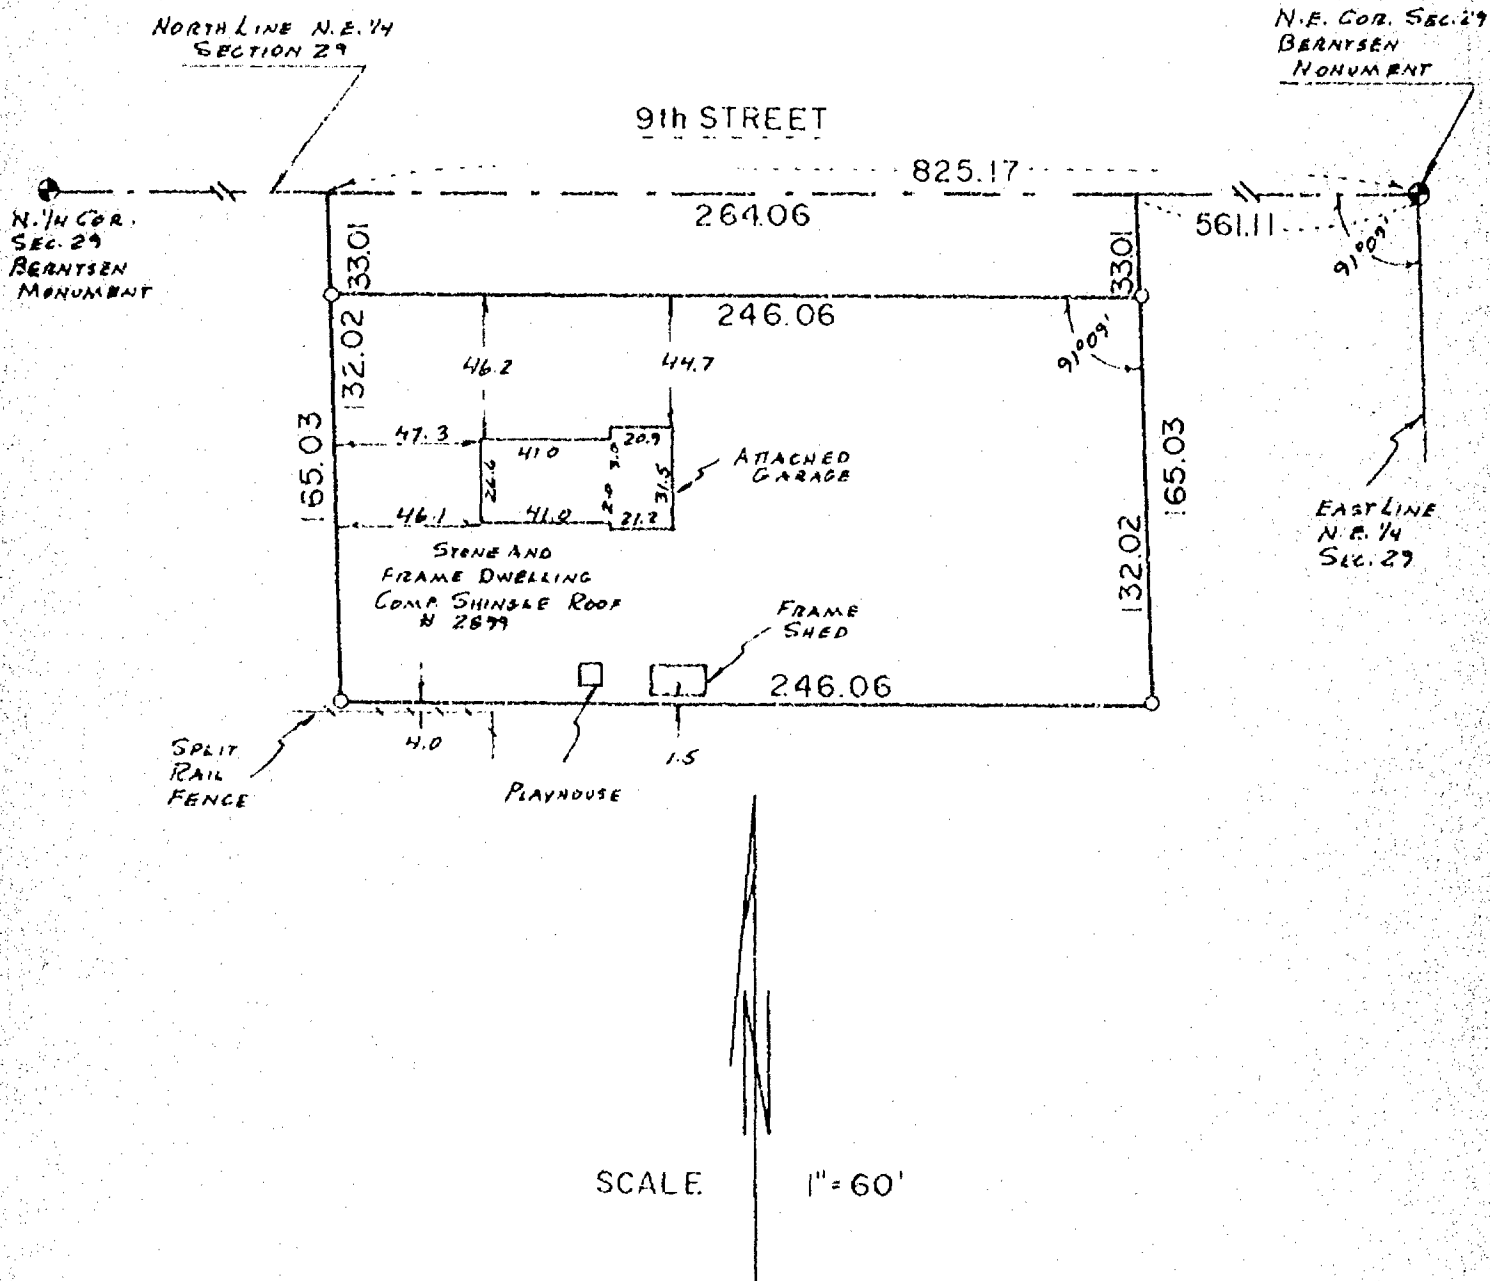


I Certify that I have surveyed the above described property (Property), and the above map is a true representation thereof and shows the size and location of the Property, its exterior boundaries, the location and dimensions of all visible structures thereon, boundary, fences, apparent easements and roadways and visible encroachments, if any. This survey is made for the exclusive use of the present owners of the Property, and also those who purchase, mortgage, or guarantee the title thereto, within one (1) year from date hereof.




national survey & engineering

417 NORTH SAWYER STREET / P.O. BOX 2563
OSHKOSH, WISCONSIN 54903
(414) 426-2800

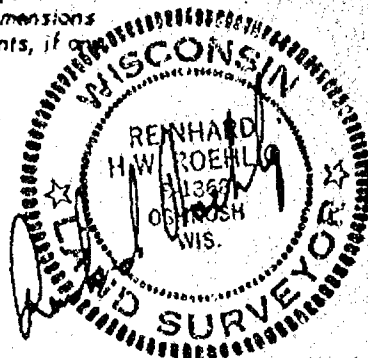

NORTH LINE OF SECTION 29
(CENTERLINE OF 9TH ST. RD (66'))

NORTH ¼ CORNER OF
SECTION 29-18-16

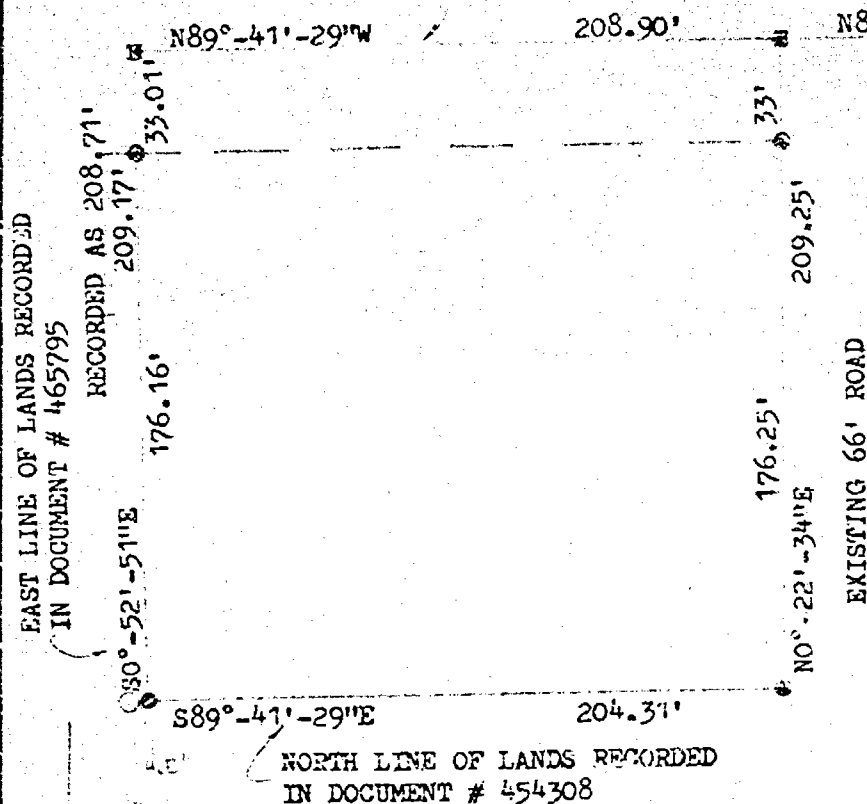

DESCRIPTION: A PARCEL OF LAND LOCATED IN THE NE ¼ OF THE NW ¼ OF SECTION 29, T18N, R16E, TOWN OF ALGOMA, WINNEBAGO COUNTY, WISCONSIN. MORE FULLY DESCRIBED AS FOLLOWS: COMMENCING AT THE NORTH ¼ CORNER OF SECTION 29; THENCE N89°-41'-29\"W, 724.72 FEET ALONG THE NORTH LINE OF SECTION 29 TO THE POINT OF BEGINNING; THENCE CONTINUING N89°-41'-29\"W, 208.90 FEET ALONG SAID NORTH LINE TO THE EAST LINE OF LANDS RECORDED IN DOCUMENT # 465795; THENCE S0°-52'-51\"E, 209.17 FEET (RECORDED AS 208.71 FEET) ALONG SAID EAST LINE TO A POINT ON THE NORTH LINE OF LANDS RECORDED IN DOCUMENT # 454308; THENCE S89°-41'-29\"E, 204.31 FEET ALONG SAID NORTH LINE TO THE WEST LINE OF A 66 FOOT ROAD; THENCE N0°-22'-34\"E, 209.25 FEET ALONG SAID WEST LINE TO THE POINT OF BEGINNING. SAID PARCEL OF LAND CONTAINING 0.99 ACRES OF LAND MORE OR LESS. SUBJECT TO ALL EASEMENTS AND RESTRICTIONS OF RECORD. RESERVING THAT PART PRESENTLY USED FOR ROAD PURPOSES.



I, ROBERT F. REIDER, CERTIFY THAT THIS PLAT OF SURVEY IS A CORRECT REPRESENTATION OF THE ABOVE DESCRIBED PROPERTY.

- ⊙ = BERNTSEN MONUMENT FOUND
- ⊙ = 3/4 x 24\" SOLID ROUND #6 IRON REBAR SET
- ⊙ = PK NAIL SET

REVISIONS		HARRY GUNNING	
		3120 W. 9TH ST. DR. OSHKOSH, WISCONSIN 54901	
		CAROW LAND SURVEYING CO., INC., P.O. BOX 1297	
		1837 W. WISCONSIN AVE. • APPLETON, WI 54912	
DRAWN BY	TFH	SCALE	DRAWING NO.
TF-KV	LEE	1\"=60'	A8111.16
DATE		11-9-81	

29-18-16


PLAT OF SURVEY

KNOWN AS 3374 WEST 20th AVENUE, BEING THE EAST 104.0 FT. FRONT AND REAR OF THE SOUTH 208.0 FT. OF THE S.W. 1/4 OF THE S.W. 1/4 OF SECTION 29, T18N, R16E, IN THE TOWN OF ALGONA, WINNEBAGO COUNTY, WISCONSIN.

JULY 26, 1983

SURVEY FOR OSHKOSH SAVINGS
AND NANCY BONGERT

SURVEY NO. 1270-S

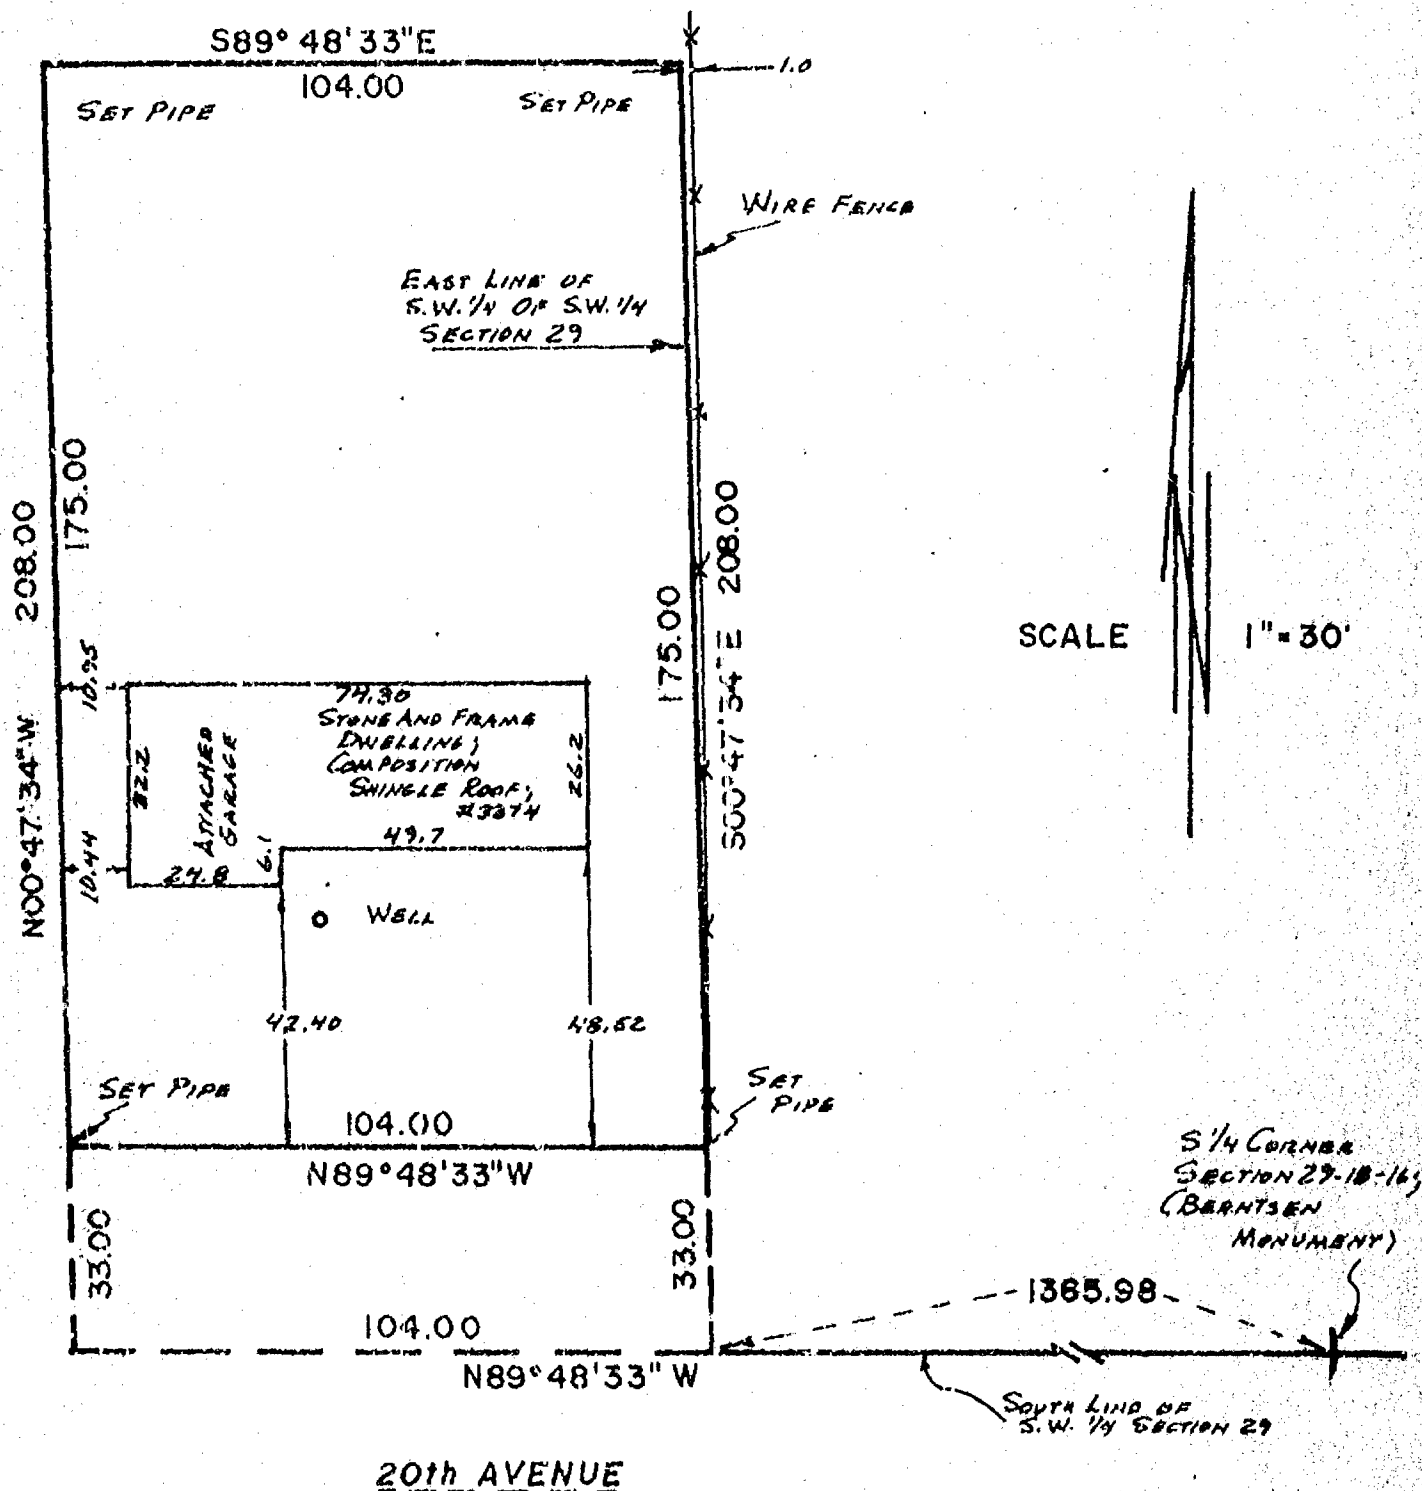


I Certify that I have surveyed the above described property (Property), and the above map is a true representation thereof and shows the size and location of the Property, its exterior boundaries, the location and dimensions of all visible structures thereon, boundary, fences, apparent easements and roadways and visible encroachments, if any.

This survey is made for the exclusive use of the present owners of the Property, and also those who purchase, mortgage, or guarantee the title thereto, within one (1) year from date hereof.



national survey & engineering

417 NORTH SAWYER STREET / P.O. BOX 2963
OSHKOSH, WISCONSIN 54903
(414) 426-2800

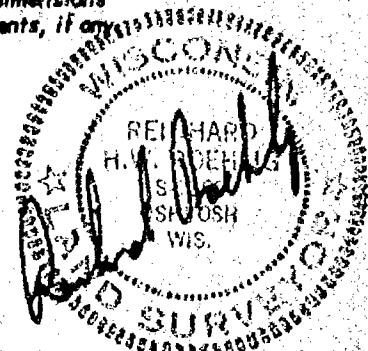


PLAT OF SURVEY

KNOWN AS 1571 SOUTH OAKWOOD ROAD. A PARCEL OF LAND LOCATED IN THE S.E. 1/4 OF THE N.E. 1/4 OF SECTION 29, T19N, R16E, IN THE TOWN OF ALGOMA, WINNEBAGO COUNTY, WISCONSIN WHICH IS BOUNDED AND DESCRIBED AS FOLLOWS; BEGINNING AT THE E. 1/4 CORNER OF SAID SECTION 29, THENCE NORTH 111.70 FT. ALONG THE EAST LINE OF THE N.E. 1/4 OF SAID SECTION 29 TO A POINT, THENCE NORTH 89°16'44" WEST 600.00 FT. TO A POINT, THENCE SOUTH 111.70 FT. TO A POINT, THENCE SOUTH 89°16'44" EAST ALONG THE SOUTH LINE OF SAID N.E. 1/4 AFORESAID 600.00 FT. TO THE PLACE OF BEGINNING. SAID PARCEL CONTAINS 1.538 ACRES, THE EAST 33.00 FT. OF THE ABOVE DESCRIBED PARCEL IS SUBJECT TO THE RIGHTS OF THE PUBLIC FOR ROAD PURPOSES.

JULY 17, 1981

(SURVEY FOR JUDY & JOSEPH TROUDT)

SURVEY NO. 183-S

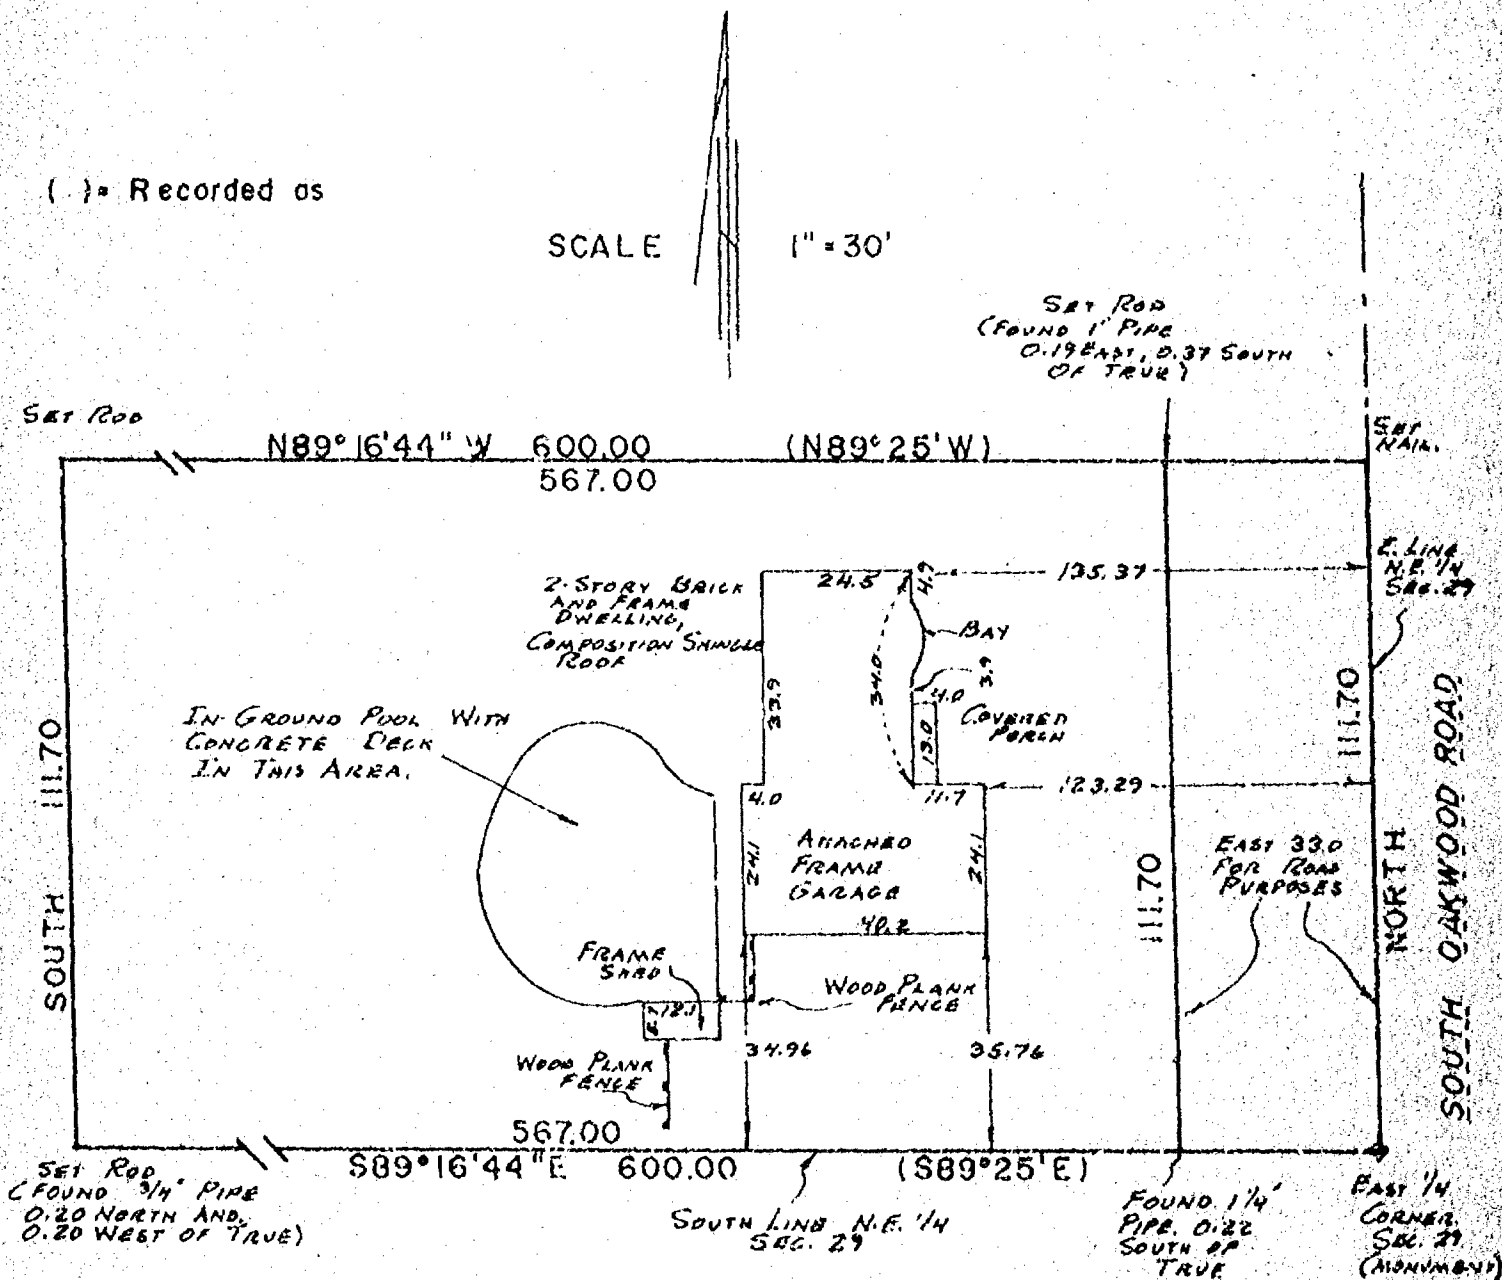

I Certify that I have surveyed the above described property (Property), and the above map is a true representation thereof and shows the size and location of the Property, its exterior boundaries, the location and dimensions of all visible structures thereon, boundary, fences, apparent easements and roadways and visible encroachments, if any.


This survey is made for the exclusive use of the present owners of the Property, and also those who purchase, mortgage, or guarantee the title thereto, within one (1) year from date hereof.



national survey & engineering

417 NORTH SAWYER STREET / P.O. BOX 2863
OSHKOSH, WISCONSIN 54903
(414) 428-2800


Ronald Reilly

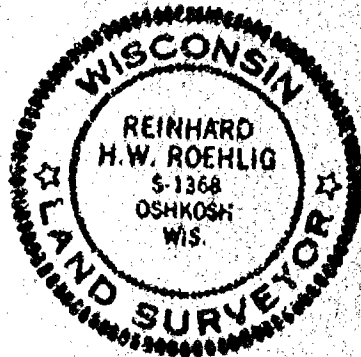

WINNEBAGO COUNTY CERTIFIED SURVEY MAP NO. 355.

Part of the SW $\frac{1}{4}$ of the SW $\frac{1}{4}$ of Sec. 29, T.18N., R.16E., Town of Algoma

ADDITION TO EXISTING PARCEL DESCRIBED IN VOL. 1316 P. 470

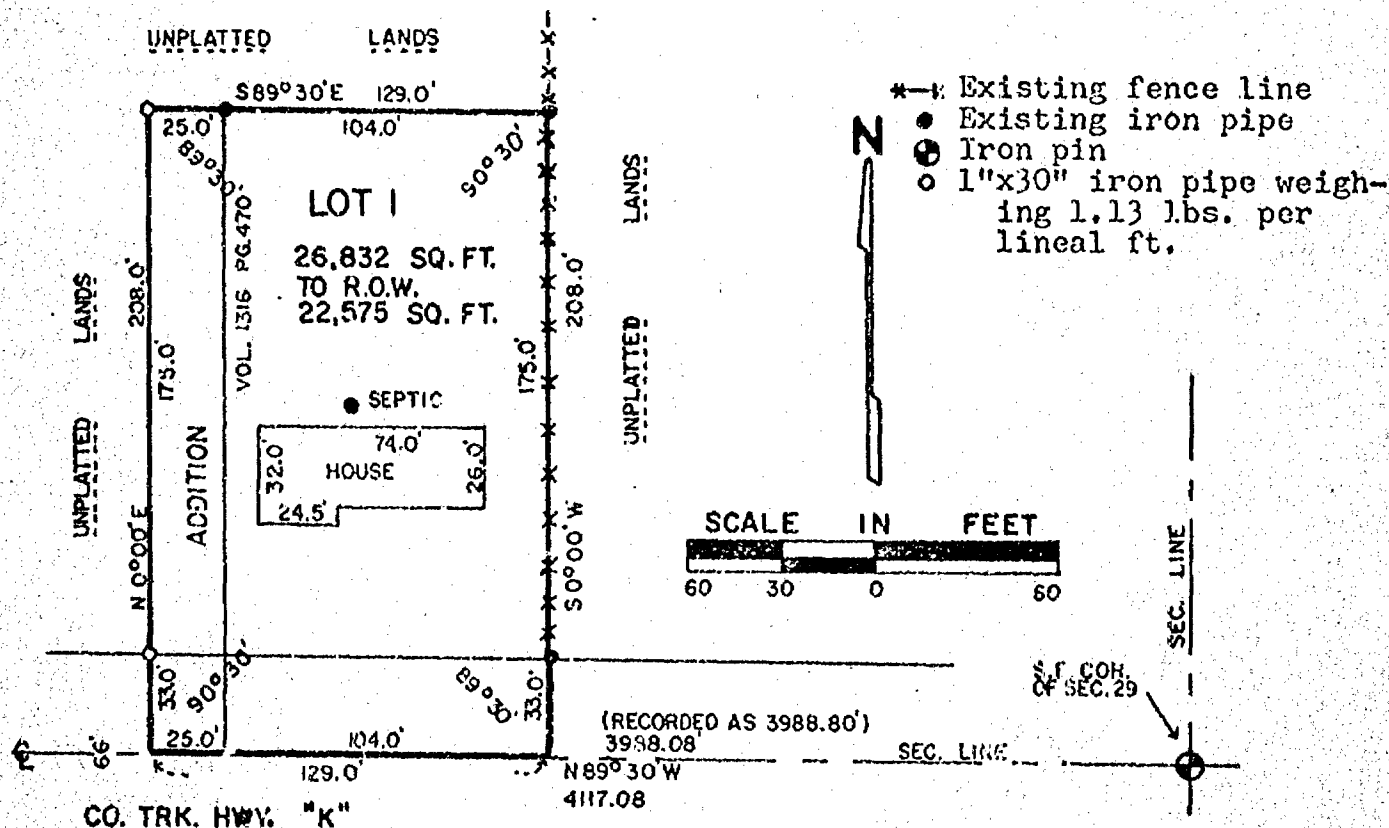


Bearings are referenced to the East line of Sec. 29, assumed bearing, N0°00'00"E.

I, Calvin W. Hawksworth, registered land surveyor, hereby certify:

That I have surveyed, divided and mapped the parcel of land located in part of the SW $\frac{1}{4}$ of the SW $\frac{1}{4}$ of Sec. 29, T.18N., R.16E. in the Town of Algoma, Winnebago County, Wisconsin, described as follows: Beginning at a point on the centerline of Co. Trk. Hwy. "K" that is 4117.08 ft., N89°30'W of the SE corner of said Sec. 29. From that point running N0°00'E, 208.00 ft., thence S89°30'E, 129.00 ft., thence S0°00'W, 208.00 ft. to the centerline of Co. Trk. Hwy. "K", thence N89°30'W along said centerline, 129.00 ft. to the said point of beginning. Being a parcel of land of 26,832.00 sq. ft. Said parcel being the same as that described in Vol. 1316, P. 470 of Winnebago County Records, plus an additional 25.00 ft. on the West side of same.

That I have made such survey, land division and map by the direction of Kenneth W. Neubauer, 1925 Clairville Rd., Oshkosh, Wisconsin, 54901; that such map is a true and correct representation of the exterior boundaries of the land surveyed.

That I have fully complied with the provisions of Sec. 236.34 of the Wisconsin Statutes in surveying and mapping the same.

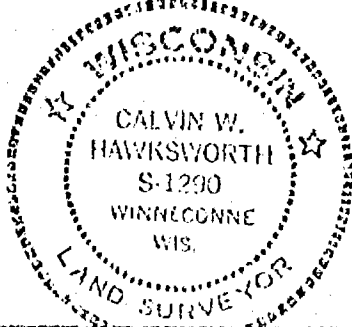

Calvin W. Hawksworth
Calvin W. Hawksworth S-1290
Wisconsin Registered Land Surveyor
May 26, 1978.

Sheet 1 of 2 sheets

WINNEBAGO COUNTY CERTIFIED SURVEY MAP NO. 355
Part of the SW $\frac{1}{4}$ of the SW $\frac{1}{4}$ of Sec. 29, T.18N., R.16E., Town of
Algoma

OWNER'S CERTIFICATE

As owners, we hereby certify that we caused the land described on this Certified Survey Map to be surveyed, divided and mapped as represented hereon.

WITNESS the hand and seal of said owners this 15th day of June, 1978.
In presence of:

Witness

Kenneth W. Neubauer
Owner(s)
1925 Clairville Rd.
Address
Oshkosh Wisc 54901
City-State Zip

Virginia T. Neubauer
Owner(s)
1925 Clairville Road
Address
Oshkosh Wisc. 54901
City-State Zip

STATE OF WISCONSIN) SS
WINNEBAGO COUNTY)

Personally came before me this 15th day of June, 1978, the above named Kenneth W. Neubauer and Virginia V. Neubauer to me known to be the persons who executed the foregoing instrument and acknowledged the same.

James J. Mueller
Notary Public, Winnebago Co., Wisc.

My commission ~~expires~~ is permanent


WINNEBAGO COUNTY PLANNING COMMITTEE CERTIFICATE

This Certified Survey Map of part of the SW $\frac{1}{4}$ of the SW $\frac{1}{4}$ of Sec. 29, T.18N, R.16E., Town of Algoma is hereby approved.

June 21, 1978
Date

Robert M. Hunter DNR
Authorized Representative
Winnebago Co. Planning Committee

Calvin W. Hawksworth
Calvin W. Hawksworth S-1290
Wisconsin Registered Land Surveyor
May 26, 1978.

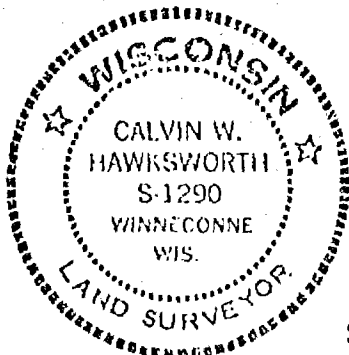

Sheet 2 of 2 sheets



Registered's Office
Winnebago County, Wis.
Recorded for record this 22nd day of June A.D. 1978
at 1:00 o'clock P.M. in
recorded in Vol. 1 of S.M. 355
on page 355
Deane S. Proyer
Deputy Registrar of Deeds

517813

Mueller - Roster 260

WINNEBAGO COUNTY CERTIFIED SURVEY MAP NO. 356
 Part of the SW $\frac{1}{4}$ of the SW $\frac{1}{4}$ of Sec. 29, T.18N., R.16E., Town of Algoma

Bearings are referenced to the East line of Sec. 29, assumed bearing, NO $^{\circ}$ 00'00"E.

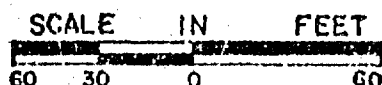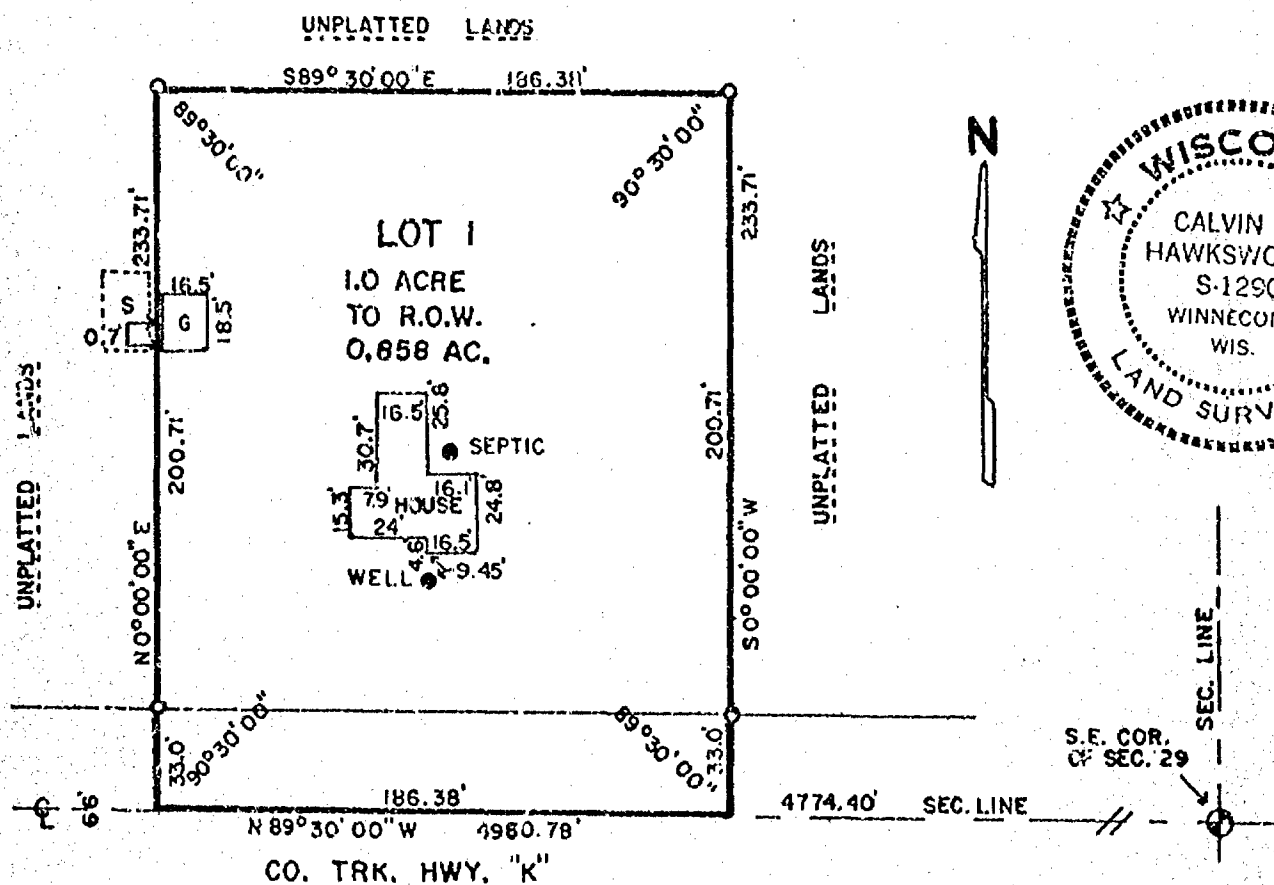

- ⊕ Iron pin
- 1"x30" iron pipe weighing 1.13 lbs./lineal ft.

I, Calvin W. Hawksworth, registered land surveyor, hereby certify:

That I have surveyed, divided and mapped the parcel of land located in the SW $\frac{1}{4}$ of the SW $\frac{1}{4}$ of Sec. 29, T.18N., R.16E., in the Town of Algoma, Winnebago County, Wisconsin, described as follows: Beginning at a point on the centerline of Co. Trk. Hwy. "K" that is 4,960.78 ft., N89°30'00"W of the SE corner of said Sec. 29. From that point running NO°00'00"E, 233.71 ft., thence S89°30'00"E, 186.38 ft., thence S0°00'00"W, 233.71 ft. to the centerline of Co. Trk. Hwy. "K", thence N89°30'00"W along said centerline, 186.38 ft. to the said point of beginning. Being a parcel of land of 1.00 acre, more or less.

That I have made such survey, land division and map by the direction of Kenneth W. Neubauer, 1925 Clairville Rd., Oshkosh, Wisconsin, 54901; that such map is a true and correct representation of the exterior boundaries of the land surveyed.

That I have fully complied with the provisions of Sec. 236.34 of the Wisconsin Statutes in surveying and mapping the same.

Calvin W. Hawksworth
 Calvin W. Hawksworth S-1290
 Wisconsin Registered Land Surveyor
 May 26, 1978.

Sheet 1 of 2 sheets

WINNEBAGO COUNTY CERTIFIED SURVEY MAP NO. 356.
Part of the SW $\frac{1}{4}$ of the SW $\frac{1}{4}$ of Sec. 29, T.18N., R.16E., Town of Algoma

OWNER'S CERTIFICATE

As owner(s) I(we) hereby certify that I(we) caused the land described on this Certified Survey Map to be surveyed, divided and mapped as represented hereon.

WITNESS the hand and seal of said owner(s) this 15th day of June, 1978.

In presence of:

Witness _____

+ Kenneth W. Neubauer
+ Virginia V. Neubauer
Owner(s)
1925 Clairville Road
Address
Oakbush, Wisc. 54901
City-State 210

STATE OF WISCONSIN) SS
WINNEBAGO COUNTY)

Personally came before me this 15th day of June 1978, the above named Kenneth W. Neubauer & Virginia V. Neubauer to me known to be the person(s) who executed the foregoing instrument and acknowledged the same.

Jama J. Mueller
Notary Public, Winnebago County, Wisconsin

My commission ~~expires~~ is permanent.


WINNEBAGO COUNTY PLANNING COMMITTEE CERTIFICATE

This Certified Survey Map of part of the SW $\frac{1}{4}$ of the SW $\frac{1}{4}$ of Sec. 29, T.18N., R.16E., Town of Algoma is hereby approved.

June 21, 1978
Date

Robert M. Hurlbut
Authorized representative
Winnebago Co. Planning Committee

Calvin W. Hawksworth
Calvin W. Hawksworth S-1290
Wisconsin Registered Land Surveyor
May 26, 1978.

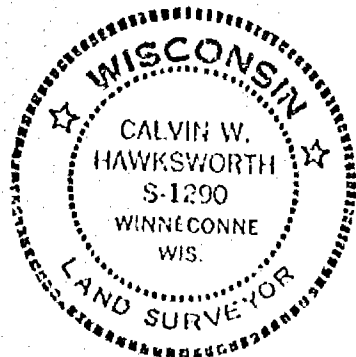

Registered Office
Winnebago County, Wis.
Received for record this 22nd day of June A.D. 1978
at 10:00 o'clock P.M. and
recorded in Vol. 1 of 5 maps
on page 356
James C. Pfeiffer
Register of Deeds

Mueller + Rottier 2.60

zoning

25-S

SHEET 1 of 3


CERTIFIED SURVEY MAP NO. 54D

BEING A PART OF THE S.W. 1/4 OF THE N.W. 1/4 OF SECTION 29, T18N, R16E,
IN THE TOWN OF ALGOMA, WINNEBAGO COUNTY, WISCONSIN.

○ ——— DENOTES 1 INCH DIAMETER IRON PIPE, 24" LONG, WEIGHT
1.13 LBS. PER LINEAL FOOT.

ALL DIMENSIONS SHOWN ARE MEASURED TO THE NEAREST HUNDREDTH OF A FOOT.

NORTH IS REFERENCED TO THE WEST LINE OF THE N.W. 1/4 OF SECTION 29
WITH AN ASSUMED BEARING OF DUE NORTH AND SOUTH.

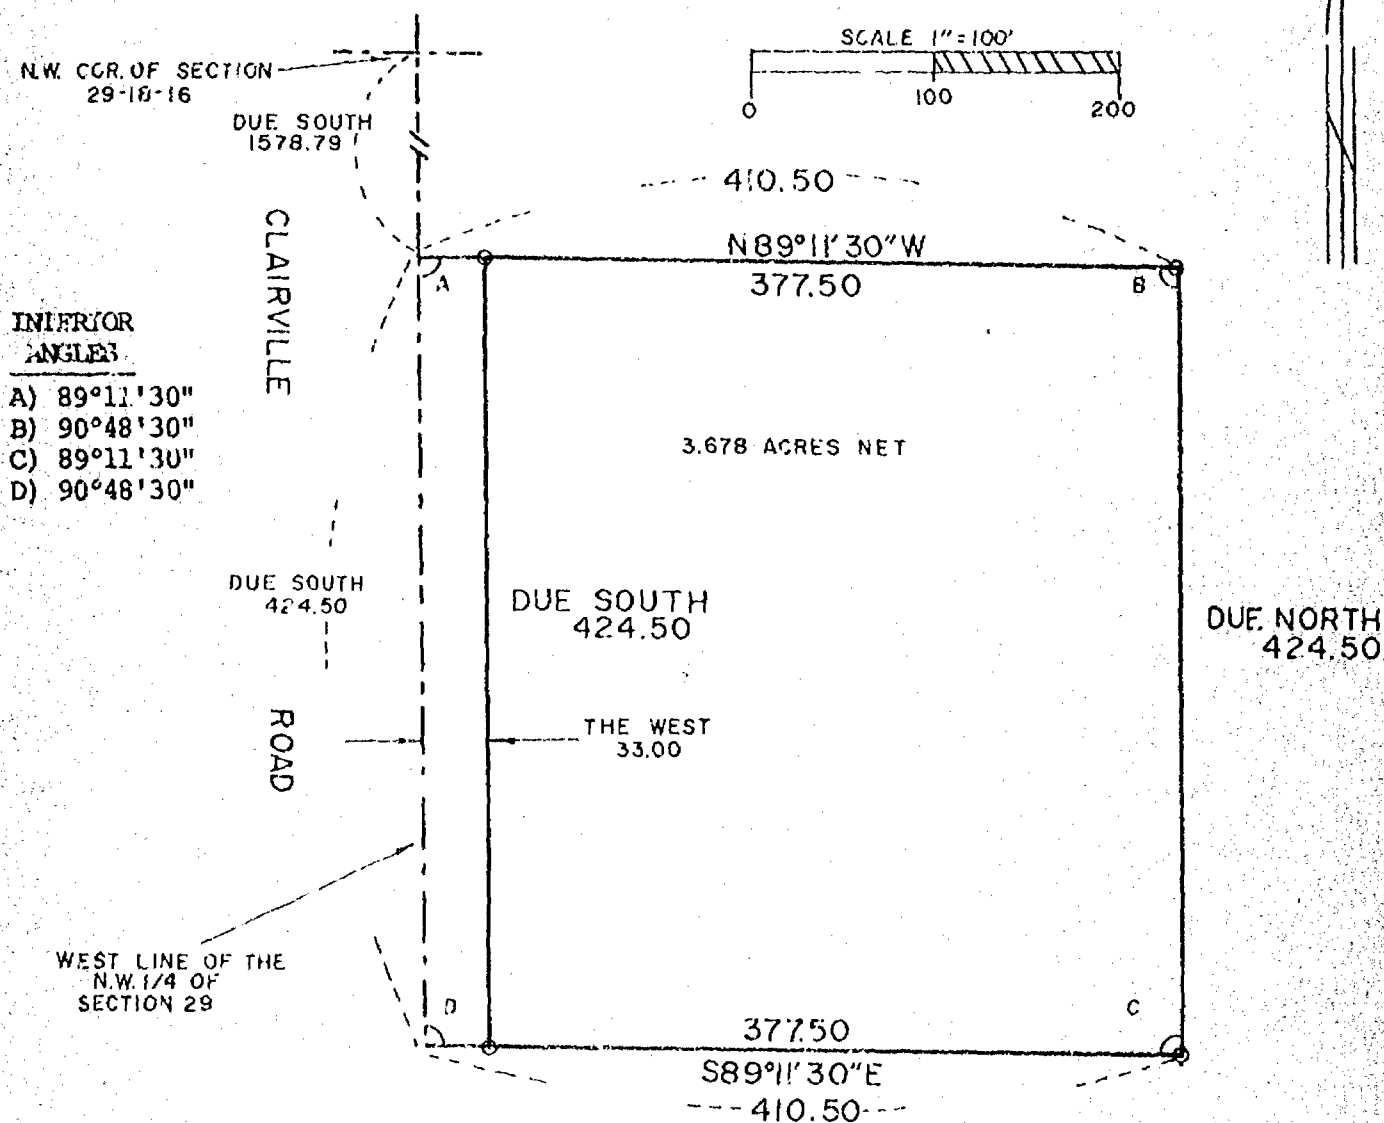

national survey & engineering

P.O. BOX 2963
OSHKOSH, WIS. 54901



CERTIFIED SURVEY MAP NO. 540

BEING A PART OF THE S.W. 1/4 OF THE N.W. 1/4 OF SECTION 29, T18N, R16E,
IN THE TOWN OF ALGOMA, WINNEBAGO COUNTY, WISCONSIN.

SURVEYOR'S CERTIFICATE
STATE OF WISCONSIN)

:SS

WINNEBAGO COUNTY)

I, REINHARD ROEHLIG, Wisconsin land surveyor, do hereby certify:

THAT I have surveyed and mapped a part of the S.W. 1/4 of the
N.W. 1/4 of Section 29, T18N, R16E, Town of Algoma, Winnebago County,
Wisconsin which is bounded and described as follows:

Commencing at the N.W. corner of Section 29, thence Due South
1578.79 ft. to the true point of beginning, thence continuing Due South
424.50 ft. to a point, thence S39°11'30"E 410.50 ft. to a point, thence
Due North 424.50 ft. to a point, thence N89°11'30"W 410.50 ft. to the
point of beginning. Excepting the West 33.00ft. for road purposes.


THAT I have made this survey and land division and map by
the direction of NICK KOLB and SELMA KOLB, his wife, Town of Algoma,
Winnebago County, Wisconsin, owners of said land.

THAT such map is a correct representation of all exterior
boundaries of the land division thereof made.

THAT I have fully complied with the provisions of Chapter 236
of the Wisconsin Statutes and the Land Subdivision Ordinance of Winnebago
County.

2-2-22
Date

Reinhard Roehlig (SEAL)
Reinhard Roehlig, Registered
Land Surveyor S-1368

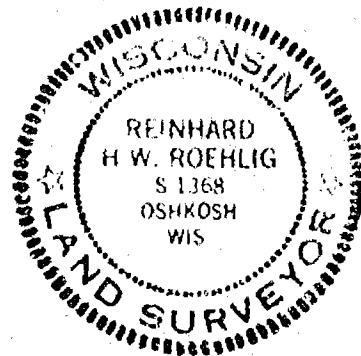

CERTIFIED SURVEY MAP NO. 540

BEING A PART OF THE S.W. 1/4 OF THE N.W. 1/4 OF SECTION 29, T18N, R16E,
IN THE TOWN OF ALGOMA, WINNEBAGO COUNTY, WISCONSIN.

OWNER'S CERTIFICATE

AS OWNERS we hereby certify that we caused the land described
on this map to be surveyed and mapped as represented on this map in
accordance with the Winnebago County Subdivision Ordinance.

WITNESS the hands and seals of said owners this 15th
day of March 1979

In The Presence of:

Diane Witzke
Diane Witzke

Nick Kolb
Nick Kolb

Robert C. Wertsch
Robert C. Wertsch

Selma Kolb
Selma Kolb

STATE OF WISCONSIN)
:SS
WINNEBAGO COUNTY)

PERSONALLY came before me this 15th day of March 1979
the above named Nick Kolb and Selma Kolb, his wife, to me known to be
the persons who executed the foregoing instrument and acknowledged the
same.

Robert C. Wertsch (SEAL)
NOTARY PUBLIC, WINNEBAGO COUNTY,
STATE OF WISCONSIN

My Commission is permanent.


WINNEBAGO COUNTY PLANNING COMMITTEE CERTIFICATE

THIS Certified Survey Map of a part of the S.W. 1/4 of the
N.W. 1/4 of Section 29, T18N, R16E, Town of Algoma, Nick Kolb and
Selma Kolb, owners, is hereby approved.

Date March 16, 1979

Robert M. Hunter
Chairman

THIS INSTRUMENT WAS DRAFTED BY REINHARD ROEHLIG

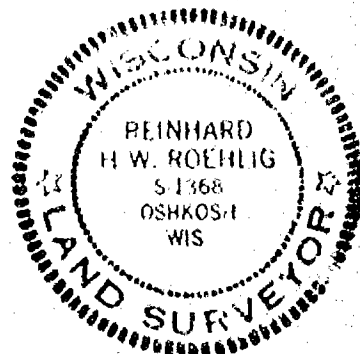




530743

Register's Office
Winnebago County, Wis.
Received for record this 20th
day of March... A.D., 19 79
at 8:02... o'clock A.M. and
recorded in Vol. 1... of S. Maps
in page 540.....

Allen M. Payne
REGISTER OF DEEDS

Weston chg
200

BEING PART OF THE NE ¼ OF THE NW ¼ OF SECTION 29, T18N., R16E, TOWN OF ALGOMA,
WINNEBAGO COUNTY, WISCONSIN.

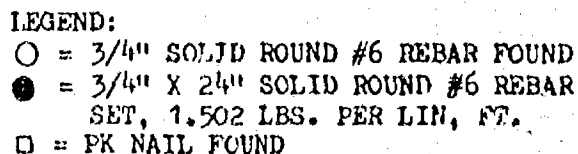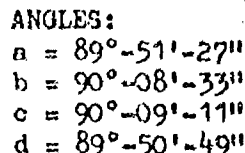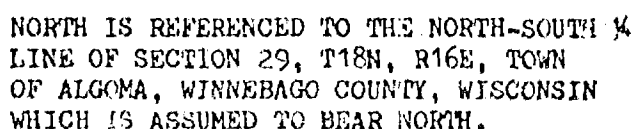

I, ROBERT F. REIDER, REGISTERED WISCONSIN LAND SURVEYOR, HEREBY CERTIFY THAT I HAVE SURVEYED, DIVIDED AND MAPPED PART OF THE NE $\frac{1}{4}$ OF THE NW $\frac{1}{4}$ OF SECTION 29, T18N, R16E, TOWN OF ALGOMA, WINNEBAGO COUNTY, WISCONSIN, BOUNDED AND DESCRIBED AS FOLLOWS: COMMENCING AT THE NORTH $\frac{1}{4}$ CORNER OF SECTION 29, THENCE SOUTH, 1114.51 FEET ALONG THE NORTH-SOUTH $\frac{1}{4}$ LINE OF SECTION 29, THENCE N88°-53'-20"W, 750.55 FEET TO THE POINT OF BEGINNING, THENCE CONTINUING N88°-53'-20"W, 175.71 FEET, THENCE N1°-15'-51"E, 217.04 FEET, THENCE S88°-35'-36"E, 175.71 FEET, THENCE S1°-15'-51"W, 216.10 FEET TO THE POINT OF BEGINNING. SAID PARCEL OF LAND CONTAINING 0.87 ACRES OF LAND MORE OR LESS. SUBJECT TO ALL EASEMENTS AND RESTRICTIONS OF RECORD.

THAT I HAVE MADE SUCH SURVEY AND MAP UNDER THE DIRECTION OF MRS. HARRY GUNNING, 3120. W. 9th ST RD. OSHKOSH, WISCONSIN 54901

THAT THIS MAP IS A CORRECT REPRESENTATION OF THE EXTERIOR BOUNDARY LINES OF THE LAND SURVEYED.

THAT I HAVE COMPLIED WITH THE PROVISIONS OF CHAPTER 236.34 OF THE WISCONSIN STATUTES AND THE SUBDIVISION REGULATIONS OF WINNEBAGO COUNTY.

Robert F. Reider 7-18-79
 ROBERT F. REIDER, RLS-1251 DATED
 CAROW LAND SURVEYING CO., INC.
 604 N. RICHMOND ST.
 APPLETON, WISCONSIN 54911 A-7411

CERTIFIED SURVEY MAP NO. _____

OWNER'S CERTIFICATE:


AS OWNER, I HEREBY CERTIFY THAT I HAVE CAUSED THE LAND DESCRIBED ON THIS CERTIFIED SURVEY MAP TO BE SURVEYED, DIVIDED AND MAPPED AS REPRESENTED. I ALSO CERTIFY THAT THIS MAP IS REQUIRED BY S. 236.10 OR S. 236.12 OF THE WISCONSIN STATUTES TO BE SUBMITTED TO THE FOLLOWING FOR APPROVAL: WINNEBAGO COUNTY PLANNING AND ZONING COMMITTEE.

WITNESS THE HAND AND SEAL OF SAID OWNER THIS _____ DAY OF _____, 1979.

OWNER_____
OWNER_____
WITNESS

PURSUANT TO THE WINNEBAGO COUNTY SUBDIVISION ORDINANCE, ALL REQUIREMENTS FOR APPROVAL HAVE BEEN FULFILLED. THIS CERTIFIED SURVEY MAP WAS APPROVED ON THE _____ DAY OF _____, 1979.

CHAIRMAN, WINNEBAGO COUNTY
PLANNING AND ZONING COMMITTEE

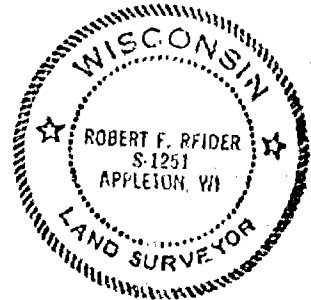

Robert F. Reider 7-18-79
 ROBERT F. REIDER, RLS. 1251 DATED
 CAROW LAND SURVEYING CO., INC.
 604 N. RICHMOND ST.
 APPLETON, WISCONSIN 54911
 (rr kv BF 7-17-79)
 A-7411-79


NW CORNER OF THE NE $\frac{1}{4}$ OF THE NW $\frac{1}{4}$
SEC. 29, T18N, R16E

DESCRIPTION:

A PARCEL OF LAND IN THE NE $\frac{1}{4}$ OF THE NW $\frac{1}{4}$ OF SECTION 29, T18N, R16E, TOWN OF ALGOMA, WINNEBAGO CO., WISCONSIN, BOUNDED AND DESCRIBED AS FOLLOWS: COMMENCING AT THE NW CORNER OF SAID NE $\frac{1}{4}$ OF THE NW $\frac{1}{4}$; THENCE DUE EAST ALONG THE NORTH LINE OF SECTION 29, 379.06 FEET TO THE POINT OF BEGINNING; THENCE CONTINUING DUE EAST ALONG SAID LINE, 104.35 FEET; THENCE DUE SOUTH, 208.71 FEET; THENCE DUE WEST, 104.35 FEET; THENCE DUE NORTH, 208.71 FEET TO THE POINT OF BEGINNING. CONTAINING 0.5 ACRES OF LAND MORE OR LESS. LESS AND EXCEPTING THE NORTH 33.00 FEET THEREOF PRESENTLY BEING USED FOR ROAD PURPOSES.



NOTE: NORTH IS REFERENCED TO THE NORTH LINE OF SECTION 29, WHICH IS ASSUMED TO BEAR DUE EAST.

o = IRON

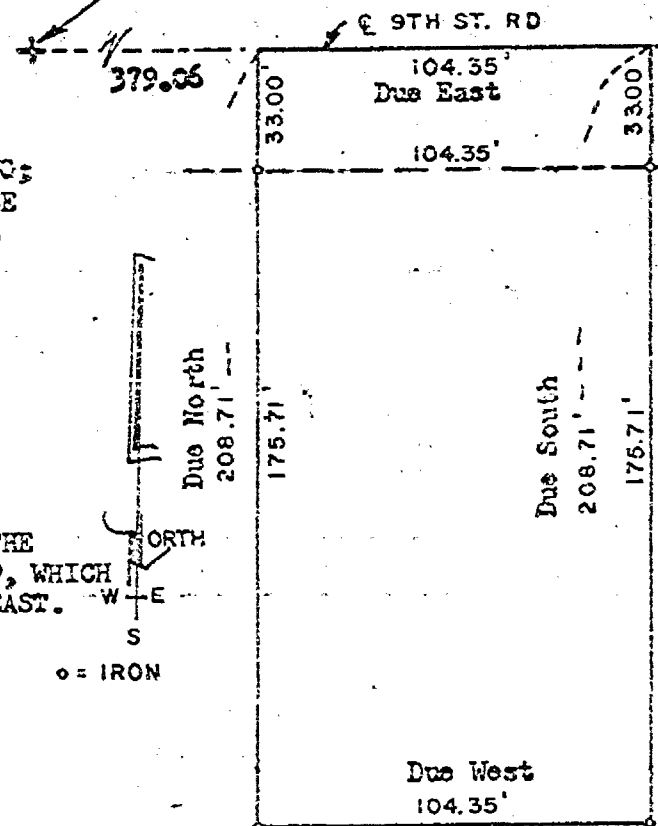


REVISIONS			CAROW LAND SURVEYING CO. 604 N. RICHMOND ST. APPLETON, WIS.		
NO.	DATE	BY			
1			SURVEY FOR MALLIET BUILDERS INC. NEENAH, WIS. OF A PARCEL OF LAND IN SEC. 29-18-16, TOWN OF ALGOMA, WINNEBAGO CO., WIS.		
2					
3			DRAWN BY LEC	SCALE 1" = 50'	MATERIAL
4			CHK'D LEC	DATE 4-21-70	DRAWING NO.
5			TRACED	APP'D LEC	A153-70

NO. 17540-2 1/2 X 11

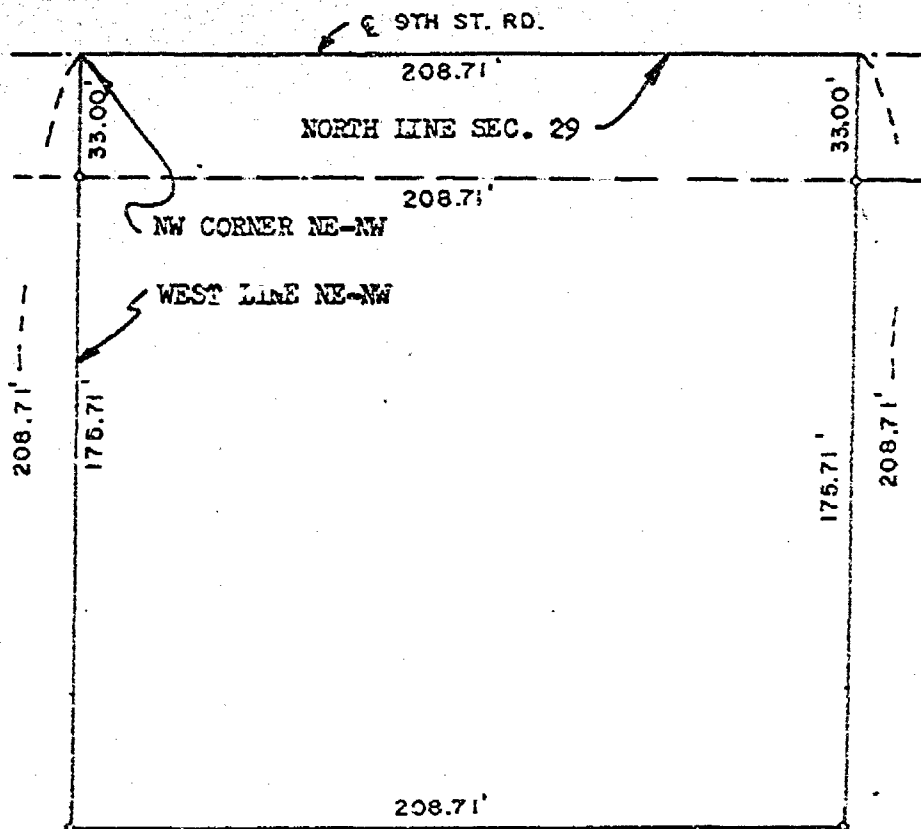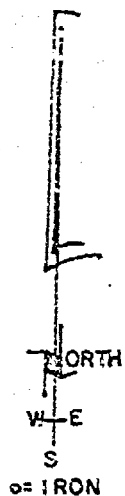

DESCRIPTION: A PARCEL OF LAND IN THE NE $\frac{1}{4}$ OF THE NW $\frac{1}{4}$ OF SECTION 29, T18N, R16E, TOWN OF ALGOMA, WINNEBAGO COUNTY, WISCONSIN, DESCRIBED AS FOLLOWS: THE NORTH 208.71 FEET OF THE WEST 208.71 FEET OF SAID NE $\frac{1}{4}$ OF THE NW $\frac{1}{4}$. CONTAINING 1.0 ACRES OF LAND MORE OR LESS. LESS AND EXCEPTING THE NORTH 33.00 FEET THEREOF PRESENTLY BEING USED FOR ROAD PURPOSES.

REVISIONS			CAROW LAND SURVEYING CO. 604 N. RICHMOND ST. APPLETON, WIS.		
NO.	DATE	BY	SURVEY FOR H. G. GUNNING, 3120 W. 9TH ST. RD. OSHKOSH OF LAND IN SEC. 29-18-16, TOWN OF ALGOMA, WINNEBAGO CO., WIS.		
1					
2					
3			DRAWN BY LEC	SCALE 1"=50'	MATERIAL
4			CHK'D LEC	DATE 4-21-70	DRAWING NO.
5			TRACED	APP'D LEC	A 152-70

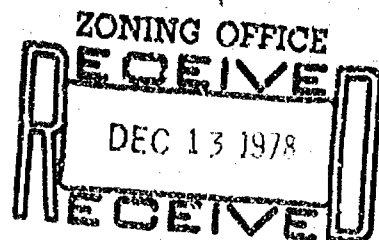

CERTIFIED SURVEY MAP NO. 492

BEING PART OF THE NE ¼ OF THE NW ¼ OF SECTION 29, T18N, R16E, TOWN OF ALGOMA,
WINNEBAGO COUNTY, WISCONSIN.

NORTH IS REFERENCED TO THE NORTH-SOUTH ¼
LINE OF SECTION 29, T18N, R16E, TOWN OF
ALGOMA, WINNEBAGO COUNTY, WISCONSIN WHICH
IS ASSUMED TO BEAR NORTH.

ANGLES:



a = 88°-53'-20" b = 91°-06'-40"

LEGEND:

□ = PK NAIL SET

● = ¾ x 24" SOLID ROUND # 6
REBAR SET, 1.502 LBS. PER
LIN. FT.

NOTE: IRONS ALONG EAST LINE OF
PROPERTY SET BACK IN FENCE LINE
TO AVOID SETTING IN LANE USED
BY FARM EQUIPMENT.

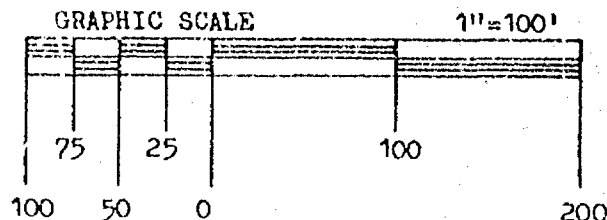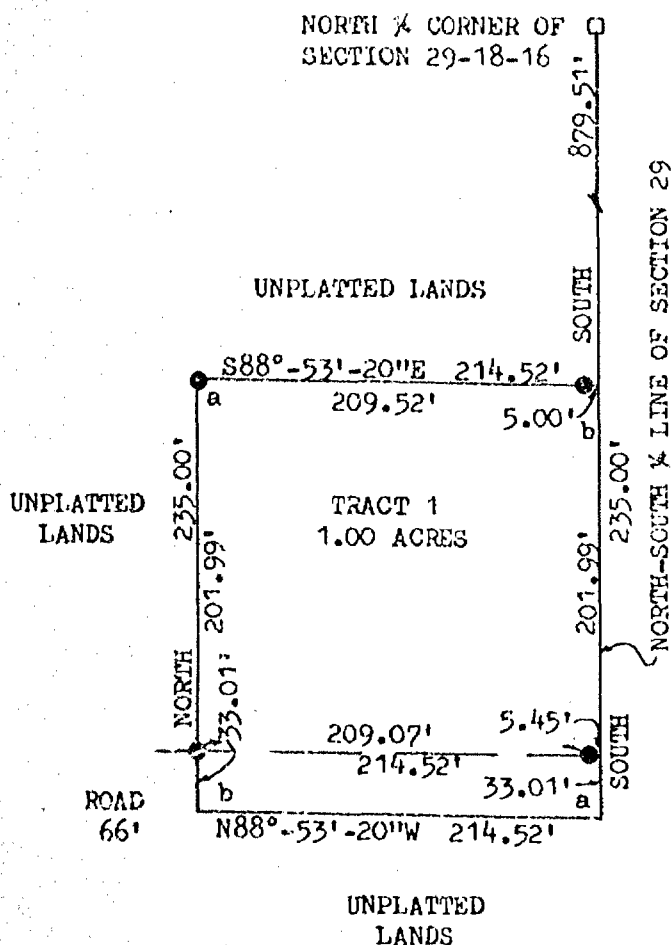


SURVEYOR'S CERTIFICATE:

I, ROBERT F. REIDER, REGISTERED WISCONSIN LAND SURVEYOR, HEREBY CERTIFY THAT I HAVE SURVEYED, DIVIDED AND MAPPED PART OF THE NE ¼ OF THE NW ¼ OF SECTION 29, T18N, R16E, TOWN OF ALGOMA, WINNEBAGO COUNTY, WISCONSIN, BOUNDED AND DESCRIBED AS FOLLOWS: COMMENCING AT THE NORTH ¼ CORNER OF SECTION 29; THENCE SOUTH, 879.51 FEET ALONG THE NORTH-SOUTH ¼ LINE OF SECTION 29 TO THE POINT OF BEGINNING; THENCE CONTINUING SOUTH, 235.00 FEET ALONG SAID NORTH-SOUTH ¼ LINE; THENCE N88°053'-20"W, 214.52 FEET; THENCE NORTH, 235.00 FEET; THENCE S88°-53'-20"E, 214.52 FEET TO THE POINT OF BEGINNING. SAID PARCEL OF LAND CONTAINING 1.16 ACRES OF LAND MORE OR LESS. SUBJECT TO ALL EASEMENTS AND RESTRICTIONS OF RECORD. RESERVING THAT PART PRESENTLY USED FOR ROAD PURPOSES.

THAT I HAVE MADE SUCH SURVEY AND MAP UNDER THE DIRECTION OF HARRY GUNNING, 3120 W. 9th ST RD., OSHKOSH, WISCONSIN 54901.

THAT THIS MAP IS A CORRECT REPRESENTATION OF THE EXTERIOR BOUNDARY LINES OF THE LAND SURVEYED.

THAT I HAVE FULLY COMPLIED WITH THE PROVISIONS OF CHAPTER 236.34 OF THE WISCONSIN STATUTES AND THE SUBDIVISION REGULATIONS OF WINNEBAGO COUNTY.

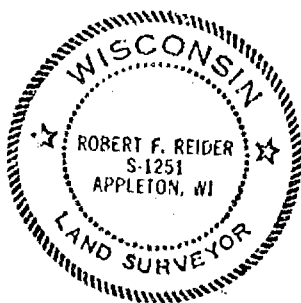

Robert F. Reider 11-29-78
ROBERT F. REIDER, RLS-1251, DATED
(rr-kv 11-18-78 TFH)
CAROW LAND SURVEYING CO., INC.
604 N. RICHMOND ST.
APPLETON, WISCONSIN 54911
A-6779-78

CERTIFIED SURVEY MAP NO. 492

OWNER'S CERTIFICATE:

AS OWNER, I HEREBY CERTIFY THAT I CAUSED THE LAND DESCRIBED ON THIS MAP TO BE SURVEYED, DIVIDED AND MAPPED AS REPRESENTED. I ALSO CERTIFY THAT THIS MAP IS REQUIRED BY S. 236.10 OR S. 236.12 OF THE WISCONSIN STATUTES TO BE SUBMITTED TO THE FOLLOWING FOR APPROVAL: WINNEBAGO COUNTY PLANNING AND ZONING COMMITTEE.


WITNESS THE HAND AND SEAL OF SAID OWNER THIS 25 DAY OF Dec., 1978.
IN THE PRESENCE OF:

Harry Gunning
HARRY GUNNING

[Signature]
WITNESS

PURSUANT TO THE SUBDIVISION REGULATION OF WINNEBAGO COUNTY, ALL REQUIREMENTS FOR APPROVAL HAVE BEEN FULFILLED. THIS CERTIFIED SURVEY MAP WAS APPROVED AND ACCEPTED THIS 11 DAY OF Dec., 1978

Robert M. Hunter
CHAIRMAN, WINNEBAGO COUNTY
PLANNING AND ZONING COMMITTEE

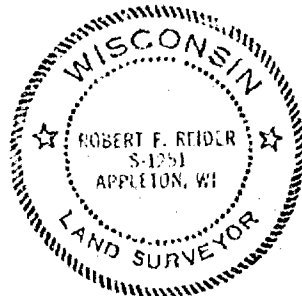

Robert F. Reider 11-29-78
ROBERT F. REIDER, RLS-1251, DATED
CAROW LAND SURVEYING CO., INC.
604 N. RICHMOND ST.
APPLETON, WISCONSIN 54911
A6779-78

Register's Office
Winnebago County, Wis.
Received for record this 14th
day of December, D. 1978
at 8:18 o'clock A.M. and
recorded in Vol. 1 of Survey
maps
page 492
[Signature]
Register of Deeds

Magnussen
2.8

526936

Survey For Rusch & Horton

Showing For Parcels # 1 And # 2


That Part Of Sec. 29-18-16 In The Town Of Algoma, Winnebago County, Wis.
Described As Follows: That Part Of The N.E.1/4 Of The N.E.1/4 Of Sec. 29-18-16
Described As Follows:

Parcel # 1

The East 165.0 ft. Of The North 165.0 ft. Of The N.E.1/4 Of The N.E.1/4 Of
Sec. 29-18-16. Said Parcel Contains 0.63 Acres More Or Less.

Parcel # 2

The West 132.0 ft. Of The East 297.0 ft. Of The North 165.0 ft. Of The
N.E.1/4 Of The N.E.1/4 Of Sec. 29-18-16. Said Parcel Contains 0.50 Acres
More Or Less.

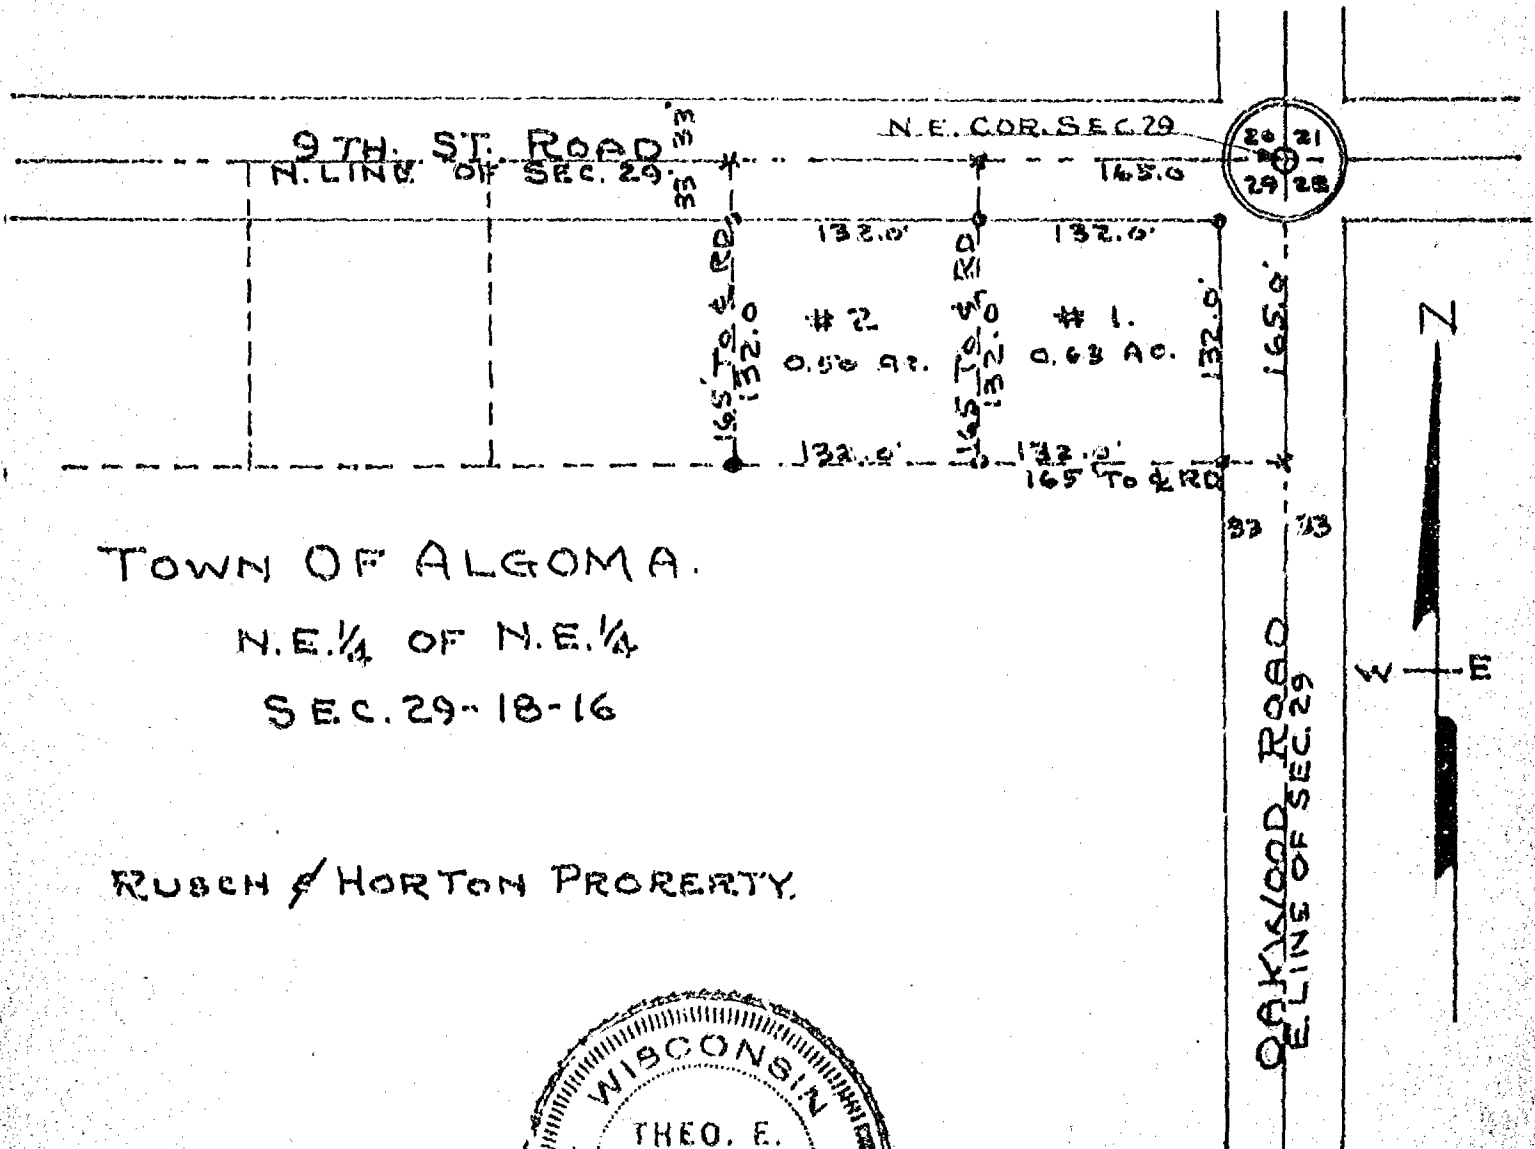

Scale
1" = 100'
Iron Stakes Shown Thus *



Survey & Platting Co.
Oshkosh, Wis.
T. E. Stearns & Reg. Surveyor
Oct. 25, 1963


(5)

SURVEY & ENGINEERING CORP.

Oshkosh, Wis

T. A. STEARNS, SURVEYOR

Dec. 13, 1958 Job # 3-10

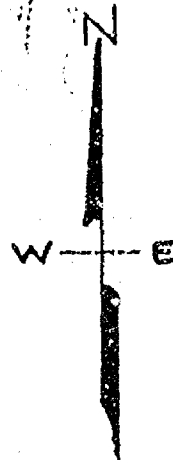

S.E. 1/4 of S.E. 1/4
SEC. 19-18-16

S.W. 1/4 of S.W. 1/4
SEC. 20-18-16

TOWN ROAD

TOWN ROAD

9TH AVE.

N.W. CORNER SEC. 29

49.5' E. MILTON JONES

N.E. 1/4 of N.E. 1/4
SEC. 30-18-16

N.W. 1/4 of N.W. 1/4
SEC. 29-18-16

SCALE
1"=400'

IRON STAKES SHOWN THIS —

Survey For E. Milton Jones

Survey of that part of the North West 1/4 of the N.W. 1/4 of Sec. 29-18-16 in the Town of Algoma, bounded & Described as follows; Commencing at the North West corner of Sec. 29 thence East along the North line of said Sec. 29, a distance of 402.55 ft. to the place of Beginning, thence due South a distance of 150.0 ft., thence East parallel with the North Line of said Sec. 29 a distance of 290.4 ft. thence due North to the North line of Sec. 29 a distance of 150.0 ft. thence West along said North line of Sec. 29, 290.4 ft. to the place of Beginning. Said Parcel containing 1.0 Acre.

Survey For Hallmark Homes:

Description Of Parcel:


That Part Of Sec. 29-18-16, Town Of Algoma, Winnebago County, Wis. Described As Follows: That Part Of The N.E. $\frac{1}{4}$ Of The N.E. $\frac{1}{4}$ Of Sec. 29-18-16 Described As Follows: The West 264.0 ft. Of The East 825.0 ft. Of The North 165.0 ft. Of The N.E. $\frac{1}{4}$ Of The N.E. $\frac{1}{4}$ Of Sec. 29-18-16.

CERTIFICATE

I, Theo. E. Stearns, Registered Surveyor In Wisc.. Do Hereby Certify That I Have Surveyed The Property & The Location Of The Foundation On The Property Described Above According To Official Records, And That The Plat Map Drawn Is A Correct Representation Of Said Survey.

Dated: Nov. 25, 1964


Theo. E. Stearns
Reg. Surveyor No. 8-359

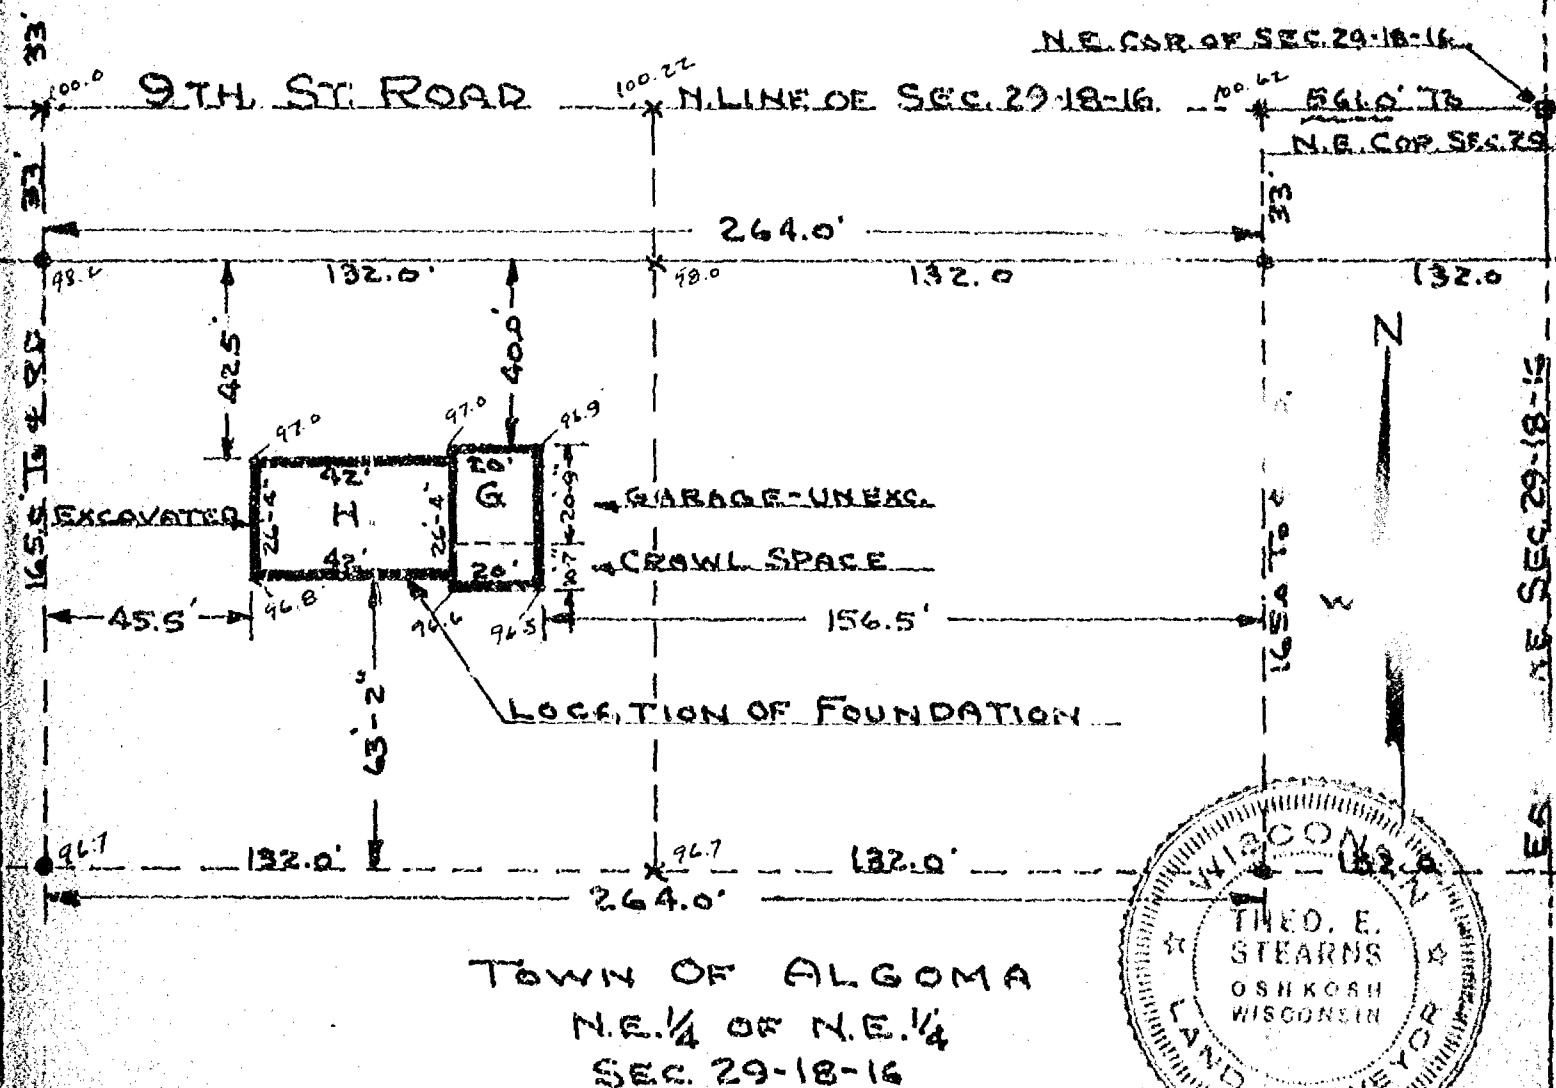

Scale

1" = 40'

Iron Stakes Shown Thus - •

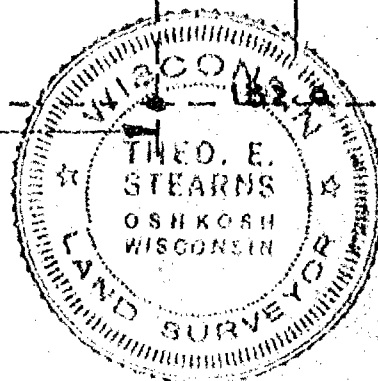

Survey & Platting Co.
Oshkosh, Wis.
T.E. Stearns - Reg. Surveyor
Nov. 25, 1964

(5)

Survey For Fox Valley Builders:



Description For Parcel 'A'
That Part Of Sec. 29-18-16, Town Of Algoma, Winnebago Co. Wis. Described As
Follows: That Part Of The E. 1/2 Of The N.E. 1/4 Of Sec. 29-18-16 Described
As Follows: The West 264.0 ft. Of The East 1089.0 ft. Of The North 165.0 ft.
Of The E. 1/2 Of The N.E. 1/4 Of Sec. 29-18-16. Said Parcel Contains 1.0 Acre
More Or Less.

CERTIFICATE


I, Theo. E. Stearns Registered Surveyor In The State Of Wis. Do Hereby
Certify That I Have Surveyed The Property And The Location Of The Foundation
On The Property According To Official Records & That The Plat Map Drawn Is
A Correct Representation Of Said Survey.

Dated: Sept. 2, 1961

Theo. E. Stearns
Reg. Surveyor

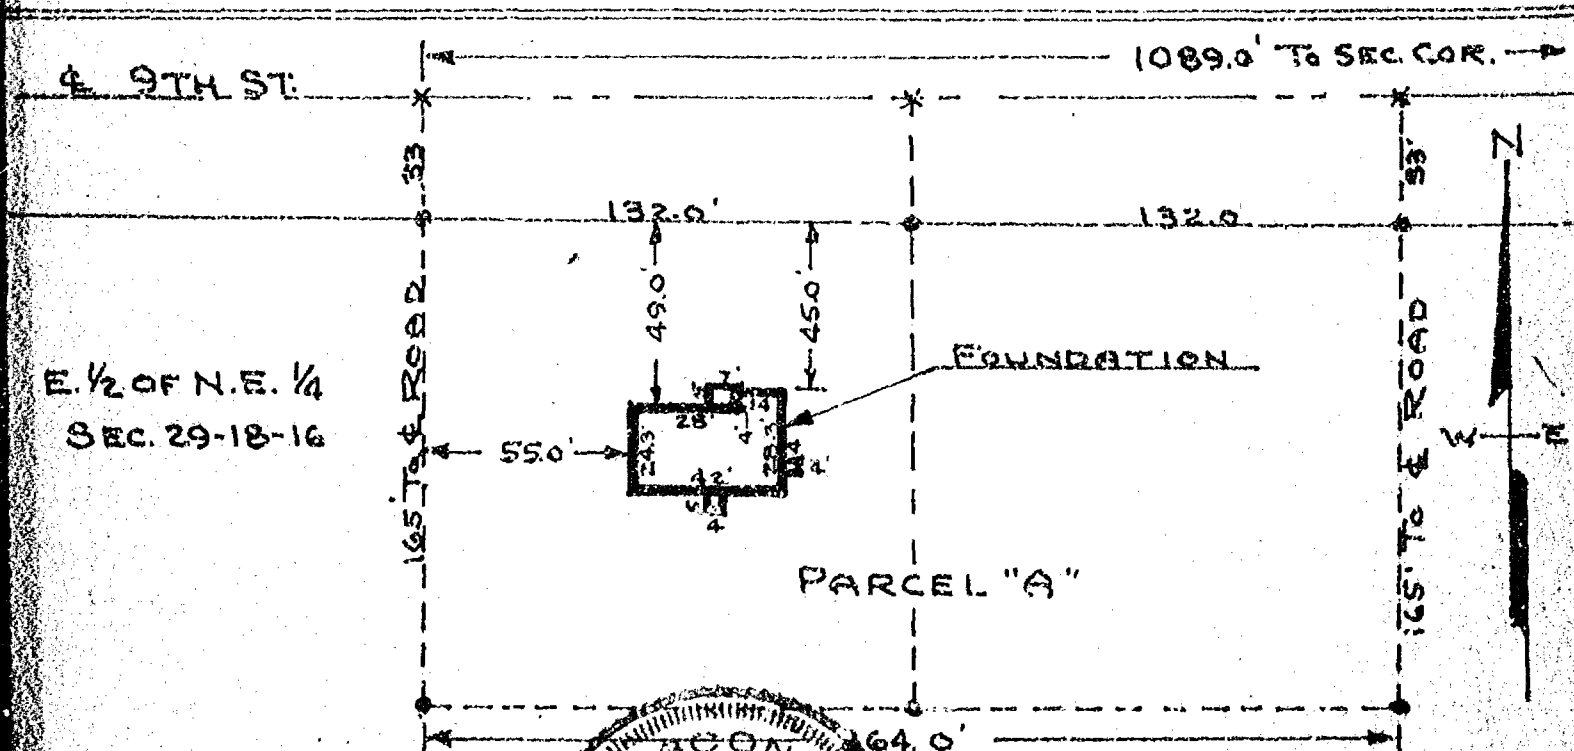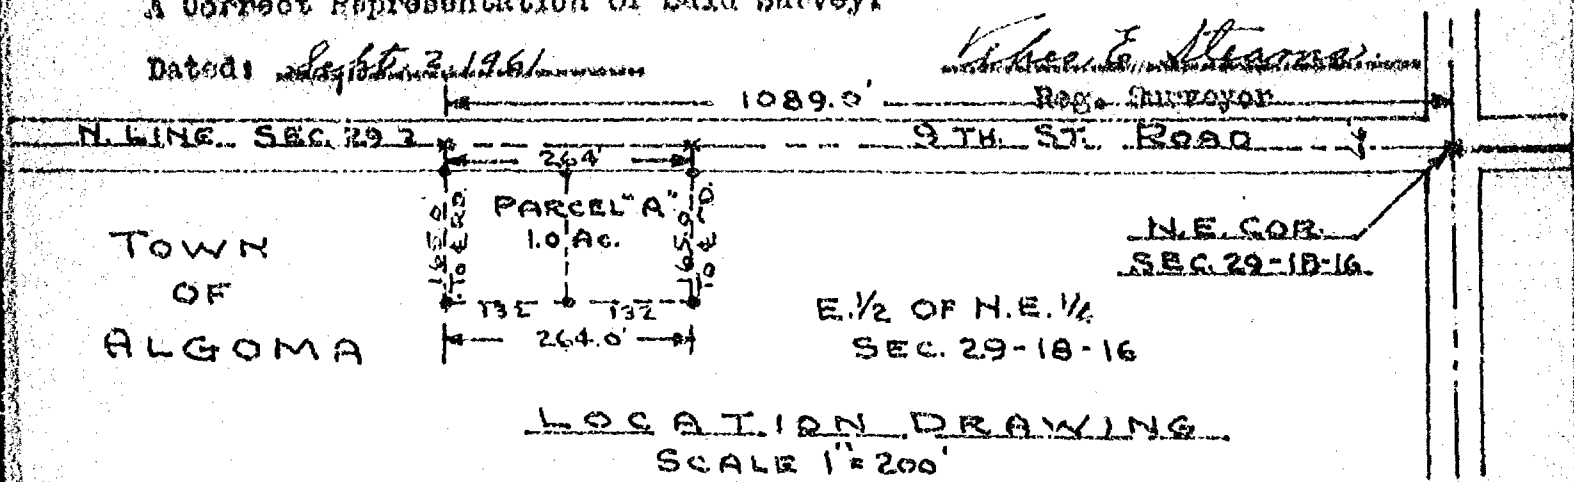

Scale
1" = 50'
Iron Stakes Shown Thus

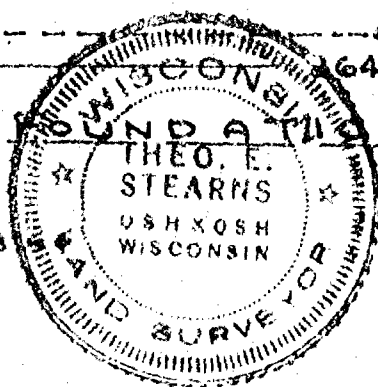

SURVEY & PLATTING CO
OSHKOSH, WIS.
T. E. STEARNS, REG. SURVEYOR
SEPT. 2, 1961

Survey For H. A. Gunning

Description:

Parcel 'A'

That Part Of Sec. 29-18-16, Town Of Algoma, Winnebago County, Wis. Described As Follows: That Part Of The N.W. 1/4 Of The N.E. 1/4 Of Sec. 29-18-16 Described As Follows: The West 130.0 ft. Of The East 330.0 ft. Of The North 165.0 ft. Of The N.W. 1/4 Of The N.E. 1/4 Of Sec. 29-18-16. Said Parcel Contains 0.49 Ac. More Or Less.

Survey For Jack Gunning

Description For Parcel 'B'

The West 30.0 ft. Of The East 360.0 ft. Of The North 165.0 ft. Of The N.W. 1/4 Of The N.E. 1/4 Of Sec. 29-18-16. Said Parcel Contains 0.11 Ac. More Or Less.


TOWN OF ALGOMA

S.W. 1/4 OF S.E. 1/4

SEC. 20-18-16



NORTH LINE OF SEC. 29-18-16

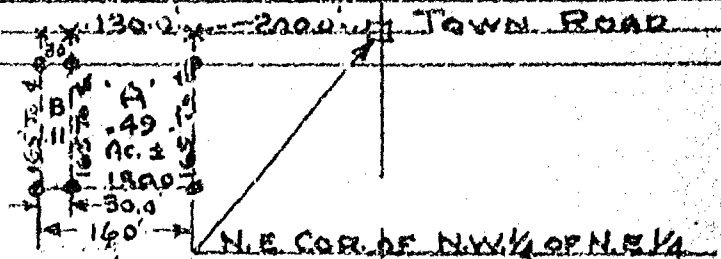

H.A. GUNNING PROPERTY

N.W. 1/4 OF N.E. 1/4
SEC. 29-18-16

N.E. 1/4 OF N.E. 1/4
SEC. 29-18-16

Scale
1" = 200'
Iron Stakes Shown There **

SURVEY & PLATTING CO.
OSHKOSH, WIS.
T. E. Stearns - County Surveyor
Dec. 15, 1960

Rev.
Aug 7, 1961

(4)

Survey Of Home At 1507 S. Oakwood Road - Richard Duffy

Lot Description:


That Part Of Sec. 29-18-16 In The Town Of Algoma, Winnebago County, Wis. Described As Follows: That Part Of The S.E. 1/4 Of The N.E. 1/4 Of Sec. 29-18-16 Described As Follows: Commencing At A Point 441.7 ft. North Of The South East Corner Of The S.E. 1/4 Of The N.E. 1/4, Thence N. 84° 54' W. A Distance Of 249.0 ft., Thence N. 18° 25' E. A Distance Of 110.8 ft., Thence S. 84° 54' E. To The East Line Of Said Sec. A Distance Of 214.0 ft., Thence South Along The East Line Of Said Sec., 108.3 ft. To The Place Of Beginning.

CERTIFICATE

I, Theo E. Stearns, Registered Surveyor In Winnebago County, Wis. Do Heroby certify That I Have Surveyed The Property & The Location Of The House & Found it in On The Property According To Official Records & That The Plat Map Drawn Is A Correct Representation Of Said Survey.

Dated: Nov. 29, 1963

Theo E. Stearns
Reg. Surveyor No. 8-353

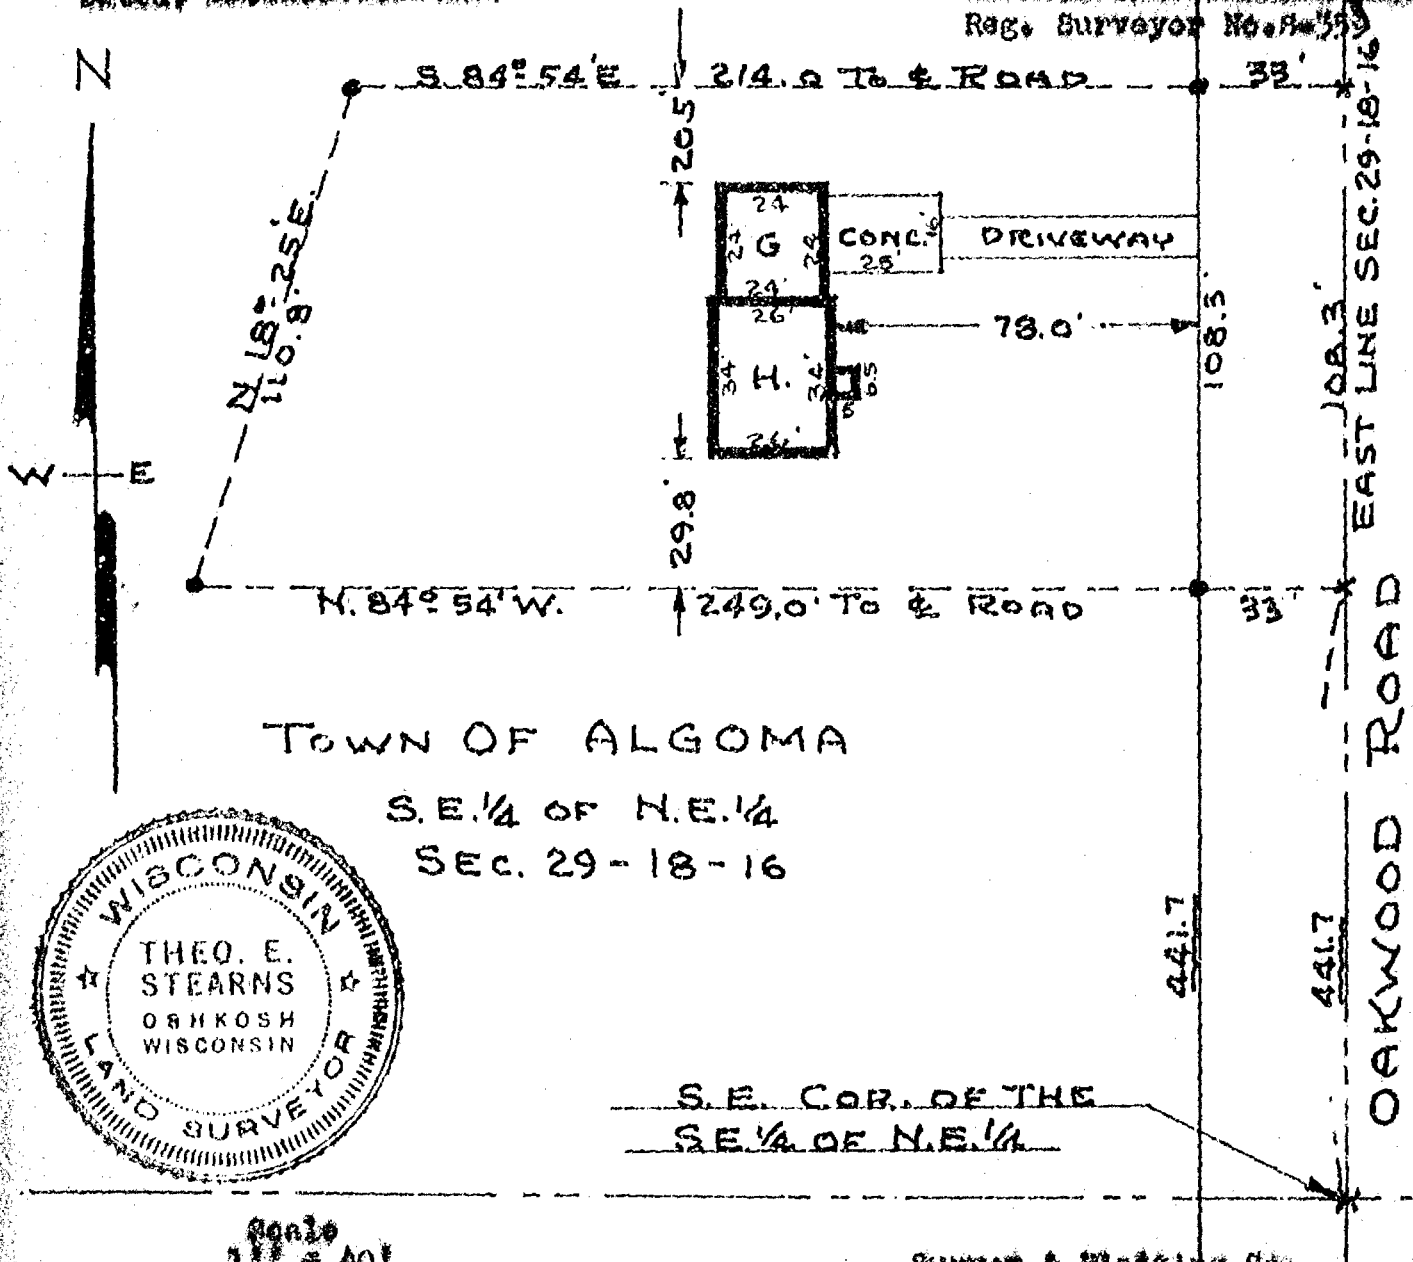

Range 11
Iron Stakes Shown Thus **

Survey & Platting Co.
Oshkosh, Wis.
T. E. Stearns - Reg. Surveyor
Nov. 29, 1963

(16)

(UNRECORDED) HOME STEAD ~~RECORDED~~ PLAT

PART OF THE N.E. 1/4 OF SEC. 29-18-16, IN THE TOWN OF
ALGAMA, WINNEBAGO COUNTY, WIS.

DESCRIPTION:-

COMMENCING AT THE N.E. CORNER OF THE NORTH EAST QUARTER OF SEC. 29, T.13N., R.14E., THENCE DUE SOUTH 1650 FT. TO THE PLACE OF BEGINNING: THENCE N. 90° 0' W. A DISTANCE OF 1355.0 FT., THENCE DUE SOUTH A DISTANCE OF 440.0 FT., THENCE N. 90° 0' E., 972.0 FT., THENCE DUE SOUTH 60.0 FT., THENCE N 90° 0' E., 383.0 FT., THENCE DUE NORTH 500.0 FT. TO PLACE OF BEGINNING.




N. LINE OF SEC. 29-18-11

9TH ST ROAD


TOWN OF ALGOMA

N. E. 1/4
SEC. 29-18-16

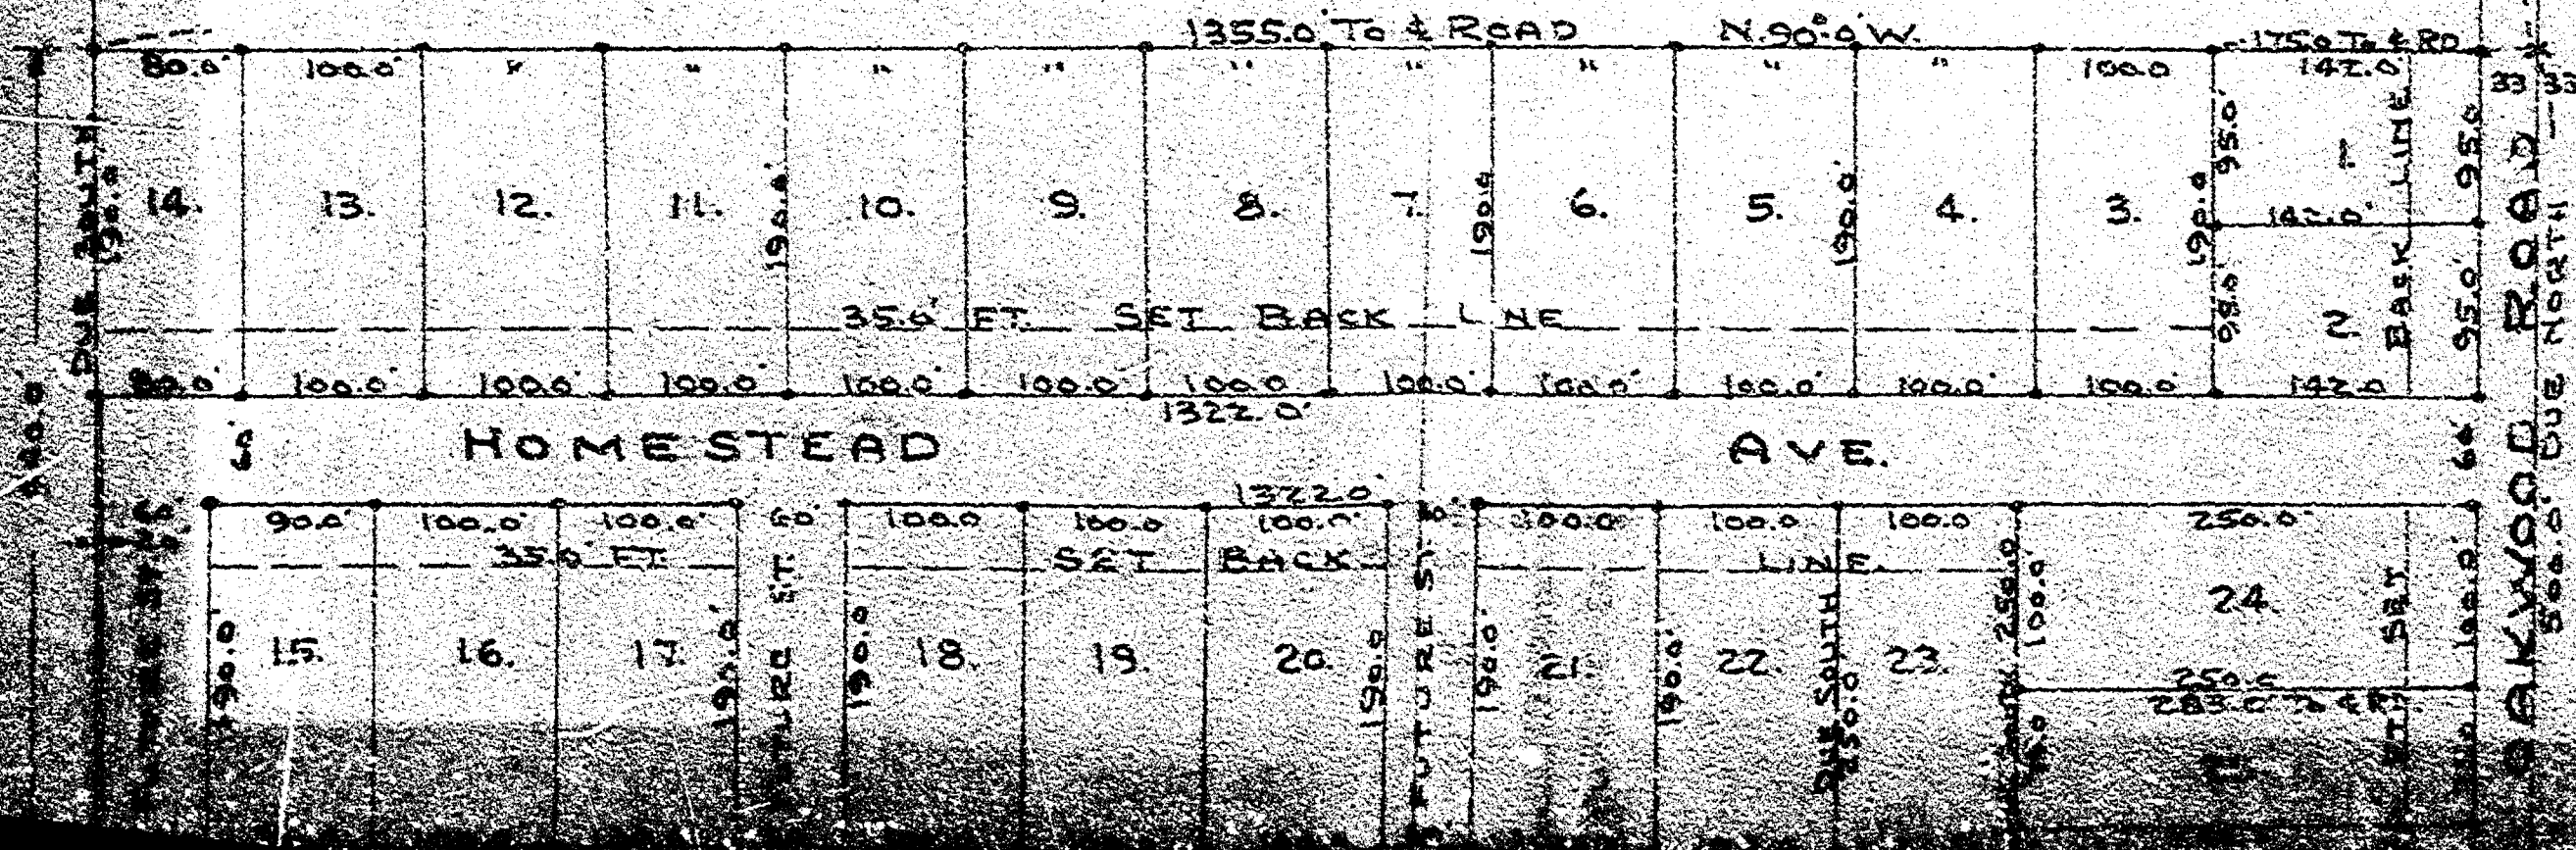

SCALE

PLAT OF SURVEY

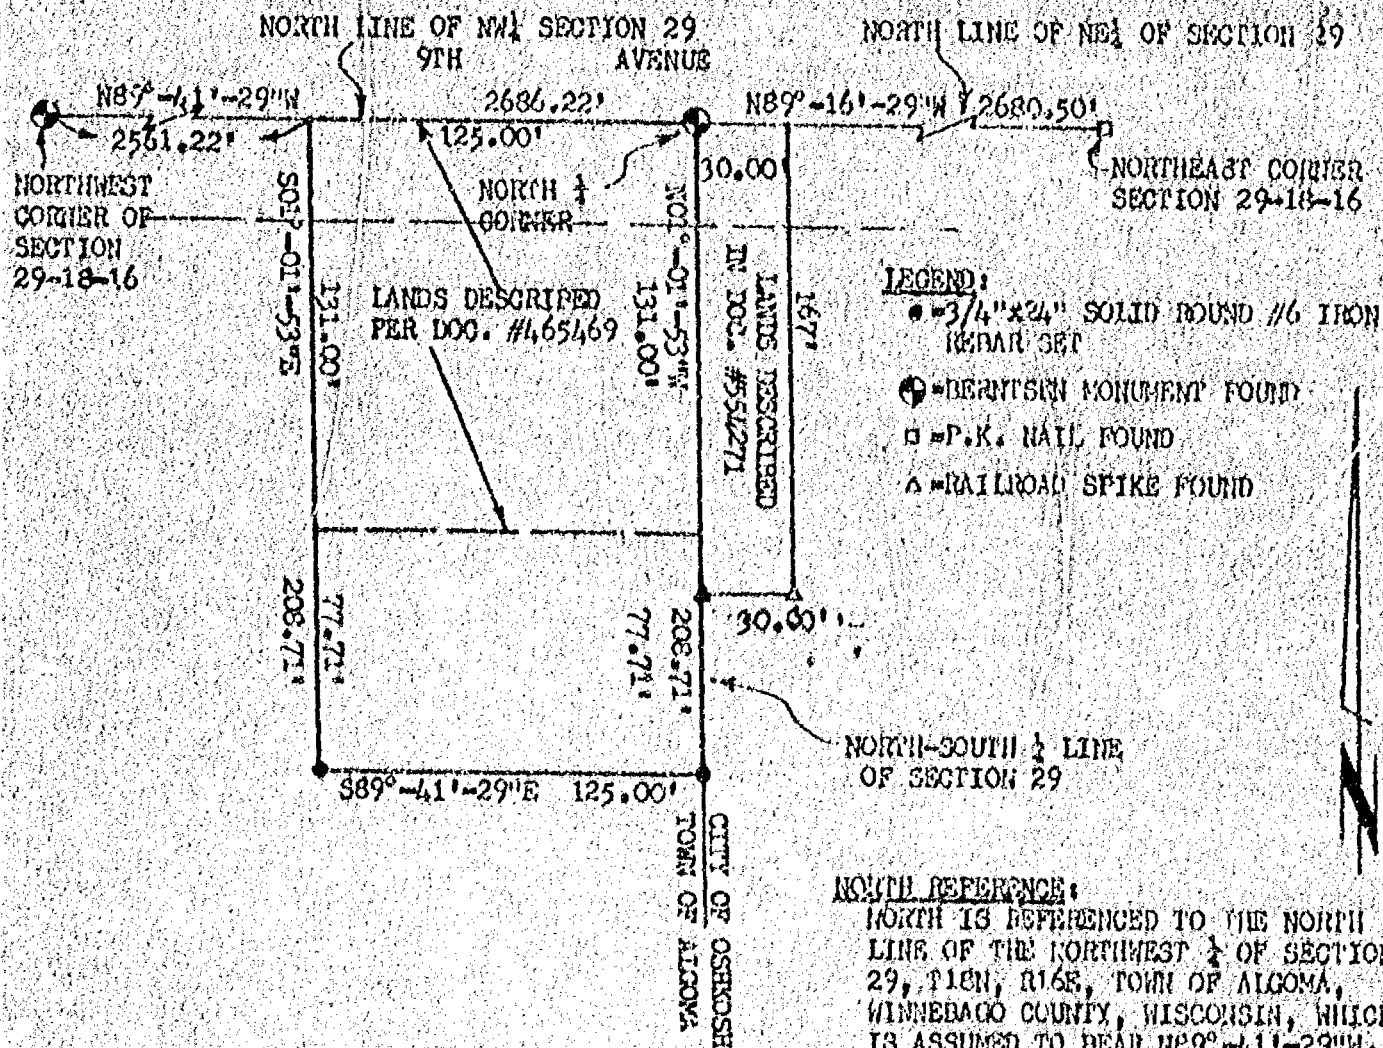


DESCRIPTION:

A PARCEL OF LAND LOCATED IN THE NORTHEAST 1/4 OF THE NORTHWEST 1/4 OF SECTION 29, T18N, R16E, TOWN OF ALCOMA, WINNEBAGO COUNTY, WISCONSIN, BOUNDED AND DESCRIBED AS FOLLOWS: BEGINNING AT THE NORTH 1/4 CORNER OF SECTION 29; THENCE N89°-41'-29"W, 125.00 FEET ALONG THE NORTH LINE OF THE NORTHWEST 1/4; THENCE S01°-01'-53"E, 208.71 FEET; THENCE S89°-41'-29"E, 125.00 FEET TO THE NORTH-SOUTH 1/2 LINE OF SECTION 29; THENCE N01°-01'-53"W, 208.71 FEET ALONG SAID LINE TO THE POINT OF BEGINNING. SAID PARCEL CONTAINS 0.60 ACRES OF LAND MORE OR LESS, SUBJECT TO ALL EASEMENTS AND RESTRICTIONS OF RECORD. RESERVING THAT PART PRESENTLY USED FOR ROAD PURPOSES.

CLIENT:

MRS. JANE MOCCO
2230 BROOKVIEW COURT
OSHKOSH, WISCONSIN

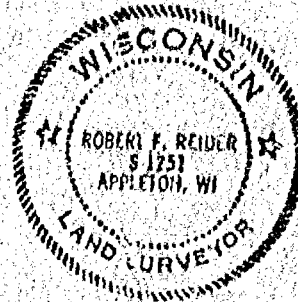

I HEREBY CERTIFY THAT I HAVE SURVEYED THE ABOVE DESCRIBED PROPERTY AND THE ABOVE MAP IS A TRUE REPRESENTATION THEREOF AND SHOWS THE SIZE AND LOCATION OF THE PROPERTY, ITS EXTERIOR BOUNDARIES, THE LOCATION AND DIMENSIONS OF ALL VISIBLE STRUCTURES THEREON, FENCES, APPARENT EASEMENTS AND ROADWAYS AND VISIBLE ENCROACHMENTS, IF ANY.

THIS SURVEY IS MADE FOR THE EXCLUSIVE USE OF THE PRESENT OWNERS OF THE PROPERTY, AND ALSO THOSE WHO PURCHASE, MORTGAGE OR GUARANTEE THE TITLE THEREOF WITHIN ONE (1) YEAR FROM THE DATE HEREON, AND AS TO THEM I HEREBY CERTIFY THAT SAID SURVEY AND THE ABOVE MAP WERE MADE IN ACCORDANCE WITH ACCEPTABLE PROFESSIONAL STANDARDS AND THAT THE INFORMATION CONTAINED HEREON IS, TO THE BEST OF MY KNOWLEDGE, INFORMATION AND BELIEF, A TRUE AND ACCURATE REPRESENTATION THEREOF.

Robert F. Reider 7-11-89
ROBERT F. REIDER DATED
RIS-1251



CAROW LAND SURVEYING CO., INC.


1837 W. WISCONSIN AVE., P.O. BOX 1287
APPLETON, WISCONSIN 54912-1297
PHONE 414-731-4168 FAX 731-5873

SCALE
1"=60'
DRAWN BY
rr-ko KJO
PROJECT NO.
A897.17

Stock No. 26273

CERTIFIED SURVEY MAP NO. 2045

BEING PART OF THE NORTHEAST $\frac{1}{4}$ OF THE NORTHWEST $\frac{1}{4}$ OF SECTION 29, T18N, R16E, TOWN OF ALGOMA, WINNEBAGO COUNTY, WISCONSIN.

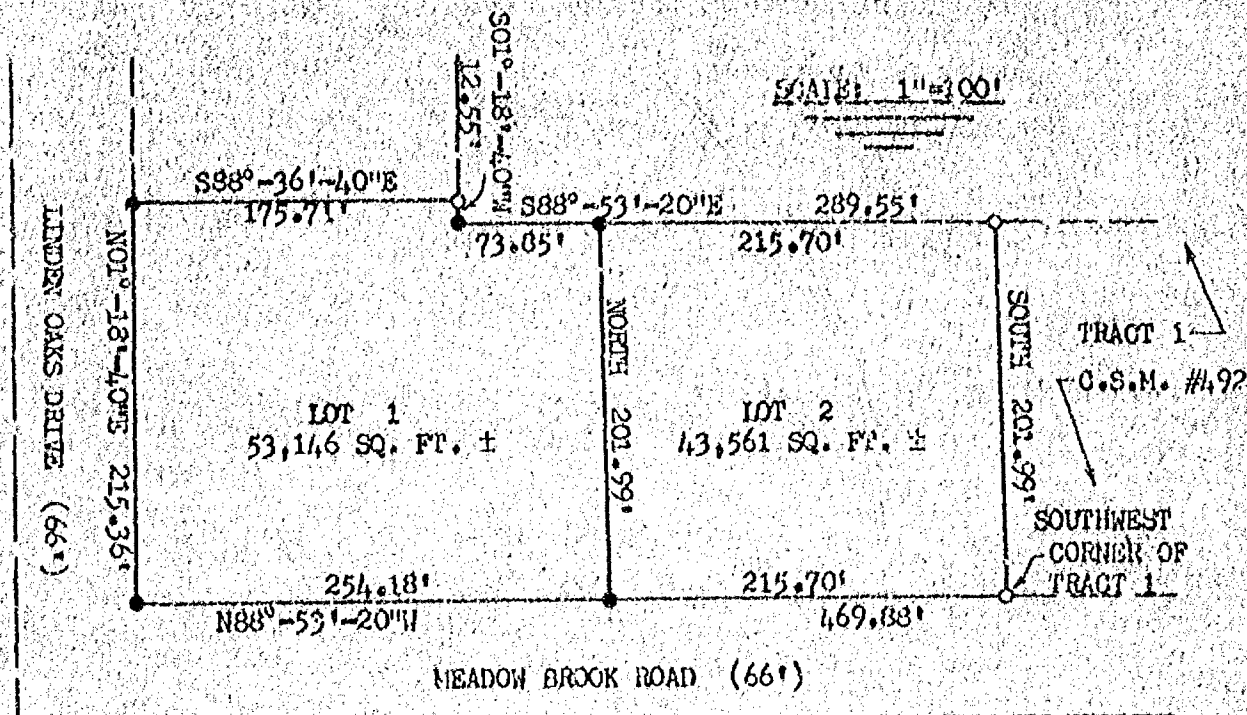

LEGEND:

- 3/4"x24" SOLID ROUND #6 IRON REBAR SET, WEIGHING 1.502 LBS. PER LIN. FOOT
- 3/4" SOLID ROUND IRON REBAR FOUND

NORTH REFERENCE:

NORTH IS REFERENCED TO THE WEST LINE OF TRACT 1 OF CERTIFIED SURVEY MAP #492, SECTION 29, T18N, R16E, TOWN OF ALGOMA, WINNEBAGO COUNTY, WISCONSIN, WHICH IS RECORDED TO BEAR DUE NORTH.


SURVEYORS CERTIFICATE:

I, ROBERT F. REIDER, REGISTERED WISCONSIN LAND SURVEYOR, CERTIFY THAT I HAVE SURVEYED, DIVIDED AND MAPPED PART OF THE NORTHEAST $\frac{1}{4}$ OF THE NORTHWEST $\frac{1}{4}$ OF SECTION 29, T18N, R16E, TOWN OF ALGOMA, WINNEBAGO COUNTY, WISCONSIN, BOUNDED AND DESCRIBED AS FOLLOWS: BEGINNING AT THE SOUTHWEST CORNER OF CERTIFIED SURVEY MAP NUMBER 492 AS RECORDED IN VOLUME 1 OF CERTIFIED SURVEY MAPS ON PAGE 492 AS DOCUMENT NUMBER 526936; THENCE N88°-53'-20"W, 469.88 FEET ALONG THE NORTH LINE OF MEADOW BROOK ROAD TO THE EAST LINE OF LINDEN OAKS DRIVE; THENCE N01°-18'-40"E, 215.36 FEET ALONG SAID EAST LINE; THENCE S88°-36'-40"E, 175.71 FEET; THENCE S01°-18'-40"W, 12.55 FEET; THENCE S88°-53'-20"E, 289.55 FEET TO THE WEST LINE OF CERTIFIED SURVEY MAP NUMBER 492; THENCE SOUTH, 201.39 FEET ALONG SAID WEST LINE TO THE POINT OF BEGINNING. SUBJECT TO ALL EASEMENTS AND RESTRICTIONS OF RECORD.

THAT I HAVE MADE SUCH SURVEY UNDER THE DIRECTION OF MRS. JANE MOCCO, 2230 BROOKVIEW COURT, OSHKOSH, WISCONSIN 54904.

THAT THIS MAP IS A CORRECT REPRESENTATION OF THE EXTERIOR BOUNDARY LINES OF THE LAND SURVEYED.

THAT I HAVE FULLY COMPLIED WITH THE PROVISIONS OF CHAPTER 236.34 OF THE WISCONSIN STATUTES AND THE SUBDIVISION ORDINANCES OF WINNEBAGO COUNTY.

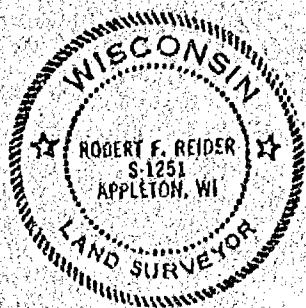

Robert F. Reider 7-7-89
 ROBERT F. REIDER RLS-1251 DATED
 CAROW LAND SURVEYING CO., INC.
 1837 W. WISCONSIN AVENUE P.O. BOX 1297
 APPLETON, WISCONSIN 54912-1297
 A896.88 (rr No KJO) 7-7-89

Stock No. 26273

CERTIFIED SURVEY MAP NO. 2045

OWNERS CERTIFICATE:

AS OWNER(S) I(WE) HEREBY CERTIFY THAT I(WE) CAUSED THE LAND DESCRIBED IN THIS CERTIFIED SURVEY MAP TO BE SURVEYED, DIVIDED AND MAPPED AS REPRESENTED. I(WE) ALSO CERTIFY THAT THIS MAP IS REQUIRED BY S. 236.10 OR S. 236.12 OF THE WISCONSIN STATUTES TO BE SUBMITTED TO THE FOLLOWING FOR APPROVAL: WINNEBAGO COUNTY ZONING AND PLANNING COMMITTEE.

WITNESS THE HAND AND SEAL OF SAID OWNER(S) THIS 2nd DAY OF July, 1989

Paul Mace
OWNER

OWNER

W. V. Van Buren
WITNESS

STATE OF WISCONSIN
COUNTY OF WINNEBAGO ss.

PERSONALLY CAME BEFORE ME THIS 2nd DAY OF July, 1989. THE ABOVE NAMED PERSON(S) TO ME KNOWN TO BE THE PERSONS WHO EXECUTED THE FOREGOING INSTRUMENT AND ACKNOWLEDGED THE SAME


NOTARY PUBLIC
STATE OF WISCONSIN
DEBBIE A. ZWEIGER

Debbie Zweiger
NOTARY PUBLIC, WINNEBAGO COUNTY
MY COMMISSION EXPIRES: 3-24-91

COUNTY PLANNING AND ZONING APPROVAL:

PURSUANT TO THE WINNEBAGO COUNTY SUBDIVISION ORDINANCE, ALL REQUIREMENTS FOR APPROVAL HAVE BEEN FULFILLED. THIS CERTIFIED SURVEY MAP WAS APPROVED THE 21st DAY OF July, 1989.

Janette Quakoff
V. CHAIRPERSON, WINNEBAGO COUNTY PLANNING AND ZONING COMMITTEE

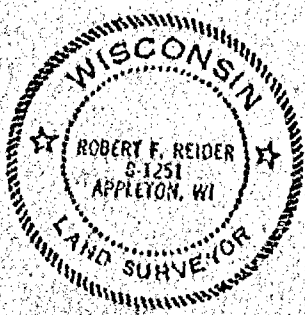

Robert F. Reider 7-7-89
ROBERT F. REIDER RIS-1251 DATED
CAROL LAND SURVEYING CO., INC.
1837 W. WISCONSIN AVENUE P.O. BOX 1297
APPLETON, WISCONSIN 54912-1297
A96.88 KJO

TREASURER'S CERTIFICATE:

I HEREBY CERTIFY THAT THERE ARE NO UNPAID TAXES OR UNPAID SPECIAL ASSESSMENTS ON ANY OF THE LANDS INCLUDED IN THIS MINOR SUBDIVISION.

Lucy W. Bradley
TREASURER, WINNEBAGO COUNTY

8/1/89
DATED

Dr. L. E. Ham
TREASURER, TOWN OF ALGOMA

7/31/89
DATED

727118

Register's Office
Winnebago County, Wis.
Received for record this 2nd
day of Aug A.D. 1989
at 9:22 o'clock A M. and
filed in Vol. 1 of CSM
on page 2043

Josephine H. Hahnel
Register of Deeds

Caron Land Surveying Co.

Stock No. 26273

88-1437

SHEET 1 OF 3


CERTIFIED SURVEY MAP NO. 1982

BEING A PART OF THE S.W. 1/4 AND THE N.W. 1/4 OF THE S.W. 1/4 OF SECTION 29, T18N, R16E, IN THE TOWN OF AIGOMA, WINNEBAGO COUNTY, WISCONSIN.

- DENOTES 3/4 INCH DIAMETER IRON ROD, 24" LONG, WEIGHING NOT LESS THAN 1.13 LBS PER LINEAL FOOT SET.
- ⊕ DENOTES ALUMINUM WINNEBAGO COUNTY BERNTSEN MONUMENT FOUND.
- △ DENOTES P.K. NAIL SET.

ALL DIMENSIONS SHOWN ARE MEASURED TO THE NEAREST HUNDREDTH OF A FOOT.

BEARINGS ARE REFERENCED TO THE WEST LINE OF THE S.W. 1/4 OF SECTION 29 WHICH HAS AN ASSUMED BEARING OF NORTH 00-33-13 WEST.

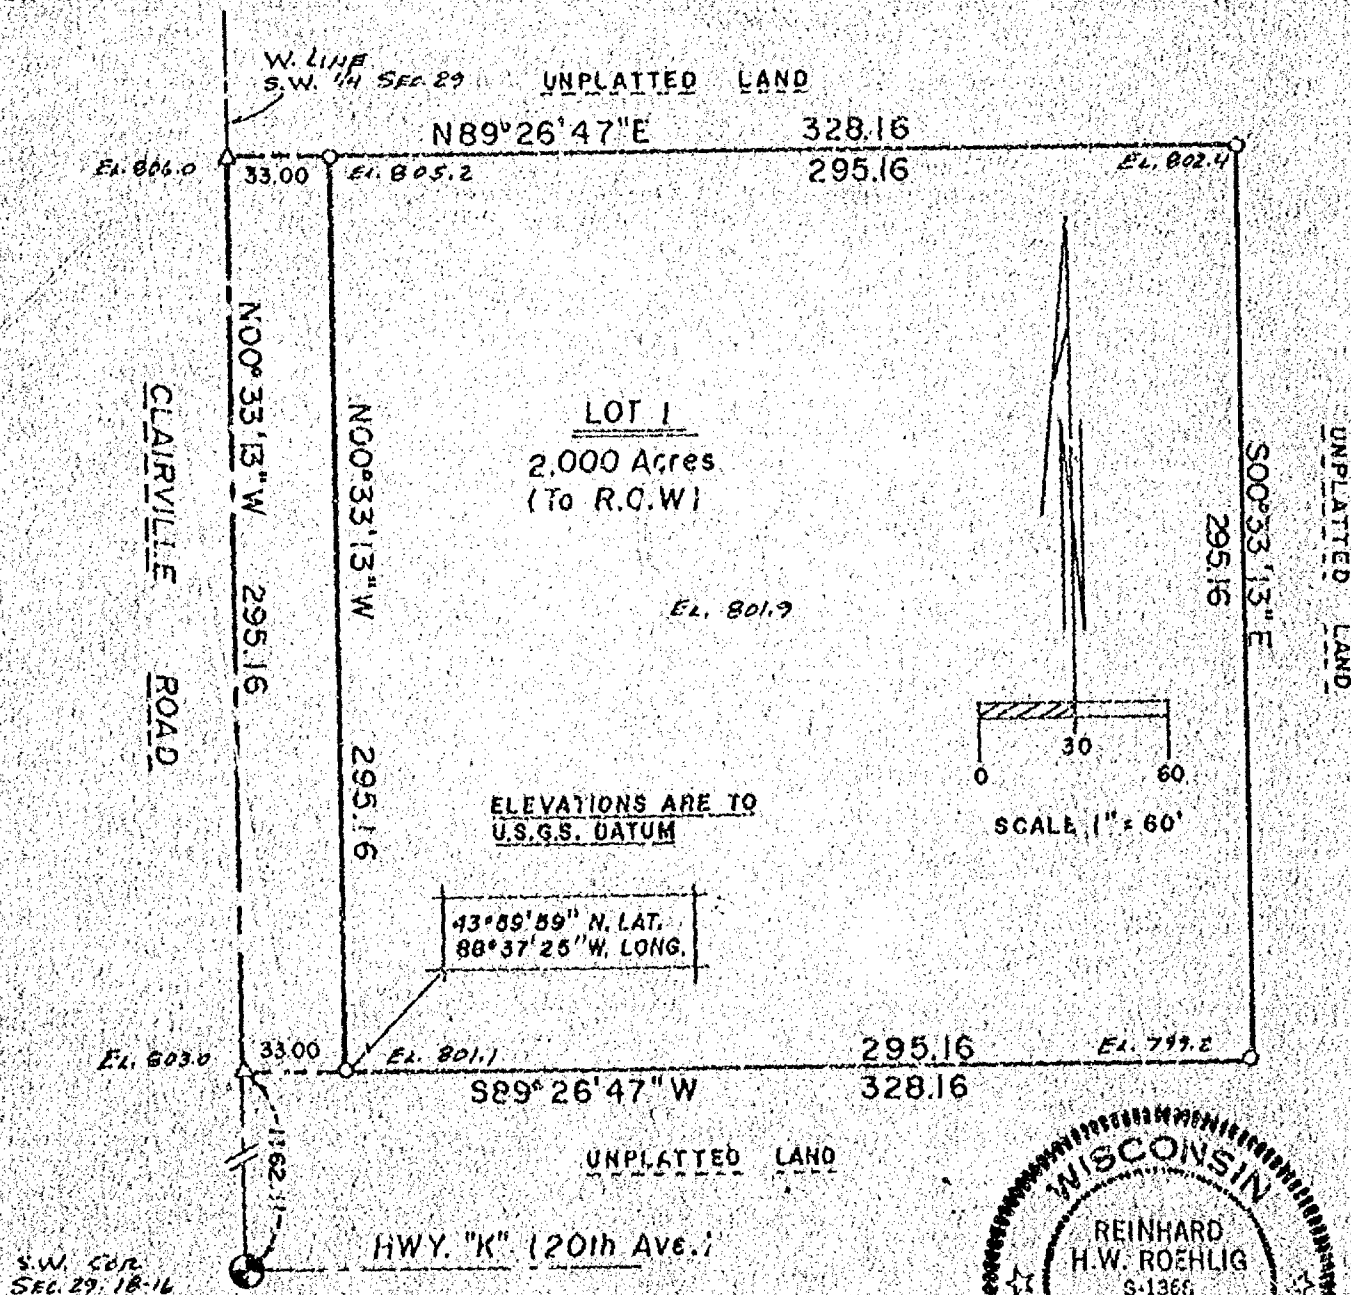

Stock No. 26273

86-1437

SHEET 2 OF 3

CERTIFIED SURVEY MAP NO. 1982

BEING A PART OF THE S.W. 1/4 AND THE N.W. 1/4 OF THE S.W. 1/4 OF SECTION 29, T18N, R16E, IN THE TOWN OF ALGOMA, WINNEBAGO COUNTY, WISCONSIN.

SURVEYOR'S CERTIFICATE
STATE OF WISCONSIN)

:SS

WINNEBAGO COUNTY)

I, REINHARD ROEHLIG, Wisconsin Land Surveyor, do hereby certify;

THAT I have surveyed and mapped a part of the S.W. 1/4 and the N.W. 1/4 of the S.W. 1/4 of Section 29, T18N, R16E, in the Town of Algoma, Winnebago County, Wisconsin, which is bounded and described as follows;

Commencing at the S.W. 1/4 corner of said Section, thence North 00-33-13 West along the West line of said S.W. 1/4 aforesaid 1162.11 ft. to the point of beginning of the parcel to be described, thence continuing North 00-33-13 West 295.16 ft., thence North 89-26-47 East 328.16 ft., thence South 00-33-13 East 295.16 ft., thence South 89-26-47 West 328.16 ft. to the point of beginning.

THAT I have made this survey and land division by the direction of Kenneth W. Neubauer and Virginia V. Neubauer, his wife, Town of Algoma, Winnebago County, owner of said land.


THAT such map is a correct representation of all the exterior boundaries of the land surveyed and the land division thereof made.

THAT I have fully complied with the provisions of Chapter 236 of the Wisconsin Statutes and the Land Subdivision Ordinance of the Winnebago County.

Date

3/17/89

Reinhard Roehlig (SEAL)
Reinhard Roehlig, Registered
Land Surveyor S-1368

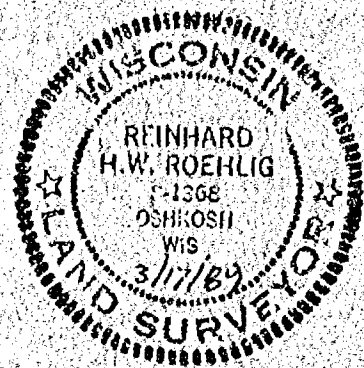

Stock No. 26273

88-1437

SHEET 3 OF 3

CERTIFIED SURVEY MAP NO. 1982

BEING A PART OF THE S.W. 1/4 AND THE N.W. 1/4 OF THE S.W. 1/4 OF SECTION 29, T18N, R16E, IN THE TOWN OF ALGOMA, WINNEBAGO COUNTY, WISCONSIN.

OWNER'S CERTIFICATE

AS OWNERS, We hereby certify that We caused the land described on this map to be surveyed, divided and mapped as represented on this map in accordance with the Winnebago County Subdivision Ordinance.

WITNESS the hands and seals of said owners this 31 day of March 1989.

In The Presence Of:

Carol NoelKenneth W. Neubauer
Kenneth W. NeubauerVirginia V. Neubauer
Virginia V. Neubauer

STATE OF WISCONSIN)

:SS

WINNEBAGO COUNTY)

PERSONALLY came before me this 31 day of March 1989 the above named Kenneth W. Neubauer and Virginia V. Neubauer, his wife, to me known to be the persons who executed the foregoing instrument and acknowledged the same.

Lawrence J. Landwehr
Notary Public Winnebago County,
State of WisconsinMy Commission Expires is permanent.

WINNEBAGO COUNTY PLANNING COMMISSION CERTIFICATE


THIS Certified Survey Map of a part of the S.W. 1/4 and the N.W. 1/4 of the S.W. 1/4 of Section 29, T18N, R16E, Town of Algoma, Winnebago County, Wisconsin, Kenneth W. Neubauer and Virginia V. Neubauer, his wife, owners, is hereby approved.

Date April 5, 1989Carol Owens
Planning Committee Representative

THIS INSTRUMENT WAS DRAFTED BY REINHARD ROEHLIG

719870

Register's Office
Winnebago County, Wis.
Received for record this 5th
day of April A.D., 1989
at 11:36 o'clock A.M. and
filed in Vol. J of C.S.M
on page 1982

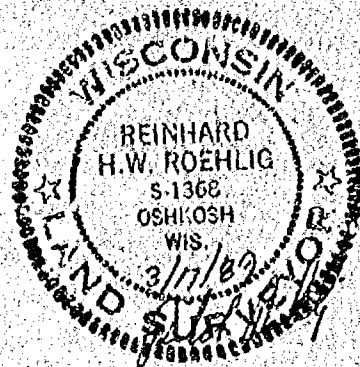Register of DeedsPd 80
Kenneth Neubauer

Stock No. 26273

89-1403

SHEET 1 OF 3


CERTIFIED SURVEY MAP NO. _____

BEING A PART OF THE N.W. 1/4 OF THE S.W. 1/4 OF SECTION 29, T18N, R16E,
IN THE TOWN OF ILGOMA, WINNEBAGO COUNTY, WISCONSIN.

- ——— DENOTES P.K. NAIL SET OR FOUND.
- ——— DENOTES 3/4 INCH DIAMETER IRON ROD FOUND.
- ——— DENOTES 3/4 INCH DIAMETER IRON ROD, 24" LONG, WEIGHING
NOT LESS THAN 1.13 LBS PER LINEAL FOOT SET.

ALL DIMENSIONS SHOWN ARE MEASURED TO THE NEAREST HUNDREDTH OF A FOOT.

BEARINGS ARE REFERENCED TO THE WEST LINE OF THE S.W. 1/4 OF SECTION 29,
WHICH HAS AN ASSUMED BEARING OF NORTH 89°-33'-13" WEST,

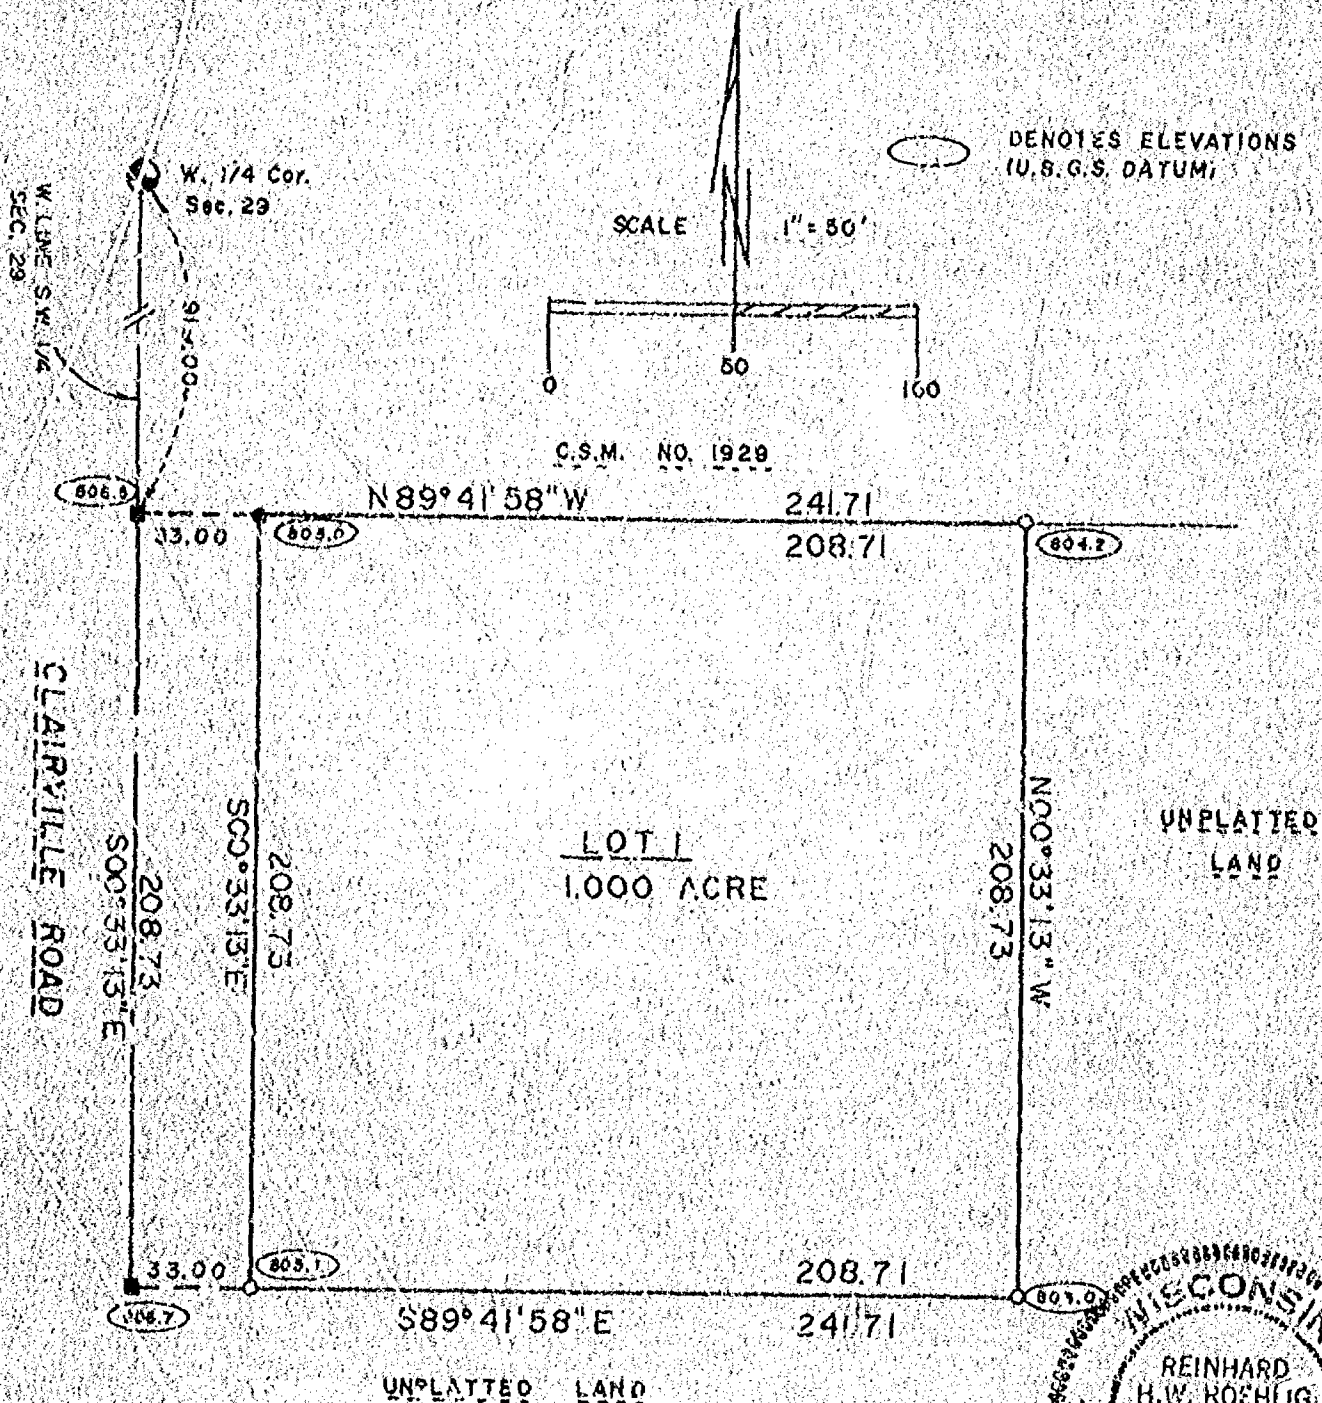**SCHULER & ASSOCIATES**

CONSULTING ENGINEERS & LAND SURVEYORS
320 W. NORTHLAND AVE. APPLETON, WIS. 54911 (608) 734-9101
2450 W. 20th AVE. OSHKOSH, WIS. 54004 (608) 425-2800

89-1403

Stock No. 26273

89-1403

SHEET 2 OF 3

CERTIFIED SURVEY MAP NO. _____

BEING A PART OF THE N.W. 1/4 OF THE S.W. 1/4 OF SECTION 29, T18N, R16E,
IN THE TOWN OF ALGOMA, WINNEBAGO COUNTY, WISCONSIN.

SURVEYOR'S CERTIFICATE
STATE OF WISCONSIN)

:SS

WINNEBAGO COUNTY)

I, REINHARD ROEHLIG, Wisconsin Land Surveyor do hereby certify;

THAT I have surveyed and mapped a part of the N.W. 1/4 of the S.W. 1/4
of Section 29, T18N, R16E, in the Town of Algoma, Winnebago County,
Wisconsin, which is bounded and described as follows:

Commencing at the W. 1/4 Corner of said Section, thence South 00-33-13
East along the West line of the S.W. 1/4 of said Section 919.00 ft. to
the S.W. corner of Certified Survey Map No. 1929 and the point of
beginning of the parcel to be described, thence continuing South 00-33-
13 East 208.73 ft., thence South 89-41-58 East 241.71 ft., thence North
00-33-13 West 208.73 ft. to a point on the South line of Certified
Survey Map No. 1929, thence North 89-41-58 West along said South line
241.71 ft. to the point of beginning.

THAT I have made this survey and land division by the direction of
Kenneth W. Neubauer and Virginia V. Neubauer, his wife, Town of Algoma,
Winnebago County, owners of said land.

THAT such map is a correct representation of all the exterior
boundaries of the land surveyed and the land division thereof made.

THAT I have fully complied with the provisions of Chapter 236 of the
Wisconsin Statutes and the Land Subdivision Ordinance of Winnebago
County.

1-23-89
Date

Reinhard Roehlig (SEAL)
Reinhard Roehlig, Registered
Land Surveyor S-1368





Stock No. 26273

89-1403

SHEET 3 OF 3

CERTIFIED SURVEY MAP NO. _____

BEING A PART OF THE N.W. 1/4 OF THE S.W. 1/4 OF SECTION 29, T18N, R16E,
IN THE TOWN OF ALGOMA, WINNEBAGO COUNTY, WISCONSIN.

OWNER'S CERTIFICATE

AS OWNERS We hereby certify that We caused the land described on this
map to be surveyed, divided and mapped as represented on this map in
accordance with the Winnebago County Subdivision Ordinance.

WITNESS the hands and seals of said owners this _____ day
of _____ 1989.

In The Presence Of:

Kenneth W. Neubauer

Virginia V. Neubauer

STATE OF WISCONSIN)

188

WINNEBAGO COUNTY)

PERSONALLY came before me this _____ day of _____ 1989 the
above named Kenneth W. Neubauer and Virginia V. Neubauer, his wife, to
me known to be the persons who executed the foregoing instrument and
acknowledged the same.

Notary Public, Winnebago County,
State of Wisconsin

My Commission Expires _____


WINNEBAGO COUNTY PLANNING COMMISSION CERTIFICATE

THIS Certified Survey Map of a part of the N.W. 1/4 of the S.W. 1/4 of
Section 29, T18N, R16E, Town of Algoma, Winnebago County, Wisconsin,
Kenneth W. Neubauer and Virginia V. Neubauer owners, is hereby
approved.

Date _____

Planning Committee Representative _____

THIS INSTRUMENT WAS DRAFTED BY
REINHARD ROEHLIG.

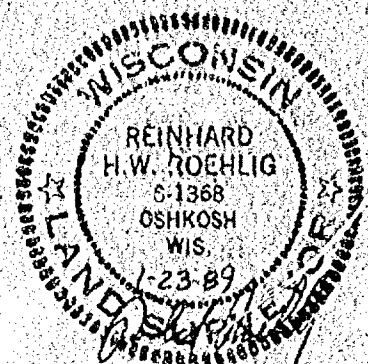

Stock No. 26273

88-1417

SHEET 1 OF 3


CERTIFIED SURVEY MAP NO. _____

BEING A PART OF THE S.W. 1/4 OF THE S.W. 1/4 OF SECTION 29, T18N, R16E,
IN THE TOWN OF ALGOMA, WINNEBAGO COUNTY, WISCONSIN.

○ DENOTES 3/4 INCH DIAMETER IRON ROD, 24" LONG, WEIGHING
NOT LESS THAN 1.13 LBS PER LINEAL FOOT SET.

ALL DIMENSIONS SHOWN ARE MEASURED TO THE NEAREST HUNDREDTH OF A FOOT.

BEARINGS ARE REFERENCED TO THE WEST LINE OF THE S.W. 1/4 OF SECTION 29
WHICH HAS AN ASSUMED BEARING OF NORTH 88°33'13" WEST.

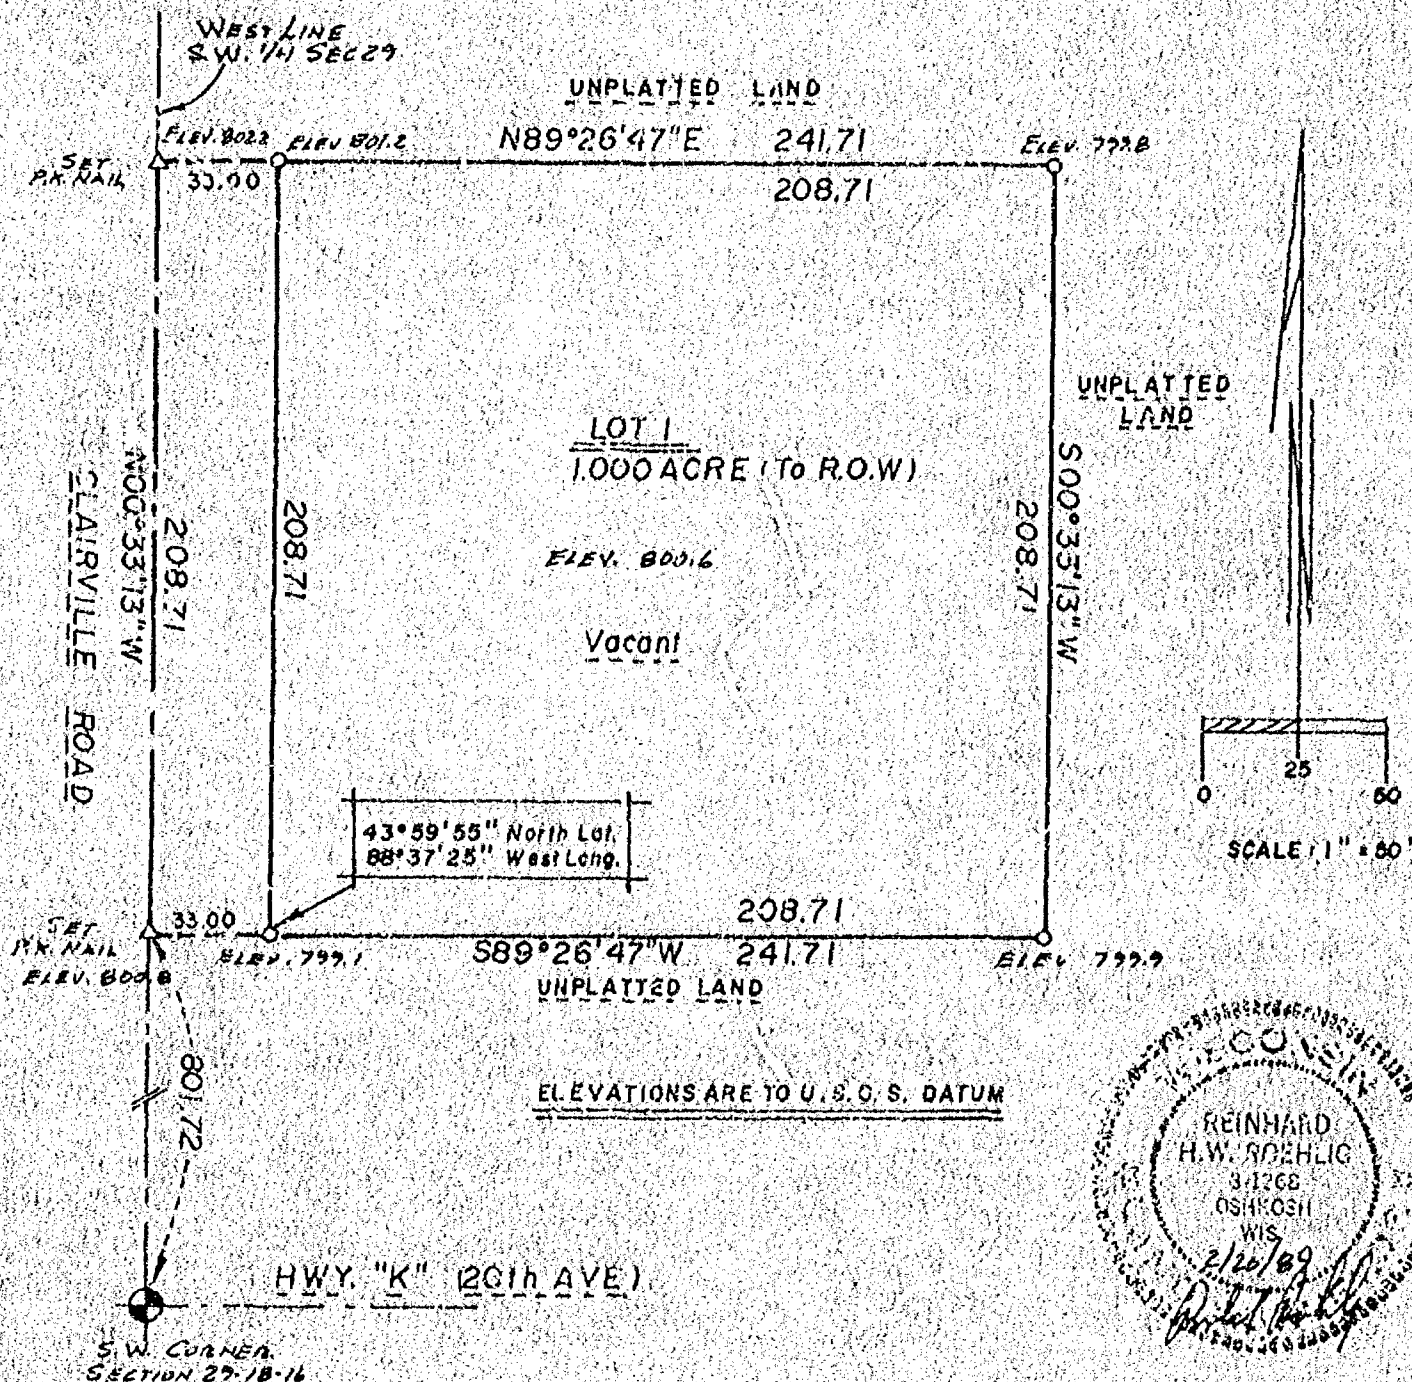**SCHULER & ASSOCIATES**

CONSULTING ENGINEERS & LAND SURVEYORS

320 N. NORTHLAND AVE. APPLETON, WIS. 54911 (414) 734-9107
417 NORTH SAWYER STREET OSHKOSH, WIS. 54901 (414) 426-2600

88-1417

Stock No. 26173

88-1417

SHEET 2 OF 3

CERTIFIED SURVEY MAP NO. _____

BEING A PART OF THE S.W. 1/4 OF THE S.W. 1/4 OF SECTION 29, T18N, R16E,
IN THE TOWN OF ALGOMA, WINNEBAGO COUNTY, WISCONSIN.

SURVEYOR'S CERTIFICATE
STATE OF WISCONSIN)

189

WINNEBAGO COUNTY)

I, REINHARD ROEHLIG, Wisconsin Land Surveyor do hereby certify;

THAT I have surveyed and mapped a part of the S.W. 1/4 of the S.W. 1/4 of Section 29, T18N, R16E, in the Town of Algoma, Winnebago County, Wisconsin, which is bounded and described as follows:

Commencing at the S.W. 1/4 corner of said Section, thence North 00-33-13 West along the West line of said S.W. 1/4 aforesaid 801.72 ft. to the point of beginning of the parcel to be described, thence continuing North 00-33-13 West 208.71 ft., thence North 89-26-47 East 241.71 ft., thence South 00-33-13 West 208.71 ft., thence South 89-26-47 West 241.71 ft. to the point of beginning.

THAT I have made this survey and land division by the direction of Kenneth W. Neubauer and Virginia V. Neubauer, his wife, Town of Algoma, Winnebago County, owners of said land.

THAT such map is a correct representation of all the exterior boundaries of the land surveyed and the land division thereof made.

THAT I have fully complied with the provisions of Chapter 236 of the Wisconsin Statutes and the Land Subdivision Ordinance of the Winnebago County.

2/20/89
Date

Reinhard Roehlig (SEAL)
Reinhard Roehlig, Registered
Land Surveyor 8-1368



Block No. 26273

00-1417

SHEET 3 OF 3

CERTIFIED SURVEY MAP NO. _____

BEING A PART OF THE S.W. 1/4 OF THE S.W. 1/4 OF SECTION 29, T18N, R16E,
IN THE TOWN OF ALGOMA, WINNEBAGO COUNTY, WISCONSIN.

OWNER'S CERTIFICATE

AS OWNERS, We hereby certify that we caused the land described on this
map to be surveyed, divided and mapped as represented on this map in
accordance with the Winnebago County Subdivision Ordinance.

WITNESS the hands and seals of said owners this _____ day
of _____, 1989.

In The Presence Of:

Kenneth W. Neubauer

Virginia V. Neubauer

STATE OF WISCONSIN)

188

WINNEBAGO COUNTY)

PERSONALLY came before me this _____ day of _____, 1989 the
above named Kenneth W. Neubauer and Virginia V. Neubauer, his wife, to
me known to be the persons who executed the foregoing instrument and
acknowledged the same.

Notary Public, Winnebago County,
State of Wisconsin

My Commission Expires _____


WINNEBAGO COUNTY PLANNING COMMISSION CERTIFICATE

THIS Certified Survey Map of a part of the S.W. 1/4 of the S.W. 1/4 of
Section 29, T18N, R16E, Town of Algoma, Winnebago County, Wisconsin,
Kenneth W. Neubauer and Virginia V. Neubauer, his wife, owners, is
hereby approved.

Date _____

Planning Committee Representative _____

THIS INSTRUMENT WAS DRAFTED BY REINHARD ROEHLIG.

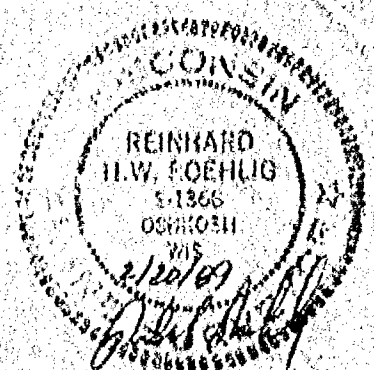

Stock No. 26273

88-1422

SHEET 1 OF 3

CERTIFIED SURVEY MAP NO. _____

BEING A PART OF THE S.W. 1/4 OF THE S.W. 1/4 OF SECTION 29, T18N, R16E,
IN THE TOWN OF ALGOMA, WINNEBAGO COUNTY, WISCONSIN.


○ ——— DENOTES 3/4 INCH DIAMETER IRON ROD, 24" LONG, WEIGHING
NOT LESS THAN 1.13 LBS PER LINEAL FOOT SET.

● ——— DENOTES 1 INCH DIAMETER IRON PIPE FOUND.

ALL DIMENSIONS SHOWN ARE MEASURED TO NEAREST HUNDREDTH OF A FOOT.


BEARINGS ARE REFERENCED TO THE SOUTH LINE OF THE S.W. 1/4 OF SECTION 29
WHICH HAS AN ASSUMED BEARING OF SOUTH 89-48-42 EAST.

△ ——— DENOTES P.K. NAIL SET.

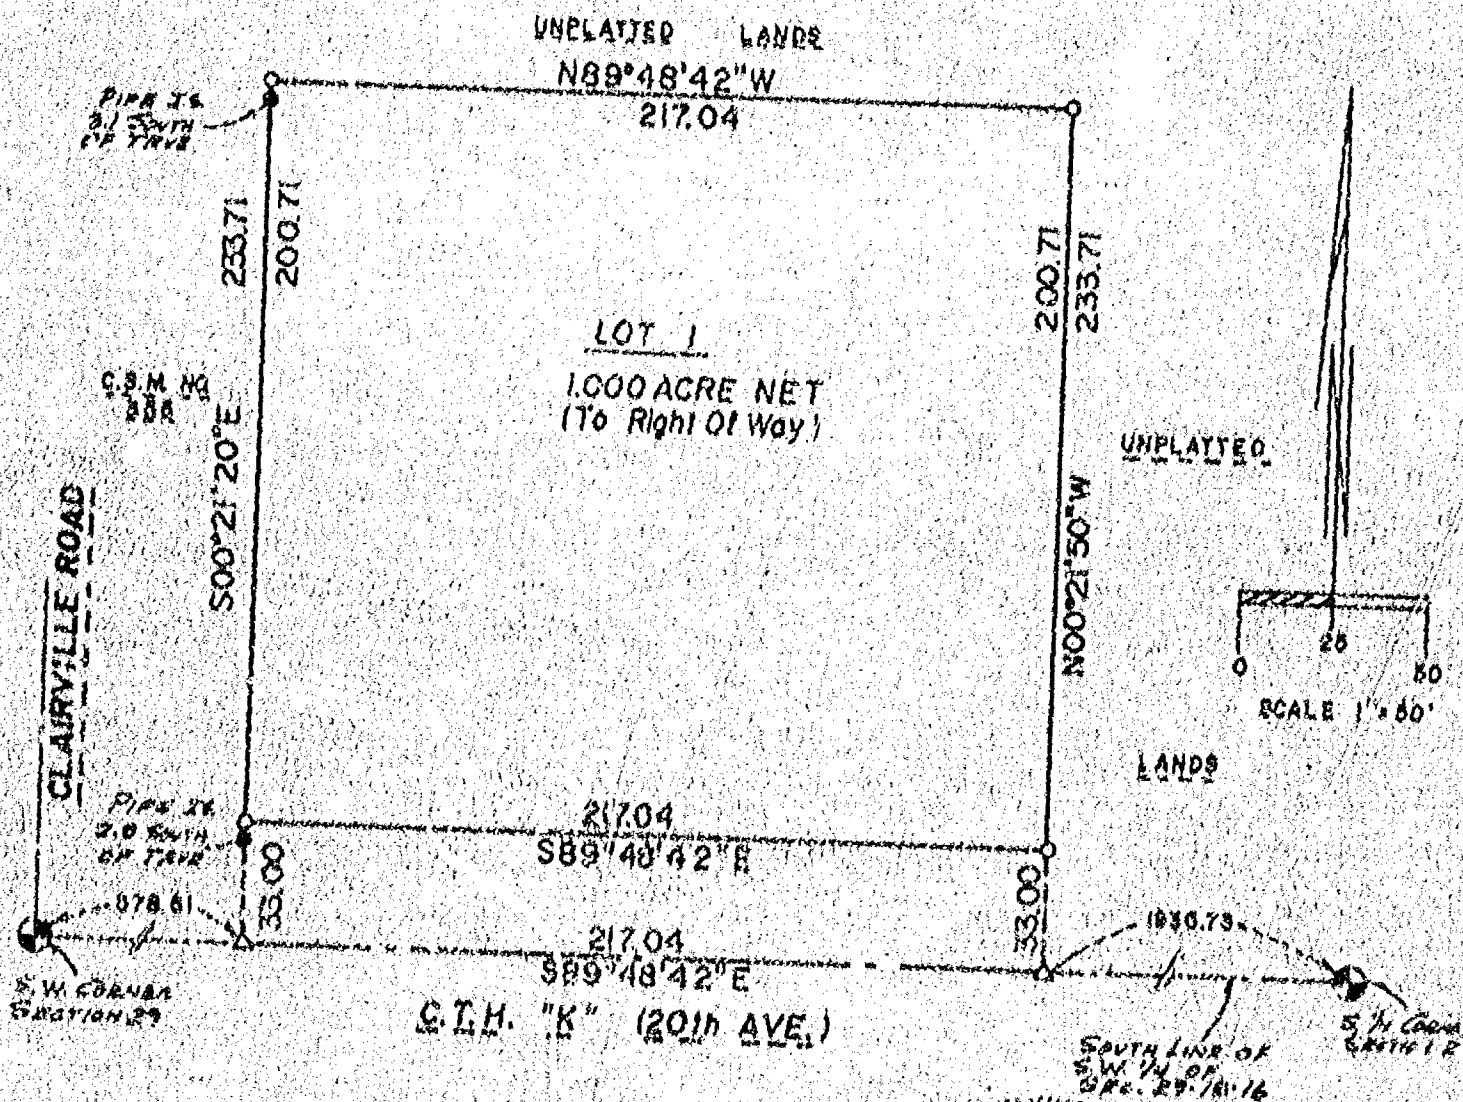

SCHULER & ASSOCIATES

CONSULTING ENGINEERS & LAND SURVEYORS
320 W. NORTLAND AVE. APPLETON, WIS. 54911 (608) 733-9107
417 NORTH SAWYER STREET OSHKOSH, WIS. 54901 (608) 686-2800

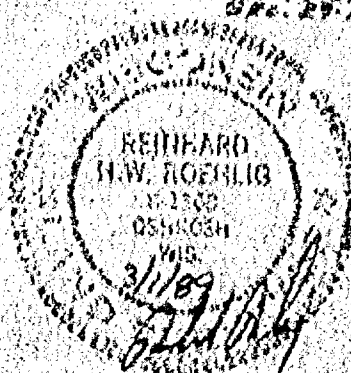

88-1422

Stock No. 26273

88-1422

SHEET 2 OF 3

CERTIFIED SURVEY MAP NO. _____

BEING A PART OF THE S.W. 1/4 OF THE S.W. 1/4 OF SECTION 29, T18N, R16E,
IN THE TOWN OF ALGOMA, WINNEBAGO COUNTY, WISCONSIN.

SURVEYOR'S CERTIFICATE
STATE OF WISCONSIN)

188

WINNEBAGO COUNTY)

I, REINHARD ROEHLIG, Wisconsin Land Surveyor do hereby certify;

THAT I have surveyed and mapped a part of the S.W. 1/4 of the S.W. 1/4
of Section 29, T18N, R16E, in the Town of Algoma, Winnebago County,
Wisconsin, which is bounded and described as follows;

Commencing at the S.W. 1/4 corner of said Section, thence South 89-48-
42 East along the South line of said S.W. 1/4 aforesaid 578.51 ft. to
the point of beginning of the parcel to be described, thence continuing
South 89-48-42 East 217.04 ft., thence North 00-21-50 West 233.71 ft.,
thence North 89-48-42 West 217.04 ft., thence South 00-21-50 East
233.71 ft. to the point of beginning.

THAT I have made this survey and land division by the direction of
Kenneth W. Neubauer and Virginia V. Neubauer, his wife, Town of Algoma,
Winnebago County, owner of said land.

THAT such map is a correct representation of all the exterior
boundaries of the land surveyed and the land division thereof made.

THAT I have fully complied with the provisions of Chapter 236 of the
Wisconsin Statutes and the Land Subdivision Ordinance of the Winnebago
County.


Date

3/1/89

Reinhard Roehlig
Reinhard Roehlig, Registered
Land Surveyor S-1368

(SEAL)



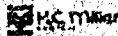

Stock No. 26273

88-1422

SHEET 3 OF 3

CERTIFIED SURVEY MAP NO. _____

BEING A PART OF THE S.W. 1/4 OF THE S.W. 1/4 OF SECTION 29, T18N, R16E,
IN THE TOWN OF ALGOMA, WINNEBAGO COUNTY, WISCONSIN.

OWNER'S CERTIFICATE

AS OWNERS, We hereby certify that We caused the land described on this map to be surveyed, divided and mapped as represented on this map in accordance with the Winnebago County Subdivision Ordinance.

WITNESS the hands and seals of said owners this _____ day
of _____ 1989.

In The Presence Of:

Kenneth W. Neubauer

Virginia V. Neubauer

STATE OF WISCONSIN)

183

WINNEBAGO COUNTY)

PERSONALLY came before me this _____ day of _____ 1989 the
above named Kenneth W. Neubauer and Virginia V. Neubauer, his wife, to
me known to be the persons who executed the foregoing instrument and
acknowledged the same.

Notary Public, Winnebago County,
State of Wisconsin

My Commission Expires _____


WINNEBAGO COUNTY PLANNING COMMISSION CERTIFICATE

THIS Certified Survey Map of a part of the S.W. 1/4 of the S.W. 1/4 of
Section 29, T18N, R16E, Town of Algoma, Winnebago County, Wisconsin,
Kenneth W. Neubauer and Virginia V. Neubauer, his wife, owners, is
hereby approved.

Date _____

Planning Committee Representative _____

THIS INSTRUMENT WAS DRAFTED BY REINHARD ROEHLIG.

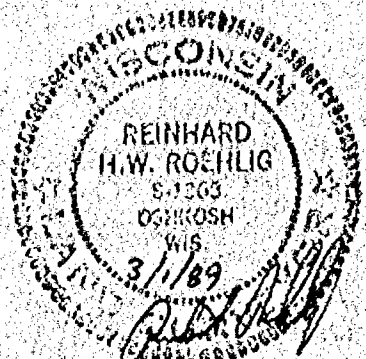

RE: MOOCO-ALGOMA
6-6-90



1837 West Wisconsin Ave.
P.O. Box 1297
Appleton, Wisconsin 54912-1297
Phone (414) 731-4168
FAX (414) 731-5673

PARCEL "A":

A PARCEL OF LAND LOCATED IN THE NE1/4 OF THE NW1/4 OF SECTION 29, T18N, R16E, TOWN OF ALGOMA, WINNEBAGO COUNTY, WISCONSIN, BOUNDED AND DESCRIBED AS FOLLOWS: COMMENCING AT THE NORTH 1/4 CORNER OF SECTION 29; THENCE N89-41-29W, 125.00 FEET ALONG THE NORTH LINE OF THE NW1/4 OF SECTION 29 TO THE WEST LINE OF LANDS DESCRIBED IN DOCUMENT #465469 AND TO THE POINT OF BEGINNING; THENCE CONTINUING N89-41-29W, 533.87 FEET ALONG SAID NORTH LINE TO THE EAST LINE OF A TOWN ROAD; THENCE S0-19-15W, 451.43 FEET ALONG SAID EAST LINE TO THE NORTH LINE OF LANDS DESCRIBED IN DOCUMENT #664080; THENCE S89-36-05E, 175.71 FEET ALONG SAID NORTH LINE TO THE EAST LINE OF SAID DESCRIBED LANDS; THENCE S0-19-15W, 417.42 FEET ALONG SAID EAST LINE AND ITS EXTENSION TO THE NORTH LINE OF LOT 1 OF CERTIFIED SURVEY MAP NO. 2045; THENCE N89-36-05W, 175.71 FEET ALONG SAID NORTH LINE TO THE EAST LINE OF A TOWN ROAD; THENCE S0-19-15W, 215.36 FEET ALONG SAID EAST LINE TO THE NORTH LINE OF A TOWN ROAD; THENCE S89-56-35E, 254.18 FEET ALONG SAID NORTH LINE TO THE WEST LINE OF LANDS DESCRIBED IN DOCUMENT #736391; THENCE N1-01-53W, 201.99 FEET ALONG SAID WEST LINE TO THE NORTH LINE OF SAID DESCRIBED LANDS; THENCE S89-56-35E, 430.22 FEET ALONG SAID NORTH LINE AND THE NORTH LINE OF LANDS DESCRIBED IN DOCUMENT #710661 TO THE EAST LINE OF THE NW1/4 OF SECTION 29; THENCE N1-01-53W, 670.80 FEET ALONG SAID EAST LINE TO THE SOUTH LINE OF LANDS DESCRIBED IN DOCUMENT #734460; THENCE N89-41-29W, 125.00 FEET ALONG SAID SOUTH LINE TO THE WEST LINE OF SAID DESCRIBED LANDS; THENCE N1-01-53W, 208.71 FEET ALONG SAID WEST LINE AND THE WEST LINE OF LANDS DESCRIBED IN DOCUMENT #465469 TO THE POINT OF BEGINNING. SAID PARCEL CONTAINS 12.417 ACRES OF LAND MORE OR LESS, SUBJECT TO ALL EASEMENTS AND RESTRICTIONS OF RECORD. RESERVING THAT PART PRESENTLY USED FOR ROAD PURPOSES.

Residential Lots • Farm Acreage Surveys • Commercial & Industrial Surveys • Topographic & Land Title Surveys • Mapping
Residential Planning • Subdivisions • Legal Descriptions • Building Staking • Certified Soil Testers • Condominium Plats

B905.44

RE: MOCCO-ALOMA
6-6-90

CAROW LAND SURVEYING
COMPANY, INC.

PARCEL "B":

A PARCEL OF LAND LOCATED IN THE NW1/4 OF SECTION 29, T18N, R16E, TOWN OF ALGOMA, WINNEBAGO COUNTY, WISCONSIN, BOUNDED AND DESCRIBED AS FOLLOWS: COMMENCING AT THE NORTH 1/4 CORNER OF SECTION 29; THENCE N89-41-29W, 724.87 FEET ALONG THE NORTH LINE OF THE NW1/4 OF SECTION 29 TO THE WEST LINE OF A TOWN ROAD; THENCE S0-19-15W, 1084.50 FEET ALONG SAID WEST LINE TO THE SOUTH LINE OF LANDS DESCRIBED IN DOCUMENT #579355 AND TO THE POINT OF BEGINNING; THENCE CONTINUING S0-19-15W, 66.00 FEET ALONG SAID WEST LINE TO THE SOUTH LINE OF A TOWN ROAD; THENCE S89-56-35E, 19.50 FEET ALONG SAID SOUTH LINE TO THE WEST LINE OF LANDS DESCRIBED IN DOCUMENT #515388; THENCE S0-03-48W, 175.71 FEET ALONG SAID WEST LINE TO THE SOUTH LINE OF THE NE1/4 OF THE NW1/4 OF SECTION 29 AS EVIDENCED AND OCCUPIED; THENCE S88-17-24W, 627.76 FEET ALONG SAID SOUTH LINE AS EVIDENCED AND OCCUPIED TO THE WEST LINE OF THE NE1/4 OF THE NW1/4 OF SECTION 29 AS EVIDENCED AND OCCUPIED; THENCE N0-25-17W, 1139.62 FEET ALONG SAID WEST LINE AS EVIDENCED AND OCCUPIED TO THE SOUTH LINE OF LANDS DESCRIBED IN DOCUMENT #703179 AS EVIDENCED; THENCE S89-41-29E, 413.25 FEET ALONG SAID SOUTH LINE AND THE SOUTH LINE OF LANDS DESCRIBED IN DOCUMENT #465795 TO THE WEST LINE OF LANDS DESCRIBED IN DOCUMENT #615503; THENCE S0-19-15W, 208.22 FEET ALONG SAID WEST LINE TO THE SOUTH LINE OF SAID DESCRIBED LANDS; THENCE S89-41-29E, 208.59 FEET ALONG SAID SOUTH LINE TO THE WEST LINE OF A TOWN ROAD; THENCE S0-19-15W, 34.06 FEET ALONG SAID WEST LINE TO THE NORTH LINE OF LANDS DESCRIBED IN DOCUMENT #568333; THENCE N89-40-15W, 209.21 FEET ALONG SAID NORTH LINE TO THE WEST LINE OF SAID DESCRIBED LANDS; THENCE S0-19-15W, 208.71 FEET ALONG SAID WEST LINE TO THE SOUTH LINE OF SAID DESCRIBED LANDS; THENCE S89-40-15E, 33.50 FEET ALONG SAID SOUTH LINE TO THE WEST LINE OF LANDS DESCRIBED IN DOCUMENT #621642; THENCE S0-19-15W, 425.63 FEET ALONG SAID WEST LINE AND THE WEST LINE OF LANDS DESCRIBED IN DOCUMENT #547005 AND DOCUMENT #579355 TO THE SOUTH LINE OF LANDS DESCRIBED IN DOCUMENT #579355; THENCE S89-56-35E, 175.71 FEET ALONG SAID SOUTH LINE TO THE POINT OF BEGINNING. SAID PARCEL CONTAINS 12.291 ACRES OF LAND MORE OR LESS. SUBJECT TO ALL EASEMENTS AND RESTRICTIONS OF RECORD.

Residential Lots • Farm Acreage Surveys • Commercial & Industrial Surveys • Topographic & Land Title Surveys • Mapping
Residential Planning • Subdivisions • Legal Descriptions • Building Staking • Certified Soil Testers • Condominium Plats

B905.44

ANNEXATION DESCRIPTION


Sheet 1 of 2

for
TOM RUSCH


NE cor. Section
29, T.18N., R.16E.

A part of the NE $\frac{1}{4}$ /NE $\frac{1}{4}$ and the SE $\frac{1}{4}$ /NE $\frac{1}{4}$, Section 29, T.18N., R.16E.,
Town of Algoma, Winnebago County, Wisconsin.

(See Sheet 2 of 2 for description)

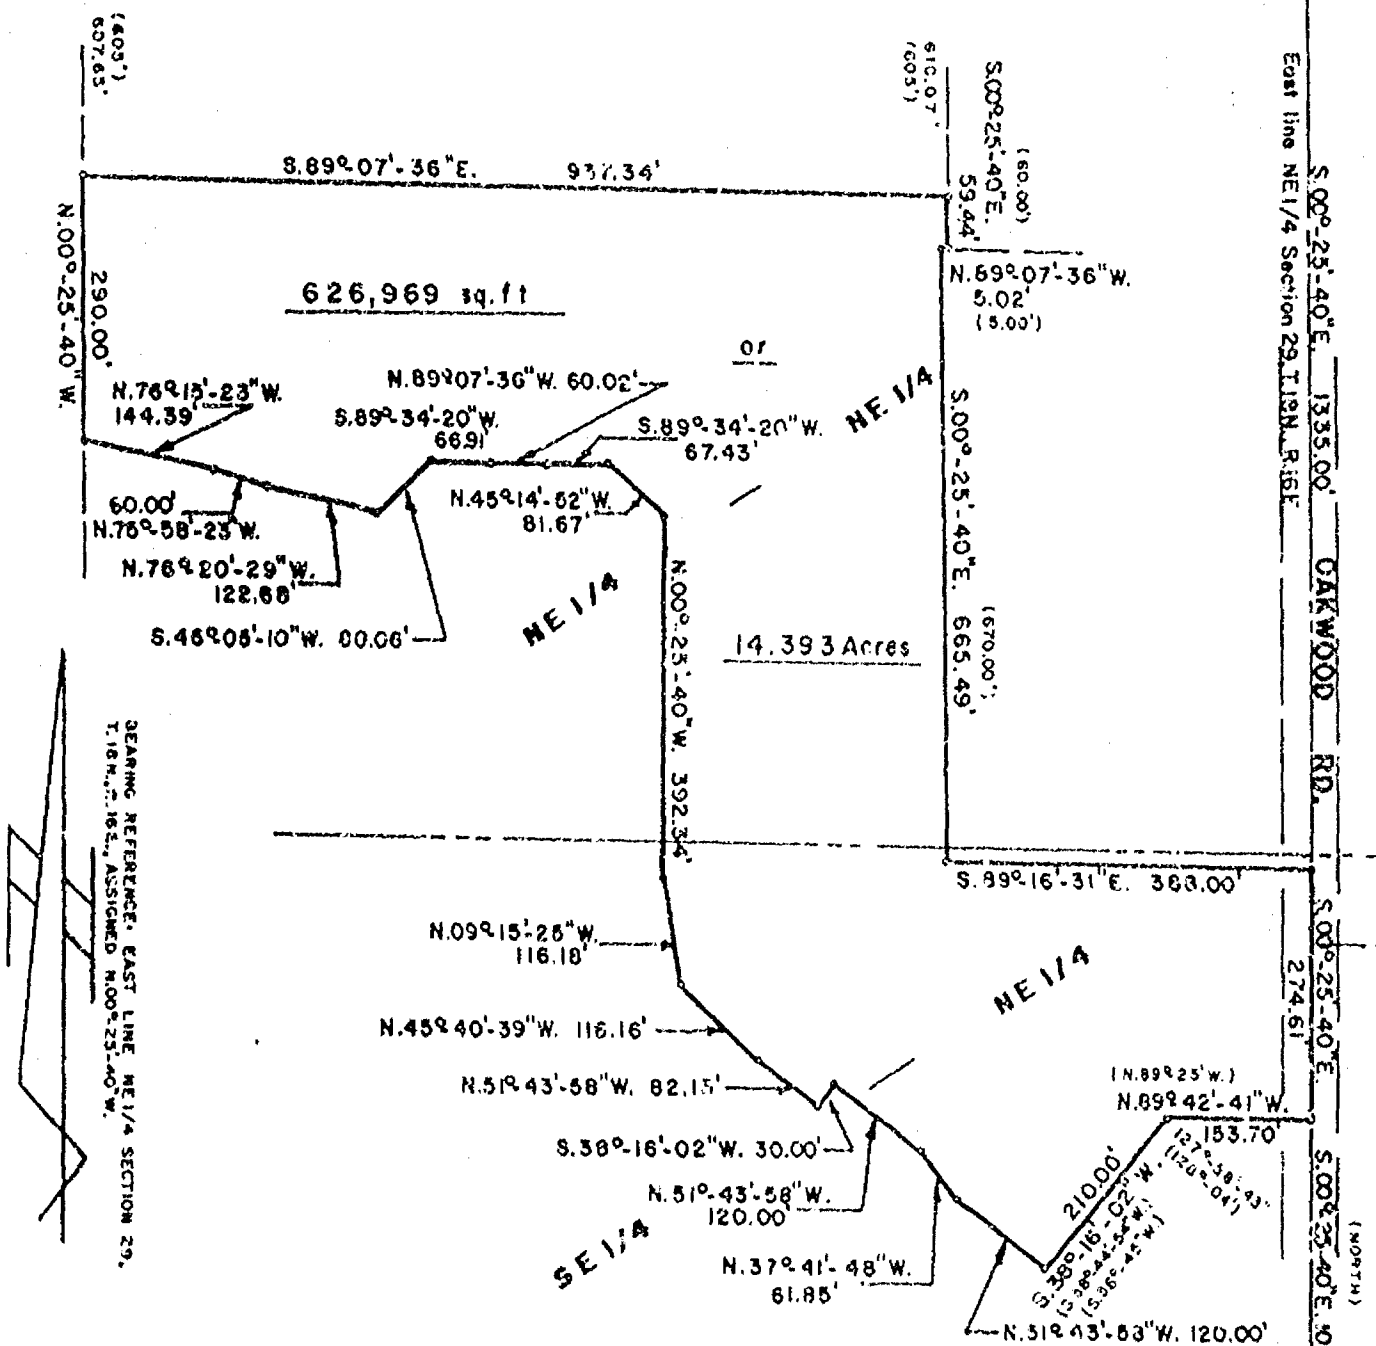

(N. 89° 25' W.) (670.00') • PREVIOUSLY RECORDED INFORMATION

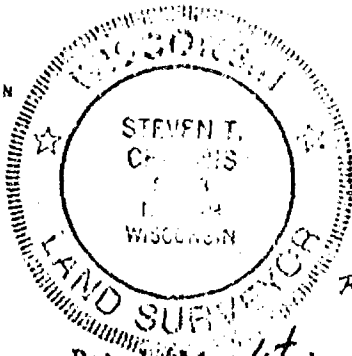


Revised 3/8/90 sk.

Dated this 1st day of February 1990.

WIS. REGISTERED LAND SURVEYOR S-0913

NOTEBOOK — PAGE —

AERO-METRIC ENGINEERING, INC.
PHOTOGRAMMETRIC ENGINEERS
LAND SURVEYORS
SHEBOYGAN, WISCONSIN

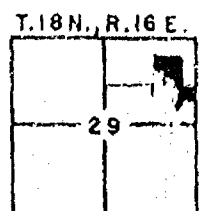

L-1026

WESTLEIGH

-ANNEXATION DESCRIPTION-

A part of the Northeast Quarter (NE $\frac{1}{4}$) of the Northeast (NE $\frac{1}{4}$) and the Southeast Quarter (SE $\frac{1}{4}$) of the Northeast Quarter (NE $\frac{1}{4}$) of Section Twenty-nine (29), Township Eighteen (18) North, Range Sixteen (16) East, Town of Algoma, Winnebago County, Wisconsin containing 14.393 Acres and being described by:


Commencing at the Northeast Corner of said Section 29; thence S.00°-25'-40"E. 1335.00 feet, along the East line of the NE $\frac{1}{4}$ of said Section 29 to the true point of beginning; thence continue S.00°-25'-40"E. 274.61 feet, along the East line of the NE $\frac{1}{4}$ of said Section 29 to a point 1033.00 feet North of the East $\frac{1}{4}$ Corner of said Section 29; thence N.89°-42'-41"W. 153.70 feet, (previously recorded as N.89°-25'W.); thence S.38°-16'-02"W. 210.00 feet, (previously recorded as Southwesterly on the West line of lands deeded by Horton and others to grantor by deed recorded in Volume 1075 of Records on Page 599 at an angle of 128°-04' with the previous line, S.38°-44'-54"W. and S.36°-45'W.), thence N.51°-43'-58"W. 120.00 feet; thence N.37°-41'-48"W. 61.85 feet; thence N.51°-43'-58"W. 120.00 feet; thence S.38°-16'-02"W. 30.00 feet; thence N.51°-43'-58"W. 82.13 feet; thence N.45°-40'-39"W. 116.16 feet; thence N.09°-15'-25"W. 116.18 feet; thence N.00°-25'-40"W. 392.34 feet; thence N.45°-14'-52"W. 81.67 feet; thence S.89°-34'-20"W. 67.43 feet; thence N.89°-07'-36"W. 60.02 feet; thence S.89°-34'-20"W. 56.91 feet; thence S.46°-05'-10"W. 80.06 feet; thence N.76°-20'-29"W. 122.68 feet; thence N.75°-58'-23"W. 60.00 feet; thence N.76°-15'-23"W. 144.39 feet; thence N.00°-25'-40"W. 290.00 feet; thence S.89°-07'-36"E. 937.34 feet; thence S.00°-25'-40"E. 59.44 feet (previously recorded as 60 feet); thence N.89°-07'-36"W. 5.02 feet (previously recorded as 5 feet); thence S.00°-25'-40"W. 665.49 feet (previously recorded as 670 feet); thence S.89°-16'-31"E. 308.00 feet to the true point of beginning.

STC/dmb
03/08/90



AERO-METRIC ENGINEERING, INC.
PHOTOGRAMMETRIC ENGINEERS
LAND SURVEYORS
SHEBOYGAN, WISCONSIN

Dated this 8th day of March, 1990
Steven T. Chalmers
WIS. REGISTERED LAND SURVEYOR S-0913

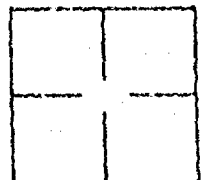

NOTEBOOK -- PAGE --

L-1826

SURVEYOR'S CERTIFICATE:


I, Thomas M. Kromm, Wisconsin Registered Land Surveyor of Aero-Metric Engineering, Inc., certify that I have surveyed, divided and mapped under the direction of Gary E. Galow a part of the Northeast Quarter (NE $\frac{1}{4}$) of the Northeast Quarter (NE $\frac{1}{4}$) of Section Twenty-nine (29), Township Eighteen (18) North, Range Sixteen (16) East, Town of Algoma, Winnebago County, Wisconsin containing 2.075 Acres of land and being described by:

Commencing at the Northeast Corner of said Section 29; thence S.00°-25'-40"E. 420.40 feet, along the East line of the NE $\frac{1}{4}$ of said Section 29; thence N.89°-09'-09"W. 842.88 feet to the true point of beginning; thence S.00°-40'-12"W. 190.20 feet; thence N.89°-07'-36"W. 473.63 feet; thence N.00°-25'-40"W. 190.02 feet; thence S.89°-09'-09"E. 477.26 feet to the true point of beginning.

The afore described being all those lands described in Volume 1118, Page 215 in the Winnebago County Register of Deeds Office.



That such is a correct representation of all exterior boundaries of the land surveyed.

That I have fully complied with the provisions of Chapter 236.34 of the Wisconsin Statutes and the Land Subdivision Ordinance of Winnebago County in surveying, dividing and mapping the same.

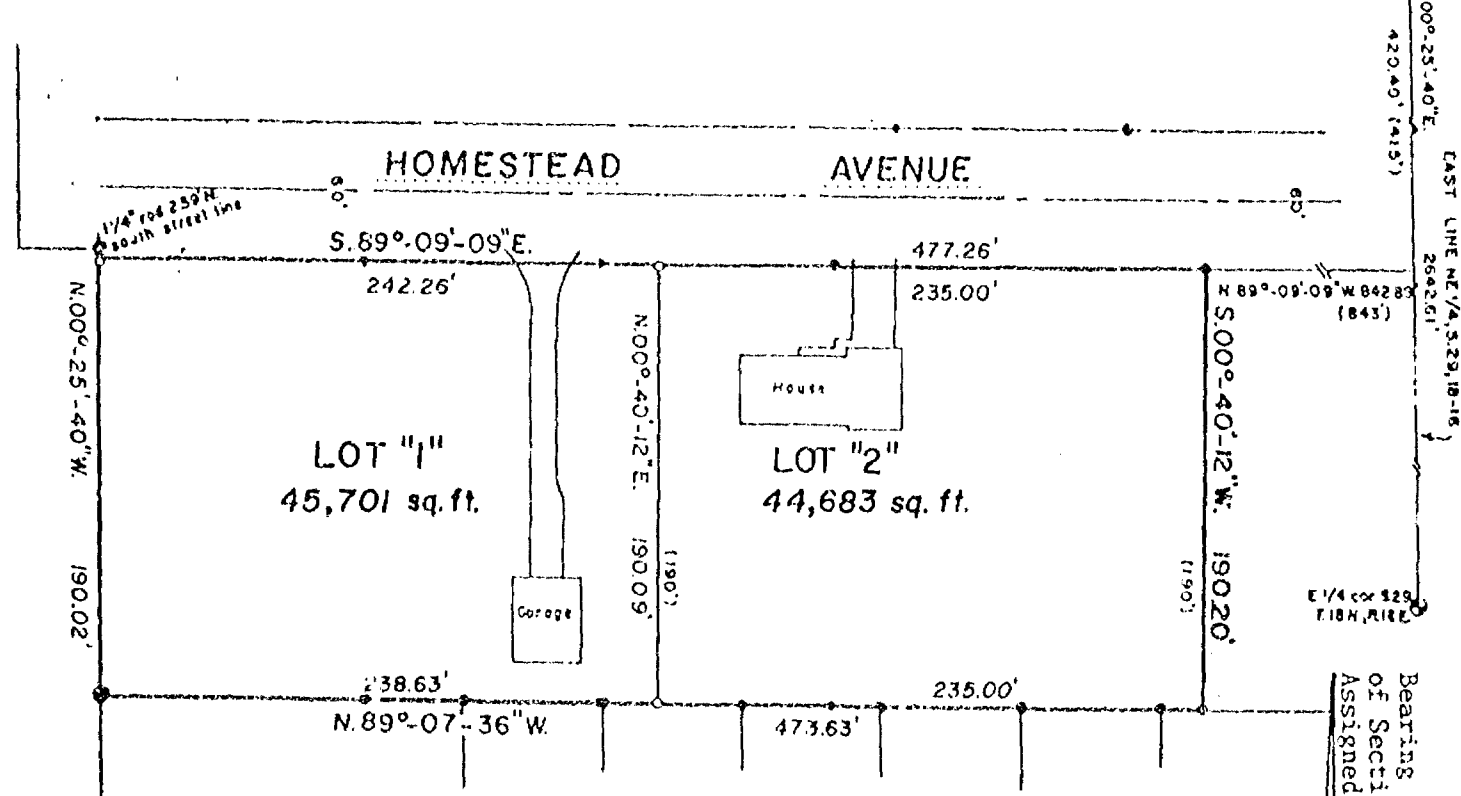

LEGEND

- = 1"X24" Iron Pipe weighing 1.68 lbs./lineal foot, Set
- = 3/4" Iron Pipe, Found
- = 1" Iron Pipe, Found
- = 1 1/2" Iron Pipe, Found
- = 2" Iron Pipe, Found
- ⊙ = Winnebago County Berntsen Monument
- () = Record Data

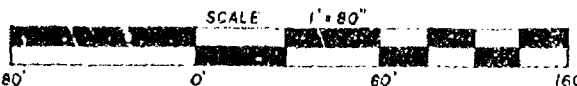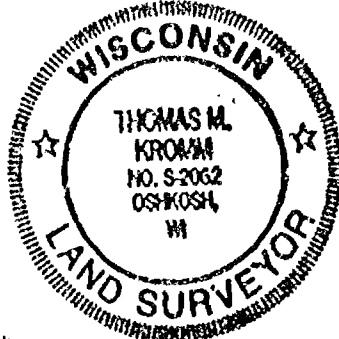

Dated this 3RD day of July, 1991.

Thomas M. Kromm
Wisconsin Registered Land Surveyor, S-2062

Revised this 8th day of August, 1991.

THIS INSTRUMENT DRAFTED BY: Thomas M. Kromm

NOTE BOOK 119

PAGE 34-38

L. 1990



Aero-Metric
ENGINEERING, INC.
LAND SURVEYS
539 NORTH MADISON ST.
CHILTON, WI 53014

WINNEBAGO COUNTY CERTIFIED SURVEY MAP NO. 2392

STATE OF WISCONSIN)
WINNEBAGO COUNTY)SS

Sheet 2 of 3

OWNER'S CERTIFICATE:

As Owners, we certify that we caused the land described on this Certified Survey Map to be surveyed, divided and mapped as represented on this map.

Dated this 11th day of July, 1991.


In the Presence of:

Walter W. Bush
Notary Public

Gary E. Galow
Gary E. Galow
Ruth A. Galow
Ruth A. Galow

STATE OF WISCONSIN)
WINNEBAGO COUNTY)SS

Personally came before me this 11th day of July, 1991, the above named Gary E. Galow and Ruth A. Galow to me known to be the persons who executed the foregoing instrument and acknowledged the same.

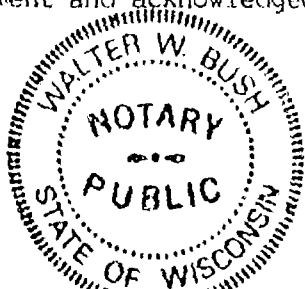

Walter W. Bush

Notary Public, Winnebago Co. Wisconsin

My Commission Expires 12 Permanently

WINNEBAGO COUNTY PLANNING & ZONING COMMITTEE:


This Certified Survey Map of a part of the NE $\frac{1}{4}$ of the NE $\frac{1}{4}$ of Section 29, T.18N., R.16E., Gary E. Galow and Ruth A. Galow, owners, is hereby approved.

Aug. 9, 1991
Date

Jeanette V. Diakoff
By: Jeanette V. Diakoff, Co-Chairperson

Dated this 3rd day of July, 1991.

Thomas M. Kromm
Wisconsin Registered Land Surveyor, S-2062
Thomas M. Kromm

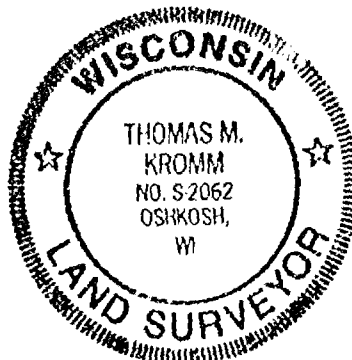

WINNEBAGO COUNTY CERTIFIED SURVEY MAP NO. 2392

STATE OF WISCONSIN)
WINNEBAGO COUNTY)^{SS}

Sheet 3 of 3

COUNTY TREASURER'S CERTIFICATE:

I, Ruth H. Bradley, being the duly elected, qualified and acting Treasurer of the County of Winnebago, do hereby certify that the records in my office show no unredeemed tax sales or no unpaid taxes or special assessments as of 7/11/91 affecting the lands included in this Certified Survey Map.

7/11/91
Date:

Ruth H. Bradley
County Treasurer: Ruth H. Bradley

CERTIFICATE OF TOWN TREASURER

STATE OF WISCONSIN)
WINNEBAGO COUNTY)^{SS}

I, Joel Edson being the duly elected, qualified and acting Town Treasurer of the Town of Algoma, do hereby certify that in accordance with the records in my office there are no unpaid taxes or unpaid special assessments as of July 16, 1991 on any of the land included in this Certified Survey Map.

7/16/91
Date:

Joel Edson
Town Treasurer: Joel Edson

Dated this 3RD day of July, 1991.

Thomas M. Kromm
Wisconsin Registered Land Surveyor, S-2062
Thomas M. Kromm



773405

Register's Office
Winnebago County, Wis.
Received for record this 9th
day of Aug. A.D., 1991
at 3:08 o'clock P. M. and
filed in Vol. 1 of CSM
on page 2392

Marjorie Adams
Register of Deeds

fd
14

S29 T18 R16

RECEIVED NOV 15 1991

STATE OF WISCONSIN)
WINNEBAGO COUNTY)SS

AFFIDAVIT OF CORRECTION

Sheet 1 of 1

For the purpose of correcting Certified Survey Map No. 2392, recorded in Volume 1 on Page 2392 of Certified Survey Maps, Document No. 773405 in the Winnebago County Register of Deeds Office.

I, Thomas M. Kromm, Registered Land Surveyor No. S-2062, of the State of Wisconsin, do hereby certify:

That I have surveyed and mapped Certified Survey Map No. 2392 of Certified Survey Maps, Document No. 773405 and recorded at 3:08 P.M. on August 9, 1991 in Volume 1 of Certified Survey Maps on Page 2392.

That the Third (3rd) paragraph of the Surveyor's Certificate reads: "The afore described being all those lands described in Volume 1118, Page 215 of records in the Winnebago County Register of Deeds Office".

That the Third (3rd) paragraph of the Surveyor's Certificate should in fact read "The afore described being all those lands described in Volume 1118, Page 215 of records and Document No. 772714 in the Winnebago County Register of Deeds Office".

That this Affidavit is made pursuant to S.236.295 of the Wisconsin Statutes.

That this Affidavit is given for the purpose of correcting said Certified Survey Map No. 2392 and for no other purpose.

In the Presence of:

Steven J. Charni
Rene M. Blatz

Dated this 8th day of November, 1991.

Thomas M. Kromm
Wisconsin Registered Land Surveyor,
S-2062
Thomas M. Kromm

STATE OF WISCONSIN)
WINNEBAGO COUNTY)SS

Personally came before me this 12th day of November, 1991, the above named Thomas M. Kromm, to me known to be the person who executed the foregoing instrument and acknowledged the same.

Lorraine C. Pregler
Notary Public, Oshkosh, Wisconsin
My Commission Expires July 10, 1994

Register's Office
Winnebago County, Wis.
Received for record
this 12th day of November
A.D. 19 91 at
8:00 o'clock AM

Gregory J. Dalmeida
REGISTER OF DEEDS

This Instrument drafted by Thomas M. Kromm

Aero-Metric
CSM

L-2042
L-1990

✓ CSM 1-2392
✓ 773405

✓ X780092