

2 - 19 - 15

NO.	SURVEYED FOR	SURVEYOR	DATE	PLAT NO.	CERTIFIED MAP NO.	SURVEYS		SURVEY LOCATION
						VOL.	PAGE	
1	Ramberg	Chas. J.	9-10-76					2-TM-RISE SW 1/4
2	Hesslaiche	Hawkins	9-23-80					SE 1/4
3	Schnuride	" "	11-3-81					SE-SE

632086

Register's Office
Winnebago County, Wis.
Received for record this 12th
day of June A.D., 1985
at 10:30 o'clock A.M. and
recorded in Vol. 1 of C.S.M.
on page 1400.

Ernest A. Johnson
Register of Deeds

Saylor Survey Chy
6.00

Stock No. 26273

WINNEBAGO COUNTY CERTIFIED SURVEY MAP NO. 1400
 Part of the W $\frac{1}{2}$ of the SE $\frac{1}{4}$ of Sec. 2, T.19N., R.15E., Town of
 Winneconne, Winnebago County, Wisconsin.

WINNEBAGO COUNTY PLANNING COMMITTEE CERTIFICATE

This Certified Survey Map of part of Sec. 2, T.19N.,
 R.15E., Town of Winneconne, is hereby approved.


Date

June 13, 1985

Authorized signature

Calvin W. Hawksworth

- Berntsen monument
 - △ Railroad spike set
 - 1"x30" iron pipe weighing 1.13 lbs./lineal ft.
- Bearings are referenced to the N-S $\frac{1}{4}$ Sec. line,
 assumed bearing N.01°17'52"W.

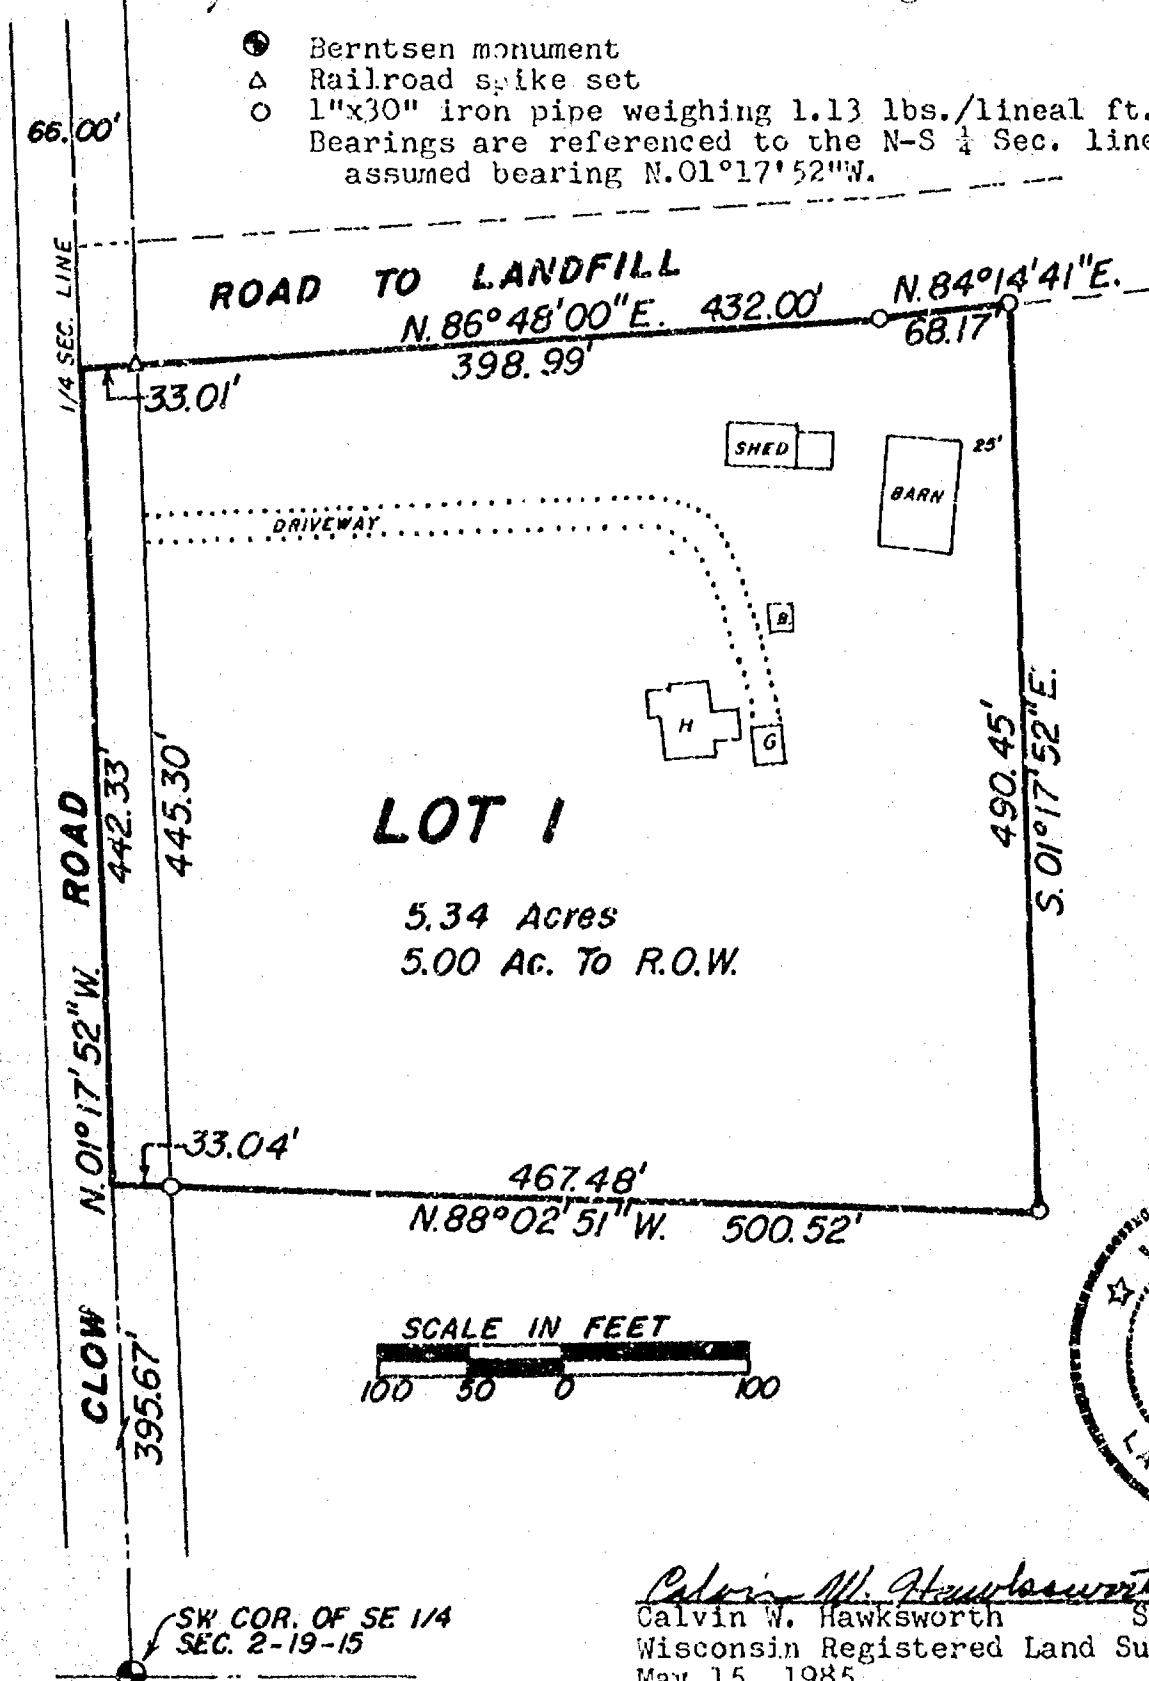

Calvin W. Hawksworth
 Calvin W. Hawksworth S-1290
 Wisconsin Registered Land Surveyor
 May 15, 1985

Sheet 1 of 2 sheets

Stock No. 26273

WINNEBAGO COUNTY CERTIFIED SURVEY MAP NO. 1400
Part of the $W\frac{1}{2}$ of the $SE\frac{1}{4}$ of Sec. 2, T.19N., R.15E., Town of
Winneconne, Winnebago County, Wisconsin.

SURVEYOR'S CERTIFICATE


I, Calvin W. Hawksworth, registered land surveyor, hereby
certify:

That I have surveyed, divided and mapped the parcel of land
located in part of the $W\frac{1}{2}$ of the $SE\frac{1}{4}$ of Sec. 2, T.19N., R.15E.,
Town of Winneconne, Winnebago County, Wisconsin, described as
follows: Beginning at a point on the West line of the $SE\frac{1}{4}$ of said
Sec. 2 that is 395.67 ft., $N01^{\circ}17'52''W.$ of the SW corner of the
 $SE\frac{1}{4}$ of said Sec. 2. From that point running $N.01^{\circ}17'52''W.$, 442.33
ft., thence $N.86^{\circ}48'00''E.$, 432.00 ft., thence $N.84^{\circ}14'41''E.$, 68.17
ft., thence $S.01^{\circ}17'52''E.$, 490.45 ft., thence $N.88^{\circ}02'51''W.$,
500.52 ft., to the said point of beginning. Being a parcel of land
of 5.34 acres, more or less.

That I have made such survey, land division and map by the
direction of Adeline Peterson (Ott), 6956 Clow Rd., Winneconne,
Wi.; 54986; that such map is a true and correct representation
of the exterior boundaries of the land surveyed.

That I have fully complied with the provisions of Sec. 236.34
of the Wisconsin Statutes and the Winnebago County Subdivisions
Ordinance in surveying, dividing and mapping the same.

Calvin W. Hawksworth
Calvin W. Hawksworth S-1290
Wisconsin Registered Land Surveyor
May 15, 1985

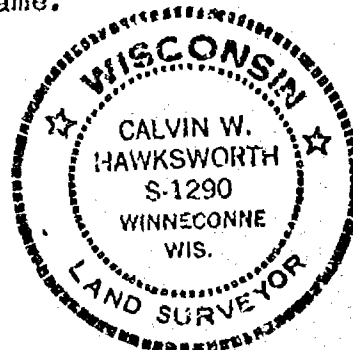

OWNER'S CERTIFICATE

As owner, I hereby certify that I caused the land described
on this certified survey map to be surveyed, divided and mapped
as represented hereon.

WITNESS the hand and seal of said owner this 20th day of
May, 1985.

In presence of:
Robert H. Saylor
Witness

Adeline Peterson
Adeline Peterson
6956 Clow Rd.
Winneconne, Wi. 54986

STATE OF WISCONSIN) SS
WINNEBAGO COUNTY)

Personally came before me this 20th day of May,
1985, the above named owner to me known to be the person who
executed the foregoing instrument and acknowledged the same.

Irene F. Haedt
Notary Public, Omro Wi.

My commission expires 10-16-1988.

 


Sheet 2 of 2 sheets

SAYLER SURVEY, INC. 139A. W. MAIN ST. WINNECONNE, WI.

zoning

FORM NO. 985-A




Stock No. 26273

REVISED WINNEBAGO COUNTY CERTIFIED SURVEY MAP NO. 1152
Located in the Southeast $\frac{1}{4}$ of the Northeast $\frac{1}{4}$ of Section 2,
T.19N., R.15E., Town of Winneconne, Winnebago County, Wisconsin

REVISION OF CERTIFIED SURVEY MAP NO. 1129, RECORDED MAY 1983
IN VOL. 1, PG. 1129, DOCUMENT NUMBER 591130

Calvin W. Hawksworth
Calvin W. Hawksworth S-1290
Wisconsin Registered Land Surveyor
June 3, 1983

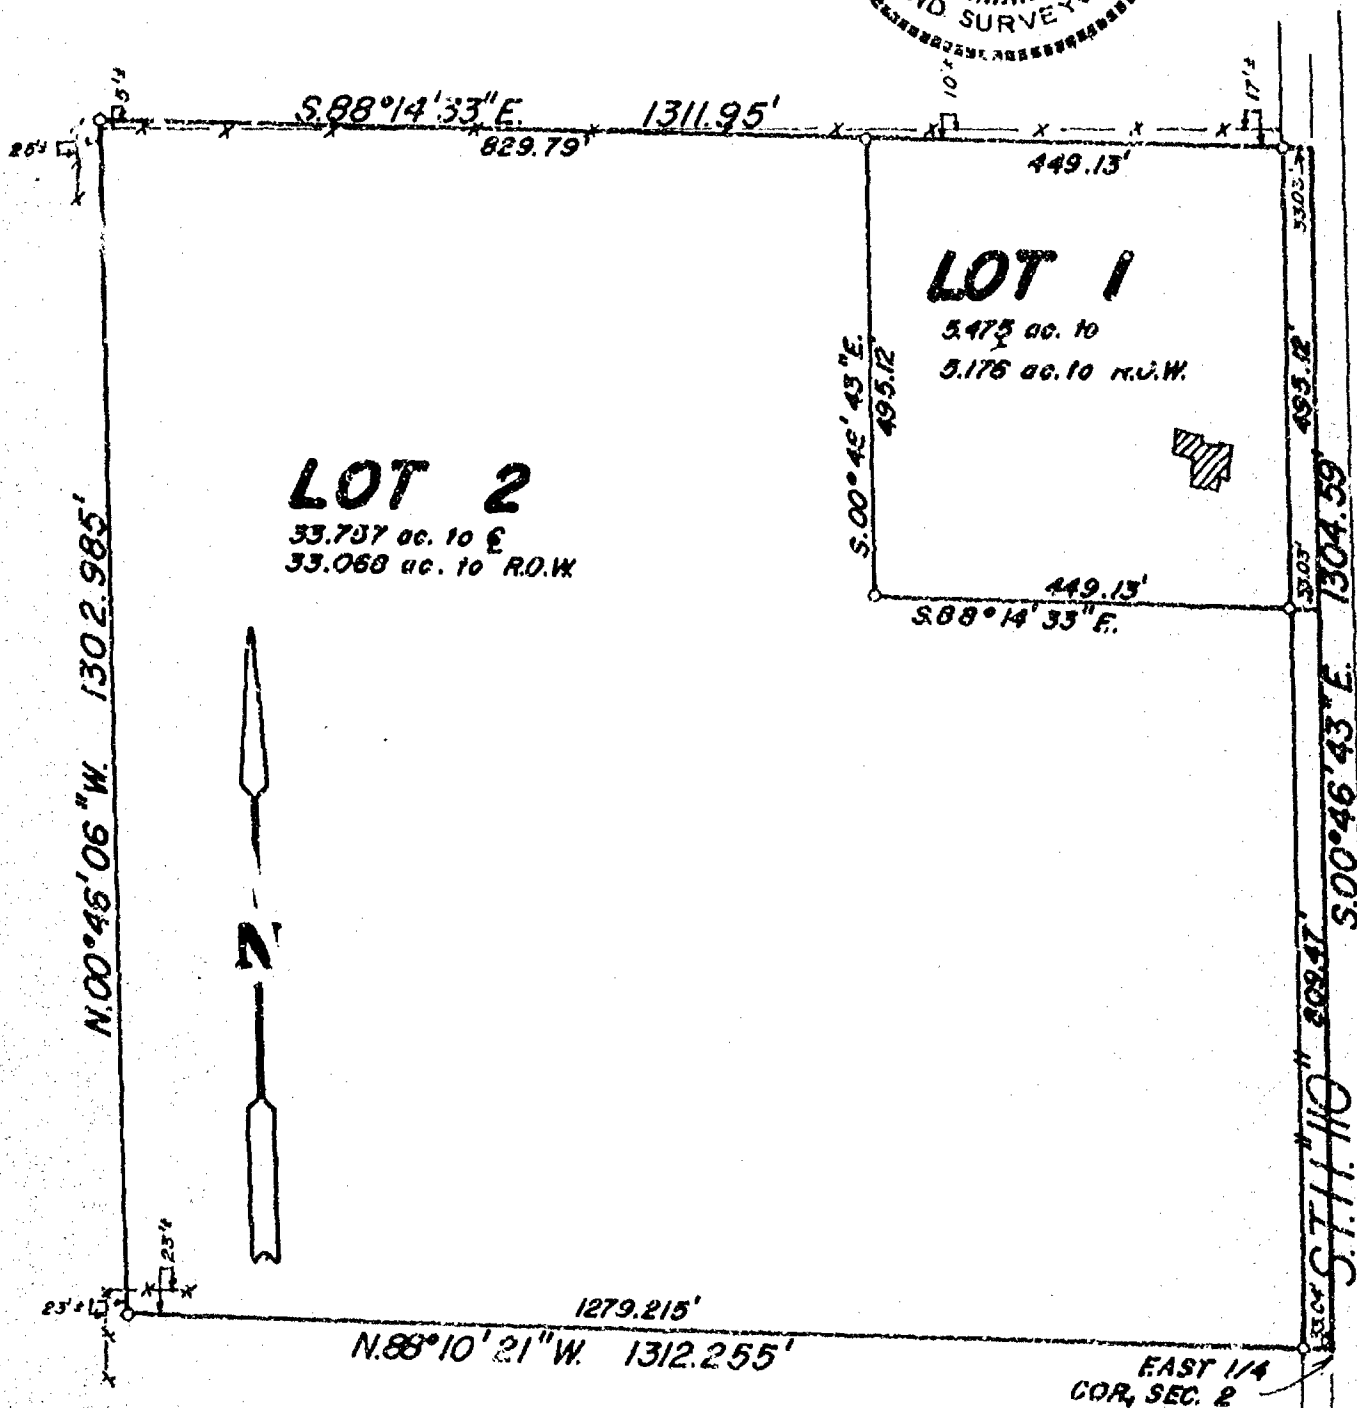

Stock No. 26273

REVISED WINNEBAGO COUNTY CERTIFIED SURVEY MAP NO. 1152
 Located in part of the Southeast $\frac{1}{4}$ of the Northeast $\frac{1}{4}$ of Section 2,
 T.19N., R.15E., Town of Winneconne, Winnebago County, Wisconsin

SURVEYOR'S CERTIFICATE

I, Calvin W. Hawksworth, registered land surveyor, hereby certify:

That I have surveyed, divided and mapped the parcel of land located in the Southeast $\frac{1}{4}$ of the Northeast $\frac{1}{4}$ of Section 2, T.19N., R.15E., Town of Winneconne, Winnebago County, Wisconsin, described as follows: Beginning at the East $\frac{1}{4}$ corner of Section 2, T.19N., R.15E. From that point running N.88°10'21"W. 1312.255 ft., thence N.00°46'06"W. 1302.935 ft., thence S.88°14'33"E. 1311.95 ft., thence S.00°46'43"E. 1304.59 ft. to the point of beginning. Being a parcel of 39.232 acres, more or less. Reserving therefrom that portion of the above described parcel presently used for road purposes.

That I have made such survey, land division and map by the direction of Don Pascarella, 5591 S.T.H. "116", Winneconne, WI 54986; that such map is a true and correct representation of the exterior boundaries of the land surveyed.

That I have fully complied with the provisions of Sec. 236.34 of the Wisconsin Statutes and the Winnebago County Subdivision Ordinance in surveying, dividing and mapping the same.



Calvin W. Hawksworth
 Calvin W. Hawksworth S-1290
 Wisconsin Registered Land Surveyor
 June 3, 1983

WINNEBAGO COUNTY PLANNING COMMITTEE CERTIFICATE

This Certified Survey Map of the Southeast $\frac{1}{4}$ of the Northeast $\frac{1}{4}$ of Section 2, T.19N., R.15E., Town of Winneconne, Winnebago County, Wisconsin, is hereby approved.

June 16, 1983
 Date Approved

Mary Ann Warming
 Authorized Signature

Sheet 2 of 3 Sheets

SAYLER SURVEY, INC. 330 Birch St., Box 252, Winneconne, WI 54986
 414-582-4234

Stock No. 26273

REVISED WINNEBAGO COUNTY CERTIFIED SURVEY MAP NO. 115.2
 Located in the Southeast $\frac{1}{4}$ of the Northeast $\frac{1}{4}$ of Section 2, T.19N.,
 R.15E., Town of Winneconne, Winnebago County, Wisconsin

OWNER'S CERTIFICATE

As owner, I hereby certify that I caused the land on this
 Certified Survey Map to be surveyed, divided and mapped as repre-
 sented hereon.

WITNESS the hand and seal of said owner this 10th day of
June, 1983.

In presence of:

Witness - PATRICK F. COUGHLIN

Dale W. Johnson
 Owner - Dale Johnson

6085 Avenue Juan Diaz

Street Address

Riverside, California 92509

City State Zip


STATE OF WISCONSIN } SS
 WINNEBAGO COUNTY }

Personally came before me this 10th day of June,
 1983, the above named owner to me known to be the person who executed
 the foregoing instrument and acknowledged the same.

Patrick F. Coughlin
 Notary Public - Patrick F. Coughlin

My commission is permanent.

Calvin W. Hawksworth
 Calvin W. Hawksworth S-1290
 Wisconsin Registered Land Surveyor
 June 3, 1983

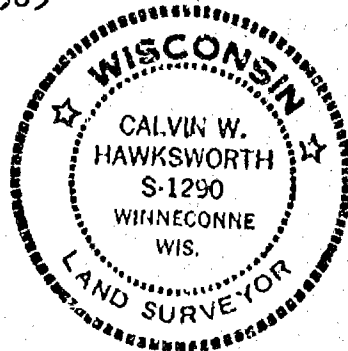

Sheet 3 of 3 Sheets
 (See Reverse Side)

SAYLER SURVEY, INC. 330 Birch St., Box 252, Winneconne, WI 54986
 414-582-4234

REVISED WINNEBAGO COUNTY CERTIFIED SURVEY MAP NO. 1152
Located in the Southeast $\frac{1}{4}$ of the Northeast $\frac{1}{4}$ of Section 2, T.19N.,
R.15E., Town of Winneconne, Winnebago County, Wisconsin

OWNER'S CERTIFICATE

As owner, I hereby certify that I caused the land described on
this Certified Survey Map to be surveyed, divided and mapped as
represented hereon.

WITNESS the hand and seal of said owner this 10th day of
June, 1983.

In presence of:

Witness - PATRICK F. COUGHLIN

Carol A. Johnson
Owner - Carol A. Johnson

641 Aubrey Drive
Street Address

STATE OF WISCONSIN)
WINNEBAGO COUNTY) SS

Virginia Beach, Virginia 23458
City State Zip

~~WITH THE ARMED FORCES OF THE UNITED STATES)~~
~~AT KEFLAVIK INTERNATIONAL AIRPORT, ICELAND)~~ SC

Personally came before me this 10th day of June
1983, the above named Carol A. Johnson to me known to be the person
who executed the foregoing instrument and acknowledged the same.

Patrick F. Coughlin
Notary Public - PATRICK F. COUGHLIN
My Commission is permanent.

Calvin W. Hawksworth
Calvin W. Hawksworth S-1290
Wisconsin Registered Land Surveyor
June 3, 1983



Register's Office
Winnebago County, Wis.
Received for record this 16th day of August A.D. 1983
at 7:32 o'clock A.M. and
recorded in Vol. 1152 of S.M.
Register of Deeds
Register of Deeds

RECEIVED JUL 26 1983


Copy to
10
atty Patrick Coughlin

596311

Stock No. 26273

WINNEBAGO COUNTY CERTIFIED SURVEY MAP NO. 112.9
 Located in the Southeast 1/4 of the Northeast 1/4 of Section 2,
 T.19N., R.15E., Town of Winneconne, Winnebago County, Wisconsin

Calvin W. Hawksworth
 Calvin W. Hawksworth S-1290
 Wisconsin Registered Land Surveyor
 June 8, 1982

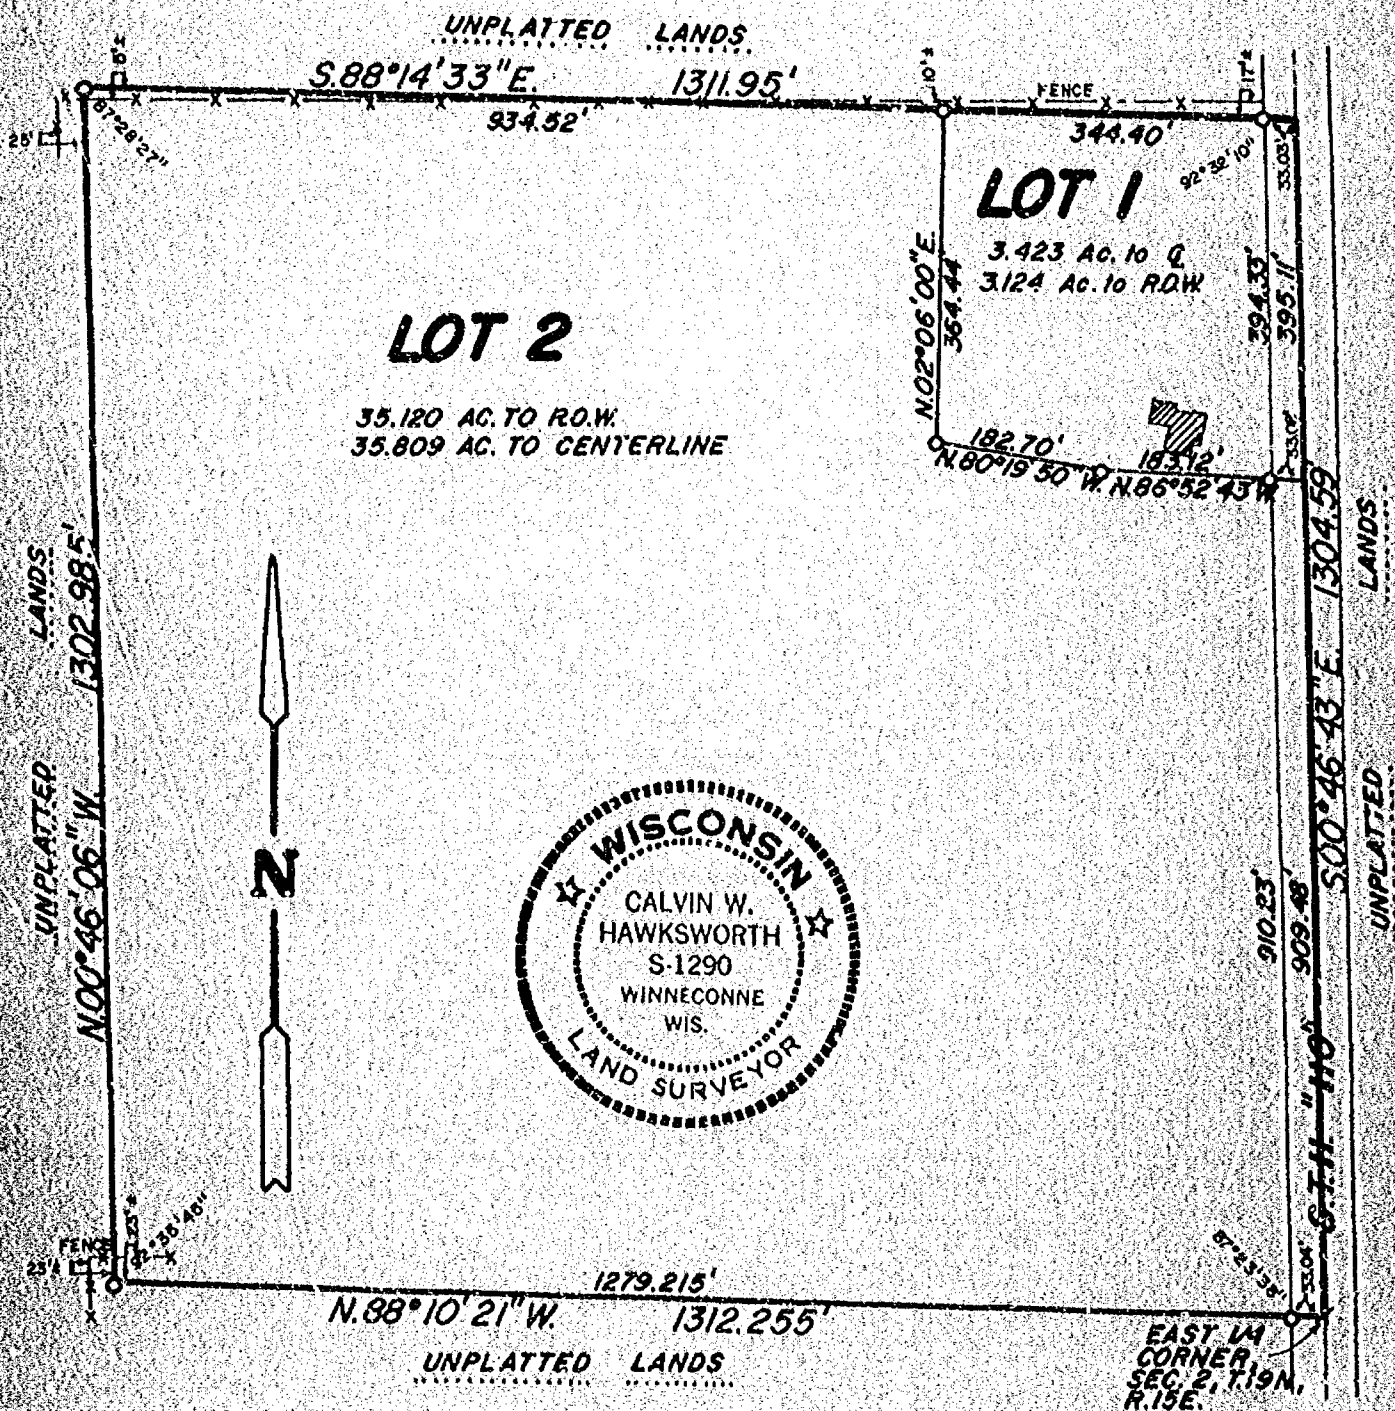

BEARINGS ARE REFERENCED TO THE
 EAST LINE OF THE NE 1/4, SEC. 2, T.19N.,
 R.15E. ASSUMED BEARING S.00°46'43"E.

SAYLER SURVEY, INC. LAND SURVEYORS WINNECONNE, WI FB 42 P151 CS-001291

Stock No. 26273

WINNEBAGO COUNTY CERTIFIED SURVEY MAP NO. 1127
 Located in the Southeast $\frac{1}{4}$ of the Northeast $\frac{1}{4}$ of Section 2,
 T.19N., R.15E., Town of Winneconne, Winnebago County, Wisconsin

SURVEYOR'S CERTIFICATE

I, Calvin W. Hawksworth, registered land surveyor, hereby certify:

That I have surveyed, divided and mapped the parcel of land located in the Southeast $\frac{1}{4}$ of the Northeast $\frac{1}{4}$ of Section 2, T.19N., R.15E., Town of Winneconne, Winnebago County, Wisconsin, described as follows: Beginning at the East $\frac{1}{4}$ corner of Section 2, T.19N., R.15E. From that point running N.88°10'21"W. 1312.255 ft., thence N.00°46'06"W. 1302.985 ft., thence S.88°14'33"E. 1311.95 ft., thence S.00°46'43"E. 1304.59 ft. to the point of beginning. Being a parcel of 39.232 acres, more or less. Reserving therefrom that portion of the above described parcel presently used for road purposes.

That I have made such survey, land division and map by the direction of Carol Johnson, 7181 Highway 110, Winneconne, WI and Wayne Schrweide, 6990 Highway 110, Winneconne, WI; that such map is a true and correct representation of the exterior boundaries of the land surveyed.

That I have fully complied with the provisions of Sec. 236.34 of the Wisconsin Statutes and the Winnebago County Subdivision Ordinance in surveying, dividing and mapping the same.



Calvin W. Hawksworth
 Calvin W. Hawksworth S-1290
 Wisconsin Registered Land Surveyor
 June 8, 1982

WINNEBAGO COUNTY PLANNING COMMITTEE CERTIFICATE

This Certified Survey Map of part of the Southeast $\frac{1}{4}$ of the Northeast $\frac{1}{4}$ of Section 2, T.19N., R.15E., Town of Winneconne, Winnebago County, Wisconsin, is hereby approved.

Feb. 23, 1983
 Date Approved

Mary Ann Warring
 Authorized Representative of the
 Winnebago County Planning Committee

Stock No. 26273

WINNEBAGO COUNTY CERTIFIED SURVEY MAP NO. 1129
 Located in the Southeast $\frac{1}{4}$ of the Northeast $\frac{1}{4}$ of Section 2,
 T.19N., R.15E., Town of Winneconne, Winnebago County, Wisconsin

OWNER'S CERTIFICATE

As owner(s), I(we) hereby certify that I(we) caused the
 land described on this Certified Survey Map to be surveyed,
 divided and mapped as represented hereon.

WITNESS the hand and seal of said owner(s) this 31
 day of December, 1982.

In presence of:

Margaret C. Martin
 Witness

Dale W. Johnson
 Owner(s)

1485 Ave. Jean Ray
 Street Address

Riverside, Cal. 92509
 City, State Zip

STATE OF CALIFORNIA

COUNTY OF RIVERSIDE

On DECEMBER 31, 1982, before me, the undersigned, a Notary Public in and for
 said State, personally appeared DALE W. JOHNSON (only)

who executed

known to me to be the person, whose name is


subscribed to the within instrument and acknowledged to me

that he executed the same

WITNESS my hand and official seal.

Signature Margaret C. Martin

MARGARET C. MARTIN
 Name (Typed or Printed)

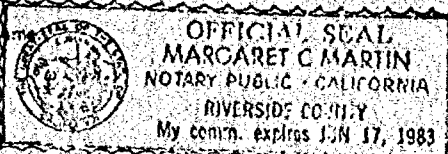

(This area for official notarial seal)



Calvin W. Hawksworth 9-1290
 Calvin W. Hawksworth
 Wisconsin Registered Land Surveyor
 June 8, 1982

WINNEBAGO COUNTY CERTIFIED SURVEY MAP NO. 1129
Located in the Southeast 1/4 of the Northeast 1/4 of Section 2,
T.19N., R.15E., Town of Winneconne, Winnebago County, Wisconsin

OWNER'S CERTIFICATE

As owner(s), I(we) hereby certify that I(we) caused the land described on this Certified Survey Map to be surveyed, divided and mapped as represented hereon.

WITNESS the hand and seal of said owner(s) this 13 day of JAN, 1983.

In presence of:

Myra L. Hallis
WITNESS

Carol A. Johnson
OWNER(S)

NAVAC Keflavik
PO Box 7
STREET ADDRESS


FPO New York, N.Y. 09571
CITY, STATE ZIP

WITH THE ARMED FORCES OF THE UNITED STATES)
) ss
AT KEFLAVIK INTERNATIONAL AIRPORT, ICELAND)

Personally came before me this 13th day of January, 19 83 the above named to me known to be the person(s) who executed the foregoing instrument and acknowledged the same.

Joel K. Meese
JOEL K. MEESE
LT, JAGC, USNR
Ass't Staff Judge Advocate
U.S. Naval Station
FPO NY 09571

By Auth: 10 USC 936

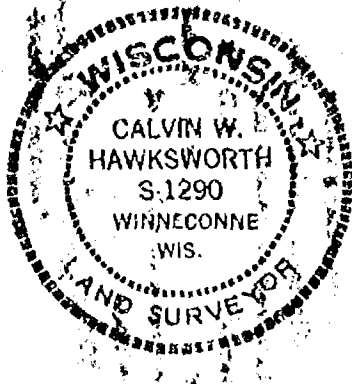

Calvin W. Hawksworth
CALVIN W. HAWKSWORTH S-1290
WISCONSIN REGISTERED LAND SURVEYOR
June 8, 1982

591130


Register's Office
Winnebago County, Wis.
received for record this *24th*
day of *July* *1883*
at *2:14* o'clock *P.*M. and
recorded in Vol. *1* of *S.M.*
on page *1127*.
Wm. J. Nelson
Register of Deeds

Joseph Malecki *Pd*
Cobbish *10⁰⁰*

WEST LINE OF THE NE $\frac{1}{4}$

ROAD

CLOW

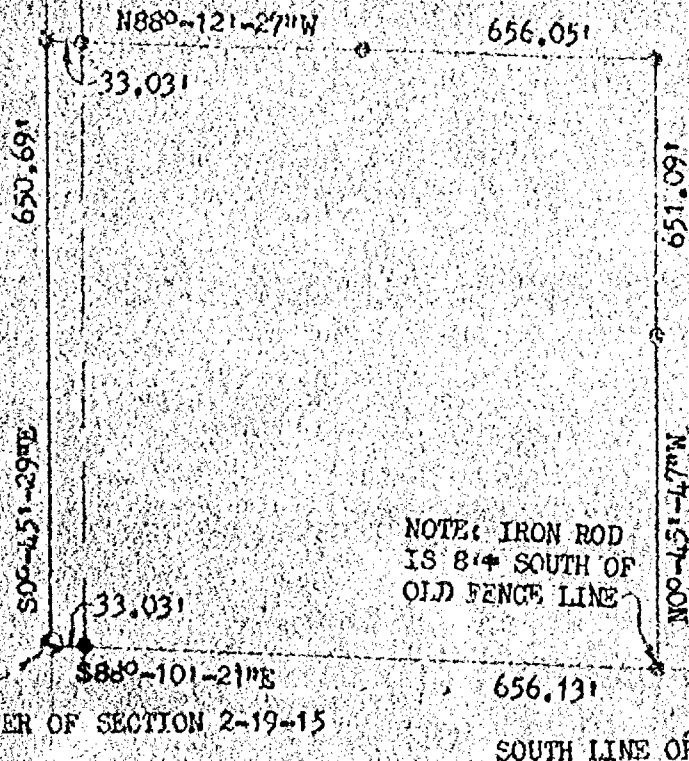

DESCRIPTION: LANDS DESCRIBED IN DOCUMENT #536007 BEING THE SW $\frac{1}{4}$ OF THE SW $\frac{1}{4}$ OF THE NE $\frac{1}{4}$ OF SECTION 2, T.19N., R.15E. TOWN OF WINNECONNE, WINNEBAGO COUNTY, WISCONSIN. MORE FULLY DESCRIBED AS FOLLOWS: BEGINNING AT THE CENTER OF SECTION 2; THENCE S88°-10'-21"E, 656.13 FEET ALONG THE SOUTH LINE OF THE NE $\frac{1}{4}$; THENCE N0°-45'-47"W, 651.09 FEET; THENCE N88°-12'-27"W, 656.05 FEET TO A POINT ON THE WEST LINE OF THE NE $\frac{1}{4}$; THENCE S0°-45'-29"E, 650.69 FEET ALONG SAID WEST LINE TO THE POINT OF BEGINNING, SAID PARCEL CONTAINS 9.79 ACRES OF LAND MORE OR LESS. SUBJECT TO ALL EASEMENTS AND RESTRICTIONS OF RECORD. RESERVING THAT PART PRESENTLY USED FOR ROAD PURPOSES.

LEGEND


● = BLUNTSEW MONUMENT FOUND

● = 3/4" x 24" SOLID ROUND #6 REBAR SET

⊞ = P.K. NAIL SET

I, ROBERT F. REIDER, CERTIFY THAT THIS PLAT OF SURVEY IS A CORRECT REPRESENTATION OF THE PROPERTY DESCRIBED.

Robert F. Reider 6-25-82

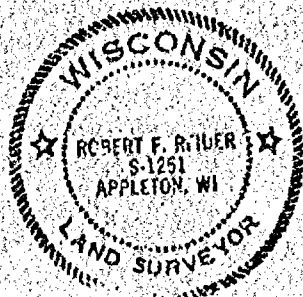

REVISIONS	JANET VAN OUDENHOVEN 7118 CLOW ROAD, WINNECONNE, WIS. 54985		
	CAROW LAND SURVEYING CO., INC., P.O. BOX 1297 1837 W. WISCONSIN AVE. APPLETON, WI 54912		
DRAWN BY	rr th RFR	SCALE	1"=200'
APP'D	LEG	DATE	6-25-82
		DRAWING NO.	1826.211

2-19-15

Plat of Survey


Part of the S.E. 1/4 of the S.E. 1/4 of Section 2, T.19N., R.15E.,
Town of Winneconne, Winnebago County, Wisconsin.

LEGAL DESCRIPTION

All that part of the S.E. 1/4 of the S.E. 1/4 of Section 2, T.19N., R.15E., Town of Winneconne, Winnebago County, Wisconsin, described as follows: Beginning at the Southeast corner of Section 2, T.19N., R.15E., that is on the centerline of State Trunk Highway "110". From that point running N. 87° 20' 07" W., 1143.81 ft., thence N. 00° 00' 00" E., 200.00 ft., thence S. 87° 20' 07" E., 1143.81 ft., thence S. 00° 00' 00" W., 200.00 ft. to the point of beginning. Being a parcel of land containing 5.245 acres, more or less.

CLIENT:

Wayne Sohrweide
6990 Highway 110
Winneconne, WI 54986

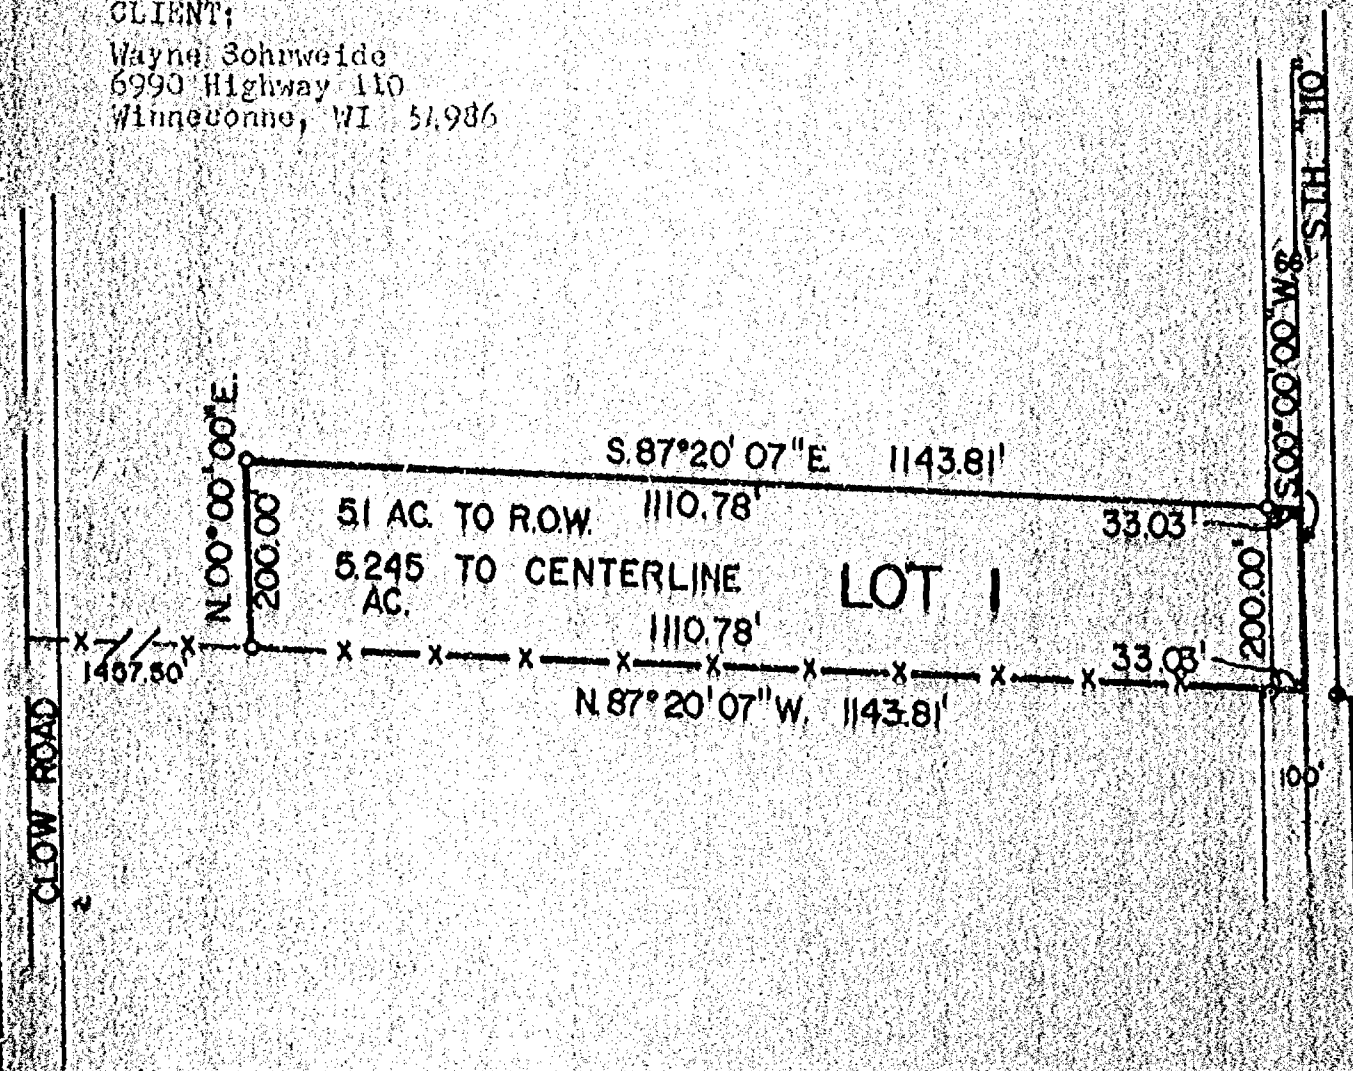

LEGEND

- = Existing monuments
- = 2" x 30" iron pipe set
- ◊ = 1" x 30" iron pipe set
- ✱ = R.O.W. POST
- ⊙ = Bernisen or Harrison monuments
- X-X = fence
- () = recorded as
- = stone monument



SURVEYORS CERTIFICATE

I, hereby certify that I have surveyed the property as shown, according to official records and that the plat above drawn is an accurate and correct representation of said survey. NOVEMBER 8, 1981

Calvin W. Hawksworth

Wisconsin Registered Land Surveyor S-1290





R. K. SAYLER, INC.
LAND SURVEYORS
WINNECONNE, WI 54986

SCALE 1" = 200'
PROJECT NO. S-001248
FIELD BOOK 43 PAGE 14

Survey for Leslie Romberg Description


A tract of land in the Southeast Quarter (SE $\frac{1}{4}$) of the Southwest Quarter (SW $\frac{1}{4}$) of Section Two (2), Township Nineteen (19) North, Range Fifteen (15) East, Town of Winneconne, Winnebago County, Wisconsin containing 5.000 Acres and being described by: Commencing at the South $\frac{1}{4}$ Corner of said Section 2, thence N. 02°-05'-17" W. 421.17 feet along the North-South $\frac{1}{4}$ Line of said Section 2, previously recorded as N. 01°-42' W. 423 feet, to the true point of beginning, thence continue N. 02°-05'-17" W. 401.83 feet along the North-South $\frac{1}{4}$ Line of said Section 2, thence S. 87°-54'-43" W. 436.43 feet, thence S. 02°-05'-17" E. 569.60 feet, thence N. 87°-54'-43" E. 185.75 feet to a one inch iron pipe found, thence N. 30°-12'-18" E. 159.60 feet, previously recorded as N. 30°-07' E. 159.7 feet, thence N. 76°-40'-46" E. 168.65 feet, previously recorded as N. 76°-37' E. 172 feet, to the true point of beginning.

Note: This survey does not comply with the minimum standards for property surveys in that the true North and South Quarter Corner locations were not established by the request of Mr. Romberg.

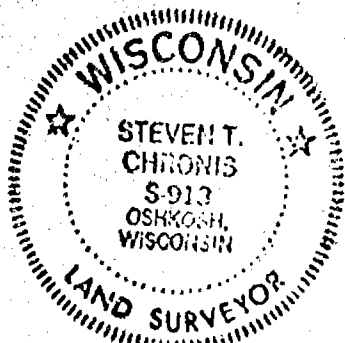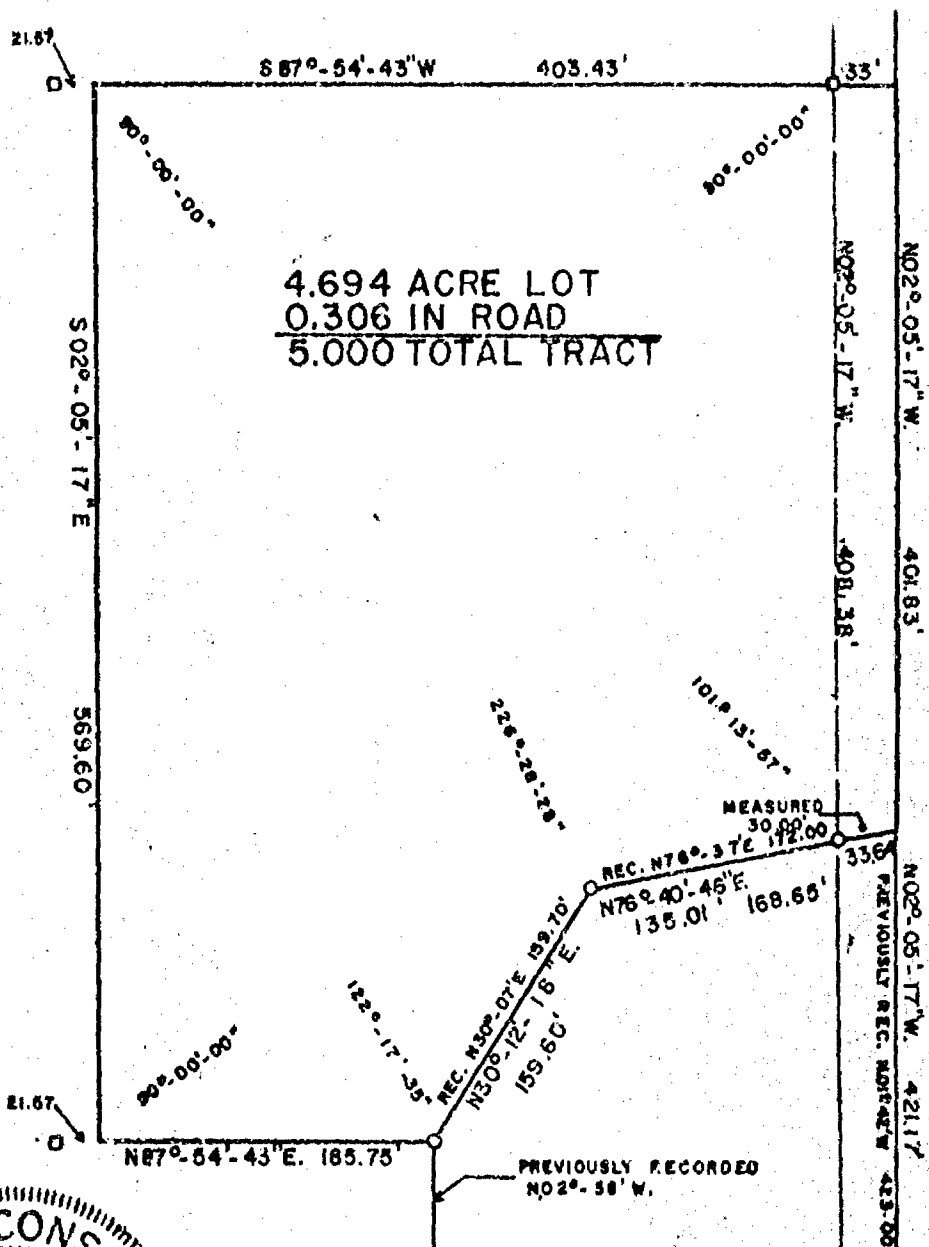


AERO-METRIC ENGINEERING, INC.
PHOTOGRAMMETRIC ENGINEERS
LAND SURVEYORS
OSHKOSH, WISCONSIN

Steven T. Chronis
WIS. REGISTERED LAND SURVEYOR S-913

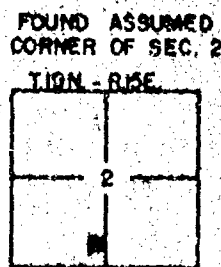

19-15-2


WINNEBAGO COUNTY CERTIFIED SURVEY MAP NO. _____

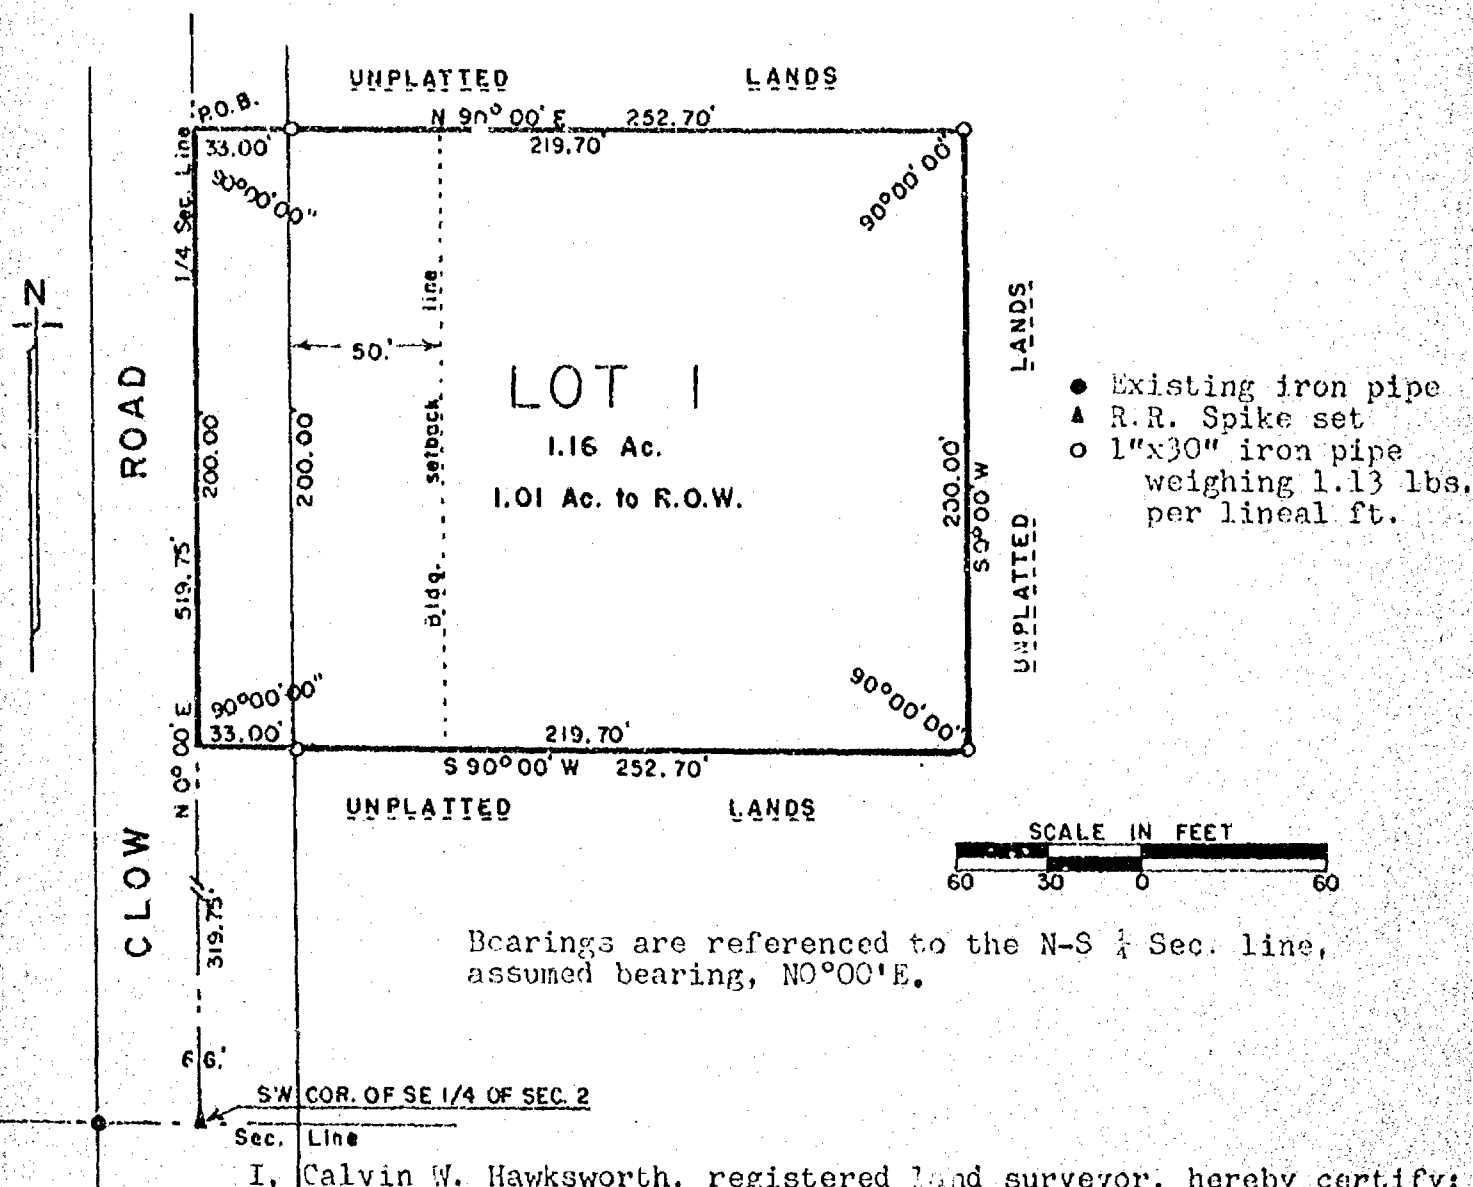Part of the SW $\frac{1}{4}$ of the SE $\frac{1}{4}$ of Sec. 2, T.19N., R.15E., Town of Winneconne.

I, Calvin W. Hawksworth, registered land surveyor, hereby certify: That I have surveyed, divided and mapped the parcel of land located in part of the SW $\frac{1}{4}$ of the SE $\frac{1}{4}$ of Sec. 2, T.19N., R.15E. in the Town of Winneconne, Winnebago County, Wisconsin, described as follows: Beginning at a point that is 519.75 ft., N0°00'E of the SW corner of the SW $\frac{1}{4}$ of said Sec. 2. From that point running N90°00'E, 252.70 ft., thence S0°00'W, 200.00 ft., thence S90°00'W, 252.70 ft., thence N0°00'E, 200.00 ft. to the said point of beginning. Being a parcel of land of 1.16 acres, more or less. Reserving therefrom that portion of above described parcel presently used for road purposes.

That I have made such survey, land division and map by the direction of Gary Herlache, 3800 E. Broadway Dr., Appleton, Wisconsin; 54911; that such map is a correct representation of the exterior boundaries of the land surveyed.

That I have fully complied with the provisions of Sec. 236.34 of the Wisconsin Statutes, the Winnebago County Subdivision Ordinance and the Town of Winneconne Zoning Ordinance in surveying, dividing and mapping the same.

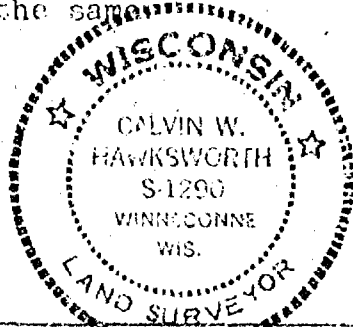

Calvin W. Hawksworth
Calvin W. Hawksworth S-1290
Wisconsin Registered Land Surveyor
September 23, 1980.

Drafted by Irene Haedt
Sheet 1 of 2 sheets

WINNEBAGO COUNTY CERTIFIED SURVEY MAP NO. _____

Part of the SW $\frac{1}{4}$ of the SE $\frac{1}{4}$ of Sec. 2, T.19N., R.15E., Town of Winneconne.OWNER'S CERTIFICATE

As owner(s) I(we) hereby certify that I(we) caused the land described on this Certified Survey Map to be surveyed, divided and mapped as represented hereon.

WITNESS the hand and seal of said owner(s) this ____ day of _____, 19____.

In presence of:

Witness _____

Owner(s) _____

Address _____

City-State _____

Zip _____

STATE OF WISCONSIN) SS
WINNEBAGO COUNTY)

Personally came before me this ____ day of _____, 19____, the above named _____ to me known to be the person(s) who executed the foregoing instrument and acknowledged the same.

Notary Public. _____

Wisc. _____

My commission expires _____.

WINNEBAGO COUNTY PLANNING COMMITTEE CERTIFICATE

This Certified Survey Map of part of the SW $\frac{1}{4}$ of the SE $\frac{1}{4}$ of Sec. 2, T.19N., R.15E., Town of Winneconne, is hereby approved.


Date _____

Authorized representative
Winnebago Co. Planning CommitteeTOWN OF WINNECONNE CERTIFICATE

This Certified Survey Map of part of the SW $\frac{1}{4}$ of the SE $\frac{1}{4}$ of Sec. 2, T.19N., R.15E., Town of Winneconne, is hereby approved.

Date _____

Town Chairman _____

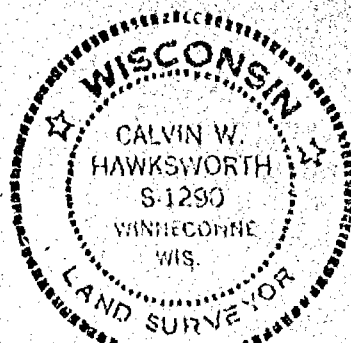


Calvin W. Hawksworth
Calvin W. Hawksworth S-1290
Wisconsin Registered Land Surveyor
September 23, 1980

228

No 480

$N\frac{1}{2}$ NE $\frac{1}{4}$ of SW $\frac{1}{4}$ Sec 2 T19N R15E
Town of Winneconne

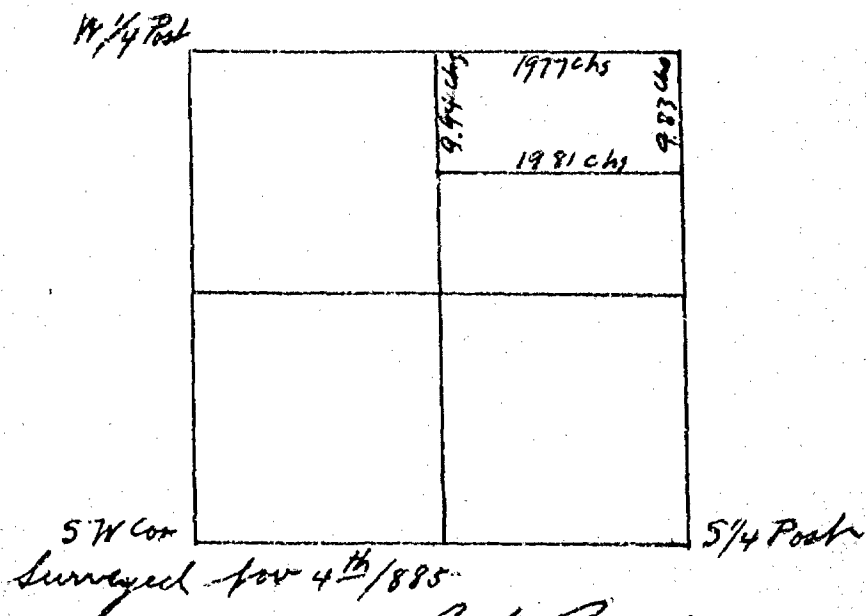

Ed A Randall
County Surveyor

CITY OF OSHKOSH
ENGINEERING DEPARTMENT

DRAWN

SCALE



Martenson & Eisele, Inc.

- Civil Engineering
- Municipal Engineering
- Construction Supervision
- Construction Inspection
- Consulting Engineering
- Land Subdividing
- Land Planning
- Property Surveys
- Topographical Surveys
- Certified Soil Testing

1018 American Court
Neenah, Wisconsin 54950
Telephone 414-731-0381
FAX 414-727-1178

Stanley C. Martenson, P.E.
David D. Eisele, P.L.S.
Charles F. Goodman, P.L.S.
John R. Davel, P.E.
James E. Smith, P.L.S.

Tract 1

Part of the Southwest 1/4 of Section 2, Town 19 North, Range 15 East, Town of Winneconne, Winnebago County, Wisconsin, described as follows:


Commencing at the South 1/4 corner of said Section 2; thence N 01°-42'-00" W, along the East line of said Southwest 1/4, a distance of 1284.00 feet to the point of beginning; thence continuing N 01°-42'-00" W, along said East line, 33.00 feet; thence S 89°-11'-00" W, 1226.07 feet; thence S 01°-42'-00" E, 393.50 feet; thence N 89°-47'-48" E, 491.67 feet; thence N 01°-42'-00" W, 365.77 feet; thence S 09°-11'-00" W, 734.50 feet to the point of beginning, containing 5.001 acres, reserving the most Easterly 33 feet for road purposes and subject to all easements and restrictions of record.

For: Mr. Leslie Romberg

Date: May 8, 1989

Project: 148-283

JUN 12 1989

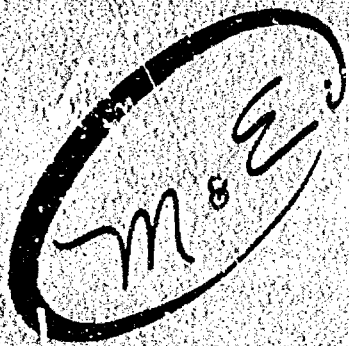

Martenson & Eisele, Inc.

- Civil Engineering
- Municipal Engineering
- Construction Supervision
- Construction Inspection
- Consulting Engineering
- Land Subdividing
- Land Planning
- Property Surveys
- Topographical Surveys
- Certified Soil Testing

1819 American Court
Neenah, Wisconsin 54956
Telephone 414-731-0381
FAX 414-733-8578

Stanley C. Martenson, P.E.
David D. Eisele, P.L.S.

Charles F. Goodman, P.L.S.
John R. Davel, P.E.
James E. Smith, P.L.S.

Tract 2

Part of the Southwest 1/4 of Section 2, Town 19 North, Range 15 East, Town of Winneconne, Winnebago County, Wisconsin described as follows:



Commencing at the South 1/4 corner of said Section 2; thence N 0°-42'00" W, along the East line of said Southwest 1/4, a distance of 1350.00 feet; to the point of beginning; thence S 89°-11'-00" W, 1740.00 feet; thence S 01°-42'-00" E, 421.00 feet; thence N 89°-47'-48" E, 514.04 feet; thence N 01°-42'-00" W, 393.50 feet; thence N 89°-11'-00" E, 1226.07 feet; thence N 01°-42'-00" W, along said East line, 33.00 feet to the point of beginning, containing 5.903 acres, reserving the East 33 feet for road purposes and subject to all easements and restrictions of record.

For: Mr. Leslie Romberg
Date: May 8, 1989

Project: 148-283


PLAT OF SUR

Part of the Southwest 1/4 of Section 4, Town 19 North,
Range 10 West, Winnebago County, Wisconsin.

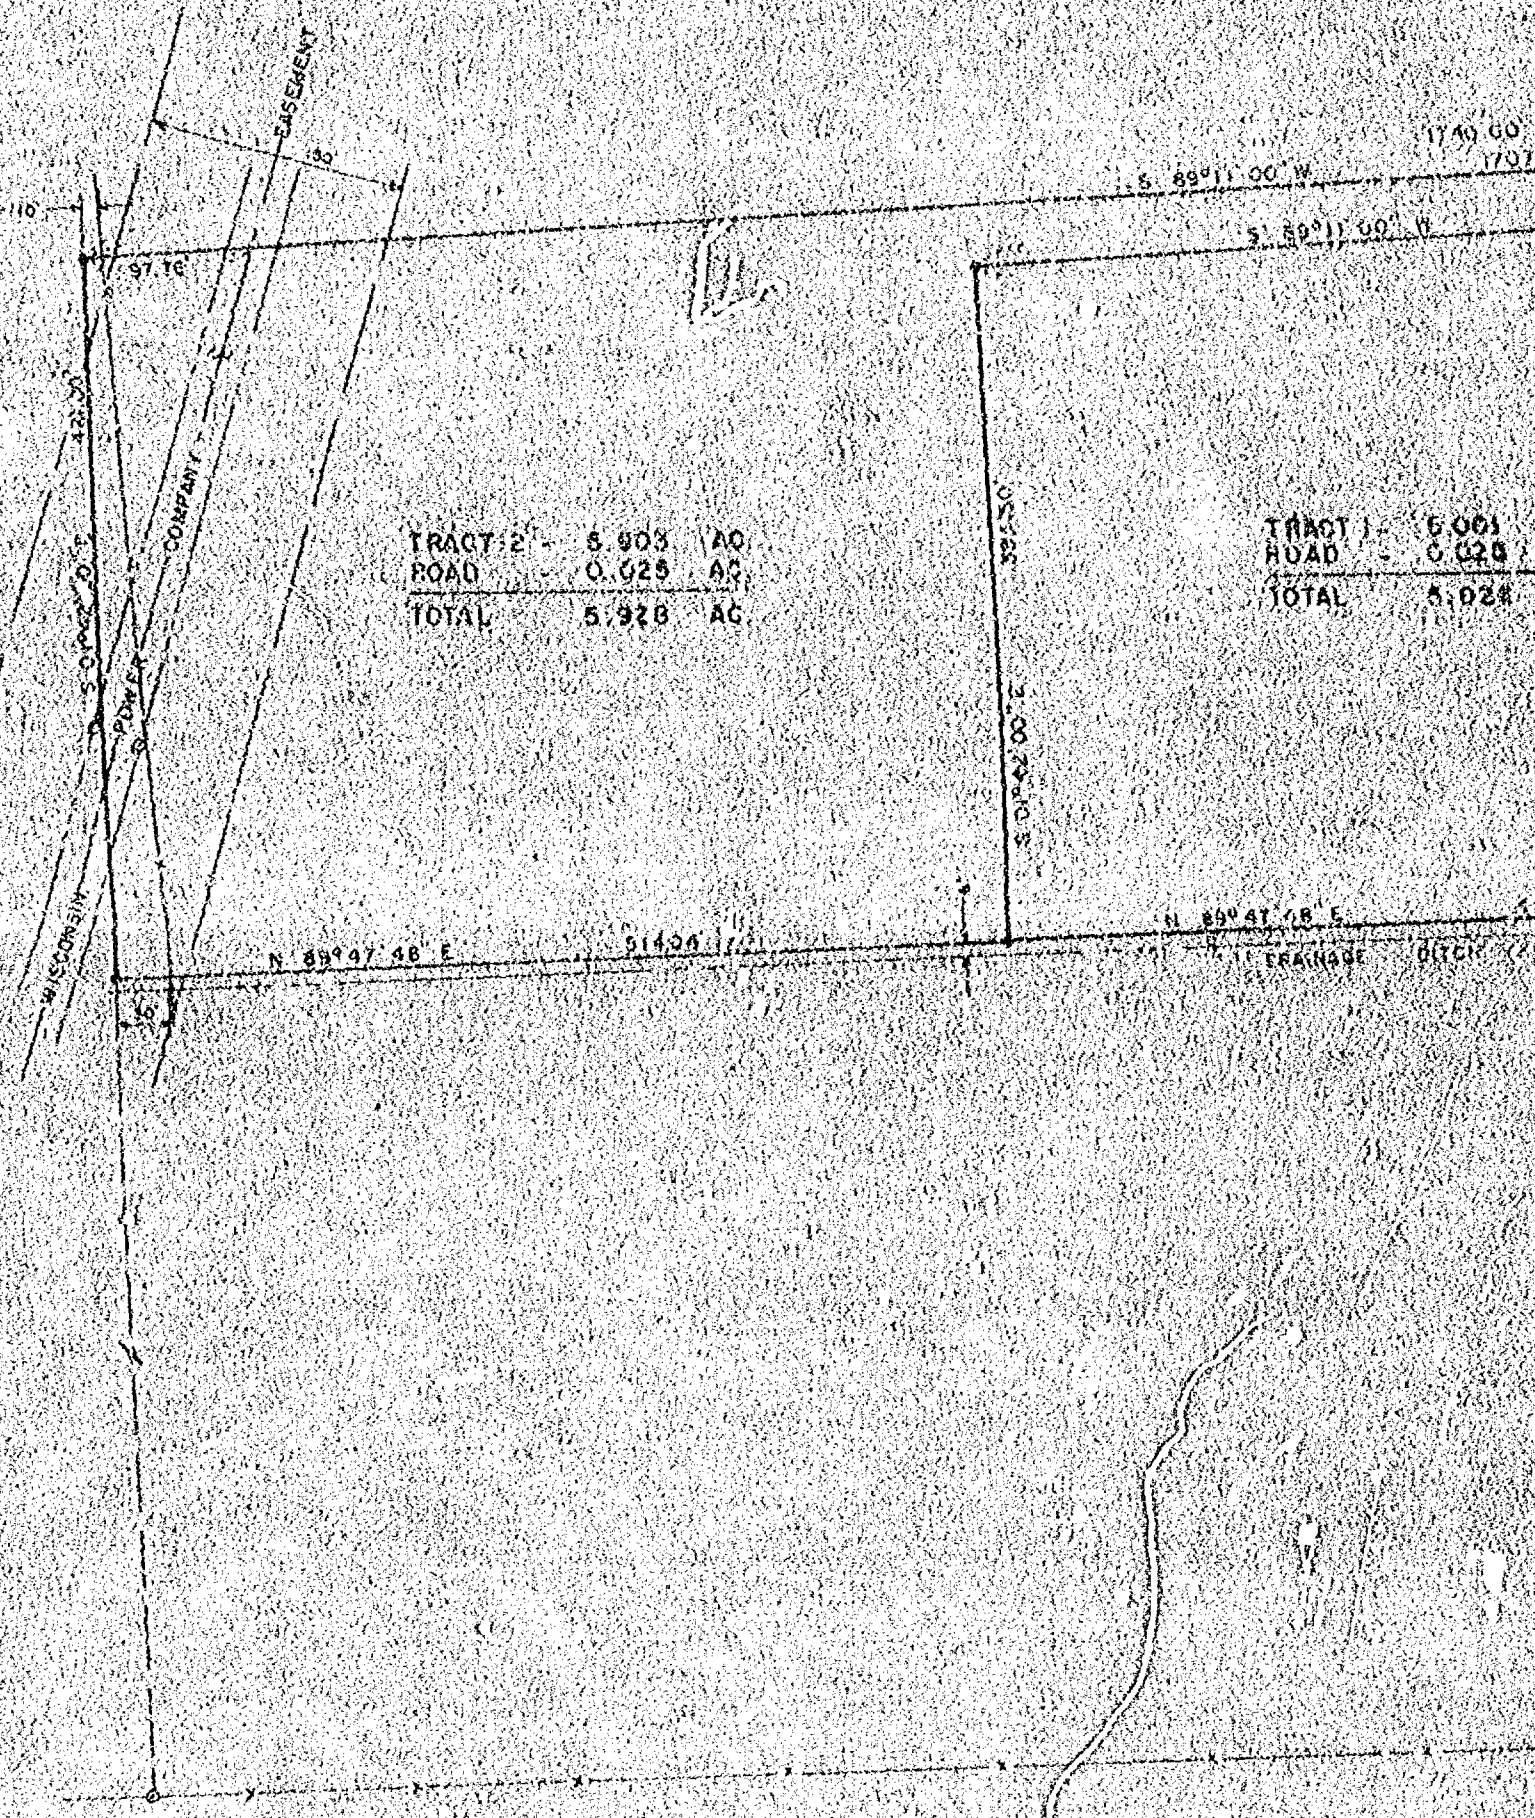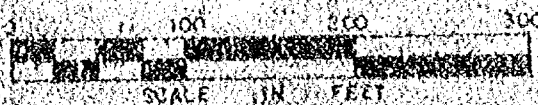


LEGEND

- POWER POLE
- 3/4" REBAR SET
- 1" IRON PIPE FOUND
- FENCE

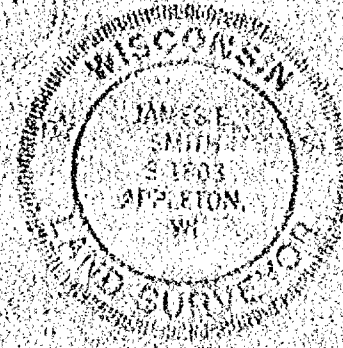

SURVEY

1930

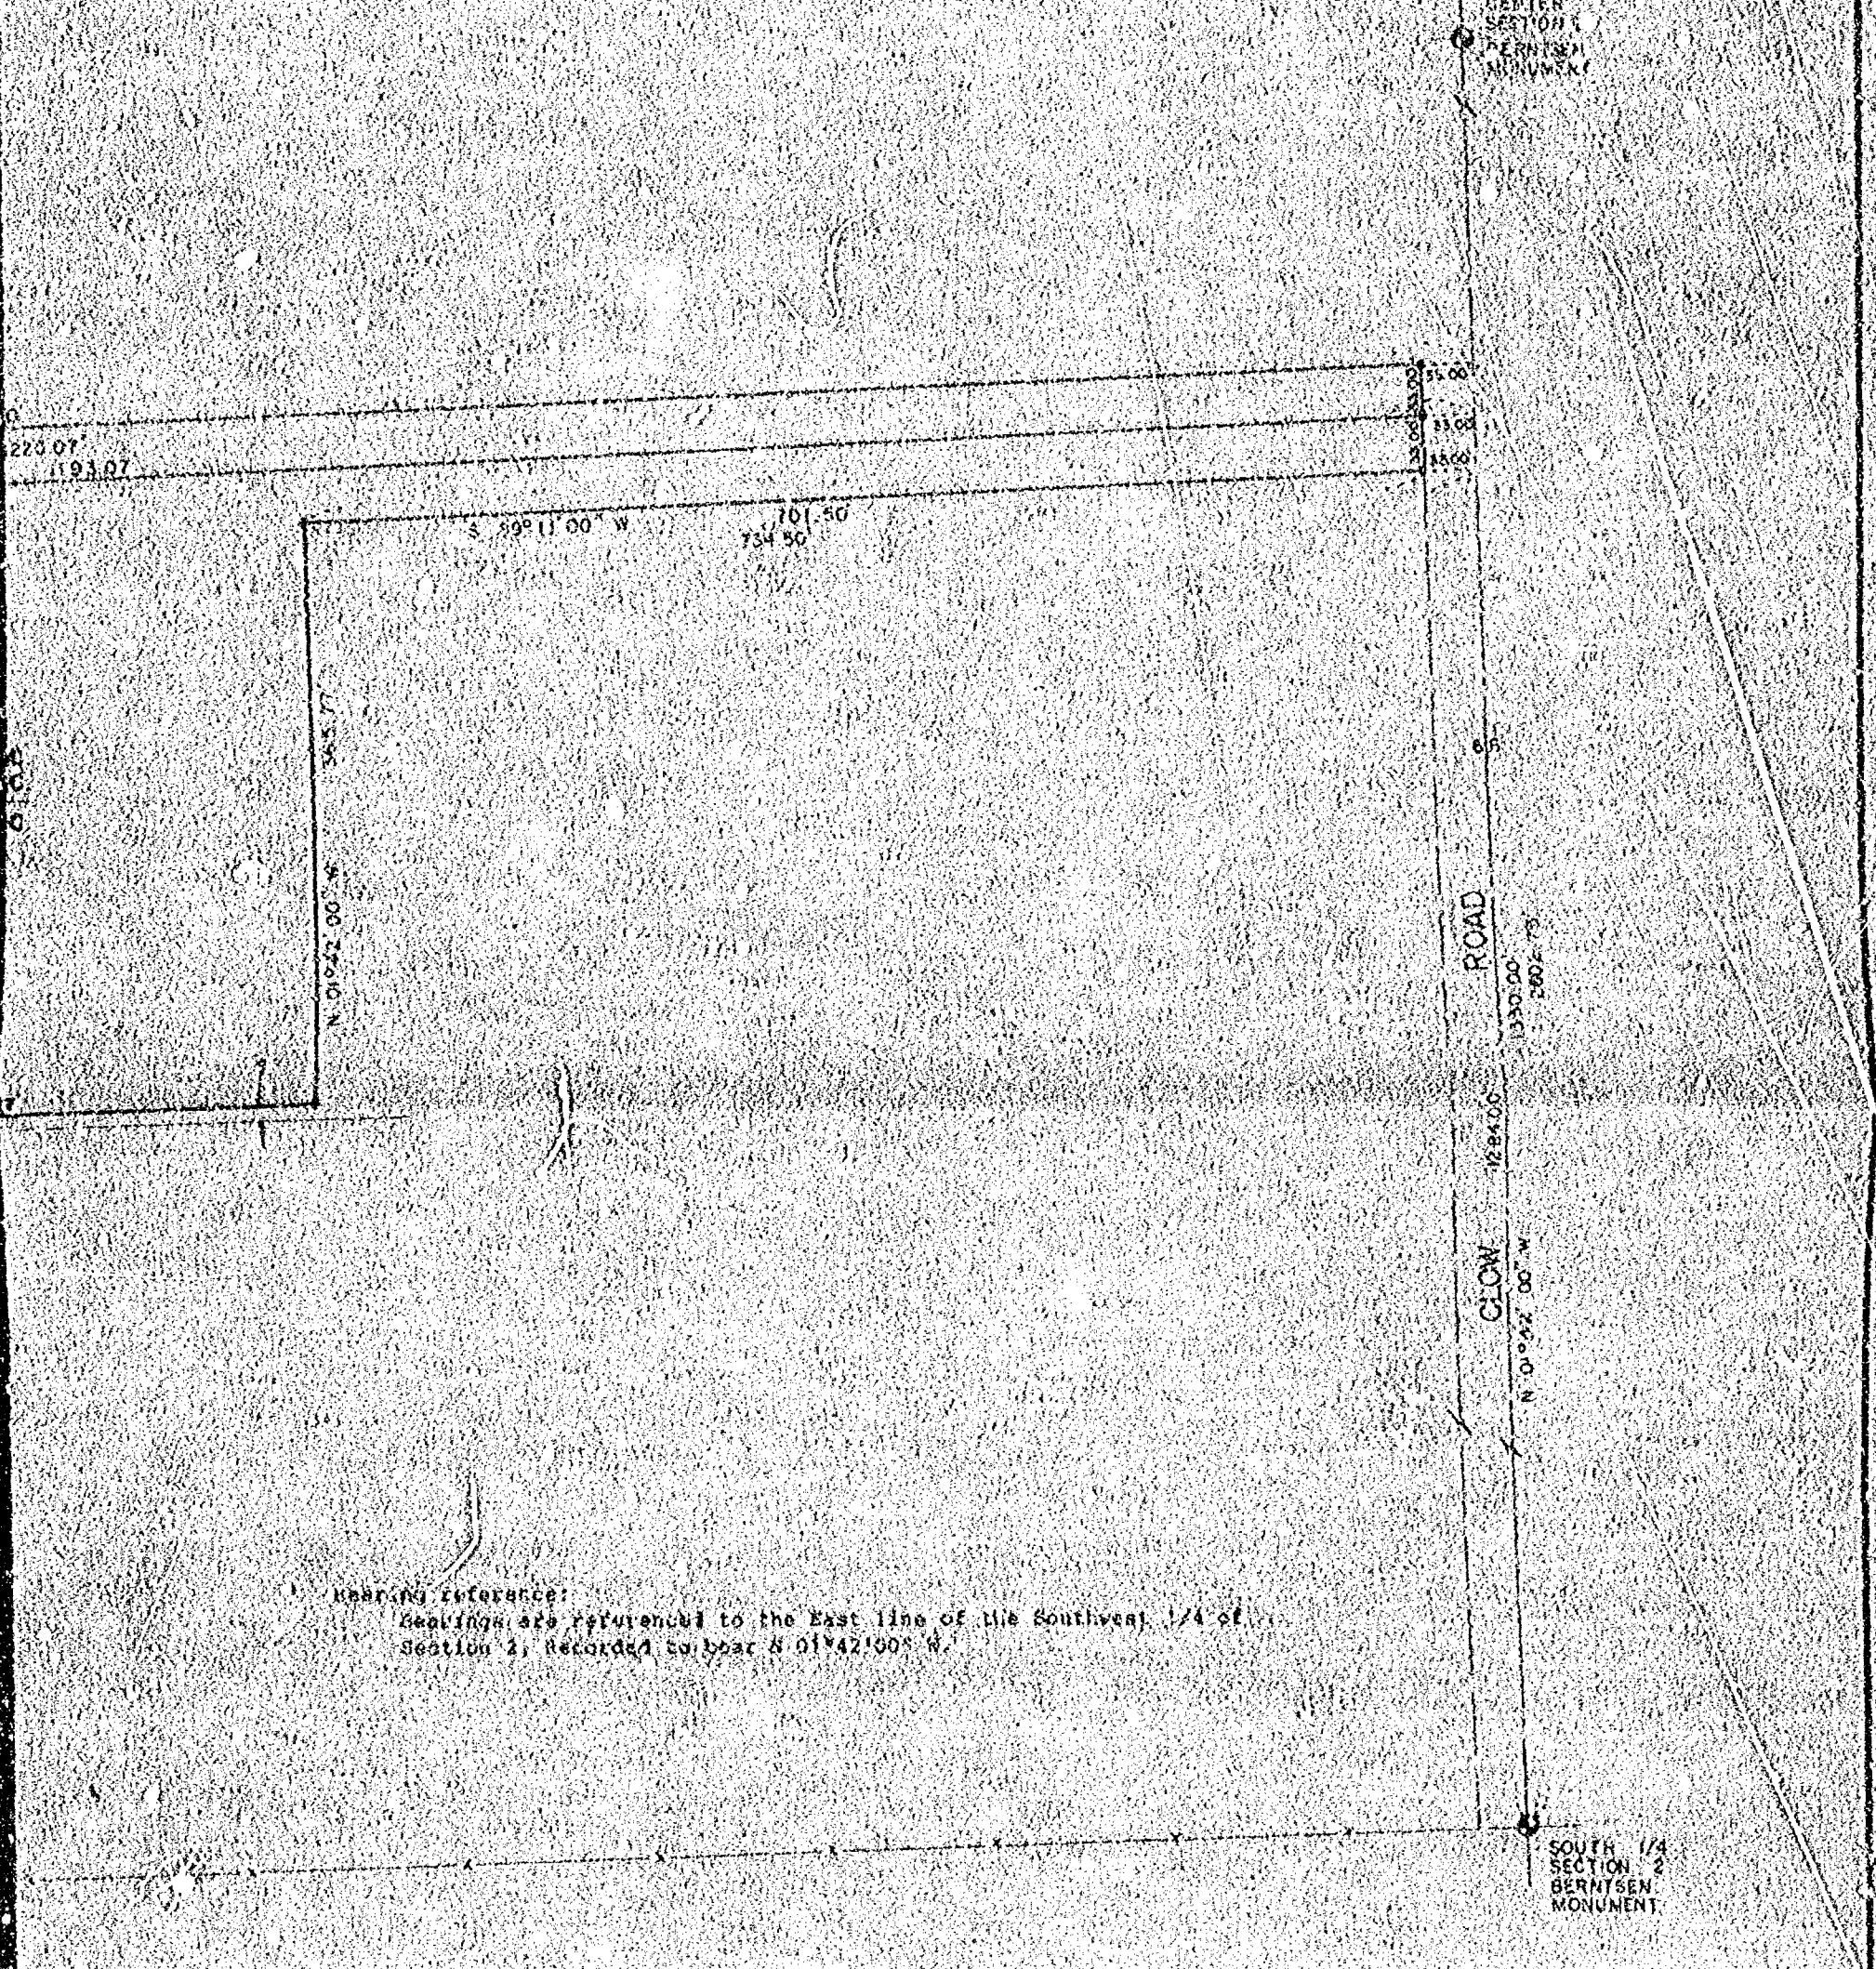

Bearing reference:
 Bearings are referenced to the East line of the Southwest 1/4 of
 Section 2, Recorded to bear S 01°42'00" W.

SURVEYOR'S CERTIFICATE

I, hereby certify that I have surveyed the property as
 shown and described, according to official records and that
 the plat above drawn is an accurate and correct representation
 of said survey, to the best of my knowledge and belief.

James H. Smith, Reg. WI Land Surveyor 4-1803

MARTENSON & EISELE, INC.



CONSULTING ENGINEERING and LAND SURVEYING
 1919 AMERICAN COURT
 NEENAH, WI. 54956

PLAT OF SURVEY FOR MR. LESLIE HOMBERG

SCALE: 1" = 100'	APPROVED BY:	DRAWN BY: JAW
DATE: 4-28-89		
		DRAWING NUMBER:
		148-25

Plat of Survey

THE N. 1/2 OF THE NE 1/4 OF THE SW 1/4 OF SEC. 2, T. 19N,
R. 15E., TOWN OF WINNECONNE, WINNEBAGO COUNTY, WI.

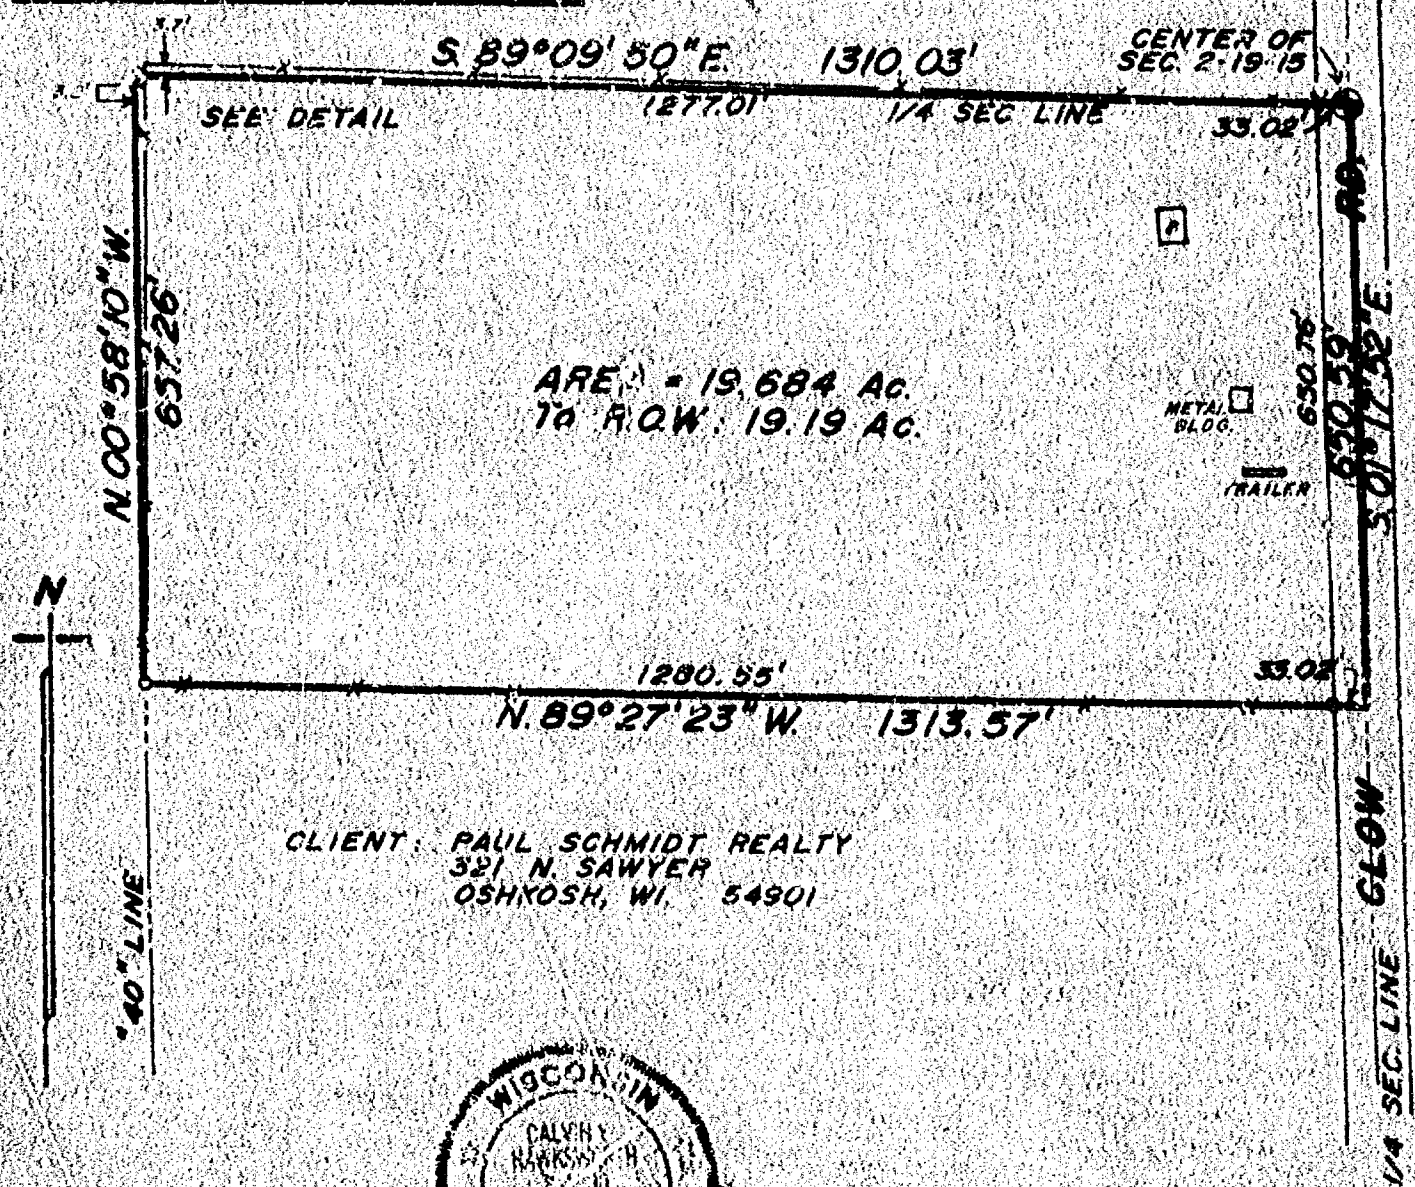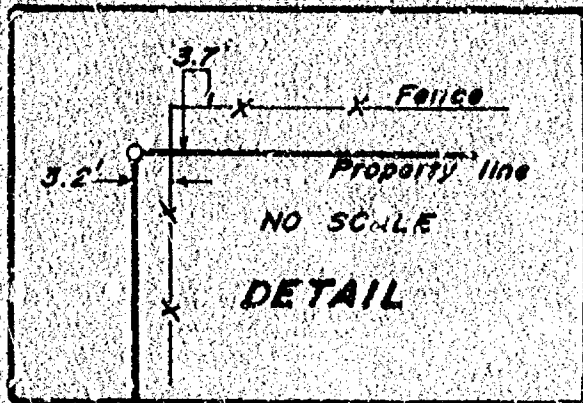

LEGEND

- = Existing monuments
- = 2" x 30" iron pipe set
- = 1" x 30" iron pipe set
- ⊙ = reference caps or R.R. spikes
- ⊕ = Bernier or Harrison monuments
- X-X = fence
- () = recorded as
- = stone monument

X = CROSS CUT IN SHELF ROCK

SURVEYORS CERTIFICATE

I, hereby certify that I have surveyed the property as shown, according to official records and that the plat above drawn is an accurate and correct representation of said survey.

MARCH 13, 1989

Calvin M. Hawksworth


Wisconsin Registered Land Surveyor S-1290

Sayler
Survey, Inc.

179A WEST MAIN, BOX 282, WINNECONNE, WI 54986

SCALE 1 IN. = 200 FT.
PROJECT NO. S-002052
FIELD BOOK 55 PAGE 69

PART OF THE NW 1/4 OF OF WINNECONNE, WINNEBAGO COUNTY, WISCONSIN

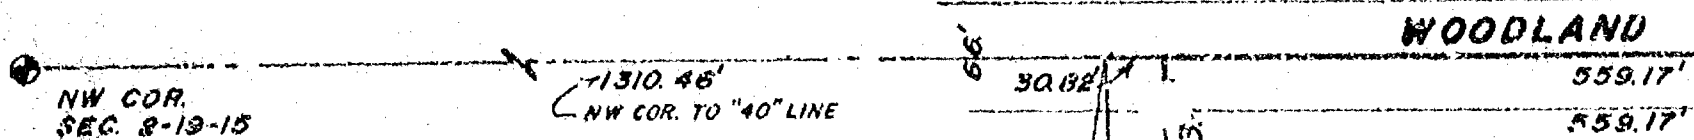

LEGAL DESCRIPTIONS:

PARCEL 1

All that part of the NE 1/4 of the NW 1/4 of Sec. 2, T.19N., R.15E. in the Town of Winneconne, Winnebago County, Wisconsin, described as follows: Beginning at a point on the North line of the NW 1/4 of said Sec. 2 that is 1310.46 ft., N. 89° 20' 21" E. of the Northwest corner of said Sec. 2. From that point running S. 00° 46' 49" E., 1174.17 ft. to the South line of the NE 1/4 of the NW 1/4 of said Sec. 2, thence S. 89° 30' 11" E., 559.31 ft., thence N. 00° 46' 49" W., 1185.47 ft. to the North line of the NW 1/4 of said Sec. 2, thence S. 89° 20' 21" W., 559.17 ft. to the said point of beginning. Being a parcel of land of 15.145 acres. Reserving therefrom the northerly 33.00 ft. presently used for road purposes. Subject to all easements and restrictions of record.

PARCEL A (AREA BETWEEN FENCE AND "40" LINE)

All that part of the NW 1/4 of the NW 1/4 of Sec. 2, T.19N., R.15E. in the Town of Winneconne, Winnebago County, Wisconsin, described as follows: Beginning at a point on the North line of the NW 1/4 of said Sec. 2 that is 1310.46 ft., N. 89° 20' 21" E. of the Northwest corner of said Sec. 2. From that point running S. 00° 46' 49" E., 1174.17 ft., thence N. 89° 30' 11" W., 18.36 ft. to an existing fence line, thence N. 01° 23' 18" W. along said fence line, 1173.89 ft. to the North line of the NW 1/4 of said Sec. 2, thence N. 89° 20' 21" E., 30.82 ft. to the said point of beginning. Being a parcel of land of 0.661 acres. Reserving therefrom the northerly 33.00 ft. presently used for road purposes. Subject to all easements and restrictions of record.


PARCEL B (FENCE LINE TO "40" LINE)

All that part of the SE 1/4 of the NW 1/4 of Sec. 2, T.19N., R.15E. in the Town of Winneconne, Winnebago County, Wisconsin, described as follows: Beginning at a point that is 1310.46 ft., N. 89° 20' 21" E. and 1174.17 ft., S. 00° 46' 49" E. of the Northwest corner of said Sec. 2. From that point running S. 89° 30' 11" E., 559.31 ft., thence S. 00° 46' 49" E., 19.48 ft. to an existing fence line, thence N. 89° 57' 17" W., along said fence line, 559.24 ft., thence N. 00° 46' 49" W., 23.89 ft. to the said point of beginning. Being a parcel of land of 0.278 acres. Subject to all easements and restrictions of record.

PARCEL 1

15.145 Acres



14.721 Ac. To R.O.W.

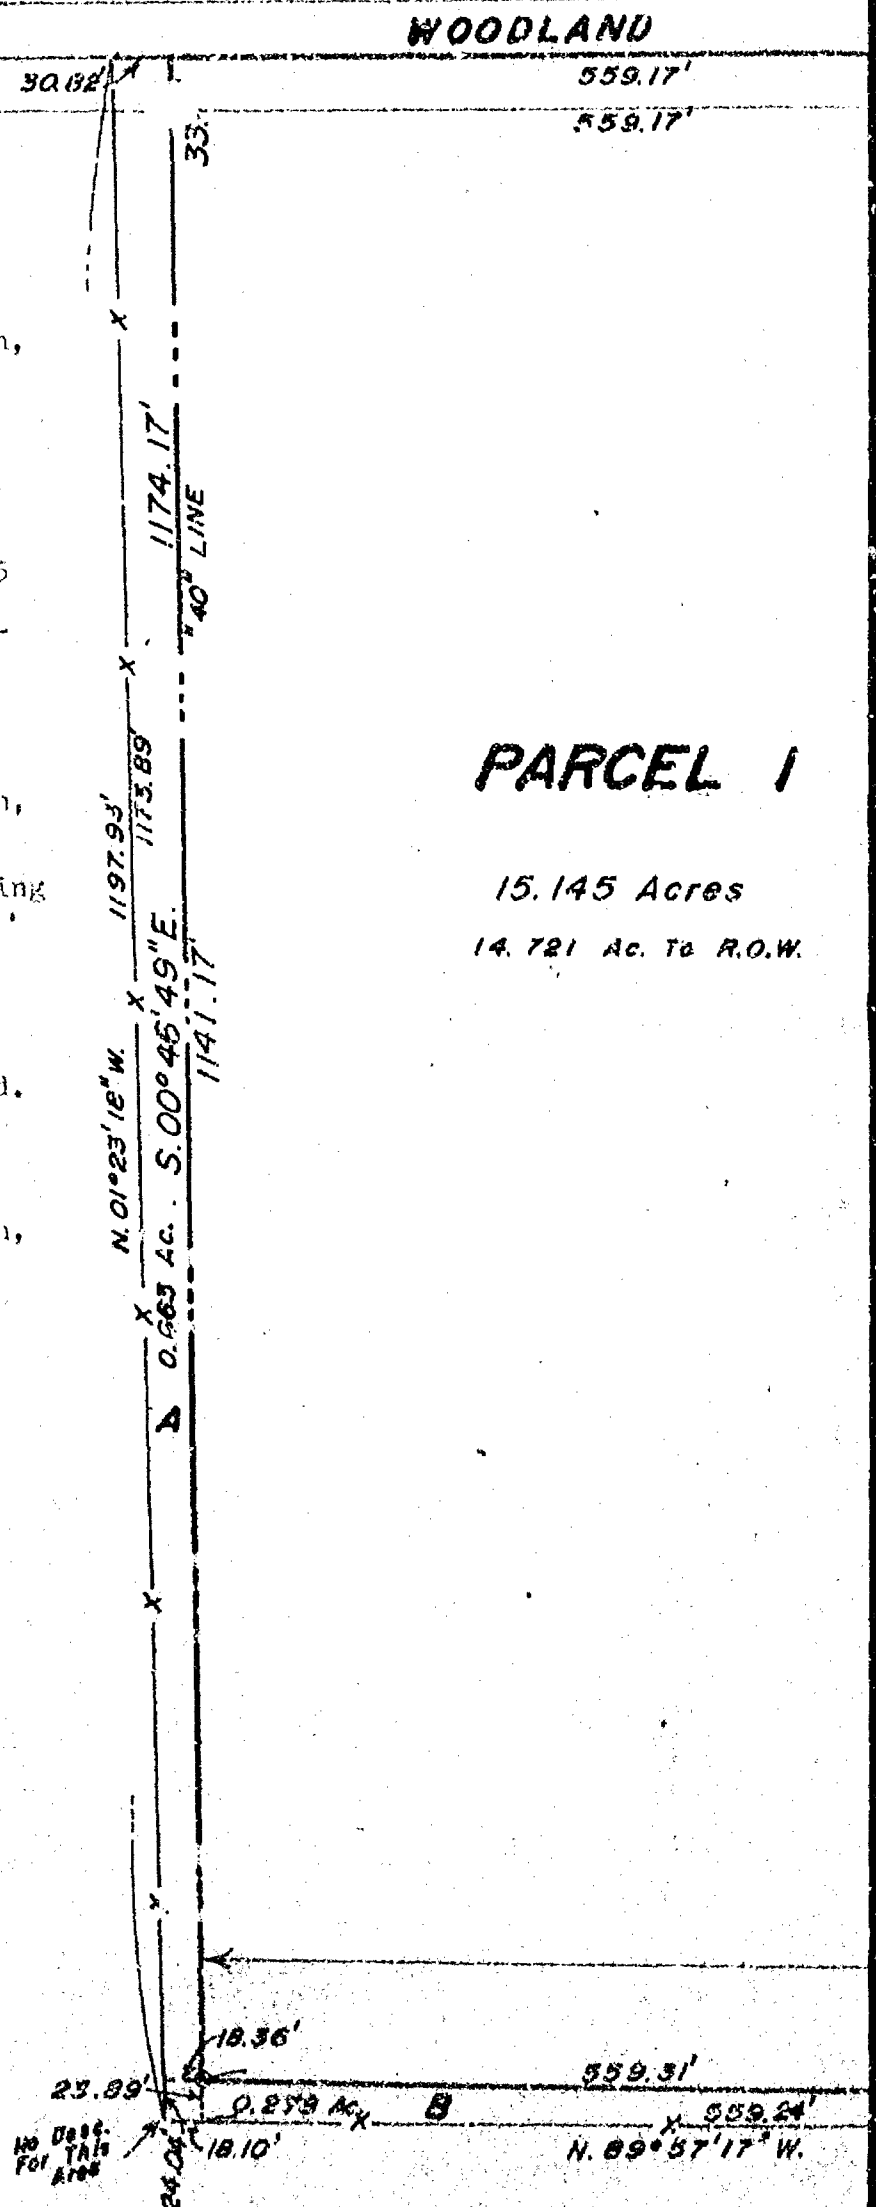


SAYLER SURVEY, INC. LAND SURVEY

SEC 2, T.19N, R.15E, TOWN
JAGO COUNTY, WISCONSIN

CLIENT: PATTI HERLACHE
4697 OTT RD.
BLACK CREEK, WI. 54106

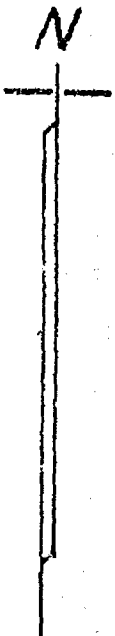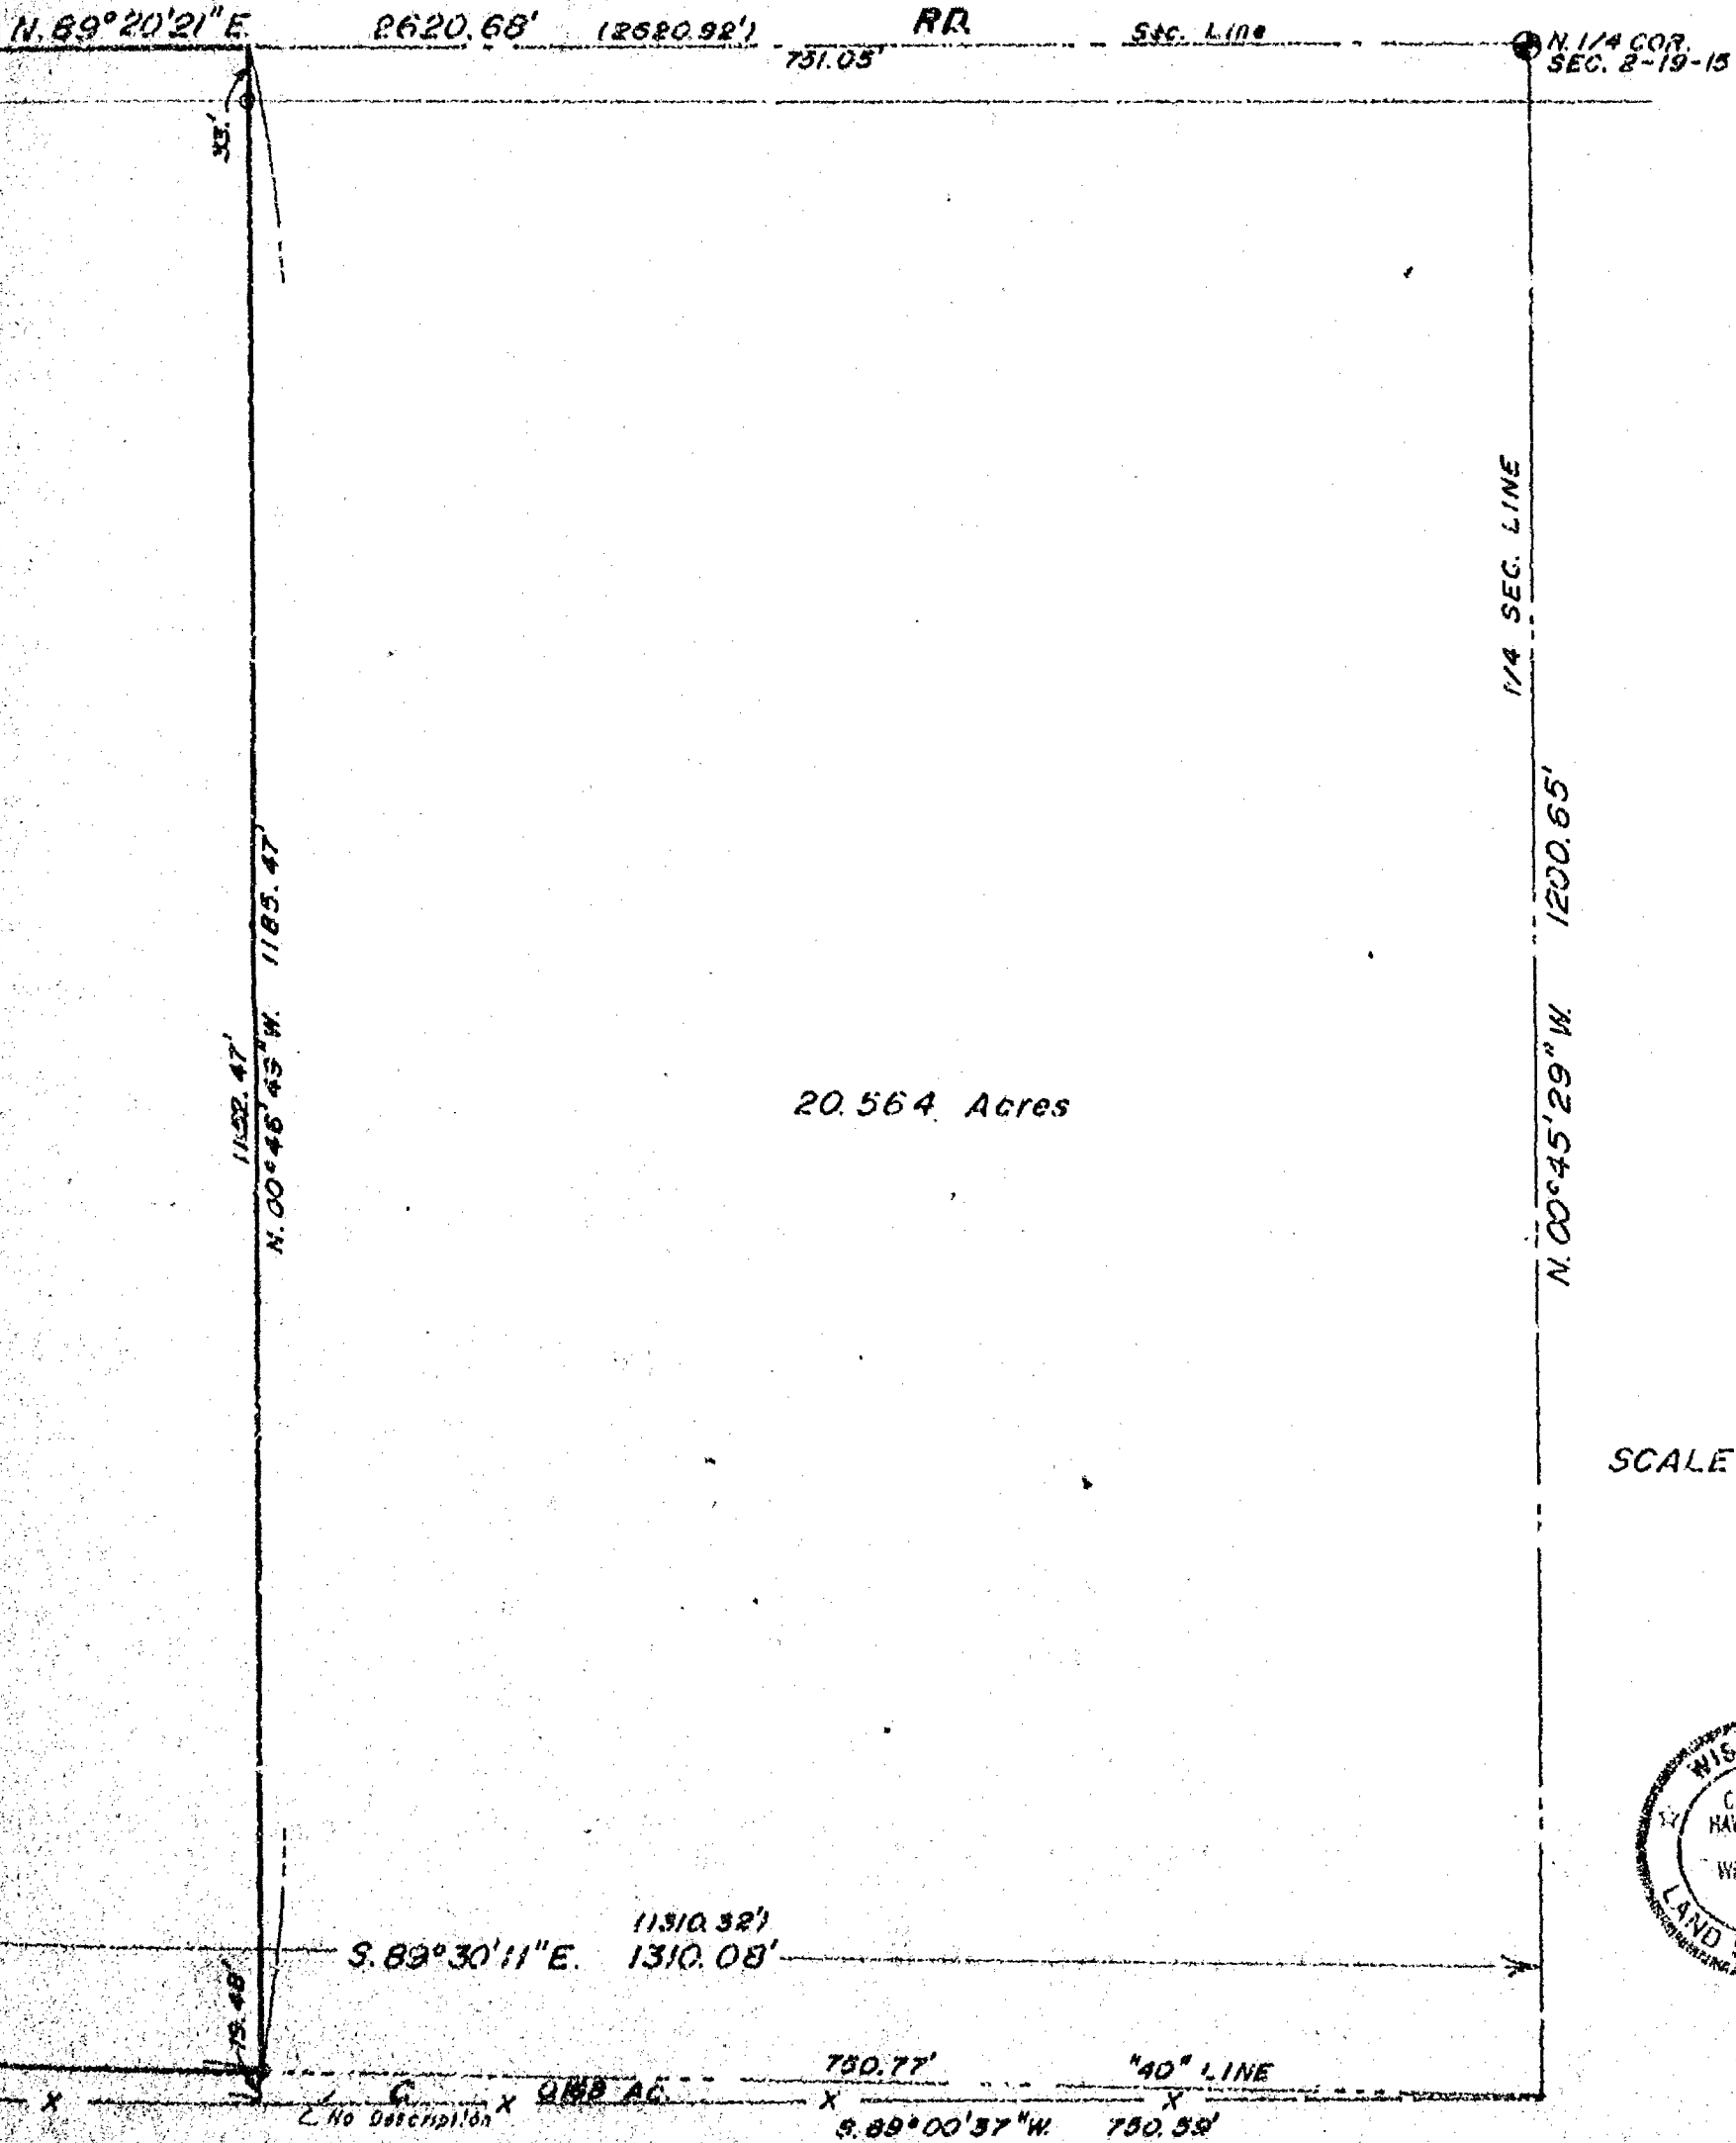

SCALE: 1 IN. = 100 FT.

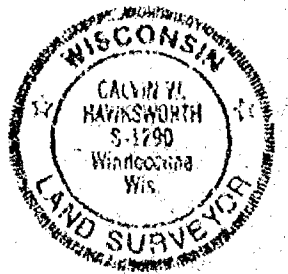

ORS WINNECONNE, WI.

● BERNTSEN MONUMENTS
○ 1" X 30" IRON PIPE SET
X--X--X EXISTING FENCE LINES

Calvin W. Hawksworth
Calvin W. Hawksworth S-1290
W.R.L.S.
August 6, 1991
S-002383 FB 62 P. 58

Stock No. 26273

WINNEBAGO COUNTY CERTIFIED SURVEY MAP NO. 2426




Part of the W1/2 of the SE1/4 of Sec. 2, T.19N., R.15E., Town of Winneconne, Winnebago Co., WI.

Bearings are reference to the West line of the SE1/4 of Sec. 2, assumed bearing, N.01°17'52"W.

LEGEND:

- Berntsen monument
- Existing irons found
- 1"x30" iron pipe weighing 1.13 lbs./lineal ft.
- ☐ Pit

Robert H. Saylor
Robert H. Saylor 1834
Wisconsin Registered Land Surveyor
August 28, 1991

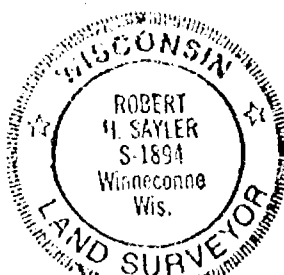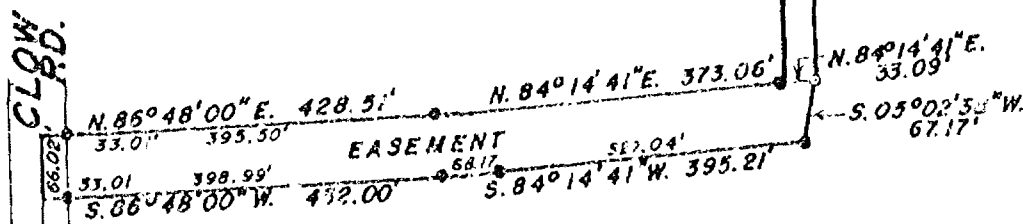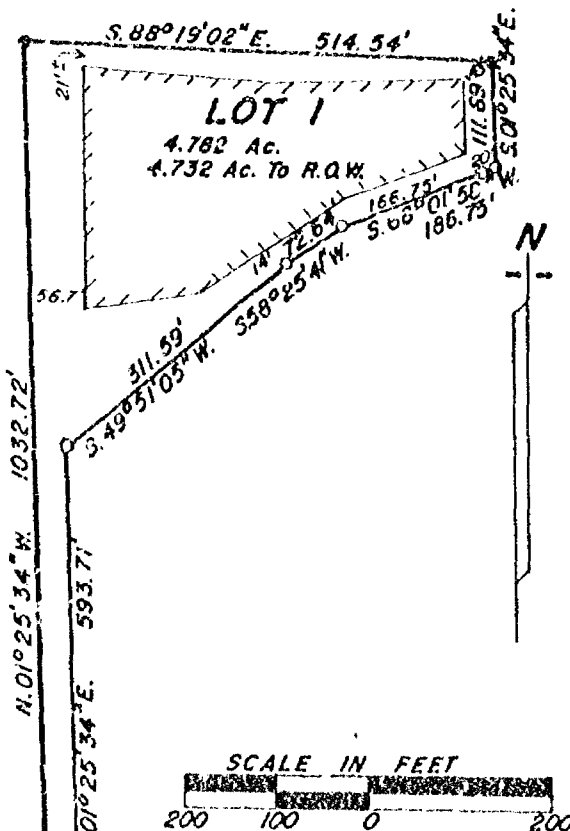

OWNER'S CERTIFICATE:

As owners, we hereby certify that we caused the land described on this certified survey map to be surveyed, divided and mapped as represented hereon.

Arden E. Christensen
Chairman, Town of Winneconne
Arden E. Christensen
6168 Christensen Rd. Oshkosh, WI. 54904

I hereby certify that the foregoing is a copy of a resolution adopted by the Town Board of the the Town of Winneconne.

Marilee E. Magerman
Town Clerk

STATE OF WISCONSIN)
WINNEBAGO COUNTY) SS

Personally came before me this 19th day of September, 1991, the above named persons to me known to be the persons who executed the foregoing instrument and acknowledged the same.

Doug J. Korte
Notary Public WI.

My commission expires Nov. 1, 1992

Sheet 1 of 2 sheets

Stock No. 26273

WINNEBAGO COUNTY CERTIFIED SURVEY MAP NO. 2426

Part of the W1/2 of the SE1/4 of Sec. 2, T.19N., R.15E., Town of Winneconne, Winnebago Co., WI.

SURVEYOR'S CERTIFICATE:

I, Robert H. Saylor, registered land surveyor, hereby certify:

That I have surveyed, divided and mapped the parcel of land located in part of the W1/2 of the SE1/4 of Sec. 2, T.19N., R.15E., in the Town of Winneconne, Winnebago County, Wisconsin, described as follows: Beginning at a point on the West line of the SE1/4 of said Sec. 2 that is 904.02 ft., N.01°17'52"W. of the South 1/4 corner of said Sec. 2. From that point running N.86°48'00"E., 428.51 ft., thence N.84°14'41"E., 373.06 ft., thence N.01°25'34"W., 1032.72 ft., thence S.88°19'02"E., 514.54 ft., thence S.01°25'34"E., 111.69 ft., thence S.68°01'53"W., 186.75 ft., thence S.58°25'41"W., 72.64 ft., thence S.49°51'05"W., 311.59 ft., thence S.01°25'34"E., 593.71 ft., thence S.05°02'38"W., 67.17 ft., thence S.84°14'41"W., 395.21 ft., thence S.86°48'00"W., 432.00 ft., thence N.01°17'52"W., 66.02 ft. to the said point of beginning. Including and subject to an easement for ingress and egress to the Town of Winneconne over and across the following parcel: Beginning at a point on the West line of the SE1/4 of said Sec. 2 that is 904.02 ft., N.01°17'52"W. of the South 1/4 corner of said Sec. 2. From that point running N.86°48'00"E., 428.51 ft., thence N.84°14'41"E., 406.15 ft., thence S.05°02'38"W., 67.17 ft., thence S.84°14'41"W., 395.21 ft., thence S.86°48'00"W., 432.00 ft., thence N.01°17'52"W., 66.02 ft. to the said point of beginning. Being a parcel of land of 4.782 acres, more or less. Subject to all easements and restrictions of record.

That I have made such survey, land division and map by the direction of Robert Padtke, 6408 St. Rd. "110", Winneconne, WI; 54996; that such map is a true and correct representation of the exterior boundaries of the land surveyed.

That I have fully complied with the provisions of Sec. 236.34 of the Wisconsin Statutes and the Winnebago County Subdivision Ordinance in surveying, dividing and mapping the same.

Robert H. Saylor
Robert H. Saylor S-1894
Wisconsin Registered Land Surveyor
August 28, 1991

TOWN TREASURER'S CERTIFICATE:

STATE OF WISCONSIN)

WINNEBAGO COUNTY) SS

I, Beverly Rosenow, being the duly elected, qualified and acting treasurer of the Town of Winneconne, do hereby certify that in accordance with the records in my office, there are no unpaid taxes or unpaid special assessments as of 8-28-91, 1991 on any of the land included in this certified survey map.

8-28-91
Date

Beverly Rosenow
Town Treasurer

COUNTY TREASURER'S CERTIFICATE:

STATE OF WISCONSIN)

WINNEBAGO COUNTY) SS

I, Manella McQuigge-Burton, being the duly elected, qualified and acting ^{Deputy} treasurer of the County of Winnebago, do hereby certify that the records in my office show no unredeemed tax sales and no unpaid taxes or special assessments as of 9/26/91, 1991 affecting the lands included in this Certified Survey Map.

9/26/91
Date

Manella McQuigge-Burton
County Treasurer (Deputy)

WINNEBAGO COUNTY PLANNING COMMITTEE CERTIFICATE:

This Certified Survey Map of part of the W1/2 of the SE1/4 of Sec. 2, T.19N., R.15E., Town of Winneconne, is hereby approved.

October 4, 1991
Date

Jessette Diakoff
Authorized signature

777487

Register's Office

Winnebago County, Wis.

Received for record this 7th

day of Oct. A.D., 19 91

at 1:22 o'clock P. M. and

filed in Vol. 1 of CSM

on page 2426

Marjorie Nelson

Register of Deeds

Chg
14⁰⁰

Chg: Schmitt Abstract

Sub. No. 26273

WINNEBAGO COUNTY CERTIFIED SURVEY MAP NO.

Part of the W1/2 of the S81/4 of Sec. 2, T.19N., R.15E., Town of Winneconne, Winnebago Co., WI.

Boundaries are referenced to the West line of the S81/4 of Sec. 2, assumed bearing, N.01°17'52"W.



REMARKS:

- (1) Deintsen monument
- (2) Existing iron found
- (3) 1" x 30" iron pipe weighing 1.13
- (4) lbs./lin. ft.

END

Robert H. Saylor

Robert H. Saylor
Land Surveyor
Winneconne, Wis.

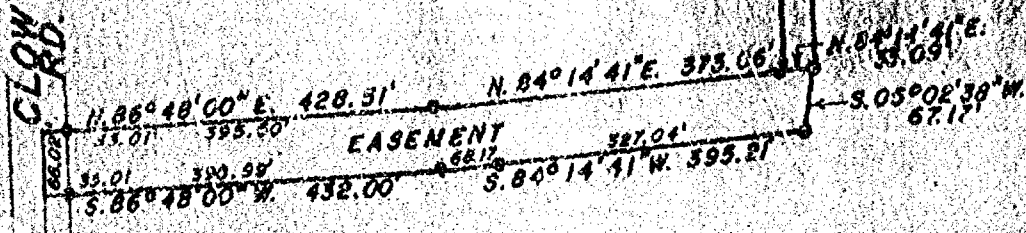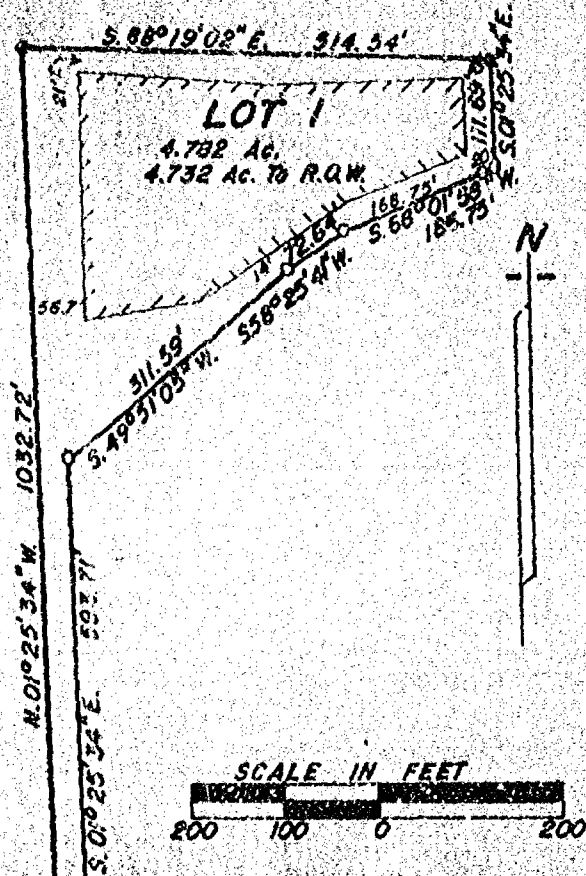

OWNER'S CERTIFICATE:

As owners, we hereby certify that we caused the land described on this certified survey map to be surveyed, divided and mapped as represented hereon.

Chairman, Town of Winneconne
Arden E. Christensen
616 Christensen Rd. Oshkosh, WI. 54904

I hereby certify that the foregoing is a copy of a resolution adopted by the Town Board of the the Town of Winneconne.

STATE OF WISCONSIN)
WINNEBAGO COUNTY) SS

Town Clerk

Personally came before me this _____ day of _____, 1991, the above named persons to me known to be the persons who executed the foregoing instrument and acknowledged the same.

My commission expires _____

Notary Public, WI.

Sheet 1 of 2 sheets

ZHC:maw

Stock No. 26273

WINNEBAGO COUNTY CERTIFIED SURVEY MAP NO.

Part of the W1/2 of the SE1/4 of Sec. 2, T.19N., R.15E., Town of Winneconne, Winnebago Co., WI.

SURVEYOR'S CERTIFICATE:

I, Robert H. Saylor, registered land surveyor, hereby certify:


That I have surveyed, divided and mapped the parcel of land located in part of the W1/2 of the SE1/4 of Sec. 2, T.19N., R.15E., in the Town of Winneconne, Winnebago County, Wisconsin, described as follows: Beginning at a point on the West line of the SE1/4 of said Sec. 2 that is 904.02 ft., N.01°17'52"W. of the South 1/4 corner of said Sec. 2. From that point running N.86°48'00"E., 428.51 ft., thence N.84°14'41"E., 373.06 ft., thence N.01°25'34"W., 1032.72 ft., thence S.88°19'02"E., 514.54 ft., thence S.01°25'34"E., 111.07 ft., thence S.68°01'58"W., 185.75 ft., thence S.58°25'41"W., 72.64 ft., thence S.49°51'05"W., 311.59 ft., thence S.01°25'34"E., 593.71 ft., thence S.05°02'38"W., 67.17 ft., thence S.84°14'41"W., 395.21 ft., thence S.36°48'00"W., 432.00 ft., thence N.01°17'52"W., 66.02 ft. to the said point of beginning. Including and subject to an easement for ingress and egress to the Town of Winneconne over and across the following parcel: Beginning at a point on the West line of the SE1/4 of said Sec. 2 that is 904.02 ft., N.01°17'52"W. of the South 1/4 corner of said Sec. 2. From that point running N.86°48'00"E., 428.51 ft., thence N.84°14'41"E., 406.15 ft., thence S.05°02'38"W., 67.17 ft., thence S.84°14'41"W., 395.21 ft., thence S.36°48'00"W., 432.00 ft., thence N.01°17'52"W., 66.02 ft. to the said point of beginning. Being a parcel of land of 4.782 acres, more or less. Subject to all easements and restrictions of record.

That I have made such survey, land division and map by the direction of Robert Radtke, 6108 St. Rd. "110", Winneconne, WI; 54986; that such map is a true and correct representation of the exterior boundaries of the land surveyed.

That I have fully complied with the provisions of Sec. 236.34 of the Wisconsin Statutes and the Winnebago County Subdivision Ordinance in surveying, dividing and mapping the same.

Robert H. Saylor

Robert H. Saylor S-1894
Wisconsin Registered Land Surveyor
August 28, 1991

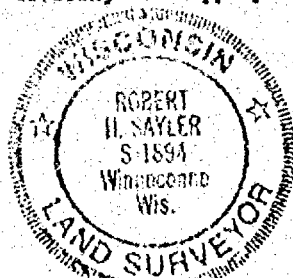TOWN TREASURER'S CERTIFICATE:

STATE OF WISCONSIN)

WINNEBAGO COUNTY) SS

I, Beverly Rosenow, being the duly elected, qualified and acting treasurer of the Town of Winneconne, do hereby certify that in accordance with the records in my office, there are no unpaid taxes or unpaid special assessments as of 8-28, 1991 on any of the land included in this certified survey map.

8-28-91

Date

Beverly Rosenow

Town Treasurer

COUNTY TREASURER'S CERTIFICATE:

STATE OF WISCONSIN)

WINNEBAGO COUNTY) SS

I, _____, being the duly elected, qualified and acting treasurer of the County of Winnebago, do hereby certify that the records in my office show no unredeemed sales and no unpaid taxes or special assessments as of _____, 1991 affecting the land included in this Certified Survey Map.

Date

County Treasurer

WINNEBAGO COUNTY PLANNING COMMITTEE CERTIFICATE:


This Certified Survey Map of part of the W1/2 of the SE1/4 of Sec. 2, T.19N., R.15E., Town of Winneconne, is hereby approved.

Date

Authorized signature

Plat of Survey

PART OF THE NE 1/4 OF THE SE 1/4 OF SEC. 2, T.19N.,
R.15E., TOWN OF WINNECONNE, WINNEBAGO CO., WI.

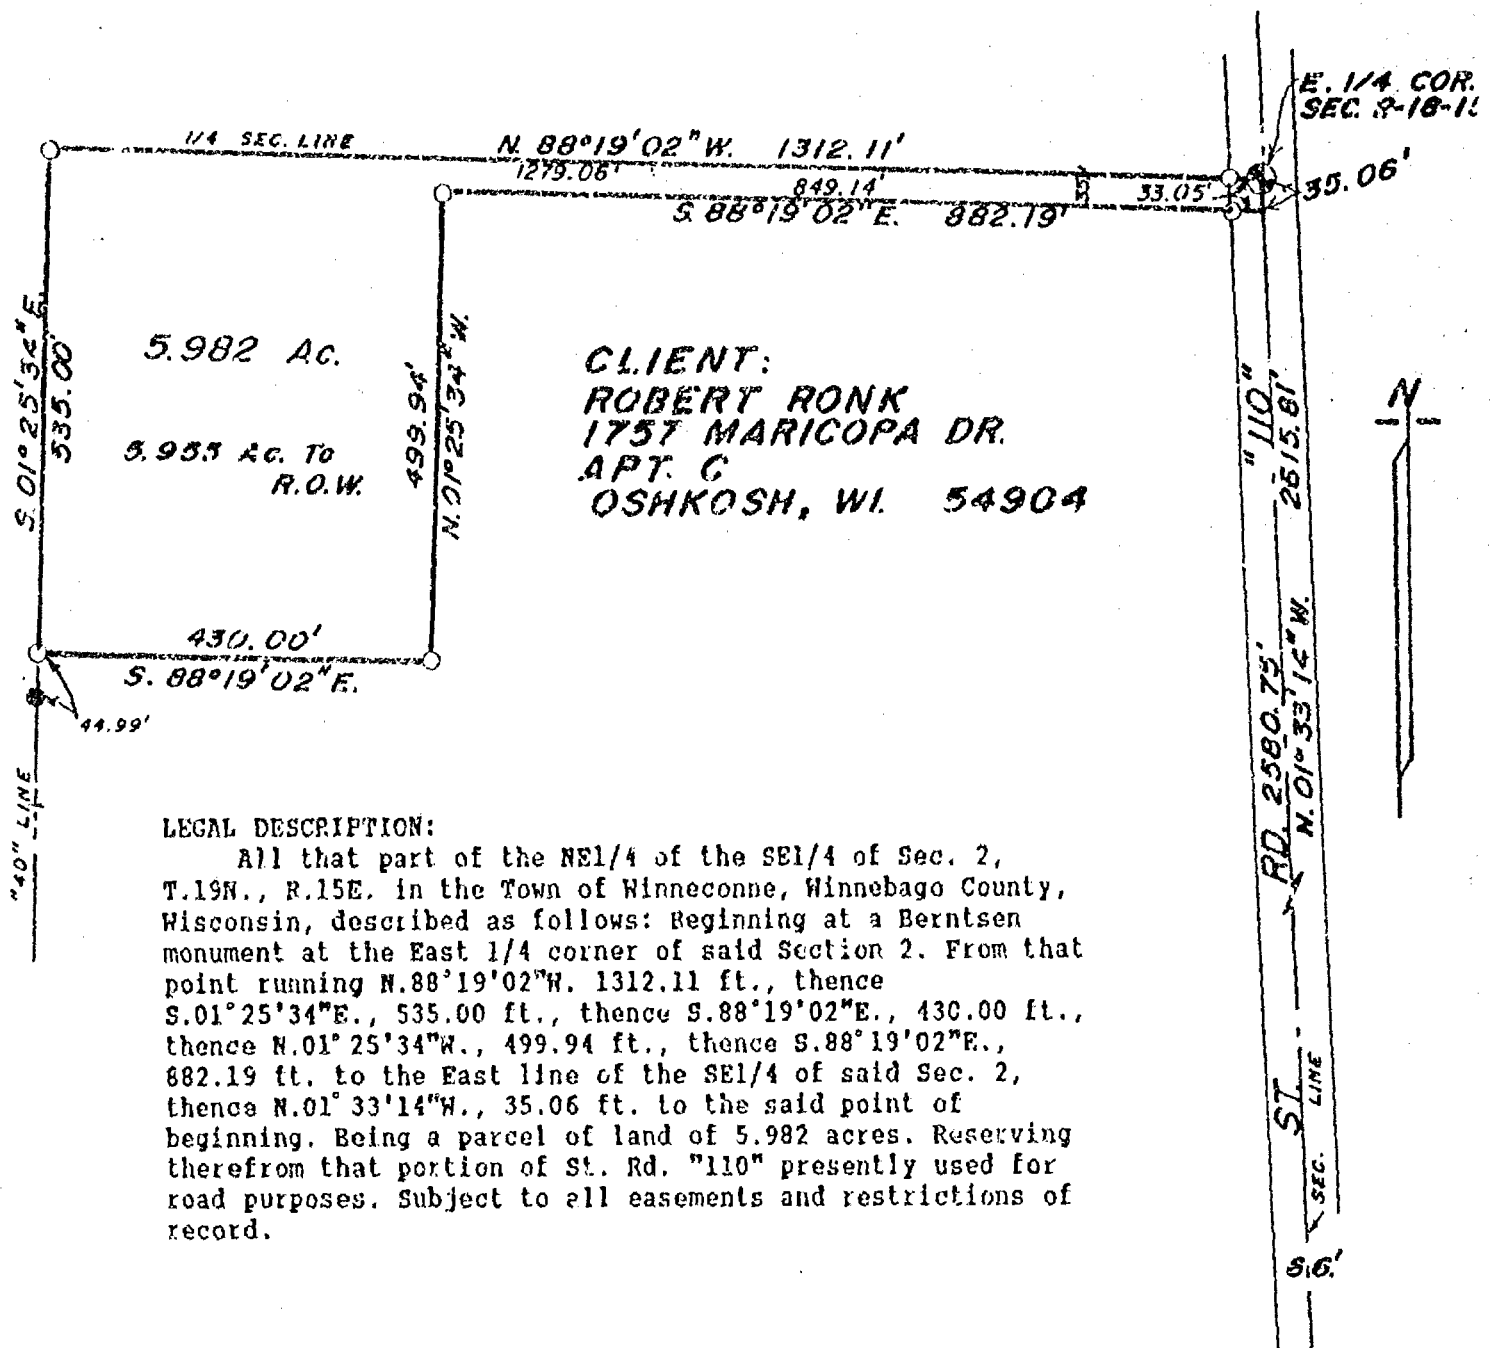

CLIENT:
ROBERT RONK
1757 MARICOPA DR.
APT. C
OSHKOSH, WI. 54904

LEGAL DESCRIPTION:

All that part of the NE 1/4 of the SE 1/4 of Sec. 2, T.19N., R.15E. in the Town of Winneconne, Winnebago County, Wisconsin, described as follows: Beginning at a Berntsen monument at the East 1/4 corner of said Section 2. From that point running N.88°19'02"W. 1312.11 ft., thence S.01°25'34"E., 535.00 ft., thence S.88°19'02"E., 430.00 ft., thence N.01°25'34"W., 499.94 ft., thence S.88°19'02"E., 882.19 ft. to the East line of the SE 1/4 of said Sec. 2, thence N.01°33'14"W., 35.06 ft. to the said point of beginning. Being a parcel of land of 5.982 acres. Reserving therefrom that portion of St. Rd. "110" presently used for road purposes. Subject to all easements and restrictions of record.



LEGEND

- = Existing monuments
- = 2" x 30' iron pipe set
- = 1" x 30' iron pipe set
- ⊙ = reference caps or RR spikes
- ⊙ = Berntsen or Harrison monuments
- x--x = fence
- () = recorded as
- = stone monument

SURVEYORS CERTIFICATE

I, hereby certify that I have surveyed the property as shown, according to official records and that the plat above drawn is an accurate and correct representation of said survey. AUGUST 2, 1993

Calvin W. Hawksworth
Wisconsin Registered Land Surveyor S-1290

Sawyer
Survey, Inc.

132A WEST MAIN, BOX 252, WINNECONNE, WI 54986

SCALE 1 IN. = 200 FT.



PROJECT NO. S-002720

FIELD BOOK 63 PAGE 46

WINNEBAGO COUNTY
GOVERNMENT LAND CORNER CERTIFICATE

TYPE OF MONUMENT BERNTSEN
STATE PLANE COORDINATES: N _____
S _____
ELEVATION - M.S.L. DATUM: _____
THETA ANGLE: _____
FIELD BOOK _____ PAGE _____
DRAWN BY: D.G. SPIREWKA

CORNER NO. 24
SECTION 2
TOWN 19 NORTH
RANGE 15 EAST

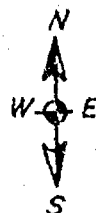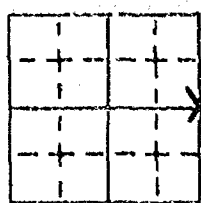


BASIS FOR MONUMENT LOCATION - PROVIDE BELOW

HISTORY OF CORNER, WITH REFERENCE TO VOLUME AND PAGE, DATES, SURVEYOR; EXACT DESCRIPTION OF MONUMENT REPLACED; IF LOCATION COMPUTED BY TAPED OR EDM TRAVERSE; LANDOWNER, WITNESSES, REMARKS, ETC. (USE REVERSE SIDE)

David Giddings, 1839, original corner post.
O. Palmer, County Surveyor, April 1868, No. 256, Vol. 1, County Surveyor Notes. Palmer set this corner by proration. W.W. Goold, County Surveyor, Nov. 1916, Page 202, Vol. 2, County Surveyor Notes. R.F. Wolverton, County Surveyor, 1949, Survey Map. I excavated for this corner, found nothing. I set this corner on the centerline of the roadway as the best evidence of the East-West location and in proportion to the O.G.S. distances between section corners north and south of this corner for North-South location. I set a Berntsen Monument for this corner.

SEAL:

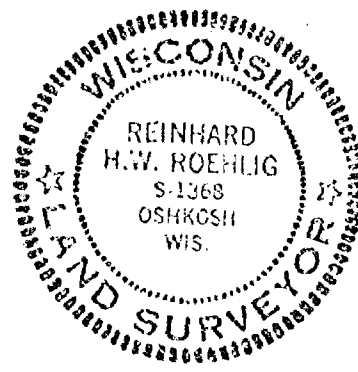

CERTIFIED CORRECT:


Reinhold Roehlig

REGISTERED LAND SURVEYOR

DATE Oct. 1, 1982

TIE SKETCH



SHOW AT LEAST FOUR TIES, ALSO FENCE LINES, ROADS, TOPO, SIZE AND TYPE OF WITNESS TREES AND ANY OTHER PERTINENT SITE DETAILS, IF OFF THE ROAD, THE BEST WAY TO ARRIVE AT THE CORNER.

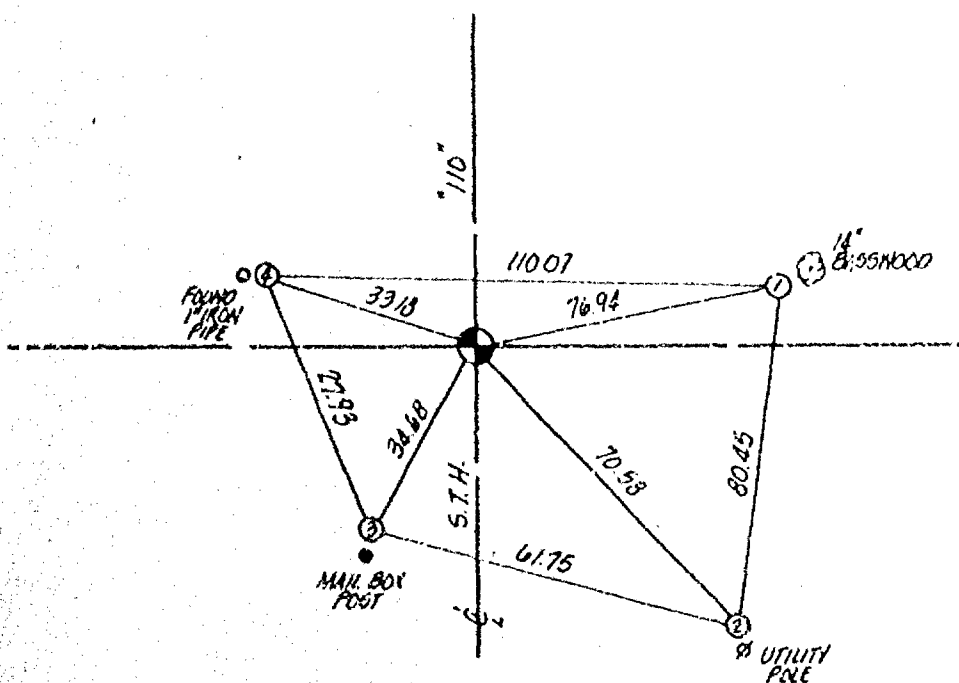

WINNEBAGO COUNTY GOVERNMENT LAND CORNER CERTIFICATE

TYPE OF MONUMENT _____
STATE PLANE COORDINATES: N _____
S _____
ELEVATION - M.S.L. DATUM: _____
THETA ANGLE: _____
FIELD BOOK _____ PAGE _____
DRAWN BY: _____

CORNER NO. 24
SECTION 2
TOWN 19 NORTH
RANGE 15 EAST

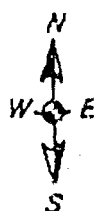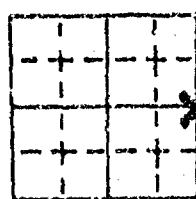


BASIS FOR MONUMENT LOCATION - PROVIDE BELOW

HISTORY OF CORNER, WITH REFERENCE TO VOLUME AND PAGE, DATES, SURVEYOR; EXACT DESCRIPTION OF MONUMENT REPLACED; IF LOCATION COMPUTED BY TAPED OR EDM TRAVERSE; LANDOWNER, WITNESSES, REMARKS, ETC. (USE REVERSE SIDE)

David Giddings, 1839, original corner post. C. Palmer, County Surveyor, April 1868, No. 256, Vol. 1, County Surveyor Notes. Palmer set this corner by proration. W.W. Goold, County Surveyor, Nov. 1916, Page 202, Vol. 2, County Surveyor Notes. R.F. Wolverton, County Surveyor, 1949, Survey Map. R. Roehlig excavated for this corner, found nothing. Roehlig set this corner on the centerline of the roadway as the best evidence of the East-West location and in proportion to the O.G.S. distances between section corners north and south of this corner for North-South location. May 1994, WisDOT set new witness monuments for this corner prior to removal by construction. New monument will be placed at corner when construction progress permits.

SEAL:

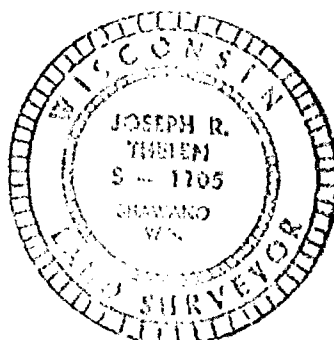


CERTIFIED CORRECT:

Joseph R. Thelen
REGISTERED LAND SURVEYOR
DATE 6-20-94

TIE SKETCH

SHOW AT LEAST FOUR TIES, ALSO FENCE LINES, ROADS, POPO, SIZE AND TYPE OF WITNESS TREES AND ANY OTHER PERTINENT SITE DETAILS. IF OFF THE ROAD, THE BEST WAY TO ARRIVE AT THE CORNER.

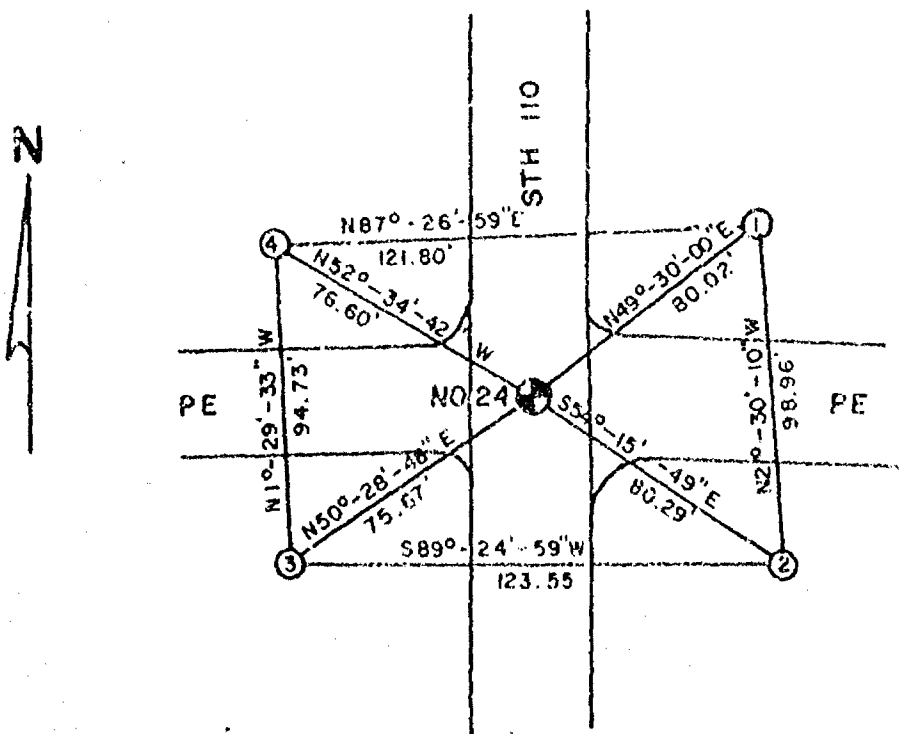

MAINTENANCE RECORD

[illegible]




NO. 3213A

CERTIFIED SURVEY MAP NO. 4577

SHEET 1 OF 4

A REDIVISION OF LOT 1 OF CERTIFIED SURVEY MAP NO. 3924 LOCATED IN PART OF THE N.W. 1/4 AND THE S.W. 1/4 OF THE S.E. 1/4 OF SECTION 2, T19N, R15E, TOWN OF WINNECONNE, WINNEBAGO COUNTY, WISCONSIN

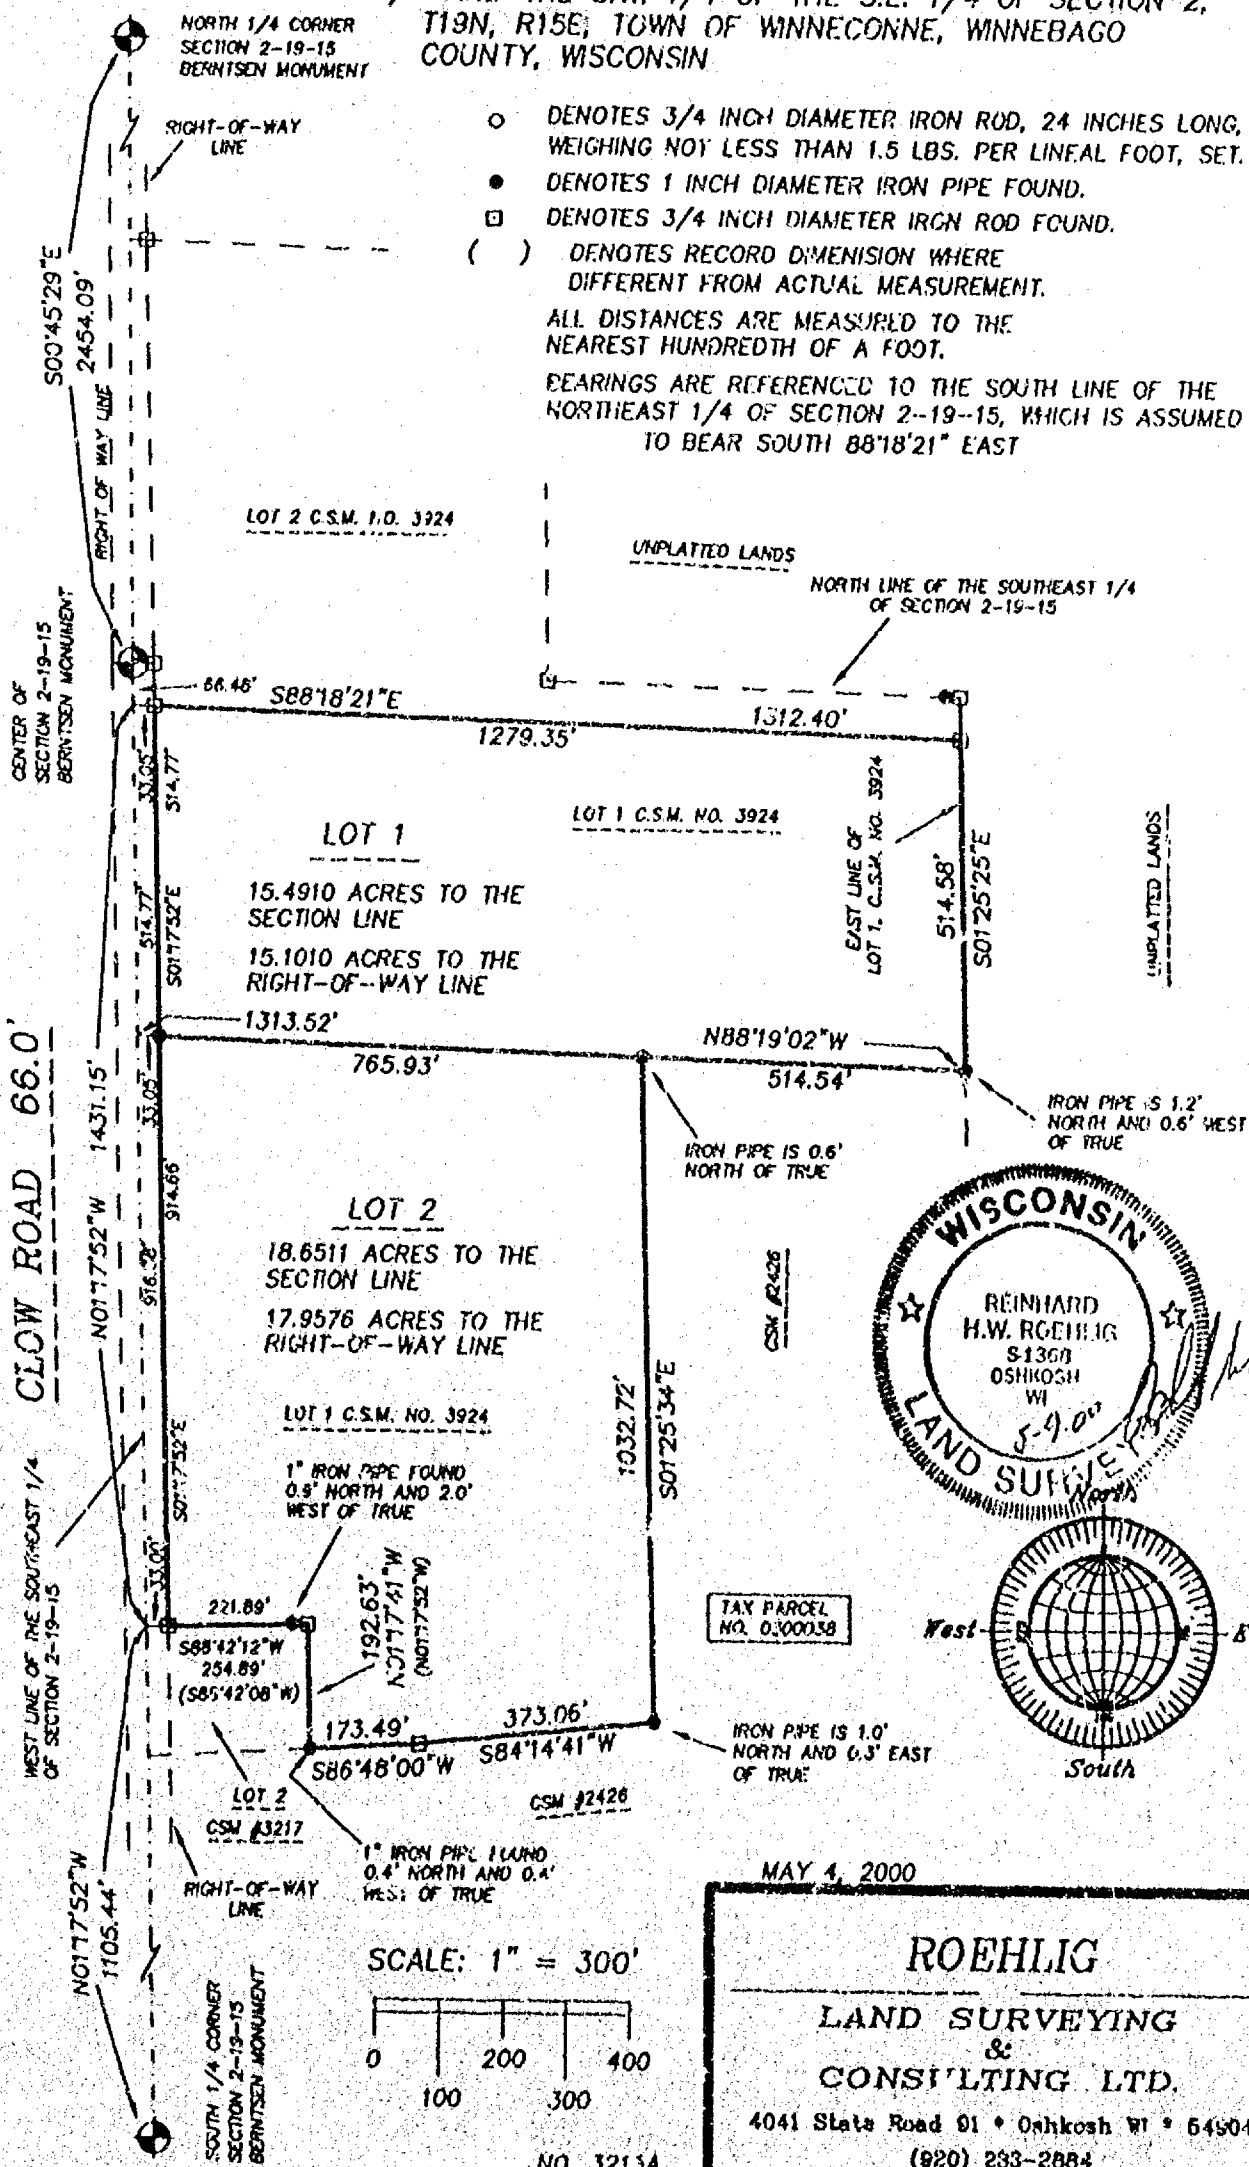

NO. 3213A

CERTIFIED SURVEY MAP NO. 4577

SHEET 2 OF 4

A REDIVISION OF LOT 1 OF CERTIFIED SURVEY MAP NUMBER 3924 LOCATED IN PART OF THE N.W. 1/4 AND THE S.W. 1/4 OF THE S.E. 1/4 OF SECTION 2, T19N, R15E, TOWN OF WINNECONNE, WINNEBAGO COUNTY, WISCONSIN.

**SURVEYORS CERTIFICATE
STATE OF WISCONSIN)**

:SS

WINNEBAGO COUNTY)

I, REINHARD ROEHLIG, Wisconsin Registered Land Surveyor do hereby certify;

THAT I have surveyed, divided and mapped a redivision of Lot 1 of Certified Survey Map Number 3924 located in part of the N.W. 1/4 and the S.W. 1/4 of the S.E. 1/4 of Section 2, T19N, R15E, Town of Winneconne, Winnebago County, Wisconsin, which is bounded and described as follows;

COMMENCING AT THE SOUTH 1/4 CORNER OF SAID SECTION, THENCE NORTH 01°17'52" WEST ALONG THE WEST LINE OF SAID 1/4 SECTION 1105.44 FT. TO THE POINT OF BEGINNING OF THE PARCEL TO BE DESCRIBED, THENCE CONTINUING NORTH 01°17'52" WEST ALONG SAID LINE 1431.15 FT., THENCE SOUTH 88°18'21" EAST ALONG THE NORTH LINE OF LOT 1 OF CERTIFIED SURVEY MAP NO. 3924 AFORESAID 1312.40 FT., THENCE SOUTH 01°25'25" EAST ALONG THE EAST LINE OF SAID LOT 514.58 FT., THENCE NORTH 88°19'02" WEST ALONG THE SOUTH LINE OF SAID LOT 514.54 FT., THENCE SOUTH 01°25'34" EAST ALONG THE EAST LINE OF SAID LOT 1032.72 FT., THENCE SOUTH 84°14'41" WEST ALONG THE SOUTH LINE OF SAID LOT 373.06 FT., THENCE SOUTH 86°48'00" WEST ALONG THE SOUTH LINE OF SAID LOT 173.49 FT. TO THE SOUTHEAST CORNER OF LOT 2 OF CERTIFIED SURVEY MAP NO. 3217, THENCE NORTH 01°17'41" WEST 192.63 FT. TO THE NORTHEAST CORNER OF SAID LOT 2, THENCE SOUTH 88°42'12" WEST ALONG THE NORTH LINE OF SAID LOT 2 AFORESAID 254.89 FT. TO THE POINT OF BEGINNING.

THAT this Certified Survey Map is contained wholly within the property described in the following recorded instrument(s): Certified Survey Map No. 3924.


THAT I have made this survey by the direction of Walter E. Woizeski, Representative for Walter E. Woizeski Trust, owner of said land.

THAT such map is a correct representation of all the exterior boundaries of the land surveyed and the land division thereof made.

THAT I have fully complied with the provisions of Chapter 236 of the Wisconsin Statutes and the Land Subdivision Ordinance of Winnebago County.

5-9-00
Date

Reinhard Roehlig
Reinhard Roehlig, Registered
Wisconsin Land Surveyor S-1368

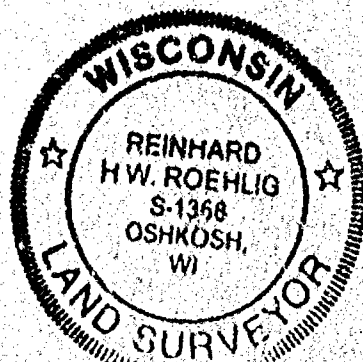

NO. 3213A

CERTIFIED SURVEY MAP NO. 4577

SHEET 3 OF 4

A REDIVISION OF LOT 1 OF CERTIFIED SURVEY MAP NUMBER 3924 LOCATED IN PART OF THE N.W. 1/4 AND THE S.W. 1/4 OF THE S.E. 1/4 OF SECTION 2, T19N, R15E, TOWN OF WINNECONNE, WINNEBAGO COUNTY, WISCONSIN.

OWNERS CERTIFICATE

AS REPRESENTATIVE FOR WALTER E. WOIZESKI TRUST, I hereby certify that I caused the land described on this map to be surveyed, divided and mapped as represented on this map in accordance with the Winnebago County Subdivision Ordinance.

WITNESS the hand and seal of said Representative this 22nd day of May, 2000.

Walter E. Woizeski

Walter E. Woizeski

STATE OF WISCONSIN)

:SS

WINNEBAGO COUNTY)

PERSONALLY came before me this 31st day of MAY 2000 the aforementioned Walter E. Woizeski, Representative for Walter E. Woizeski Trust, to me known to be the person who executed the foregoing instrument and acknowledged the same.

John Hoff
Notary Public, Winnebago
County, State of Wisconsin

My Commission Expires 6-15-2003

COUNTY TREASURERS CERTIFICATE

I, Diana M. Hellmann being the duly elected, qualified and acting treasurer for Winnebago County, do hereby certify that in accordance with the records in my office, there are no unpaid taxes or unpaid special assessments as of 6-7-00 on any land included in this Certified Survey Map.

Date 6-7-00

Treasurer Diana M. Hellmann
Deputy


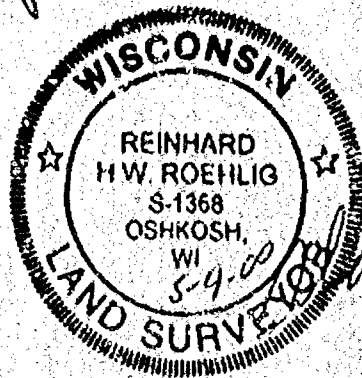


EXHIBIT MAP

FOR REZONING PURPOSES ONLY. A CERTIFIED SURVEY MAP IS REQUIRED
TO SATISFY COUNTY AND TOWN SUBDIVISION ORDINANCES.

A PART OF THE NE. 1/4 OF THE NE. 1/4, SECTION 2, T.19N., R.15E.
TOWN OF WINNECONNE, WINNEBAGO COUNTY, WISCONSIN.

SURVEY FOR:
LEONARD AND ANDREA MANSON
5835 WOODLAND RD
WINNECONNE, WI 54986

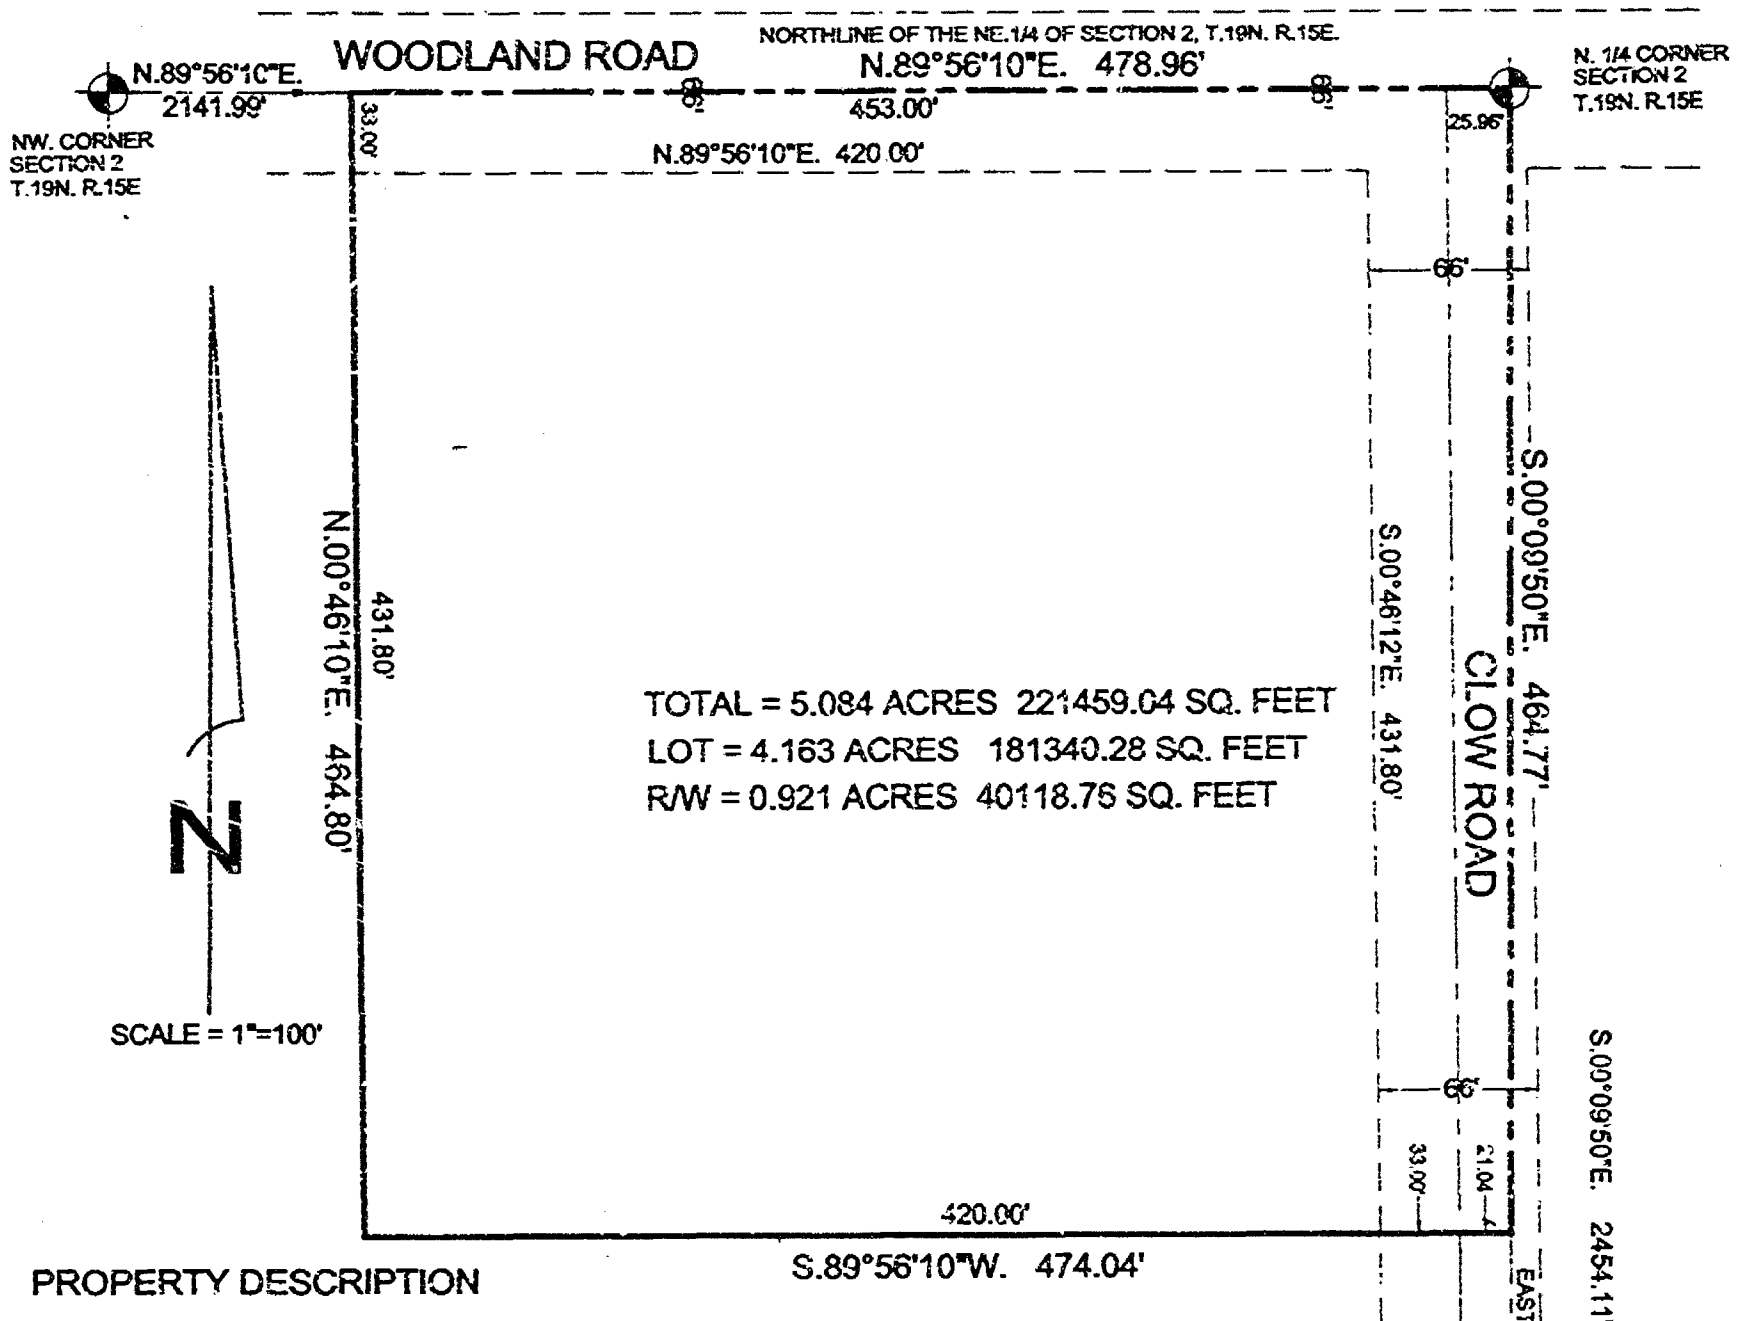

PROPERTY DESCRIPTION

A PART OF THE NORTHEAST QUARTER (NE. 1/4) OF THE NORTHEAST QUARTER (NE. 1/4) OF SECTION TWO (2), TOWNSHIP NINETEEN (19), RANGE FIFTEEN (15) EAST, TOWN OF WINNECONNE, WINNEBAGO COUNTY, WISCONSIN CONTAINING 221459.04 SQ. FT (5.084 ACRES) AND BEING DESCRIBED AS FOLLOWS:


COMMENCING AT THE NORTH QUARTER CORNER OF SAID SECTION 2 AND THE POINT OF BEGINNING; THENCE S.00°09'50"E. 464.77 FEET ALONG THE EAST LINE OF THE NE. 1/4 OF THE NE. 1/4 OF SAID SECTION 2; THENCE S.89°56'10"E. 474.04 FEET; THENCE N.00°46'12"W. 464.80 FEET TO A POINT ON THE NORTHLINE OF THE NE. 1/4 OF THE NE. 1/4 OF SAID SECTION 2; THENCE N.89°56'10"E. 478.96 FEET ALONG THE NORTHLINE OF THE NE. 1/4 OF THE NE. 1/4 OF SAID SECTION 2 TO THE POINT OF BEGINNING AND BEING SUBJECT TO ALL EASEMENTS AND RESTRICTIONS OF RECORD.

SURVEYOR'S CERTIFICATE:

I, LAWRENCE C. KRIESCHER, WISCONSIN REGISTERED LAND SURVEYOR, HEREBY CERTIFY THAT I HAVE SURVEYED THE ABOVE DESCRIBED PROPERTY AND THAT THE MAP SHOWN IS A TRUE AND ACCURATE REPRESENTATION THEREOF TO THE BEST OF MY KNOWLEDGE AND BELIEF.

DATED THIS 28TH DAY OF JUNE

Lawrence C. Kriescher
WISCONSIN REGISTERED LAND SURVEYOR S-1599
LAWRENCE C. KRIESCHER

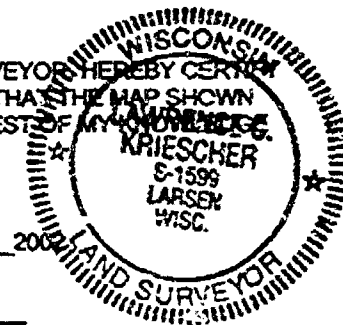

CENTER 1/4 CORNER
SECTION 2
T.19N. R.15E

NOTEBOOK: 7 PAGE: 54

L.C. KRIESCHER AND ASSOCIATES LLC.
5251 GRANDVIEW ROAD
LARSEN, WI. 54947
920-836-3576

BOL IDARY SURVEY
LAND DESIGN


PROJECT NO.
FILE: MANSON.DWG
DWG. NO. L-140



STATE OF WISCONSIN
WINNEBAGO COUNTY

WINNEBAGO COUNTY CERTIFIED SURVEY MAP NO. 5125

A PART OF THE NW 1/4 OF THE NW 1/4 OF SECTION 2, T14N, R15E, TOWNSHIP 14 NORTH, RANGE 15 EAST, COUNTY OF WINNEBAGO, WISCONSIN

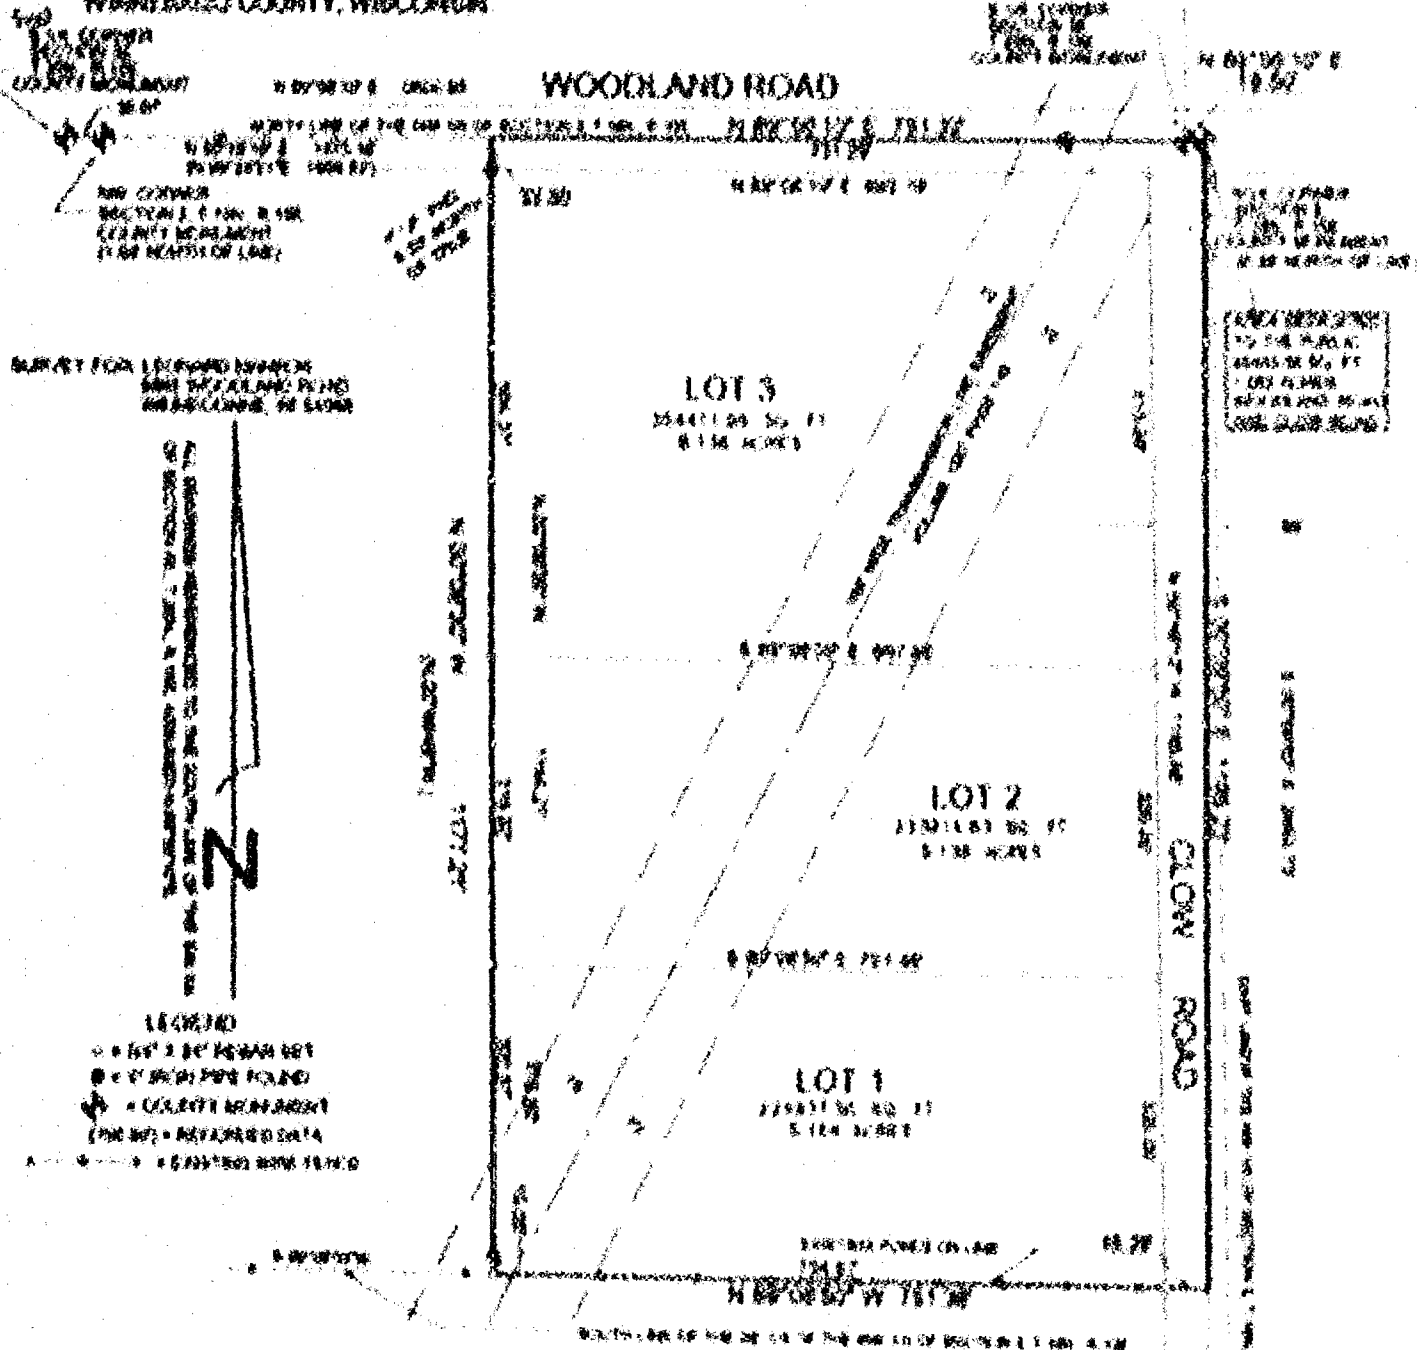

DATED THIS 21st DAY OF OCTOBER 2008

James C. Kriescher
WINNEBAGO COUNTY REGISTERED LAND SURVEYOR & ENGINEER
LARSSEN, C. #123456789




CORNER OF SECTION
25, T14N, R15E, S1/2
COUNTY OF WINNEBAGO

PROJECT NO. 270701
FILE NO. WABCO(4) DWG
NOTEBOOK 7 PAGE 34

L.C. KRIESCHER AND ASSOCIATES LLC.
5251 GRANDVIEW ROAD
LARSEN, WI. 54947
920.830.3578

EXHIBIT MAP
LAND DESIGN

SCALE 1" = 200'

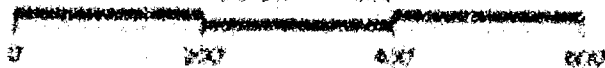


DWG. NO. L-148



STATE OF WISCONSIN
WINNEBAGO COUNTY, SS


WINNEBAGO COUNTY CERTIFIED SURVEY MAP NO. 5175

A PART OF THE NE.1/4 OF THE NW.1/4 OF SECTION 2, T.19N., R.15E., TOWN OF WINNECONNE
WINNEBAGO COUNTY, WISCONSIN.

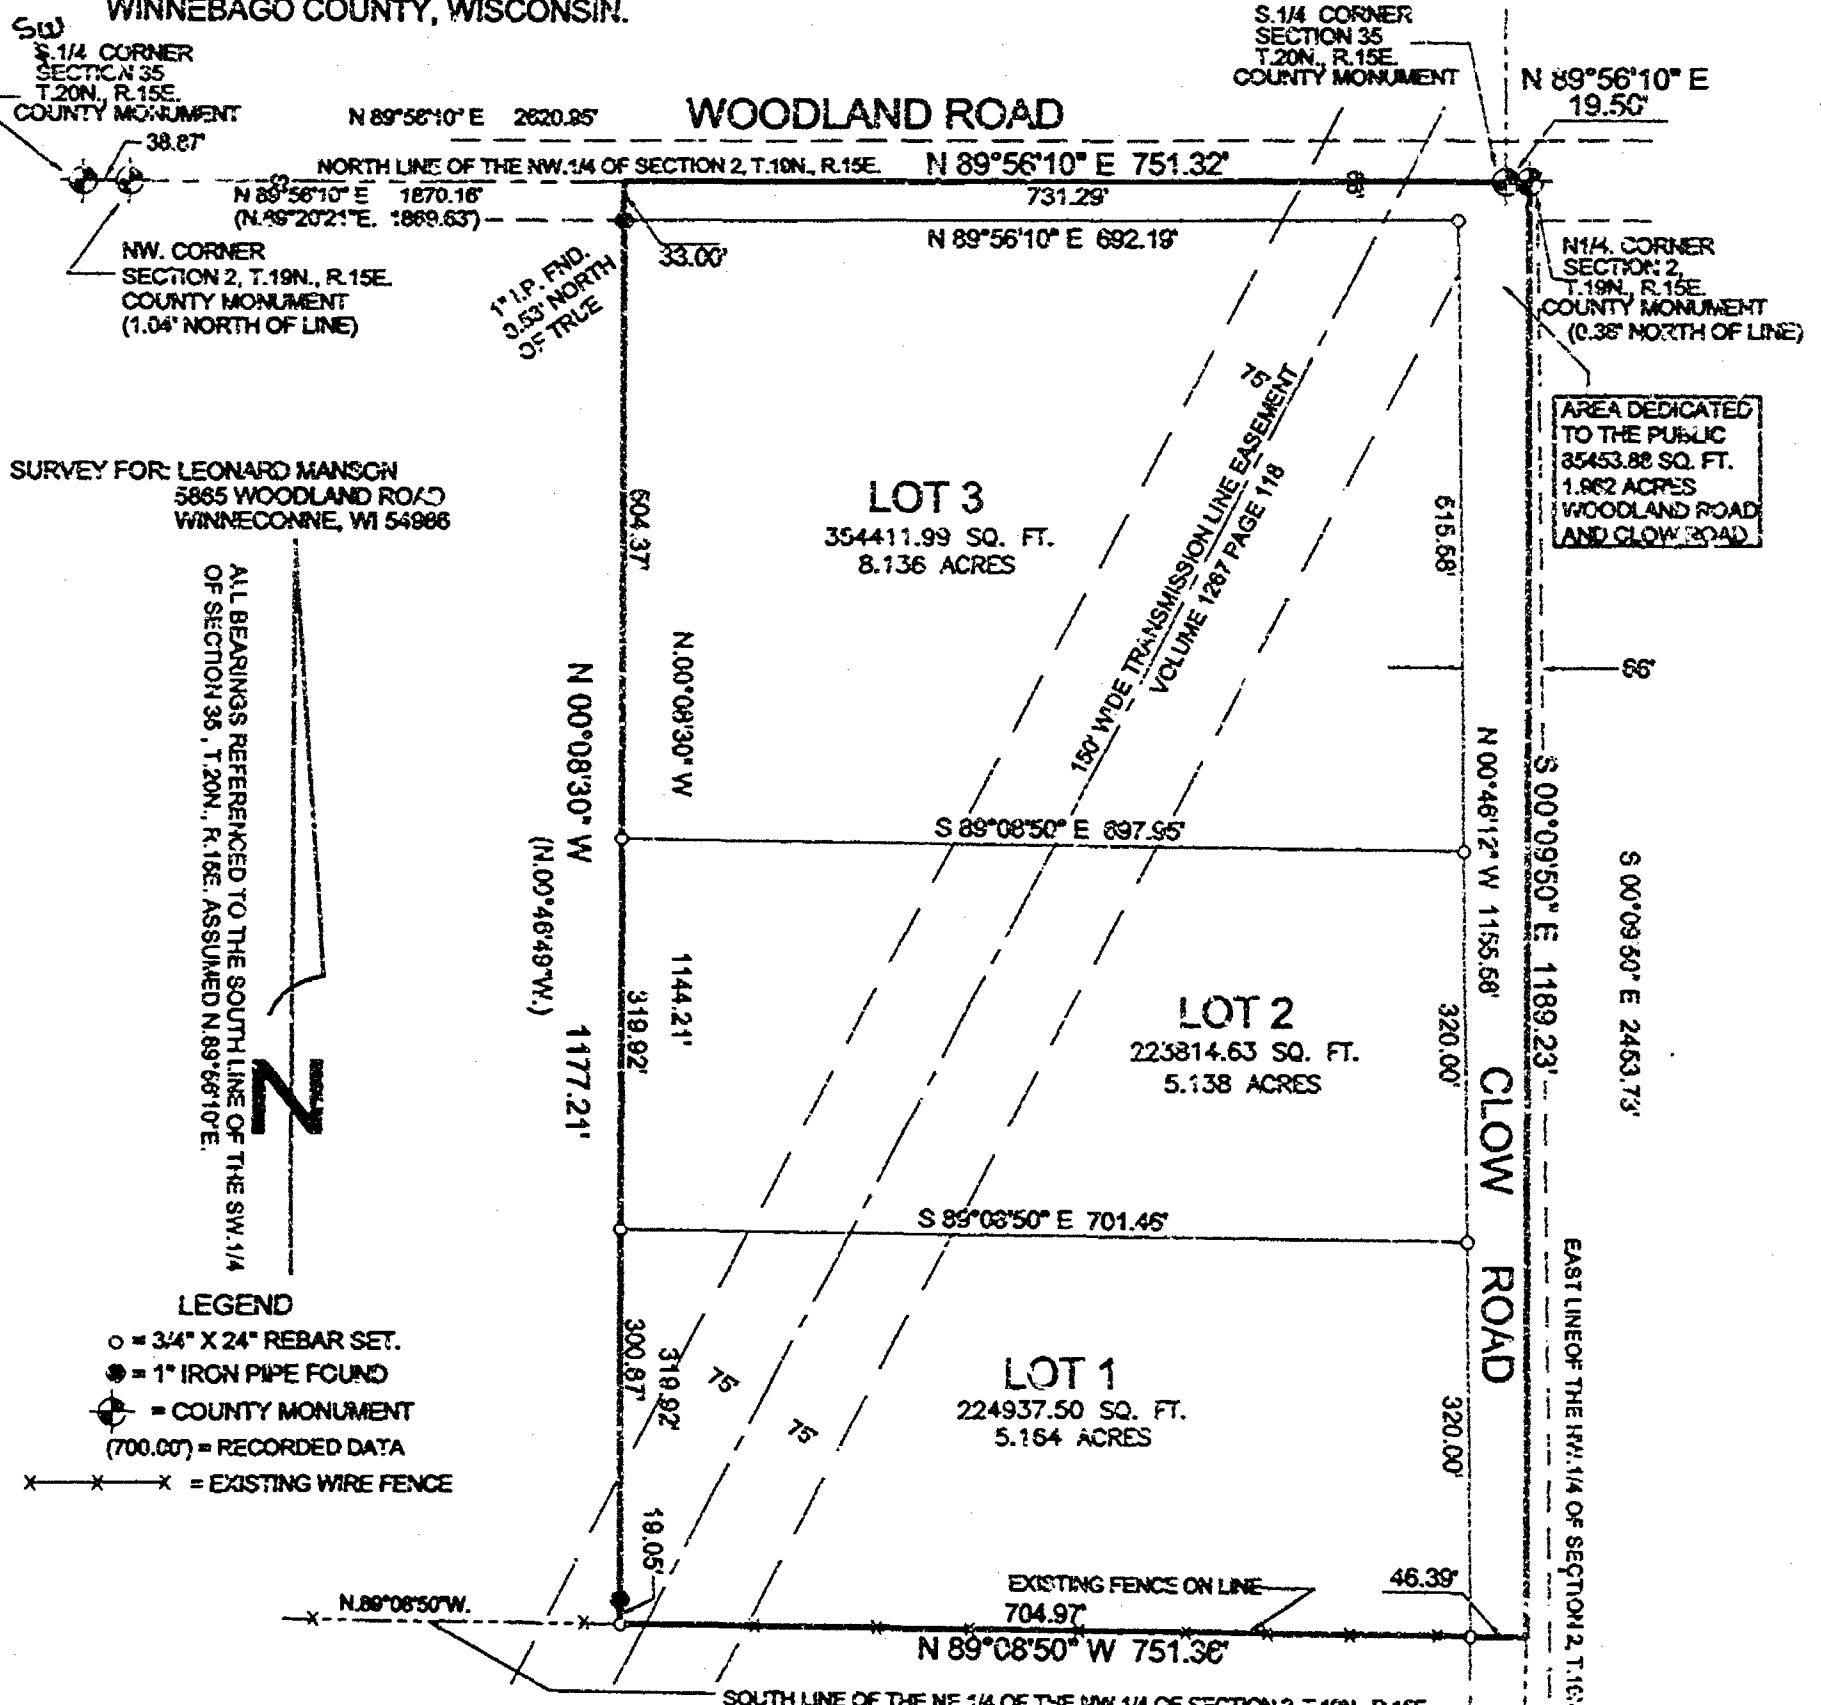

DATE THIS 21ST DAY OF OCTOBER 2002

Lawrence C. Kriescher
WISCONSIN REGISTERED LAND SURVEYOR S-1599
LAWRENCE C. KRIESCHER

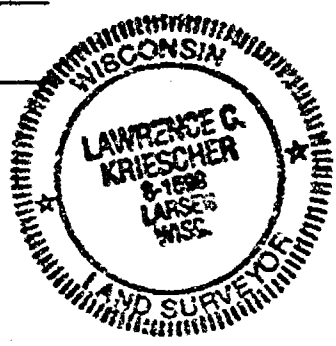


CENTER OF SECTION
SECTION 2, T.19N., R.15E.
COUNTY MONUMENT

PROJECT NO. 220701
FILE NO. MANSON(4).DWG
NOTEBOOK:7 PAGE:54

L.C. KRIESCHER AND ASSOCIATES LLC.
5251 GRANDVIEW ROAD
LARSEN, WI. 54947
920-836-3576

BOUNDARY SURVEY
&
LAND DESIGN

SCALE: 1" = 200'

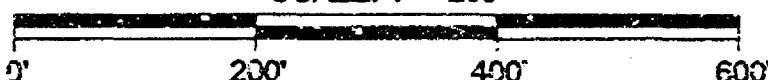


DWG. NO. L-148



STATE OF WISCONSIN
WINNEBAGO COUNTY, SS


WINNEBAGO COUNTY CERTIFIED SURVEY MAP NO. 5175

A PART OF THE NE. 1/4 OF THE NW. 1/4 OF SECTION 2, T.19N., R.15E., TOWN OF WINNECONNE
WINNEBAGO COUNTY, WISCONSIN.

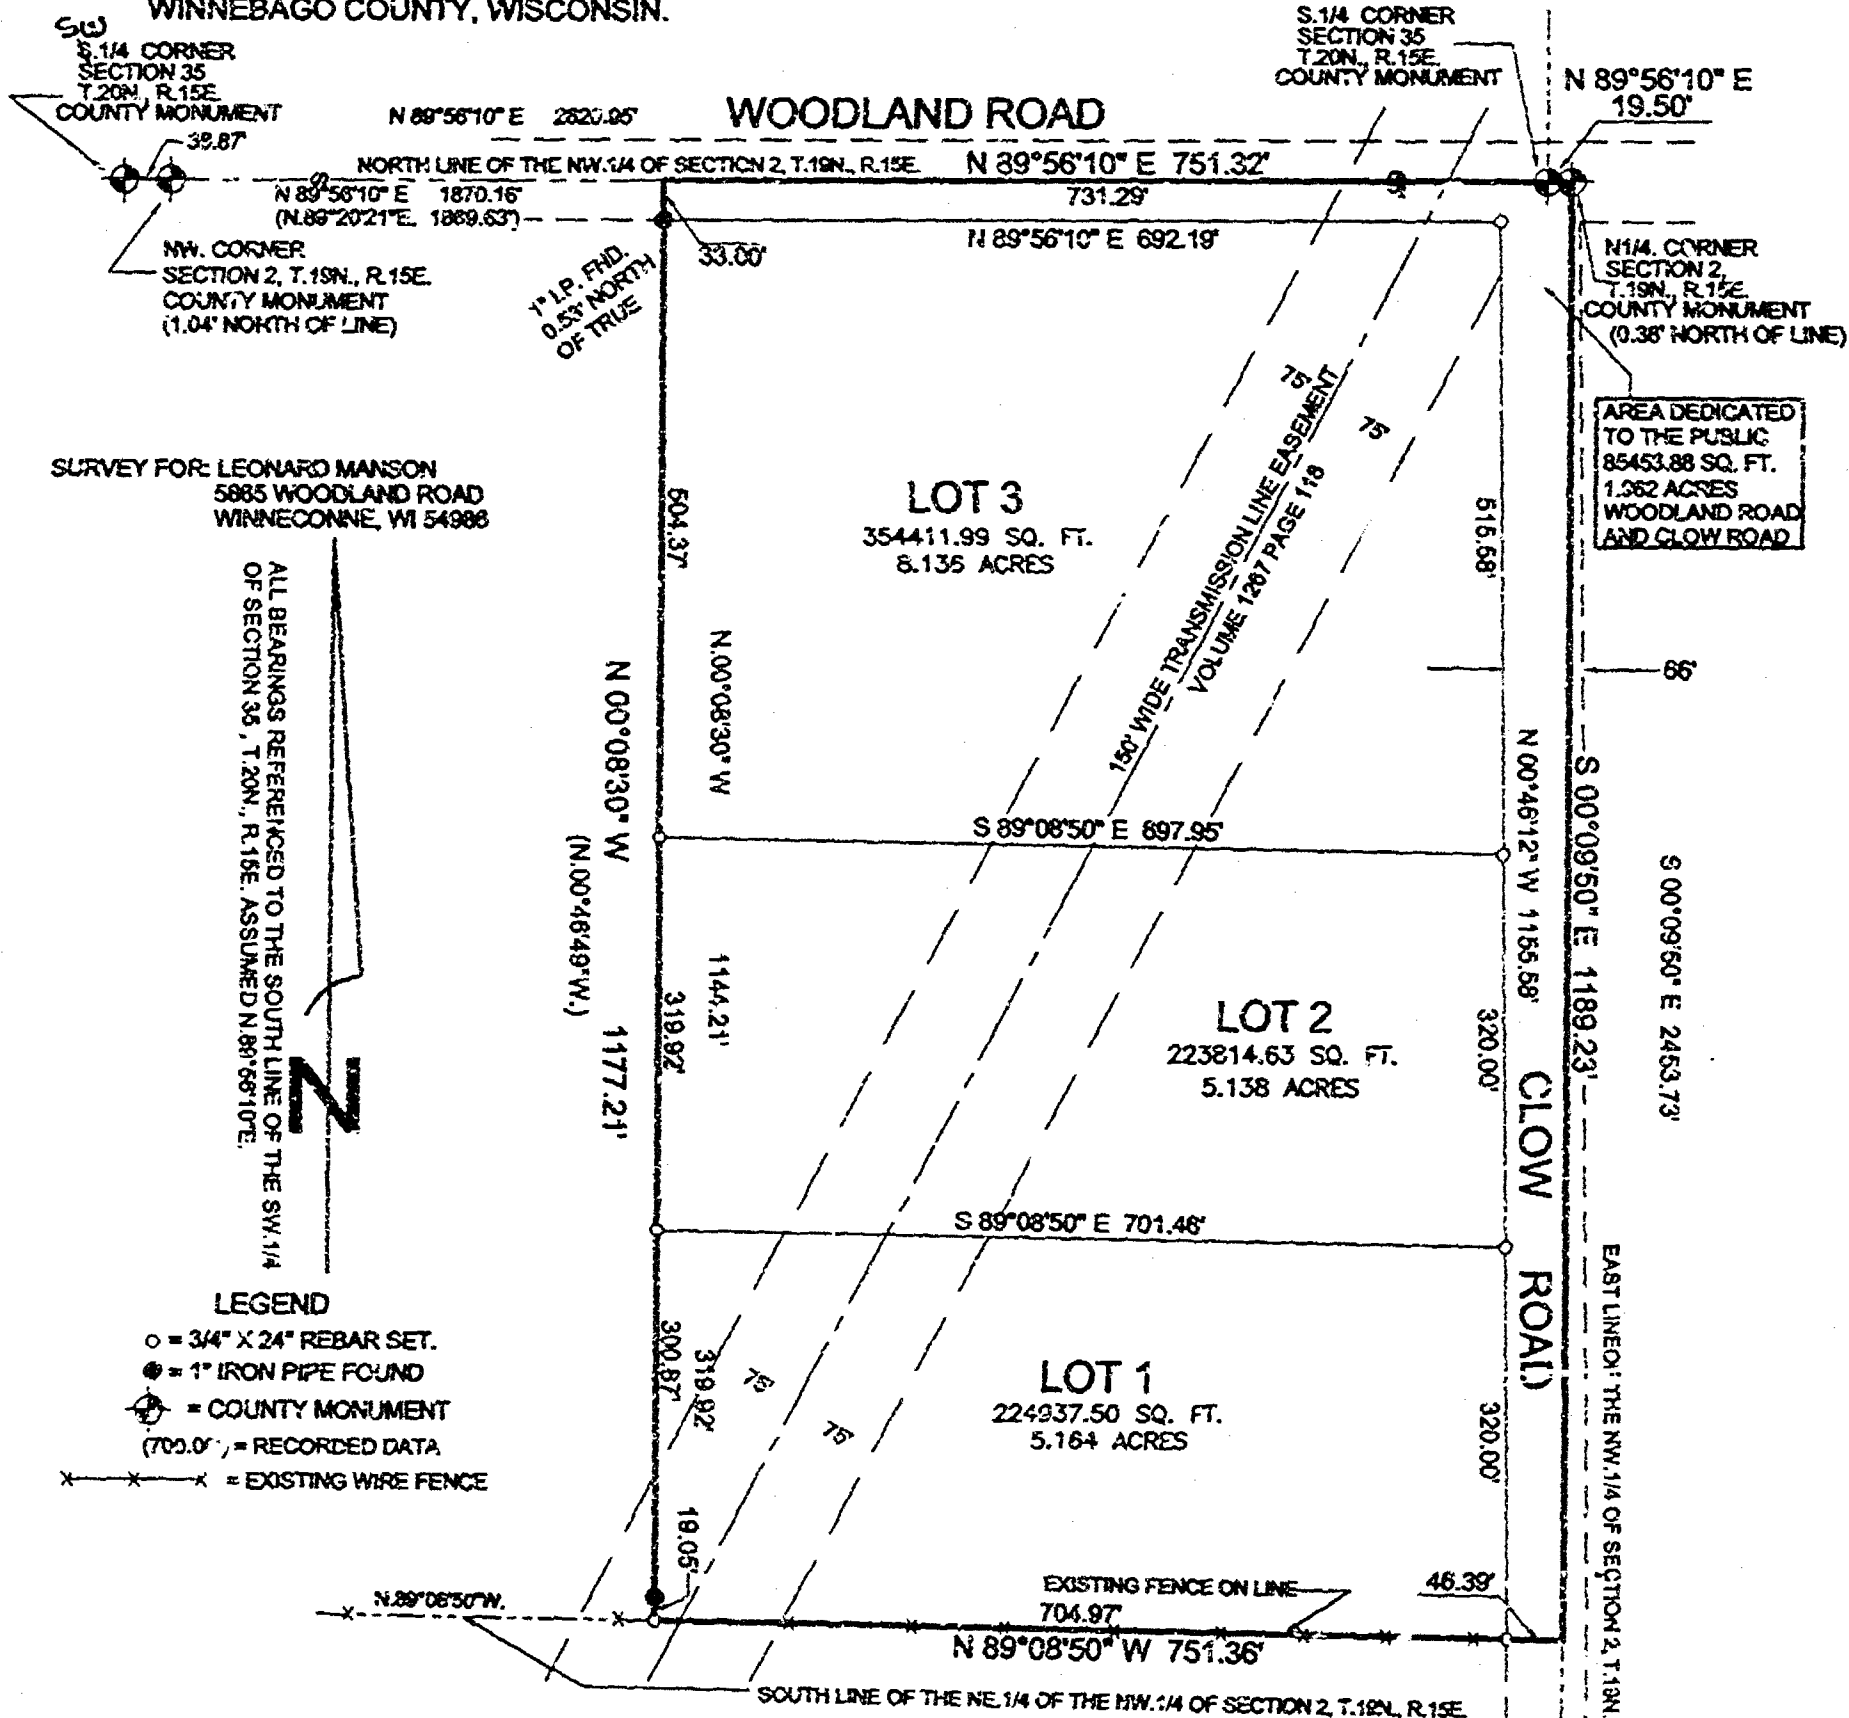

DATED THIS 21ST DAY OF OCTOBER 2002

Lawrence C. Kriescher
WISCONSIN REGISTERED LAND SURVEYOR S-1599
LAWRENCE C. KRIESCHER

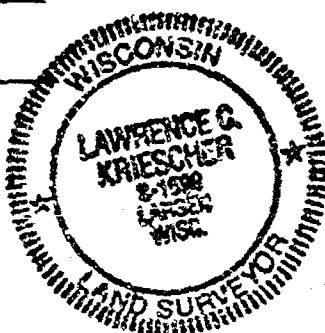


CENTER OF SECTION
SECTION 2, T.19N., R.15E.
COUNTY MONUMENT

PROJECT NO. 220701
FILE NO. MANSON(4).DWG
NOTEBOOK:7 PAGE:54

L.C. KRIESCHER AND ASSOCIATES LLC.
5251 GRANDVIEW ROAD
LARSEN, WI. 54947
920-836-3576

BOUNDARY SURVEY
&
LAND DESIGN

SCALE: 1" = 200'

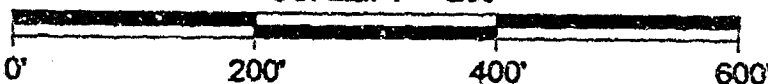

DWG. NO. L-148

#5775

WINNEBAGO COUNTY CERTIFIED SURVEY

WEST 1/4

A PART OF THE NE 1/4 OF THE NW 1/4 OF SECTION 1 T1N. 14S. TOWNSHIP OF WINNEBAGO, WINNEBAGO COUNTY, WISCONSIN

SURVEYOR'S CERTIFICATE

I, LAWRENCE C. KIRK, WINNEBAGO REGISTERED LAND SURVEYOR OF L.C. KIRK AND ASSOCIATES, L.L.C., CERTIFY THAT I HAVE SURVEYED, MEASURED AND MAPPED UNDER THE DIRECTION OF ANNEA MARSON A PART OF THE NORTHEAST QUARTER (NE 1/4) OF THE NORTHWEST QUARTER (NW 1/4) OF SECTION TWO (2), TOWNSHIP NINETEEN (19) NORTH, RANGE SIXTEEN (16) EAST, TOWNSHIP OF WINNEBAGO, WINNEBAGO COUNTY, WISCONSIN CONTAINING 602.12 ACRES MORE OR LESS (25 AND 3/4 ACRES) OF LAND AND BEING DESCRIBED AS FOLLOWS:

COMMENCED AT THE NORTH QUARTER CORNER OF EAST SECTION 2 AND THE POINT OF BEGINNING THENCE S 89° 00' 00" E 110.23 FEET ALONG THE EAST LINE OF THE NE 1/4 OF THE NW 1/4 OF SAID SECTION 2 THENCE N 89° 00' 00" E 75.14 FEET ALONG THE SOUTH LINE OF THE NE 1/4 OF THE NW 1/4 OF SAID SECTION 2 THENCE S 89° 00' 00" E 111.21 FEET TO A POINT ON THE NORTH LINE OF THE NW 1/4 OF SAID SECTION 2 THENCE N 89° 00' 00" E 131.22 FEET ALONG THE NORTH LINE OF THE NW 1/4 OF SAID SECTION 2 TO THE POINT OF BEGINNING AND SUBJECT TO ALL EASEMENTS AND RESTRICTIONS OF RECORD.

THAT SUCH IS A CORRECT REPRESENTATION OF ALL EXTERIOR BOUNDARIES OF LAND SURVEYED THAT I HAVE FULLY COMPLIED WITH THE PROVISIONS OF CHAPTER 19.14 OF THE WISCONSIN STATUTES AND THE LAND SURVEYING ORDINANCE OF WINNEBAGO COUNTY AND THE TOWN OF WINNEBAGO IN SURVEYING AND MAPPING THE LAND.

DATED THIS 21ST DAY OF OCTOBER, 2008

Lawrence C. Kirk
WINNEBAGO REGISTERED LAND SURVEYOR & 1908
LAWRENCE C. KIRK



WINNEBAGO COUNTY PLANNING AND ZONING COMMITTEE

A PART OF THE NE 1/4 OF THE NW 1/4 OF SECTION 1 T1N. 14S. TOWNSHIP OF WINNEBAGO, WINNEBAGO COUNTY, WISCONSIN
DONALD E. BAKER CHAIRMAN IS HEREBY APPROVED

DATE

BY AUTHORIZED REPRESENTATIVE

CITY OF OSHKOSH PLANNING COMMISSION CERTIFICATE

A PART OF THE NE 1/4 OF THE NW 1/4 OF SECTION 1 T1N. 14S. TOWNSHIP OF WINNEBAGO, WINNEBAGO COUNTY, WISCONSIN
DONALD E. BAKER CHAIRMAN IS HEREBY APPROVED

DATE

BY AUTHORIZED REPRESENTATIVE

TOWN BOARD APPROVAL

THIS CERTIFIED SURVEY MAP HAS BEEN REVIEWED AND APPROVED BY THE TOWN BOARD OF THE TOWN OF WINNEBAGO, WINNEBAGO COUNTY, WISCONSIN

DATE

TOWN BOARD REPRESENTATIVE

THIS CERTIFIED SURVEY MAP IS ALL OF THE PARCELS NO. 000000
OWNER OF RECORD: ANNEA MARSON AND ANNEA MARSON
THIS C.S.M. IS CONTAINED WHOLLY WITHIN THE PROPERTY DESCRIBED IN THE FOLLOWING RECORDS: INCL. 111772

FORM NO. 5-148

#5175

PART 101

WINNEBAGO COUNTY CERTIFIED SURVEY

A PART OF THE NE 1/4 OF THE NW 1/4 OF SECTION 2, T 14N, R 15E, TOWN OF WINNEBAGO,
WINNEBAGO COUNTY, WISCONSIN

OWNER'S CERTIFICATE

AS OWNER I HEREBY CERTIFY THAT I CAUSED THE LAND ON THE CERTIFIED SURVEY MAP TO BE SURVEYED, LAYED
OFF, MAPPED AND EXEMPTED AS REPRESENTED ON THIS MAP
BY THE PROVISIONS OF

Edward A. Hanson
EDWARD A. HANSON

Orville Hanson
ORVILLE HANSON

STATE OF WISCONSIN
COUNTY OF WINNEBAGO

PERSONALLY CAME BEFORE ME THIS 21st DAY OF November FOR THE ABOVE NAMED
EDWARD HANSON AND ORVILLE HANSON WHO TO ME SEEMED TO BE THE PERSONS WHO EXECUTED THE FOREGOING
INSTRUMENT AND ACKNOWLEDGE THE SAME.

James E. Smith
COUNTY CLERK, WINNEBAGO COUNTY, WISCONSIN

COUNTY TREASURER'S CERTIFICATE

I BEING DULY ELECTED, QUALIFIED AND ACTING TREASURER OF THE COUNTY OF WINNEBAGO, DO HEREBY CERTIFY THAT THE
RECORDS IN MY OFFICE SHOW NO UNPAID TAX SALES AND NO UNPAID TAXES OR SPECIAL ASSESSMENTS OF
AFFECTING THE LANDS INCLUDED IN THIS CERTIFIED SURVEY MAP.

11/21/08
DATED

Maye K. Brown
COUNTY TREASURER

CERTIFICATE OF TOWN TREASURER

I BEING DULY ELECTED, QUALIFIED AND ACTING TOWN TREASURER OF THE TOWN OF WINNEBAGO, DO HEREBY CERTIFY THAT IN
ACCORDANCE WITH THE RECORDS IN MY OFFICE I HAVE NOT PAID SPECIAL ASSESSMENTS AS OF
AFFECTING THE LANDS INCLUDED IN THIS CERTIFIED SURVEY MAP.

11-21-08
DATED

Scott Johnson
TOWN TREASURER

DATED THIS 21st DAY OF OCTOBER 2008

James C. Smith
WINNEBAGO COUNTY CLERK
JAMES C. SMITH



1217988

REGISTER'S OFFICE
WINNEBAGO COUNTY, WI
RECORDED ON

12-09-2002 03:23 PM

Vol. 1 p. 5175
SUSAN WINNINGHOFF
REGISTER OF DEEDS

RECORDING FEE 17.00
TRANSFER FEE
OF PAGES

Escon

NO. 3213A

CERTIFIED SURVEY MAP NO. 4577

SHEET 4 OF 4

A REDIVISION OF LOT 1 OF CERTIFIED SURVEY MAP NUMBER 3924 LOCATED IN PART OF THE N.W. 1/4 AND THE S.W. 1/4 OF THE S.E. 1/4 OF SECTION 2, T19N, R15E, TOWN OF WINNECONNE, WINNEBAGO COUNTY, WISCONSIN.

TOWN TREASURERS CERTIFICATE

I, Julie Van Dijk, being the duly elected, qualified and acting treasurer for the Town of Winneconne, do hereby certify that in accordance with the records in my office, there are no unpaid taxes or unpaid special assessments as of 5-22-00 on any land included in this Certified Survey Map.

Date 5-22-00

Treasurer Julie Van Dijk

**WINNEBAGO COUNTY PLANNING COMMISSION
CERTIFICATE OF APPROVAL**


This Certified Survey Map of a redivision of Lot 1 of Certified Survey Map Number 3924 located in part of the N.W. 1/4 and the S.W. 1/4 of the S.E. 1/4 of Section 2, T19N, R15E, Town of Winneconne, Winnebago County, Wisconsin, is hereby approved.

Date July 21, 2000

Jeanne M. Stewart
County Planning Commission
Representative

THIS DOCUMENT WAS DRAFTED BY

DAVID CARLSON.

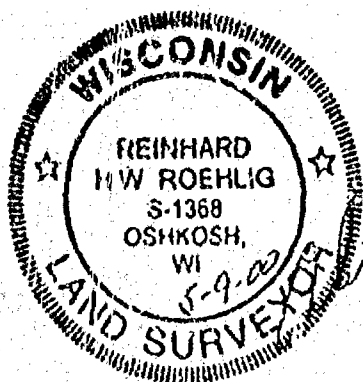

110-279
REGISTER'S OFFICE
WINNEBAGO COUNTY, WI
RECORDED ON
07-21-2000 01:30 PM
SUSAN WINNINGHOFF
REGISTER OF DEEDS
RECORDING FEE 16.00
TREASURER FEE
IF PAGES