


SEC 32 TAN RISE

Plat of Survey

LOCATION OF THE SW COR. OF THE NW 1/4 OF THE SW 1/4, SEC. 32
T. 19N., R. 15E., TOWN OF WINNECONNE, WINNEBAGO COUNTY, WI

CLIENT: DAN KROMM
6992 KROMM RD.
OMRO, WI

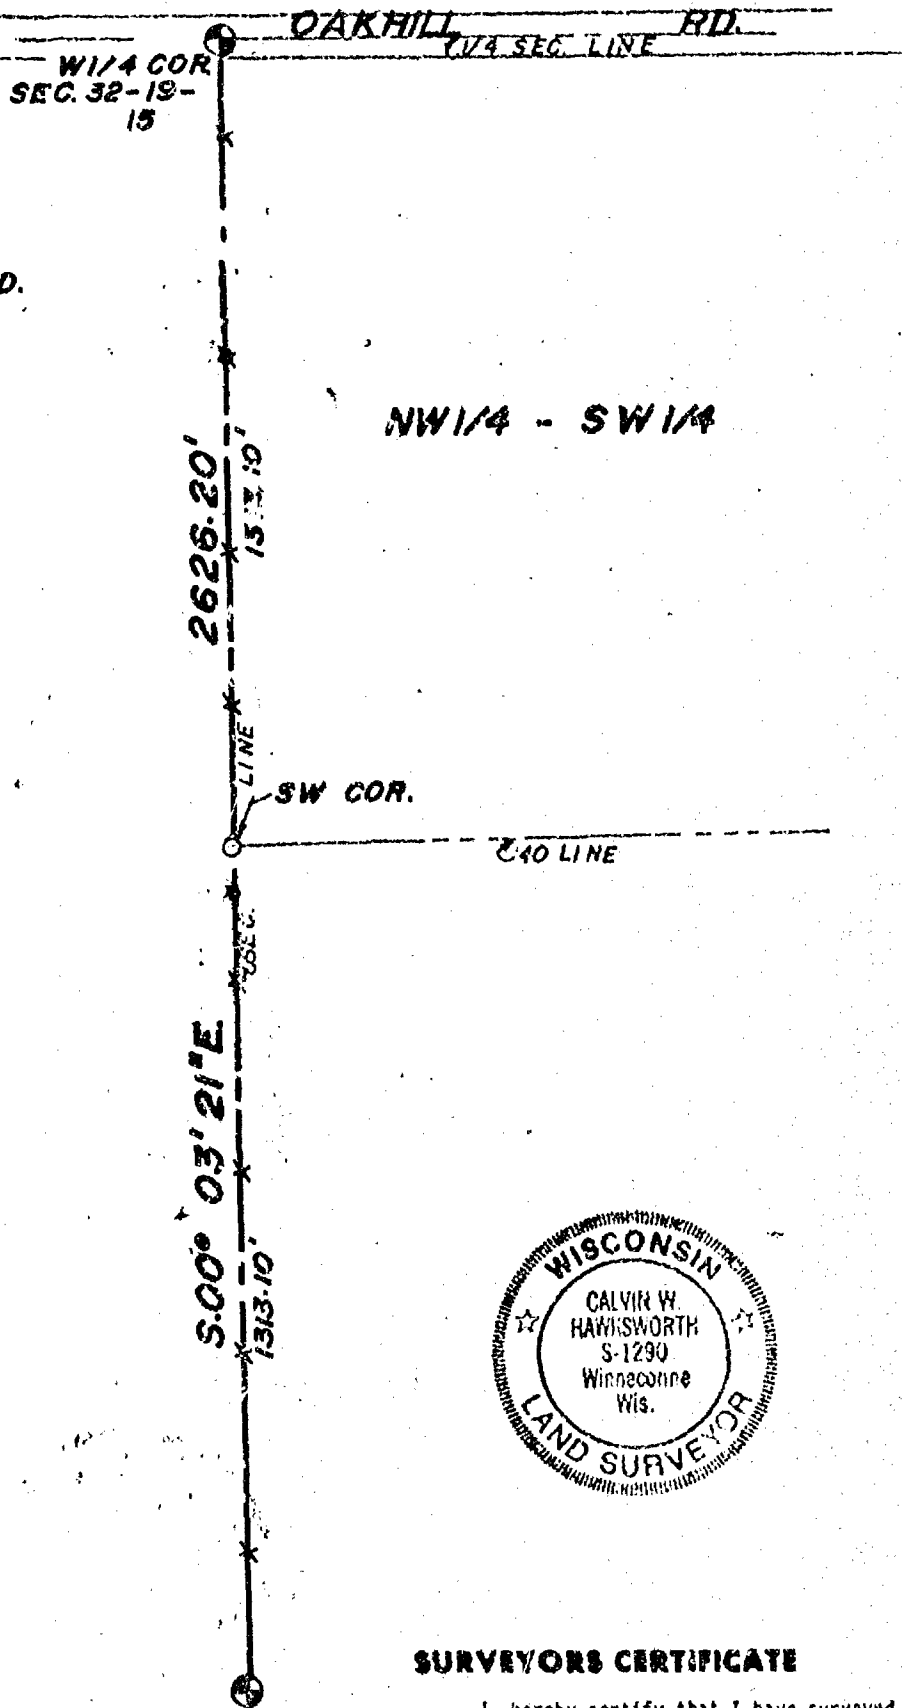

NW 1/4 - SW 1/4



LEGEND

- = Existing monuments
- = 2" x 30" iron pipe set
- = 1" x 30" iron pipe set
- = reference caps or RR spikes
- = Bernisen or Harrison monuments
- x—x = fence
- () = recorded as
- = stone monument

SW COR.
SEC. 32-19-15

SURVEYORS CERTIFICATE

I, hereby certify that I have surveyed the property as shown, according to official records and that the plat above drawn is an accurate and correct representation of said survey. DECEMBER 4, 1987

Calvin W. Hawisworth
Wisconsin Registered Land Surveyor S-1290

Sayler
Survey, Inc.

1394 WEST MAIN, BOX 252, WINNECONNE, WI 54980

SCALE 1" = 300'
PROJECT NO. S-001874
FIELD BOOK 42 PAGE 141


ZONING MAP

Located in the Southwest 1/4 of Section 32, T.19N., R.15E.,
Town of Winneconne, Winnebago County, Wisconsin

Beginning at an iron pipe that is 639.64 ft. N.89°59'40"E.
and 943.85 ft. S.00°45'20"E. from the West 1/4 corner of said
Section 32. From that point running S.00°45'20"E. 290.40 ft.,
thence S.89°14'40"W. 183.00 ft., thence N.00°45'20"W. 290.40 ft.,
thence N.89°14'40"E. 183.00 ft. to the point of beginning.
Being a parcel of land of 1.22 acres, more or less.

CLIENTS:
Walter & Pat Lucki
130 Spruce Street,
Oro, WI 54963

NOTE: This map and description
are for zoning purposes only.

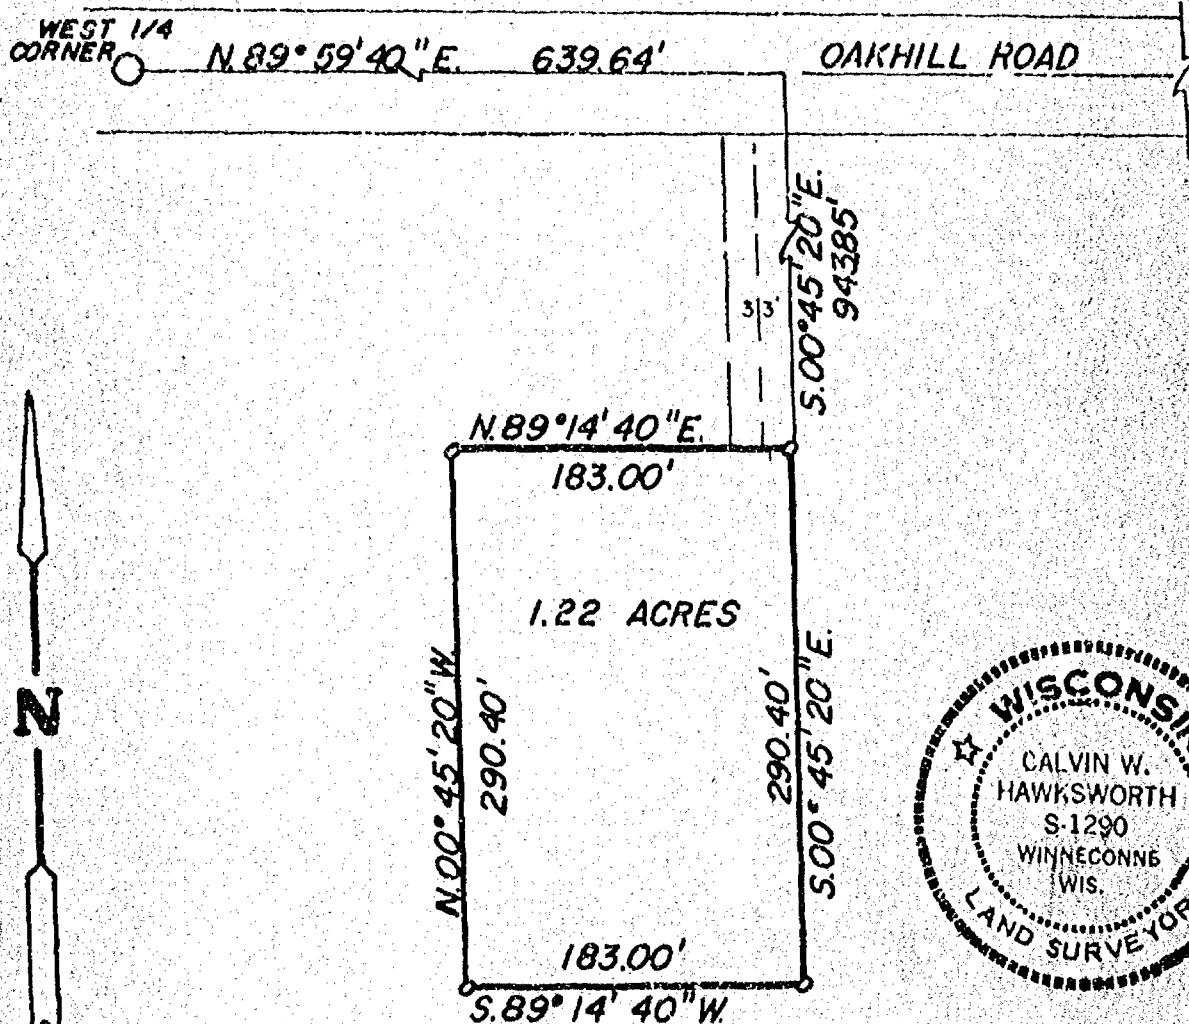

LEGEND

- = Existing monuments
- = 1" IRON PIPE SET BY GOULD
- = 1" x 30" iron pipe set
- = reference caps or RR spikes
- ⊙ = Berntsen or Harrison monuments
- X-X = fence
- () = recorded as
- = stone monument

SURVEYORS CERTIFICATE

I, hereby certify that I have surveyed the property
as shown, according to official records and that the plat
above drawn is an accurate and correct representation of
said survey. MARCH 2, 1982

Calvin W. Hawksworth

Wisconsin Registered Land Surveyor S-1290

S

S

R. K. SAYLER, INC.
LAND SURVEYORS
WINNECONNE, WI 54936

SCALE 1" = 100'

PROJECT NO. S-001271

FIELD BOOK 42 PAGE 141

Stock No. 26273

WINNEBAGO COUNTY CERTIFIED SURVEY MAP NO. 1086
 Located in part of the Northeast $\frac{1}{4}$ of the Southwest $\frac{1}{4}$ of Section
 32, T.19N., R.15E., Town of Vinneconne, Winnebago County, WI


WINNEBAGO COUNTY PLANNING COMMITTEE CERTIFICATE

This Certified Survey Map of part of the Northeast $\frac{1}{4}$ of
 the Southwest $\frac{1}{4}$ of Section 32, T.19N., R.15E., Town of Winne-
 conne, Winnebago County, Wisconsin, is hereby approved.

Date Jan. 11, 1983
 Approved

Mary Ann Warming
 Authorized Representative

Calvin W. Hawksworth
 Calvin W. Hawksworth S-1290
 Wisconsin Registered Land Surveyor
 January 3, 1983

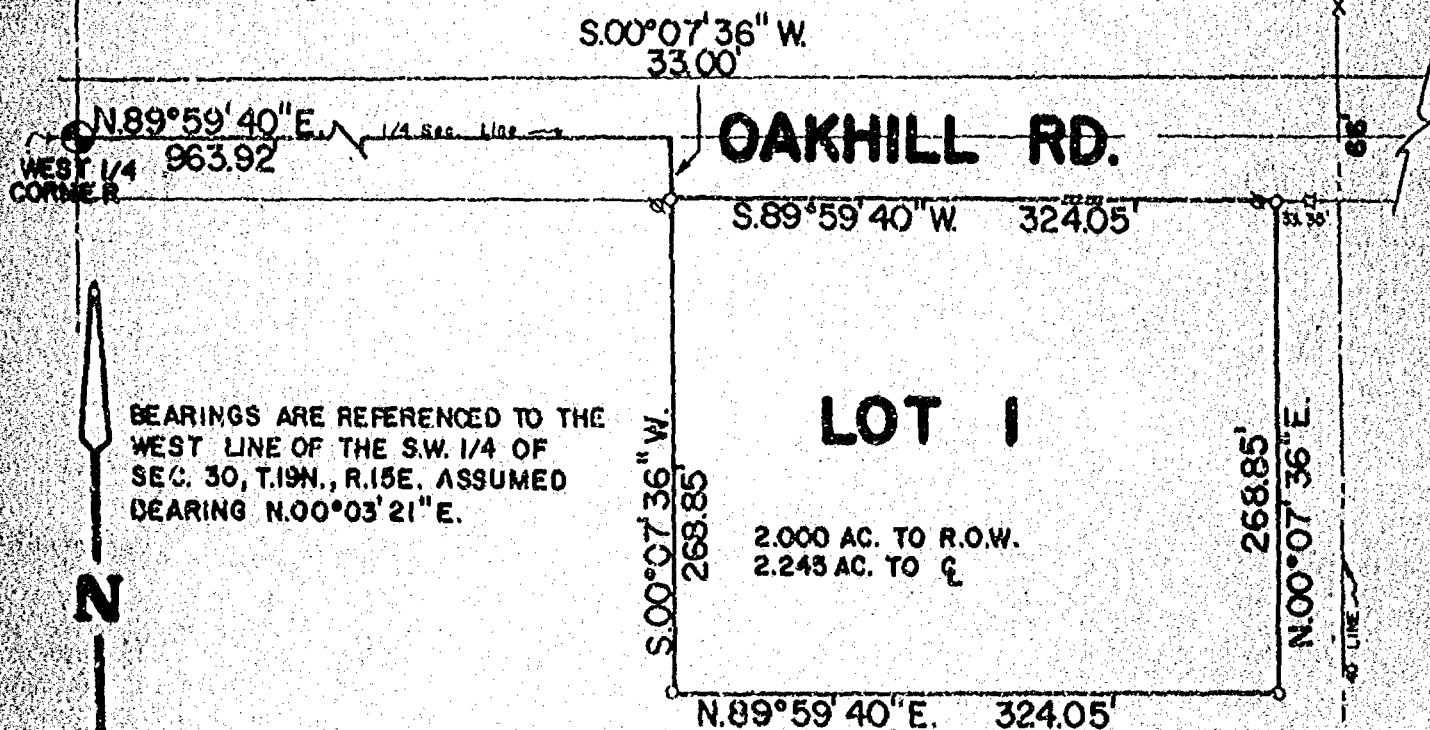

LEGEND


- 1" x 30" IRON PIPE SET WEIGHING 1.13 LBS./LIN. FT.
- ⊙ BERNTSEN MONUMENT
- ⊙ POWER POLE
- CULVERT
- X—X— FENCE
- STAND BOX

SCALE: 1" = 100'

100' 0' 100' 200'

SHEET 1 of 2 SHEETS

SAYLER SURVEY, INC. Land Surveyors WINNECONNE, WI FB. 48, PG. 34 CS-001328

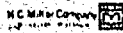

Stock No. 26273

WINNEBAGO COUNTY CERTIFIED SURVEY MAP NO. 1086
 Located in part of the Northeast $\frac{1}{4}$ of the Southwest $\frac{1}{4}$ of Section
 32, T.19N., R.15E., Town of Winneconne, Winnebago County, WI


SURVEYOR'S CERTIFICATE

I, Calvin W. Hawksworth, registered land surveyor, hereby
 certify:

That I have surveyed, divided and mapped the parcel of land
 located in part of the Northeast $\frac{1}{4}$ of the Southwest $\frac{1}{4}$ of Section
 32, T.19N., R.15E., Town of Winneconne, Winnebago County, Wiscon-
 sin, described as follows: Beginning at a point that is 963.92
 ft. N.89°59'40"E. and 33.00 ft. S.00°07'36"W. of the West $\frac{1}{4}$ corner
 of said Section 32. From that point running S.00°07'36"W.
 268.85 ft., thence N.89°59'40"E. 324.05 ft., thence N.00°07'36"E.
 268.85 ft., thence S.89°59'40"W. 324.05 ft., along the southerly
 right-of-way line of Oakhill Road to the point of beginning.
 Being a parcel of land of 2.000 acres, more or less.

That I have made such survey, land division and map by the
 direction of Mary Gruetzmacher, 7280 State Highway 21, Omro,
 Wisconsin 54963; that such map is a true and correct representation
 of the exterior boundaries of the land surveyed.

That I have fully complied with the provisions of Sec.
 236.34 of the Wisconsin Statutes and the Winnebago County
 Certified Surveyor Ordinance in surveying, dividing and mapping
 the same.

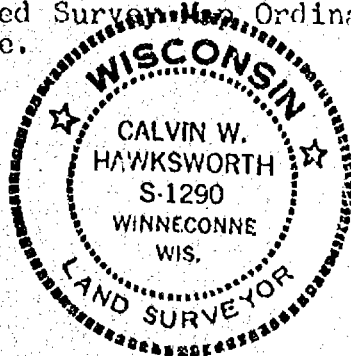

Calvin W. Hawksworth
 Calvin W. Hawksworth S-1290
 Wisconsin Registered Land Surveyor
 January 3, 1983

OWNER'S CERTIFICATE

As owner, I hereby certify that I caused the land described
 on this certified survey map to be surveyed, divided and mapped as
 represented hereon.

WITNESS the hand and seal of said owner this 4 day of
JAN., 1983.

In presence of:

Robert H. Saylor
 Witness

Clarence J. Pingry
 Clarence J. Pingry, Owner

5025 Hwy. 116
 Street Address

OMRO WI. 54963
 City State Zip

STATE OF WISCONSIN } SS
 WINNEBAGO COUNTY }

Personally came before me this 4th day of January,
 1983 the above named owner to me known to be the person who executed
 the foregoing instrument and acknowledged the same.



Bonita M. Brennan
 Notary Public WI

My commission expires 9-8-85.

SHEET 2 of 2 SHEETS

SAYLER SURVEY, INC. 330 Birch St., Box 252, Winneconne, WI 54986
 414-582-4234

584943

Register's Office
Winnebago County, Wis.
Received for record file. 12th
day of Jan A.D. 1983
at 9:00 o'clock A.M.
recorded in Vol. 1 of S.M.
in page 1086.
Myra's Adm.
Register of Deeds




Sayler Lennay

Pd
6⁰⁰

Stock No. 26273

WINNEBAGO COUNTY CERTIFIED SURVEY MAP NO.
 Located in the Southwest $\frac{1}{4}$ of Section 32, T.19N., R.15E.,
 Town of Winneconne, Winnebago County, Wisconsin

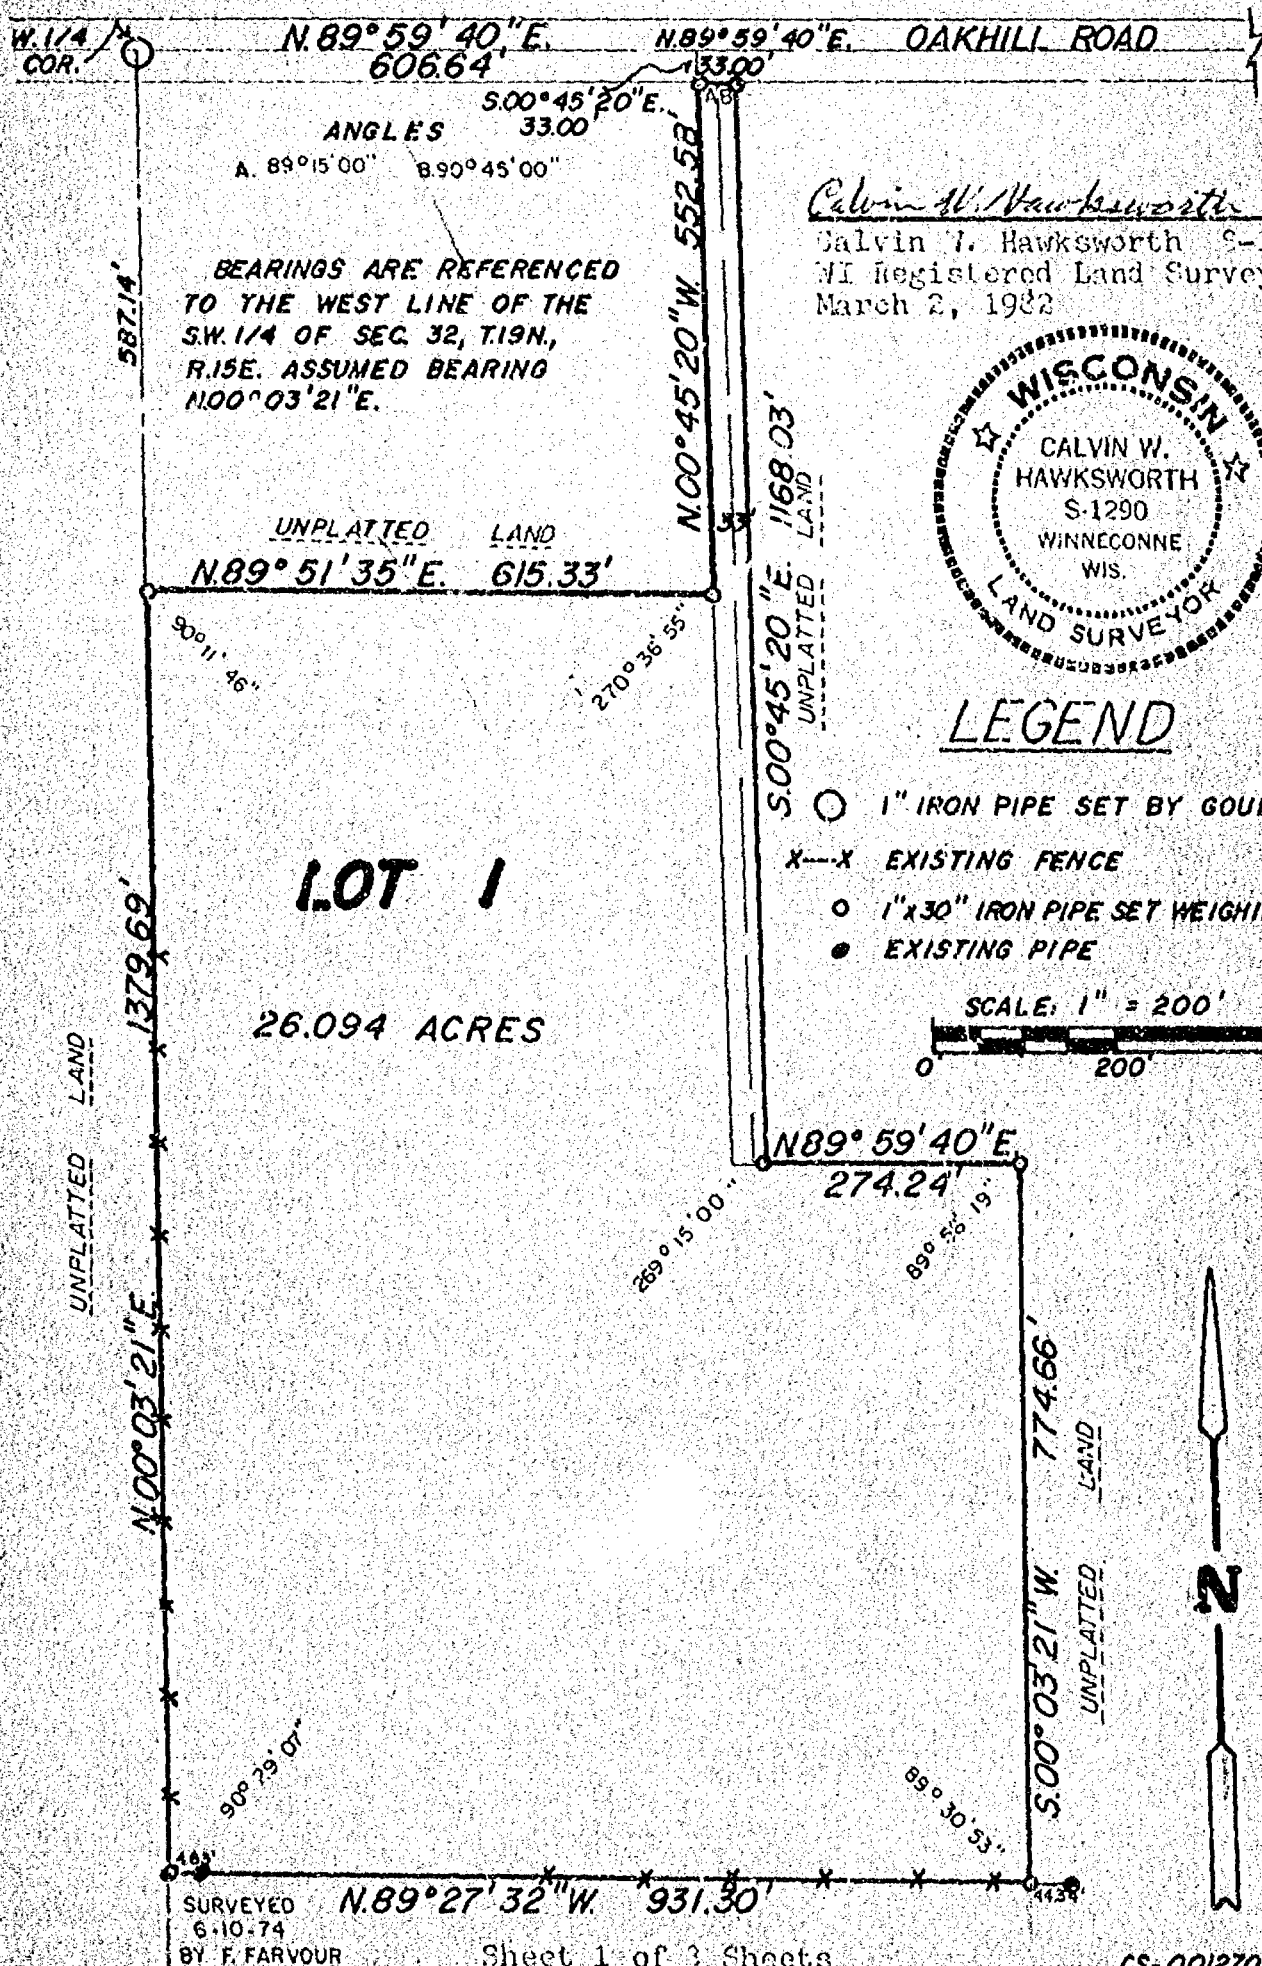

Stock No. 26273

WINNEBAGO COUNTY CERTIFIED SURVEY MAP NO.
Located in the Southwest $\frac{1}{4}$ of Section 32, T.19N., R.15E.,
Town of Winneconne, Winnebago County, Wisconsin

SURVEYOR'S CERTIFICATE

I, Calvin W. Hawksworth, registered land surveyor, hereby certify:

That I have surveyed, divided and mapped the parcel of land located in the Southwest $\frac{1}{4}$ of Section 32, T.19N., R.15E., Town of Winneconne, Winnebago County, Wisconsin, described as follows: Beginning at an iron pipe on the southerly right-of-way line of Oakhill Road that is 606.64 ft. N.89°59'40"E. and 33.00 ft. S.00°45'20"E. from the West $\frac{1}{4}$ corner of said Section 32. From that point running N.89°59'40"E. 33.00 ft. on said southerly right-of-way line of Oakhill Road to an iron pipe, thence S.00°45'20"E. 1168.03 ft. to an iron pipe, thence N.89°59'40"E. 274.24 ft. to an iron pipe, thence S.00°03'21"W. 774.66 ft. to an iron pipe, thence N.89°27'32"W. 931.30 ft. to an iron pipe, thence N.00°03'21"E. 1379.69 ft. along the west line of Section 32 to an iron pipe, thence N.89°51'35"W. 615.33 ft. to an iron pipe, thence N.00°45'20"W. 552.58 ft. to an iron pipe that is the point of beginning. Being a parcel of land of 26.094 acres, more or less.

That I have made such survey, land division and map by the direction of Walter and Pat Tucki, 430 Spruce Street, Onro, Wisconsin 54963; that such map is a true and correct representation of the exterior boundaries of the land surveyed.

That I have fully complied with the provisions of Sec. 236.34 of the Wisconsin Statutes and the Winnebago County Certified Survey Map Ordinance in surveying and mapping the same.



Calvin W. Hawksworth
Calvin W. Hawksworth
WI Registered Land Surveyor
March 2, 1982

S-1290

OWNERS CERTIFICATE

As owners, we hereby certify that we caused the land described on this Certified Survey Map to be surveyed, divided and mapped as represented hereon.

WITNESS the hand and seal of said owners this 13th day of March, 1982.

In presence of:

/s/ Patrick F. Coughlin
Witness

/s/ Clarence John Pingry
Owners

/s/ Martha Pingry
Street Address
3025 Highway 116
Onro, WI
City, State

54963
Zip

STATE OF WISCONSIN) ss
WINNEBAGO COUNTY

Personally came before me this 13th day of March, 1982 the above named Clarence John Pingry and Martha Pingry persons to me known to be the persons who executed the foregoing instrument and acknowledged the same.

/s/ Patrick F. Coughlin
Notary Public

My commission ~~expires~~ is permanent.

Stock No. 26273

WINNEBAGO COUNTY CERTIFIED SURVEY MAP NO.
Located in the Southwest $\frac{1}{4}$ of Section 32, T.19N., R.15E.,
Town of Winneconne, Winnebago County, Wisconsin

WINNEBAGO COUNTY PLANNING COMMITTEE CERTIFICATE

This Certified Survey Map of part of the Southwest $\frac{1}{4}$ of
Section 32, T.19N., R.15E., Town of Winneconne, Winnebago
County, Wisconsin, is hereby approved.


Robert M. Hartzel
Authorized Representative of
Winnebago County Planning Committee

Calvin W. Hawksworth
Calvin W. Hawksworth S-1290
WI Registered Land Surveyor
March 2, 1982



No 581 Corn 7 Survey of Highway Between Sec 32-19-15 Winneconne & Sec 5-18-15

Omro By Order of Peter Vredenburg Chm Bd Supervisors
of Winneconne J A Tuttle Chairman Bd Supervisors Omro
Highway laid out 4 rods wide

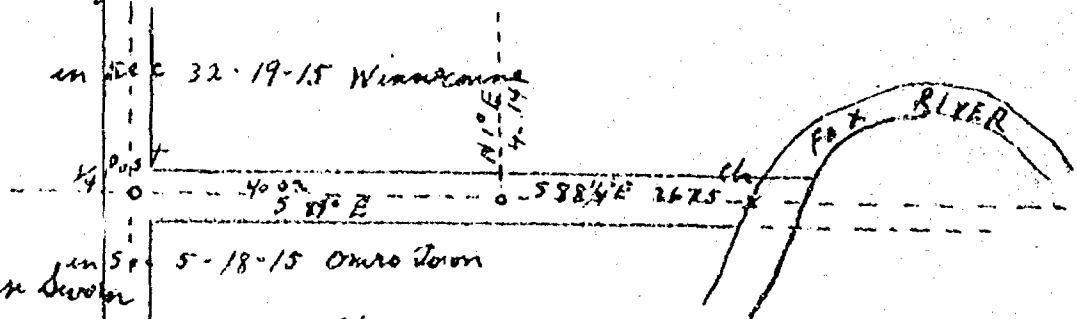

Chain Men Survey

H G Buser

S. A. Wood

J. Mills

E. Pongry sworn 2nd day

New B.T. to S 1/4 Post Sec 32-19-15 East

Elm 14 N 31° E 0.99 1/2

Willow 10 S 15° E 0.64 3/8

New B.T. to S E Cor Sec 32-19-15 E

White Oak 15 N 53 3/4 W 1.05

Buckeye 12 N 60 1/2 E 1.11 3/8

Surveyed Dec 9th 1893

H. W. Leach.

County Surveyor.


CITY OF OSHKOSH
ENGINEERING DEPARTMENT

DRAWN

SCALE

Survey of Part of Sec 32 Township No 19 Range No 15 East Town of Winneconne

161

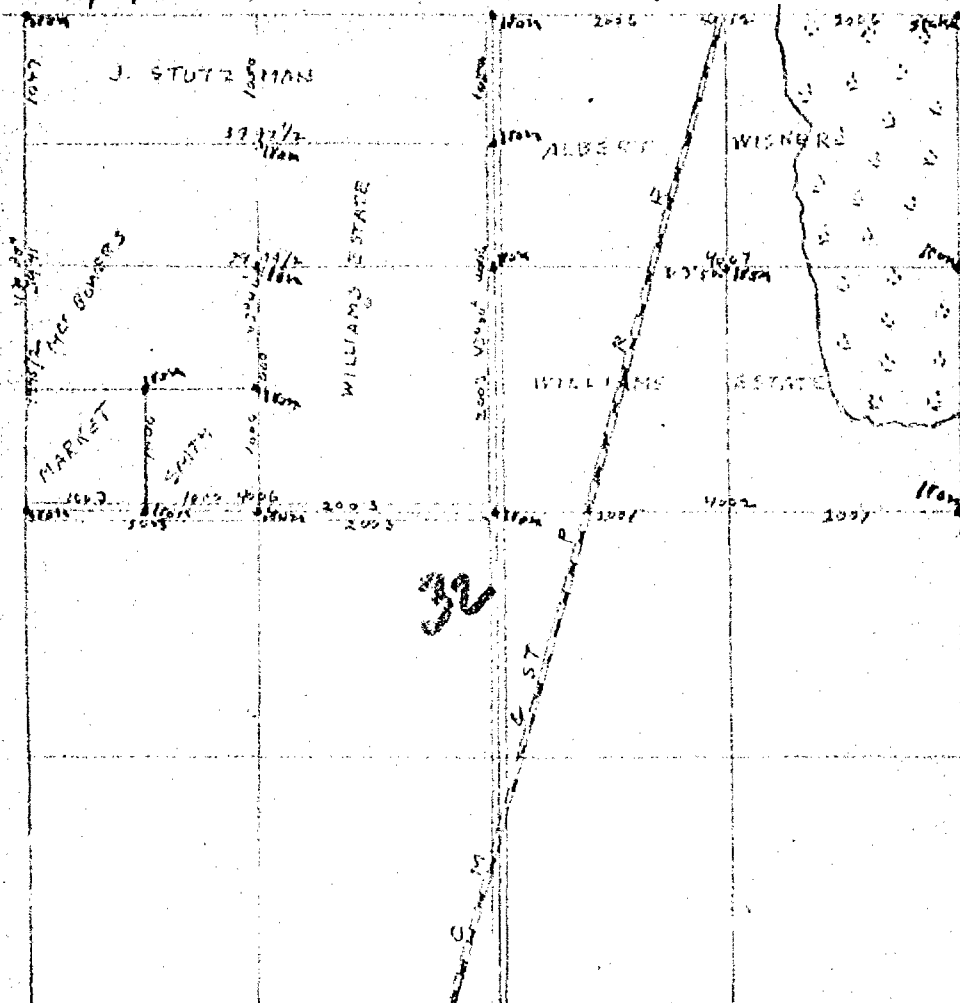

At the corner of Sec 1 found a stone and some broken Dishes set for corner 1 set in this spot a 1 1/4 inch gas pipe 5 ft long drove it down level with the ground and placed stone around it at the 1/4 S bet Sec 31 and 32 I dug in the road for 6 ft square and could find nothing to indicate a corner all Govt Bearings was obliterated so I lined up the road North and South and East and West and set the 1/4S in the center of both roads set for corner 1 1/4 inch gas pipe 4 1/2 long drove it down level with the ground could find nothing for Bearings at the 1/4 S bet Sec 29 and 32 I dug in road and down 2 1/2 ft below the surface I found a stone and some broken dishes for 1/4S I set in this spot for a permanent corner a 1 1/2 inch solid round iron set it level with the ground No Bearings I then from those points surveyed out the property shown on the above map and set iron stakes as shown marked in Red Ink Began April 21st Completed April 22d 1914

W W Gould CO Surveyor

Henry Andersen Chairman
John Vanderloh

CITY OF OSHKOSH
ENGINEERING DEPARTMENT


DRAWN

SCALE

SURVEY OF PART OF SEC 32 TOWNSHIP NO 19
RANGE NO 15 EAST TOWN OF WINNECONNE
WINNEBAGO WIS.

N^o 581 Cont Survey of Highway Between Sec 32-19-15 Winneconne, & Sec 5-18-15

Omro By Order of Peter Vredenberg Chm Bd Supervisor
of Winneconne. J. A. Little Chairman Bd Supervisors Omro
Highway laid out 14 rods wide

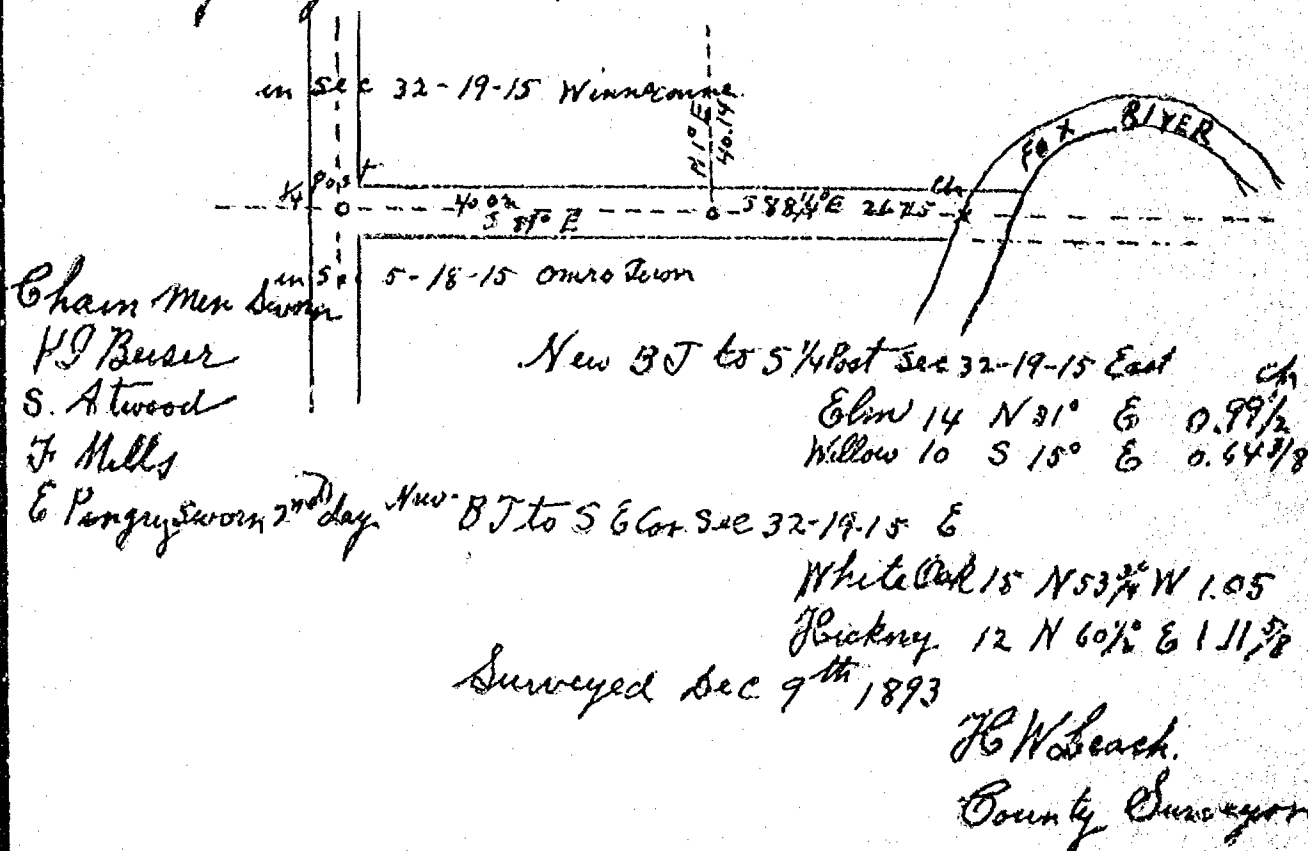

CITY OF OSHKOSH
ENGINEERING DEPARTMENT


DRAWN

SCALE

Plat of Survey

PART OF THE W 1/2 OF THE SE 1/4 OF SEC. 32, T.19N., R.15E.,
TOWN OF WINNECONNE, WINNEBAGO COUNTY, WI.

CLIENT: DAN BOYCE
6185 HWY 21
OMRO, WI 54963

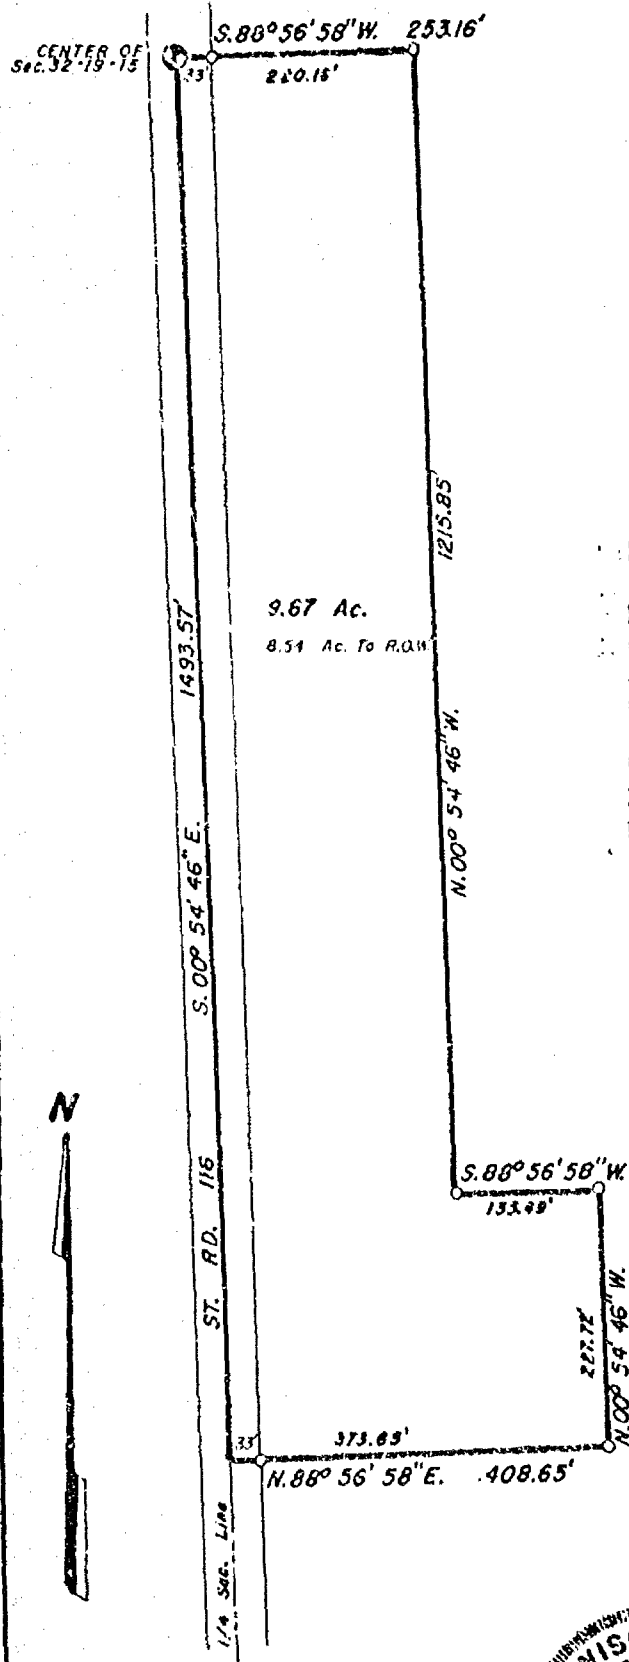

LEGAL DESCRIPTION:

All that part of the W 1/2 of the SE 1/4 of Sec. 32, T.19N., R.15E., Town of Winneconne, Winnebago County, Wisconsin, described as follows: Beginning at a Berntsen monument at the center of said Sec. 32. From that point running S.00° 54' 46" E., 1493.57 ft., thence N.88° 56' 58" E., 408.65 ft., thence N.00° 54' 46" W., 227.72 ft., thence S.88° 56' 58" W., 155.49 ft., thence N.00° 54' 46" W., 1215.85 ft., thence S.88° 56' 58" W., 253.16 ft. to the said point of beginning. Being a parcel of land of 9.67 acres. Subject to all easements and restrictions of record.

N

LEGEND

- = Existing monuments
- = 2" x 30" iron pipe set
- = 1" x 30" iron pipe set
- = reference cups or RR spikes
- ⊙ = Berntsen or Harrison monuments
- x---x = fence
- () = recorded as
- = stone monument



SURVEYORS CERTIFICATE

I, hereby certify that I have surveyed the property as shown, according to official records and that the plat above drawn is an accurate and correct representation of said survey. SEPTEMBER 29, 1992

Robert H. Sayler
Wisconsin Registered Land Surveyor S-1894

Sawyer
Survey, Inc.

1394 WEST MAIN, BOX 252, WINNECONNE, WI 54986

SCALE 1 IN. = 200 FT.
PROJECT NO. S-002583
FIELD BOOK 65 PAGE 38

Plat of Survey



PART OF THE SW 1/4, SEC. 32, T. 19N., R. 15E., TOWN OF WINNECONNE, WINNEBAGO COUNTY, WISCONSIN

CLIENT: Exerman Petrack
2 W. 5th St.
Winneconne, WI. 54986

CURVE TABLE

① - ②
Δ - 63°06'36.8"
R - 190.39'
L - 209.70'
T - 116.92'
LC - 199.26'
LCB - S. 31°25'42"E.

Sheet 1 of 2 sheets

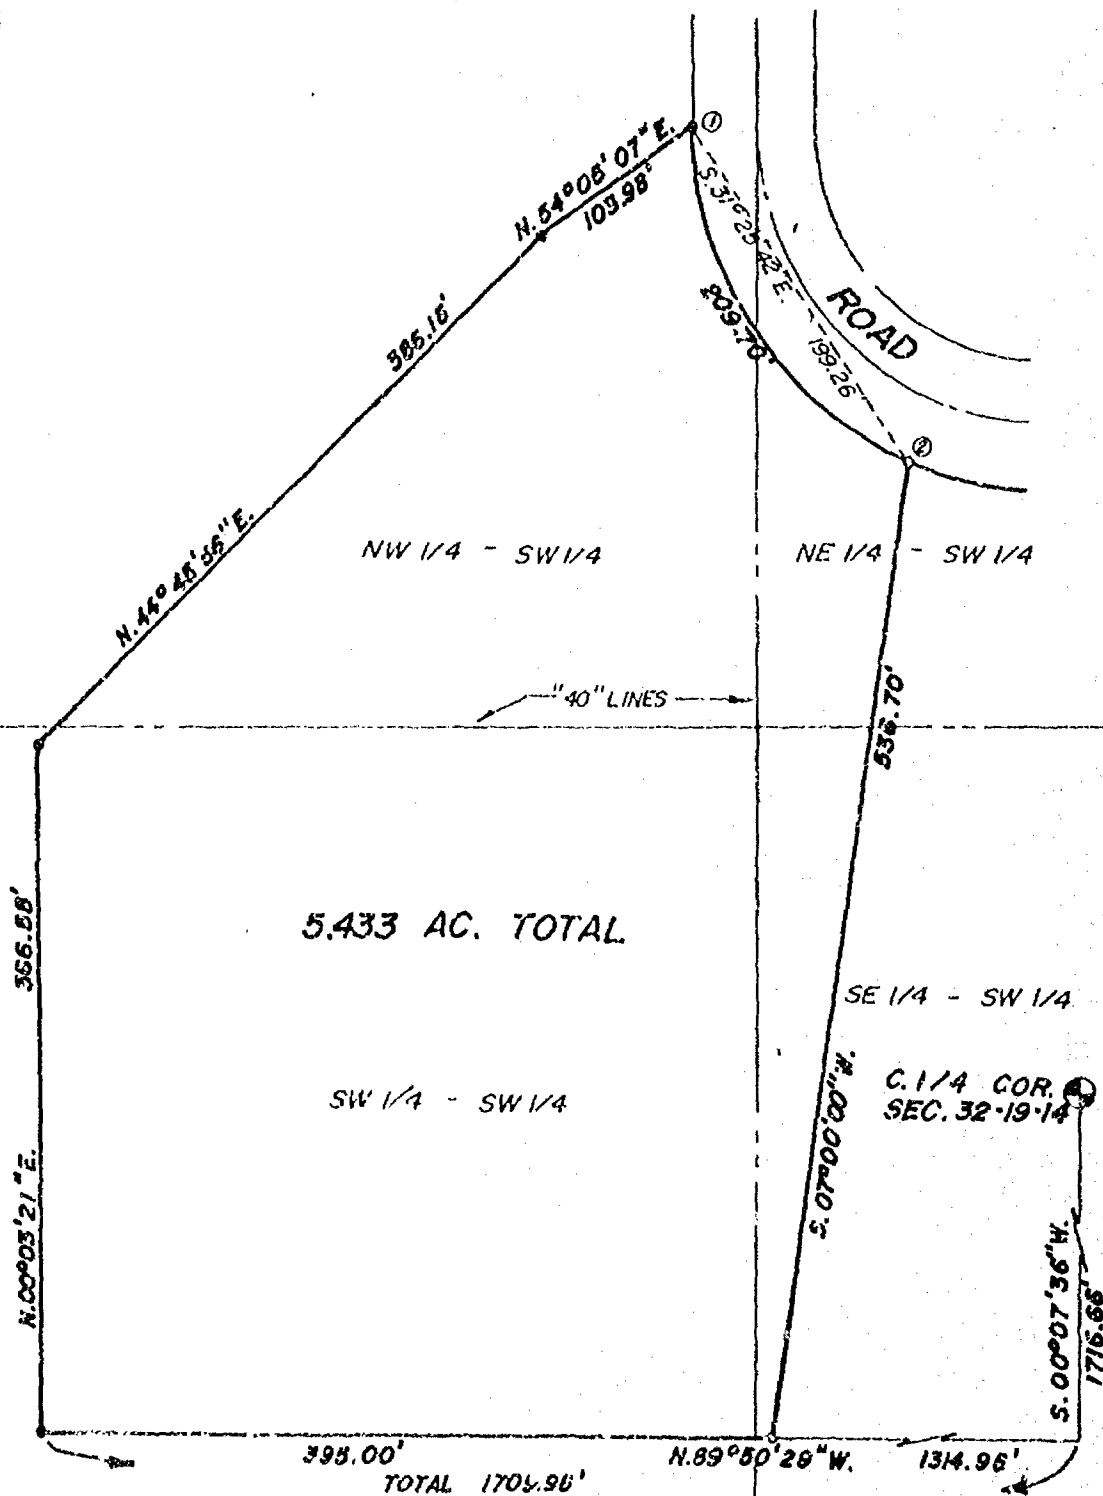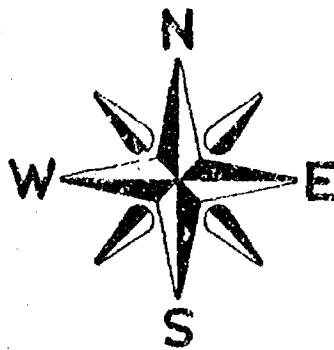

LEGEND

- = Existing monuments
- = 2" x 30" iron pipe set
- = 1" x 30" iron pipe set
- = reference caps or RR spikes
- ⊙ = Bernsten or Harrison monuments
- X-X = fence
- () = recorded as
- = stone monument



SURVEYORS CERTIFICATE

I, hereby certify that I have surveyed the property as shown, according to official records and that the plat above drawn is an accurate and correct representation of said survey. MARCH 11, 1992

Calvin W. Haselwerth
Wisconsin Registered Land Surveyor S-1890

Saylor
Survey, Inc.

139A WEST MAIN, BOX 262, WINNECONNE, WI 54986

SCALE 1 IN. = 100 FT.
PROJECT NO. S-002482
FIELD BOOK PLAT PAGE

Plat of Survey

PART OF THE SW 1/4, SEC. 32, T. 19N., R. 15E., TOWN OF WINNECONNE, WINNEBAGO COUNTY, WISCONSIN

LEGAL DESCRIPTION:

All that part of the SW 1/4 of Sec. 32, T. 19N., R. 15E., Town of Winneconne, Winnebago County, Wisconsin fully described as follows: Beginning at a point which is 1716.66 ft., S. 00° 07' 36" W., and 1314.96 ft., N. 89° 50' 29" W. from the C1/4 Corner of said Sec. 32. From that point continuing N. 89° 50' 29" W., 395.00 ft., thence N. 00° 03' 21" E., 366.58 ft., thence N. 44° 45' 56" E., 386.16 ft., thence N. 54° 05' 07" E., 103.98 ft. to the beginning of a curve, thence 209.70 ft., along the arc of said curve which bears S. 31° 25' 42" E., 199.26 ft., thence S. 07° 00' 00" W., 536.70 ft. to the said point of beginning. Being a parcel of land of 5.433 acres, more or less. Subject to all easement and restrictions of record.

CLIENT: Emeran Petrack
2 N. 5th ST.
Winneconne, WI. 54986

Sheet 2 of 2 sheets



LEGEND

- = Existing monuments
- = 2" x 30" iron pipe set
- ◊ = 1" x 30" iron pipe set
- ⊙ = reference caps or RR spikes
- ⊗ = Bernsten or Harrison monuments
- x—x = fence
- () = recorded as
- = stone monument

SURVEYORS CERTIFICATE

I, hereby certify that I have surveyed the property as shown, according to official records and that the plat above drawn is an accurate and correct representation of said survey. MARCH 11, 1992

Calvin W. Hawksworth
Wisconsin Registered Land Surveyor S-1290

Sayler
Survey, Inc.

139A WEST MAIN, BOX 252, WINNECONNE, WI 54986

SCALE _____
PROJECT NO. S-002482
FIELD BOOK PLAT PAGE —

County

FORM NO. 585-A




Stock No. 26273

WINNEBAGO COUNTY CERTIFIED SURVEY MAP NO.
Part of the N1/2 of the SW1/4 of Sec. 32, T.19N., R.15E., Town of Winneconne, Winnebago Co., Wi.

Bearings are referenced to the North line of the SW1/4 of Sec. 32, assumed bearing, N.89°59'40"E.

- Existing iron pipe found
- 1"x39" iron pipe weighing 1.13 lbs./lineal ft.

Tax Parcel No. 030-0508

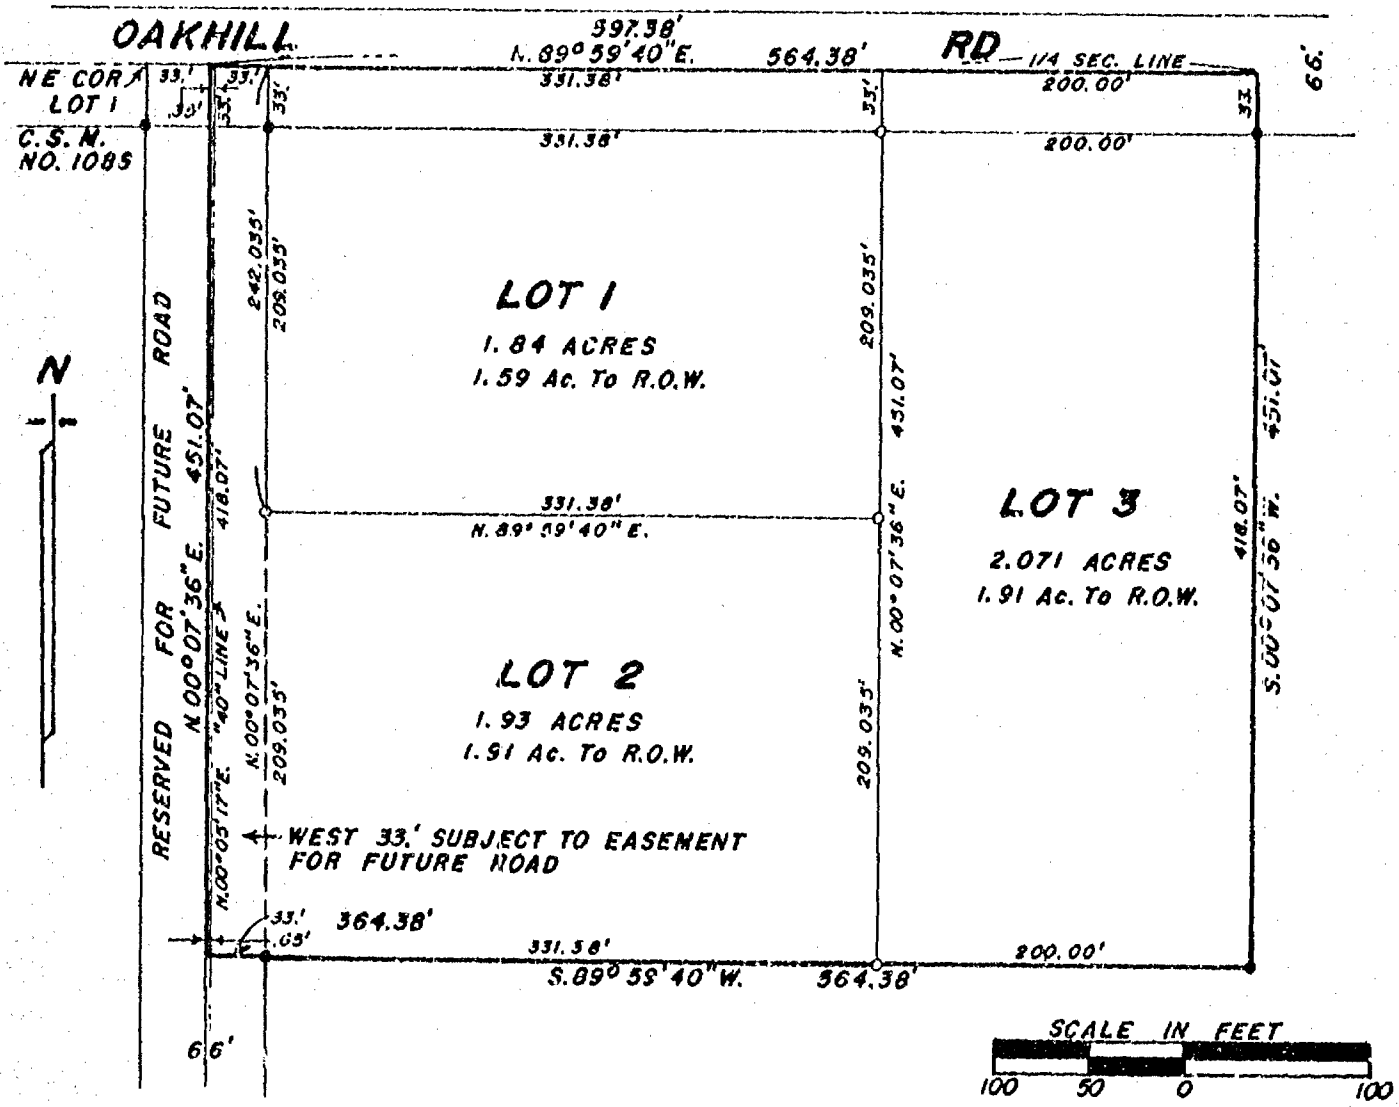

SURVEYOR'S CERTIFICATION:

I, Robert H. Saylor, registered land surveyor, hereby certify:
That I have surveyed, divided and mapped the parcel of land located in part of the N1/2 of the SW1/4 of Sec. 32, T.19N., R.15E. in the Town of Winneconne, Winnebago County, Wisconsin, described as follows: Beginning at a point on the North line of the SW1/4 of said Sec. 32 that is 33.00 ft., N.89°59'40"E. of the the Northeast corner of Lot 1 of Certified Survey Map No. 1086, Doc. No. 584943, Winnebago County Records. From that point continuing N.89°59'40"E. 564.38 ft., thence S.00°07'36"W., 451.07 ft., thence S.89°59'40"W., 564.38 ft., thence N.00°07'36"E., 451.07 ft. to the said point of beginning. Reserving therefrom that portion within the right of way of Oakhill Road presently used for road purposes. The West 33.00 ft. of Lot 2 is subject to and includes an easement for a future road. Subject to all easements and restrictions of record.

That I have made such survey, land division and map by the direction of Emeran Petrack, 2 N. 5th St., Winneconne, WI; 54986; that such map is a true and correct representation of the exterior boundaries of the land surveyed.

That I have fully complied with the provisions of Sec. 236.34 of the Wisconsin Statutes and the Winnebago County Subdivision Ordinance in surveying, dividing and mapping the same.

Robert H. Saylor
Robert H. Saylor S-1894
Wisconsin Registered Land Surveyor
April 7, 1992



Sheet 1 of 2 sheets

SAYLER SURVEY, INC. LAND SURVEYORS WINNECONNE, WI. F.B. 65 P.20

Stock No. 26273

WINNEBAGO COUNTY CERTIFIED SURVEY MAP NO.

Part of the N $\frac{1}{2}$ of the SW $\frac{1}{4}$ of Sec. 32, T.19N., R.15E., Town of Winneconne, Winnebago Co., WI.


OWNER'S CERTIFICATE:

As owners, we hereby certify that we caused the land described on this certified survey map to be surveyed, divided and mapped as represented hereon.

Emeran PetrackEmeran Petrack
2 N. 5th St. Winneconne, WI. 54986Shirley M. PetrackShirley M. Petrack
2 N. 5th St. Winneconne, WI. 54986

STATE OF WISCONSIN)

WINNEBAGO COUNTY) SS

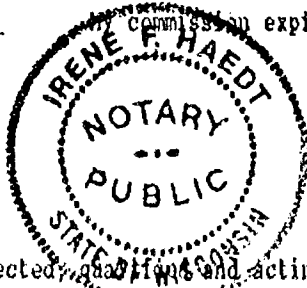Personally came before me this 8th day of April, 1992, the above named persons to me known to be the persons who executed the foregoing instrument and acknowledged the same.Irene J. HaedtNotary Public, Omro, WI.My commission expires 10-11-1992

TOWN TREASURER'S CERTIFICATE:

STATE OF WISCONSIN)

WINNEBAGO COUNTY) SS

I, Beverly Rosenow, being the duly elected, qualified and acting treasurer of the Town of Winneconne, do hereby certify that in accordance with the records in my office, there are no unpaid taxes or unpaid special assessments as of _____, 1992, on any of the land included in this certified survey map.

Date

Town Treasurer

COUNTY TREASURER'S CERTIFICATE:

STATE OF WISCONSIN)

WINNEBAGO COUNTY) SS

I, _____, being the duly elected, qualified and acting treasurer of the County of Winnebago, do hereby certify that the records in my office show no unredeemed tax sales and no unpaid taxes or special assessments as of _____, 1992 affecting the lands included in this certified survey map.

Date

County Treasurer

WINNEBAGO COUNTY PLANNING COMMITTEE CERTIFICATE:

This certified survey map of part of the N $\frac{1}{2}$ of the SW $\frac{1}{4}$ of Sec. 32, T.19N., R.15E., Town of Winneconne, is hereby approved.

Date

Authorized signature

Robert H. SaylorRobert H. Saylor
S-1894
Wisconsin Registered Land Surveyor
April 7, 1992

Sheet 2 of 2 sheets



SAYLER SURVEY, INC. WINNECONNE, WI.



Stock No. 26273


WINNEBAGO COUNTY CERTIFIED SURVEY MAP NO. 2513

Part of the N1/2 of the SW1/4 of Sec. 32, T.19N., R.15E., Town of Winneconne, Winnebago Co., WI.

Bearings are referenced to the North line of the SW1/4 of Sec. 32, assumed bearing, N.89°59'40"E.

- Existing iron pipe found
- 1"x30" iron pipe weighing 1.13 lbs./lineal ft.

Tax Parcel No. 030-0508

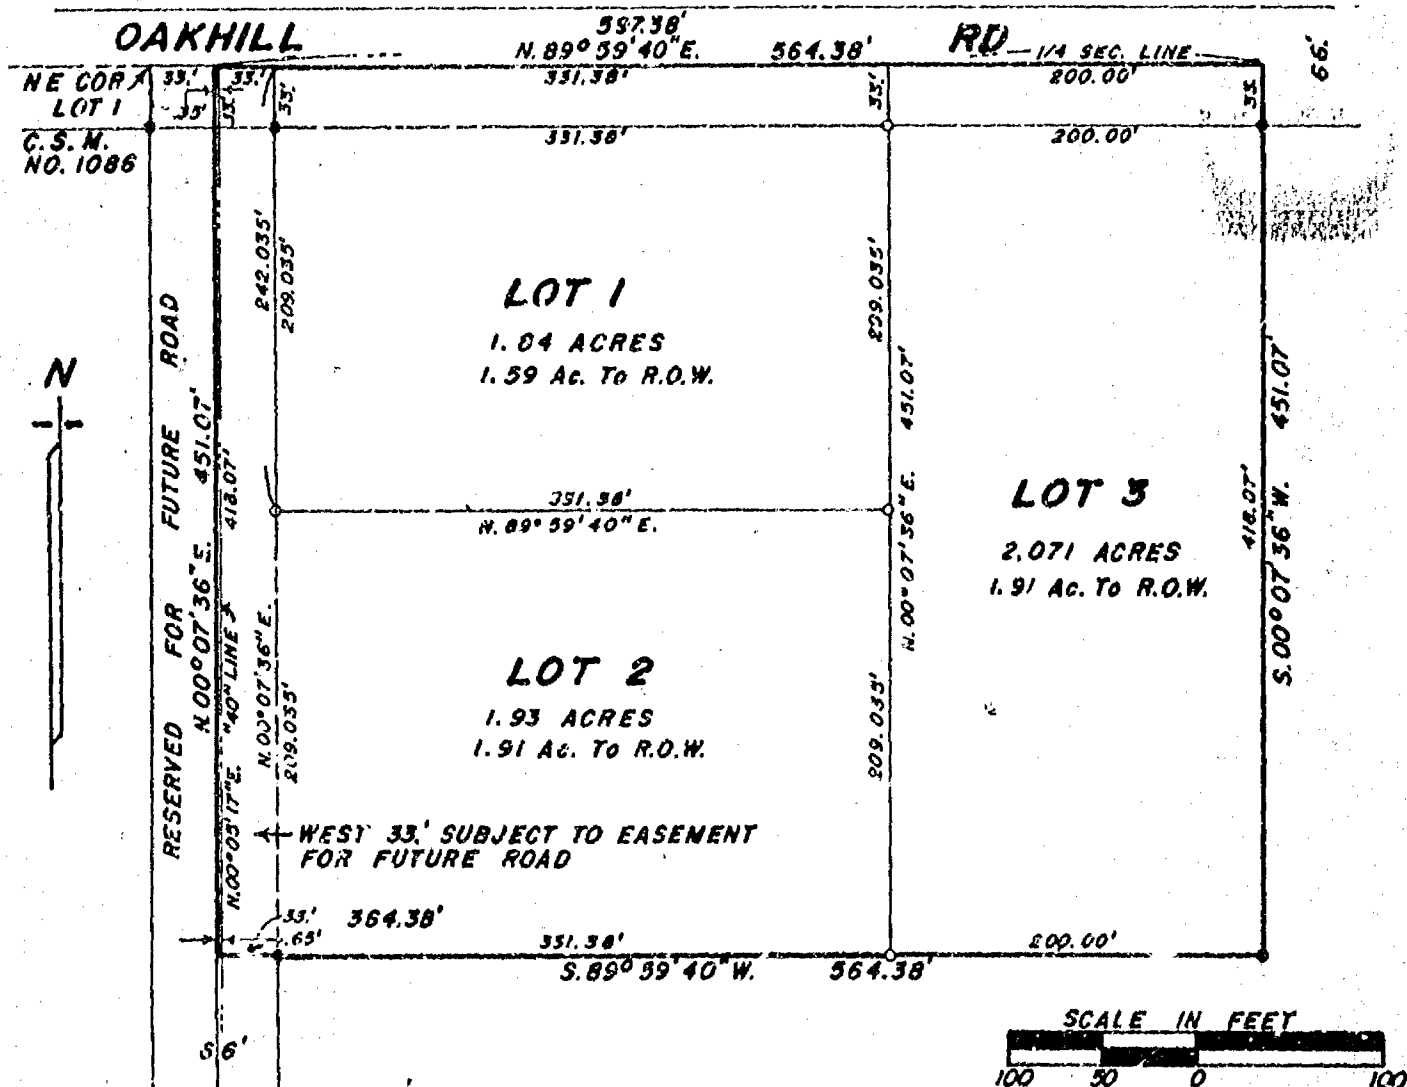**SURVEYOR'S CERTIFICATE:**

I, Robert H. Saylor, registered land surveyor, hereby certify:

That I have surveyed, divided and mapped the parcel of land located in part of the N1/2 of the SW1/4 of Sec. 32, T.19N., R.15E. in the Town of Winneconne, Winnebago County, Wisconsin, described as follows: Beginning at a point on the North line of the SW1/4 of said Sec. 32 that is 33.00 ft., N.89°59'40"E. of the the Northeast corner of Lot 1 of Certified Survey Map No. 1086, Doc. No. 584943, Winnebago County Records. From that point continuing N.89°59'40"E. 564.38 ft., thence S.00°07'36"W., 451.07 ft., thence S.89°59'40"W., 564.38 ft., thence N.00°07'36"E., 451.07 ft. to the said point of beginning. Reserving therefrom that portion within the right of way of Oakhill Road presently used for road purposes. The West 33.00 ft. of Lot 2 is subject to and includes an easement for a future road. Subject to all easements and restrictions of record.

That I have made such survey, land division and map by the direction of Emeran Petrack, 2 N. 5th St., Winneconne, WI; 54986; that such map is a true and correct representation of the exterior boundaries of the land surveyed.

That I have fully complied with the provisions of Sec. 236.34 of the Wisconsin Statutes and the Winnebago County Subdivision Ordinance in surveying, dividing and mapping the same.

Robert H. Saylor
Robert H. Saylor S-1894
Wisconsin Registered Land Surveyor
April 7, 1992



Sheet 1 of 2 sheets

SAYLER SURVEY, INC. LAND SURVEYORS WINNECONNE, WI. F& 65 P20



Stock No. 26273

WINNEBAGO COUNTY CERTIFIED SURVEY MAP NO. 2513
 Part of the N $\frac{1}{2}$ of the SW $\frac{1}{4}$ of Sec. 32, T.19N., R.15E., Town of Winneconne, Winnebago Co., WI.

OWNER'S CERTIFICATE:

As owner, we hereby certify that we caused the land described on this certified survey map to be surveyed, divided and mapped as represented hereon.

Emeran Petrack
 Emeran Petrack
 2 N. 5th St. Winneconne, WI. 54986


Shirley Petrack
 Shirley M. Petrack
 2 N. 5th St. Winneconne, WI. 54986

STATE OF WISCONSIN)
 WINNEBAGO COUNTY) SS

Personally came before me this 8th day of April, 1992, the above named persons to me known to be the persons who executed the foregoing instrument and acknowledged the same.

Irene J. Haedt
 Notary Public, Omro, WI.

Commission expires 10-11-1992

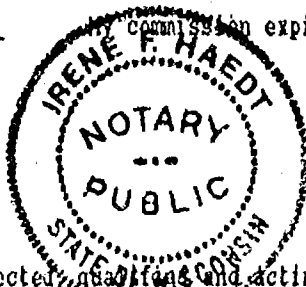**TOWN TREASURER'S CERTIFICATE:**

STATE OF WISCONSIN)
 WINNEBAGO COUNTY) SS

I, Beverly Rosenow, being the duly elected, qualified and acting treasurer of the Town of Winneconne, do hereby certify that in accordance with the records in my office, there are no unpaid taxes or unpaid special assessments as of January 1, 1992, on any of the land included in this certified survey map.

4-9-92
 Date

Beverly Rosenow
 Town Treasurer

COUNTY TREASURER'S CERTIFICATE:

STATE OF WISCONSIN)
 WINNEBAGO COUNTY) SS

I, Marcella McQuay-Renton, being the duly elected, qualified and acting ^{Deputy} treasurer of the County of Winnebago, do hereby certify that the records in my office show no unredeemed tax sales and no unpaid taxes or special assessments as of 4/13/92, 1992 affecting the lands included in this certified survey map.

4/13/92
 Date

Marcella McQuay-Renton
 County Treasurer (Deputy)

WINNEBAGO COUNTY PLANNING COMMITTEE CERTIFICATE:

This certified survey map of part of the N $\frac{1}{2}$ of the SW $\frac{1}{4}$ of Sec. 32, T.19N., R.15E., Town of Winneconne, is hereby approved.

May 1, 1992
 Date

Jeanette Diskoff
 Authorized signature

Robert H. Saylor
 Robert H. Saylor
 S-1894
 Wisconsin Registered Land Surveyor
 April 7, 1992

796436


Register's Office

Winnebago County, Wis.

Received for record this 5thday of May A.D., 1992at 8:12 o'clock PM andfiled in Vol. 1 of CSMon page 2513

Margie K. Kahan
 Register of Deeds

Sheet 2 of 2 sheets

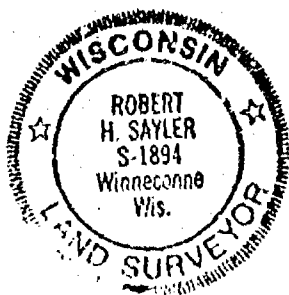


✓ SAYLER SURVEY, INC. WINNECONNE, WI.

Chg
 12th

Plat of Survey

PART OF THE W 1/2 OF THE SE 1/4 OF SEC. 32, T.19N., R.15E.,
TOWN OF WINNECONNE, WINNEBAGO COUNTY, WI.

CLIENT: DAN YOST
6424 YOST RD.
OMRO, WI 54963

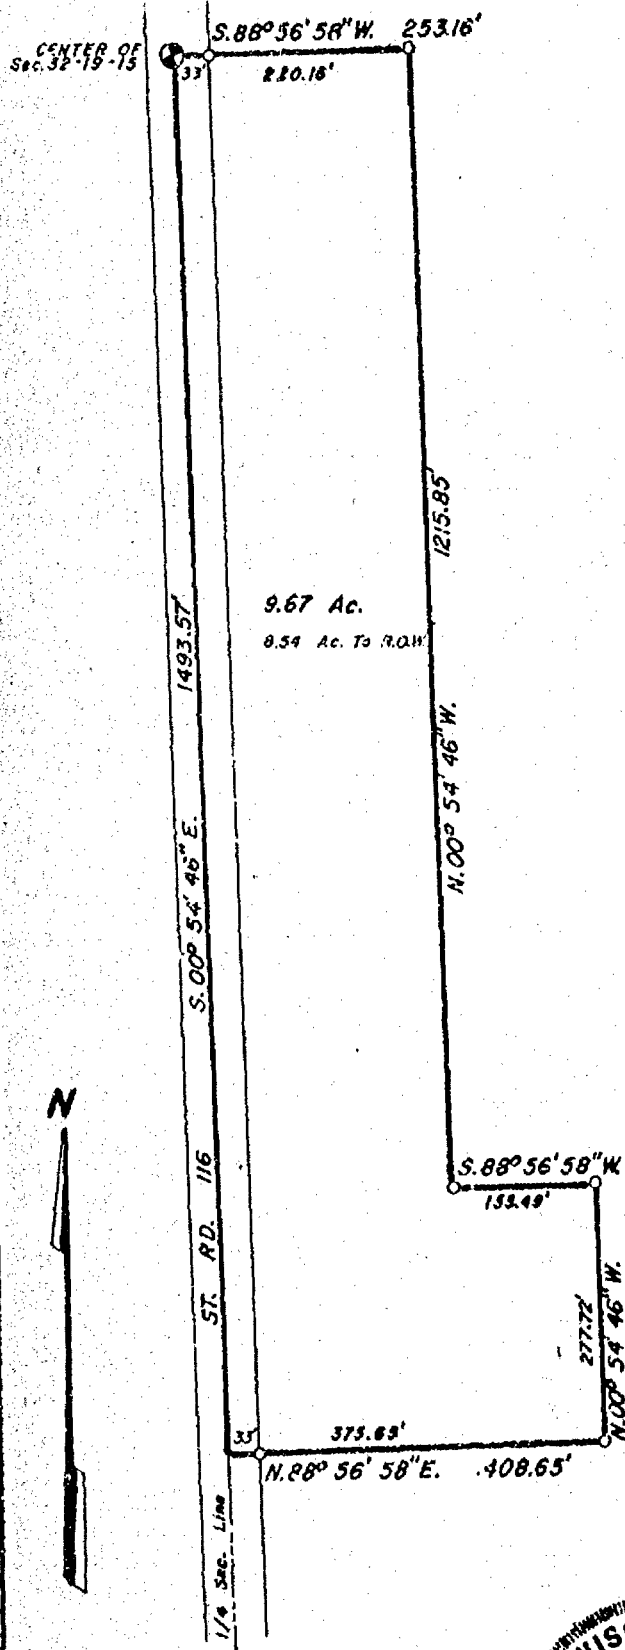


LEGAL DESCRIPTION:

All that part of the W 1/2 of the SE 1/4 of Sec. 32, T.19N., R.15E., Town of Winneconne, Winnebago County, Wisconsin, described as follows: Beginning at a Berntsen monument at the center of said Sec. 32. From that point running S. 00° 54' 46\"E. 1493.57 ft., thence N. 88° 56' 58\"E. 408.65 ft., thence N. 00° 54' 46\"W. 277.72 ft., thence S. 88° 56' 58\"W. 155.49 ft., thence N. 00° 54' 46\"W. 1215.85 ft., thence S. 88° 56' 58\"W. 253.16 ft., to the said point of beginning. Being a parcel of land of 9.67 acres. Reserving therefrom that portion with State Road 116 presently used for road purposes. Subject to all easements and restrictions of record.

Description Corrected April 6, 1993

LEGEND

- = Existing monuments
- = 2" x 30" iron pipe set
- = 1" x 30" iron pipe set
- = reference caps or RR spikes
- ⊙ = Bernisen or Harrison monuments
- x-x = fence
- () = recorded as
- = stone monument

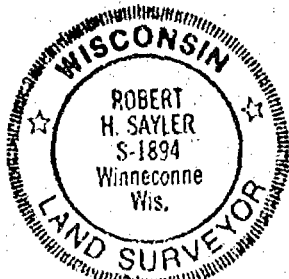

SURVEYORS CERTIFICATE

I, hereby certify that I have surveyed the property as shown, according to official records and that the plat above drawn is an accurate and correct representation of said survey. SEPTEMBER 29, 1992

Robert H. Saylor

Wisconsin Registered Land Surveyor S-1894
Revised April 6, 1993

Saylor
Survey, Inc.

139A WEST MAIN, BOX 252, WINNECONNE, WI 54986

SCALE 1 IN. = 200 FT.
PROJECT NO. S-182583
FIELD BOOK 65 PAGE 38

171




Stock No. 26273

WINNEBAGO COUNTY CERTIFIED SURVEY MAP NO. 2793

Part of the W1/2 of the SE1/4 of Sec. 32, T.19N., R.15E., Town of Winneconne, Winnebago Co., WI.

Bearings are referenced to the West line of the SE1/4 of Sec. 32, assumed bearing, S.00°54'46"E.

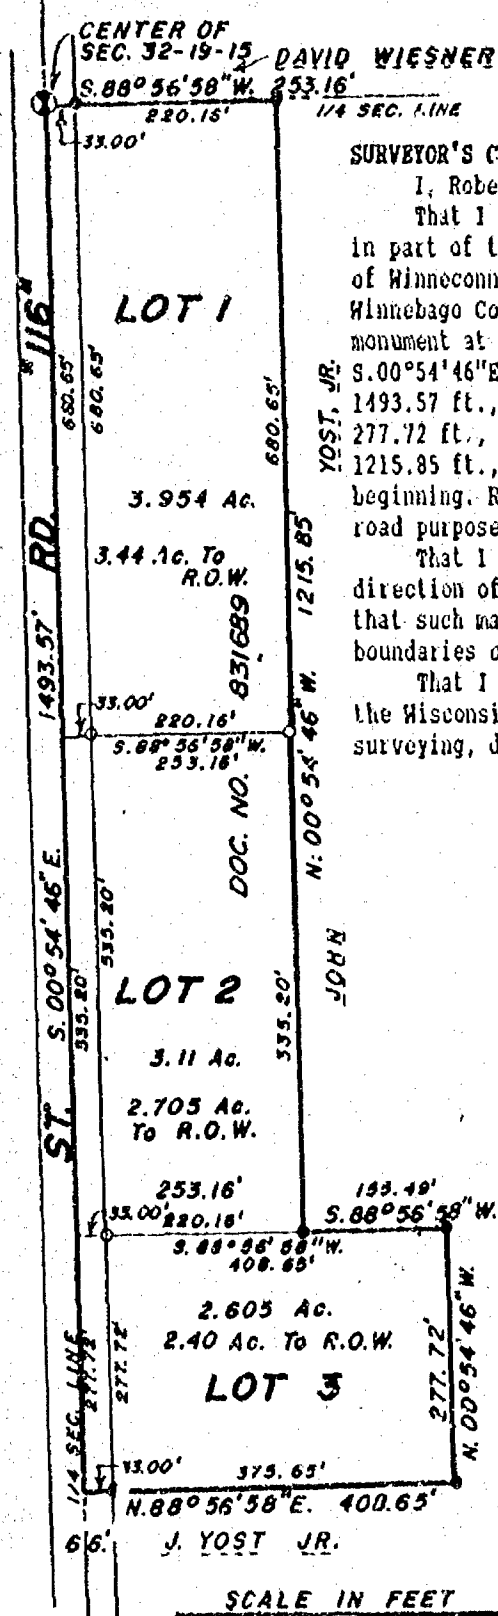Tax Parcel No. 030-0517
0519Note: Doc. No. 831689 is a correction
to Doc. No. 813589

SURVEYOR'S CERTIFICATE:

I, Robert H. Sayler, registered land surveyor, hereby certify:
That I have surveyed, divided and mapped the parcel of land located in part of the W 1/2 of the SE1/4 of Sec. 32, T.19N., R.15E. in the Town of Winneconne, Winnebago County, Wisconsin, being Document No. 813589 of Winnebago Co. Records and described as follows: Beginning at a Berntsen monument at the center of said Sec. 32. From that point running S.00°54'46"E. along the westerly line of the SE1/4 of said Sec. 32, 1493.57 ft., thence N.08°56'58"E., 408.65 ft., thence N.00°54'46"W., 277.72 ft., thence S.88°56'58"W., 155.49 ft., thence N.00°54'46"W., 1215.85 ft., thence S.88°56'58"W., 253.16 ft. to the said point of beginning. Reserving therefrom the Westerly 33.00 ft. presently used for road purposes. Subject to all easements and restrictions of record.

That I have made such survey, land division and map by the direction of Danny C. Boyce, 1789 N. Oakwood Rd., Oshkosh, WI; 54904; that such map is a true and correct representation of the exterior boundaries of the land surveyed.

That I have fully complied with the provisions of Sec. 236.34 of the Wisconsin Statutes and the Winnebago County Subdivision Ordinance in surveying, dividing and mapping the same.

Robert H. Sayler
Robert H. Sayler S-1894
Wisconsin Registered Land Surveyor

April 28, 1993
REVISED SEPTEMBER 3, 1993

- Existing irons found
- 1"x30" iron pipe weighing 1.13 lbs./lineal ft.
- ⊙ Berntsen monument



SETBACKS:

Front Yard: 75 ft.
Rear Yard: 50 ft.
Side Yard: Min. 10 ft.

Sheet 1 of 2 sheets

WINNEBAGO COUNTY PLANNING COMMITTEE CERTIFICATE

This Certified Survey Map of part of the W1/2 of the SE1/4 of Sec. 32, T.19N., R.15E., Town of Winneconne is hereby approved.

September 27, 1993
Date

Granville Dinkoff
Authorized signature



Stock No. 26273

WINNEBAGO COUNTY CERTIFIED SURVEY MAP NO. 2793

Part of the W1/2 of the SE1/4 of Sec. 32, T.19N., R.15E., Town of Winneconne, Winnebago Co., Wi.

OWNER'S CERTIFICATE:

As owner, I hereby certify that I have caused the land described on this certified survey map to be surveyed, divided and mapped as represented hereon.

Danny C. Boyce
1789 N. Oakwood Rd. Oshkosh, WI. 54904

STATE OF WISCONSIN)
WINNEBAGO COUNTY) SS

Personally came before me this 30th day of April, 1993, the above named person to me known to be the person who executed the foregoing instrument and acknowledged the same.

Irene F. Haedt
Notary Public, Oshkosh Wi.

My commission expires 10-6-96

CERTIFICATE OF TOWN TREASURER:

STATE OF WISCONSIN)
WINNEBAGO COUNTY) SS

I, Joy Meinen, being the duly elected, qualified and acting treasurer of the Town of Winneconne, do hereby certify that in accordance with the records in my office, there are no unpaid taxes or unpaid special assessments as of September 7, 1993 on any of the land included in this certified survey map.

September 7, 1993
Date

Joy Meinen
Town Treasurer

COUNTY TREASURER'S CERTIFICATE


STATE OF WISCONSIN)
WINNEBAGO COUNTY) SS

I, Ruth H. Bradley, being the duly elected, qualified and acting treasurer of the County of Winnebago, do hereby certify that the records in my office show no unredeemed tax sales and no unpaid taxes or special assessments as of September 21, 1993 affecting the lands included in this Certified Survey Map.

9/21/93
Date

Ruth H. Bradley
County Treasurer

Robert H. Saylor
Robert H. Saylor S-1894
Wisconsin Registered Land Surveyor
April 28, 1993

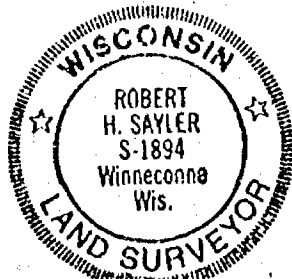

Sheet 2 of 2 sheets

850816

Register's Office

Winnebago County, Wis.

Received for record this 29thday of Sept A.D., 19 93at 8:04 o'clock AM, andfiled in Vol. 1 of CSMon page 2793

Marjorie Adams
Registrar of Deeds

SAYLER SURVEY, INC. WINNECONNE, WI.

Chg.
1202

Part of the NW1/4 of the SW1/4 of Sec. 32, T.19N., R.15E., Town of Winneconne, Winnebago County, Wisconsin
 Tax NO. 030-0150-02
 0610


Surveyor's Certificate:

I, Calvin W. Hawksworth, Wisconsin Registered Land Surveyor, hereby certify:
 That I have surveyed, divided and mapped the parcel of land located in part of the NW1/4 of the SW1/4 of Sec. 32, T.19N., R.15E., Town of Winneconne, Winnebago County, Wisconsin, described as follows: Beginning at a Berntsen Monument at the West 1/4 corner of said Sec. 32. From that point running N. 89° 59' 40" E., 607.13 ft. thence S. 89° 51' 09" W. (recorded as S. 89° 51' 35" W.), 615.15 ft. (recorded as 615.33 ft.), thence W. 00° 04' 34" E. (recorded as W. 00° 03' 21" E.), 587.00 ft. to the said point of beginning. Being a parcel of land of 8.221 acres. Reserving therefrom that portion lying within the right of way of Oak Hill Road presently used for road purposes. Subject to all easements and restrictions of record.

That I have made such survey, land division and map by the direction of Gregg Peterson, 1616 Schaeffer Circle, Apt. 2, Appleton, Wisconsin, 54915; that such map is a true and correct representation of the exterior boundaries of the land surveyed.

That I have fully complied with the provisions of Sec. 236.34 of the Wisconsin Statutes and Winnebago County Subdivision Ordinance in surveying, dividing and mapping the same.

Bearings are referenced to the North line of the SW1/4 of Sec. 32.
 Assumed Bearing: N. 89° 59' 40" E.

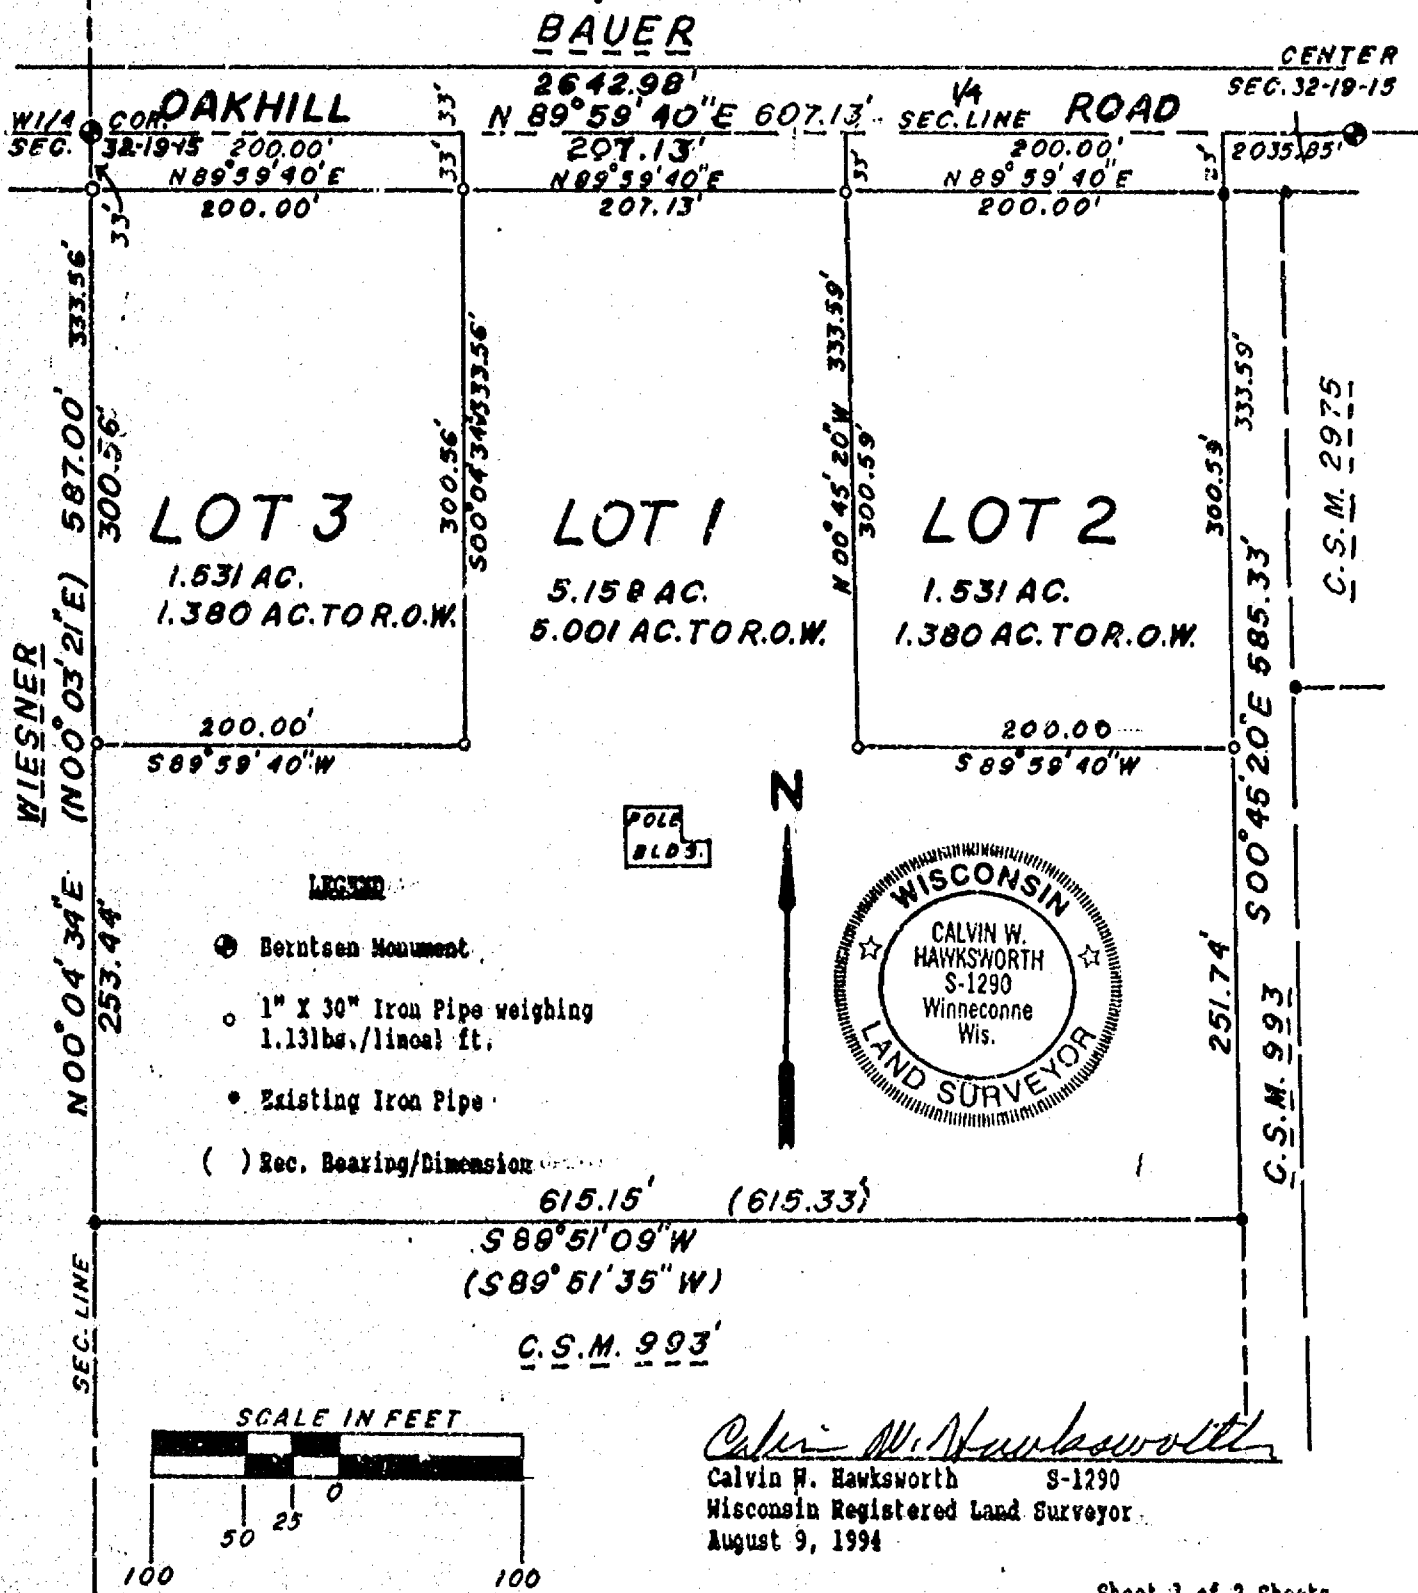

WINNEBAGO COUNTY CERTIFIED SURVEY MAP NO. 3034

Part of the NW1/4 of the SW1/4 of Sec. 32, T.19N., R.15E., Town of Winneconne, Winnebago County, Wisconsin.
TAX NO. 030-0150-02
510-

WINNEBAGO COUNTY PLANNING COMMITTEE:

This Certified Survey Map of part of the NW1/4 of the SW1/4 of Sec. 32, T.19N., R.15E., Town of Winneconne, Winnebago County, Wisconsin is hereby approved.

Date

Authorized Signature

CERTIFICATE OF COUNTY TREASURER:

STATE OF WISCONSIN)

WINNEBAGO COUNTY) SS

I, Mary E. Krueger-Deputy being the duly elected, qualified and acting Treasurer of the County of Winnebago, do hereby certify that the records in my office show no unredeemed tax sales and no unpaid taxes or special assessments as of October 12, 1994 affecting the lands included in this Certified Survey Map.

Date

Authorized Signature

TOWN TREASURER'S CERTIFICATE:

STATE OF WISCONSIN)

WINNEBAGO COUNTY) SS

I, Joy Meinen, being the duly elected, qualified and acting Treasurer of the Town of Winneconne, do hereby certify that in accordance with the records in my office, there are no unpaid taxes or unpaid special assessments as of Oct. 12, 1994 on any of the land included in this Certified Survey Map.

Date

Town Treasurer

OWNER'S CERTIFICATE:

As owner(s), I(we) hereby certify that I(we) caused the land described on this Certified Survey Map to be surveyed, divided and mapped as represented hereon.

Gregg Peterson

1616 Schaeffer Circle Apt. 2
Appleton, Wisconsin 54915

Patricia Peterson

2342 W County Q
Berlin WI 54923

STATE OF WISCONSIN)

WINNEBAGO COUNTY) SS

Personally came before me this 18th day of August, 1994, the above named person(s) to me known to be the person(s) who executed the foregoing instrument and acknowledge the same.

Notary Public, Winnebago County, WI
U. Qshkosh, WI

My commission expires 2-22-98

Calvin W. Hawksworth
Wisconsin Registered Land Surveyor
August 9, 1994



Register's Office
Winnebago County, Wis.
Received for record this 17th day of October A.D., 1994 at 2:32 o'clock P.M. and filed in Vol. 1 of C.S.M. on page 3034
Virginia DeLam
Register of Deeds

883171

Sheet 2 of 2 Sheets

SAYLER SURVEY, INC

LAND SURVEYORS

WINNECONNE, WI

F.B. 68 P. 108

WINNEBAGO COUNTY CERTIFIED SURVEY MAP NO. 2975
Part of the NW1/4 of the SW1/4 of Sec. 32, T.19N., R.15E., Town of Winneconne, Winnebago County, Wisconsin

I, Calvin W. Hawksworth, Wisconsin Registered Land Surveyor, hereby certify:
That I have surveyed, divided and mapped the parcel of land located in part of the NW1/4 of the SW1/4 of Sec. 32, T.19N., R.15E., Town of Winneconne, Winnebago County, Wisconsin, described as follows:
Beginning at a point on the North line of the SW1/4 of said Sec. 32 that is 639.64 ft., N.89°59'40"E. of a Berntsen Monument at the West 1/4 corner of said Sec. 32. From that point running N.89°54'40"E., 324.28 ft., thence S.00°07'36"W., 301.85 ft., thence S.89°59'40"W., 319.63 ft., thence N.00°45'20"W., 301.88 ft. to the said point of beginning. Being a parcel of land of 2.231 Acres. Reserving therefrom that portion lying within the right of way of Oak Hill Road presently used for road purposes. Subject to all easements and restrictions of record.

That I have made such survey, land division and map by the direction of Emeran J. and Shirley M. Petrack 2 North 5th. Street, Winneconne, Wisconsin 54986; that such map is a correct representation of the exterior boundaries of the land surveyed.

That I have fully complied with the provisions of Sec. 236.34 of the Wisconsin Statutes and Winnebago County Subdivision Ordinance in surveying, dividing and mapping the same.

Calvin W. Hawksworth
Calvin W. Hawksworth S-1290
Wisconsin Registered Land Surveyor
July 12, 1994



WINNEBAGO COUNTY PLANNING COMMITTEE CERTIFICATE:


This Certified Survey Map of part of the NW1/4 of the SW1/4 of Sec. 32, T.19N., R.15E., Town of Winneconne, Winnebago County, Wisconsin is hereby approved.

August 3, 1994
Date

Jeanette Diakoff
Authorized Signature

Tax Parcel No.

Bearings are Referenced to the
North Line of the SW1/4 of Sec. 32,
Assumed Bearing
N.89°54'40"E.

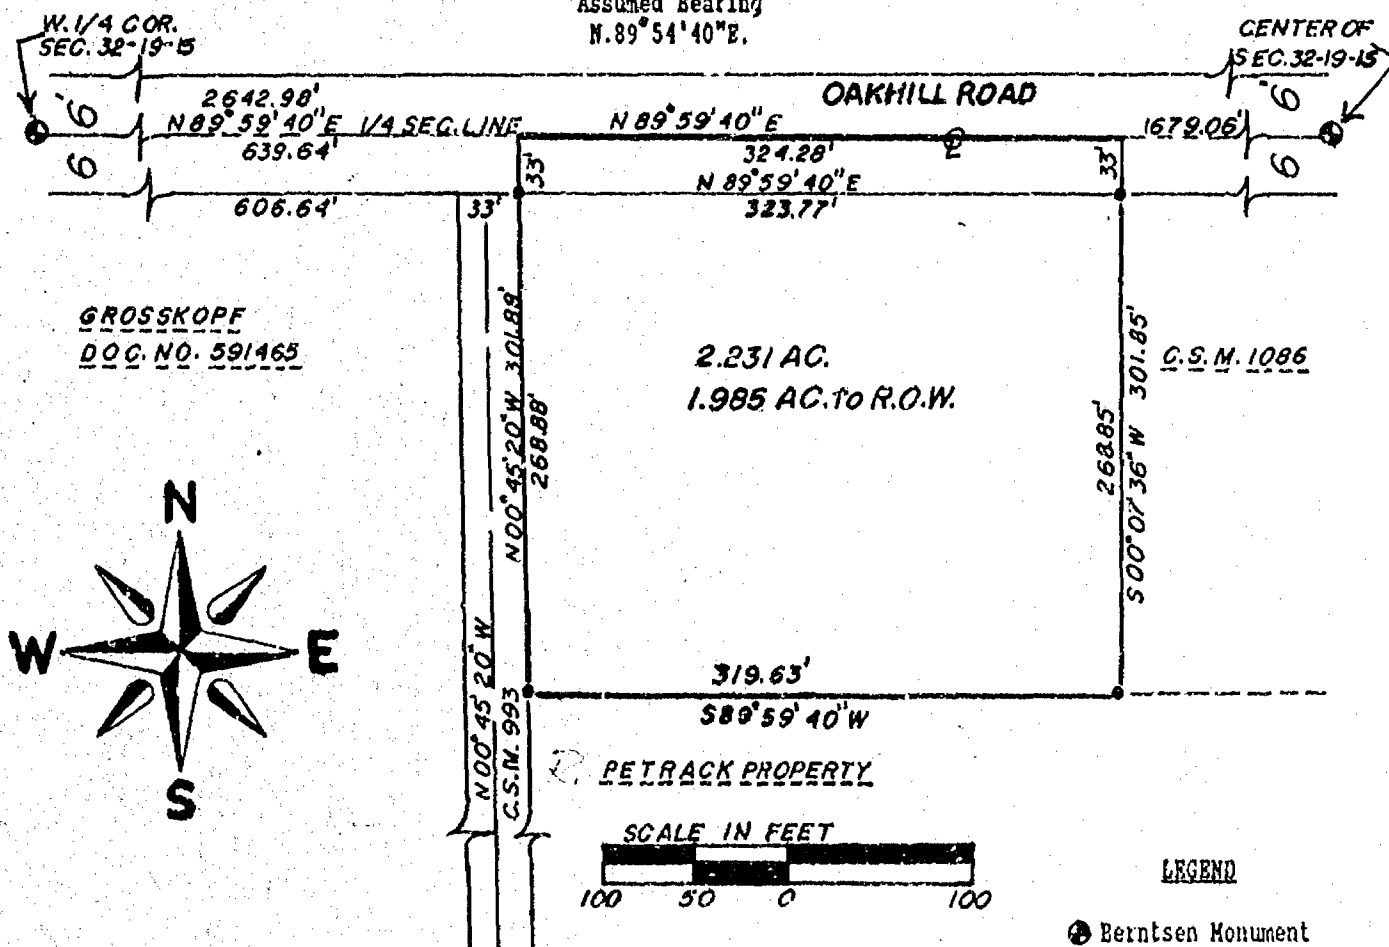

WINNEBAGO COUNTY CERTIFIED SURVEY MAP NO. 2975

Part of the NW1/4 of the SW1/4 of Sec. 32, T.19N., R.15E., Town of Winneconne, Winnebago County, Wisconsin

CERTIFICATE OF COUNTY TREASURER:

STATE OF WISCONSIN)
WINNEBAGO COUNTY) SS

I, Mary E. Krueger - Deputy
being the duly elected, qualified and acting
treasurer of the County of Winnebago, do hereby
certify that the records in my office show no
unredeemed tax sales and no unpaid taxes or special
assessments as of July 26, 1994,
affecting the lands included in this certified
survey map.

7-26-94
Date

Mary E. Krueger - Deputy
Authorized Signature

OWNER'S CERTIFICATE:

As owner(s), I(we) hereby certify that I(we) caused the land described on this certified survey map to be surveyed, divided and mapped as represented hereon.

Emeran J. Petrack
Emeran J. Petrack
2 North 5th Street
Winneconne, Wisconsin 54986

TOWN TREASURERS CERTIFICATE:

STATE OF WISCONSIN)
WINNEBAGO COUNTY) SS

I, Joy Meinen, being the duly elected, qualified
and acting treasurer of the Town of Winneconne,
do hereby certify that in accordance with the
records in my office, there are no unpaid taxes
or unpaid special assessments as of July 20,
1994 on any of the land included in this
certified survey map.

July 20, 1994
Date

Joy Meinen
Town Treasurer

Shirley M. Petrack
Shirley M. Petrack
2 North 5th Street
Winneconne, Wisconsin 54986


STATE OF WISCONSIN)
WINNEBAGO COUNTY) SS

Personally came before me this 13th day
of July, 1994, the above named
person(s) to me known to be the person(s) who
executed the foregoing instrument and acknowledge
the same.

Irene F. Haedt
Notary Public

My commission expires 10-6-1996

Calvin W. Hawisworth
Calvin W. Hawisworth S-1290
Wisconsin Registered Land Surveyor
July 12, 1994

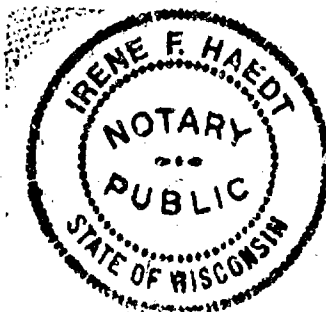

883393


Register's Office
Winnebago County, Wis.
Received for record this 5th
day of Aug, A.D., 1994
at 8:06 o'clock AM, and
filed in Vol. 1 of CSM
on page 2975

Margaret Klamm
Register of Deeds

Mortgage Survey

PART OF THE NE 1/4 OF THE SW 1/4 OF SEC. 32,
T.19N., R.15E., TOWN OF WINNECONNE,
WINNEBAGO CO., WI.

CLIENT: JOHN SCHWOCHERT
6793 OAK HILL RD.
OMRO, WI. 54963

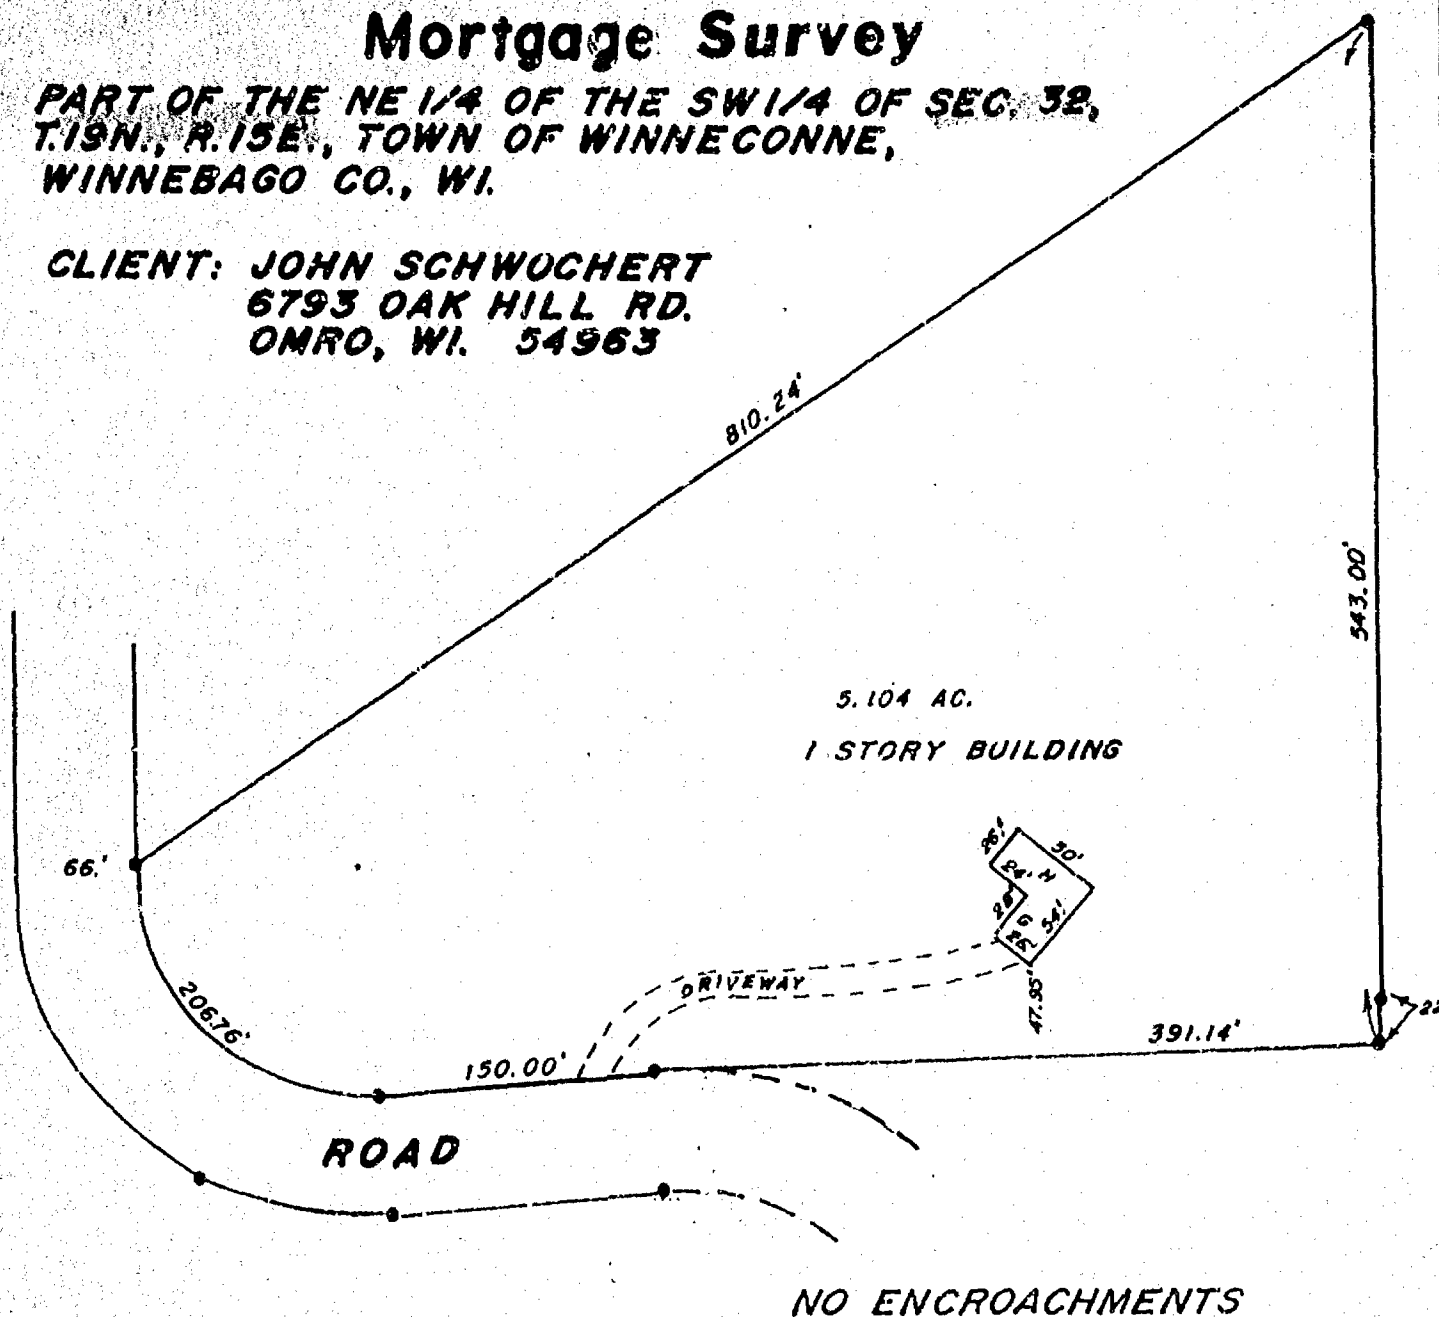

I, Robert H. Saylor certify that this mortgage inspection was made by me or under my direction and control, of the described property on January 21, 1994, according to the official records and that this drawing is a true representation of the principal building lines thereon and is accurate to the best of my knowledge and belief. North Shore Bank, Brookfield, WI. in agreement with Saylor Survey, Inc., has waived parts of Administrative Code A-E, 5.01 (3 through 7).

THIS IS NOT A BOUNDARY SURVEY NOR INTENDED TO BE. THIS MORTGAGE INSPECTION IS MADE FOR THE EXCLUSIVE USE OF NORTH SHORE BANK, BROOKFIELD, WI.

LEGEND

- = Existing monuments
- = 2" x 30" iron pipe set
- ◊ = 1" x 30" iron pipe set
- ⊙ = reference caps or RR spikes
- ⊗ = Bernsen or Harrison monuments
- X-X = fence
- () = recorded as
- = stone monument



Robert H. Saylor
Wisconsin Registered Land Surveyor 5-1894

Saylor
Survey, Inc.

Box 252, Winneconne, WI 54986

SCALE 1 IN. = 200 FT.

PROJECT NO. MS-003791

FIELD BOOK PLAT PAGE

AFFIDAVIT

Part of the NW1/4 of the SW1/4 of Sec. 32, T.19N., R.25E., Town of Winneconne,
Winnebago Co., WI.

Issued to: Emeran J. & Shirley M. Petrack

FOR: Correction to C.S.M. No. 2975, Doc. No. 883393, Rec. 8-5-1994.

I, Calvin W. Hawksworth, registered land surveyor, hereby certify:
That on July 12, 1994, I surveyed, mapped and recorded Certified Survey Map No.
2975 of Winnebago County Records. Said map failed to show the Lot No. on the face of
said plat as required.

The lot shown should be labeled Lot 1.

The above change should be noted on above Certified Survey Map.

Calvin W. Hawksworth
Calvin W. Hawksworth S-1290
Wisconsin Registered Land Surveyor
February 7, 1995.



This instrument was drafted by Calvin W. Hawksworth.

NOTARY PUBLIC:
STATE OF WISCONSIN)
WINNEBAGO COUNTY) SS

Personally came before me this 7th day of February, 1995,
the above named Calvin W. Hawksworth, to me known to be the person who executed the
foregoing instrument and acknowledged the same.

Irene F. Haedt
Notary Public, Omaro, WI.

My commission expires 10-6-96



897702

Register's Office
Winnebago County, Wis.
Received for record
this 12th Day of
February
A.D. 1995
at 9:04 o'clock AM


Irene Haedt
REGISTER OF DEEDS

Chg.
10.00

02M 2975
883393

Part of the SW1/4 of Sec. 32, T.19N., R.15E., Town of Winneconne, Winnebago Co., WI. (A Road)

Bearings are referenced to the North line of the SW1/4 of Sec. 32, T.19N., R.15E., assumed bearing, N.89°59'40"E.

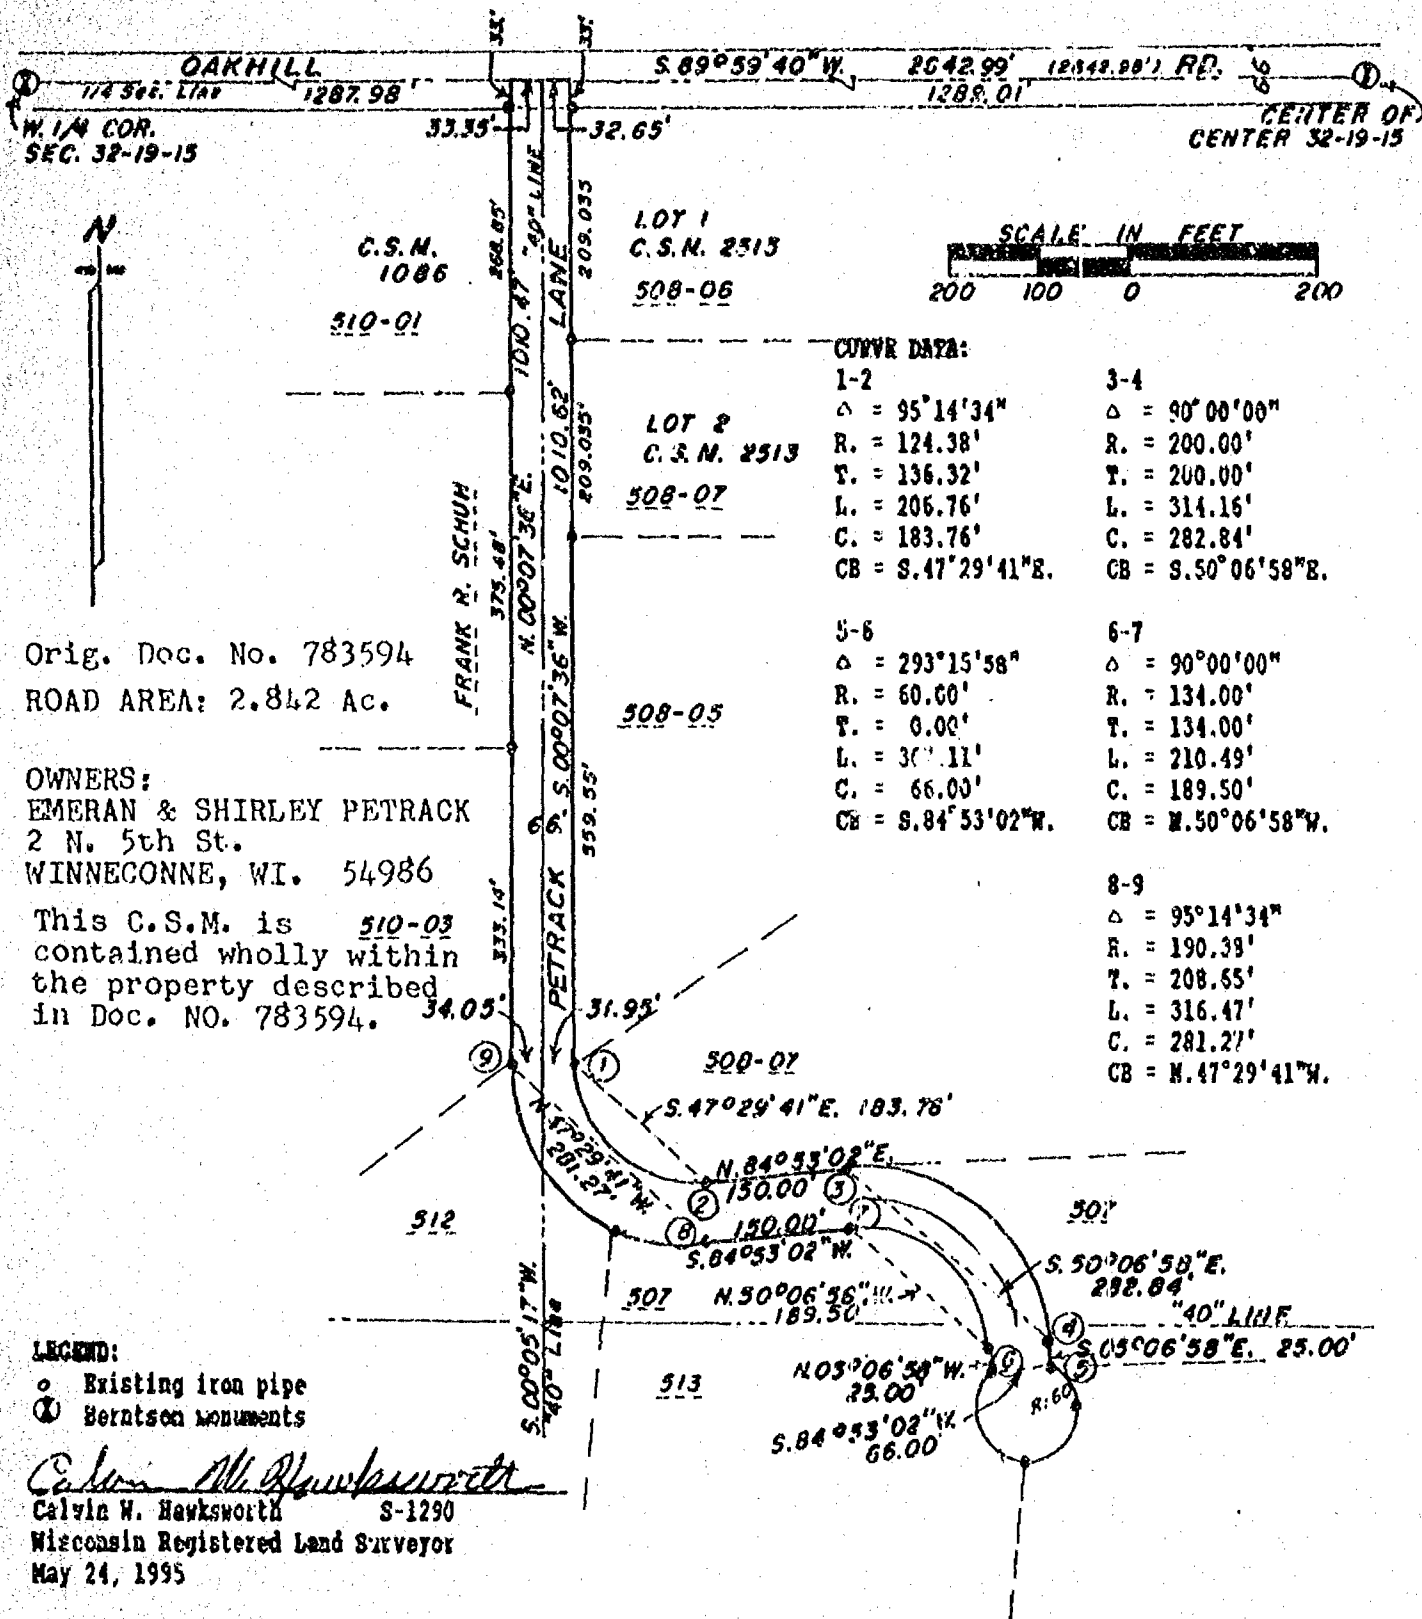

WINNEBAGO COUNTY PLANNING COMMISSION CERTIFICATE:

This Certified Survey Map of a road in the SW1/4 of Sec. 32, T.19N., R.15E., Town of Winneconne, is hereby approved.

June 30, 1995
Date

Janette Diskoff
Authorized signature

NOTE: CENTER LINE IS NOT ON "40" LINE

Sheet 1 of 2 sheets

SAYLER SURVEY, INC

LAND
SURVEYORS

WINNECONNE, WI

F.B. 49 P. 102



WINNEBAGO COUNTY CERTIFIED SURVEY MAP NO: 3199

Part of the SW1/4 of Sec. 32, T.19N., R.15E., Town of Winneconne, Winnebago County, Wisconsin.

SURVEYOR'S CERTIFICATE:

I, Calvin W. Hawksworth, registered land surveyor, hereby certify:

That I have surveyed and mapped a road in part of the SW1/4 of Sec. 32, T.19N., R.15E. in the Town of Winneconne, Winnebago County, Wisconsin, described as follows: Beginning at a point on the North line of the SW1/4 of said Sec. 32 that is 1287.98 ft., N.89°39'40"E. of a Berntsen monument at the West 1/4 corner of said Sec. 32. From that point continuing N.89°39'40"E., 66.00 ft., thence S.60°07'36"W., 1010.62 ft., thence 206.76 ft. along the arc of a curve whose chord bears S.47°29'41"E., 183.76 ft., thence N.84°53'02"W., 150.00 ft., thence 314.16 ft. along the arc of a curve whose chord bears S.52°06'58"W., 282.84 ft., thence S.05°06'58"E., 25.00 ft., thence 307.11 ft. along the arc of a cul de sac whose chord bears S.84°53'02"W., 66.00 ft., thence N.05°06'58"W., 25.00 ft., thence 210.49 ft. along the arc of a curve whose chord bears N.50°06'58"W., 189.50 ft., thence S.84°53'02"W., 150.00 ft., thence 316.47 ft. along the arc of a curve whose chord bears N.47°29'41"W., 281.27 ft., thence N.00°07'36"W., 1010.47 ft. to the said point of beginning. Being a parcel of land of 2.842 acres. Subject to all easements and restrictions of record.

That I have made such survey and map by the direction of Karl J. Luaders, Att., for Eileen and Shirley Petrack, 2 N. 5th St., Winneconne, WI; 54986; that such map is a true and correct representation of the exterior boundaries of the land surveyed.

That I have fully complied with the provisions of Sec. 236.34 of the Wisconsin Statutes and the Winnebago County Subdivision Ordinance in surveying and mapping the same.

Calvin W. Hawksworth
Calvin W. Hawksworth S-1290
Wisconsin Registered Land Surveyor
May 24, 1995



TOWN BOARD RESOLUTION:

Resolved, that this Certified Survey Map of a road dedication in part of the SW1/4 of Sec. 32, T.19N., R.15E. in the Town of Winneconne; Eileen & Shirley Petrack, owners is hereby approved by the Town Board of the Town of Winneconne.

<u>June 15, 1995</u>	Approved:	<u>Arden E. Christensen</u>
Date		Chairman
<u>June 15, 1995</u>	Signed	<u>Arden E. Christensen</u>
Date		Chairman

I hereby certify that the foregoing is a copy of a resolution adopted by the Town Board of the Town of Winneconne.

Marilyn E. Mueggen
Town Clerk

TOWN TREASURER'S CERTIFICATE:

STATE OF WISCONSIN)
WINNEBAGO COUNTY) SS

I, Joy Meinen, being the duly elected, qualified and acting treasurer of the Town of Winneconne, do hereby certify that in accordance with the records in my office, there are no unpaid taxes or unpaid special assessments as of June 5, 1995 on any of the land included in this certified survey map.

June 5, 1995
Date Joy Meinen
Town Treasurer

COUNTY TREASURER'S CERTIFICATE:

STATE OF WISCONSIN)
WINNEBAGO COUNTY) SS

I, Mary E. Mueggen-Deputy, being the duly elected, qualified and acting treasurer of the County of Winnebago, do hereby certify that the records in my office show no unredeemed tax sales and no unpaid taxes or special assessments as of June 21, 1995, affecting the lands included in this certified survey map.

6/27/95
Date Mary E. Mueggen-Deputy
County Treasurer

WINNEBAGO COUNTY CERTIFIED SURVEY MAP NO. 3199
Part of the SW1/4 of Sec. 32, T.19N., R.15E., Town of Winneconne, Winnebago Co., WI. (Road)

OWNER'S CERTIFICATE:

As owners, we hereby certify that we caused the land described on this certified survey map to be surveyed, dedicated and mapped as represented hereon.

Emran J. Petrack
Emran J. Petrack
2 North 5th St.
Winneconne, WI. 54986

Shirley M. Petrack
Shirley M. Petrack
2 North 5th St.
Winneconne, WI. 54986

STATE OF WISCONSIN)
WINNEBAGO COUNTY) ss

Personally came before me this 1st day of June, 1995, the above named persons to me known to be the persons who executed the foregoing instrument and acknowledged the same.

Irene F. Haedt
Notary Public, Omro, WI.

My commission expires 10-6-1996

Calvin W. Hawksworth
Calvin W. Hawksworth S-1290
Wisconsin Registered Land Surveyor
May 24, 1995



Sheet 3 of 3 sheets

908410

Register's Office
Winnebago County, Wis.
Received for record this 3rd day of June A.D., 1995
at 3:06 o'clock P.M. and
filed in Vol. L of C.S.M
on page 3199

Susan Winneconne
Register of Deeds

SAYLER SURVEY, INC

LAND
SURVEYORS

WINNECONNE, WI

F.B. 49 P. 102

Chy
140


Reg. of Records
County

WINNEBAGO COUNTY CERTIFIED SURVEY MAP No. 3218
Part of the SE1/4 of the SW1/4 and part of the SW1/4 of the SW1/4
of Sec. 32, T.19N., R.15E., Town of Winneconne, Winnebago County, Wisconsin

SURVEYOR'S CERTIFICATE:

I, Calvin W. Hawksworth, Wisconsin Registered Land Surveyor, hereby certify:
That I have surveyed, divided and mapped the parcel of land located in
part of the SE1/4 of the SW1/4 and part of the SW1/4 of the SW1/4 of Sec. 32,
T.19N., R.15E., Town of Winneconne, Winnebago County, Wisconsin, described as follows:
Beginning at the South 1/4 corner of said Sec. 32. From that point running along the South line
of said Sec. 32, S.89°17'00"W., 2639.36 ft. to the West line of said Sec. 32, thence along said West
line N.00°59'26"W., 659.11 ft., thence N.89°29'32"E., 954.04 ft., thence N.00°53'11"W., 269.57 ft.,
thence N.89°08'48"E., 1154.93 ft. to the center line of the former Chicago, Milwaukee, St. Paul and
Pacific Railroad Company, thence along said former center line S.19°33'18"W., 914.48 ft., thence
N.89°17'00"E., 570.88 ft. to the center line of State Road "116", thence along said center line
S.00°54'46"E., 66.00 ft. to the said point of beginning. Reserving therefrom that portion lying
within the right of way of State Road "116". Subject to an
easement over and across described parcel for ingress and egress
as shown. Subject to all easements and restrictions of record.

TAX No. 030-0511
030-0511-01
030-0512-01
030-0513-01

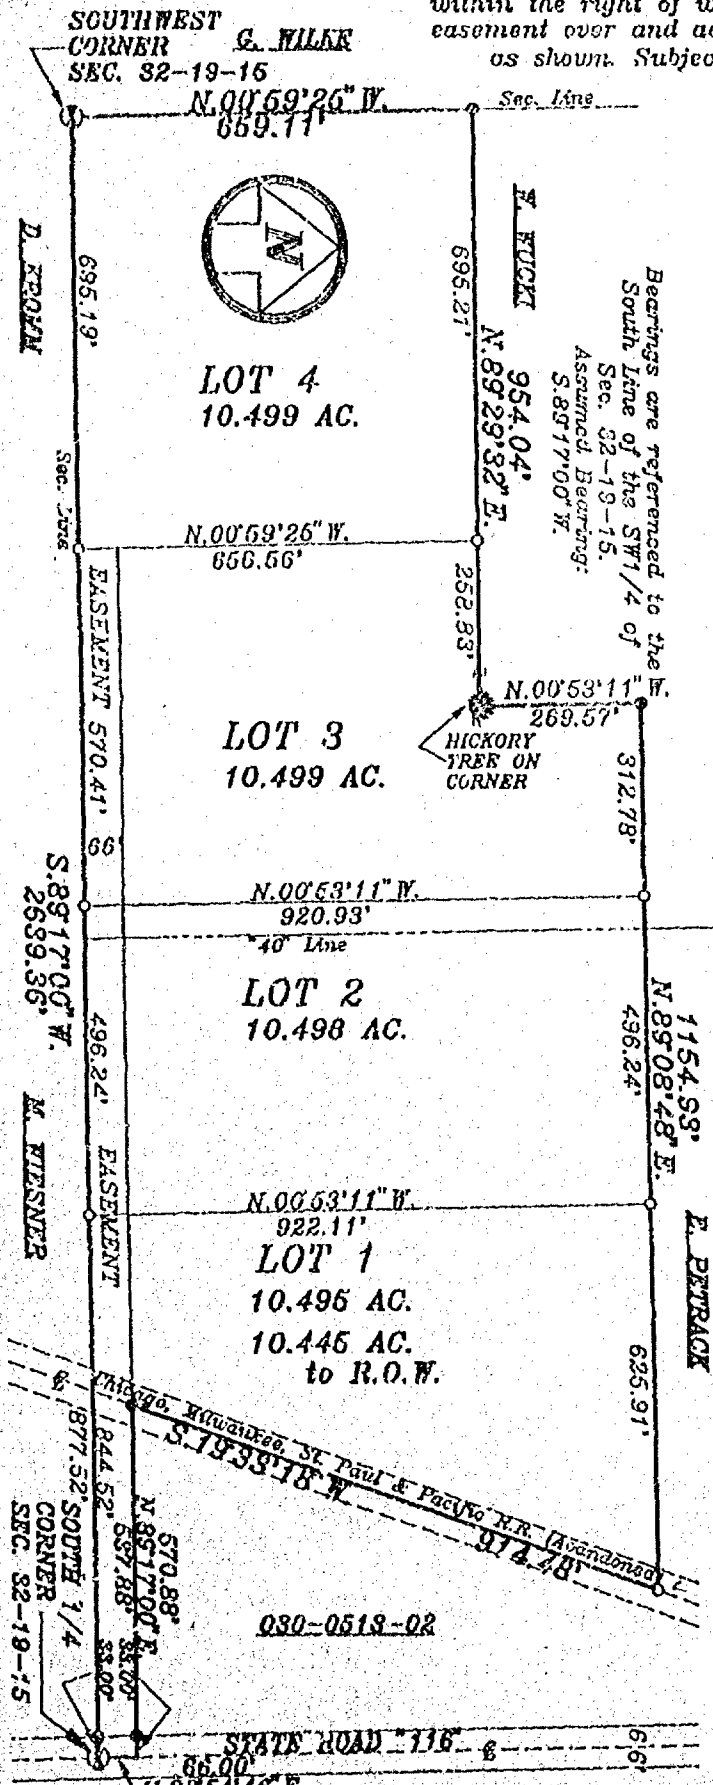

That I have made such survey, land
division and map by the direction of Marge
Tomasek, 631 Hawthorne Drive, Omro,
Wisconsin 54963; that such map is a true
and correct representation of the exterior
boundaries of the land surveyed.

That I have fully complied with the
provisions of Sec. 236.34 of the Wisconsin
Statutes and the Winnebago County Subdivision
Ordinance in surveying, dividing and mapping
the same.

Calvin W. Hawksworth

Calvin W. Hawksworth S-1290
Wisconsin Registered Land Surveyor
July 6, 1995

**WINNEBAGO COUNTY PLANNING
COMMITTEE CERTIFICATE:**

This Certified Survey Map of part of the
SE1/4 of the SW1/4 & part of the SW1/4 of
SW1/4 of Sec. 32, T.19N., R.15E., Town of
Winneconne, Winnebago County, Wisconsin,
is hereby approved.

Date _____

Authorized Signature


This C.S.M. is contained wholly
within the property described
in the following recorded
instrument:

DOC. No. 899689
WINNEBAGO COUNTY RECORDS

LEGEND

- (X) Bernsten Monument
- 1" x 30" Iron Pipe Set
weighing 1.13lbs/lin. ft.
- Existing Iron Pipe Found

SCALE IN FEET

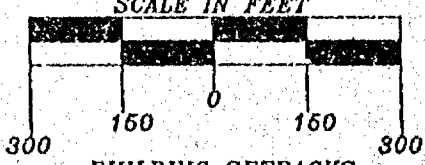

BUILDING SETBACKS

- 30' Minimum from road
right of way
- 25' Minimum rear yard
- 7' Minimum one side yard
- 10' Minimum other side yard



WINNEBAGO COUNTY CERTIFIED SURVEY MAP No. 3218
Part of the SE1/4 of the SW1/4 and part of the SW1/4 of the SW1/4
of Sec. 32, T.19N., R.15E., Town of Winneconne, Winnebago County, Wisconsin

COUNTY TREASURER'S CERTIFICATE:
STATE OF WISCONSIN)
WINNEBAGO COUNTY) SS

I, _____ being the duly elected, qualified and acting Treasurer of the County of Winnebago, do hereby certify that the records in my office show no unredeemed tax sales and no unpaid taxes or special assessments as of _____, 1995 affecting the lands included in this Certified Survey Map.

Date

County Treasurer

TOWN TREASURER'S CERTIFICATE:
STATE OF WISCONSIN)
WINNEBAGO COUNTY) SS

I, Joy Meinen, being the duly elected, qualified and acting Treasurer of the Town of Winneconne, do hereby certify that in accordance with the records in my office, there are no unpaid taxes or unpaid special assessments as of _____, 1995 on any of the land included in this Certified Survey Map.

Date

Town Treasurer

OWNER'S CERTIFICATE:

As owner(s), I(we) hereby certify that I(we) caused the land described on this Certified Survey Map to be surveyed, divided and mapped as represented hereon.

Marjorie E. Tomasek
Marjorie Tomasek (Marjorie E.)
631 Hawthorne Drive
Omro, Wisconsin 54963



STATE OF WISCONSIN)
WINNEBAGO COUNTY) SS

Personally came before me this 10th day of July, 1995, the above named person(s) to me known to be the person(s) who executed the foregoing instrument and acknowledge the same.

James F. Naedt My commission expires 10-6-1996
Notary Public Omro, WI

Calvin W. Hawksworth
Calvin W. Hawksworth
Wisconsin Registered Land Surveyor
July 6, 1995

S-1290

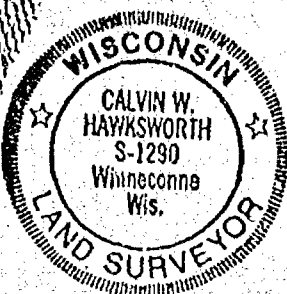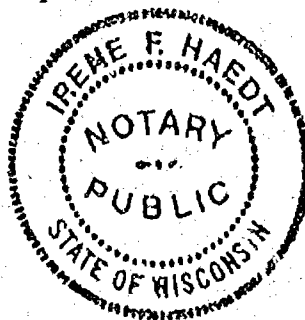

Doc. # 910586


Register's Office
Winnebago County, Wis.
Received for record this 28th
day of July A.D., 1995
at 8:02 o'clock A.M. and
filed in Vol. 1 of CSM
on page 3218

Register of Deeds

Reg. of Deeds
County

WINNEBAGO COUNTY CERTIFIED SURVEY MAP NO. 3199
Part of the SW1/4 of Sec. 32, T.19N., R.15E., Town of Winneconne, Winnebago Co., WI. (A Road)

Bearings are referenced to the North line of the SW1/4 of Sec. 32, T.19N., R.15E., assumed bearing, N.89°59'40"E.

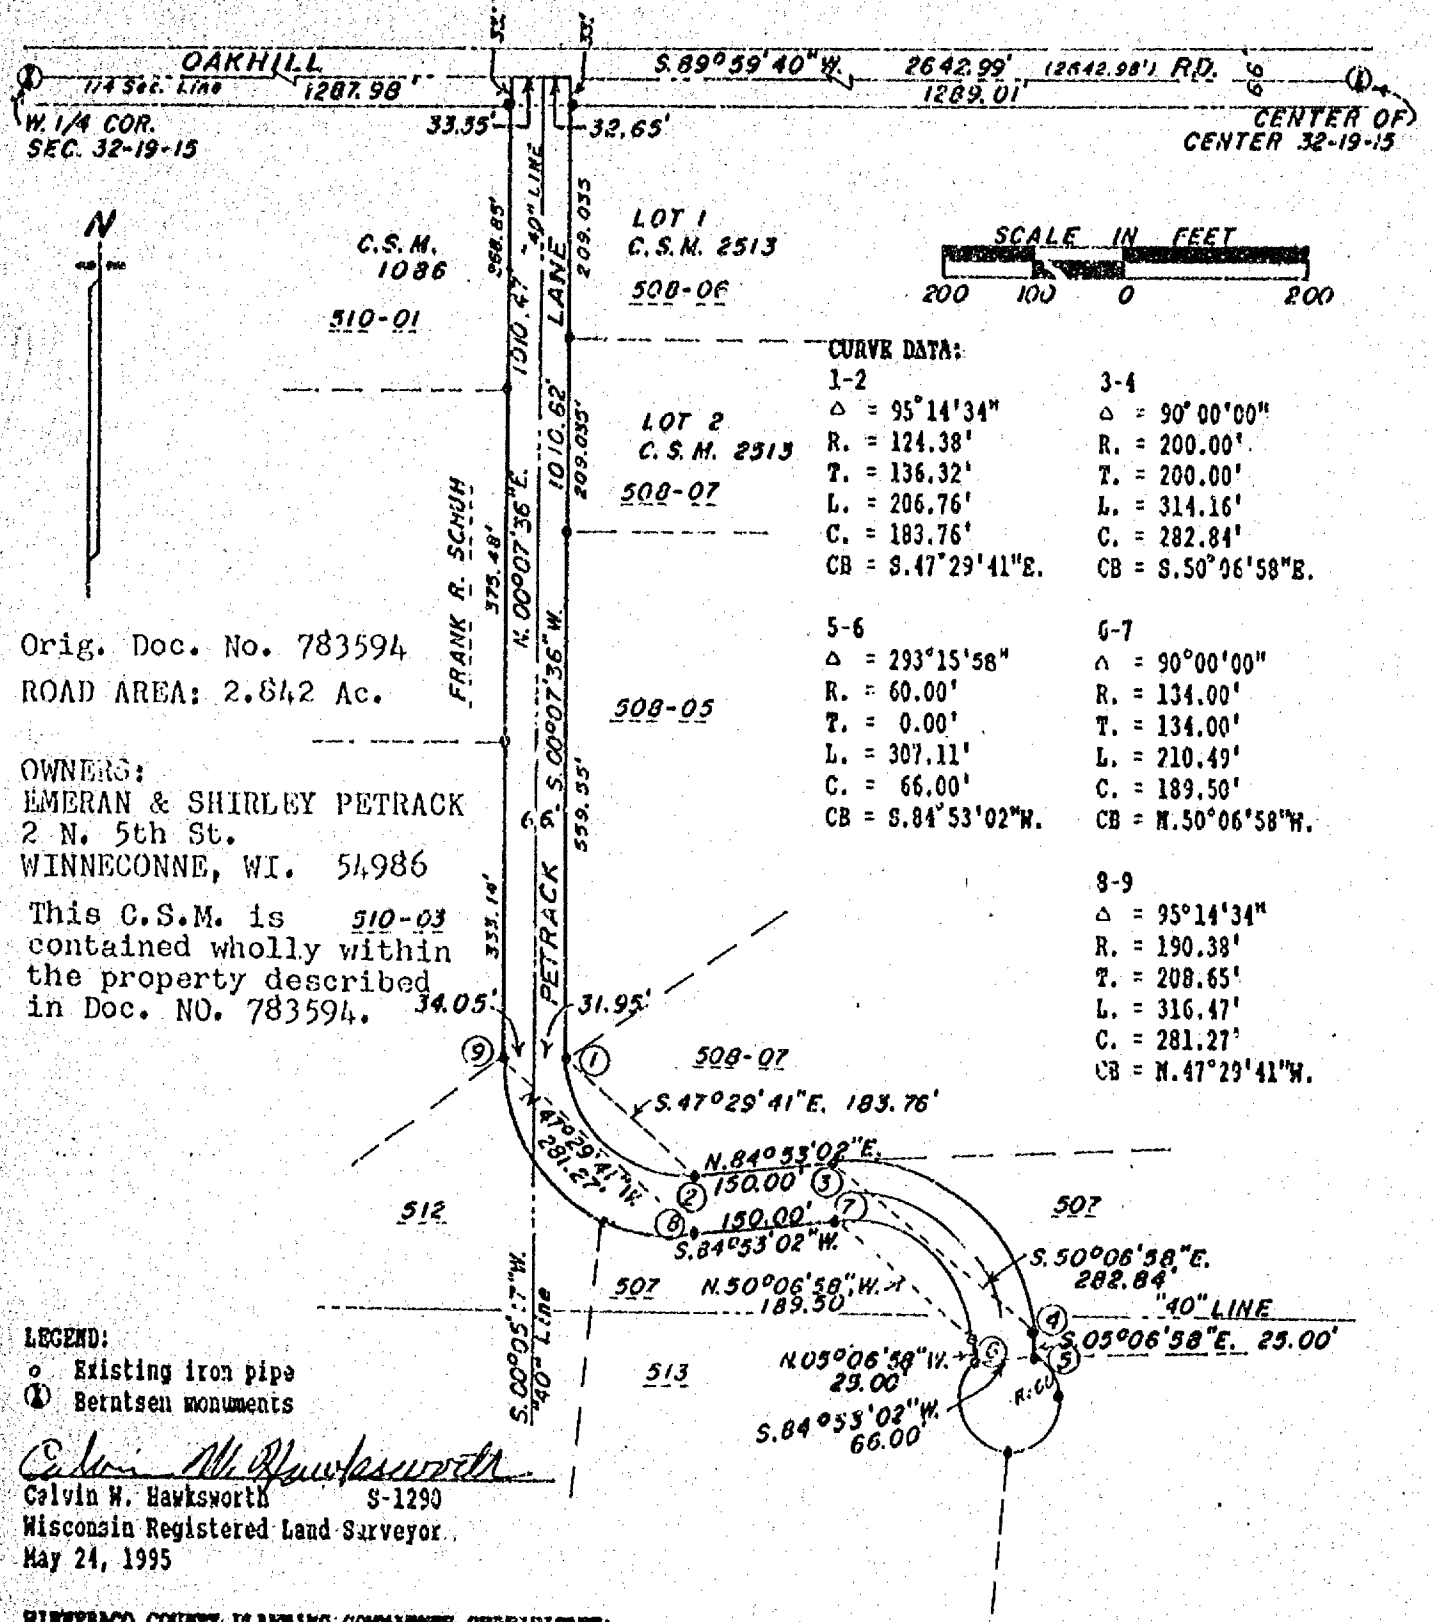

Orig. Doc. No. 783594
ROAD AREA: 2.842 Ac.

OWNERS:
EMERAN & SHIRLEY PETRACK
2 N. 5th St.
WINNECONNE, WI. 54986

This C.S.M. is 510-03
contained wholly within
the property described
in Doc. NO. 783594.

LEGEND:
o Existing iron pipe
① Berntsen monuments

Calvin W. Hawksworth
Calvin W. Hawksworth S-1290
Wisconsin Registered Land Surveyor
May 24, 1995

WINNEBAGO COUNTY PLANNING COMMITTEE CERTIFICATE:
This Certified Survey Map of a road in the SW1/4 of Sec. 32, T.19N., R.15E., Town of Winneconne, is hereby approved.

Date _____ Authorized signature _____

NOTE: CENTER LINE IS NOT ON "40" LINE
Sheet 1 of 3 sheets



WINNEBAGO COUNTY CERTIFIED SURVEY MAP NO. 3199

Part of the SW1/4 of Sec. 32, T.19N., R.15E., Town of Winneconne, Winnebago County, Wisconsin.

SURVEYOR'S CERTIFICATE:

I, Calvin W. Hawksworth, registered land surveyor, hereby certify:


That I have surveyed and mapped a road in part of the SW1/4 of Sec. 32, T.19N., R.15E. in the Town of Winneconne, Winnebago County, Wisconsin, described as follows: Beginning at a point on the North line of the SW1/4 of said Sec. 32 that is 1287.98 ft., N.89°59'40"E. of a Berntsen monument at the West 1/4 corner of said Sec. 32. From that point continuing N.89°59'40"E., 66.06 ft., thence S.00°07'36"W., 1010.62 ft., thence 206.76 ft. along the arc of a curve whose chord bears S.47°29'41"E., 183.76 ft., thence N.84°53'02"W., 150.00 ft., thence 314.16 ft. along the arc of a curve whose chord bears S.50°06'58"E., 282.84 ft., thence S.05°06'58"E., 25.00 ft., thence 197.11 ft. along the arc of a cul de sac whose chord bears S.84°53'02"W., 66.00 ft., thence N.05°06'58"W., 25.00 ft., thence 210.49 ft. along the arc of a curve whose chord bears N.50°06'58"W., 189.50 ft., thence S.84°53'02"W., 150.00 ft., thence 316.47 ft. along the arc of a curve whose chord bears N.47°29'41"W., 281.27 ft., thence N.00°07'36"E., 1010.47 ft. to the said point of beginning. Being a parcel of land of 2.842 acres. Subject to all easements and restrictions of record.

That I have made such survey and map by the direction of Earl J. Luaders, Att., for Ezeran and Shirley Petrack, 2 N. 5th St., Winneconne, WI; 54986; that such map is a true and correct representation of the exterior boundaries of the land surveyed.

That I have fully complied with the provisions of Sec. 236.34 of the Wisconsin Statutes and the Winnebago County Subdivision Ordinance in surveying and mapping the same.

Calvin W. Hawksworth

Calvin W. Hawksworth S-1290
Wisconsin Registered Land Surveyor
May 24, 1995

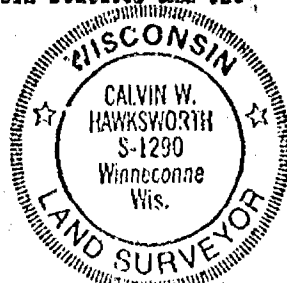

TOWN BOARD RESOLUTION:

Resolved, that this Certified Survey Map of a road dedication in part of the SW1/4 of Sec. 32, T.19N., R.15E. in the Town of Winneconne, Ezeran & Shirley Petrack, owners is hereby approved by the Town Board of the Town of Winneconne.

_____	Approved:	_____
Date		Chairman
_____	Signed	_____
Date		Chairman

I hereby certify that the foregoing is a copy of a resolution adopted by the Town Board of the Town of Winneconne.

Town Clerk

TOWN TREASURER'S CERTIFICATE:

STATE OF WISCONSIN)
WINNEBAGO COUNTY) SS

I, Joy Molnen, being duly elected, qualified and acting treasurer of the Town of Winneconne, do hereby certify that in accordance with the records in my office, there are no unpaid taxes or unpaid special assessments as of _____, 1995 on any of the land included in this certified survey map.

Date Town Treasurer

COUNTY TREASURER'S CERTIFICATE:

STATE OF WISCONSIN)
WINNEBAGO COUNTY) SS

I, _____, being the duly elected, qualified and acting treasurer of the County of Winnebago, do hereby certify that the records in my office show no unredeemed tax sales and no unpaid taxes or special assessments as of _____, 1995, affecting the lands included in this certified survey map.

Date County Treasurer

Sheet 2 of 3 sheets

WINNEBAGO COUNTY CERTIFIED SURVEY MAP NO. 3199
Part of the SW1/4 of Sec. 32, T.19N., R.15E., Town of Winneconne, Winnebago Co., WI. (Road)

OWNER'S CERTIFICATE:

As owners, we hereby certify that we caused the land described on this certified survey map to be surveyed, dedicated and mapped as represented hereon.

Everan J. Petrack

Everan J. Petrack
2 North 5th St.
Winneconne, WI. 54986

Shirley M. Petrack

Shirley M. Petrack
2 North 5th St.
Winneconne, WI. 54986

STATE OF WISCONSIN)
WINNEBAGO COUNTY) SS


Personally came before me this 1st day of June, 1995, the above named persons to me known to be the persons who executed the foregoing instrument and acknowledged the same.

Irene F. Haedt
Notary Public, Omro, WI.

My commission expires 10-6-1996

Calvin W. Hawksworth

Calvin W. Hawksworth S-1290
Wisconsin Registered Land Surveyor
May 24, 1995.

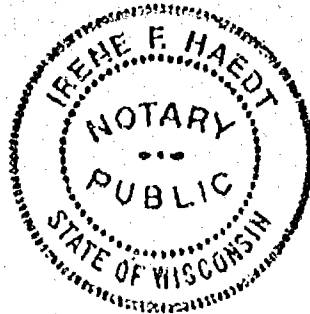

Sheet 3 of 3 sheets

Doc # 908410

Register's Office
Winnebago County, Wis.
Received for record this 30th
day of June A.D., 1995
at 3:06 o'clock P.M. and
filed in Vol. 1 of CSM
on page 3199

Register of Deeds

County

WINNEBAGO COUNTY CERTIFIED SURVEY MAP NO. 22222
Part of the NW1/4 of the SW1/4 of Sec. 32, T.19N., R.15E., Town of Winneconne, Winnebago County, Wisconsin
TAX NO. 030-0150-02

Surveyor's Certificate:


I, Calvin W. Hawksworth, Wisconsin Registered Land Surveyor, hereby certify:

That I have surveyed, divided and mapped the parcel of land located in part of the NW1/4 of the SW1/4 of Sec. 32, T.19N., R.15E., Town of Winneconne, Winnebago County, Wisconsin, described as follows: Beginning at a Berntsen Monument at the West 1/4 corner of said Sec. 32. From that point running N.89°59'40"E., 607.13 ft thence S.00°45'20"E., 585.33 ft., thence S. 89°51'09"W. (recorded as S.89°51'35"W.), 615.15 ft. (recorded as 615.33 ft.), thence N.00°04'34"E. (recorded as N.00°03'21"E.), 587.00 ft. to the said point of beginning. Being a parcel of land of 8.221 acres. Reserving therefrom that portion lying within the right of way of Oak Hill Road presently used for road purposes. Subject to all easements and restrictions of record.

That I have made such survey, land division and map by the direction of Gregg Peterson, 1616 Schaeffer Circle, Apt. 2, Appleton, Wisconsin, 54915; that such map is a true and correct representation of the exterior boundaries of the land surveyed.

That I have fully complied with the provisions of Sec. 236.34 of the Wisconsin Statutes and Winnebago County Subdivision Ordinance in surveying, dividing and mapping the same.

Bearings are referenced to the North line of the SW1/4 of Sec. 32;
Assumed Bearing: N.89°59'40"E.

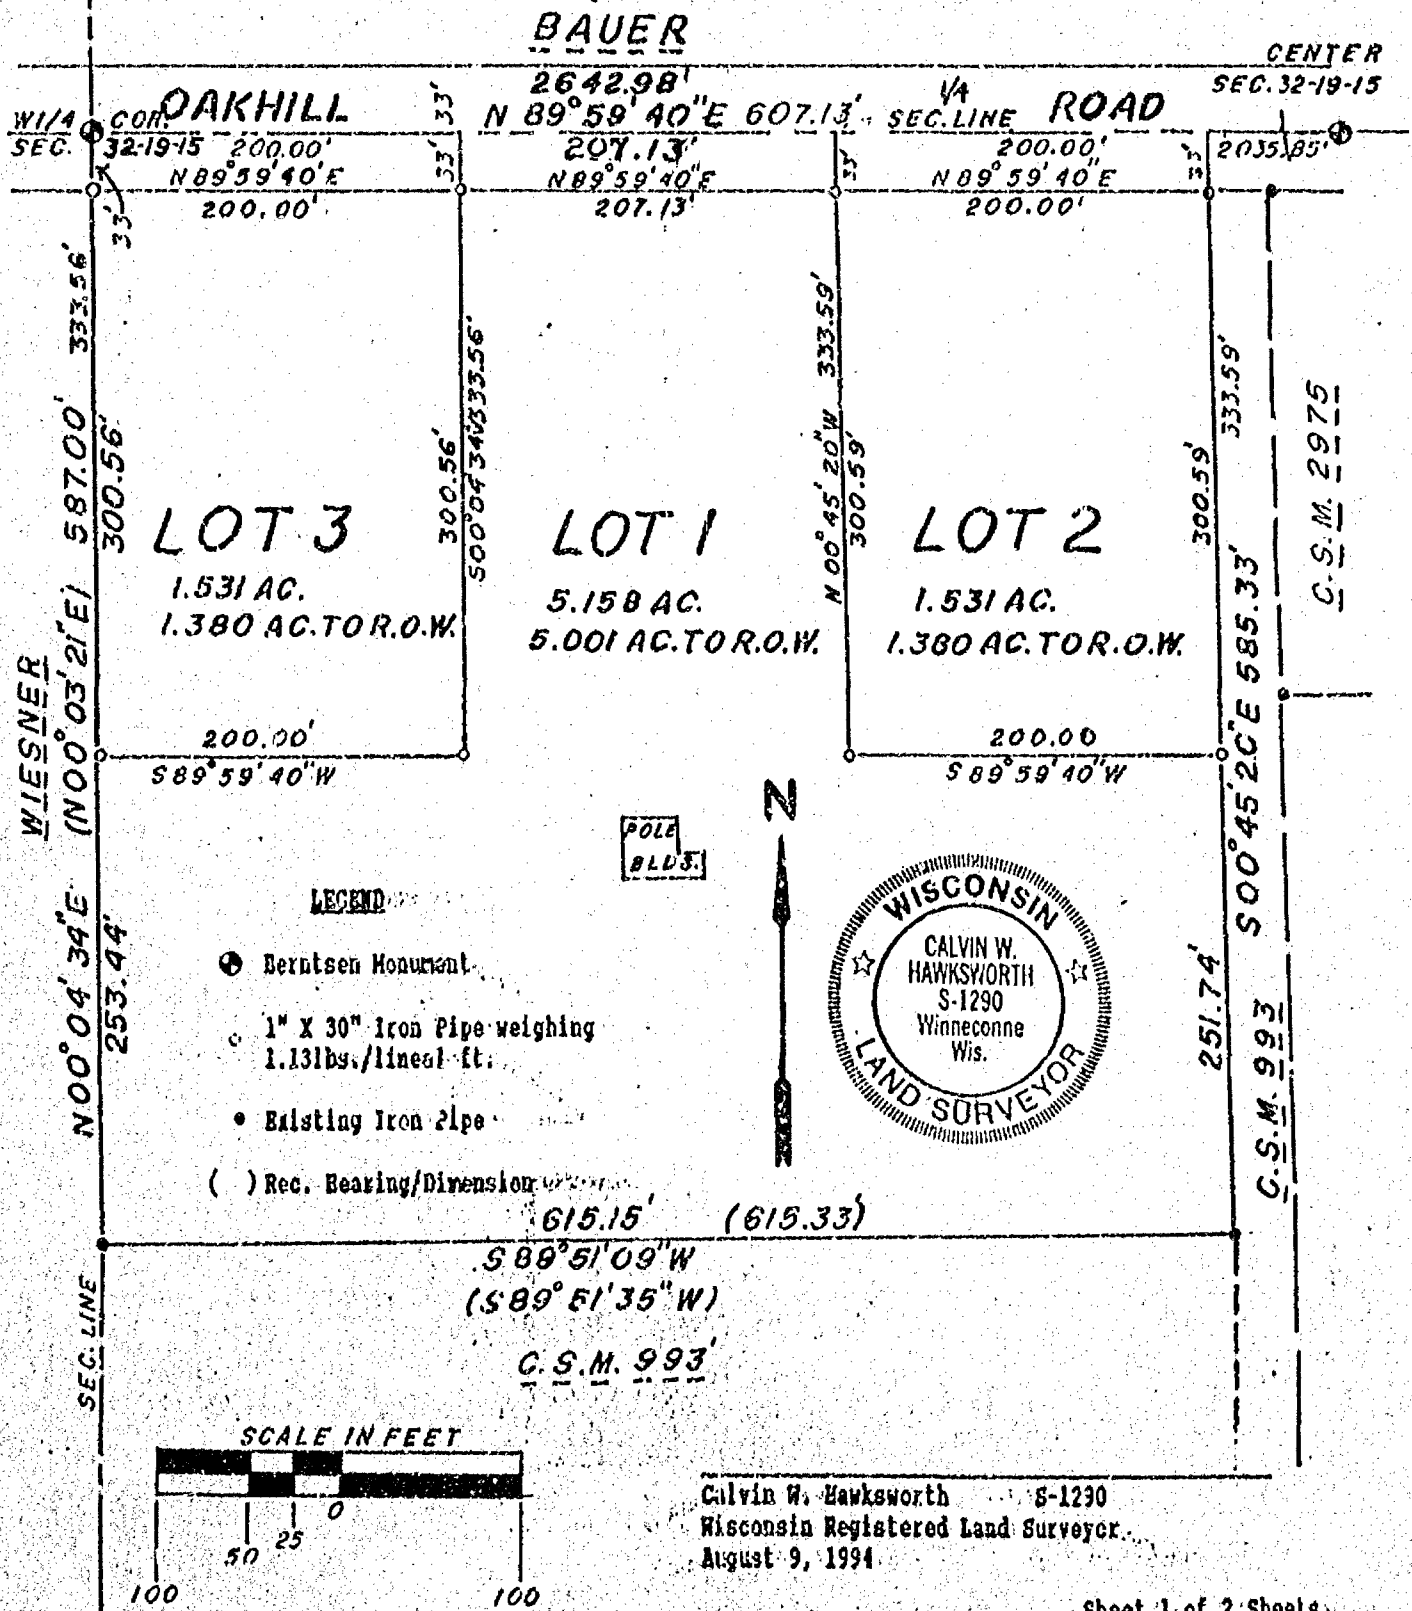


WINNEBAGO COUNTY CERTIFIED SURVEY MAP No. 3218 Part of the SE1/4 of the SW1/4 and part of the SW1/4 of the SW1/4 of Sec. 32, T.19N., R.15E., Town of Winneconne, Winnebago County, Wisconsin

SURVEYOR'S CERTIFICATE:

I, Calvin W. Hawksworth, Wisconsin Registered Land Surveyor, hereby certify:
 That I have surveyed, divided and mapped the parcel of land located in
 part of the SE1/4 of the SW1/4 and part of the SW1/4 of the SW1/4 of Sec. 32,
 T.19N., R.15E., Town of Winneconne, Winnebago County, Wisconsin, described as follows:
 Beginning at the South 1/4 corner of said Sec. 32. From that point running along the South line
 of said Sec. 32, S.89°17'00"W., 2639.36 ft. to the West line of said Sec. 32, thence along said West
 line N.00°59'25"W., 659.11 ft., thence N.89°29'32"E., 954.04 ft., thence N.00°53'11"W., 269.67 ft.,
 thence N.89°08'48"E., 1154.93 ft. to the center line of the former Chicago, Milwaukee, St. Paul and
 Pacific Railroad Company, thence along said former center line S.19°33'18"W., 814.48 ft., thence
 N.89°17'00"E., 670.88 ft. to the center line of State Road "116", thence along said center line
 S.00°54'48"E., 66.00 ft. to the said point of beginning. Reserving therefrom that portion lying
 within the right of way of State Road "116". Subject to an
 easement over and across described parcel for ingress and egress
 as shown. Subject to all easements and restrictions of record.

TAX No. 030-0511
 030-0511-01
 030-0512-01
 030-0513-01

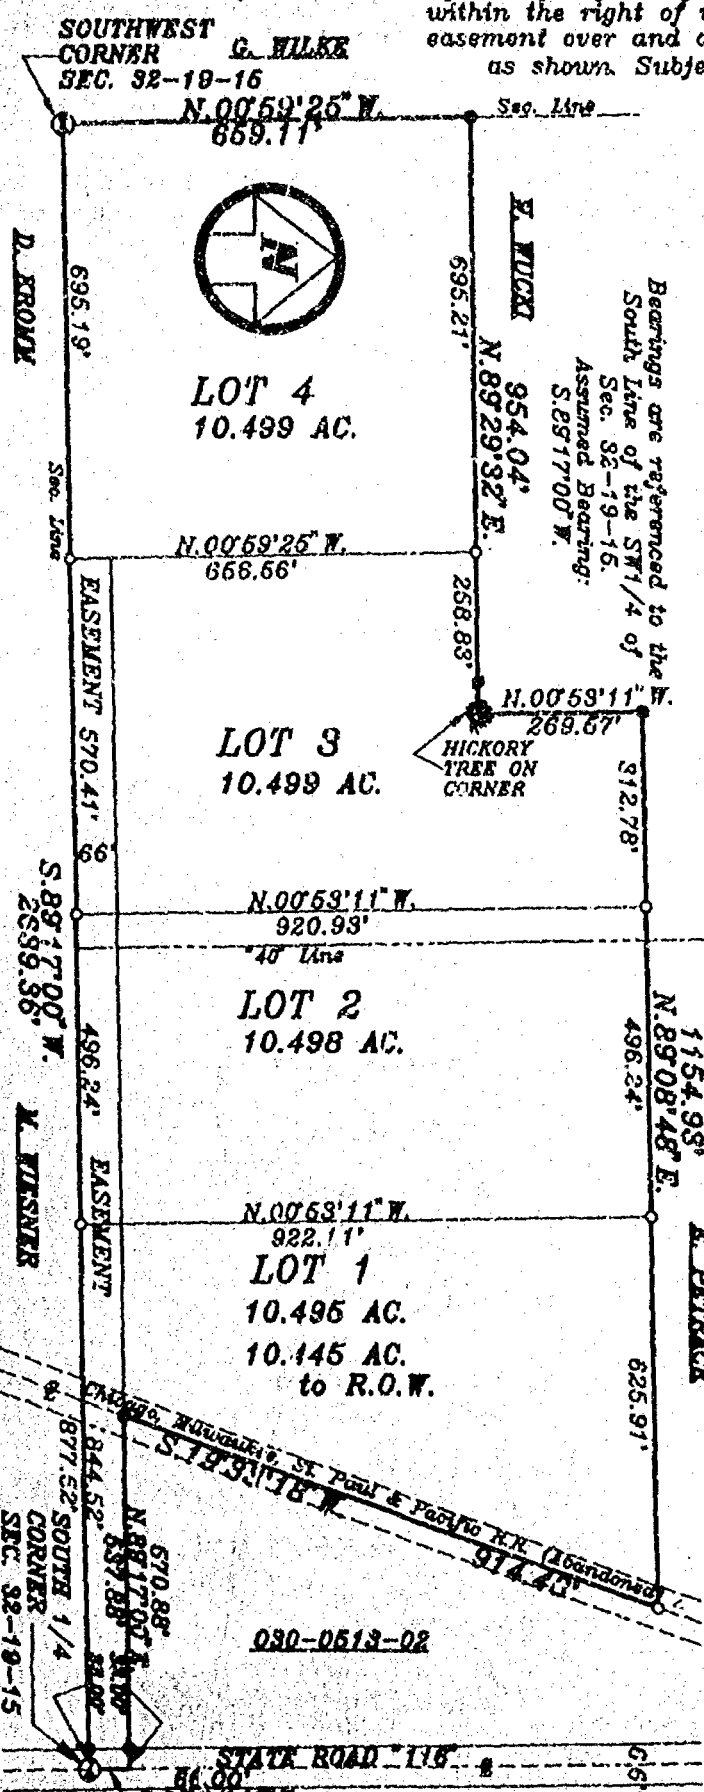

That I have made such survey, land
 division and map by the direction of Margo
 Tomasek, 631 Hawthorne Drive, Omro,
 Wisconsin 54983; that such map is a true
 and correct representation of the exterior
 boundaries of the land surveyed.
 That I have fully complied with the
 provisions of Sec. 236.34 of the Wisconsin
 Statutes and the Winnebago County Subdivision
 Ordinance in surveying, dividing and mapping
 the same.

Calvin W. Hawksworth
 Calvin W. Hawksworth S-1290
 Wisconsin Registered Land Surveyor
 July 6, 1995

**WINNEBAGO COUNTY PLANNING
 COMMITTEE CERTIFICATE:**

This Certified Survey Map of part of the
 SE1/4 of the SW1/4 & part of the SW1/4 of
 SW1/4 of Sec. 32, T.19N., R.15E., Town of
 Winneconne, Winnebago County, Wisconsin,
 is hereby approved.



Date 7/27/95

Jeanette Diakoff
 Authorized Signature

This C.S.M. is contained wholly
 within the property described
 in the following recorded
 instrument:

DOC. No. 899883
 WINNEBAGO COUNTY RECORDS

- LEGEND**
- ① Bernsten Monument
 - 1" x 30" Iron Pipe Set weighing 1.13lbs/lin. ft.
 - Existing Iron Pipe Found

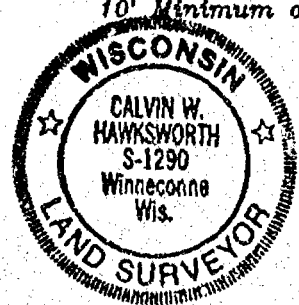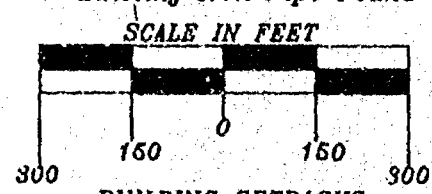

WINNEBAGO COUNTY CERTIFIED SURVEY MAP No. 3218
Part of the SE1/4 of the SW1/4 and part of the SW1/4 of the SW1/4
of Sec. 32, T.19N., R.15E., Town of Winneconne, Winnebago County, Wisconsin

COUNTY TREASURER'S CERTIFICATE:
STATE OF WISCONSIN)

WINNEBAGO COUNTY) SS

I, Mary E. Kruger, Deputy, being the duly elected, qualified and acting Treasurer of the County of Winnebago, do hereby certify that the records in my office show no unredeemed tax sales and no unpaid taxes or special assessments as of July 19, 1995 affecting the lands included in this Certified Survey Map.

7/20/95
Date

Mary E. Kruger, Deputy
County Treasurer

TOWN TREASURER'S CERTIFICATE:
STATE OF WISCONSIN)

WINNEBAGO COUNTY) SS

I, Joy Meinen, being the duly elected, qualified and acting Treasurer of the Town of Winneconne, do hereby certify that in accordance with the records in my office, there are no unpaid taxes or unpaid special assessments as of July 19, 1995 on any of the land included in this Certified Survey Map.

July 19, 1995
Date

Joy Meinen
Town Treasurer

OWNER'S CERTIFICATE:

As owner(s), I(we) hereby certify that I(we) caused the land described on this Certified Survey Map to be surveyed, divided and mapped as represented hereon.

Marjorie E. Tomasek
Marjorie E. Tomasek
631 Hawthorne Drive
Omro, Wisconsin 54983

STATE OF WISCONSIN)
WINNEBAGO COUNTY) SS


Personally came before me this 10th day of July, 1995, the above named person(s) to me known to be the person(s) who executed the foregoing instrument and acknowledge the same.

Irene F. Haedt
Notary Public Omro, WI

My commission expires 10-6-1996

Calvin W. Hawksworth
Calvin W. Hawksworth
Wisconsin Registered Land Surveyor
July 6, 1995

S-1290

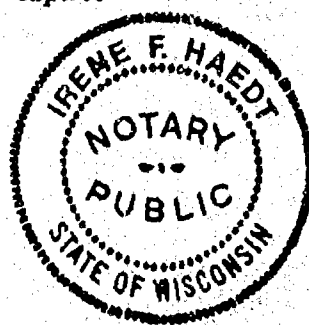

910586



Register's Office
Winnebago County, Wis.
Received for record this 28th
day of July, A.D., 19 95
at 8:02 o'clock AM, and
filed in Vol. 1 of SSM
on page 3218

Greg
1200
Irene F. Haedt
Register of Deeds

✓ SAYER SURVEY, INC

LAND
SURVEYORS

WINNECONNE, WI

Sheet 2 of 2 Sheets
F.B. 67 P.152

Register's Office
Winnebago County, Wis.
Received for record
this 22nd day of
May
A.D. 1997
2:00 o'clock PM
Deena Whanghoff
REGISTER OF DEEDS

970532

AFFIDAVIT OF CORRECTION

I, David W. Carlson II, State of Wisconsin Registered Land Surveyor No. 2251, do hereby certify the following in connection with a Certified Survey Map recorded in the Winnebago County Register of Deeds Office in **Volume 1 of Certified Survey Maps on page 3218 as Document Number 910586**, said Certified Survey Map is located in part of the SE1/4 of the SW1/4 and part of the SW1/4 of the SW1/4 of Section 32, Town 19 North, Range 15 East, Town of Winneconne, Winnebago County, Wisconsin:

The sentence shown in the Surveyor's Certificate on page 1 of 2, which reads:

"From that point.....thence North 00 degrees 53 minutes 11 seconds West, 269.57 ft., thence North 89 degrees 08 minutes 48 seconds East, 1154.93 ft....."

Should read:

“From that point.....thence North 00 degrees 53 minutes 11 seconds West, 264.57 ft., thence North 89 degrees 08 minutes 48 seconds East, 1434.93 ft.,.....”

The distance shown on the map on the West line of Lot 3 which reads: 269.57 feet; should be changed to read: 264.57 feet.

The distance shown on the map on the North line of Lots 1,2,3 which reads: 1154.93 feet; should be changed to read: 1434.93 feet.

David W. Calhoun

David W. Carlson II, Reg. WI Land Surveyor S-2251

MAY 21, 1997
Date



State of Wisconsin)) ss
Winnebago County)

Personally came before me on this 21 day of MAY, 1997,
the above named David W. Carlson II, to me known to be the person who executed the foregoing
instrument and acknowledge the same.

Notary

Name _____


WINNEBAGO
County

My commission expires _____

4/4/2000

Drafted by James E. Smith
Sayler Surveying

Return to: 3Chg
Sayler Surveying
Box 252
Winneconne, WI 54986

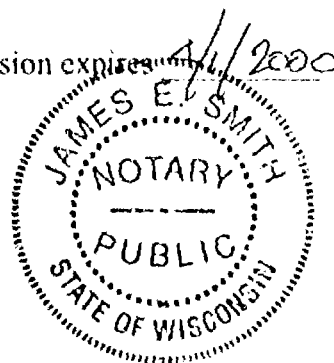

JAN 07, 1999

TO: Cartographer/Zoning Secretary

FM: Zoning Administrator

RE: Navigability Determination Map Updates

Diane/Janet:

Please update the GIS for the following DNR navigability determinations:

1. NE SW S 32, T 19 N, R 15 E, TOWN OF WINNECONNE (BESAW)

Diane: After updating, determine the affected parcels ~~where~~ ~~navigable~~ and attach a list of parcel numbers affected and within 1000' or 300' so that file 13 can be updated.
Tag stream section with DNR Determ & Date.


Janet: Update File 13, file in parcel file(s) and microfiche in Surveyors Records according to Section, Town, Range.

GIS Updated 1-7-99 by D. Culver

File 13 Updated 3/17/99 by gmo

Verified by Zoning administrator [Signature]

12/17/98

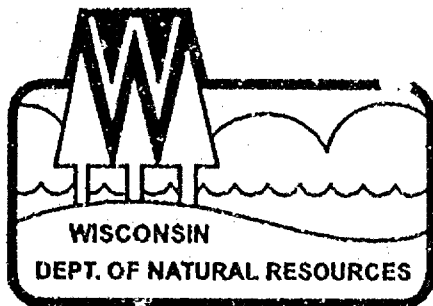

State of Wisconsin \ DEPARTMENT OF NATURAL RESOURCES

Tommy G. Thompson, Governor
George E. Meyer, Secretary
William R. Selbig, Regional Director

Oshkosh Service Center
905 Bay Shore Drive
P.O. Box 2565
Oshkosh, Wisconsin 54903
Telephone 920-424-3050
FAX 920-424-4404

December 29, 1998

File Ref:

Ms. Virginia Besaw
5060 Patreak Lane
Omro, WI 54963

SUBJECT: Navigability Determination

Dear Ms. Besaw:

I am writing in regard to your request for a navigability determination of an unnamed watercourse in the NE1/4 of the SW 1/4 of Section 32, Township 19 North, Range 15 East, Winnebago County, Wisconsin. See attached map for better detail.

On December 17, 1998, I inspected the above-mentioned watercourse. This request was conducted in regards to your complaint of the neighbors pond flooding a drainage ditch located on your property that appears to flow in a northeasterly direction. The watercourse inspected was from Patreak Lane east to Highway 116. This watercourse is considered Non-navigable.

A waterway is considered navigable if it has defined bed and banks, and it is possible to float it in a canoe or other small craft at some time of the year-even if only during spring floods. Since this section of watercourse has no defined bed or banks, this watercourse did not meet the criteria for being considered navigable.

Since the determination on this watercourse is considered Non-navigable, no Department action can be taken. However, if you would like to pursue this matter further, you would need to file a civil lawsuit against your neighbor to resolve this issue.

If you have any further questions, please feel free to contact me at the above address or call (920) 424-7885.

Sincerely,

Keith A. Patrick
Water Management Assistant


cc: Dick Koch-WDNR, NER
Rob Braun-Winnebago Co. Zoning
Gary Knaption-COE, Green Bay office
Warden-Winnebago County



Quality Natural Resources Management
Through Excellent Customer Service




Non-navigable

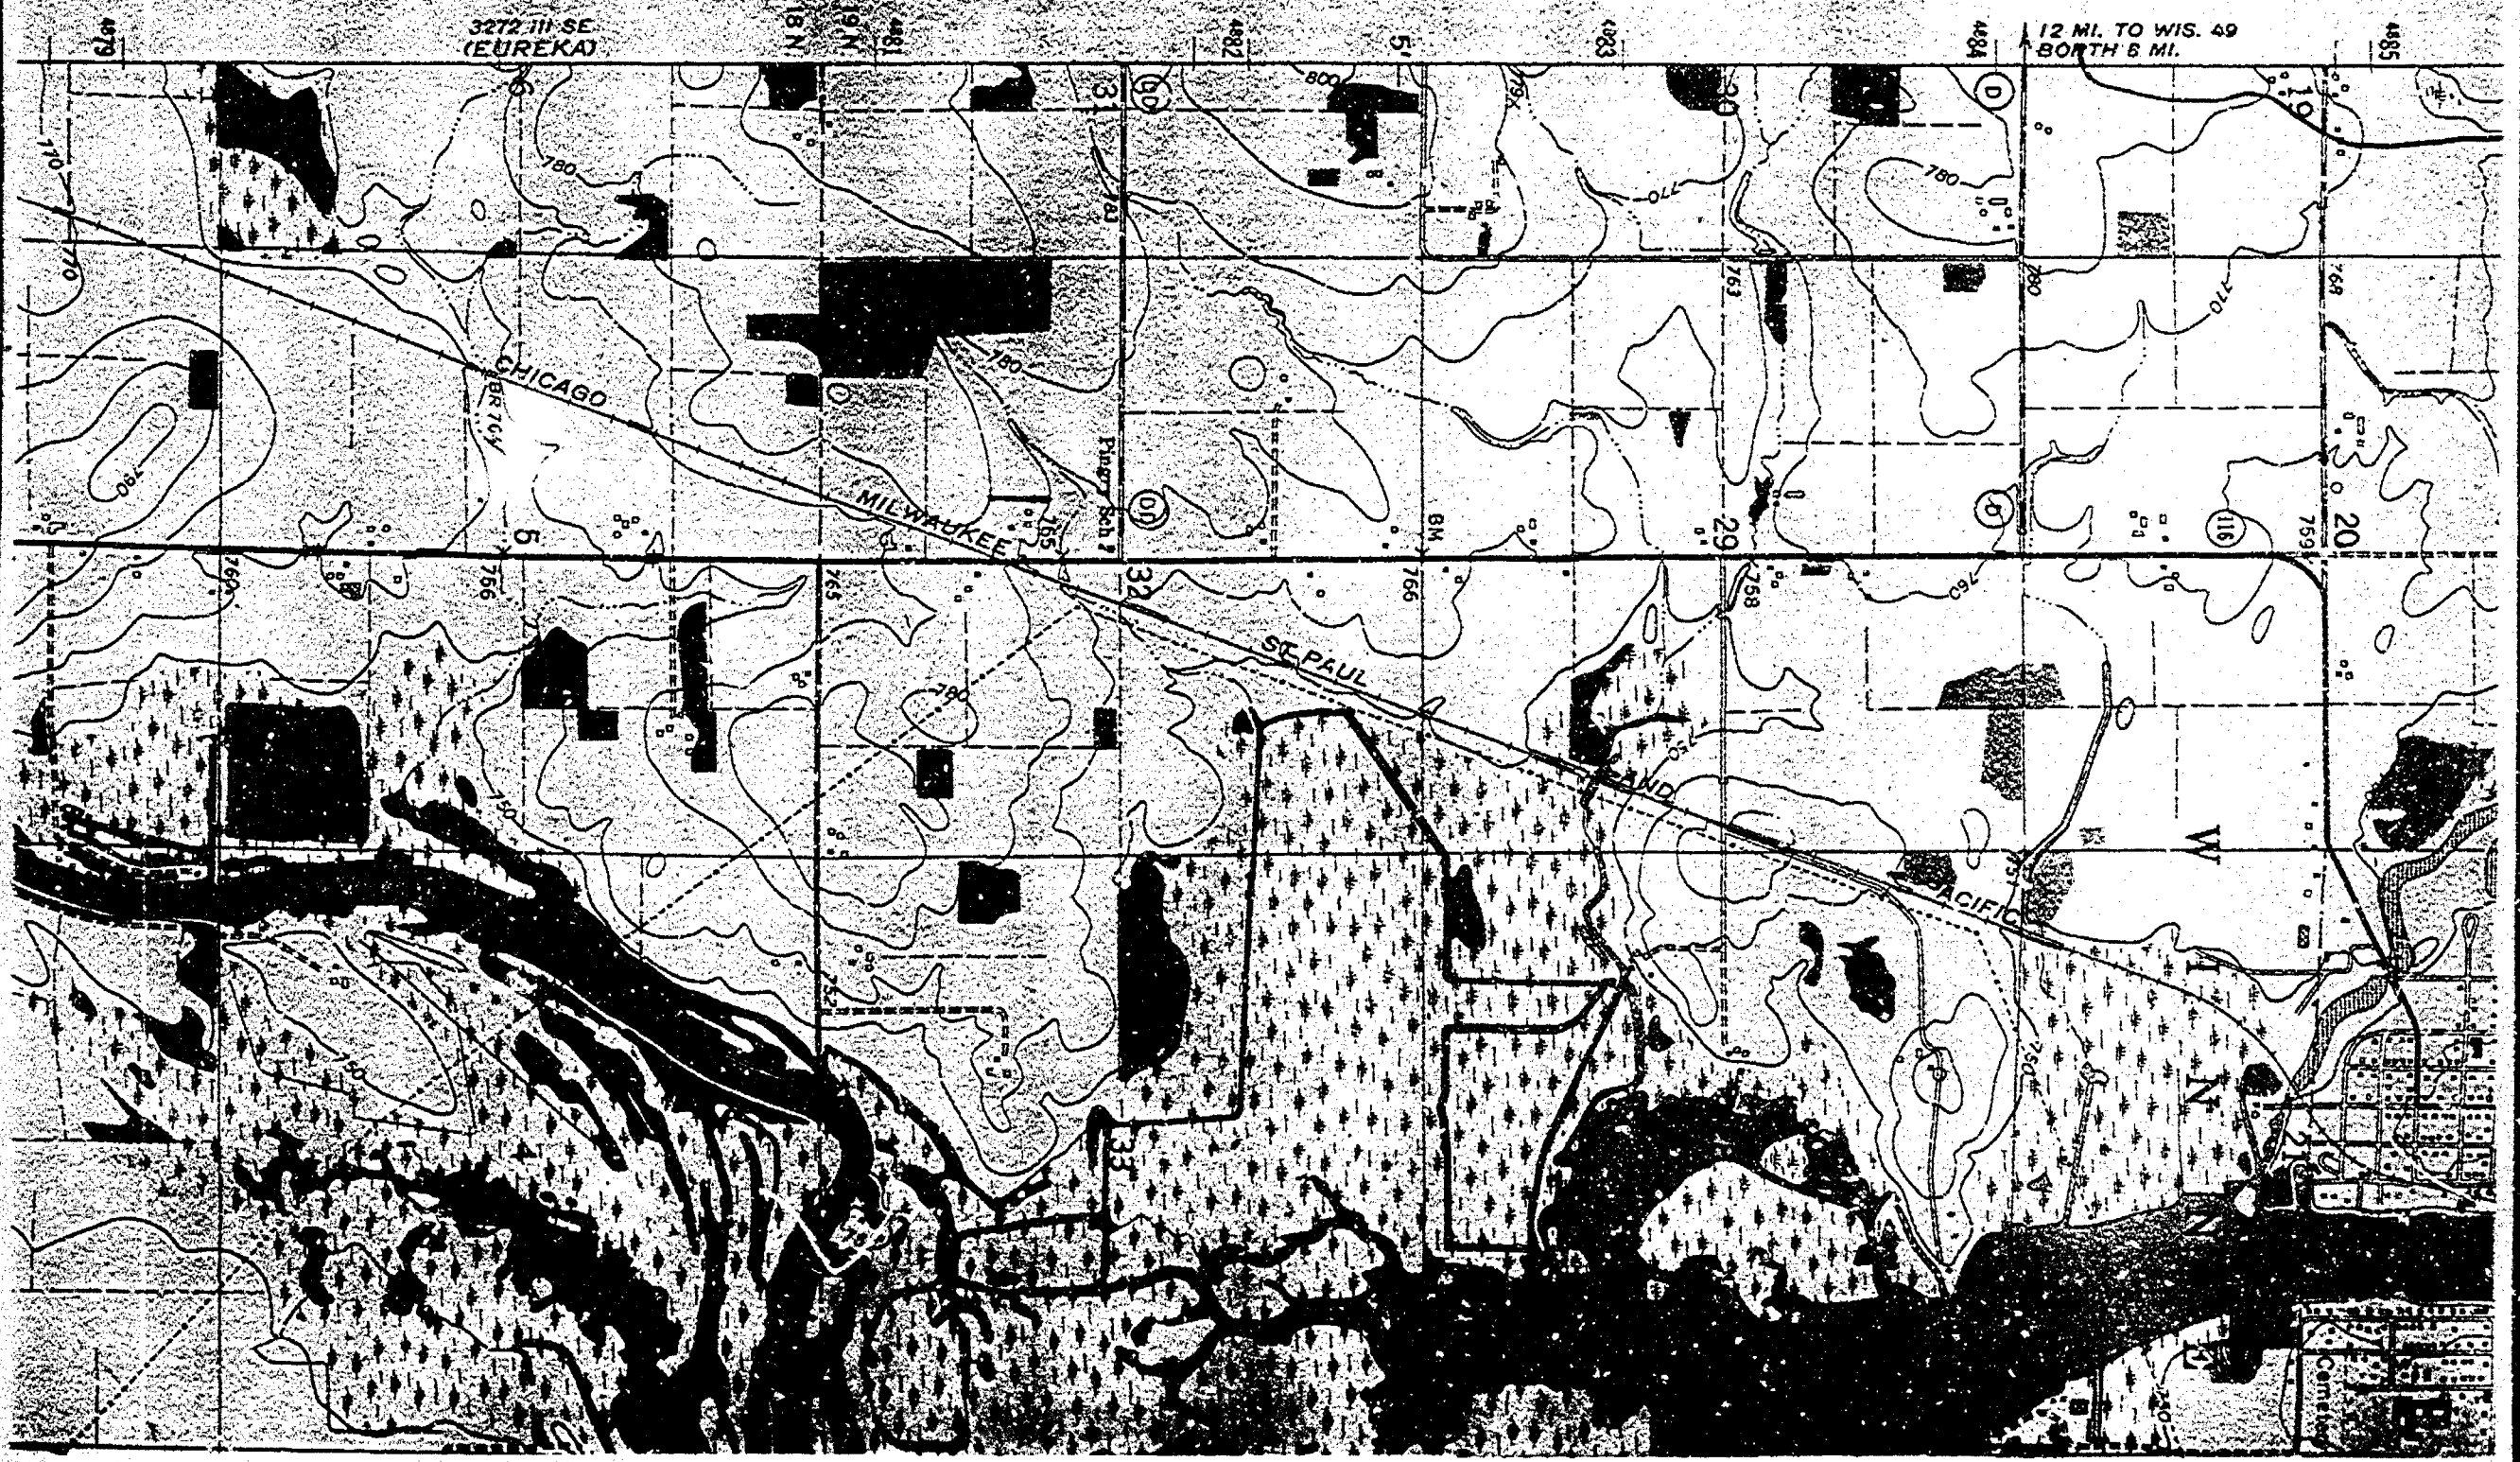


Non-navigable

3272 III SE
(EUREKA)

12 MI. TO WIS. 49
BORTH 8 MI.

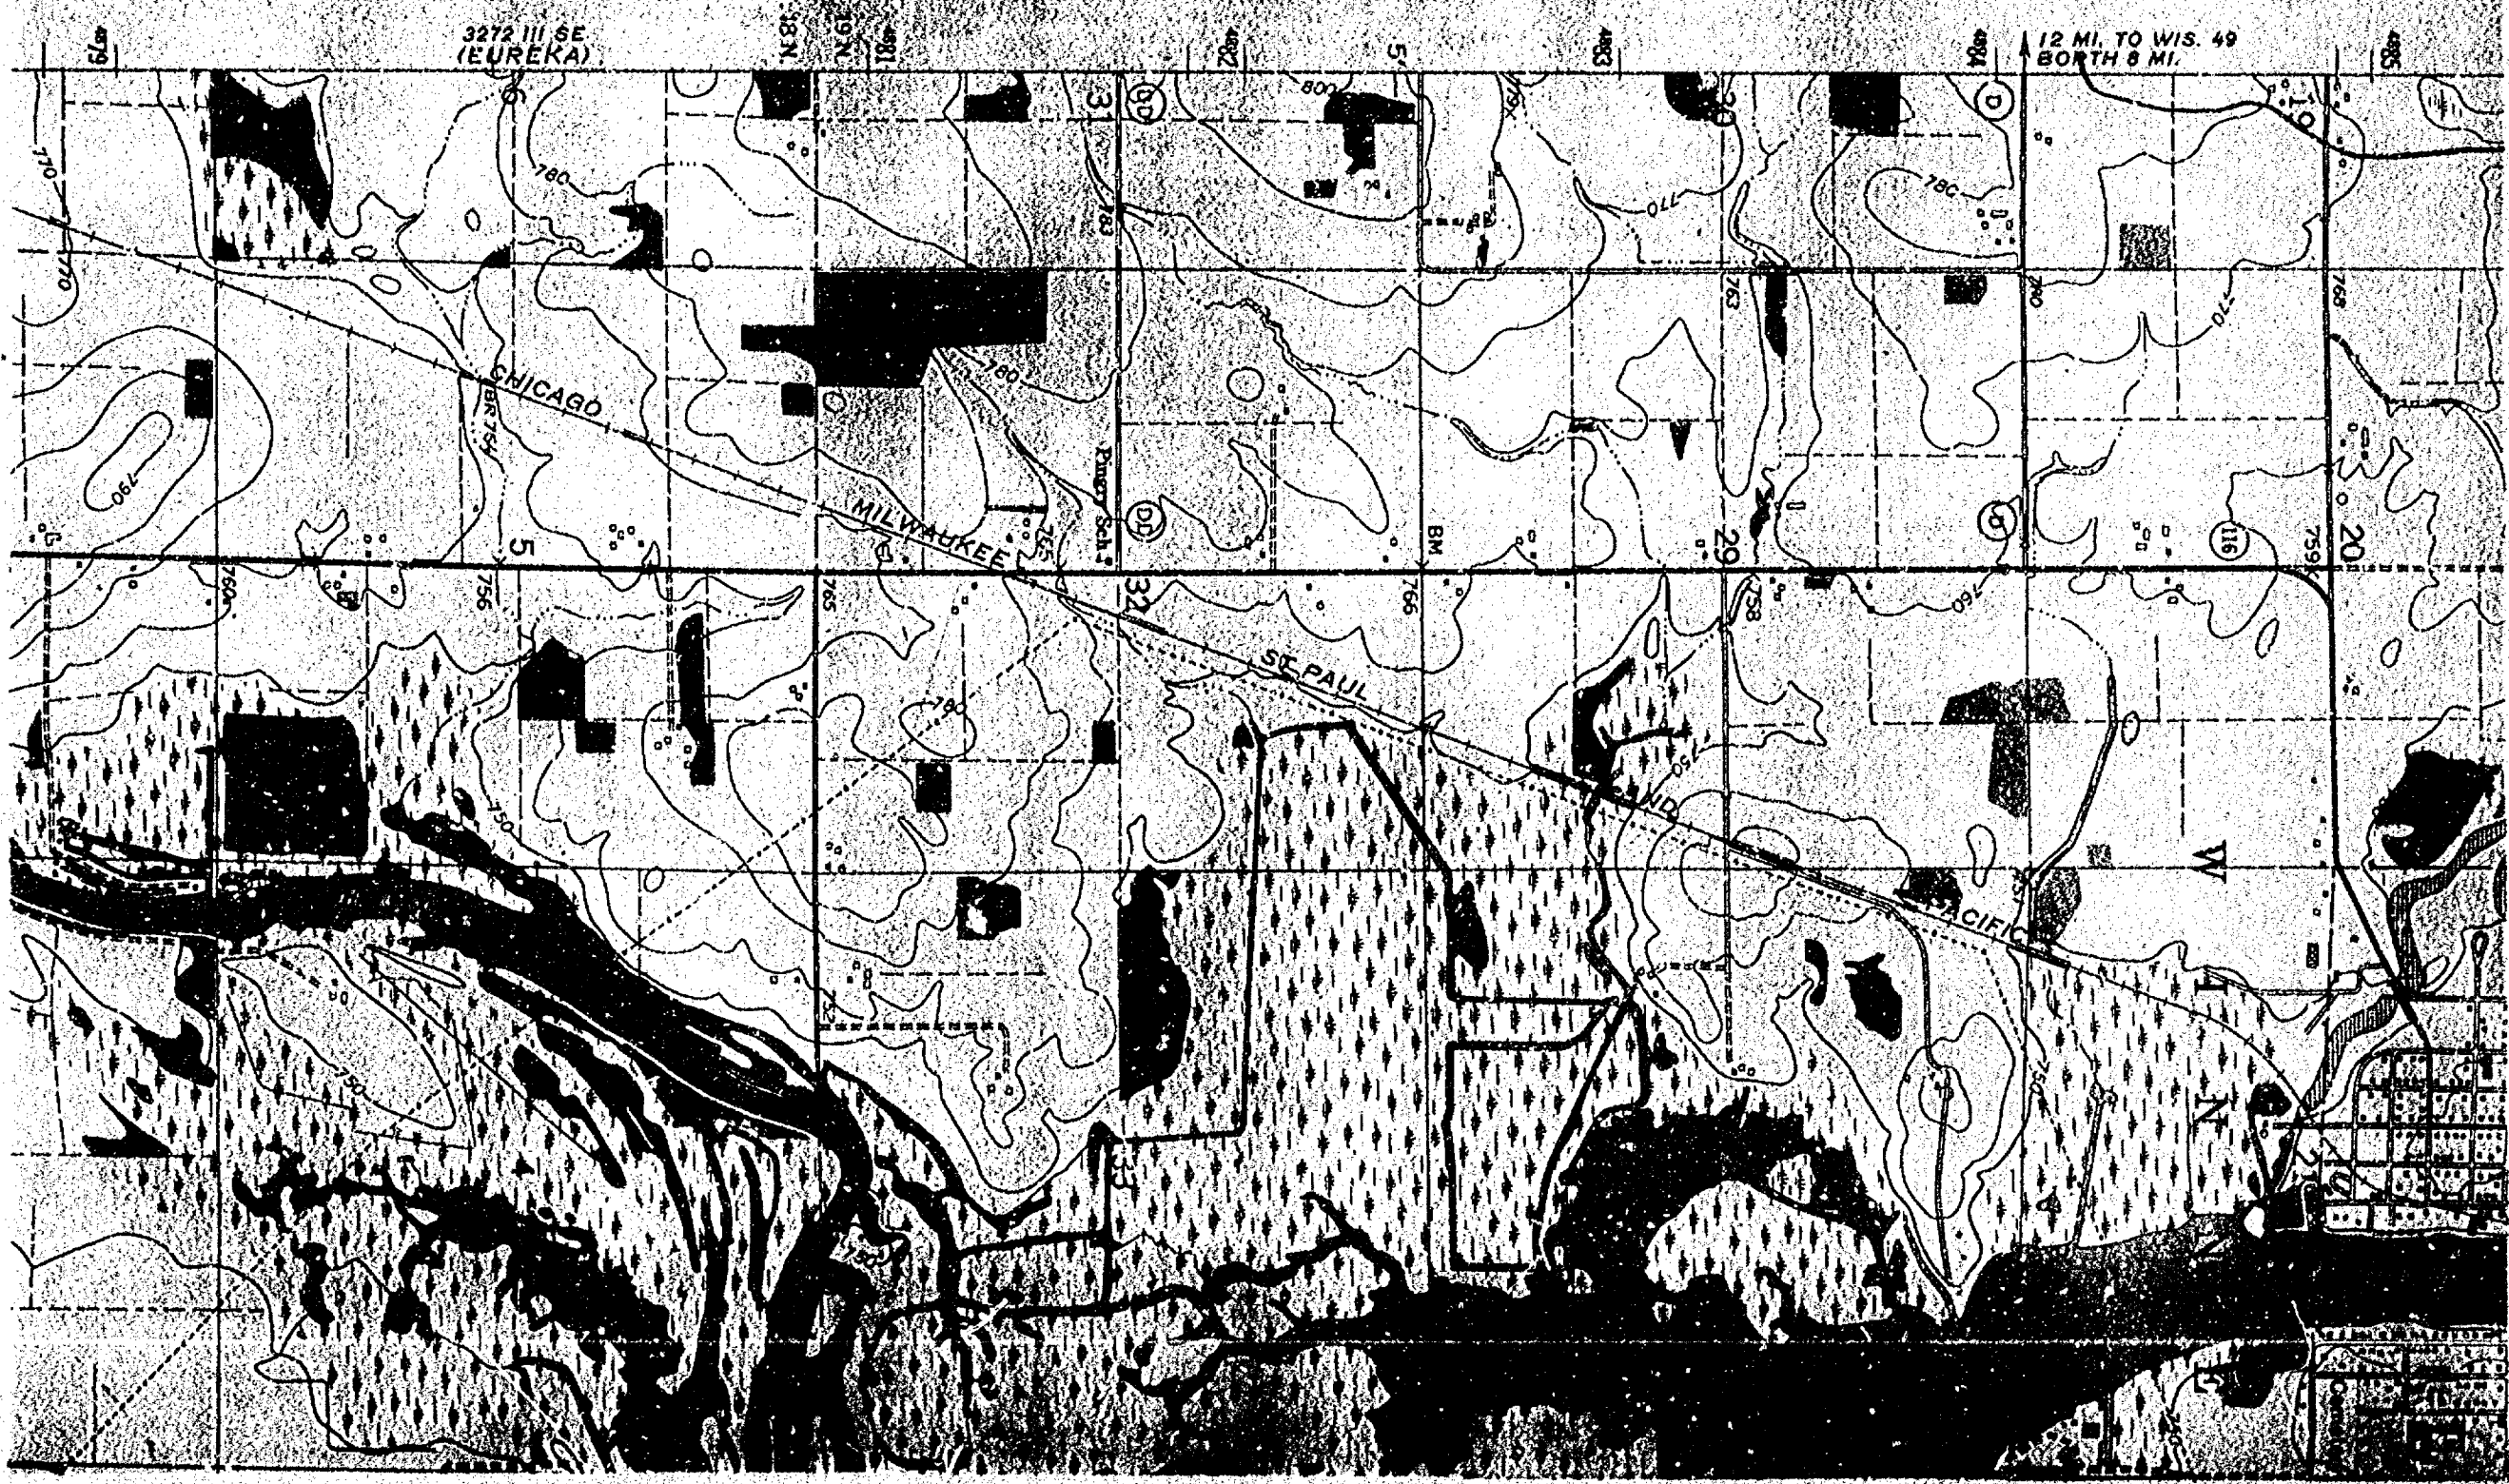

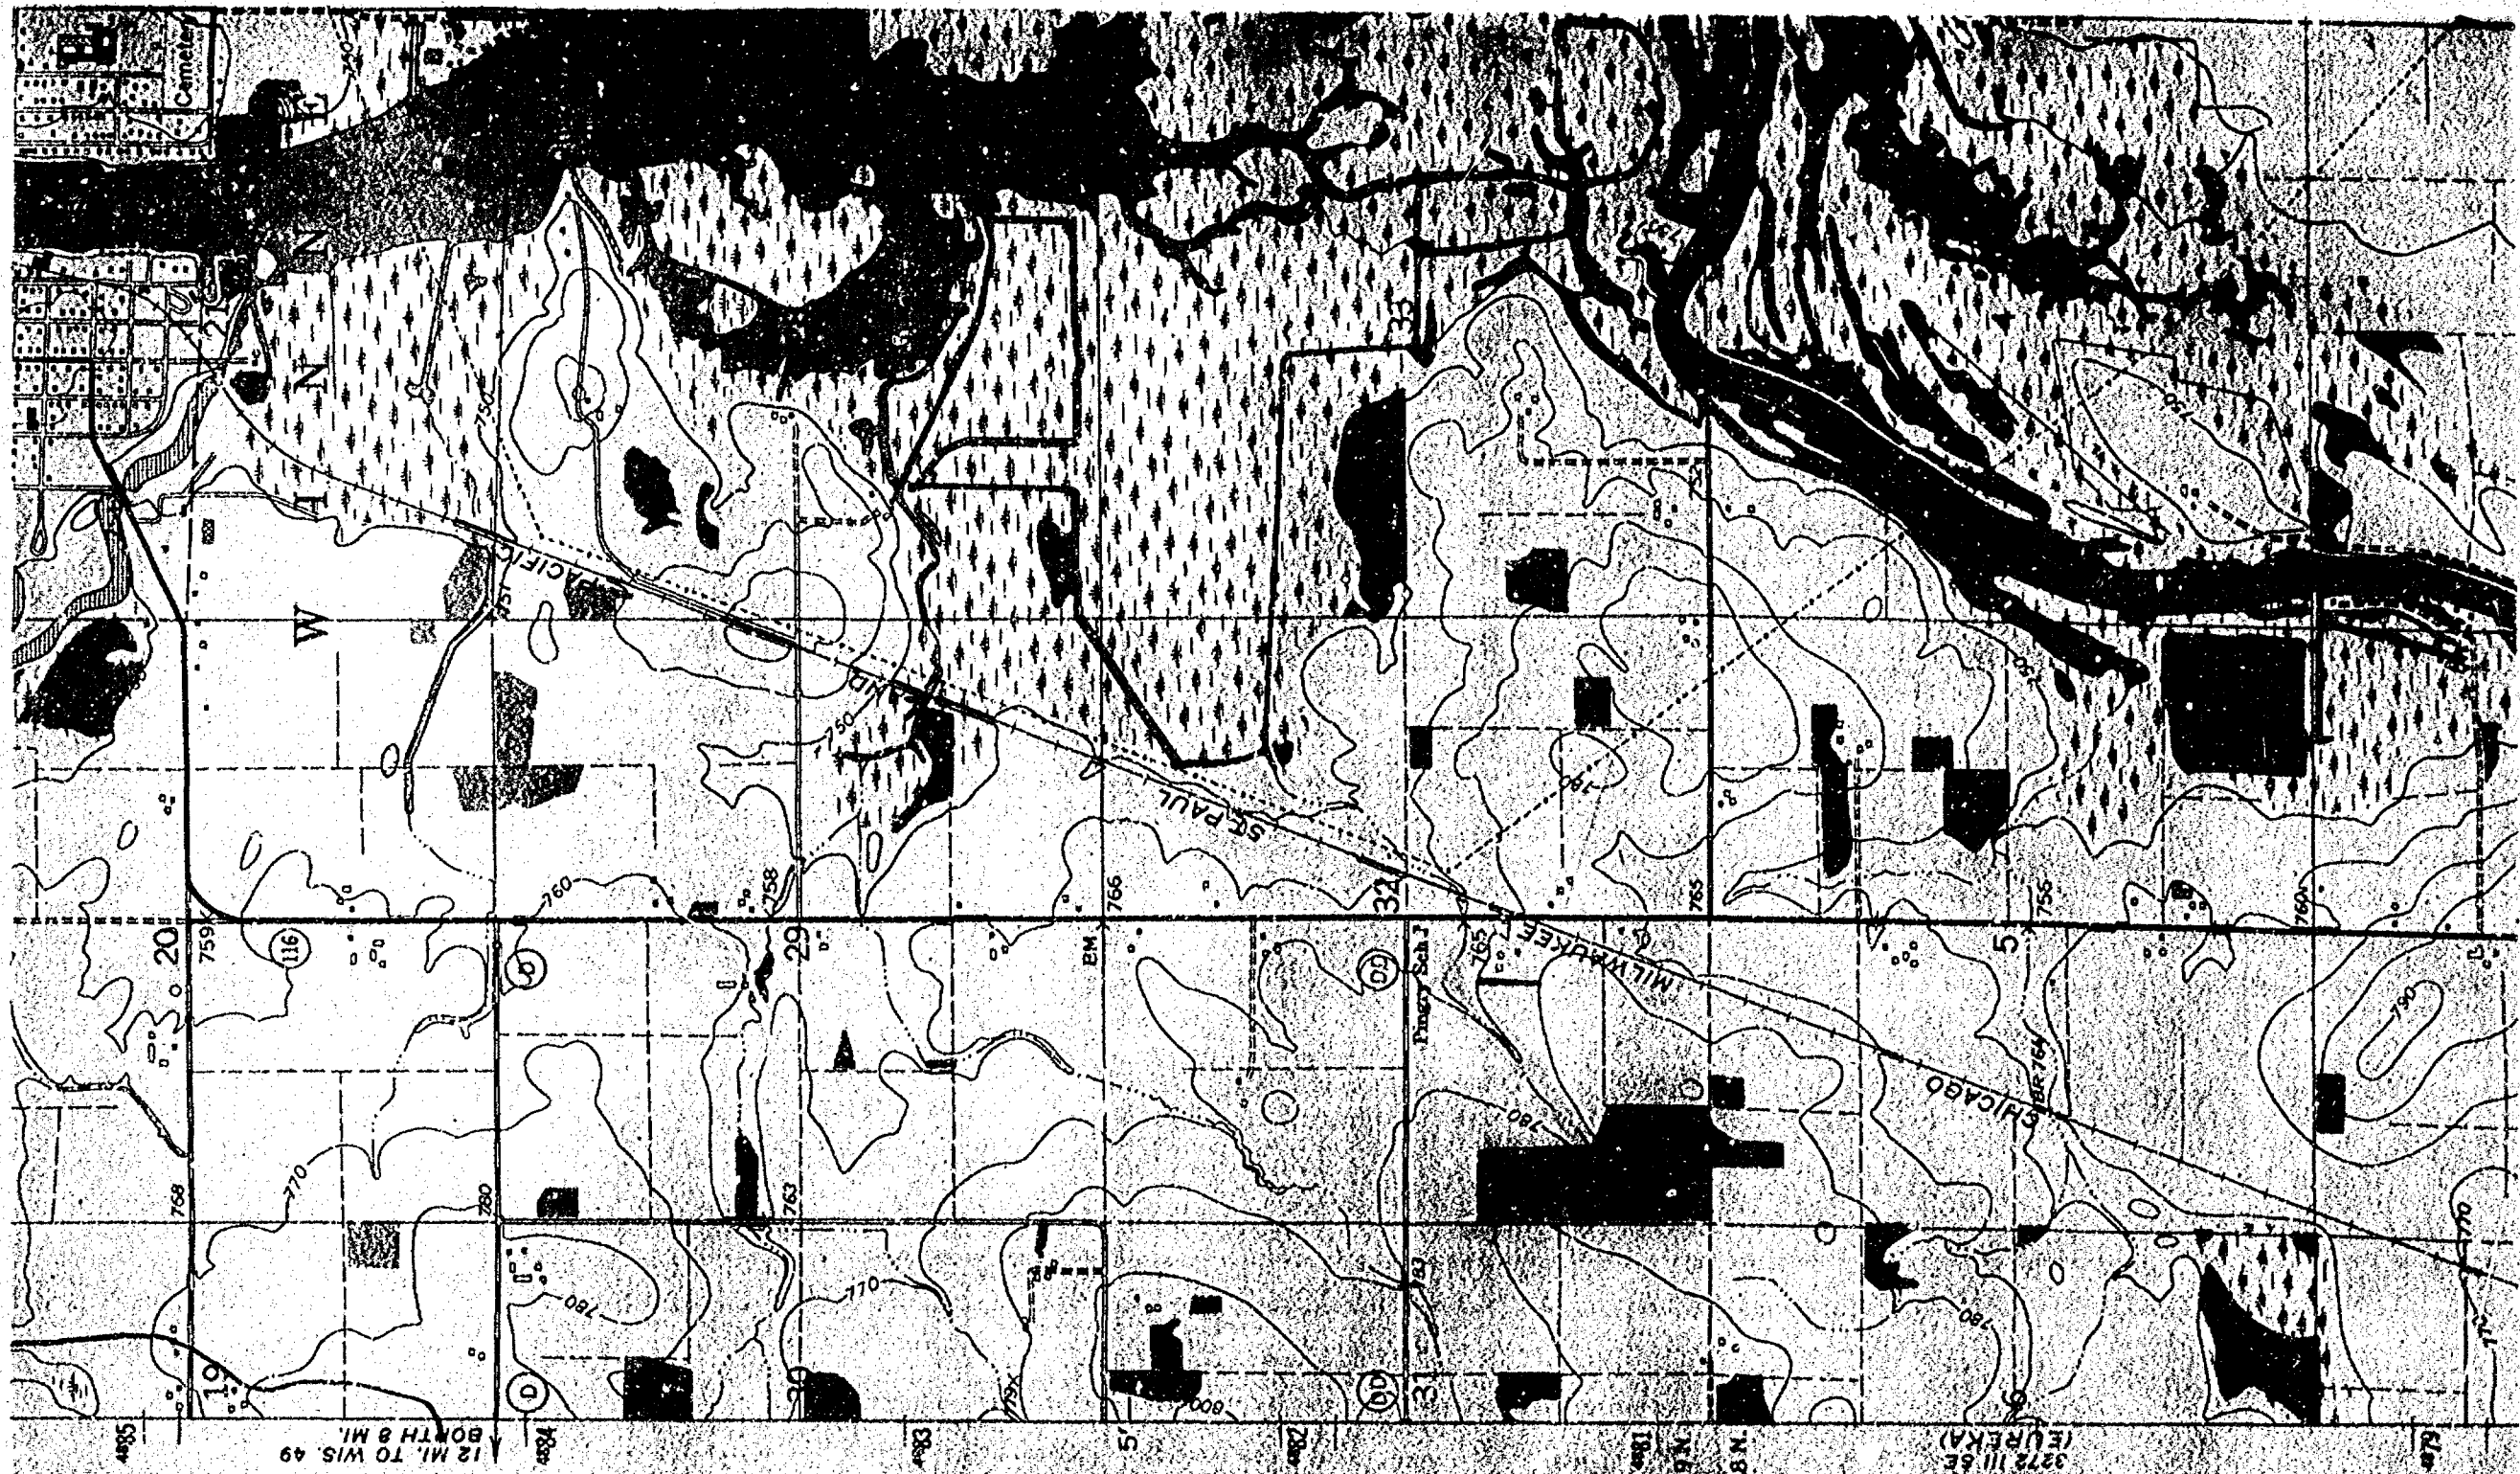

Non-navigable

SEP 13, 1995

TO: Drainage Inspector/Cartographer/Zoning Secretary

FM: Zoning Administrator

RE: Navigability Determination Map Updates

Rick/Diane/Lisa:

Please update the GIS for the following DNR navigability determinations:

1. NW SE, S 32, T 19N, R 15E, WINNECONNE (GONZALES)
2. SE SE, S 08, T 17N, R 14E, NEPEUSKUN (MOE)
3. SW SE, S 18, T 19N, R 14E, POYGAN (WELSCH) NO MAP ATTACHED

Rick: Update USGS Quads

(Identified on Quadrangle)
(Bohn Plat)

Diane: After updating, determine the affected parcels where navigable and attach a list of parcel numbers affected and within 300' so that file 13 can be updated.

Lisa: Update File 13, file in parcel file(s) and microfiche in Surveyors Records according to Section, Town, Range.

USGS Quads Updated Sept 26, 1995 by Rick Haft

GIS Updated 12-12-95 by D. Culver

File 13 Updated 10-22-96 by R. Jank

Verified by Zoning administrator

R. Jank 10/20/96

030-0517
030-0517-01
04-0177
020-0697

check parcels
on #1



George E. Meyer, Secretary
William R. Selbig, District Director

State of Wisconsin | DEPARTMENT OF NATURAL RESOURCES

Oshkosh Area Office

505 Bayshore Drive

Box 2565

Oshkosh, Wisconsin 54903

Telephone #: (414)424-2050

Telefax #: (414)424-4404

August 15, 1995

3500

MIKE GONZALES
1723 ARIZONA ST
OSHKOSH, WI 54901

SUBJECT: Navigability determination of an unnamed stream located in the NW1/4, SE1/4, Section 32, T15N, T18E, Town of Winneconne, Winnebago County.

Dear Mr. Gonzales:

This letter is in request to your navigability determination of an unnamed stream which flows beneath highway 116 south of Oak Hills Road in the Town of Winneconne.

On August 9, 1995 I was at this site and determined the stream to be non-navigable to the east of highway 116 for about 500 feet. There were not defined banks or a bed to meet our definition of navigable.

If you have any questions please contact me at the above address or call me at 414-424-4003.

Sincerely,

Tere Locke


Tere Locke

Water Management Specialist

cc: Ron Faasbender
Robert Braun



NON NAVIGABLE

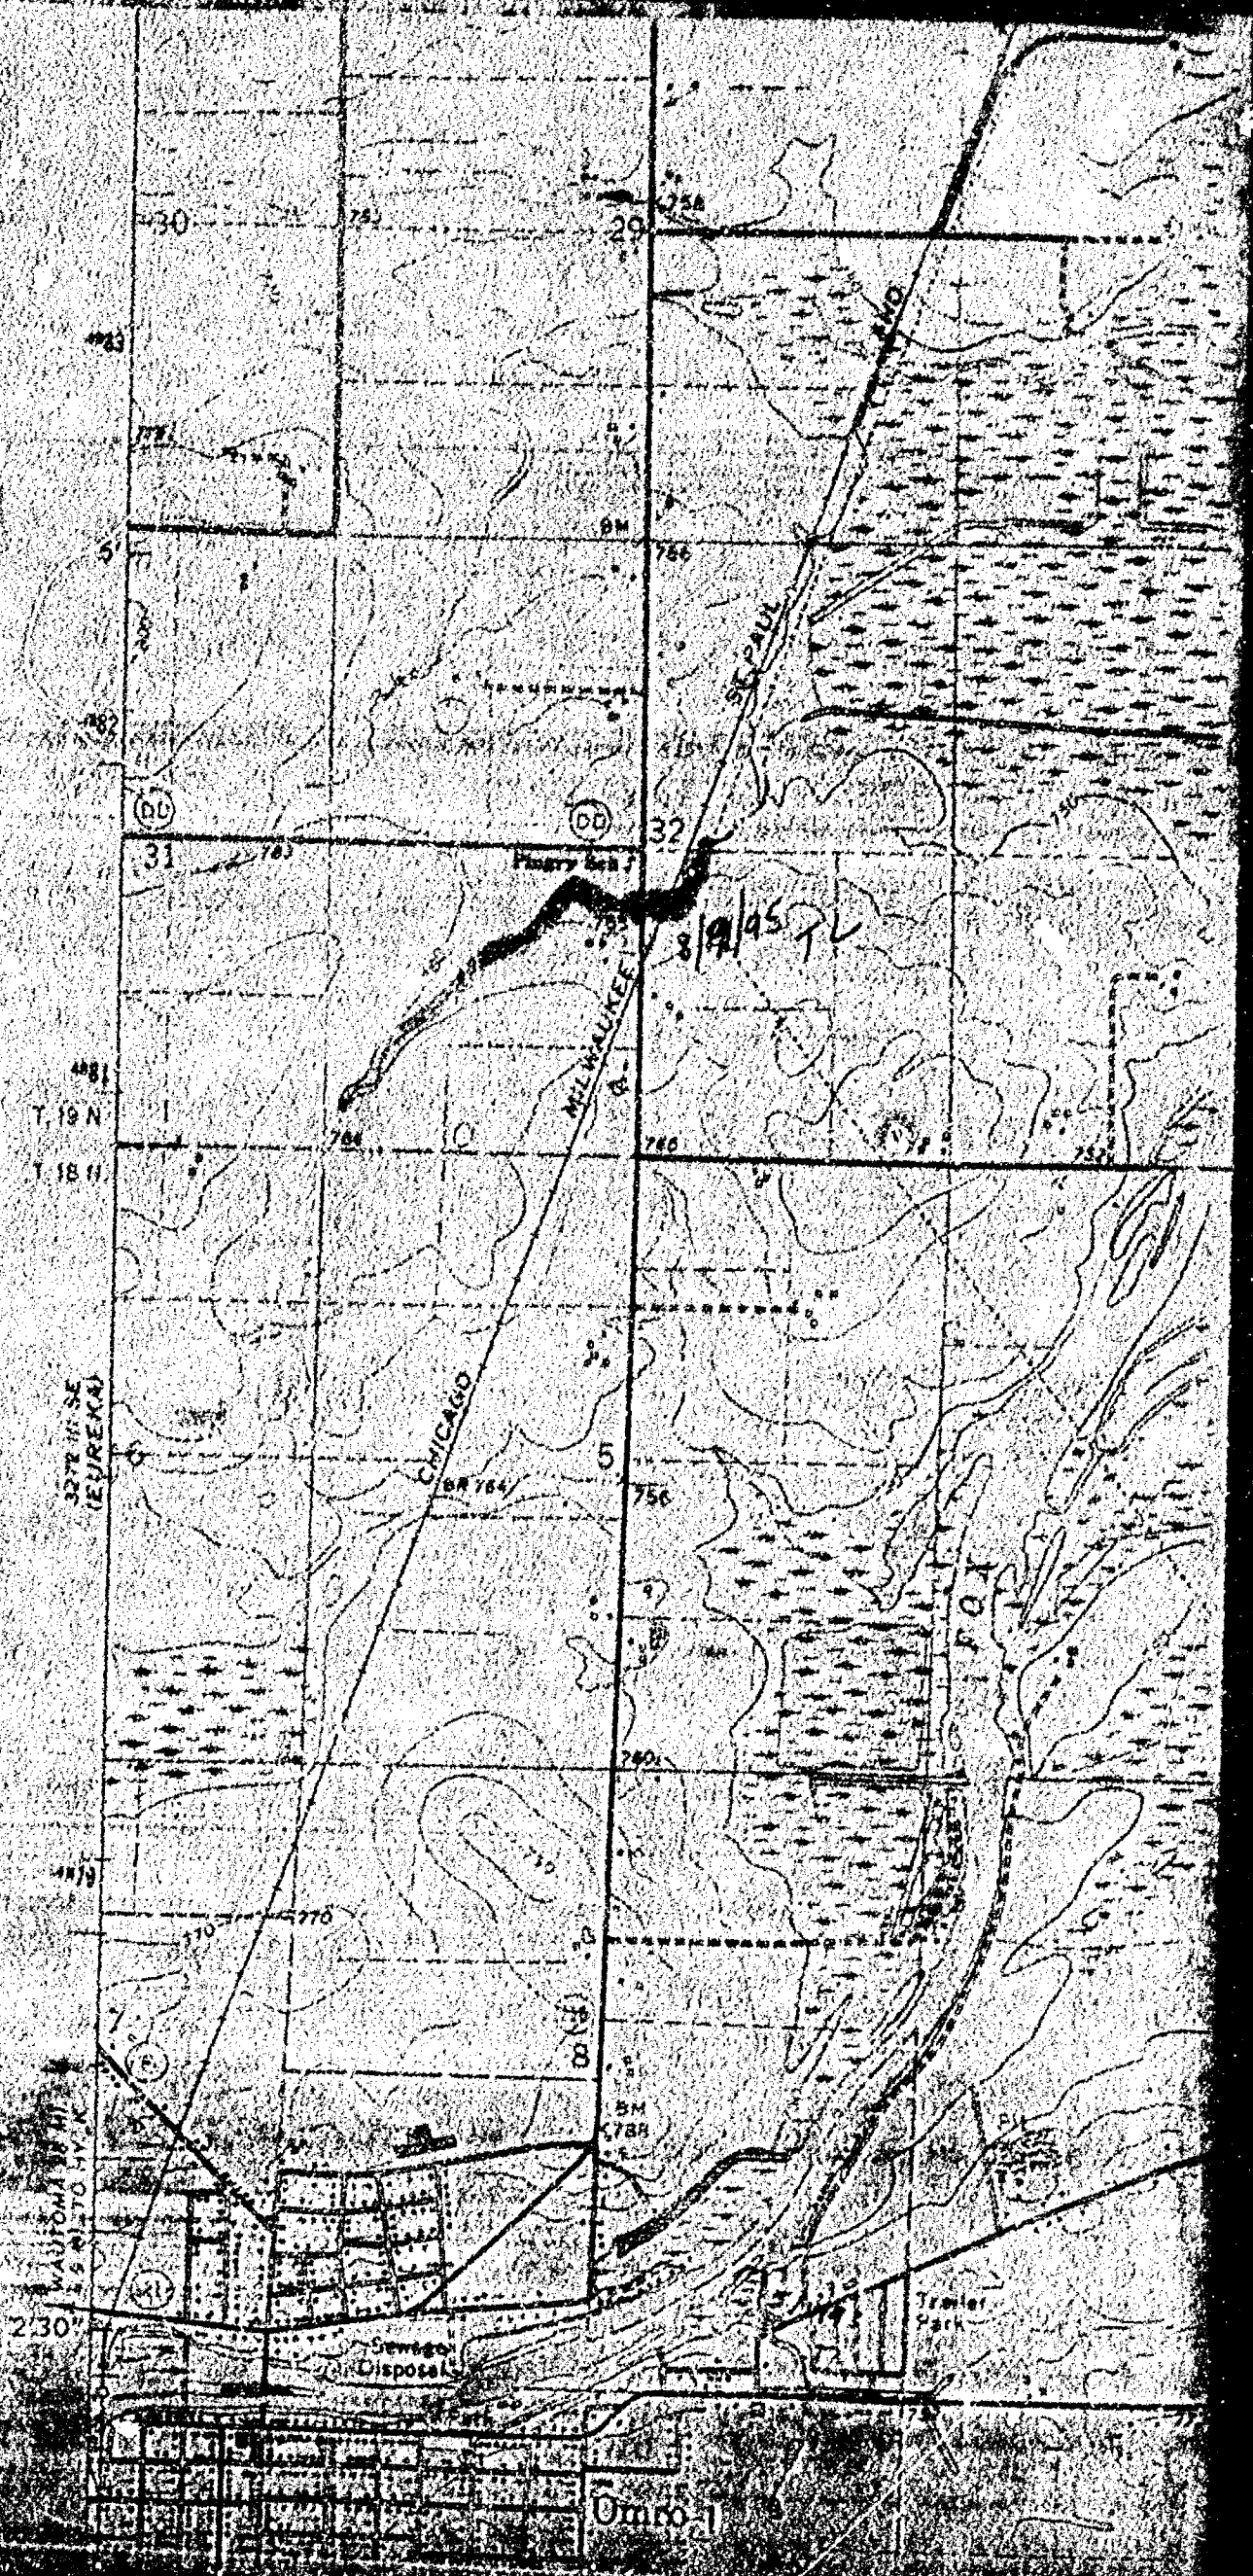



George E. Meyer, Secretary
William R. Seibig, District Director

State of Wisconsin | DEPARTMENT OF NATURAL RESOURCES

RECEIVED

SEP 16 1994

Oshkosh Area Office
905 Bayshore Drive
Box 2666

Oshkosh, Wisconsin 54903
Telephone #1 (414) 224-3050
Teletex #1 (414) 424-4404

September 14, 1994

WINNEBAGO COUNTY
PLANNING DEPT

3500

EMERAN J PETRACK
2 N 5TH ST
WINNECONNE, WI 54986

SUBJECT: Navigability determination of an unnamed creek located in the SW1/4, Section 12, T19N, R15E, Town of Winneconne, Winnebago County.

Dear Mr. Petrack:

This letter is in response to your request for a navigability determination of an unnamed creek located south of Oak Hills Road and west of highway 116 in the Town of Winneconne.

On September 13, 1994 I located this creek and determined it to be non-navigable to the west of highway 116. A permit is required from the Department to dredge this creek, if that is ever considered.

This small creek is also bordered by wetlands which would require a U.S. Army Corps permit if alterations are anticipated. You should contact Gary Knapton, telephone, 414-448-2824. If an Army Corps permit is required the Department must review that permit and has authority to grant or deny water quality certification.

If you have any questions please contact me at the above address or call me at 414-424-4003.

Sincerely,

Tere Locke

Tere Locke
Water Management Specialist

cc: Ron Fassbender
Robert Braun