


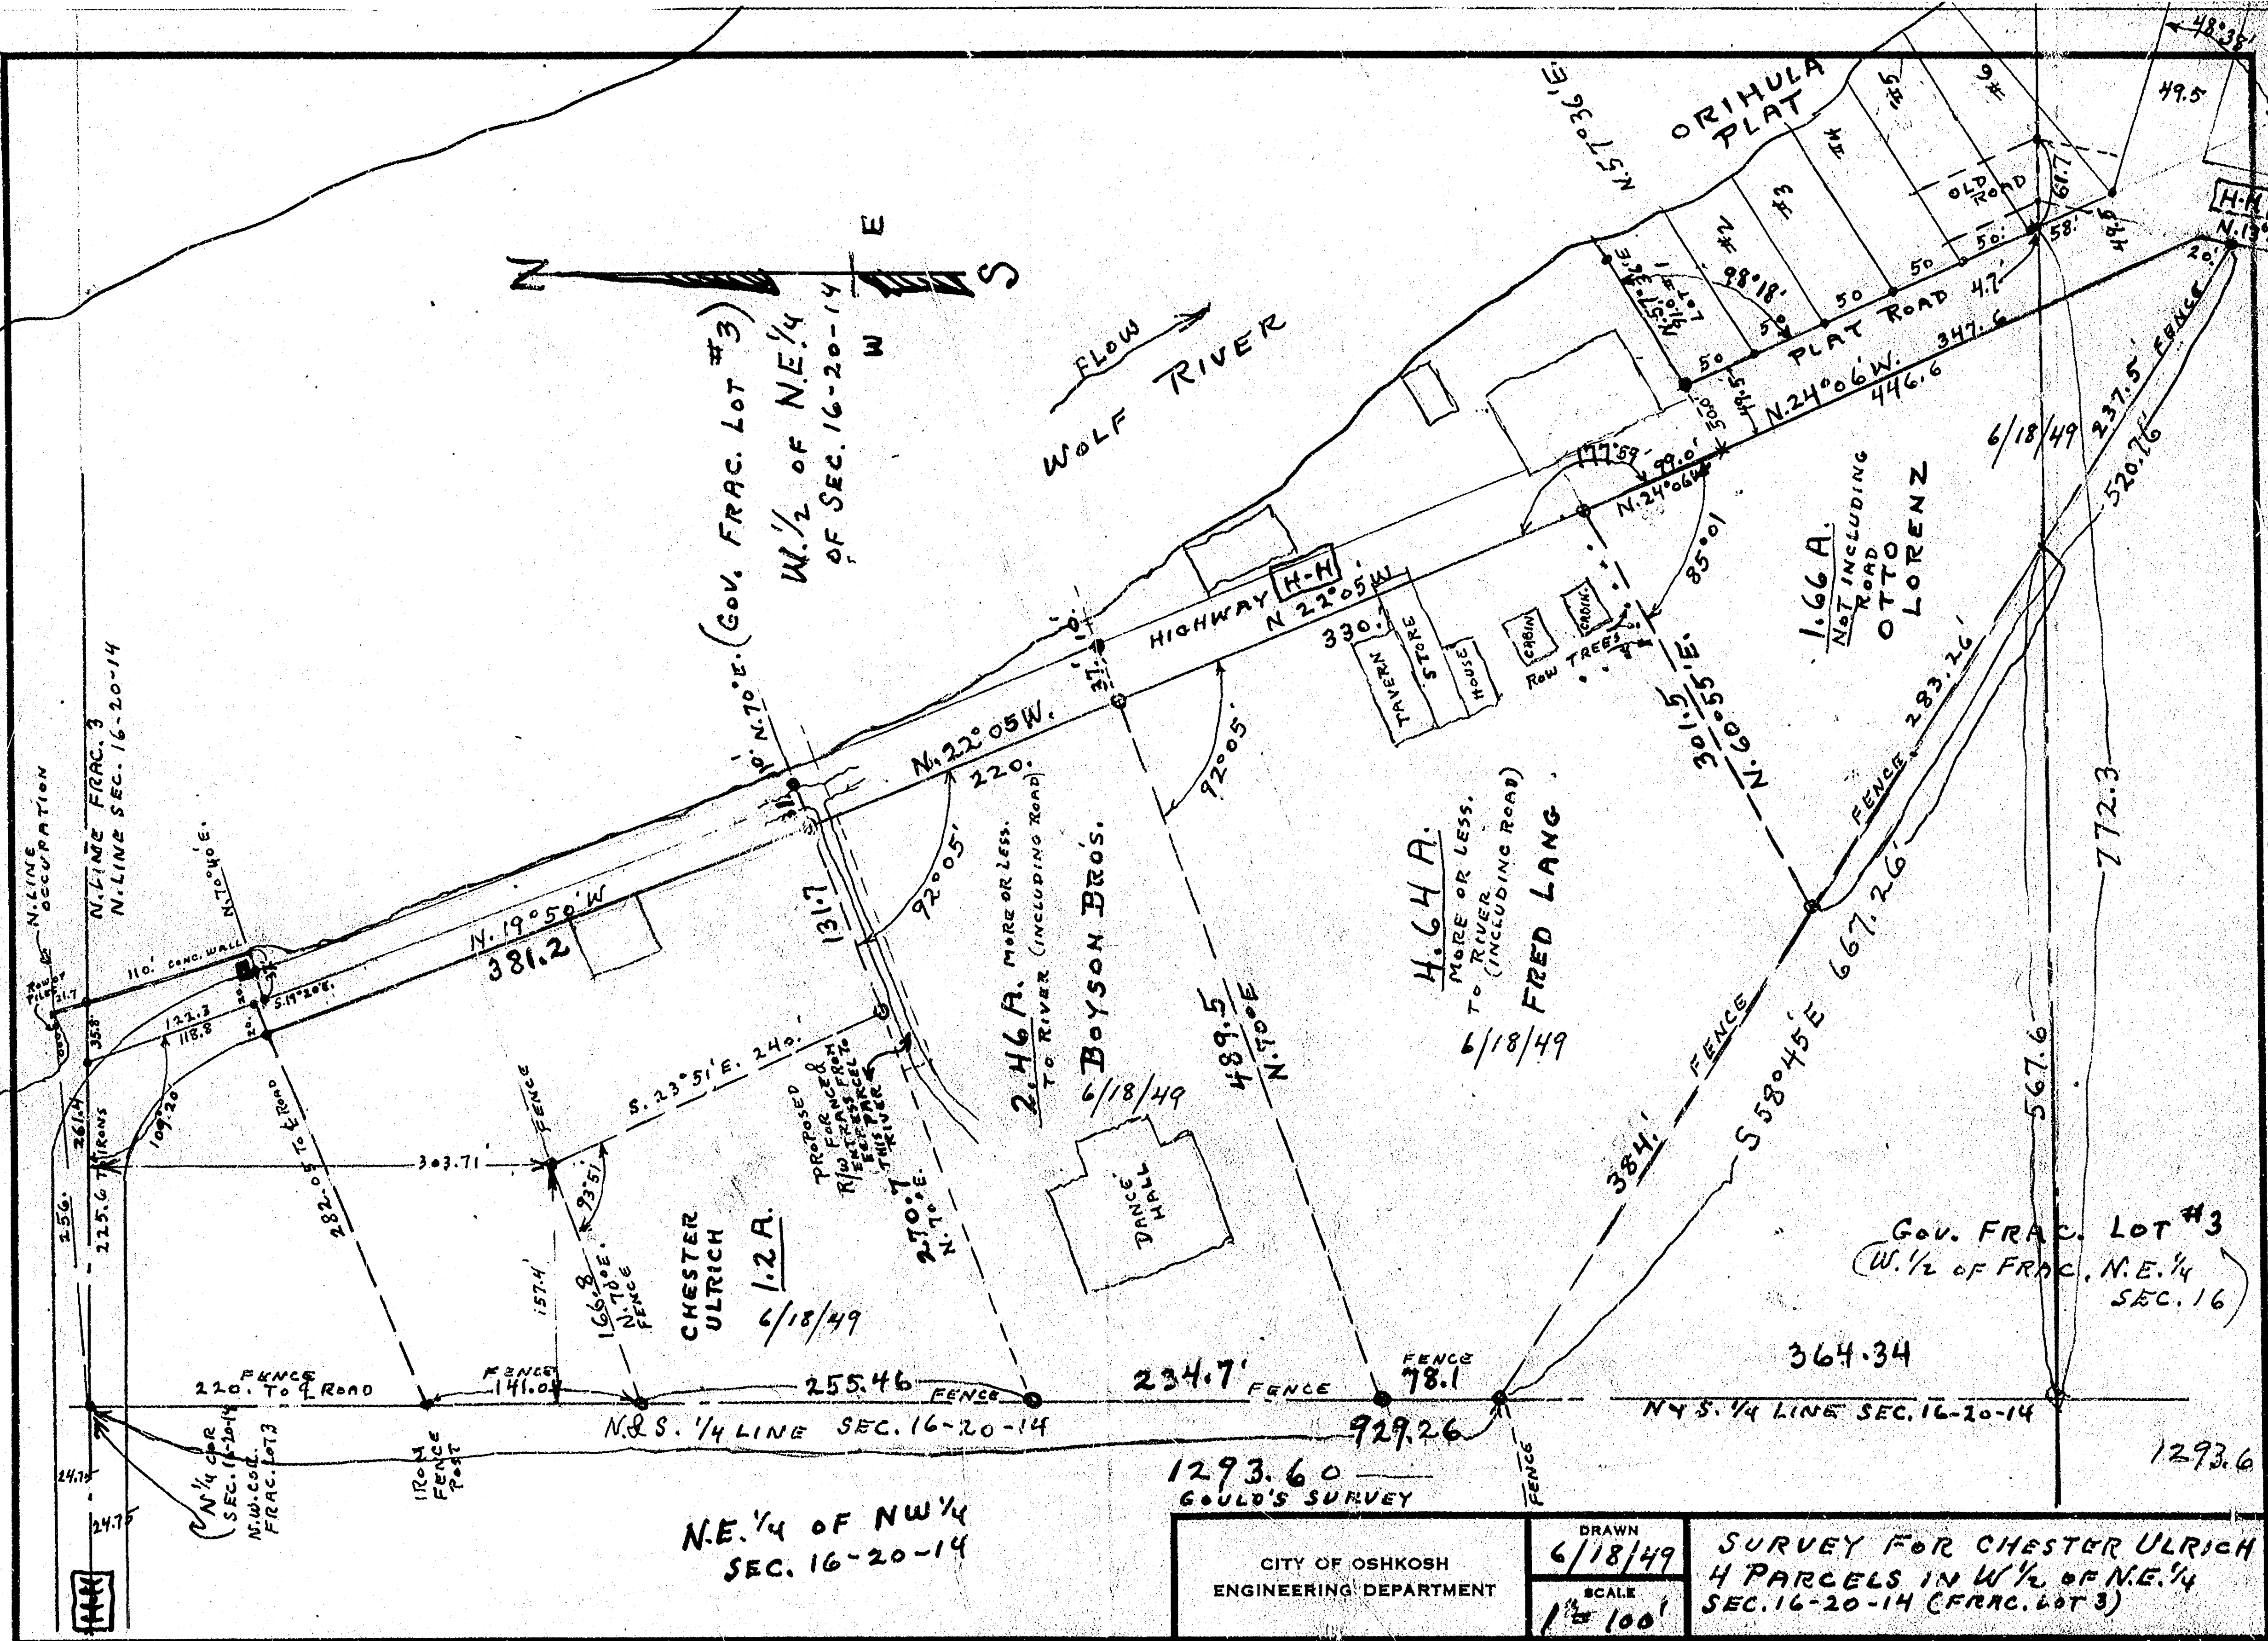


N.E. 1/4 of NW 1/4
SEC. 16-20-14

1293.60
GOULD'S SURVEY

CITY OF OSHKOSH ENGINEERING DEPARTMENT	DRAWN 6/18/49	SURVEY FOR CHESTER ULRICH 4 PARCELS IN W 1/2 OF N.E. 1/4 SEC. 16-20-14 (FRAC. LOT 3)
	SCALE 1" = 100'	


16-20-14 ORIHULA (TOWN WOLF RIVER) SEC. 16

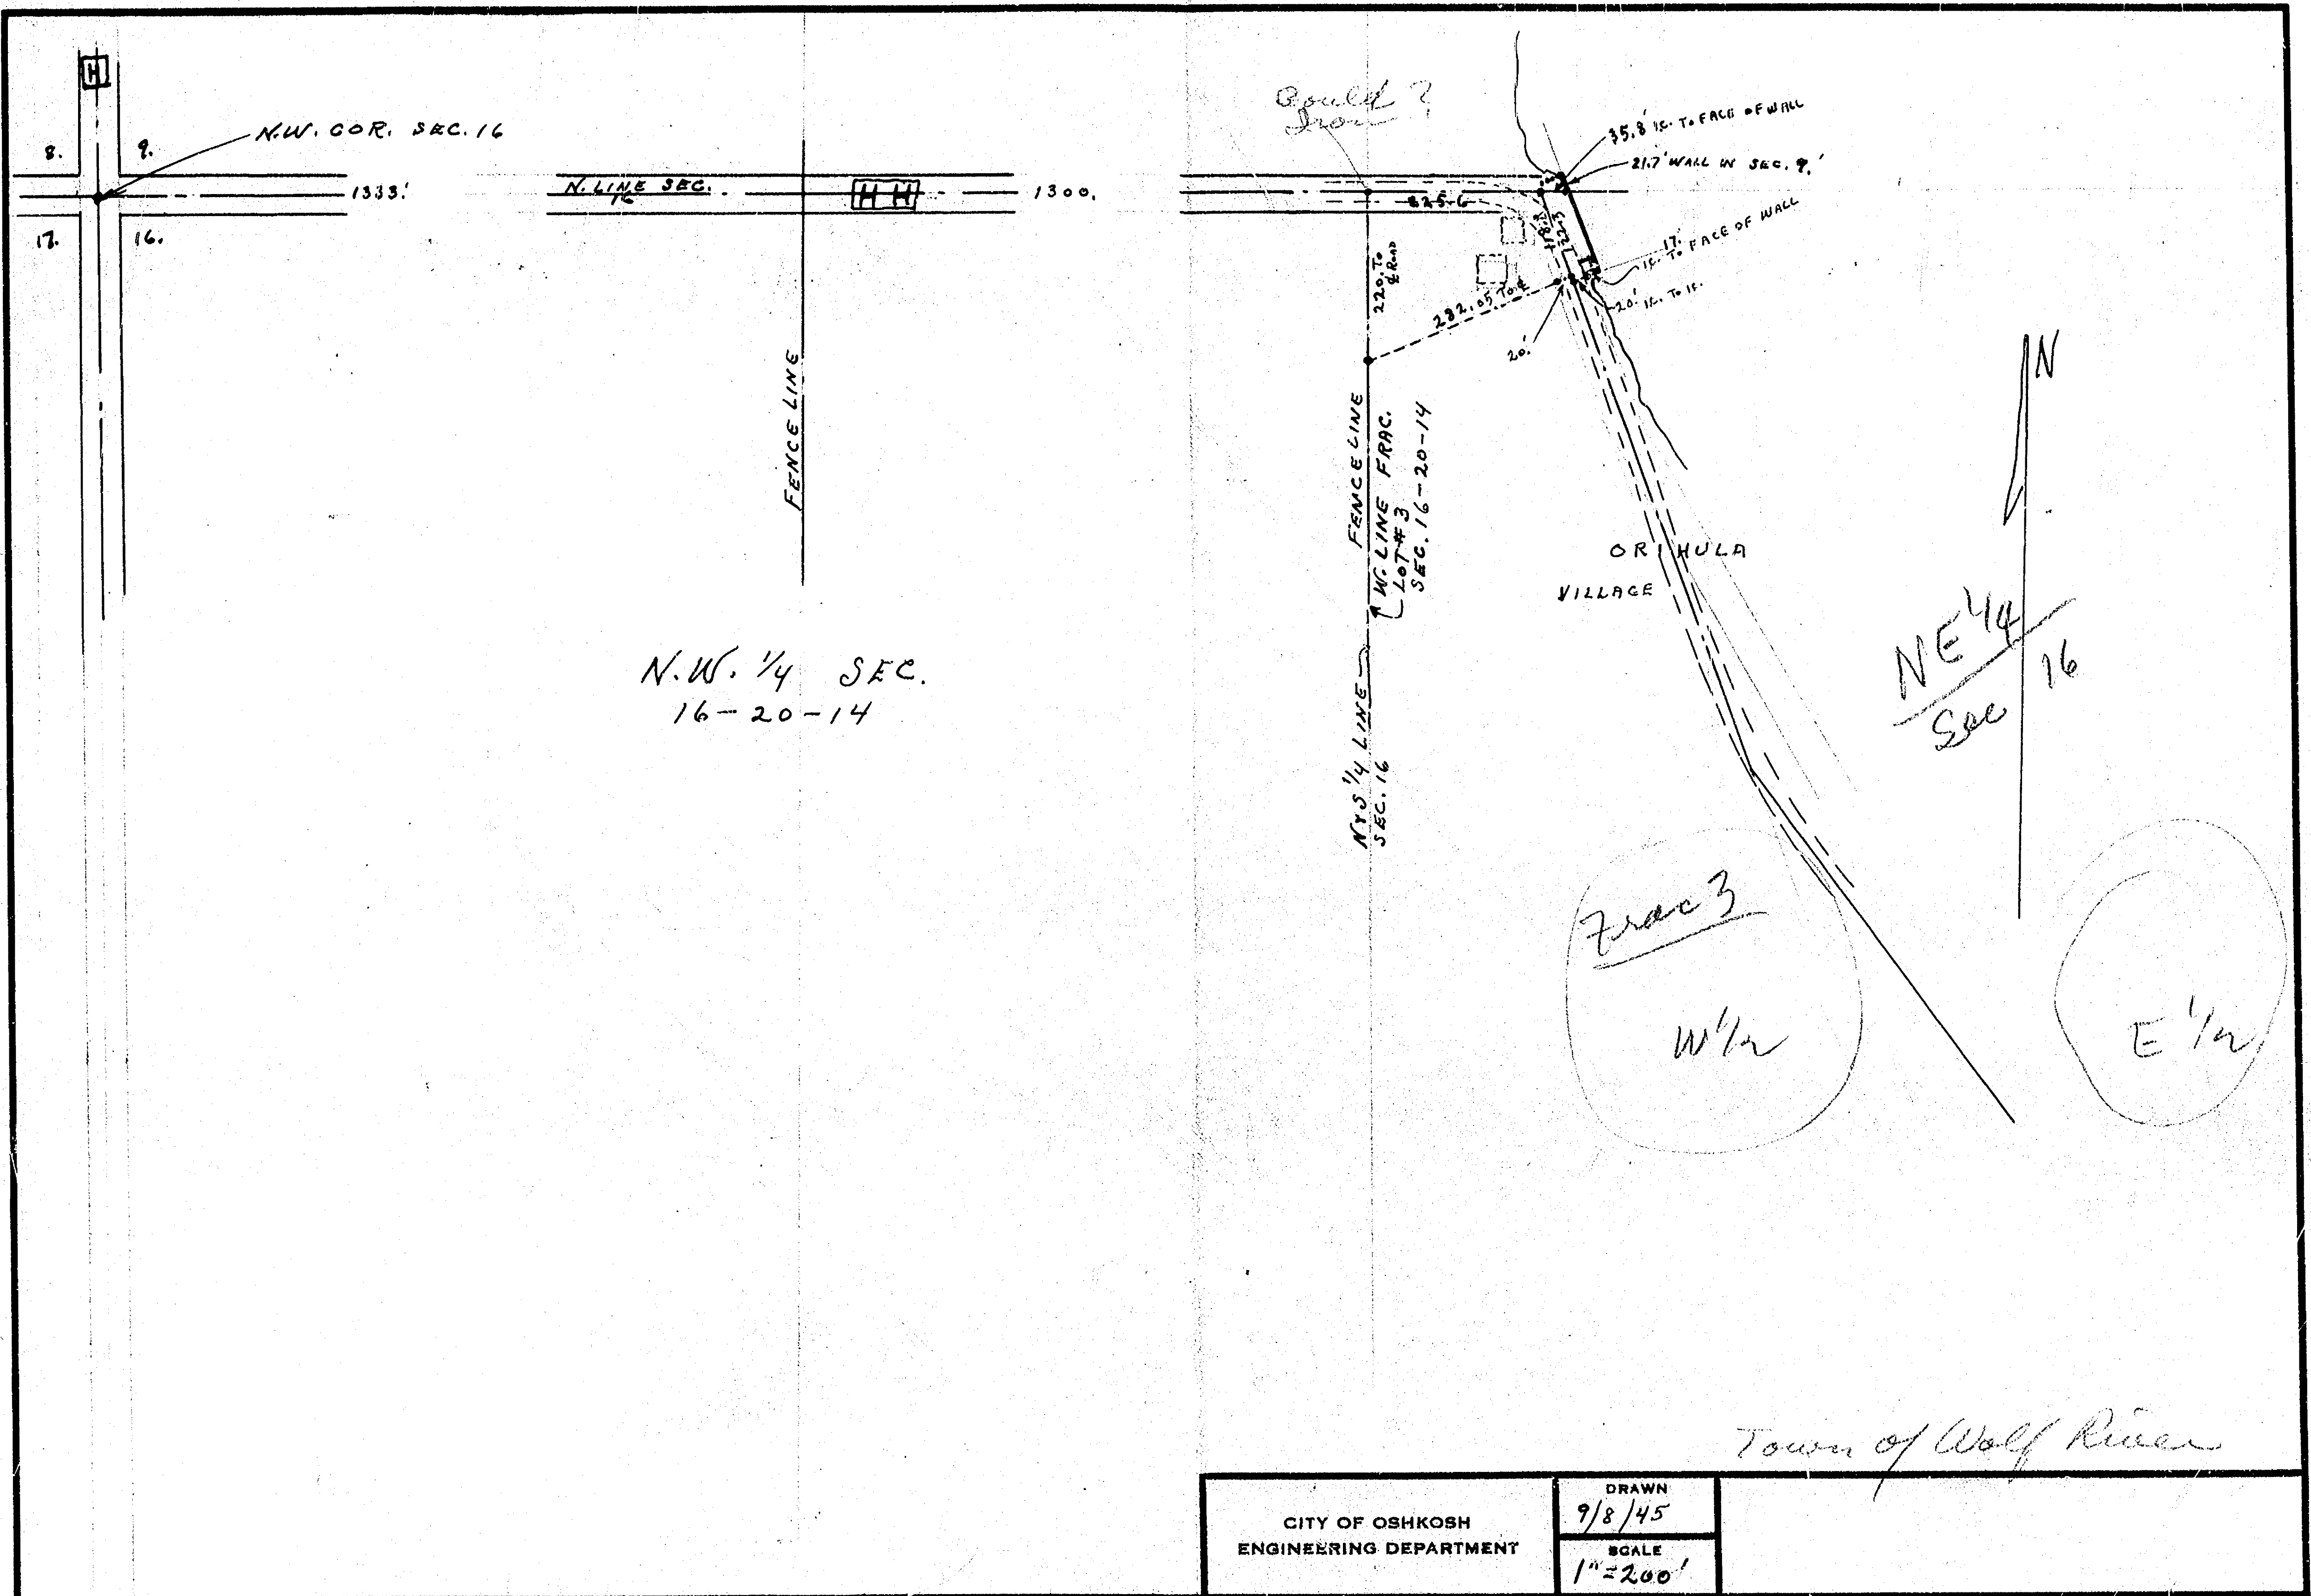

16-20-14

Sec 16

Sec Line bet sec 16 and 17
HIGHWAY

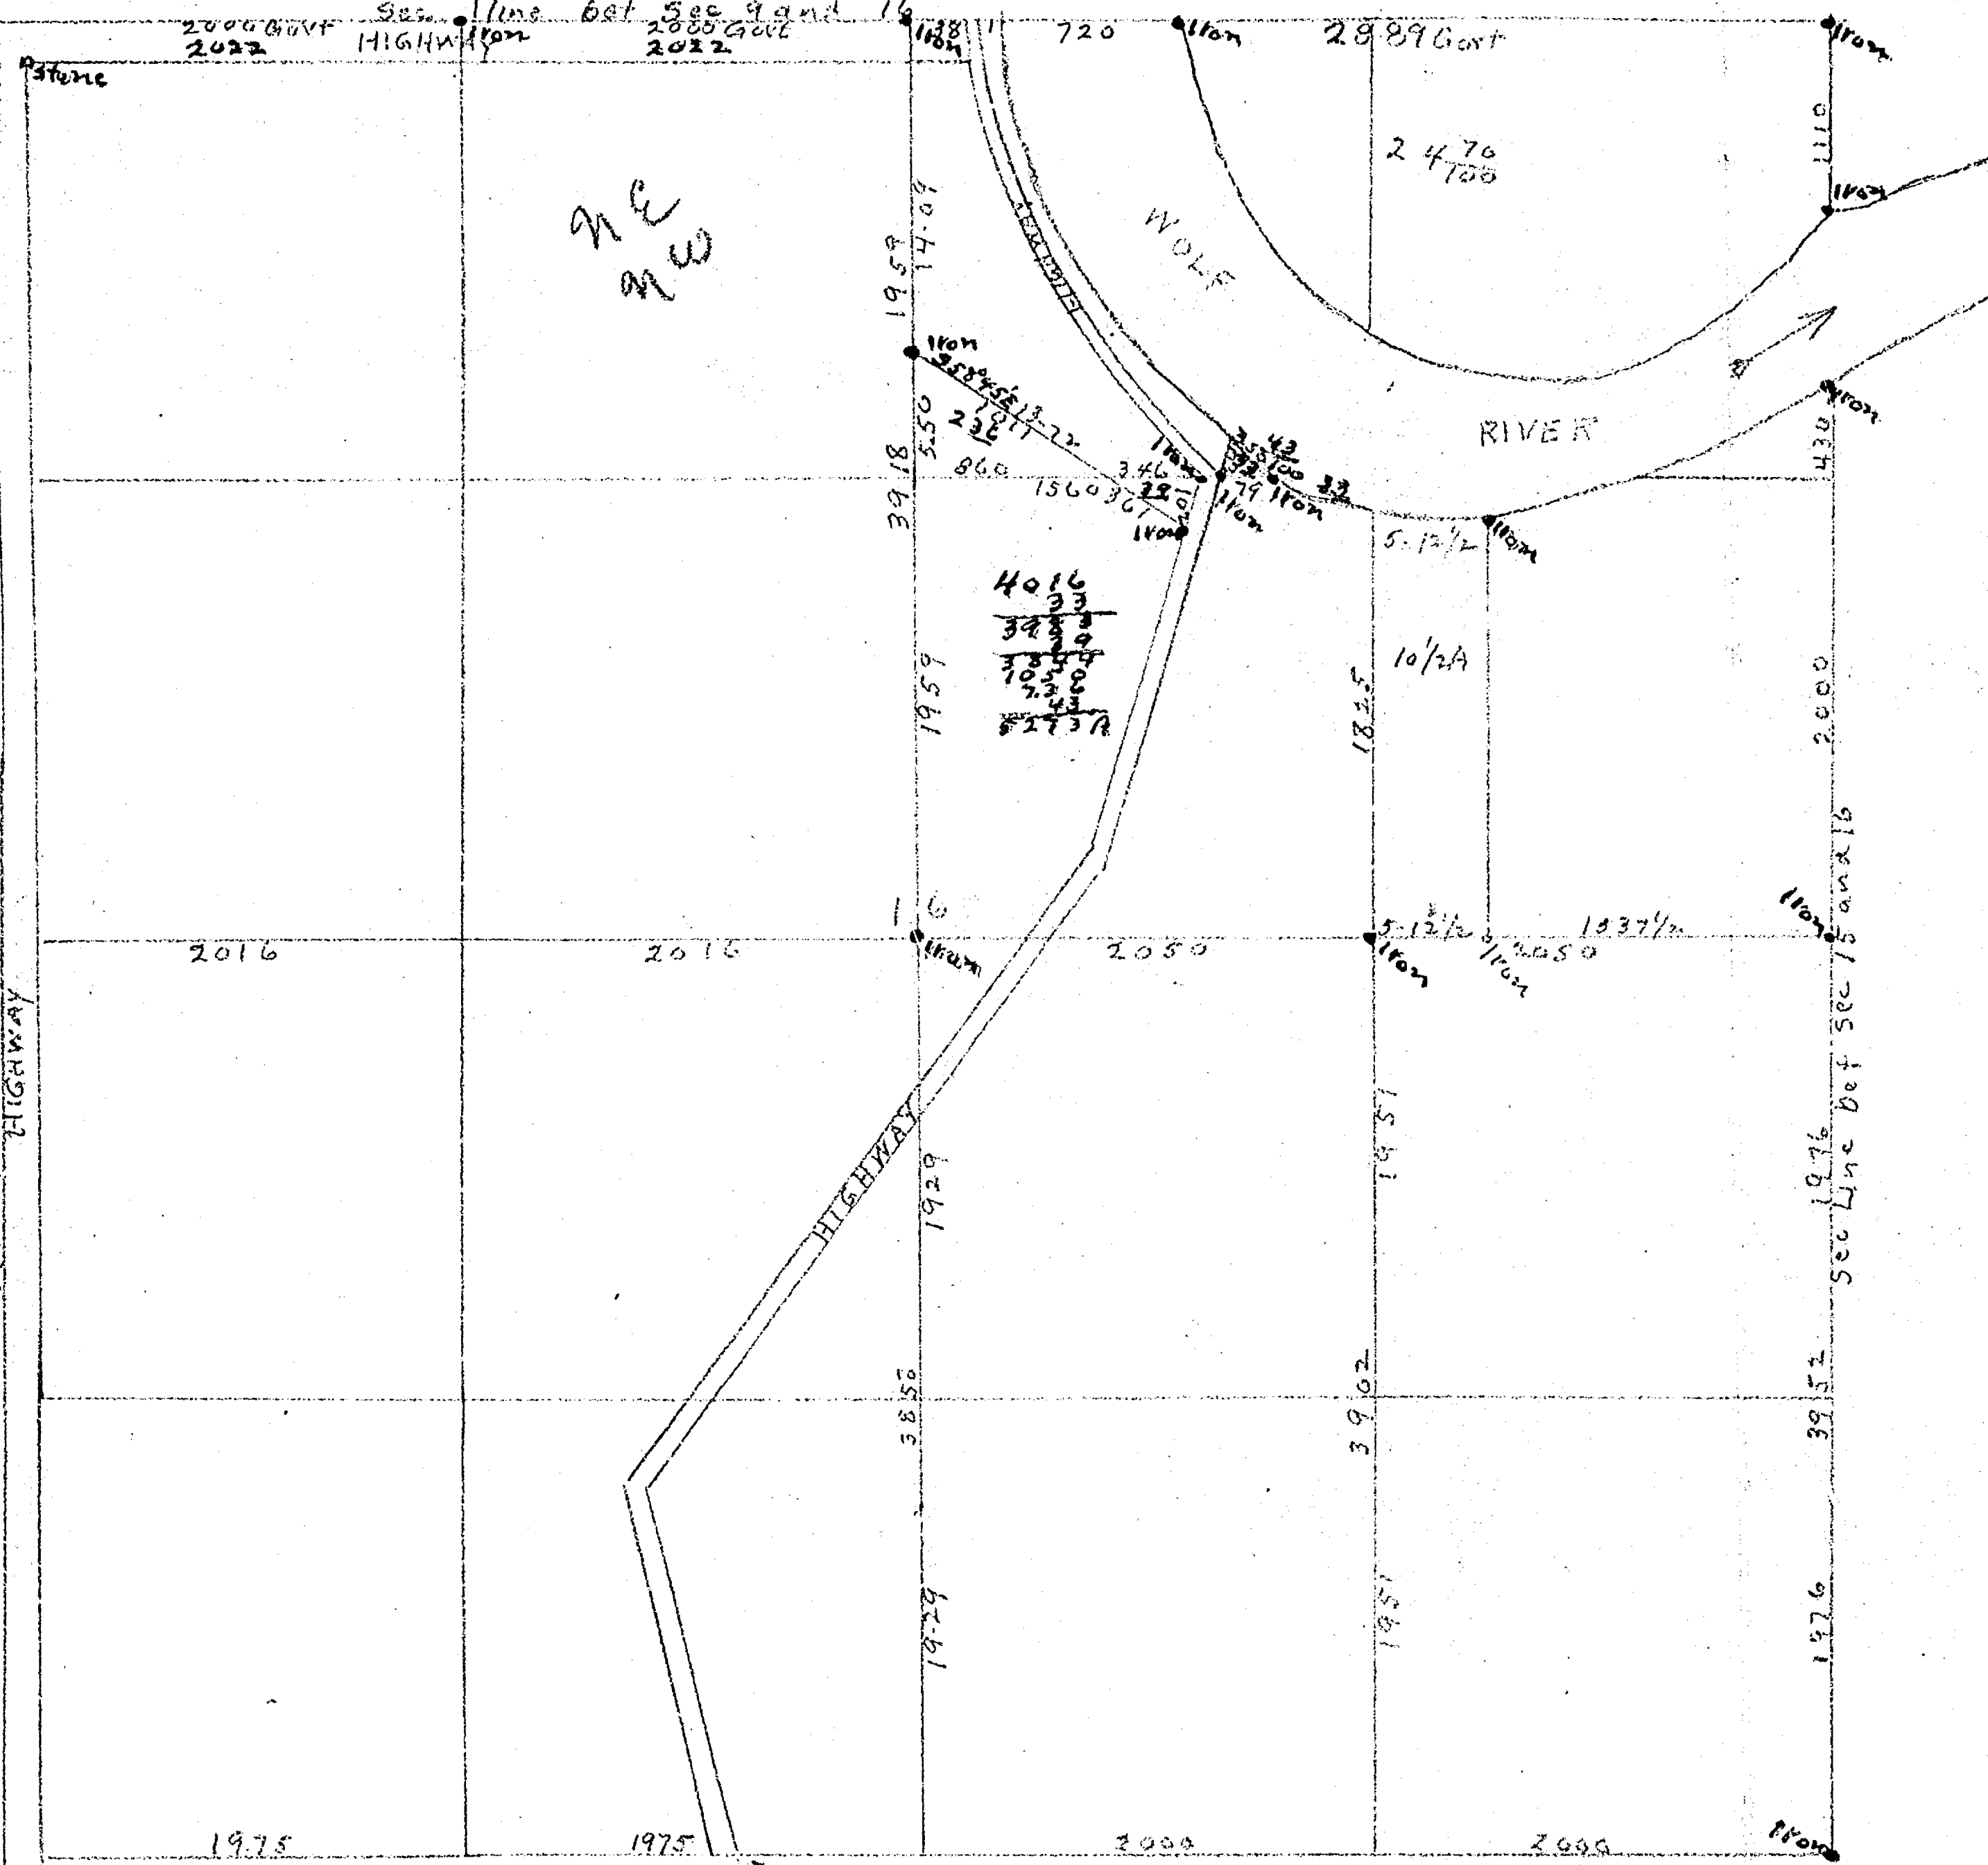


I Began at the center of Sec where I found a iron stake I measured the 1/4 Line North and found It as shown on above map I then surveyed out the land in W 1/2 NE 1/4 shown on above map set iron stakes as shown marked in Red Ink Began Oct 22d Completed Oct 23rd 1915 I then Drew a map of this survey and mailed it to R Bartell at Orihula on Oct 24th 1915 W W Gould Co Surveyor

Arnold Bartell Chairman
Erwin Bartell

SURVEY OF IN W 1/2 NE 1/4 SEC 16
TOWNSHIP NO 20 RANGE NO 14 EAST
TOWN OF WOLF RIVER

16-20-14

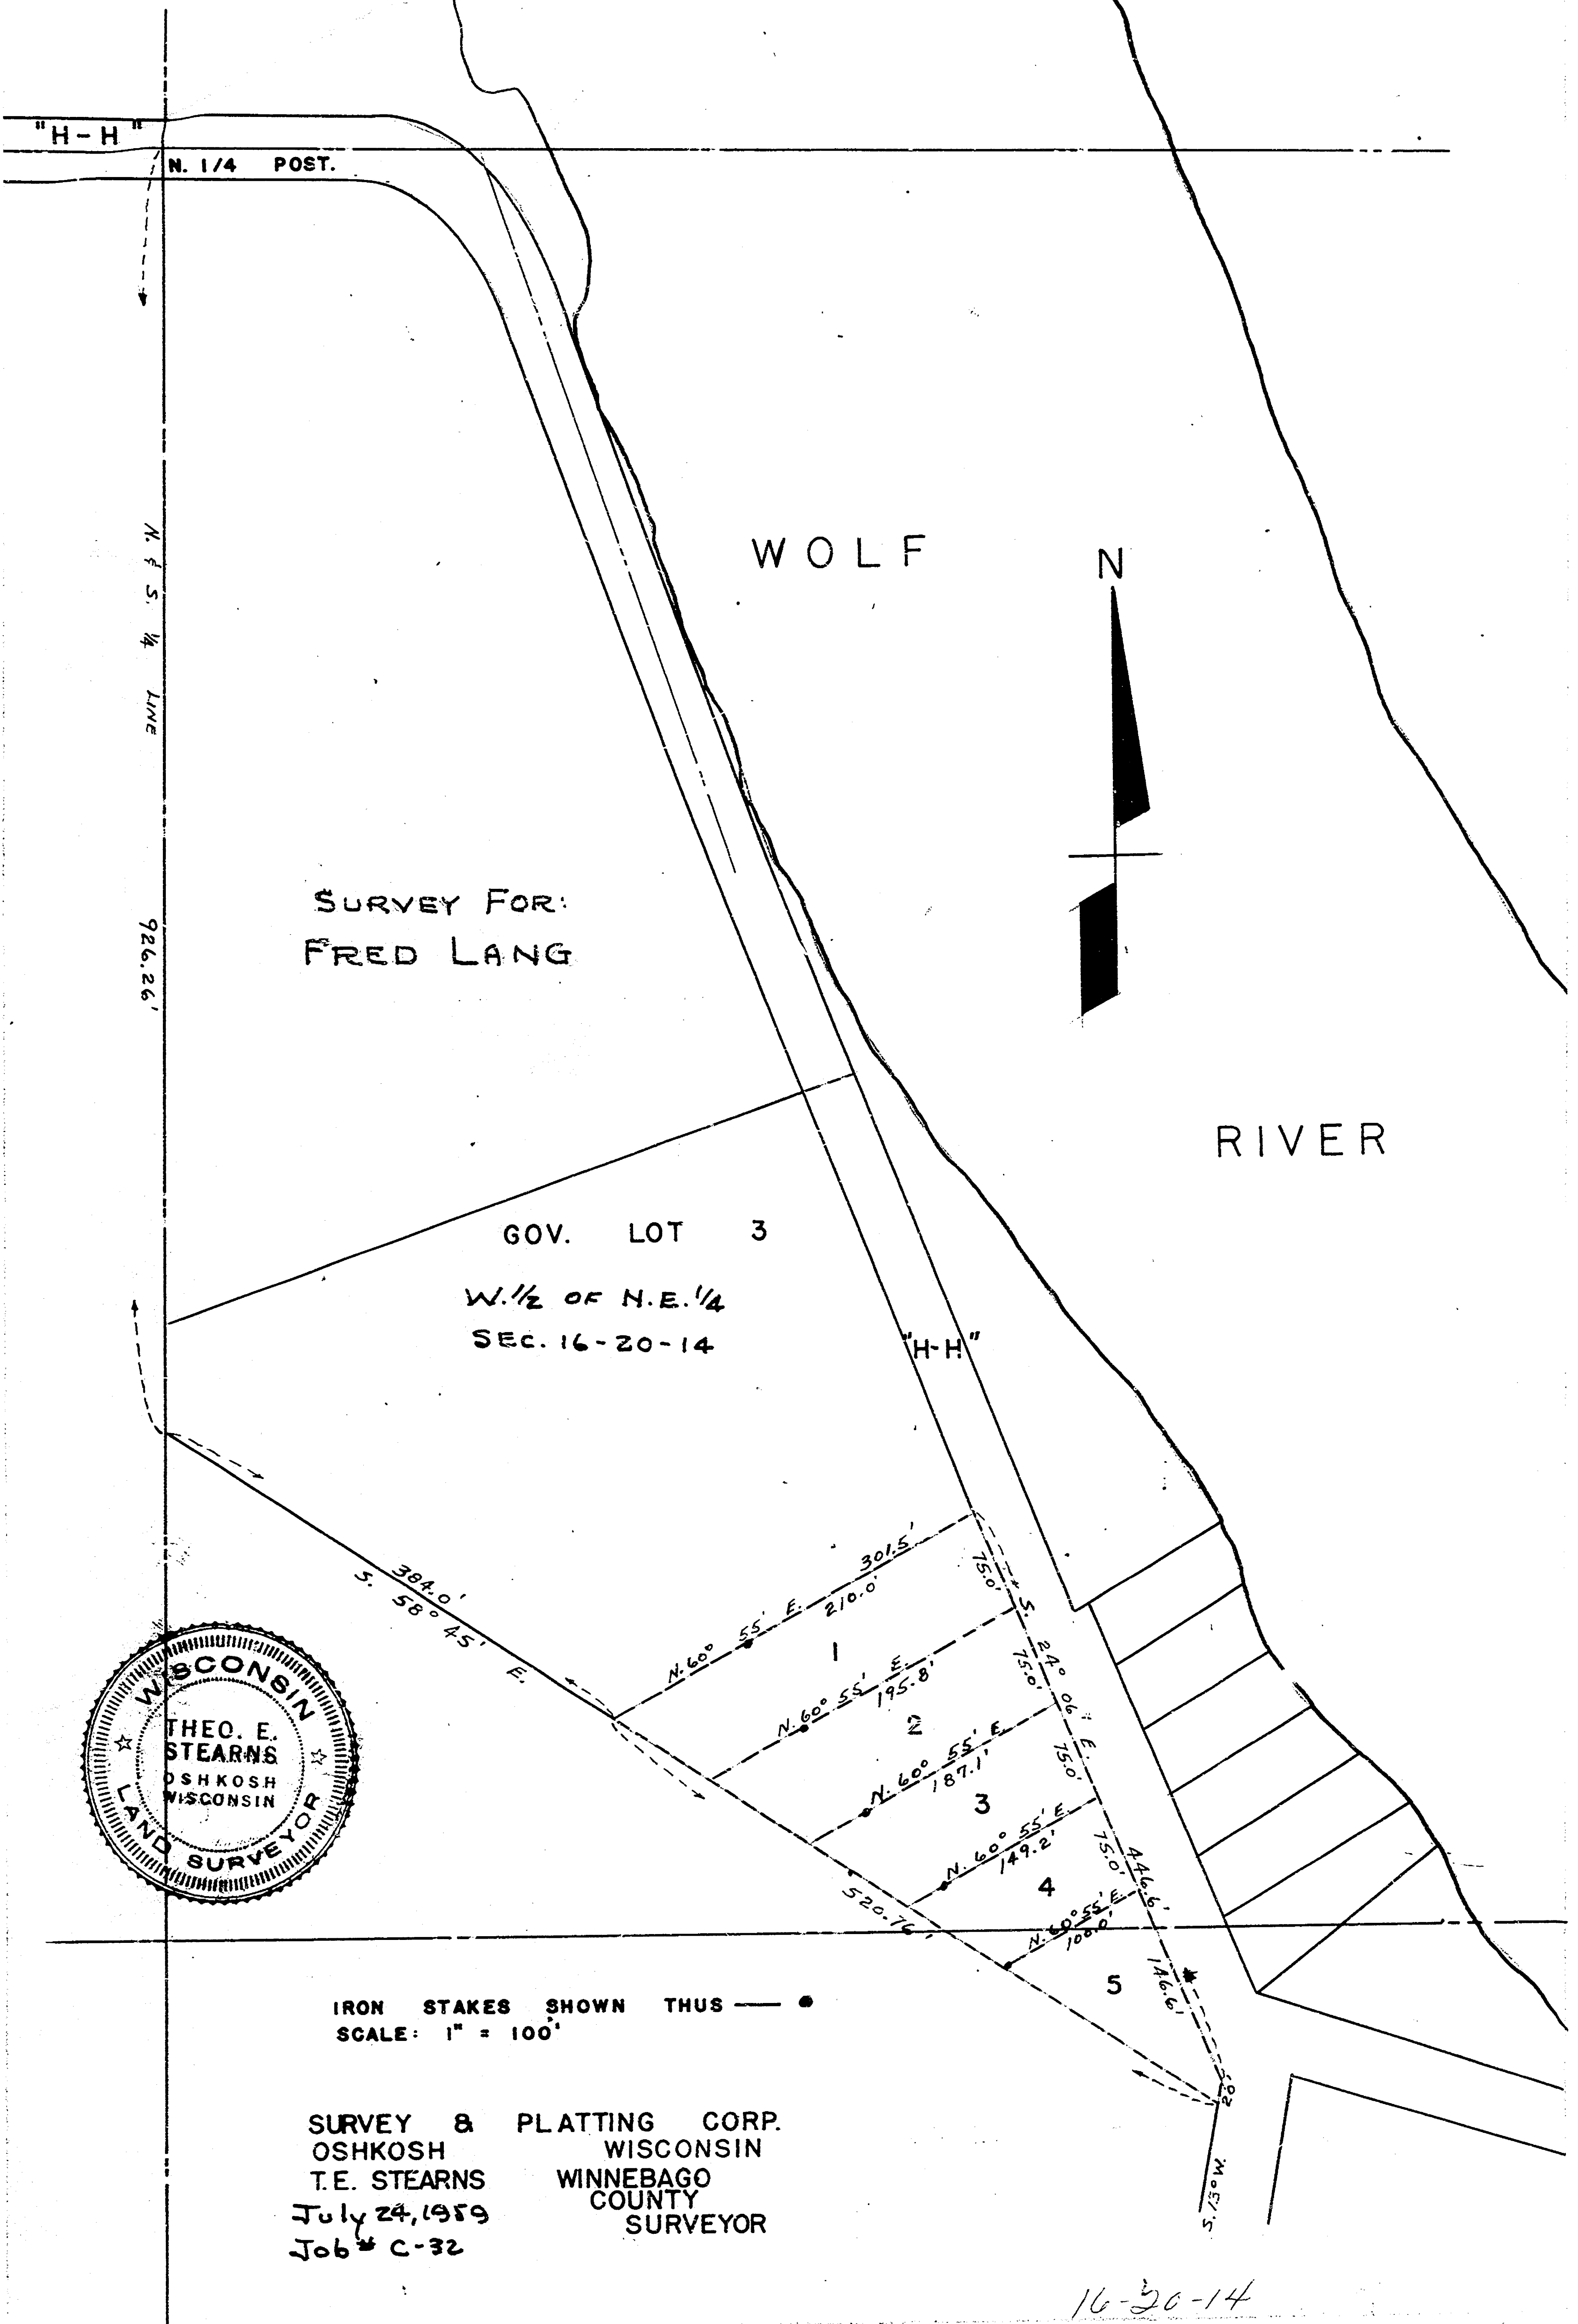

SURVEY FOR:
FRED LANG

GOV. LOT 3

W. 1/2 OF N.E. 1/4
SEC. 16-20-14

RIVER



IRON STAKES SHOWN THUS — •
SCALE: 1" = 100'

SURVEY & PLATTING CORP.
OSHKOSH WISCONSIN
T.E. STEARNS WINNEBAGO
JULY 24, 1959 COUNTY
JOB # C-32 SURVEYOR

16-20-14

LOTS 26 & 27 OF FIRST ADDITION
 TO THE PLAT OF ORIHULA IN SEC. 16,
 T.20N., R.14E., TOWN OF WOLF RIVER,
 WINNEBAGO CO., WISCONSIN.

EXISTING PARCEL

WOLF RIVER
 PLAT OF ORIHULA
 WOLF RIVER
 FIRST ADDITION
 LANE

TOP OF WATER ELEVATION:
 7-6-88 746.35

SCALE: 1 in. = 100 ft.

N
 W E
 S

BENCH MARKS SET ON POWER POLES
 (ELEVATIONS SHOWN ON PLAT)
 EXISTING IRONS FOUND
 IRON PIPE SET

100 YR. FLOOD ELEV. 751.35

OWNER: DAWN SCHOENICK
 1532 N. OAKWOOD
 OSHKOSH, WI.
 54904


Calvin W. Hawksworth
 CALVIN W. HAWKSWORTH S-1290
 WISCONSIN REGISTERED LAND SURVEYOR
 JULY 21, 1988

LOT 26
 LOT 27
 AREA = 3,350.00 SQ. FT.

HOUSE
 FLOOR EL. 751.28

SCALE: 1 in. = 10 ft.

16-20-14

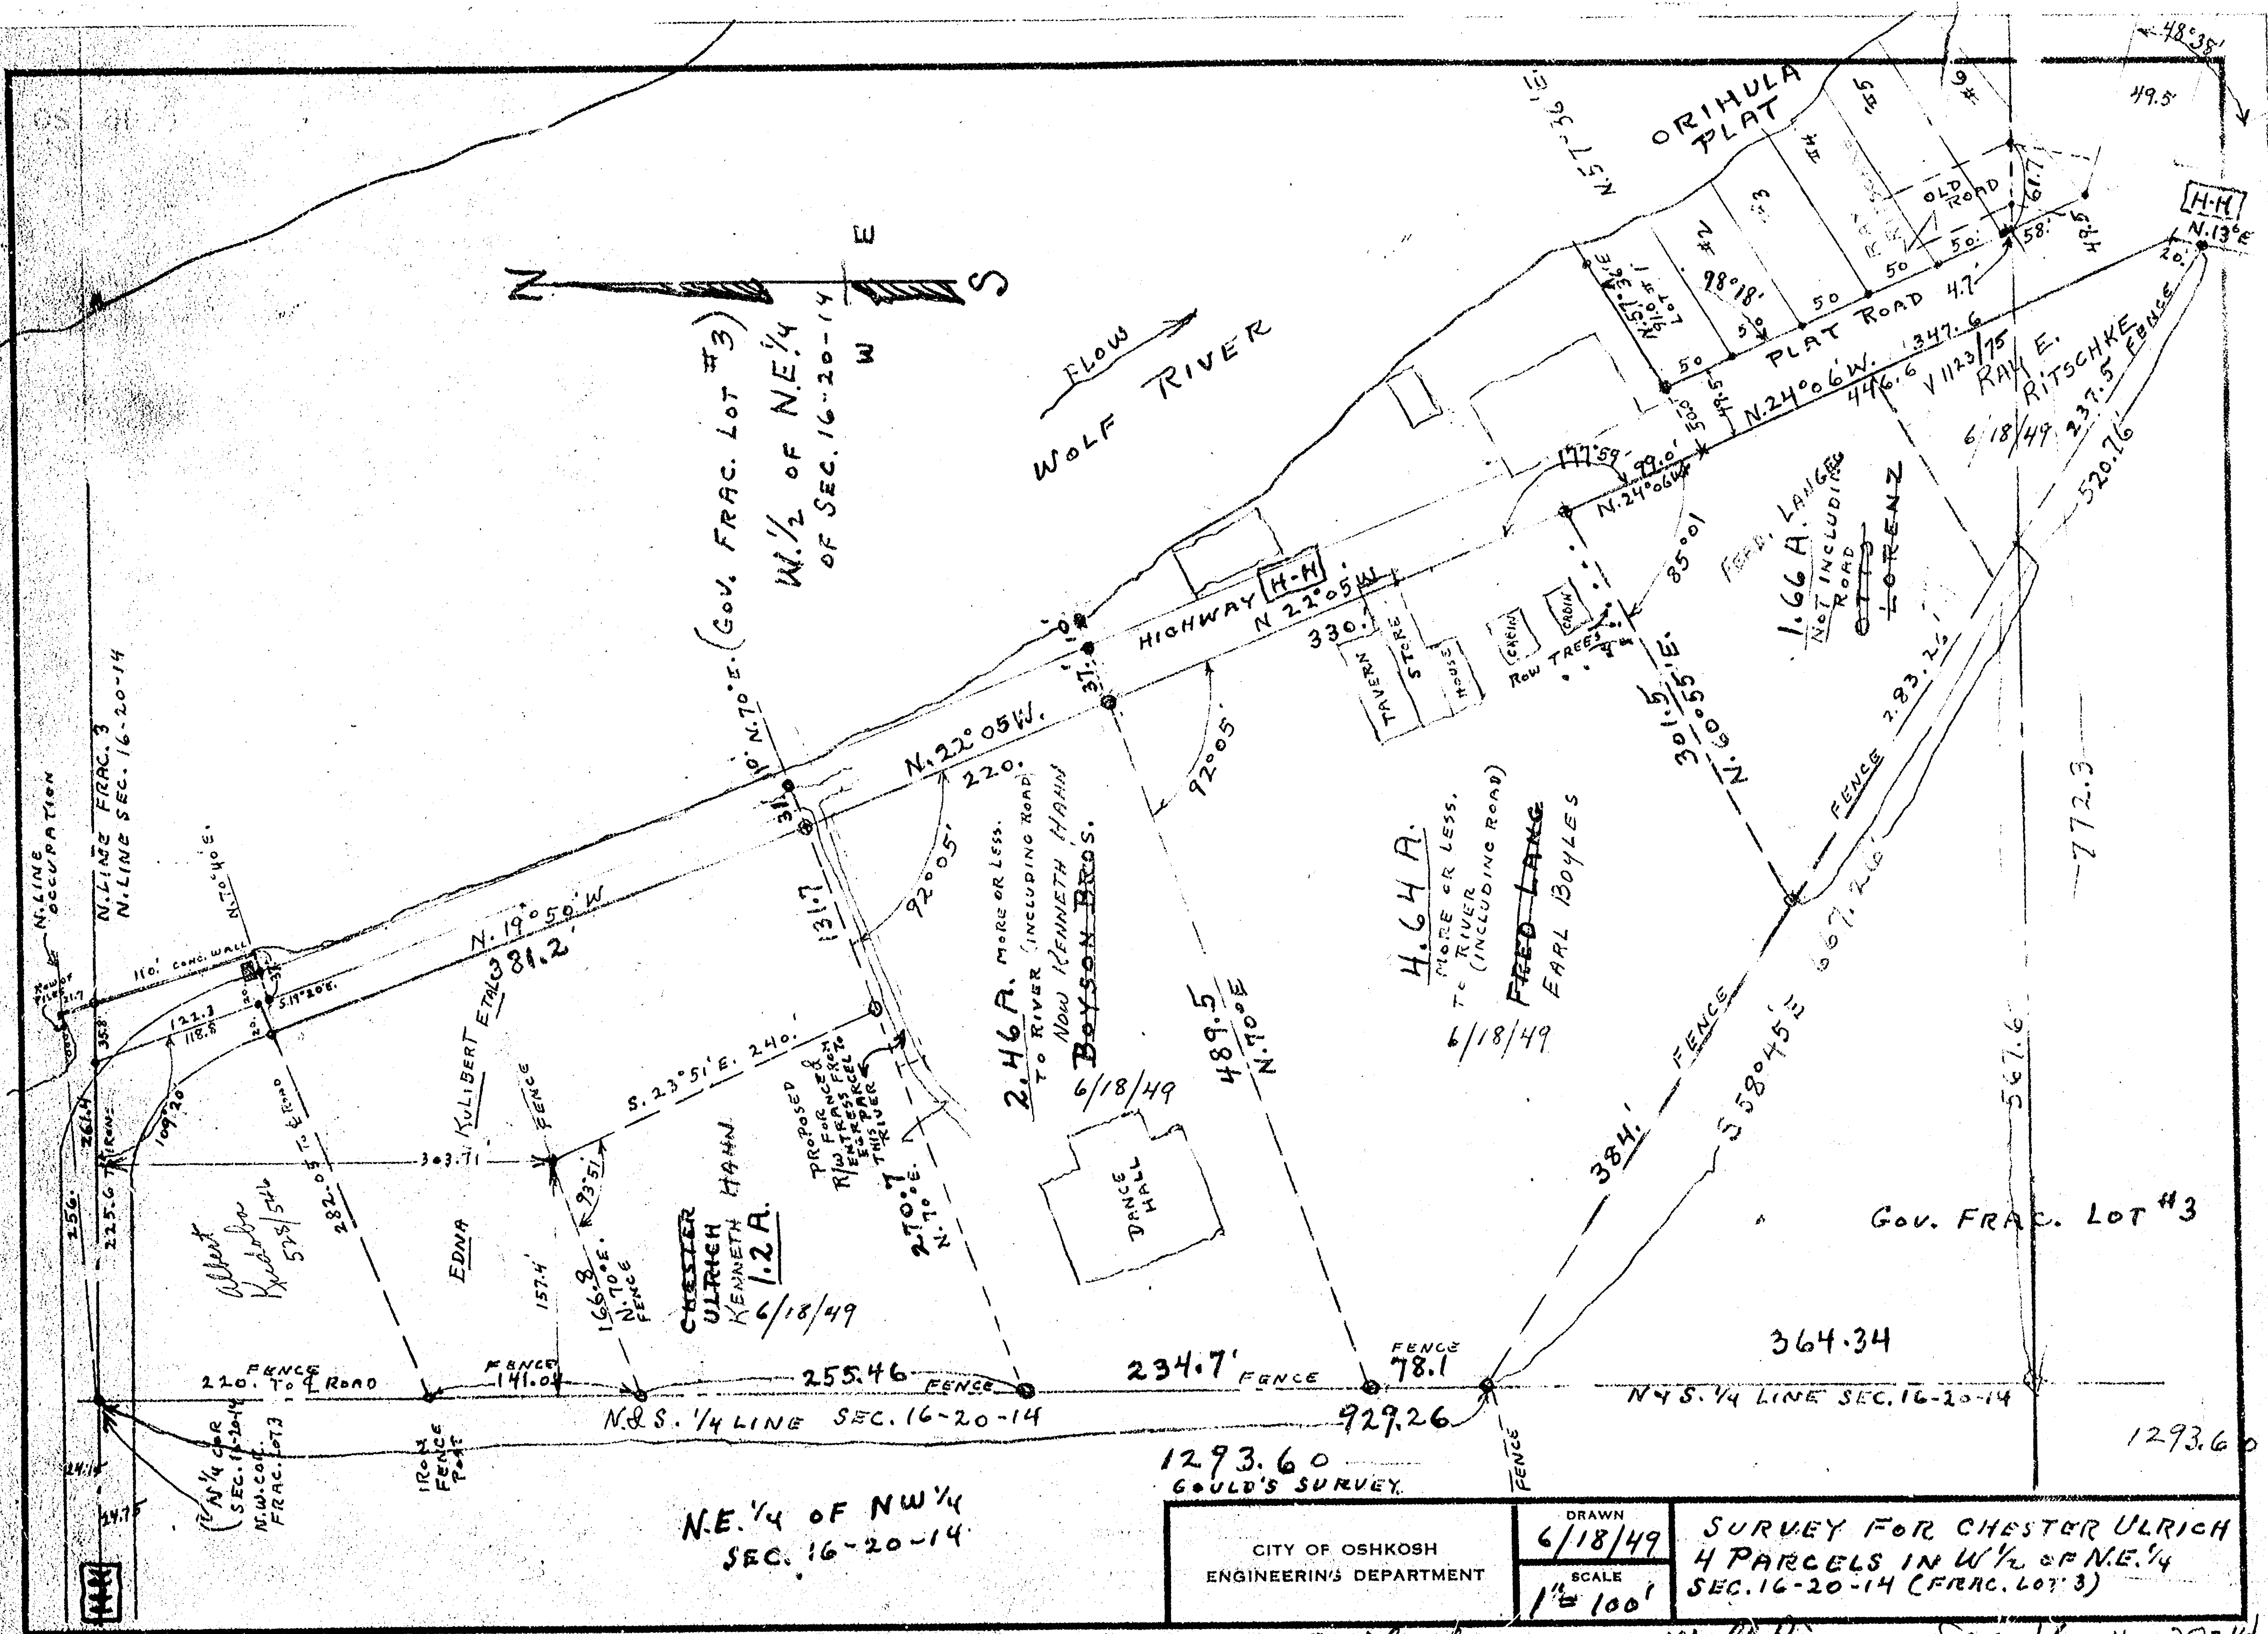

Oriskany

Wolf River Sec 16 16-20-14