


35-20-15

SURVEY for WILLIAM L. HENSHILWOOD

Tract "A"---Walter E. Woizeski to William L. Henshilwood & Pamela R. Peterson

A part of the Southeast Quarter (SE $\frac{1}{4}$) of the Southeast Quarter (SE $\frac{1}{4}$) of Section Thirty-five (35), Township Twenty (20) North, Range Fifteen (15) East; Town of Winchester, Winnebago County, Wisconsin containing 2.212 Acres of land and being described by: Commencing at the Northwest corner of Lot 1 of Certified Survey Map No. 416, recorded in Volume 1 on page 416 of Certified Survey Maps, Document No. 521824 and being the true point of beginning; thence N.00°-30'-13"W. 280.73 feet; thence N.86°-17'-49"E. 333.53 feet, to a point on the West line of S.T.H. "110"; thence S.00°-24'-42"E. 298.30 feet, along the West line of S.T.H. "110" to the NE corner of said Lot 1; thence S.89°-18'-56"W. 332.54 feet along the North line of said Lot 1 to the NW corner of said Lot 1 and being the true point of beginning.

The above described property is subject to a Septic Drainage Field Easement recorded in Document No. 583184 as recorded in the Winnebago County Registry.

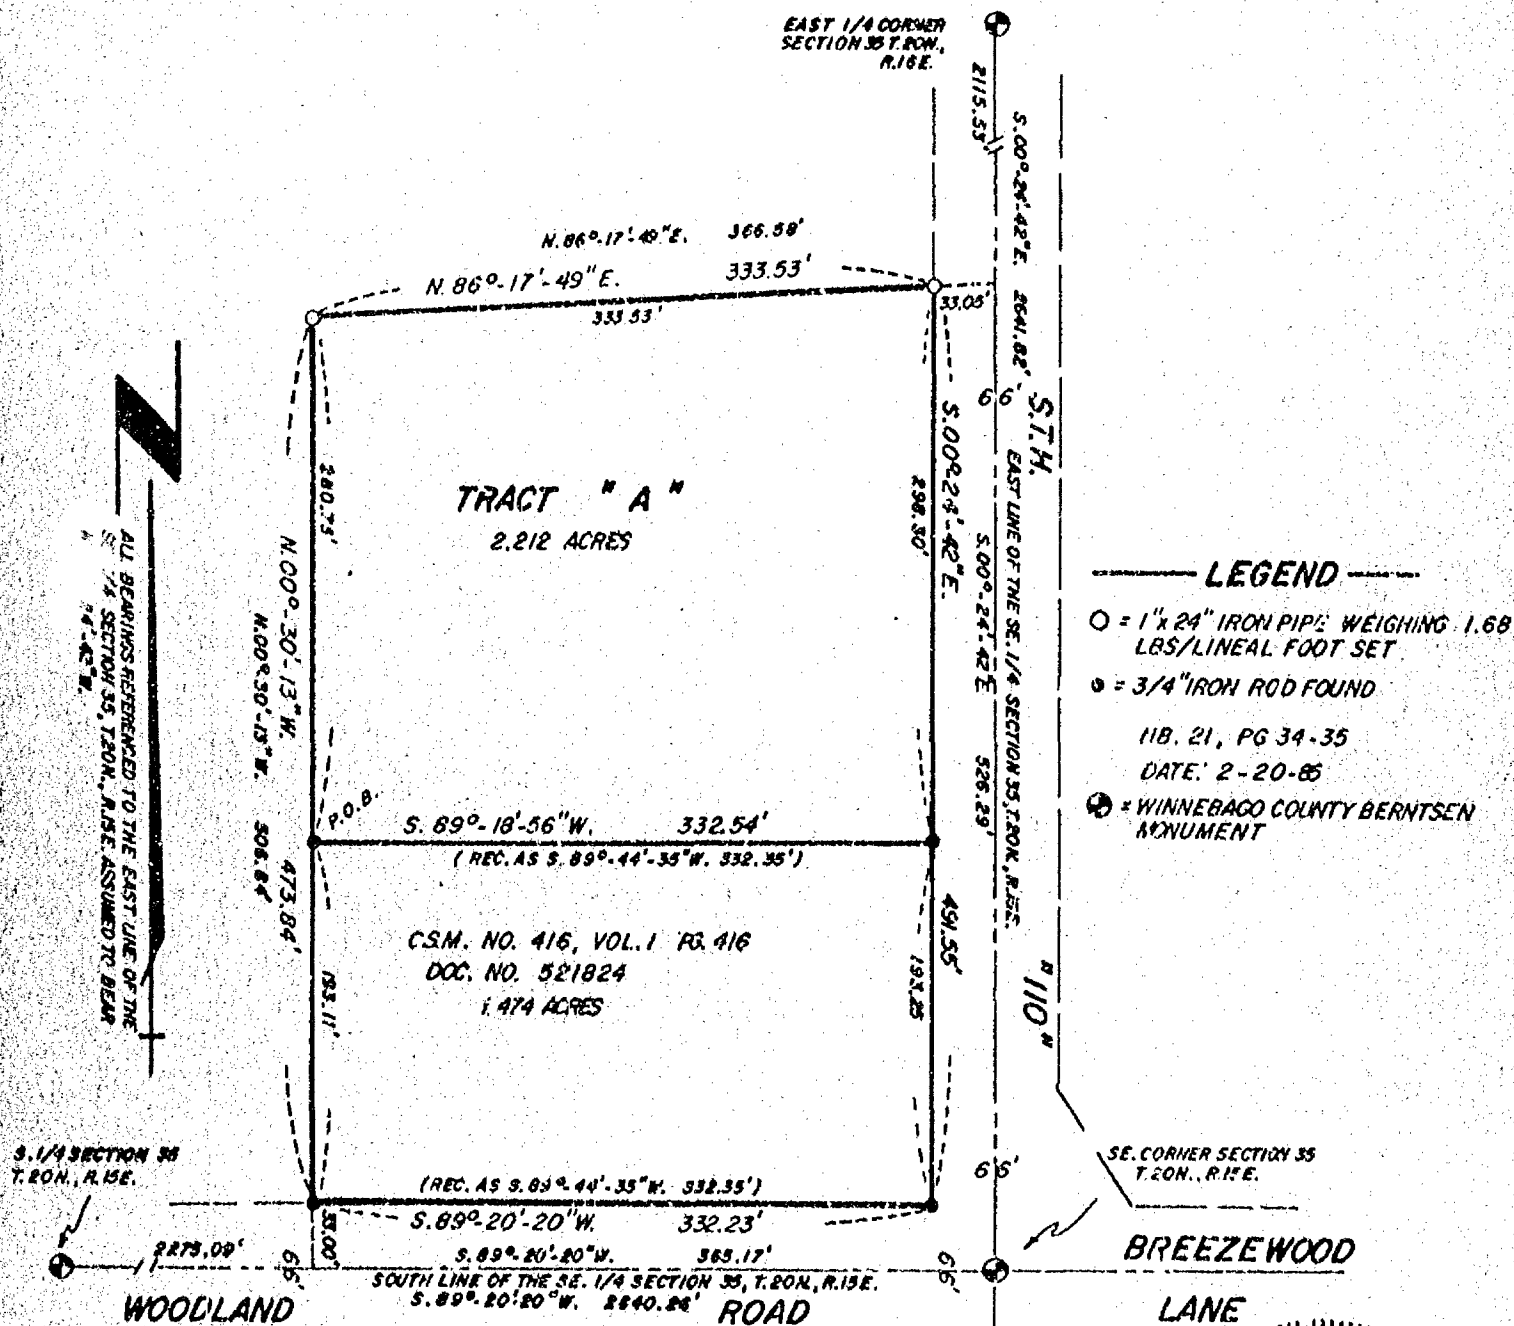


DATE OF THIS 21st DAY OF FEBRUARY, 1985

Lawrence C. Kriescher
WISCONSIN REGISTERED LAND SURVEYOR S - 1599
LAWRENCE C. KRIESCHER

AERO-METRIC ENGINEERING INC.

1091 SOUTH WASHBURN STREET

OSHKOSH, WISCONSIN 54901

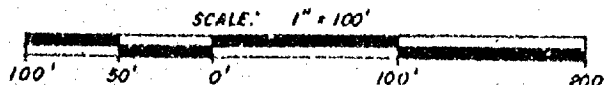

632087

Register's Office

Winnebago County, Wis.

Received for record this *12th*
day of *June* A.D., 19*85*
at *10:32* o'clock *A* M. and
recorded in Vol. *1...* of *C.S.M*
on page *1401*.

Elizabeth A. Johnson
Register of Deeds


Geo. - Metc

Chy
6.00

SURVEYOR'S CERTIFICATE:

I, Lawrence C. Kriescher, Wisconsin Registered Land Surveyor of Aero-Metric Engineering, Inc. certify that I have surveyed, divided and mapped under the direction of William L. Henshilwood a part of the Southeast Quarter (SE $\frac{1}{4}$) of the Southeast Quarter (SE $\frac{1}{4}$) and all Lot 1 of Certified Survey Map No. 416, recorded in Volume 1 on page 416 of Certified Survey Maps, all located in Section Thirty-five (35), Township Twenty (20) North, Range Fifteen (15) East, Town of Winchester, Winnebago County, Wisconsin containing 3.686 Acres of land and being described by: Commencing at the Southeast corner of said Section 35; thence S.89°-20'-20"W. 365.17 feet, along the South line of the SE $\frac{1}{4}$ of said Section 35; thence N.00°-30'-13"W. 33.00 feet, to the North line of Woodland Road and being the true point of beginning; thence N.00°-30'-13"W. 473.84 feet; thence N.86°-17'-49"E. 333.53 feet, to a point on the West line of S.T.H. "110"; thence S.00°-24'-42"E. 491.55 feet, along the West line of S.T.H. "110" to its intersection with the North line of Woodland Road; thence S.89°-20'-20"W. 332.23 feet, along the North line of Woodland Road to the true point of beginning.

EAST 1/4 CORNER
SECTION 35 T.20N.
R.15E.

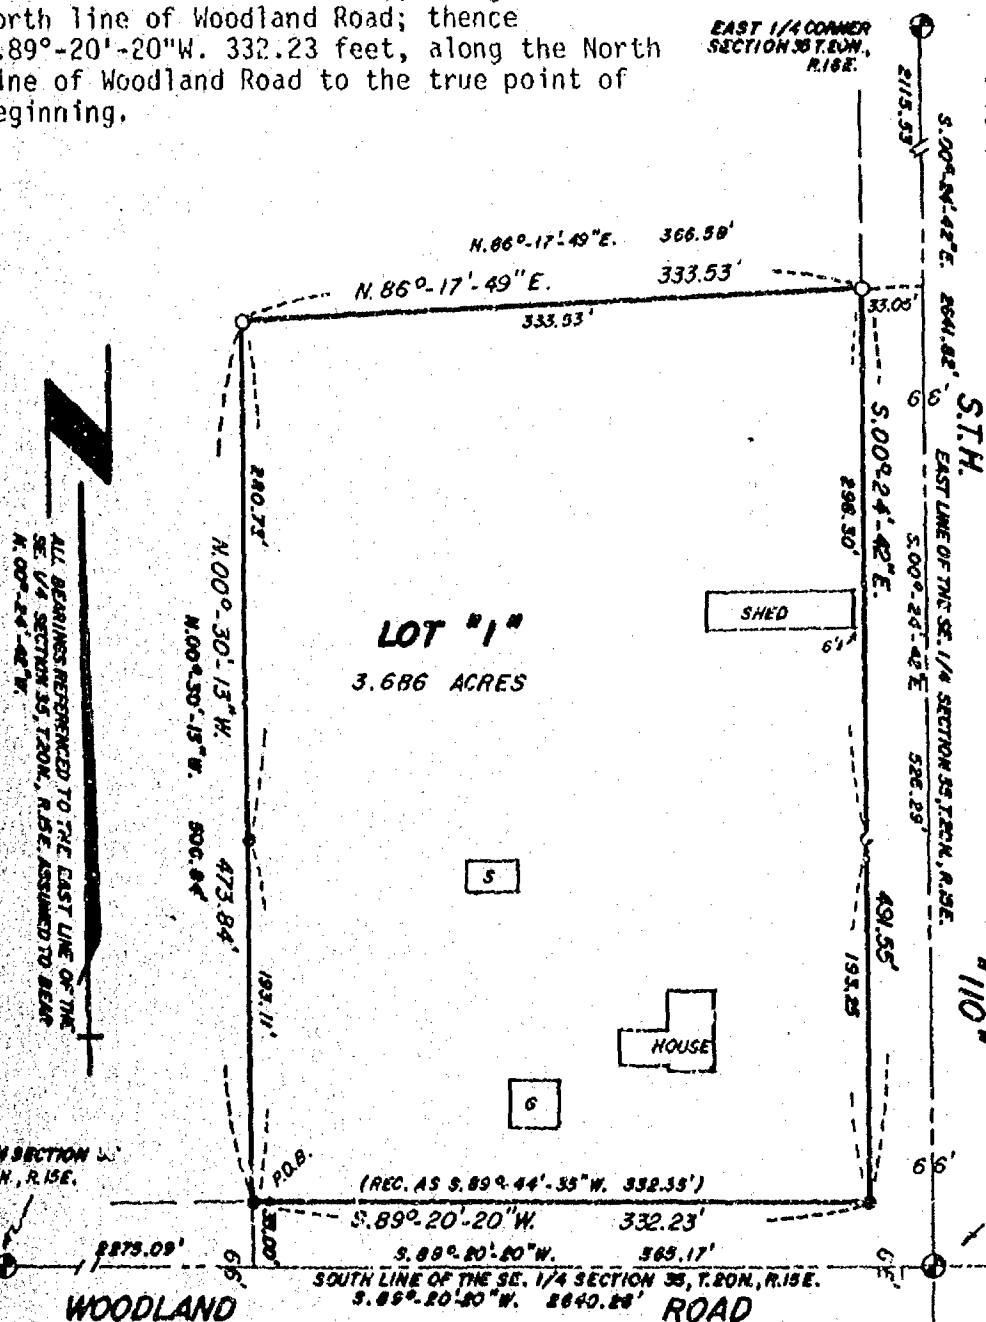

LEGEND


- = 1" x 24" IRON PIPE WEIGHING 1.68 LBS/LINEAL FOOT SET
- = 3/4" IRON ROD FOUND
- NB. 21, PG 34-35
- DATE: 2-20-85
- ⊙ = WINNEBAGO COUNTY BERNTSEN MONUMENT

DATED THIS 21st DAY OF FEBRUARY, 1985

Lawrence C. Kriescher
WISCONSIN REGISTERED LAND SURVEYOR S-1599
LAWRENCE C. KRIESCHER

AERO-METRIC ENGINEERING INC.

1091 SOUTH WASHBURN STREET
OSHKOSH, WISCONSIN 54901

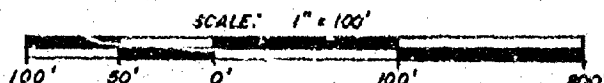


THIS INSTRUMENT DRAFTED BY LAWRENCE C. KRIESCHER S-1599



That such is a correct representation of all exterior boundaries of the land surveyed.
That I have fully complied with the provisions of Chapter 236.34 of the Wisconsin Statutes and the Land Subdivision Ordinance of Winnebago County in surveying and mapping the same.

Dated this 21st day of FEBRUARY, 1985

Lawrence C. Kriescher
Wisconsin Registered Land Surveyor S-1599
Lawrence C. Kriescher

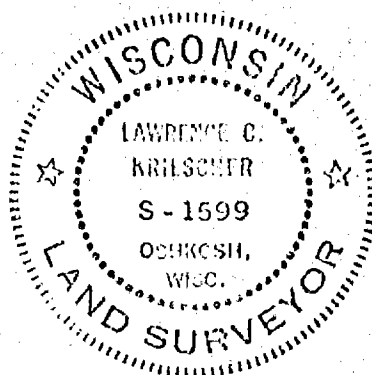

OWNER'S CERTIFICATE:

As owners we hereby certify that we caused the land described on this Certified Survey Map to be surveyed, divided and mapped as represented on this map.

Dated this 28th day of May, 1985

In the Presence of:

Lawrence C. Kriescher

Barbara A. Kriescher

William L. Henshilwood
William L. Henshilwood

Pamela R. Peterson
Pamela R. Peterson

STATE OF WISCONSIN }
WINNEBAGO COUNTY } SS

Walter Woizeski
Walter Woizeski

Personally came before me this 28th day of May, 1985, the above named William L. Henshilwood and Pamela R. Peterson to me known to be the persons who executed the foregoing instrument and acknowledged the same. Walter Woizeski personally came before me and executed the foregoing instrument and acknowledged the same.

Charles B. Gurnea
Notary Public _____, Wisconsin
My Commission expires 6-15-86

WINNEBAGO COUNTY PLANNING & ZONING COMMITTEE:

This Certified Survey Map of a part of the Southeast Quarter (SE $\frac{1}{4}$) of the Southeast Quarter (SE $\frac{1}{4}$) and all of Lot 1 of Certified Survey Map No. 416, all in Section 35, T.20N., R.15E., Town of Winchester, William L. Henshilwood and Pamela R. Peterson, owners, is hereby approved. Also owner of the above named property is Walter Woizeski.


June 13, 1985
Date

Eurole Owens
By:

[illegible]

CERTIFIED SURVEY MAP NO. 416

Part of the Southeast 1/4 of the Southeast 1/4 of
Section 35, Town 20 North, Range 15 East, Town of
UNPLAIED LANDS
Winchester, Winnebago County, Wisconsin.

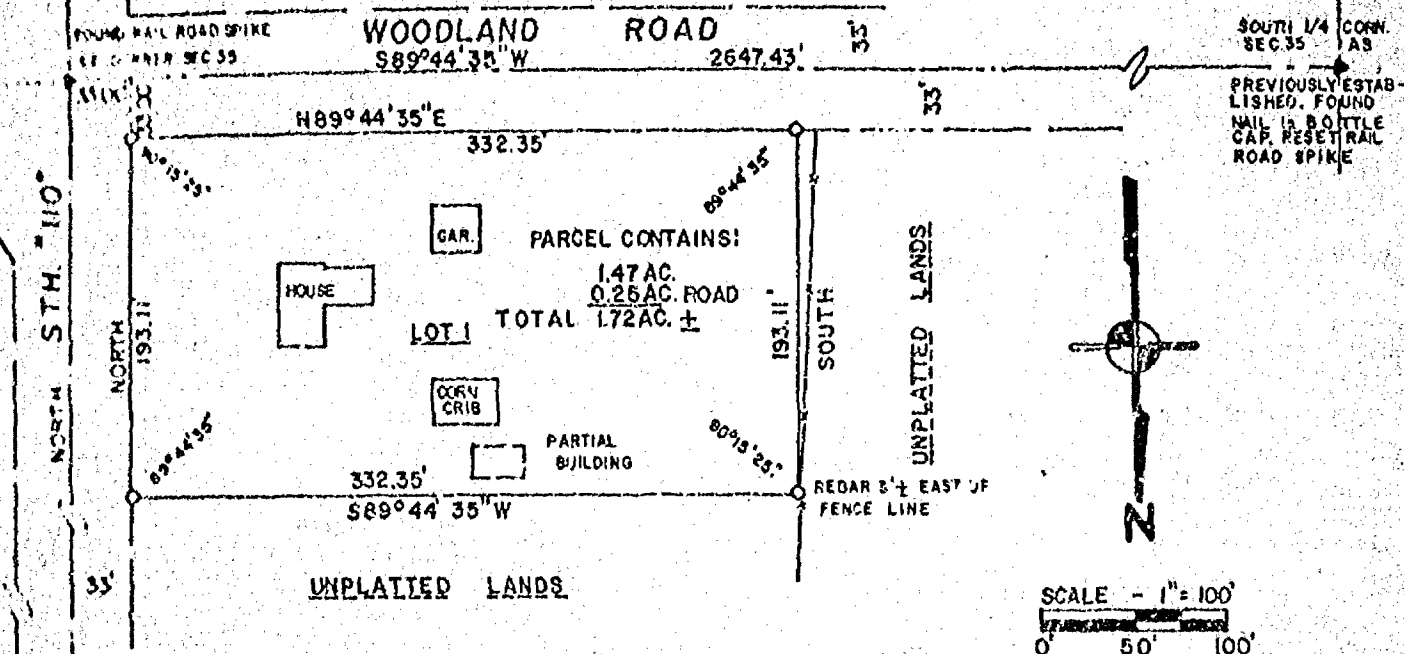

Legend

3/4"x24" dia. round steel
rod set, weighing
1.505 lbs. per lin. ft.

Reference Meridian is the South line of the Southeast 1/4 of Section 35, which is assumed to bear $389^{\circ}44'35''$

NEW YORK'S CERTIFICATE:

State of Wisconsin)
Winnebago County)


Prepared by;
Martenson & Eisele, Inc.
1919 American Ct.
Neenah, Wis. 54956
Ph. 731-0381.

I, David D. Elsie, Land Surveyor, do hereby certify that I have Surveyed all that part of the Southeast 1/4 of the Southeast 1/4 of Section 35, Town 20 North, Range 15 East, Town of Winchester, Winnebago County, Wisconsin, morefully described as follows:

Commencing at the Southeast corner of said Section 35; thence S89°44'35"W 33.00 ft.; thence North 33.00 ft.; to the point of beginning of lands herein described, said point being on the south line of Woodland Road and the west line of S.T.R. "110"; thence North along the the West line of S.T.R. "110" 193.11 ft.; thence S89°44'35"W 332.35 ft.; thence South 193.11 ft. to the North line of Woodland Road; thence N89°44'35"E 332.35 ft. to the point of beginning. Subject to all easements and right-of-way of record, and that I have fully complied with Chapter 216.34 of the Wisconsin Statutes in surveying, dividing, and mapping the land, and with the Winnebago County Land Subdivision Ordinance.

Given under my hand this 11 day of Aug, 1978.

David D. Elsele
David D. Elsele, Reg. Land Surveyor S-974

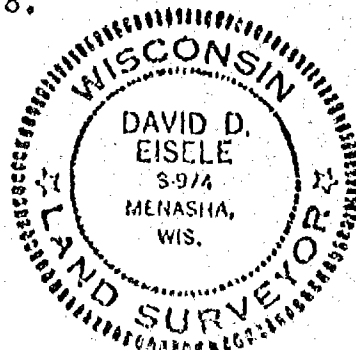

Proj. 148-21

SHEET 1 of 2

CERTIFIED SURVEY MAP NO. 416

STATEMENT OF OWNER

I, Walter E. Woizeski, hereby certify that we caused the land described to be surveyed, divided, and mapped all as shown on this

map, this 25th day of Aug., 1978.

Walter E. Woizeski

Walter E. Woizeski
Owner Walter E. Woizeski

Owner

State of Wisconsin)
Winnebago County)

Personally came before me on the 25th day of Aug., 1978, the above named Walter E. Woizeski, who is known to be the persons who executed the foregoing instrument and acknowledged the same.

NOTARY PUBLIC,
STATE OF WISCONSIN

My commission expires MARCH 26, 1982

Notary Public - Winnebago County, Wis.

NOTARY CERTIFICATE

I hereby certify that there are no unpaid taxes or unpaid special assessments on any of the lands included in this Minor Subdivision.


Frank R. Ruck
County Treasurer
this 25th day of August, 1978.

Frank R. Ruck
County Treasurer
this 25th day of August, 1978.

PLANNING COMMITTEE

I, Robert M. Hunter, Chairman, Planning and Zoning Committee, certify that all the requirements for approval have been fulfilled. This Minor Subdivision was approved by the Winnebago County Planning and Zoning Committee on 29th day of Aug., 1978.

Robert M. Hunter
Chairman, Planning and Zoning Committee

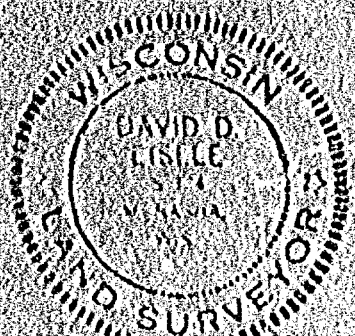

Sheet 2 of 2

521824

Registered & Filed
Winnebago County, Wis.
Received for record this 31st
day of August, A.D. 1978
at 9:08 o'clock A.M. and
recorded in Vol. 1 of S. Maps
on page 416


REGISTER OF DEEDS
John P. Payne

David D. Leslie
Aug 11, 1978

079

35-20-15

Plat of Survey

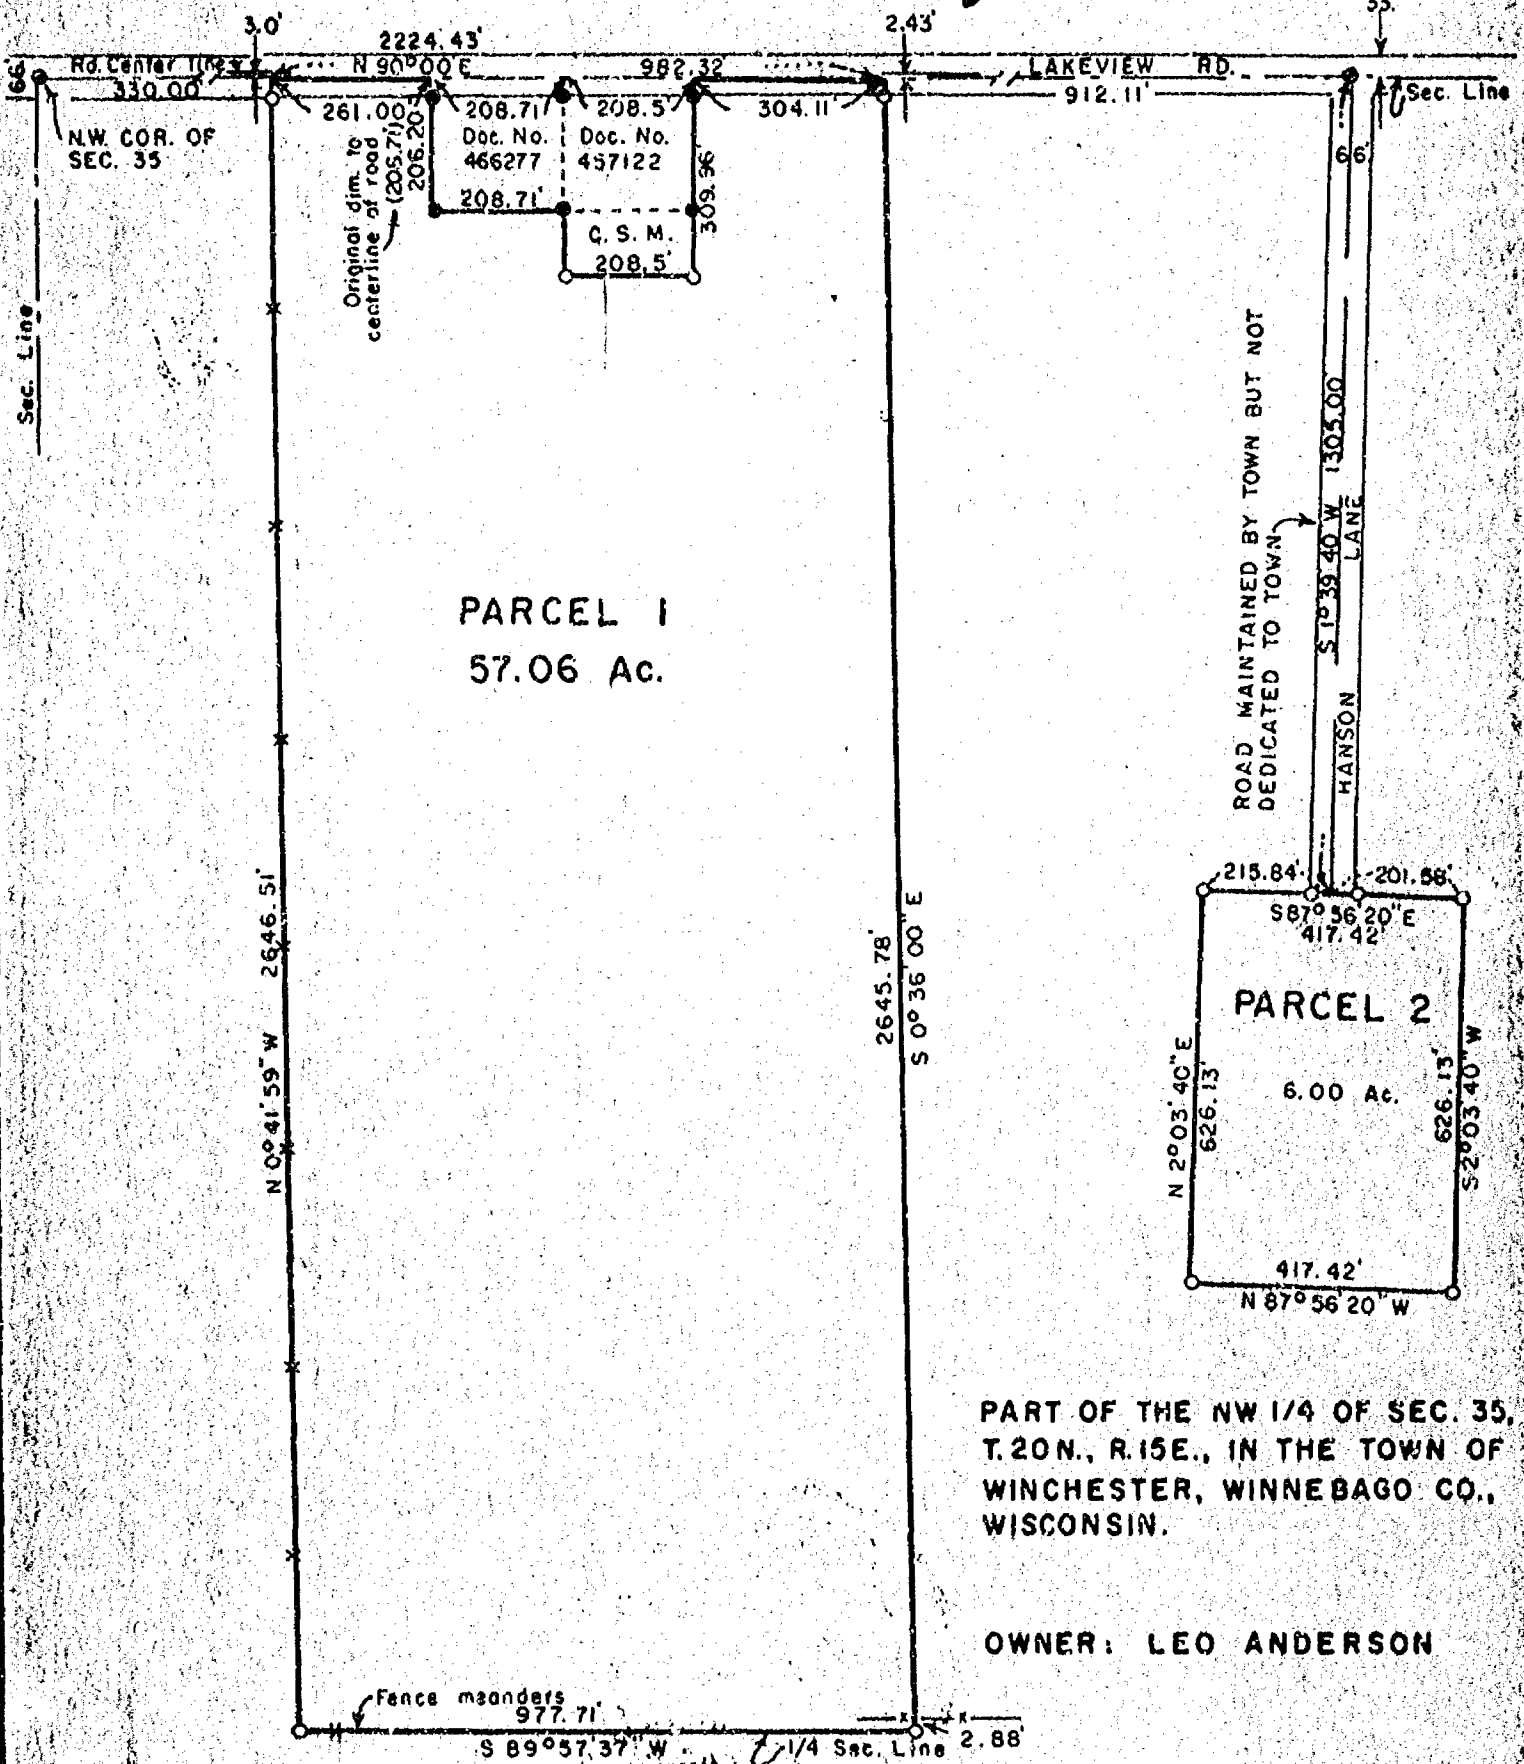

PARCEL 1
57.06 Ac.


PARCEL 2
6.00 Ac.

PART OF THE NW 1/4 OF SEC. 35,
T.20N., R.15E., IN THE TOWN OF
WINCHESTER, WINNEBAGO CO.,
WISCONSIN.

OWNER: LEO ANDERSON

LEGEND


- = Existing monuments
- = 2" x 30" iron pipe set
- = 1" x 30" iron pipe set
- = reference caps or R.R. spikes
- = Bernitsen or Harrison monuments
- X-X = fence
- () = recorded us
- = stone monument

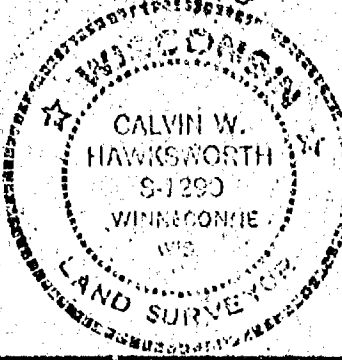

SURVEYORS CERTIFICATE

I, hereby certify that I have surveyed the property as shown, according to official records and that the plat above drawn is an accurate and correct representation of said survey. MAY 23, 1979

Calvin W. Hawksworth
Wisconsin Registered Land Surveyor S-1209

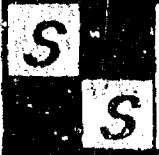


R. K. SAYLER, INC.
LAND SURVEYORS
WINNECONNE, WI 54986

SCALE 1 in. = 300 ft.
PROJECT NO. S-000977
FIELD BOOK 37 PAGE 81

WINNEBAGO COUNTY CERTIFIED SURVEY MAP NO. 574

Part of the NW $\frac{1}{4}$ of the NW $\frac{1}{4}$ of Sec. 35, T.20N., R.15E., Town of
Winchester

ADDITION TO DOC. NO. 457152

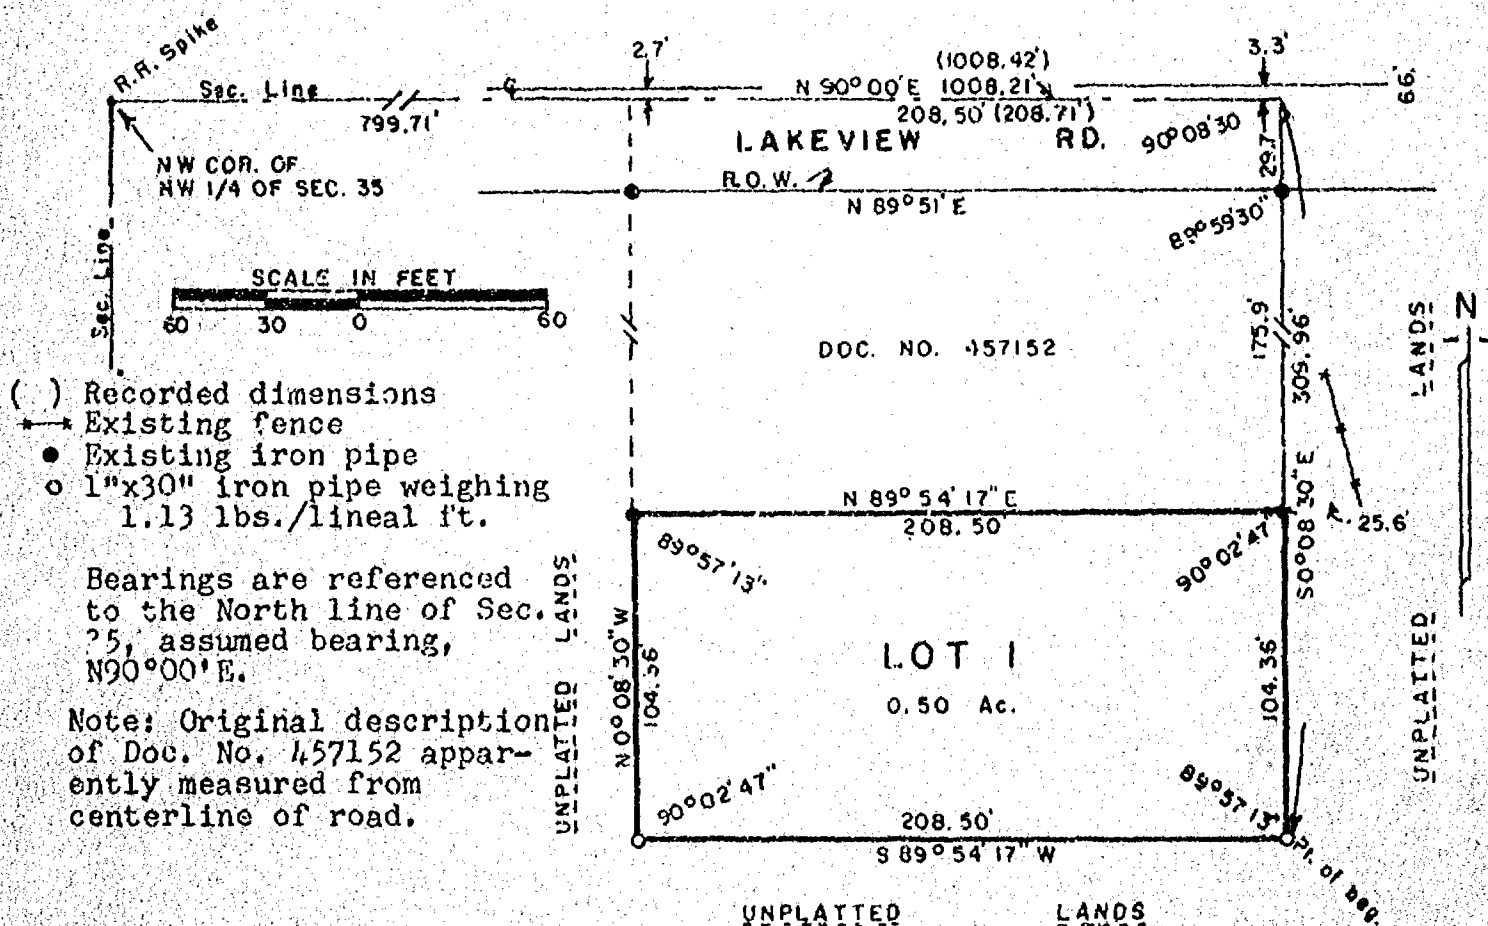


I, Calvin W. Hawksworth, registered land surveyor, hereby
certify:

That I have surveyed, divided and mapped the parcel of land located in part of the NW $\frac{1}{4}$ of the NW $\frac{1}{4}$ of Sec. 35, T.20N., R.15E. in the Town of Winchester, Winnebago County, Wisconsin, described as follows: Beginning at an iron pipe that is 1008.21 ft., N90°00'E and 309.96 ft., S0°08'30"E of the NW corner of the NW $\frac{1}{4}$ of said Sec. 35. From that point running S89°54'17"W, 208.50 ft., thence N0°08'30"W, 104.36 ft., thence N89°54'17"E, 208.50 ft., thence S0°08'30"E, 104.36 ft. to the said point of beginning. Being a parcel of land of 0.50 acres, more or less. Said parcel is an addition to the parcel of land described in Document No. 457152 of Winnebago County Records.

That I have made such survey, land division and map by the direction of Leo Anderson, 7363 Anderson Lane, Winneconne, Wisconsin, 54986; that such map is a true and correct representation of the exterior boundaries of the land surveyed.

That I have fully complied with the provisions of Sec. 236.34 of the Wisconsin Statutes and the Certified Survey Map Ordinance of Winnebago County in surveying and mapping the same.

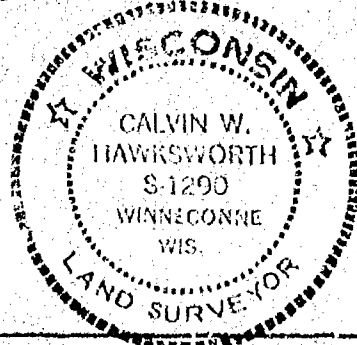

Calvin W. Hawksworth
Calvin W. Hawksworth S-1290
Wisconsin Registered Land Surveyor
May 24, 1979.

Sheet 1 of 2 sheets

WINNEBAGO COUNTY CERTIFIED SURVEY MAP NO. 574
 Part of the NW $\frac{1}{4}$ of the NW $\frac{1}{4}$ of Sec. 35, T.20N., R.15E., Town of
 Winchester.

OWNER'S CERTIFICATE

As owner(s) I(we) hereby certify that I(we) caused the land described on this Certified Survey Map to be surveyed, divided and mapped as represented hereon.

WITNESS the hand and seal of said owner(s) this 5th day of June, 1979.
 In presence of:

Gene Haedt
 Witness

Lorraine Anderson & Les Anderson
 Owner(s)

7363 Anderson Lane
 Address

Winneconne, Wis 54986
 City-State Zip

STATE OF WISCONSIN) SS
 WINNEBAGO COUNTY)

Personally came before me this 5th day of June, 1979, the above named Lorraine Anderson & Les Anderson to me known to be the person(s) who executed the foregoing instrument and acknowledged the same.

Eva May Coats
 Notary Public, Winnebago Co., Wis.

My commission expires June 8, 1980.

WINNEBAGO COUNTY PLANNING COMMITTEE CERTIFICATE

This Certified Survey Map of part of the NW $\frac{1}{4}$ of the NW $\frac{1}{4}$ of Sec. 35, T.20N., R.15E. in the Town of Winchester is hereby approved.

June 1, 1979
 Date

Robert M. Hunt, DRS
 Authorized representative
 Winnebago County Planning Committee

Calvin W. Hawksworth
 Calvin W. Hawksworth S-1290
 Wisconsin Registered Land Surveyor
 May 24, 1979



534394

Register's Office
 Winnebago County, Wis.
 Received for record this 6th
 day of June, A.D. 1979
 at 8:18 o'clock AM and
 recorded in Vol. 1 of S Maps
 on page 574

Sheet 2 of 2 sheets

Robert M. Payne
 Register of Deeds

R. K. Layton


Survey For M. Tannen:

Description For Parcel # 1

That Part Of The N.W. 1/4 Of The N.W. 1/4 Of Sec. 35-20-15, Town Of Winchester, Winnebago County, Wis. Described As Follows: The East 208.71 ft. Of The West 1008.42 ft. Of The North 208.71 ft. Of The N.W. 1/4 Of The N.W. 1/4 Of Sec. 35-20-15. Said Parcel Contains 1.0 Acres More Or Less.

Description For Parcel # 2


That Par' Of The N.W.1/4 Of The N.W.1/4 Of Sec. 35-20-15, Town Of Winchester, Winnebago County, Wis. Described As Follows: The East 208.71 ft. Of The West 799.71 ft. Of The North 208.71 ft. Of The N.W.1/4 Of The N.W.1/4 Of Sec. 35-20-15. Said Parcel Contains 1.0 Acres More Or Less.

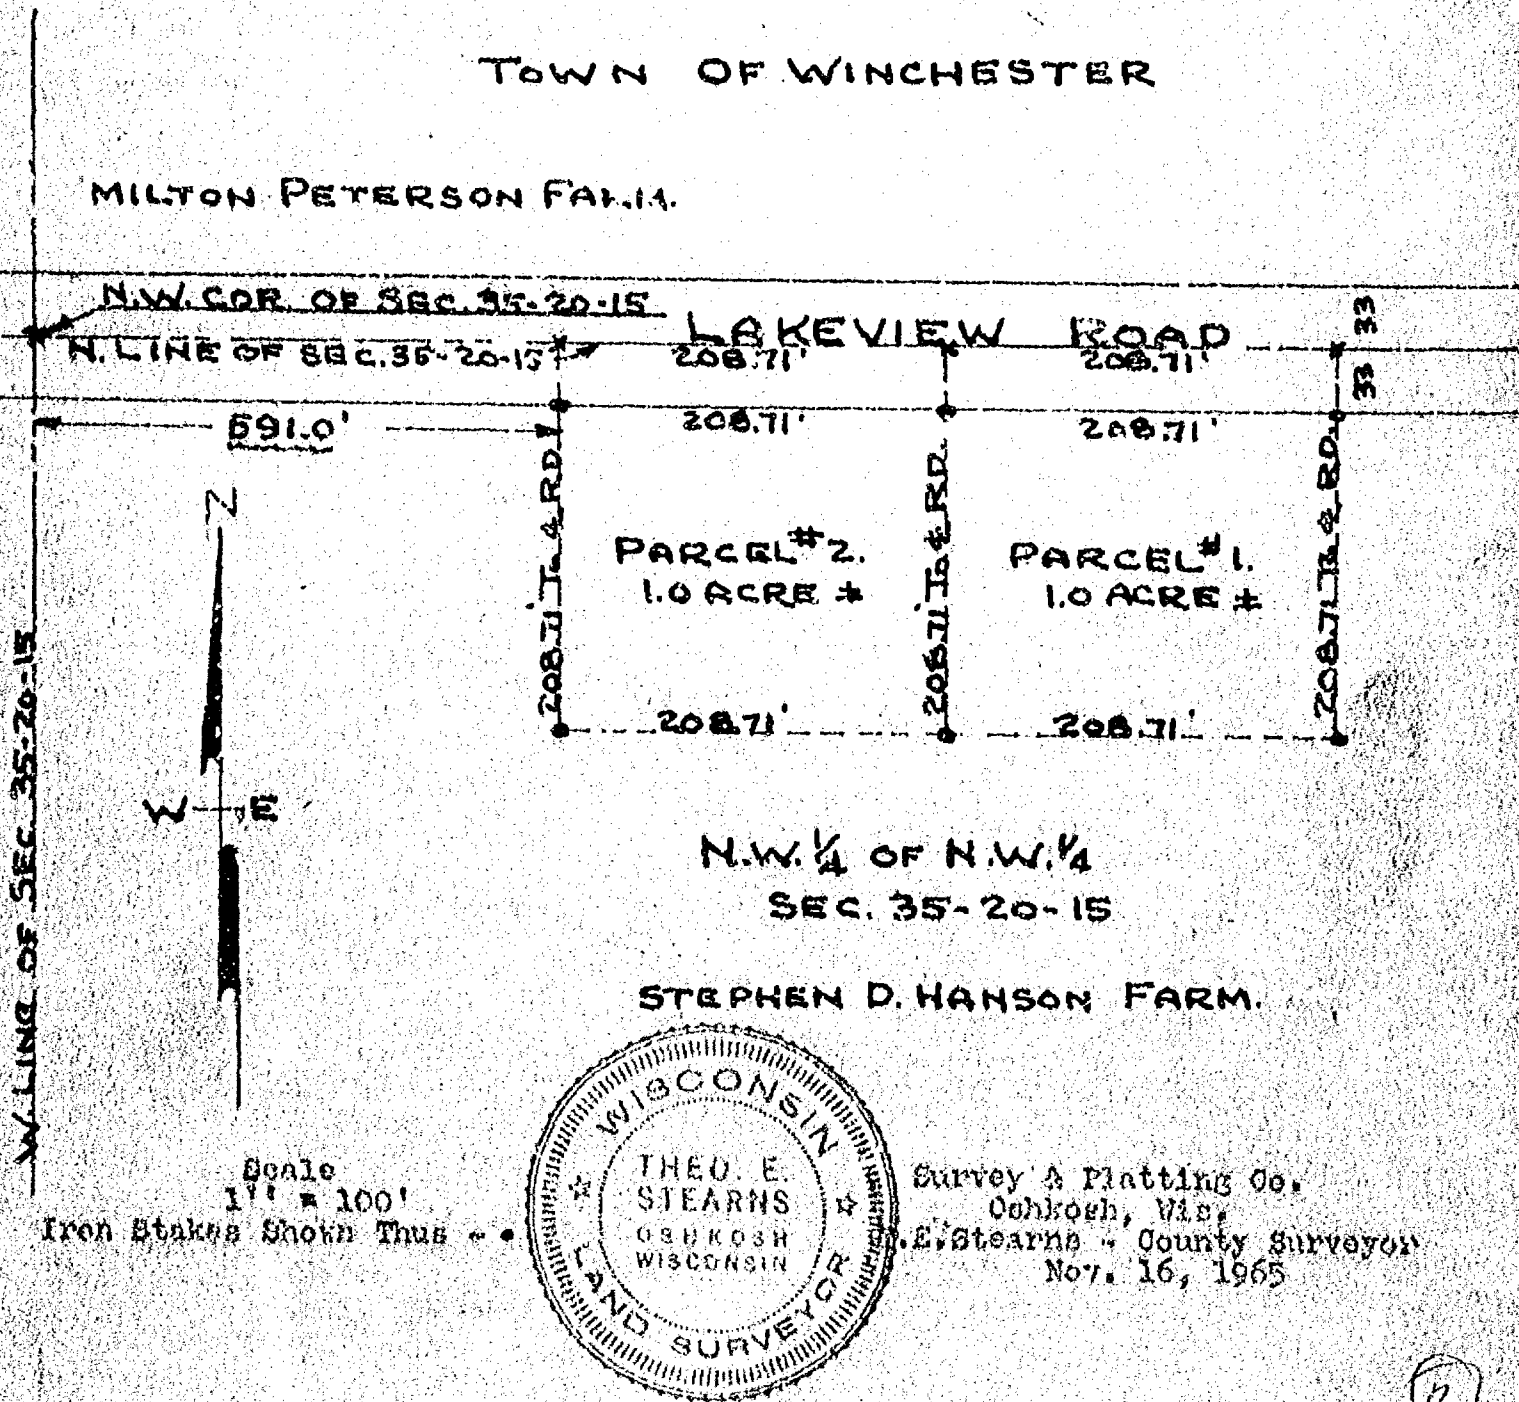

WINNEBAGO COUNTY GOVERNMENT LAND CORNER CERTIFICATE

CORNER NO. 154
SECTION 35
TOWN 20 NORTH
RANGE 15 EAST

TYPE OF MONUMENT BERNTSEN
STATE PLANE COORDINATES: N _____
S _____
ELEVATION-M.S.L. DATUM: _____
THETA ANGLE: _____
FIELD BOOK _____ PAGE _____
DRAWN BY: D.G. SPIREWKA

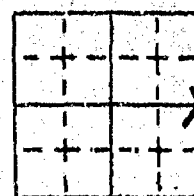


BASIS FOR MONUMENT LOCATION - PROVIDE BELOW

HISTORY OF CORNER, WITH REFERENCE TO VOLUME AND PAGE, DATES, SURVEYOR; EXACT DESCRIPTION OF MONUMENT REPLACED; IF LOCATION COMPUTED BY TAPED OR EDM TRAVERSE; LANDOWNER, WITNESSES, REMARKS, ETC. (USE REVERSE SIDE)

David Giddings, 1839, original corner post.
Sam Callahan, County Surveyor, Dec. 1856,
No. 86, and H.W. Leach, County Surveyor,
Dec. 1900, No. 600, Vol. 1, County Surveyor
Notes, Surveys by R.K. Sayler and Dave
Eisele tied to this corner. No monumentation
called for. I excavated for this corner
opposite an old fence line to the east,
found nothing. I set this corner on the
fence line east as being evidence of
Callahan's survey for North-South location
and the centerline of the road as the best
evidence of East-West location. I set a
Berntsen Monument for this corner.

SEAL:

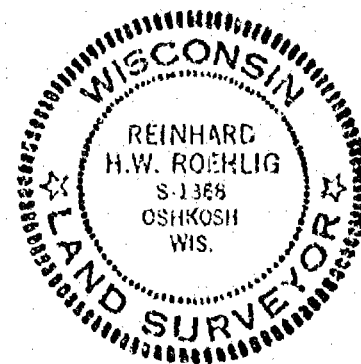

CERTIFIED CORRECT:


Reinhard Roerlig

REGISTERED LAND SURVEYOR

DATE OCT. 1, 1982

TIE SKETCH

SHOW AT LEAST FOUR TIES, ALSO FENCE LINES, ROADS, TOPO, SIZE AND TYPE OF WITNESS TREES AND ANY OTHER PERTINENT SITE DETAILS. IF OFF THE ROAD, THE BEST WAY TO ARRIVE AT THE CORNER.

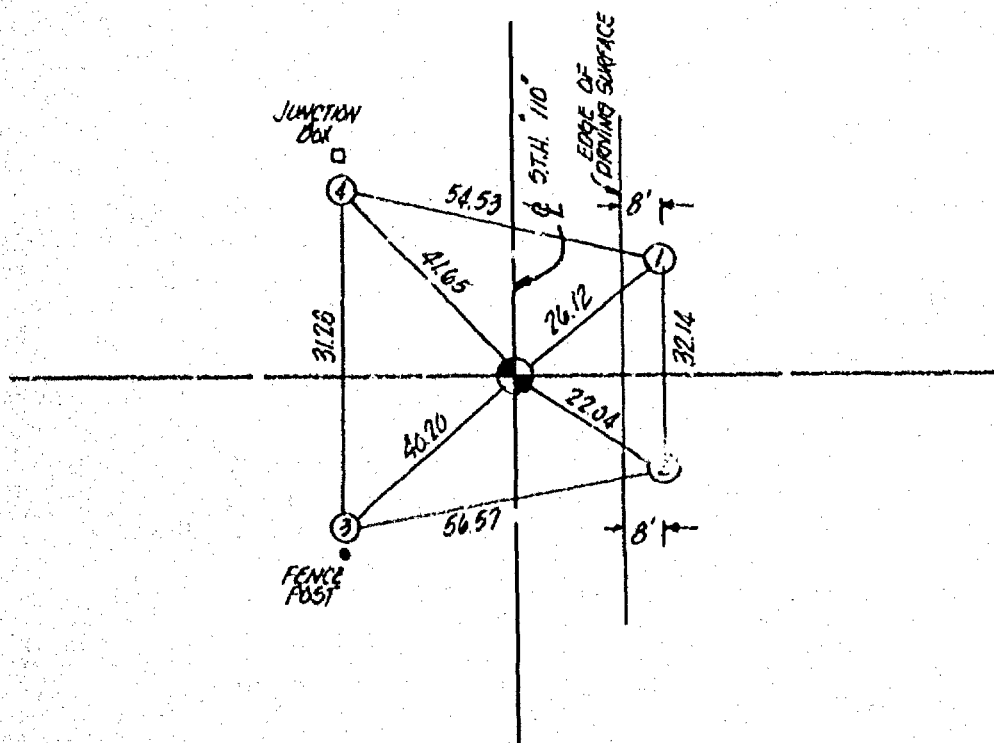

MAINTENANCE RECORD

[illegible]

**WINNEBAGO COUNTY
GOVERNMENT LAND CORNER CERTIFICATE**

TYPE OF MONUMENT BERNISEN

STATE PLANE COORDINATES: N
S


ELEVATION-M.S.L. DATUM:

THETA ANGLE:

FIELD BOOK PAGE

DRAWN BY:

CORNER NO. 154
SECTION 35
TOWN 20 NORTH
RANGE 15 EAST

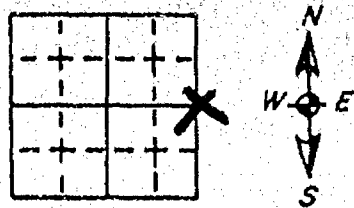


BASIS FOR MONUMENT LOCATION - PROVIDE BELOW

HISTORY OF CORNER, WITH REFERENCE TO VOLUME AND PAGE, DATES, SURVEYOR; EXACT DESCRIPTION OF MONUMENT REPLACED; IF LOCATION COMPUTED BY TAPE OR EDM TRAVERSE; LANDOWNER, WITNESSES, REMARKS, ETC. (USE REVERSE SIDE)

David Giddings, 1839, original corner post.
Sam Callahan, County Surveyor, Dec. 1856, No. 86, and H.W. Leach, County Surveyor, Dec. 1900, No. 600, Vol. 1, County Surveyor Notes. Surveys by R.K. Sayler and Dave Eisele tied to this corner. No monumentation called for. R. Roehlig excavated for this corner opposite an old fence line to the east, found nothing. Roehlig set this corner on the fence line east as being evidence of Callahan's survey for North-South location and the centerline of the road as the best evidence of East-West location. May 1994, WisDOT set new witness monuments for this corner prior to its removal by construction. New monument will be placed at corner location when construction progress permits.

SEAL:

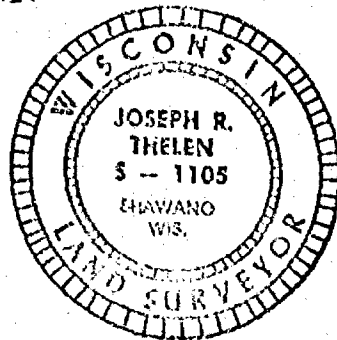


CERTIFIED CORRECT:

Joseph R. Thelen
REGISTERED LAND SURVEYOR
DATE 6-20-94

TIE SKETCH

SHOW AT LEAST FOUR TIES, ALSO FENCE LINES, ROADS, TOPO, SIZE AND TYPE OF WITNESS TREES AND ANY OTHER PERTINENT SITE DETAILS. IF OFF THE ROAD, THE BEST WAY TO ARRIVE AT THE CORNER.

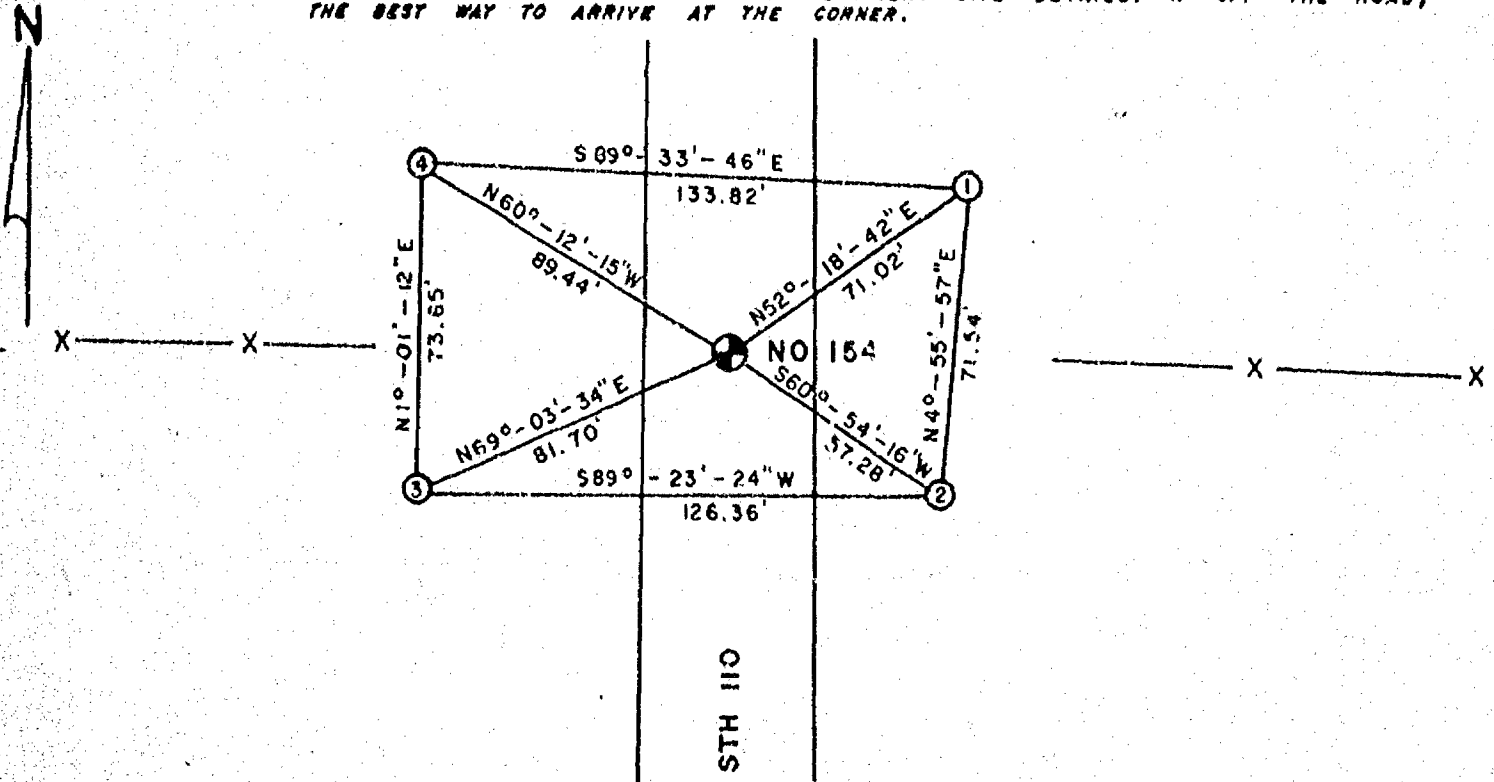


MAINTENANCE RECORD

[illegible]

WINNEBAGO COUNTY GOVERNMENT LAND CORNER CERTIFICATE

TYPE OF MONUMENT BERNTSEN
STATE PLANE COORDINATES: N
S
ELEVATION-M.S.L. DATUM:
THETA ANGLE:
FIELD BOOK PAGE
DRAWN BY: D.G. SPIREWKA

CORNER NO. 167
SECTION 35
TOWN 20 NORTH
RANGE 15 EAST

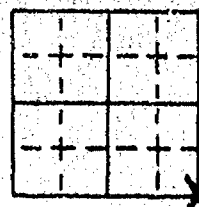


BASIS FOR MONUMENT LOCATION - PROVIDE BELOW

HISTORY OF CORNER, WITH REFERENCE TO VOLUME AND PAGE, DATES, SURVYOR; EXACT DESCRIPTION OF MONUMENT REPLACED; IF LOCATION COMPUTED BY TAPED OR EDM TRAVERSE; LANDOWNER, WITNESSES, REMARKS, ETC. (USE REVERSE SIDE)

David Giddings, 1839, original corner post. This is a common corner with the N.W. corner of Section 1-19-15, Sam Callanan, County Surveyor, Dec. 1856, No. 86, C. Palmer, County Surveyor, April 1868, No. 256, and H.W. Leach, County Surveyor, Dec. 1900, No. 600, Vol. 1, County Surveyor Notes. Recent surveys by Dale Rice, R.K. Sayler and Dave Eisele. R.K. Sayler, 1975, calls for a railroad spike at this corner. Dave Eisele, Martenson and Eisele, 1978, used the existing railroad spike for this corner location. I excavated for this corner, found nothing. I found the railroad spike used by Eisele and accepted it as the best possible location of this corner. This location fits O.G.S. (over)

SEAL:

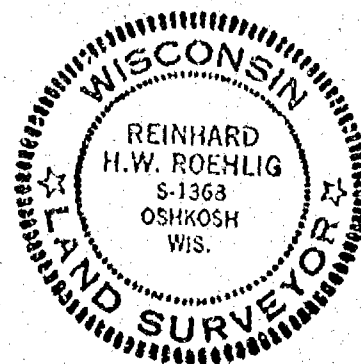


CERTIFIED CORRECT:

Reinhard Roehlig
REGISTERED LAND SURVEYOR
DATE Oct. 1, 1982

TIE SKETCH

SHOW AT LEAST FOUR TIES, ALSO FENCE LINES, ROADS, TOPO, SIZE AND TYPE OF WITNESS TREES AND ANY OTHER PERTINENT SITE DETAILS. IF OFF THE ROAD, THE BEST WAY TO ARRIVE AT THE CORNER.

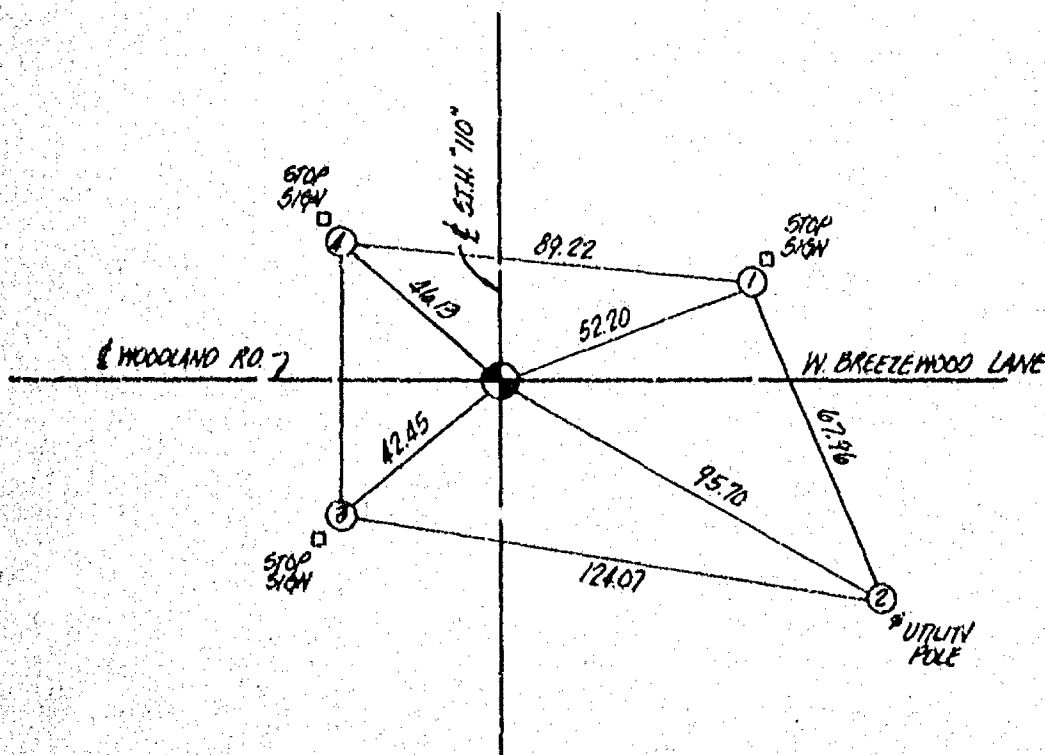




Q



WINNEBAGO COUNTY GOVERNMENT LAND CORNER CERTIFICATE

CORNER NO. 167
SECTION 35
TOWN 20 NORTH
RANGE 15 EAST

TYPE OF MONUMENT BERNTSEN
STATE PLANE COORDINATES: N _____
S _____
ELEVATION-M.S.L. DATUM: _____
THETA ANGLE: _____
FIELD BOOK _____ PAGE _____
DRAWN BY: _____

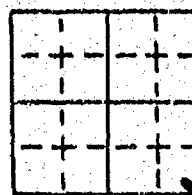


BASIS FOR MONUMENT LOCATION - PROVIDE BELOW

HISTORY OF CORNER, WITH REFERENCE TO VOLUME AND PAGE, DATES, SURVEYOR; EXACT DESCRIPTION OF MONUMENT REPLACED; IF LOCATION COMPUTED BY TAPE OR EDM TRAVERSE; LANDOWNER, WITNESSES, REMARKS, ETC. (USE REVERSE SIDE)

David Gladdings, 1839, original corner post. This is a common corner with the N.W. corner of Section 1-19-15. Sam Callahan, County Surveyor, Dec. 1856, No. 26, C. Palmer, County Surveyor, April 1868, No. 256, and H.W. Leach, County Surveyor, Dec. 1900, No. 600, Vol. 1, County Surveyor Notes. Recent surveys by Dale Rice, R.K. Sayler and Dave Eisele. R.K. Sayler, 1975, calls for a railroad spike at this corner. Dave Eisele, Martenson and Eisele, 1978, used the existing railroad spike for this corner location. R. Roehlig excavated for this corner, found nothing. Roehlig found railroad spike used by Eisele and accepted it as the best possible location of this corner. This location fits O.G.S. distances. Roehlig replaced the railroad spike with a Berntsen Monument.

SEAL:

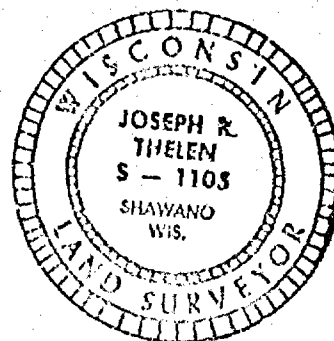


CERTIFIED CORRECT.

Joseph R. Thelen
REGISTERED LAND SURVEYOR
DATE 6-20-94

TIE SKETCH

SHOW AT LEAST FOUR TIES, ALSO FENCE LINES, ROADS, TOPO, SIZE AND TYPE OF WITNESS TREES AND ANY OTHER PERTINENT SITE DETAILS, IF OFF THE ROAD, THE BEST WAY TO ARRIVE AT THE CORNER.

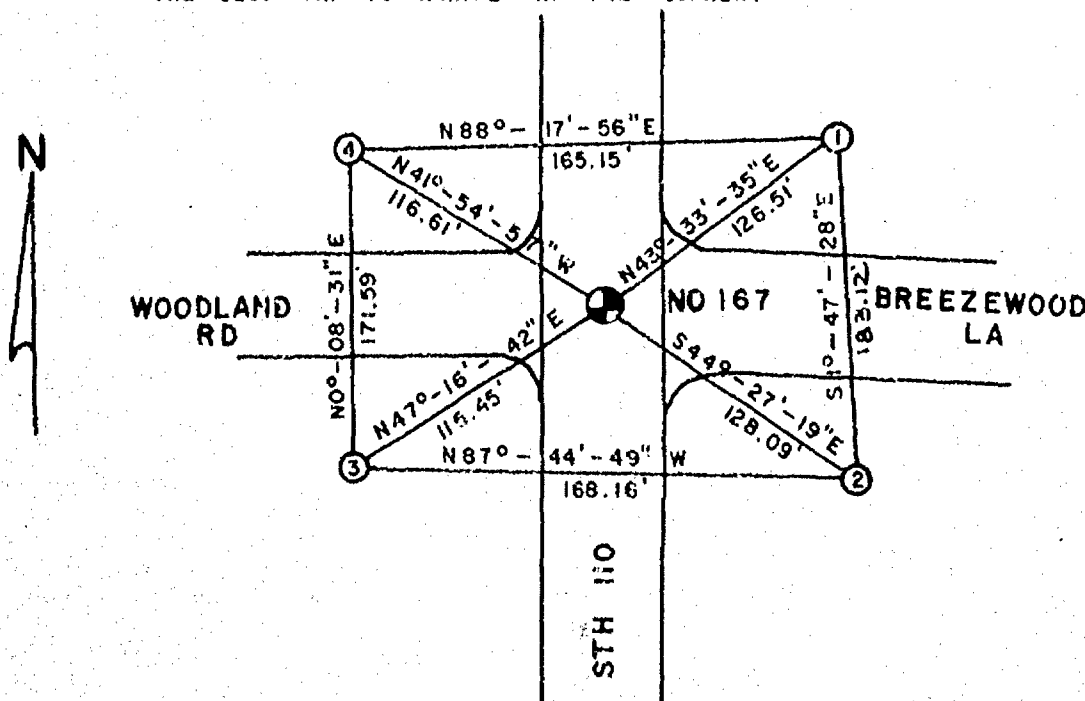

May 1994, WisDOT set new witness monuments prior to removal of corner by road construction. New monument will be placed at corner location when construction progress permits.

MAINTENANCE RECORD

[illegible]