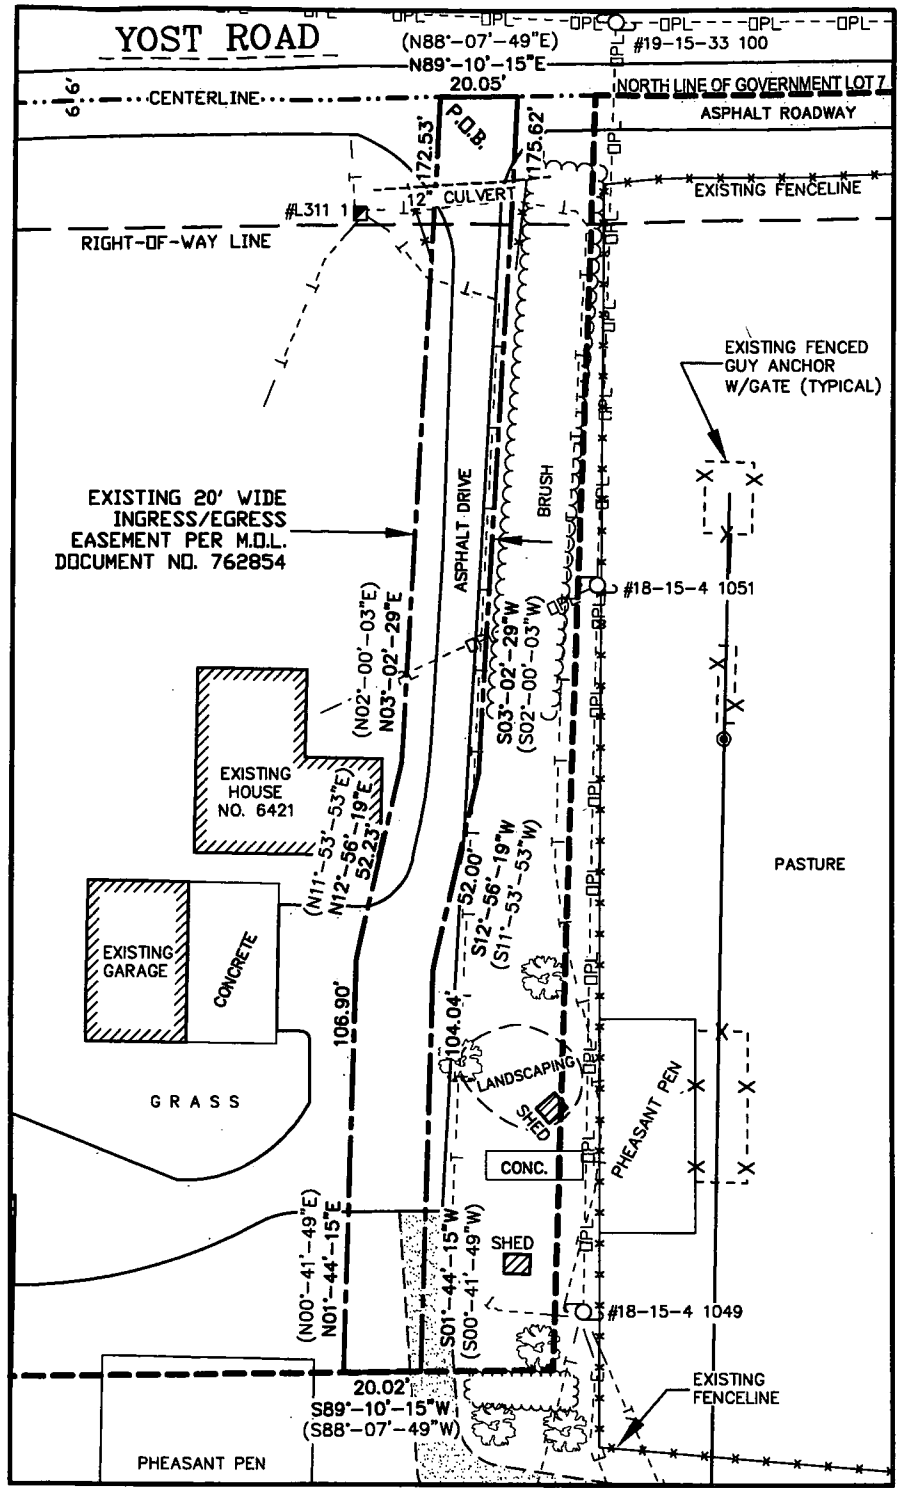

GRAPHIC SCALE

50 0 25 50 100

11" x 17" – 1" = 50'
22" x 34" – 1" = 25'

CALL DIGGERS HOTLINE TOLL FREE
1(800)242-8511
OPERATES 24 HOURS A DAY 365 DAYS A YEAR

WARNING
CALL BEFORE YOU DIG
48 HOURS BEFORE YOU DIG

WETLAND NOTE:

–THE PRESENCE AND LOCATION OF WETLANDS HAS NOT BEEN DETERMINED ON THIS PROPERTY. WETLANDS SHOULD ONLY BE DETERMINED BY ACTUAL FIELD DELINEATION PERFORMED BY A QUALIFIED WETLAND SPECIALIST.

TRUE NORTH
00°-53'-37"
GRID NORTH (NAD 83/91)

BEARINGS REFERENCED TO THE WINNEBAGO COUNTY COORDINATE SYSTEM AND THE NORTH LINE OF GOVERNMENT LOT 7, SECTION 4, T.18N., R.15E., WHICH BEARS: N89°-10'-15"E

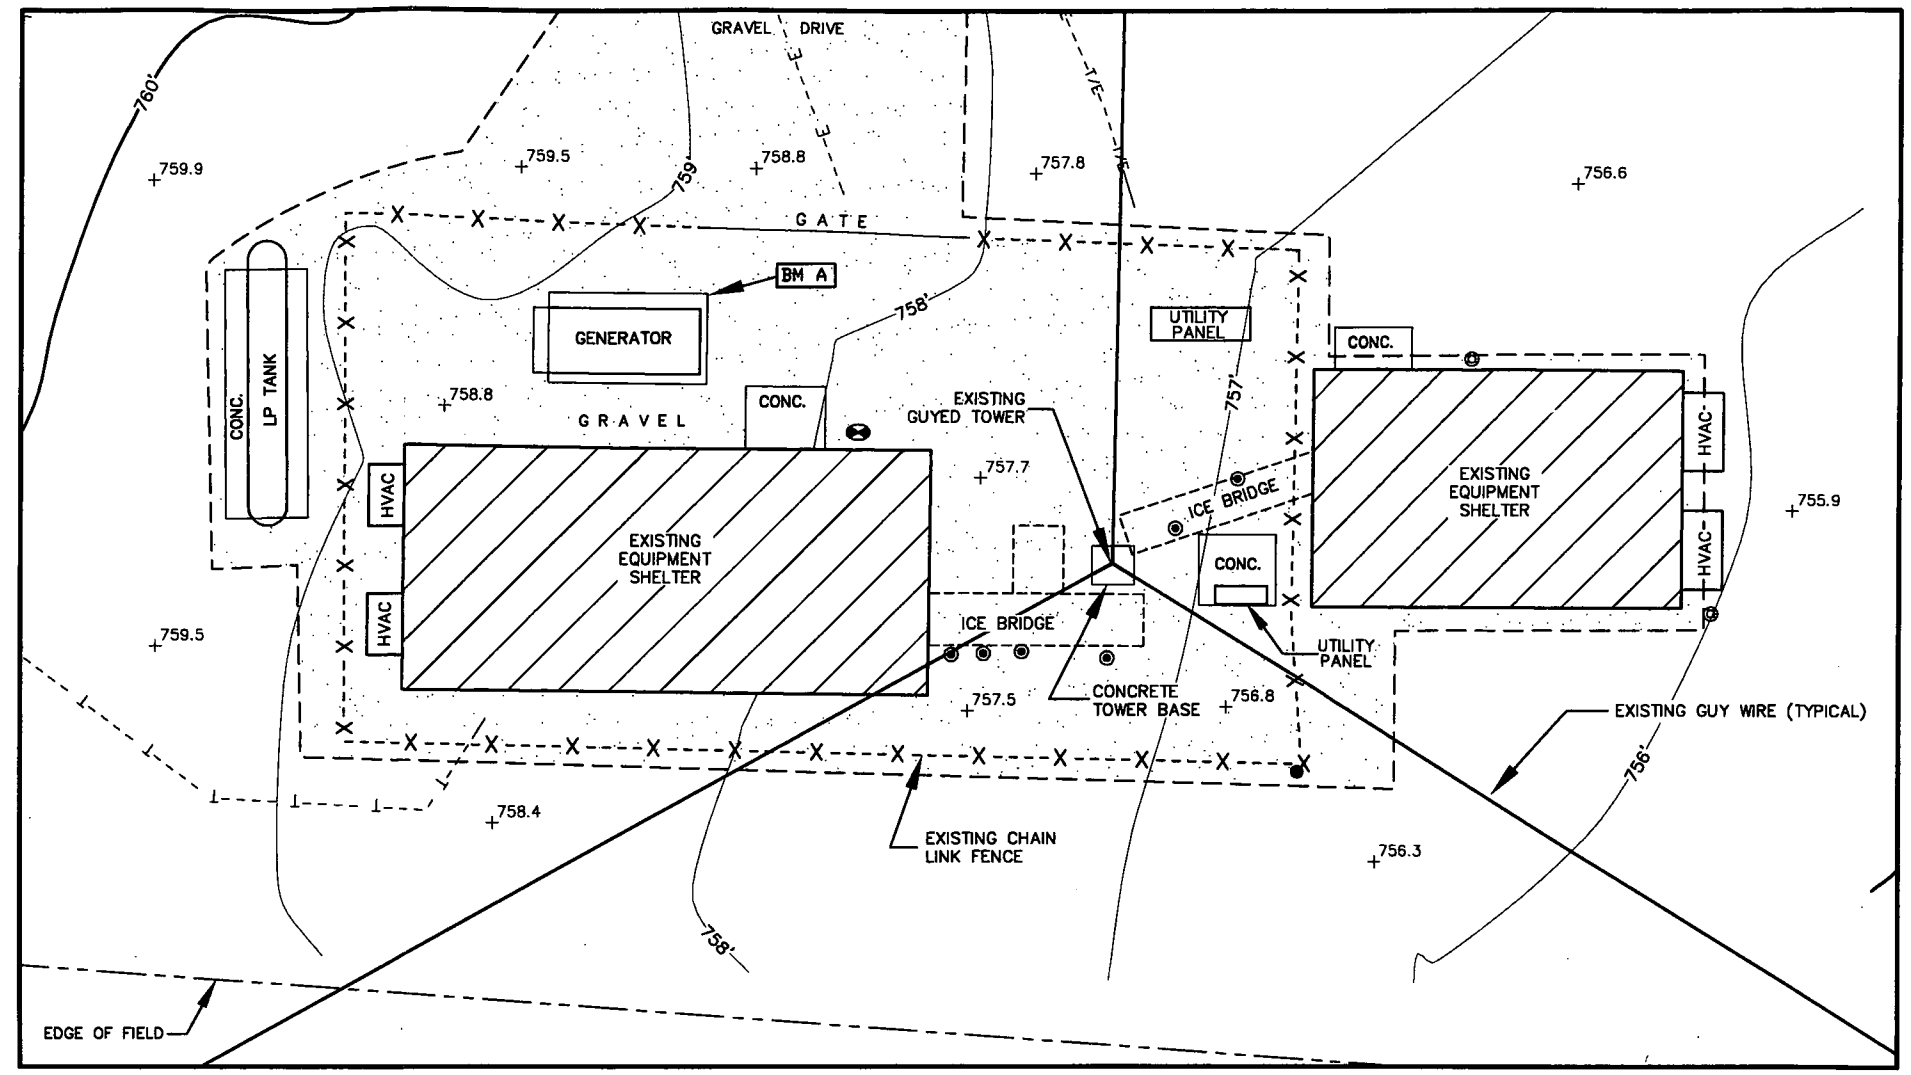

GRAPHIC SCALE

10 0 5 10 20

11" x 17" – 1" = 10'
22" x 34" – 1" = 5'

EXISTING TOWER BASE

LATITUDE: 44°-04'-06.24"
LONGITUDE: 88°-43'-09.90"
(Per North American Datum of 83/91)

Lighting Rod Elevation: 1072.7'
(Highest Point)

Top of Whip Antenna Elevation: 1071.5'
Top of Light Elevation: 1066.9'
Top of Tower Elevation: 1064.9'
Bottom of Whip Antenna Elevation: 1059.9'
Guy Wire Elevation: 1055.4'
Top of Antenna Elevation: 1010.3'
Bottom of Antenna Elevation: 1006.6'
Top of Antenna Elevation: 1009.9'
Bottom of Antenna Elevation: 1006.8'
Guy Wire Elevation: 988.7'
Guy Wire Elevation: 924.1'
Top of Light Elevation: 909.3'
Centerline of Dish Elevation: 859.7'
Guy Wire Elevation: 843.4'

Top of Tower Base Elevation: 758.1'

Ground Elevation: 757.4'
(Per North American Vertical Datum of 1988)

BENCHMARK INFORMATION
SITE BENCHMARK: (BM A)
TOP OF NORTHEAST CORNER
CONCRETE GENERATOR PAD
ELEVATION: 759.40'

I, Craig A. Keach, hereby certify that none of the property described hereon is within a flood plain as defined by FEMA.

SURVEYOR'S CERTIFICATE

I, Craig A. Keach, Wisconsin Registered Land Surveyor of Meridian Surveying, LLC., certify that I have surveyed the described property and that the map shown is a true and accurate representation thereof to the best of my knowledge and belief.

Dated this 7th day of MARCH, 2013.

WISCONSIN REGISTERED LAND SURVEYOR
Craig A. Keach, S-2333

WISCONSIN
CRAIG A. KEACH
S-2333
NEENAH WIS.
LAND SURVEYOR

–LEGEND–

- = COUNTY MONUMENT FOUND
- = GAS METER
- = METAL POST
- = GROUNDING PORT
- = TELEPHONE PEDESTAL
- = EXISTING POWER POLE
- –OPL– = OVERHEAD ELECTRIC
- –T/E– = BURIED ELEC. & TELE.
- –T– = BURIED TELEPHONE
- –E– = BURIED ELECTRIC
- = PROPERTY LINE
- = EXISTING TREE

SITE NAME: OMRO	SITE ADDRESS: 6421 YOST ROAD OMRO, WI 54963
SITE NUMBER: 776301	

MERIDIAN SURVEYING, LLC
N8774 Firelane 1
Menasha, WI 54952
Office: 920-993-0881
Fax: 920-273-6037

AS-BUILT SURVEY
FOR
US CELLULAR

BEING A PART OF GOVERNMENT LOT 7, SECTION 4, T.18N., R.15E., TOWN OF OMRO, WINNEGAGO COUNTY, WISCONSIN

NO.	DATE	DESCRIPTION	BY
1	10/22/12	Preliminary Survey	J.D.

DRAWN BY: J.D.
FIELD WORK DATE: 10-19-12
CHECKED BY: C.A.K.
FIELD BOOK: M-25, PG. 64
JOB NO.: 7015-B1233
SHEET 2 OF 2