


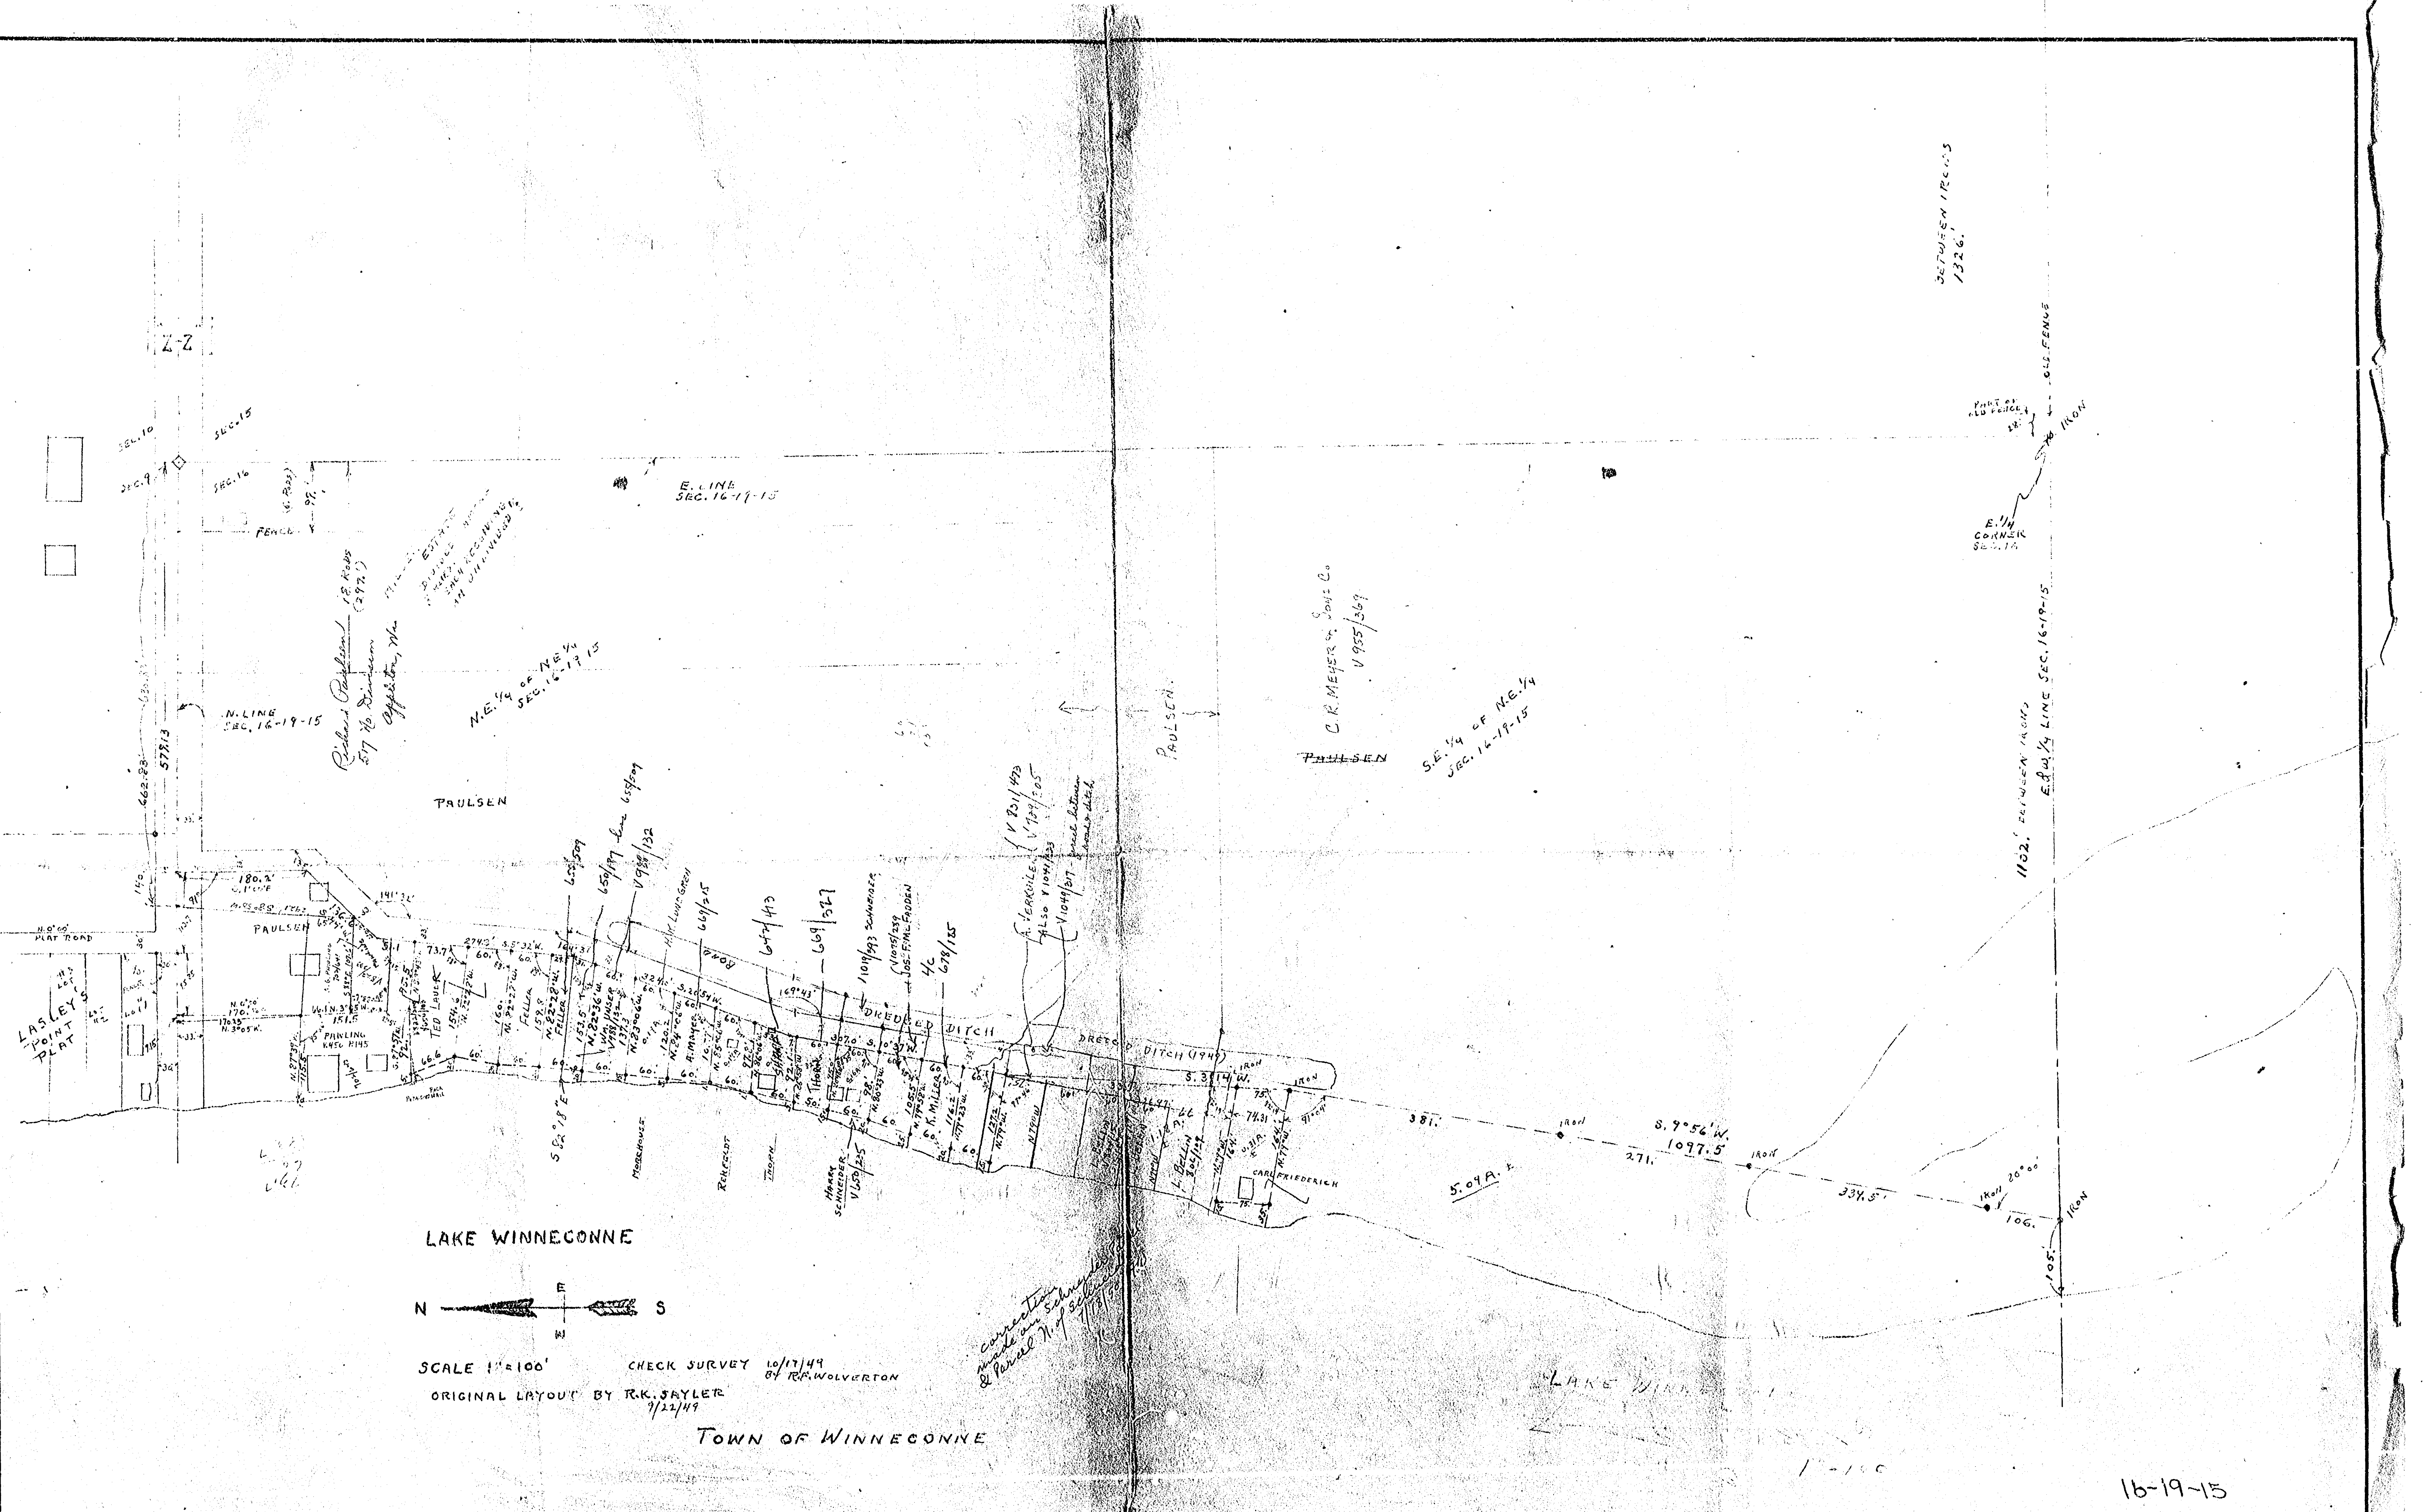

CITY OF OSHKOSH WISCONSIN ENGINEERING DEPARTMENT	APPROVED CITY ENGINEER	DRAWN		DRAWER NO.		
		TRACED				
		CHK'D.		FILE NO.		
		SCALES		SHEET NO.		
		CONNECTED TO "AS BUILT" SURVEYS		FIELD BOOK		