CITY OF


OSHKOSH


(2)

Winnebagoland Surveying
5[illegible] Avenue, Oshkosh, Wisconsin 54901
1405 East Nevada Phone (414) 426-4957

MAP OF SURVEY

NORTH 1/2 OF LOT 4, BLOCK 'E', BALDWIN - KNAPP - FITZGERALD'S ADDITION, 10TH WARD, CITY OF OSHKOSH, WINNEBAGO COUNTY, WISCONSIN

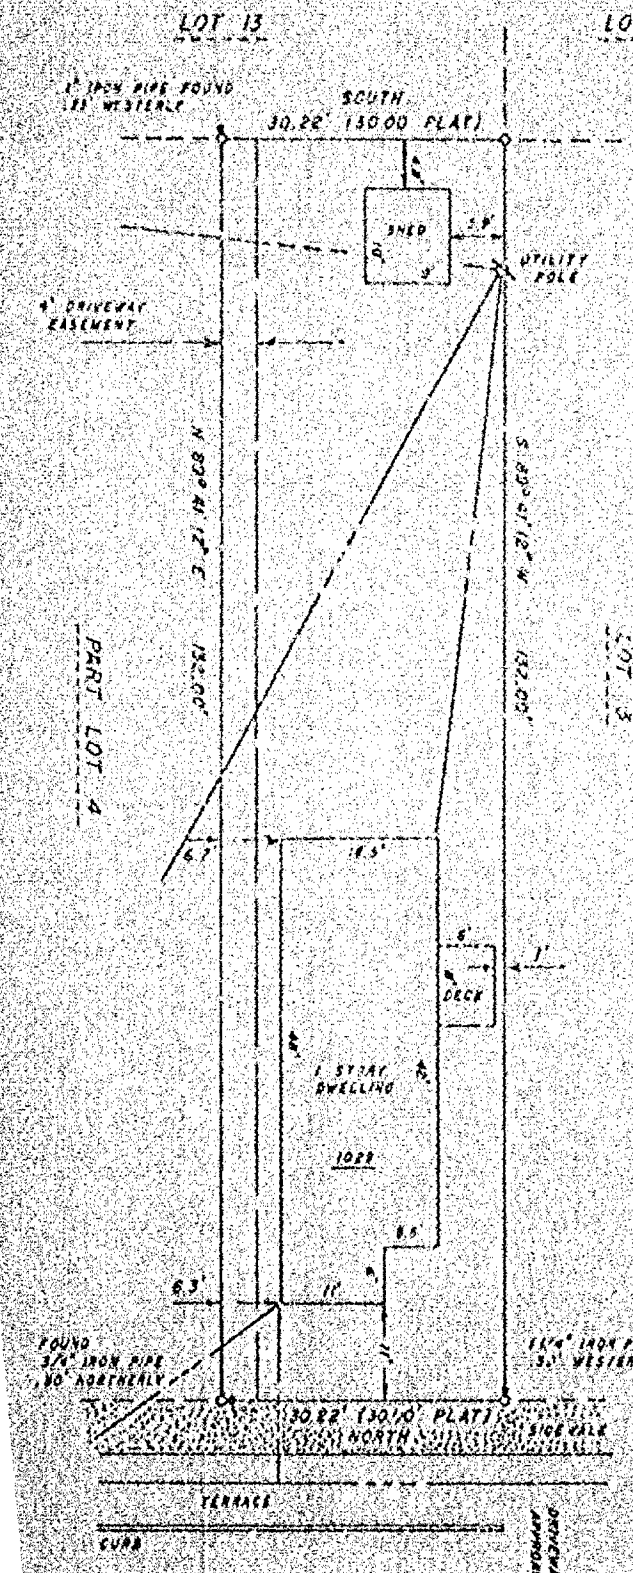

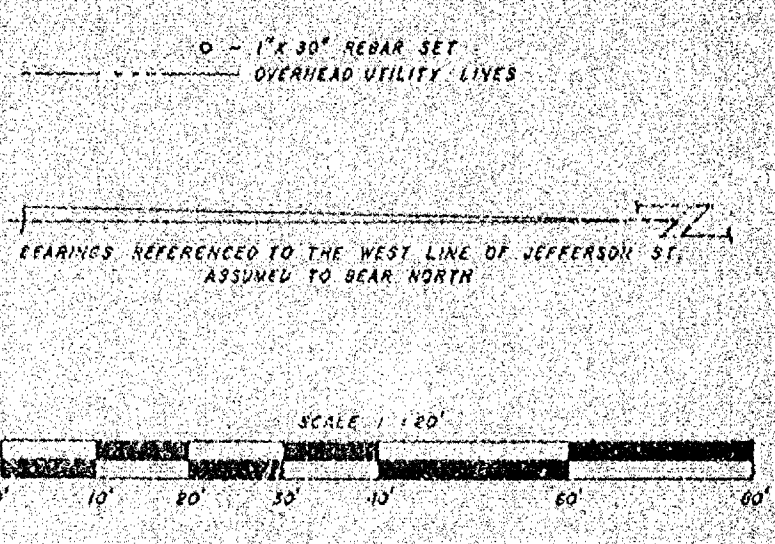


SURVEYOR'S CERTIFICATE

I, ALAN K. SHUTE, WISCONSIN REGISTERED LAND SURVEYOR, HAVE SURVEYED THE SITE SHOWN ON THIS MAP. THIS SURVEY AND MAP REFLECT THE SITE DESCRIBED IN LAND CONTRACT #547254 AND SHOWS THE SIZE AND LOCATION OF THE PROPERTY, ITS EXTERIOR BOUNDARIES, THE SIZE AND LOCATION OF ALL STRUCTURES THEREON, FENCES, APPARENT EASEMENTS, ROADWAYS AND VISIBLE ENCROACHMENTS, IF ANY. THIS SURVEY IS MADE FOR THE EXCLUSIVE USE OF LEONA DIXON, 1029 JEFFERSON STREET, OSHKOSH, WISCONSIN, 54901 AND THOSE WHO PURCHASE, MORTGAGE OR GUARANTEE THE TITLE THERETO WITHIN ONE (1) YEAR FROM THE DATE HEREOF. TO THEM I CERTIFY THAT THIS SURVEY AND MAP WERE MADE IN ACCORDANCE WITH ACCEPTABLE PROFESSIONAL STANDARDS AND IN MY PROFESSIONAL OPINION THE ACCOMPANYING MAP IS A TRUE AND ACCURATE REPRESENTATION OF THIS SITE TO THE BEST OF MY KNOWLEDGE, INFORMATION AND BELIEF.

Alan K. Shute

ALAN K. SHUTE S-1518
DATED THIS 24th DAY OF OCTOBER, 1983

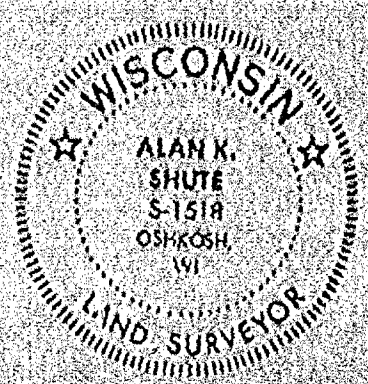


NO. 19-1070-83 | LEONA DIXON, 1029 JEFFERSON STREET, OSHKOSH, WISCONSIN 54901 | PAGE 1 OF 1

[illegible]BOOK 102 PAGES 57, 58 | DRAWN BY: ALAN K. SHUTE

Winnebagoland Surveying
511 Baldwin Avenue, Oshkosh, Wisconsin 54901
Phone (414) 426-4957

MAP OF SURVEY

LOTS 4 AND 5, BANDEROB'S SUBDIVISION, 8TH WARD,
CITY OF OSHKOSH, WINNEBAGO COUNTY,
WISCONSIN

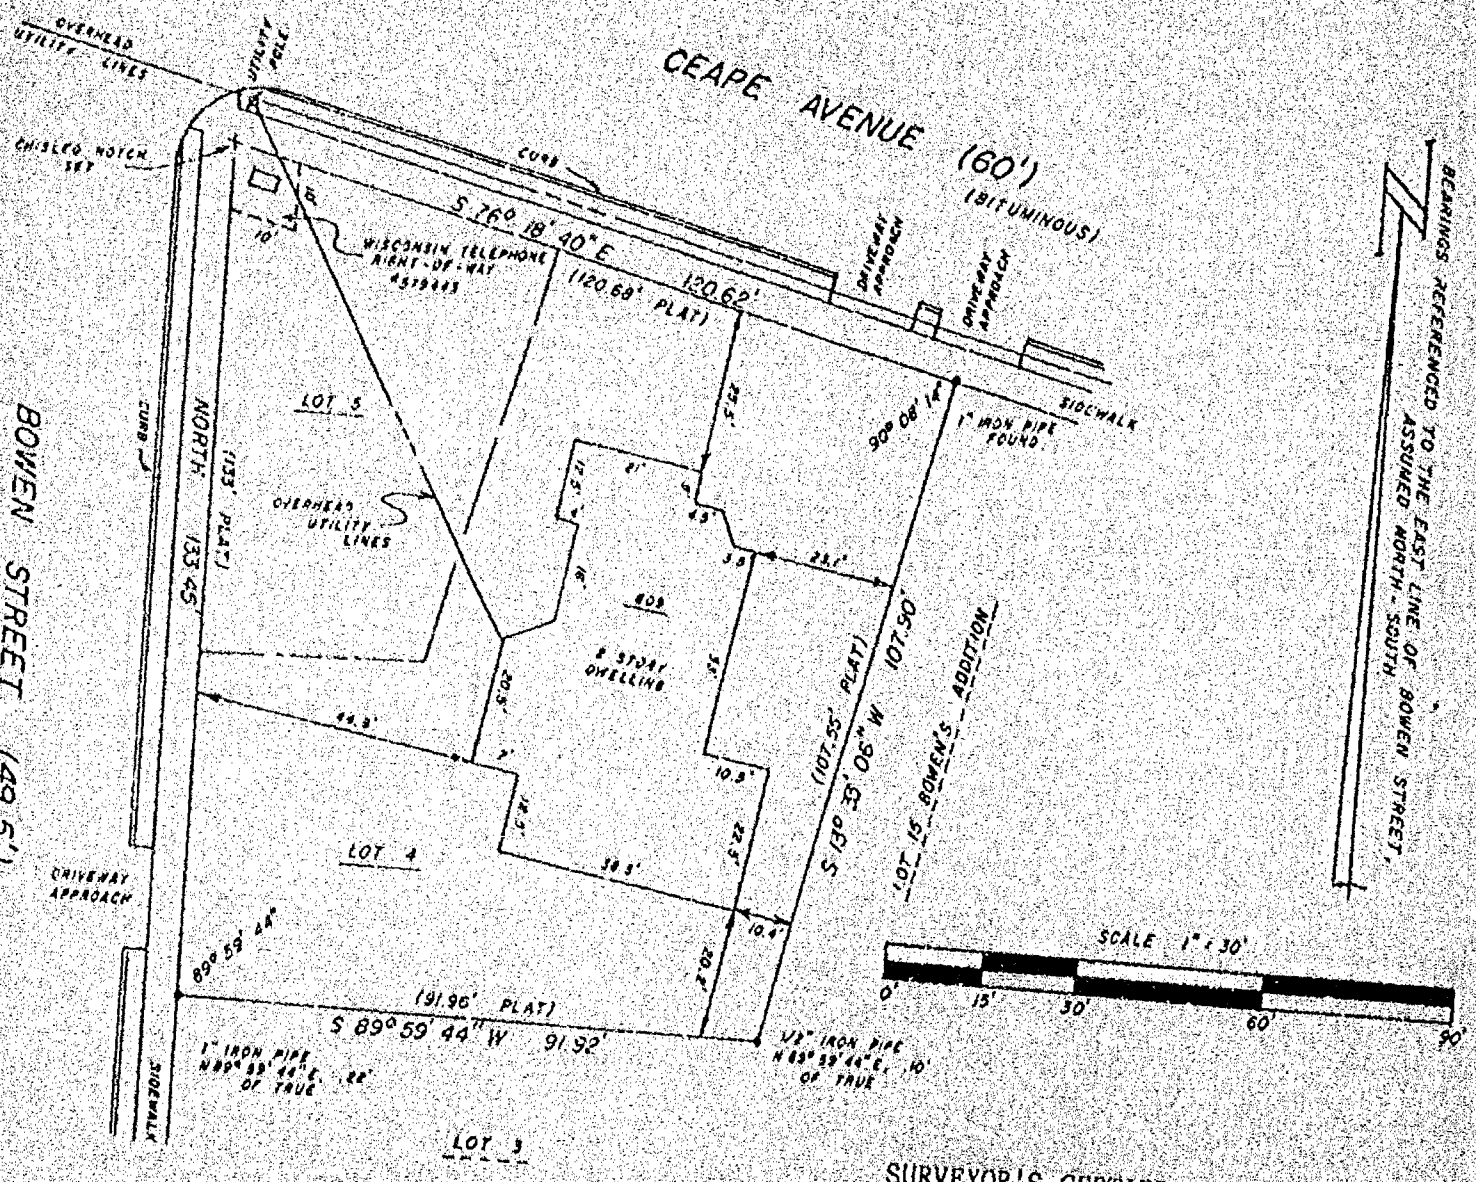

SURVEYOR'S CERTIFICATE

I, ALAN K. SHUTE, WISCONSIN REGISTERED LAND SURVEYOR, HAVE SURVEYED THE SITE SHOWN ON THIS MAP. THIS SURVEY AND MAP REFLECT THE SITE DESCRIBED IN WARRANTY DEED #436474 AND SHOWS THE SIZE AND LOCATION OF THE PROPERTY, ITS EXTERIOR BOUNDARIES, THE SIZE AND LOCATION OF ALL STRUCTURES THEREON, FENCES, APPARENT EASEMENTS, ROADWAYS AND VISIBLE ENCROACHMENTS, IF ANY. THIS SURVEY IS MADE FOR THE EXCLUSIVE USE OF THOMAS V. KISER, 2 SOUTH PARK AVENUE, FOND DU LAC, WISCONSIN AND THOSE WHO PURCHASE, MORTGAGE OR GUARANTEE THE TITLE THERETO WITHIN ONE (1) YEAR FROM THE DATE HEREOF. TO THEM I CERTIFY THAT THIS SURVEY AND MAP WERE MADE IN ACCORDANCE WITH ACCEPTABLE PROFESSIONAL STANDARDS AND IN MY PROFESSIONAL OPINION THE ACCOMPANYING MAP IS A TRUE AND ACCURATE REPRESENTAION OF THIS SITE TO THE BEST OF MY KNOWLEDGE, INFORMATION AND BELIEF.


WISCONSIN
ALAN K. SHUTE
S-1518
OSHKOSH, WI
LAND SURVEYOR


Alan K. Shute


ALAN K. SHUTE S-1518

DATED THIS 28th DAY OF SEPTEMBER, 1983

JOB NO. 19-1069-83	THOMAS V. KISER 2 SOUTH PARK AVENUE FOND DU LAC, WISCONSIN	PAGE 1 OF 1
FIELDBOOK 102, PAGES 51, 52		DRAWN BY ALAN K. SHUTE

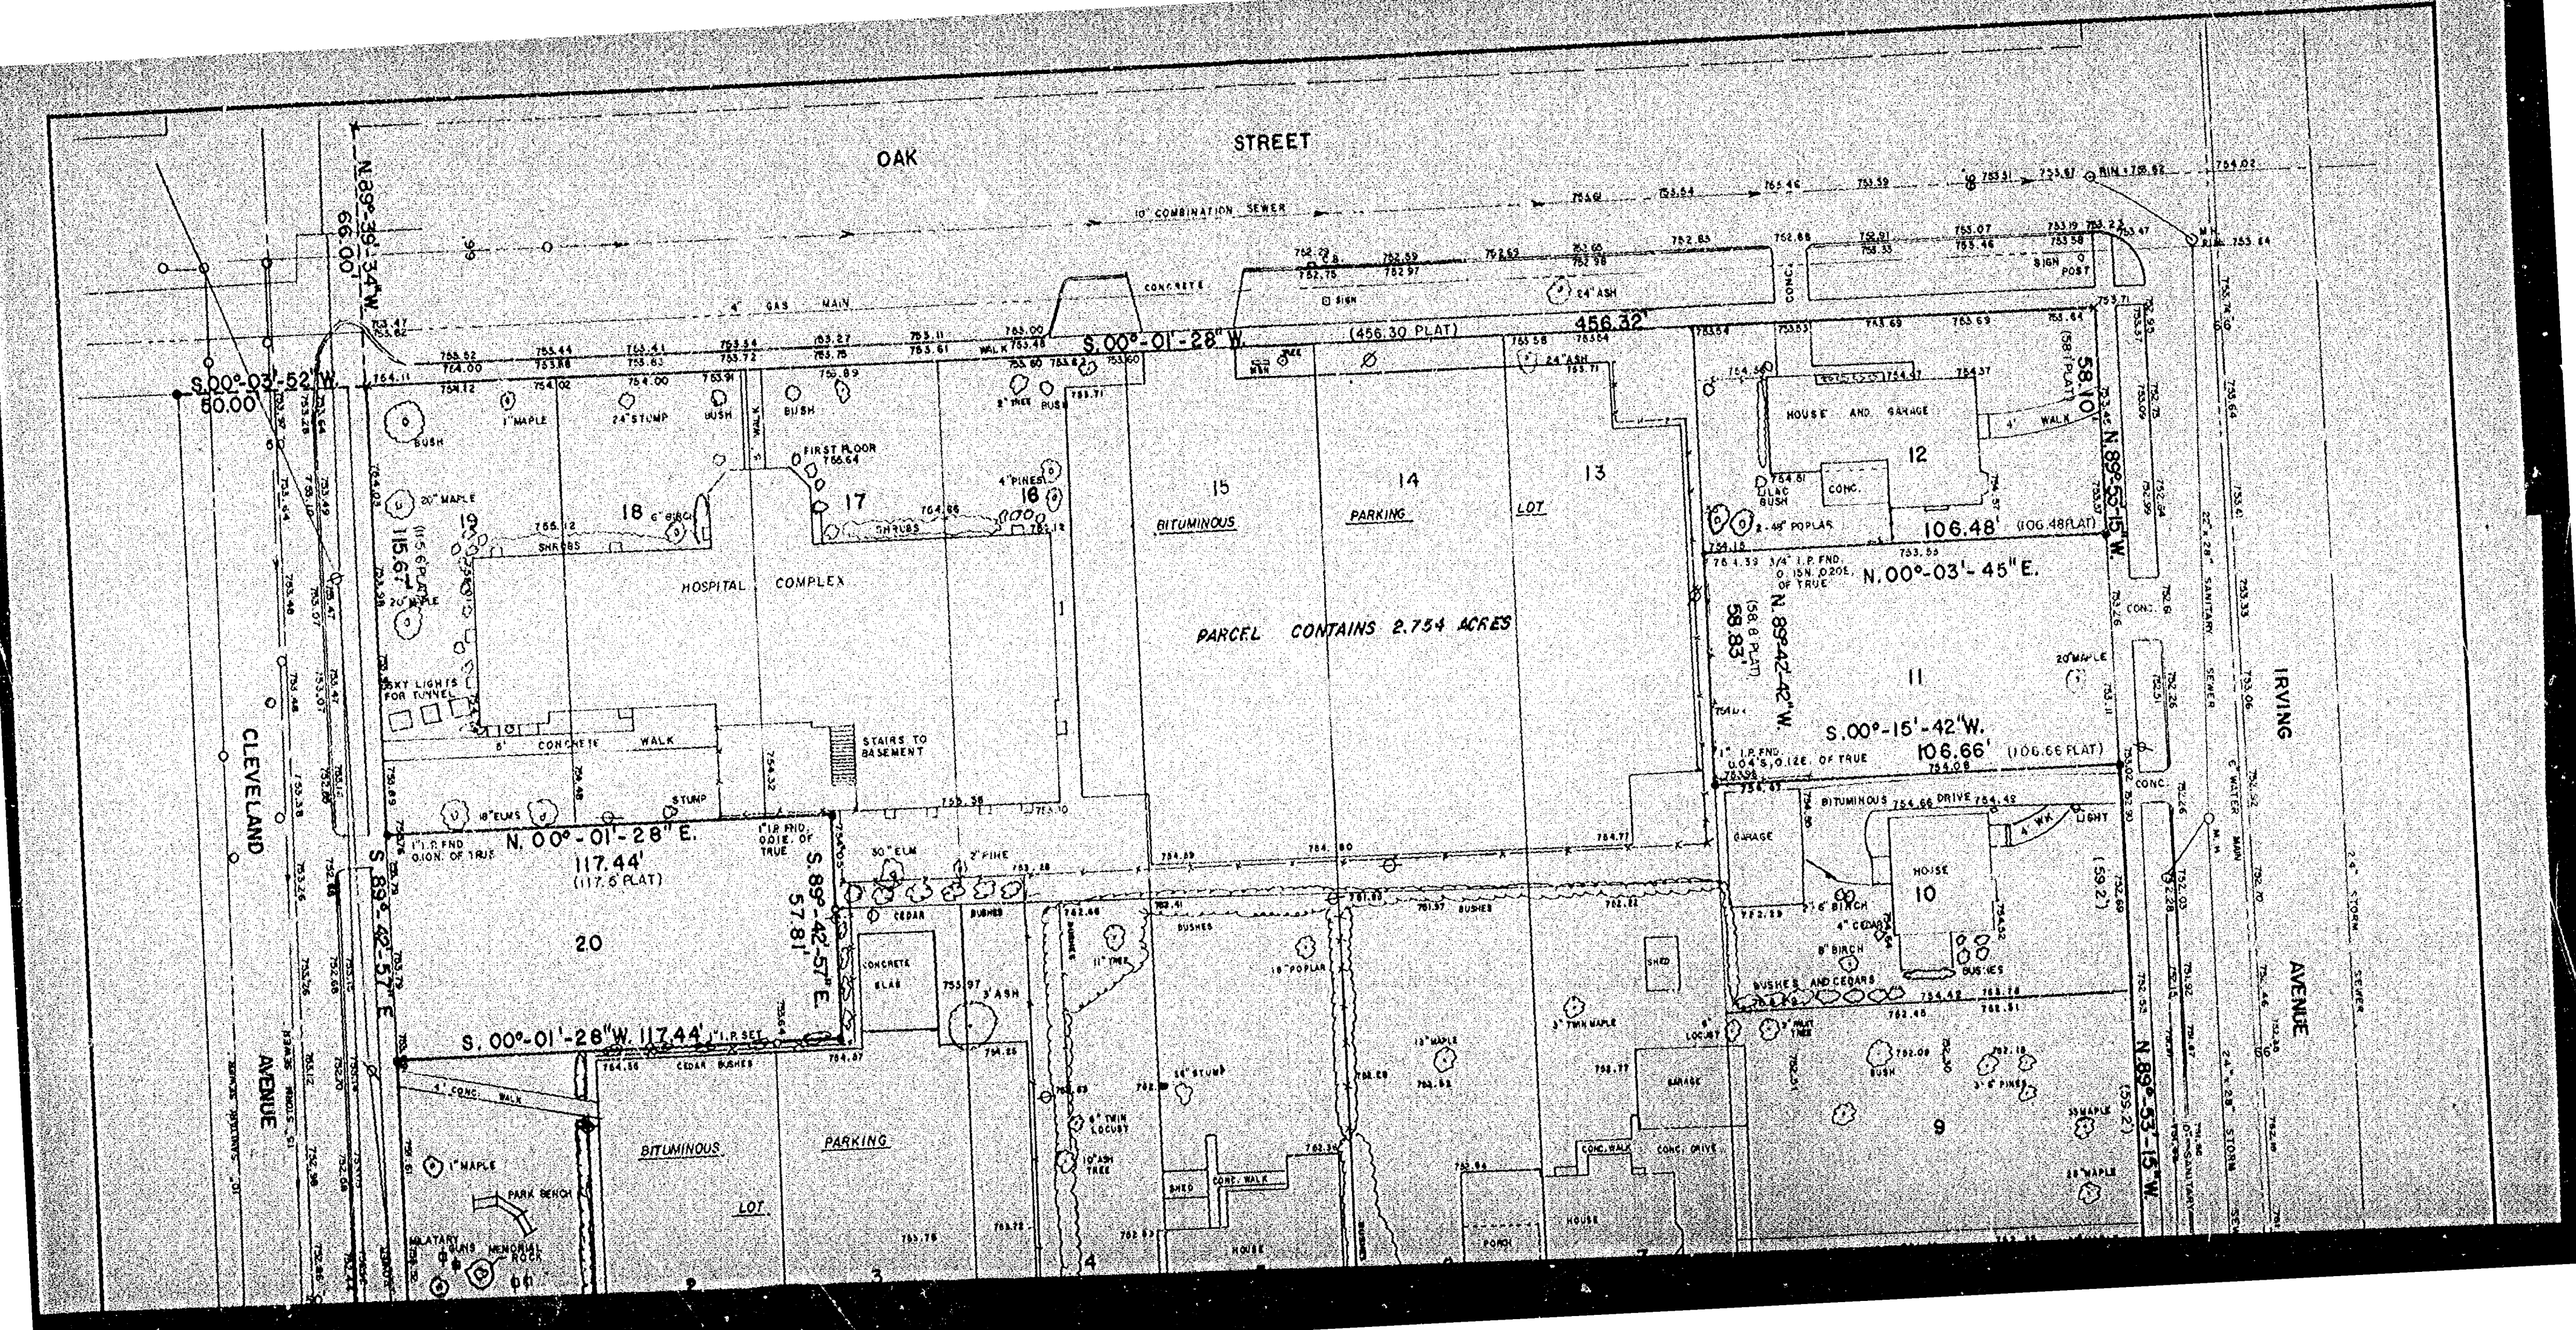
OAK STREET
CLEVELAND AVENUE
IRVING AVENUE
N.89°-39'-34"W. 66.00'
S.00°-03'-52"W. 60.00
S.00°-01'-28"W. (456.30 PLAT) 456.32'
N.89°-53'-15"W. 58.10' (58' PLAT)
N.89°-53'-15"W. 106.48' (106.48 PLAT)
N.00°-03'-45"E.
N.89°-42'-42"W. 58.83' (58.8 PLAT)
S.00°-15'-42"W. 106.66' (106.66 PLAT)
N.00°-01'-28"E. 117.44' (117.6 PLAT)
S.89°-42'-57"E. 57.81'
S.00°-01'-28"W. 117.44'
N.89°-53'-15"W. (55.2')
HOSPITAL COMPLEX
PARCEL CONTAINS 2.754 ACRES
BITUMINOUS PARKING LOT
HOUSE AND GARAGE
BITUMINOUS DRIVE
10" COMBINATION SEWER
4" GAS MAIN
8" WATER MAIN
24"x 28" SANITARY SEWER
24" STORM SEWER
SKY LIGHTS FOR TUNNEL
STAIRS TO BASEMENT
FIRST FLOOR 766.64
CONCRETE WALK
CONCRETE SLAB
SHED
GARAGE
HOUSE
PORCH
CONC. WALK
CONC. DRIVE
PARK BENCH
MEMORIAL ROCK
SHRUBS
BUSHES
BUSHES AND CEDARS
CEDAR BUSHES
SIGN
SIGN POST
LIGHT
MH
1" I.P. FND. O.ISN. OF TRUE
1" I.P. FND. O.0.I.E. OF TRUE
3/4" I.P. FND. O.ISN. 0.20S. OF TRUE
1" I.P. FND. O.0.4'S, 0.12E. OF TRUE
1" I.P. SET
1 2 3 4 5 6 7 8 9 10 11 12 13 14 15 16 17 18 19 20

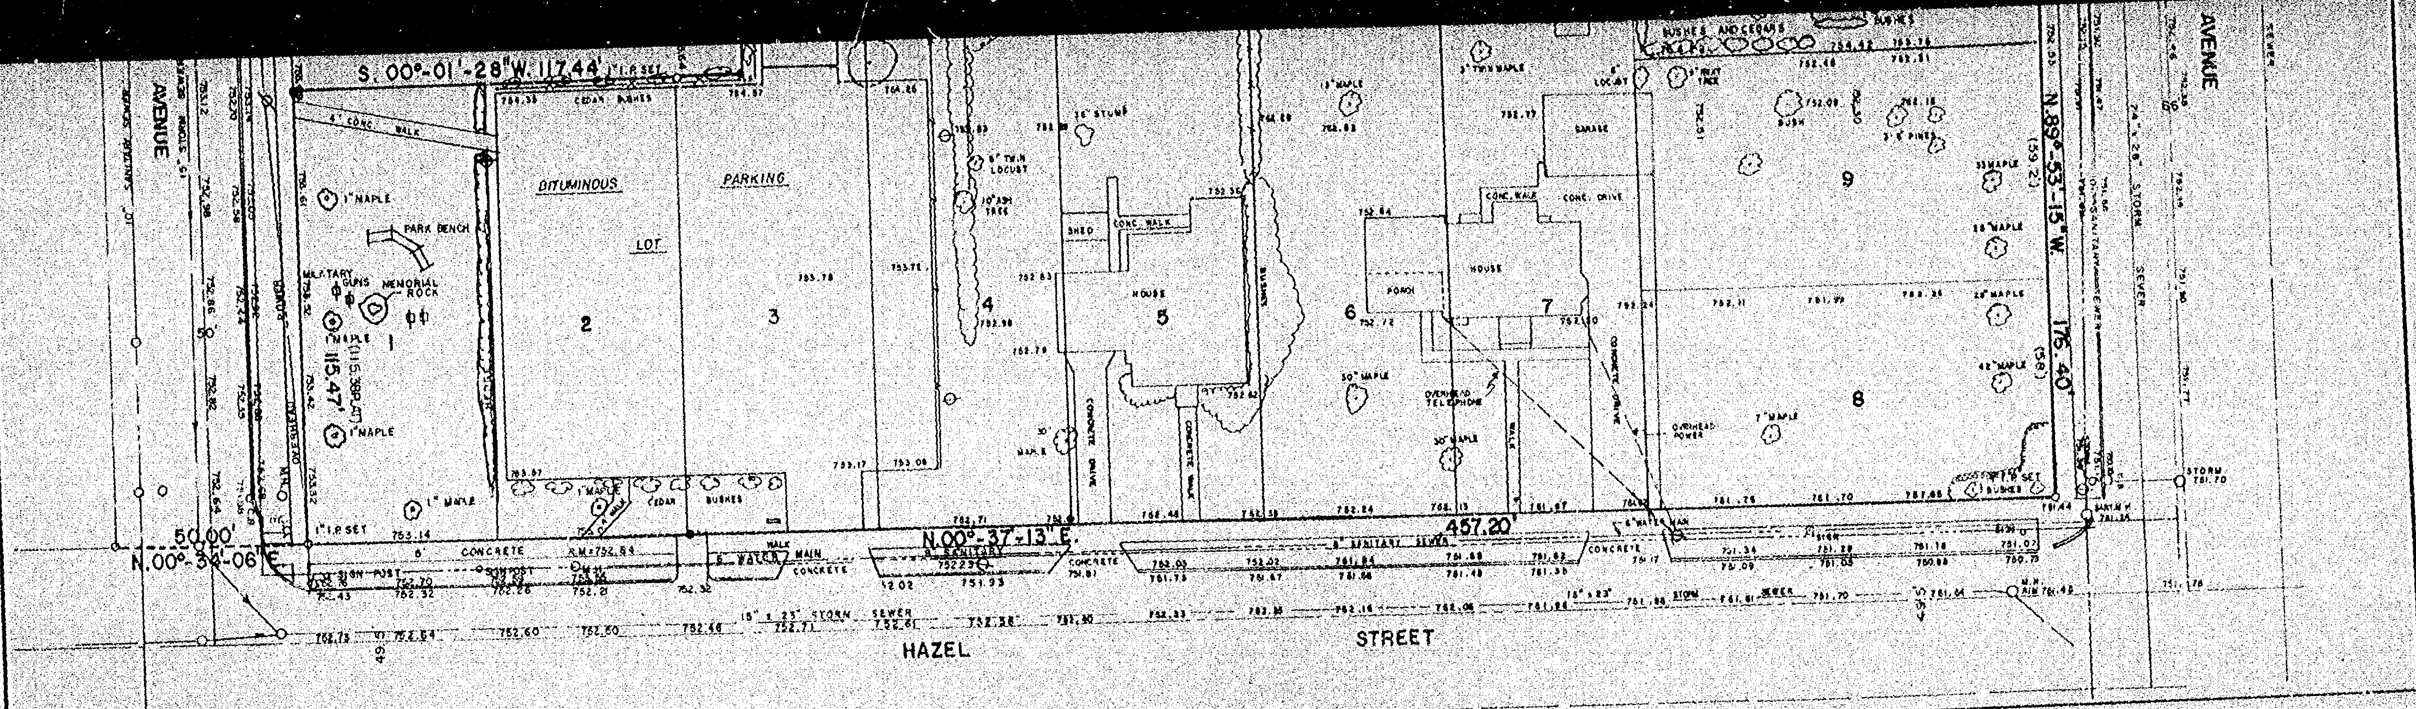
S. 00°-01'-28"W. 117.44'
AVENUE
BITUMINOUS
PARKING
LOT
PARK BENCH
MILITARY GUNS
MEMORIAL ROCK
1" MAPLE
115.47'
1" I.P. SET
753.14
50.00'
N.00°-34'-06"E.
6" CONCRETE
R.M.=752.84
752.70
752.32
752.26
752.21
752.32
CEDAR BUSHES
WALK
6" WATER MAIN
CONCRETE
N.00°-37'-13"E.
457.20'
8" SANITARY SEWER
752.23
751.93
752.02
CONCRETE
751.91
751.73
751.67
751.66
751.48
751.35
751.09
751.05
751.03
751.00
750.75
CONCRETE
751.17
751.34
751.29
751.18
751.02
750.88
750.75
751.09
751.05
751.04
M.H. RIM 751.48
751.70
751.76
751.70
751.68
751.44
751.35
751.70
STORM 751.70
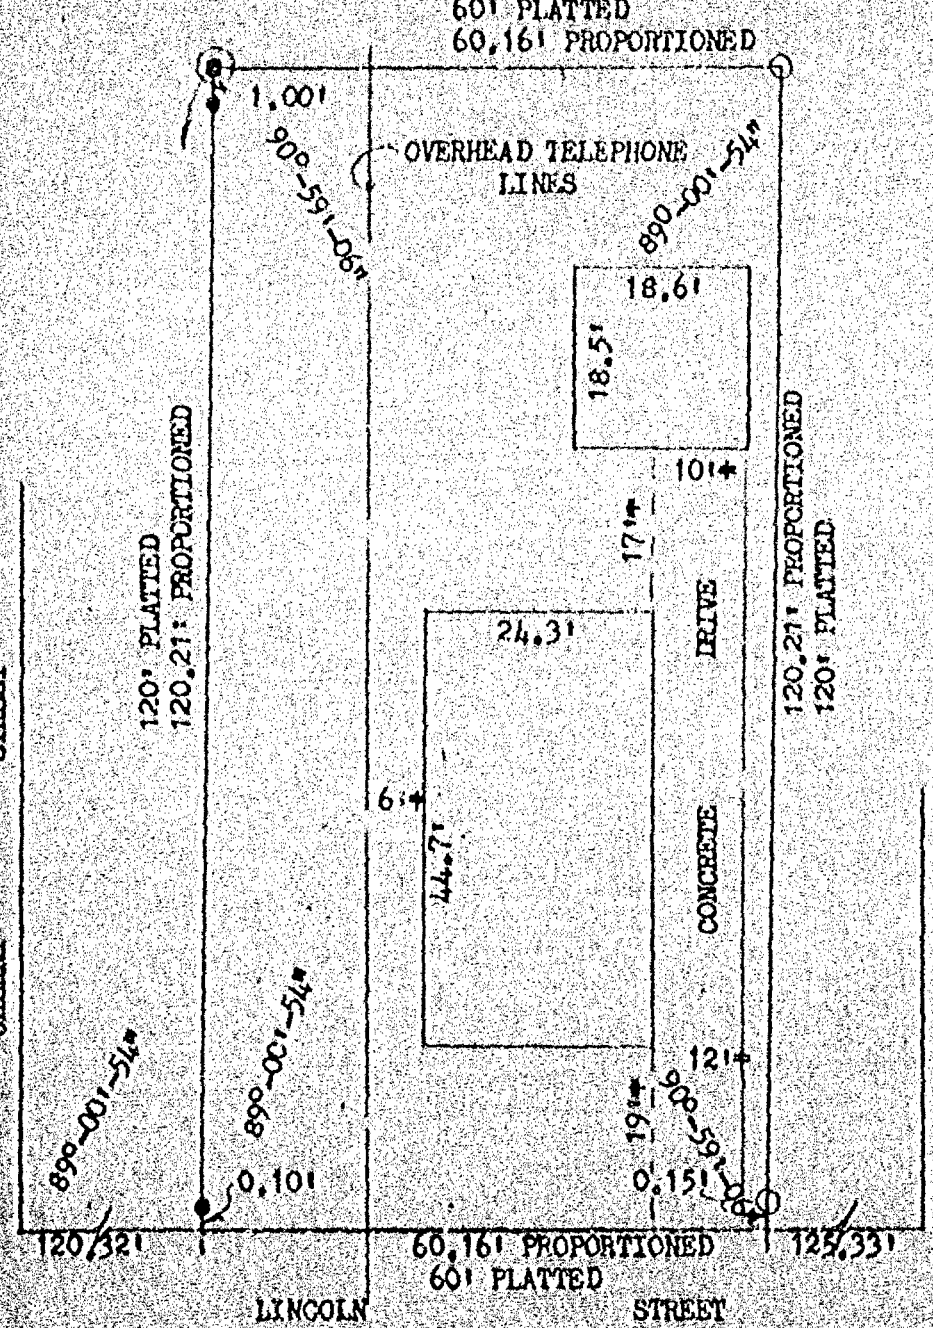

SONTAG - 614 W. LINCOLN STREET

DESCRIPTION: LOT 22, BLOCK 138, HOW WRIGHT & PECK'S ADDITION, FIFTH WARD, CITY OF OSHKOSH, WINNEBAGO COUNTY, WISCONSIN.

LEGEND

○ = ½" IRON PIPE FOUND

| = CHISEL NOTCH SET IN CONCRETE WALK

● = 3/4" x 24" SOLID ROUND #6 REBAR SET

(■) = 5" SPIKE SET IN 15" BOX ELDER

HOUSE IS A TWO STORY.

THERE ARE NO BUILDING ENCROACHMENTS.


WISCONSIN
ROBERT F. REIDER
S-1251
APPLETON, WI
LAND SURVEYOR

I, ROBERT F. REIDER, CERTIFY THAT THIS PLAT OF SURVEY IS A CORRECT REPRESENTATION OF THE PROPERTY DESCRIBED.

Robert F. Reider 6-28-83


ROBERT F. REIDER, RLS-1251 DATED

REVISIONS	FLEET MORTGAGE CORP. 3127 W. SPENCER ST., APPLETON, WIS. 54911		
A.S.B. 6-29-83 RFR	CAROW LAND SURVEYING CO., INC., P.O. BOX 1297 1837 W. WISCONSIN AVE. • APPLETON, WI 54912		
	DRAWN BY RFR 2	SCALE 1"=20'	DRAWING NO. A826.34
	APP'D LEO	DATE 6-28-83	

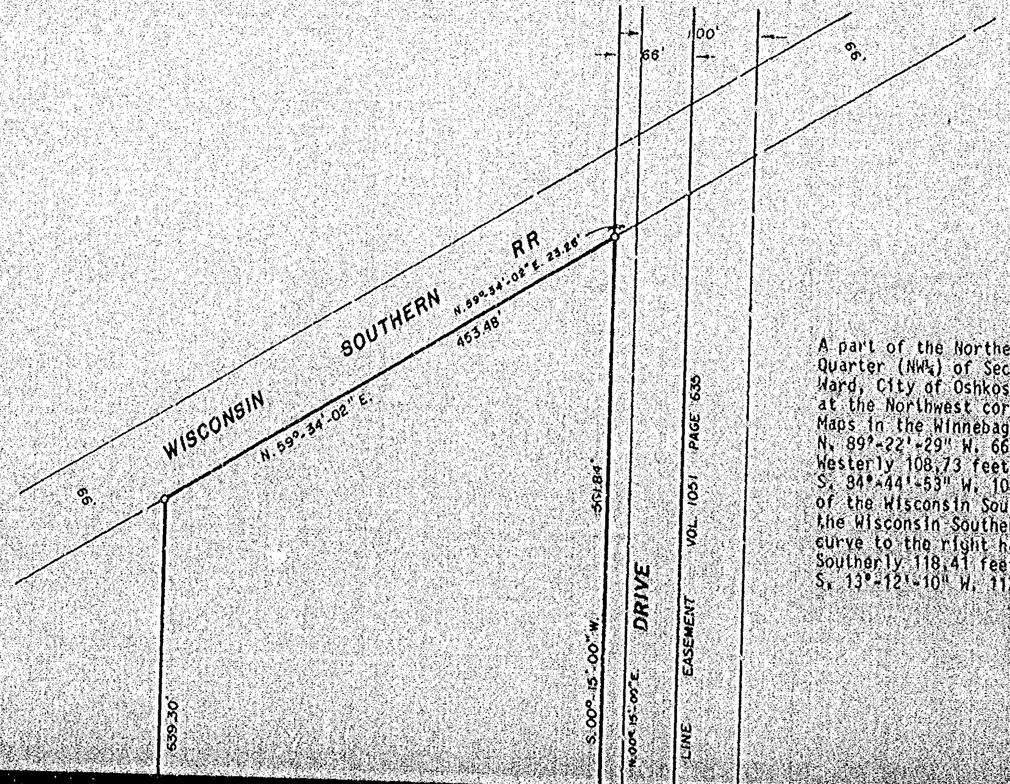

- DESCRIPTION -

A part of the Northeast Quarter (NE¼) of the Northwest Quarter (NW¼) and the Southeast Quarter (SE¼) of the Northwest Quarter (NW¼) of Section Thirty-three (33), Township Eighteen (18) North, Range Sixteen (16) East, Thirteenth (13th) Ward, City of Oshkosh, Winnebago County, Wisconsin containing 6.464 Acres of land and being described by: Commencing at the Northwest corner of Lot 1 of Certified Survey Map No. 845 recorded in Volume 1 on Page 845 of Certified Survey Maps in the Winnebago County Register of Deeds Office, Document No. 558809; thence N. 00°-15'-00" E. 60.00 feet; thence N. 89°-22'-29" W. 66.00 feet, to the true point of beginning; thence continue N. 89°-22'-29" W. 235.96 feet; thence Westerly 108.73 feet, along the arc of a curve to the left having a radius of 530.00 feet and the chord of which bears S. 84°-44'-53" W. 108.54 feet; thence N. 00°-15'-00" E. 639.30 feet, to a point on the Southeasterly right-of-way line of the Wisconsin Southern Railroad; thence N. 59°-34'-02" E. 452.48 feet, along the Southeasterly right-of-way line of the Wisconsin Southern Railroad; thence S. 00°-15'-00" W. 561.84 feet; thence Southerly 88.57 feet, along the arc of a curve to the right having a radius of 195.89 feet and the chord of which bears S. 13°-12'-10" W. 87.82 feet; thence Southerly 118.41 feet, along the arc of a curve to the left having a radius of 261.89 feet and the chord of which bears S. 13°-12'-10" W. 117.40 feet; thence S. 00°-15'-00" W. 100.00 feet, to the true point of beginning.

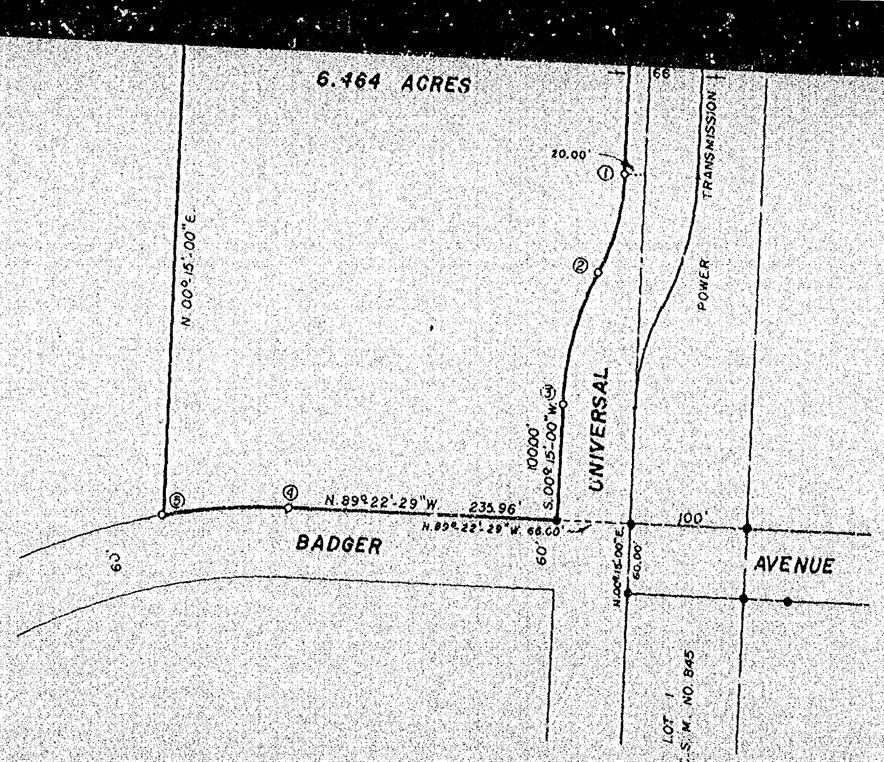

CURVE	RADIUS	CHORD LENGTH	CHORD BEARING	ARC LENGTH	CENTRAL ANGLE	TANGENT BEARING	TANGENT BEARING
1-2	195.89'	87.82'	S. 13°-12'-10"W.	88.57'	25°-54'-20"	N. 00° 15'-00"E.	S. 26°-09'-20"W.
2-3	261.89'	117.40'	S. 13°-12'-10"W.	118.41'	25°-54'-20"	N. 26°-09'-20"E.	S. 00°-15'-00"W.
4-5	530.00'	108.54'	S. 84°-44'-53"W.	108.73'	11°-45'-16"	S. 89°-22'-29"E.	S. 78°-52'-18"W.

CURVE DATA

I, RONALD A. DERCKS, WISCONSIN REGISTERED LAND SURVEYOR OF AERO-METRIC ENGINEERING, INC., CERTIFY THAT I HAVE SURVEYED THE ABOVE DESCRIBED PROPERTY AND THAT THE MAP SHOWN ABOVE IS A TRUE AND CORRECT REPRESENTATION THEREOF TO THE BEST OF MY KNOWLEDGE AND BELIEF.

DATED THIS 15TH DAY OF August, 1983

LEGEND
○ = 1" IRON PIPE SET
● = 1" IRON PIPE FOUND

Ronald A. Dercks
WISCONSIN REGISTERED LAND SURVEYOR S-1615
RONALD A. DERCKS

AERO-METRIC ENGINEERING, INC.
1091 SOUTH WASHBURN STREET OSHKOSH, WISCONSIN 54901
DATE: 8/10/83 NOTEBOOK: 70 PAGE: 75 SCALE: 1" = 100'

SURVEY FOR O.I.D.C. OF A PART OF THE NW 1/4 OF SECTION 33, T. 18 N., R. 16 E., 13 TH WARD, CITY OF OSHKOSH, WINNEBAGO COUNTY, WISCONSIN.

D— 183

DESIGN PRODUCTS CO.

THIS INSTRUMENT DRAWN BY RONALD A. DERCKS


PLAT OF SURVEY

KNOWN AS 1670 OHIO STREET, BEING THE SOUTH 48 AND 4/10 FT., BEING THE SOUTH 1/3 OF LOT 11 IN JOHN SMITH'S 2nd ADDITION TO OSHKOSH, IN THE 13th WARD, CITY OF OSHKOSH, WINNEBAGO COUNTY, WISCONSIN.

JULY 25, 1983

SURVEY FOR OSHKOSH SAVINGS
APPLICANT: LELAND BARTELT
(CONSENT WAIVER ON FILE)

SURVEY NO. 1271-S1

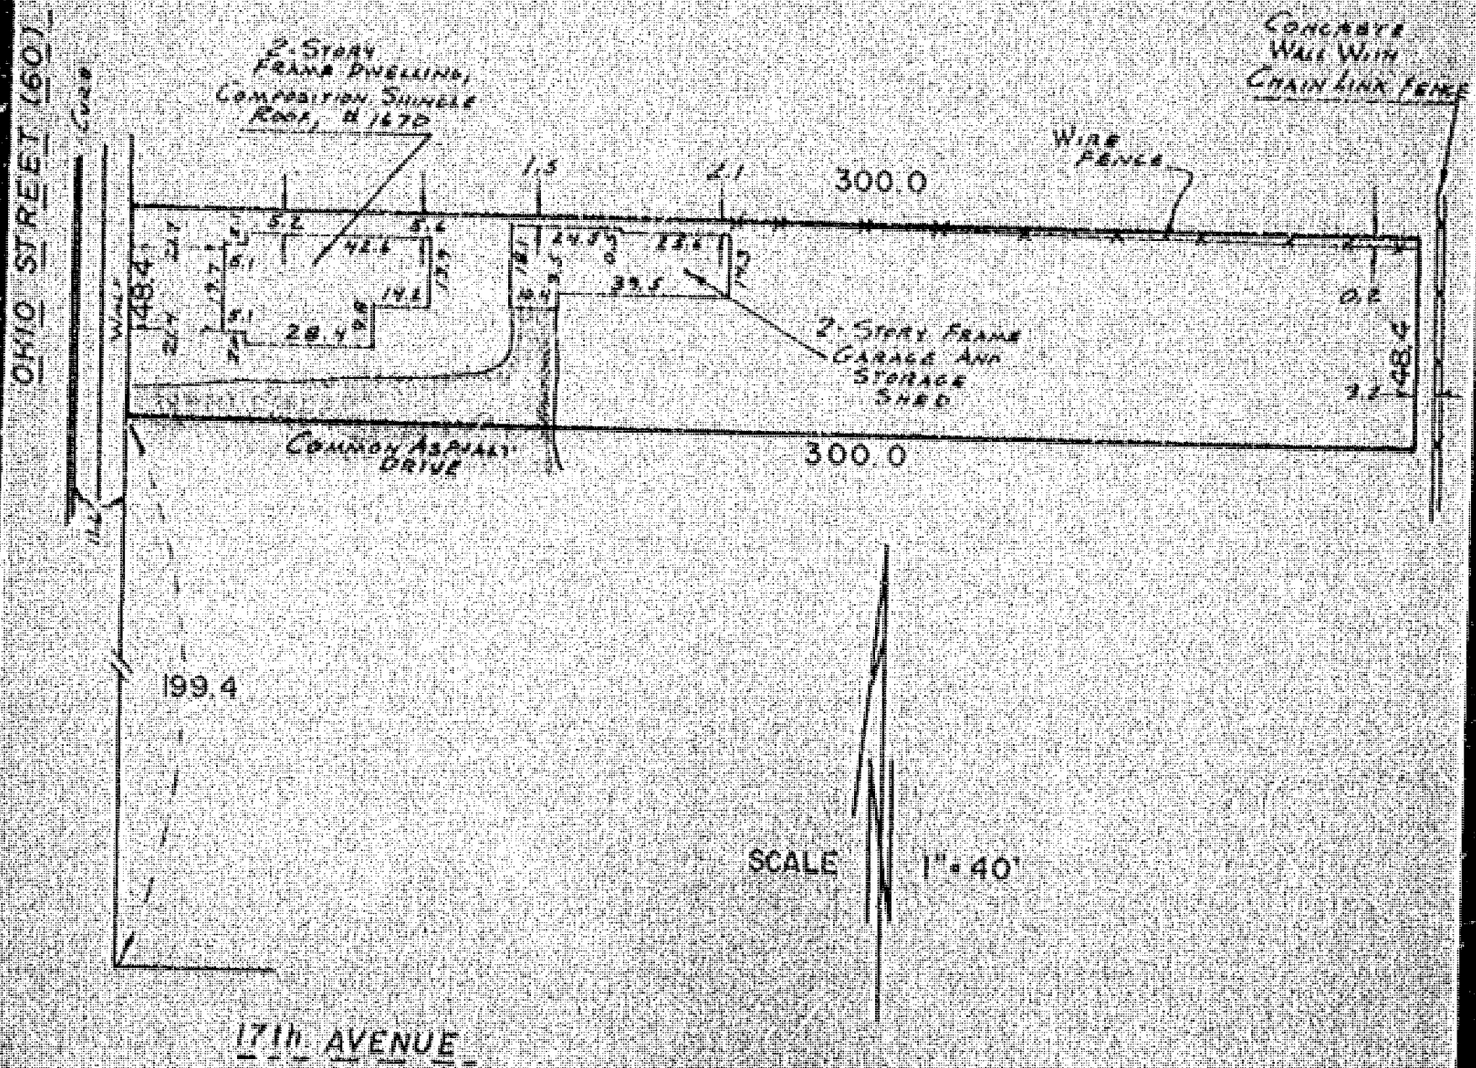

I Certify that I have surveyed the above described property (Property), and the above map is a true representation thereof and shows the size and location of the Property, its exterior boundaries, the location and dimensions of all visible structures thereon, boundary fences, apparent easements and roadways and visible encroachments. This survey is made for the exclusive use of the present owners of the Property, and of those who purchase, mortgage, or guarantee the title thereto, within one (1) year from date hereof.

WISCONSIN
REINHARD H.W. MOTHLAGH
S-1366
OSHKOSH
WIS.
SURVEYOR

national survey & engineering
412 NORTH SAWYER STREET / PO BOX 2983
OSHKOSH, WISCONSIN 54903
(414) 426-2800

PLAT OF SURVEY


KNOWN AS 1610 WESTHAVEN DRIVE, BEING LOT 5 IN SWEDEN'S PLAT, 13th WARD,
CITY OF OSHKOSH, WINNEBAGO COUNTY, WISCONSIN.

SURVEY NO. 12672-1

JUNE 18, 1993

SURVEY FOR: FIRST SAVINGS
SALESPERSON: KENNETH G. HILL
CLIENT: FIRST SAVINGS

CURVE DATA
RADIUS: 497.65
ARC: 68.99
CHORD: S 50°00 WAS'W
68.94

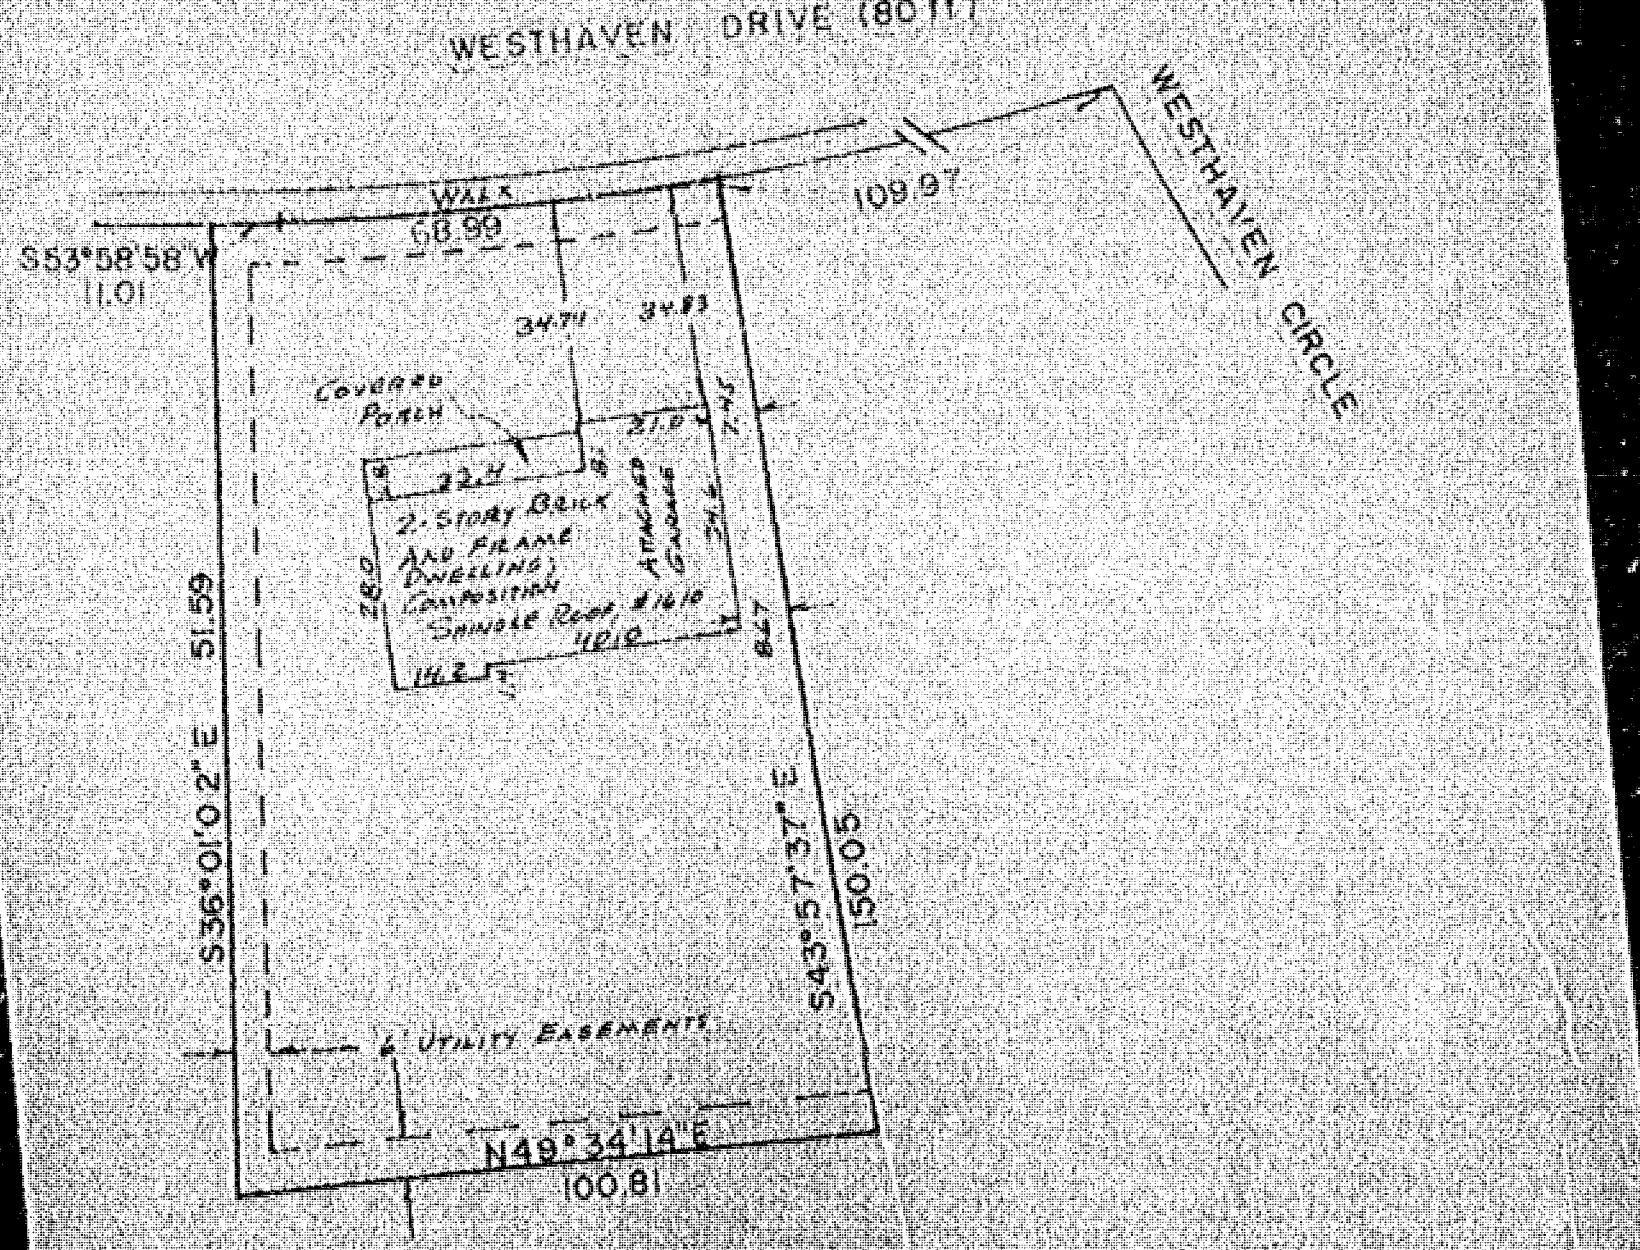

I Certify that I have surveyed the above described property (Property), and the above map is a true representation thereof and shows the size and location of the Property, its exterior boundaries, the location and dimensions of all visible structures thereon, boundary fences, apparent easements and roadways and visible encroachments. If any.

This survey is made for the exclusive use of the present owners of the Property and also those who purchase, mortgage, or guarantee the title thereto, within one (1) year from date hereof.

WISCONSIN
REGISTERED
LAND SURVEYOR

national survey & engineering
417 NORTH SAWYER STREET / PO BOX 2953
OSHKOSH, WISCONSIN 54903
(414) 426-2800


PLAT OF SURVEY

KNOWN AS 1303 LIBERTY STREET, BEING THE NORTH 50.0 FT. OF LOT 1 IN BLOCK 123 IN THE 12TH WARD, CITY OF OSHKOSH, PER LAYTON'S MAP OF 1894, WINNEBAGO COUNTY, WISCONSIN.

JULY 5, 1983

SURVEY FOR OSHKOSH SAVINGS
(MORTGAGE WAIVER ON FILE)
APPLICANT: LEZOTTE

SURVEY NO. 125921

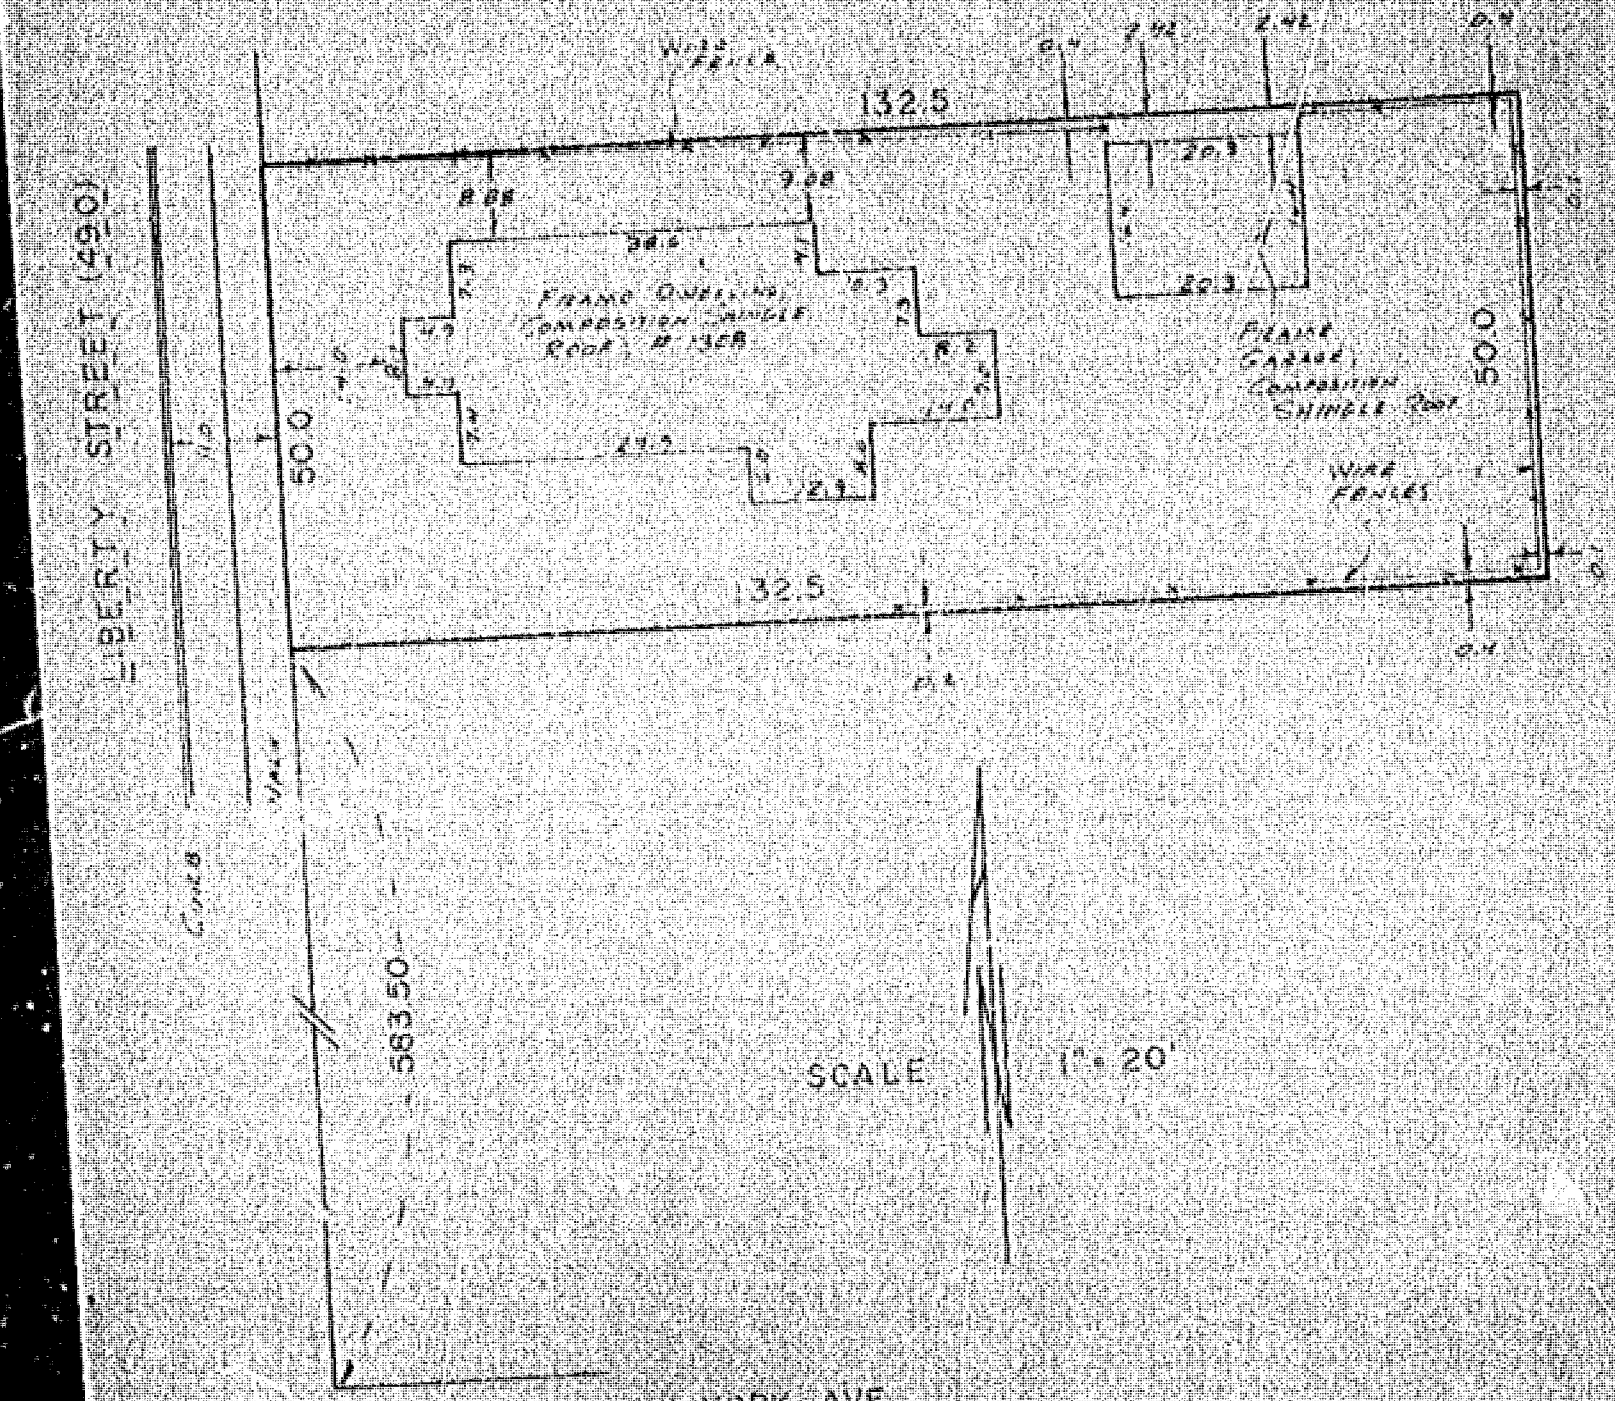

I Certify that I have surveyed the above described property (Property), and the above map is a true representation thereof and shows the size and location of the Property, its exterior boundaries, the location and dimensions of all visible structures thereon, boundary fences, apparent easements and roadways and visible encroachments, if any.

This survey is made for the exclusive use of the present owners of the Property, and also those who purchase, mortgage, or guarantee the title thereto, within one (1) year from date hereof.

WISCONSIN REGISTERED SURVEYOR

national survey & engineering
312 NORTH SAWYER STREET, P.O. BOX 2963
OSHKOSH, WISCONSIN 54903
(414) 426-2800


PLAT OF SURVEY

KNOWN AS 1205 NORTH POINT STREET, BEING LOT 175 IN THE 4TH ADDITION TO NORTH POINT PLAT, 15th WARD, CITY OF OSHKOSH, WINNEBAGO COUNTY, WISCONSIN.

JULY 7, 1981

SURVEY FOR: OSHKOSH SAVINGS
APPLICANT: RAYMOND & CHERIE PETERSON (CONSENT WAIVER ON FILE)

SURVEY NO. 1259-81

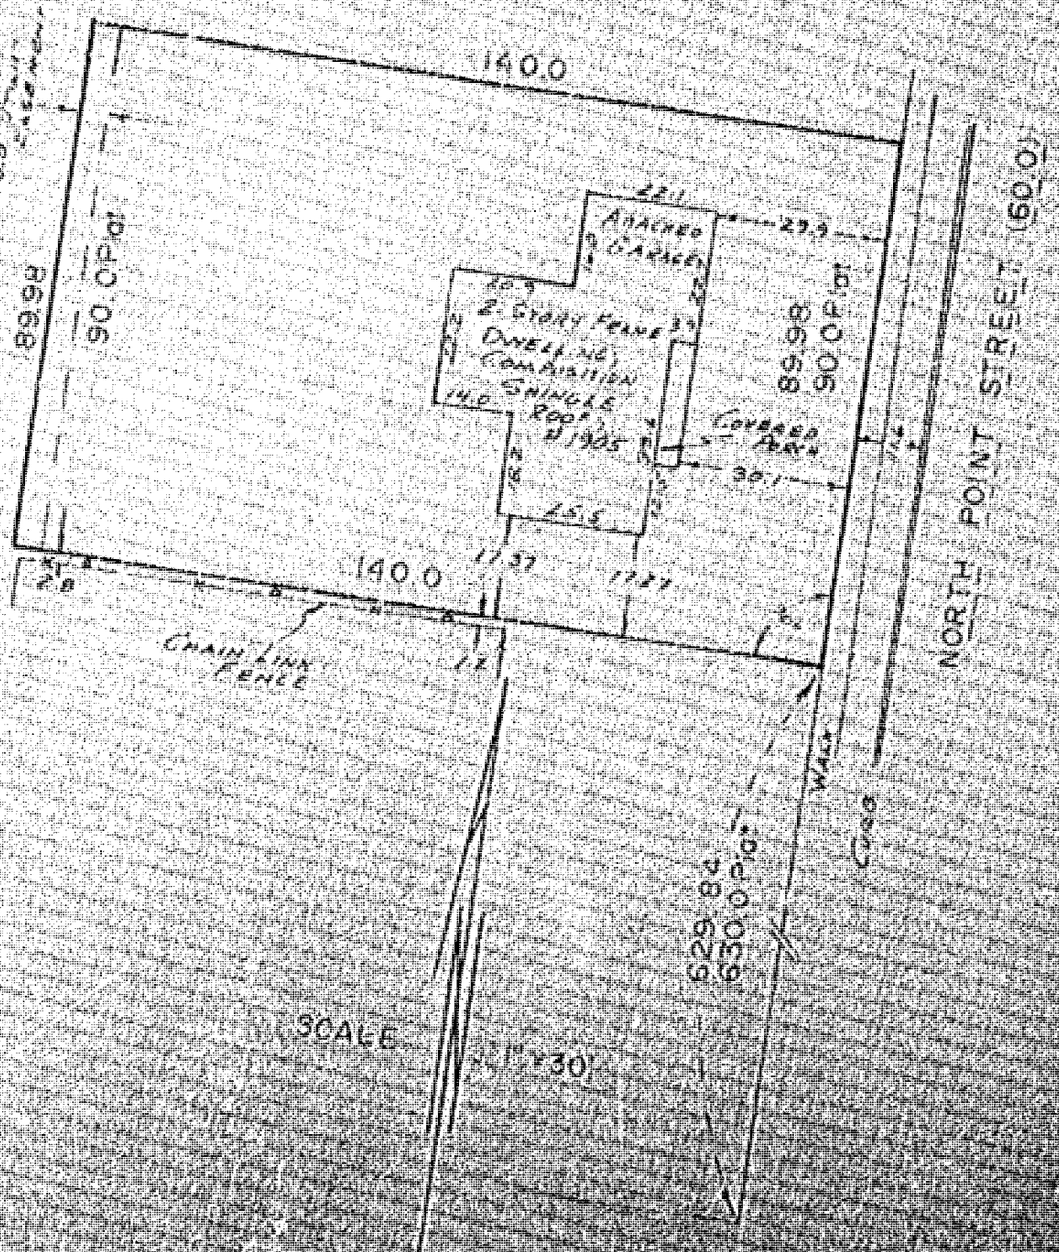

I Certify that I have surveyed the above described property (Property) and the above map is a true representation thereof and shows the size and location of the Property, its exterior boundaries, the location of all visible structures thereon, boundary fences, apparent easements or encroachments, the location and dimensions of any visible means of access to the Property and its apparent area. This survey is made for the exclusive use of the present owners of the Property and those who purchase, mortgage, or guarantee the title thereto, within sixty (60) days from date hereof.

national survey & engineering
812 NORTH BOWKER STREET (P.O. BOX 2065)
OSHKOSH, WISCONSIN 54903
(414) 426-2800

WISCONSIN
REGISTERED
LAND SURVEYOR


PLAT OF SURVEY

BEING 1315 WEST 5th AVENUE; LOT 2 IN BLOCK 6 OF VANDERPOOL'S SECOND ADDITION; PART OF LOTS 14, 17 AND 18 IN THE SUBDIVISION OF THE S.E. 1/4 OF SECTION 22, T18N, R16E, CITY OF OSHKOSH, PER LEACH'S MAP OF 1894, WINNEBAGO COUNTY, WISCONSIN.

JULY 12, 1983 — SURVEY FOR OSHKOSH SAVINGS — SURVEY NO. 1261-M

APPLICANT: PAULICK

(DOCUMENT NUMBER ON FILE)

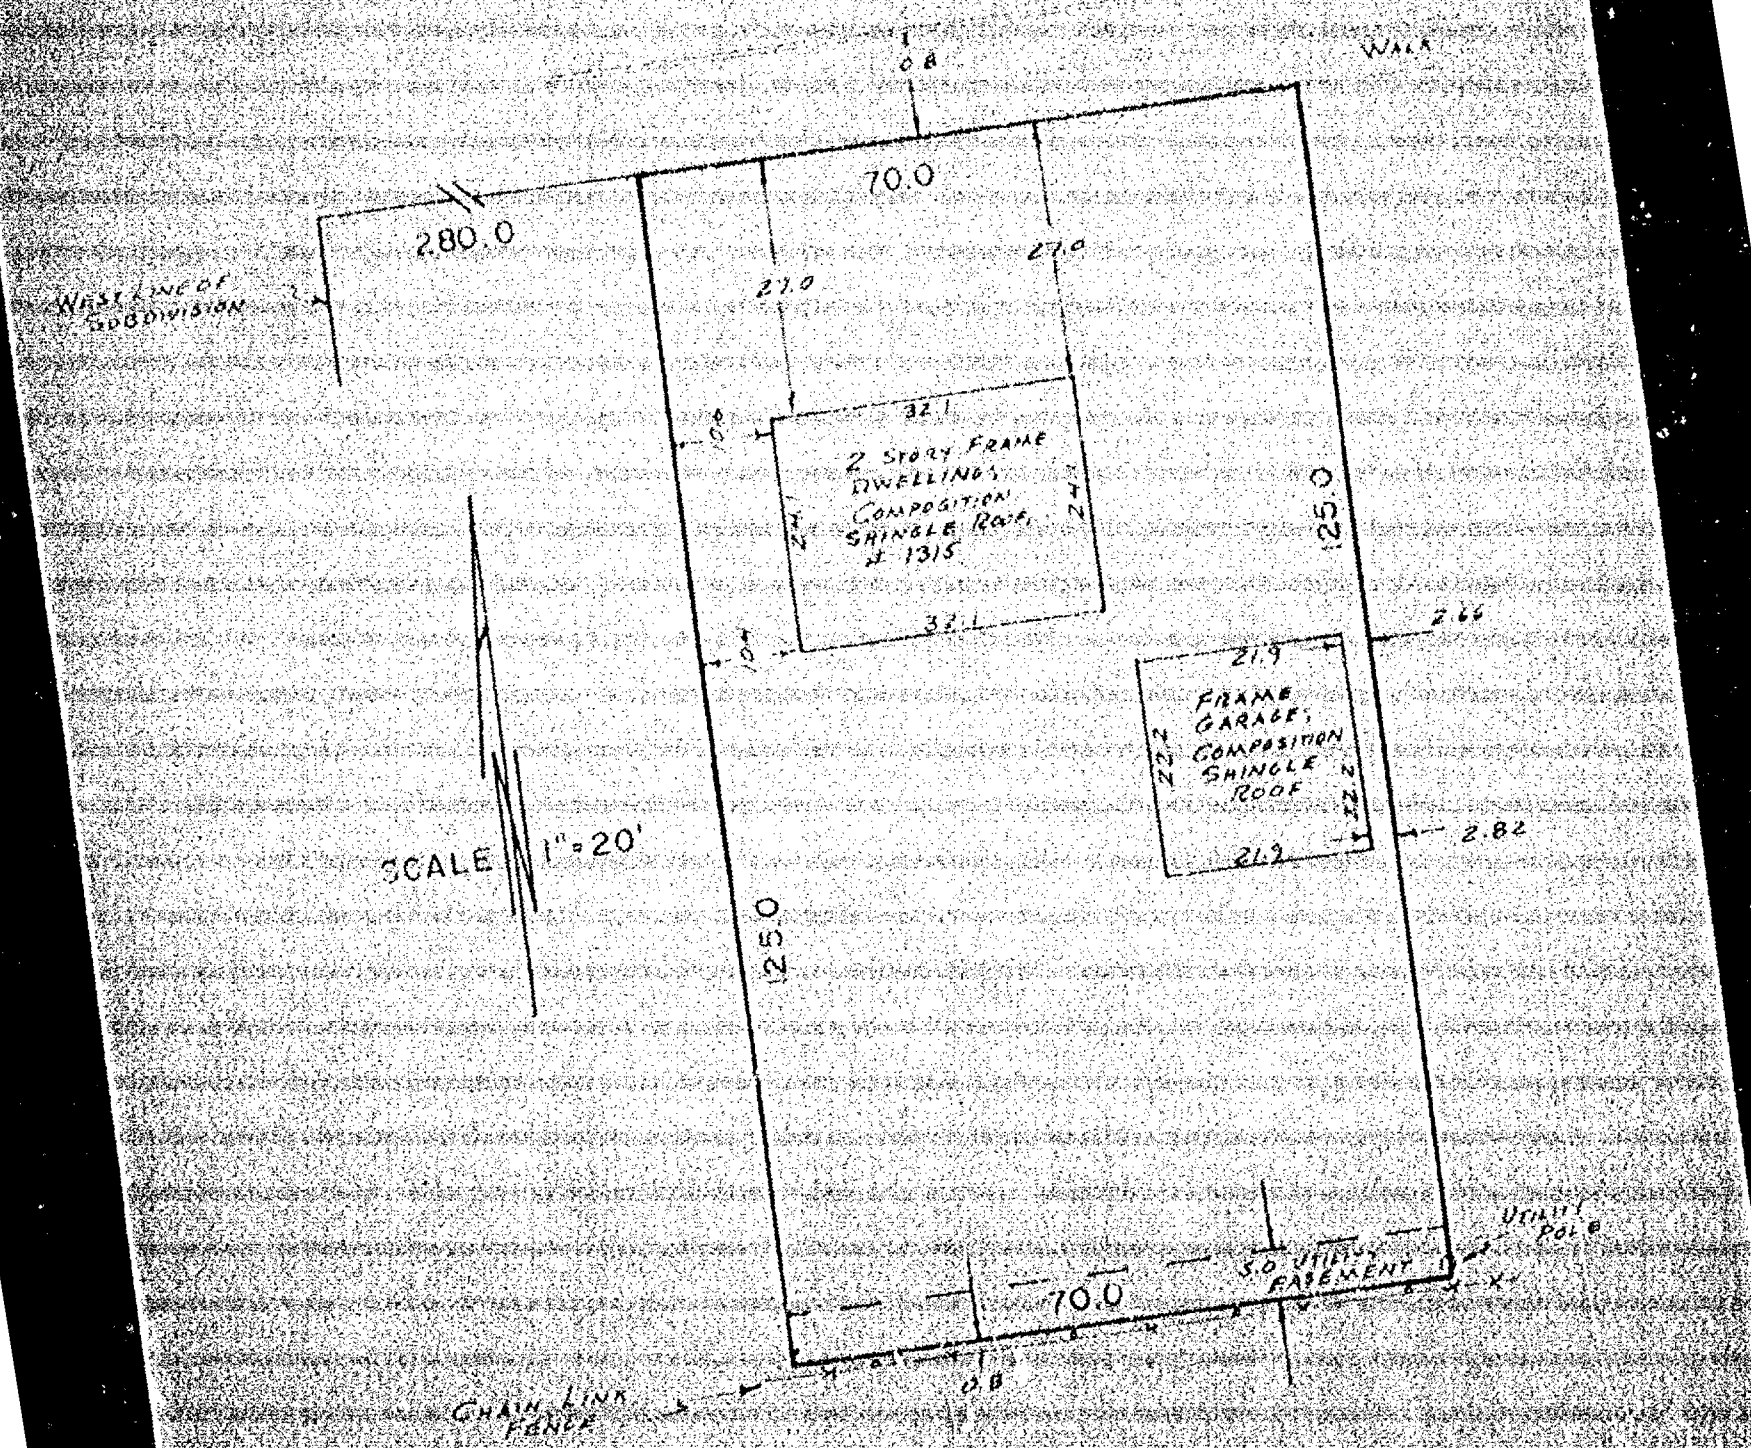

I Certify that I have surveyed the above described property (Property), and the above map is a true copy thereof and shows the size and location of the Property, its exterior boundaries, the location and dimensions of all visible structures thereon, boundary fences, apparent easements and roadways and visible encroachments, if any. This survey is made for the exclusive use of the present owners of the Property, and also those who purchase, mortgage, or guarantee the title thereto, within one (1) year from date hereof.

WISCONSIN REGISTERED LAND SURVEYOR — DELMAR H. VOELKER — S-1455 — OSHKOSH WIS

national survey & engineering
417 NORTH SAWYER STREET / PO BOX 2965
OSHKOSH, WISCONSIN 54903
(414) 426-2800


PLAT OF SURVEY

KNOWN AS 1212-1224 WEST 4th STREET, BEING LOTS 1 AND 2 OF BLOCK 3; AND THAT PART OF WEST 4th STREET (NOW VACATED) DESCRIBED AS FOLLOWS: COMMENCING AT THE S.W. CORNER OF SAID LOT 2; THENCE NORTHEASTERLY ALONG THE SOUTHERLY LINE OF LOT 2, 230.78 FT. TO THE WEST LINE OF SOUTH SAWYER STREET, THENCE SOUTH ALONG THE EXTENDED WEST LINE OF SAID SAWYER STREET 20.6 FT., THENCE SOUTHWESTERLY TO THE PLACE OF BEGINNING. ALL IN VANDERPOOL'S SECOND ADDITION IN THE 6th WARD, CITY OF OSHKOSH, WINNEBAGO COUNTY, WISCONSIN.

JULY 11, 1983

SURVEY FOR ANDREW THOMPSON AND FIRST SAVINGS (MONUMENT WAIVER ON FILE)

SURVEY NO. 1262-M

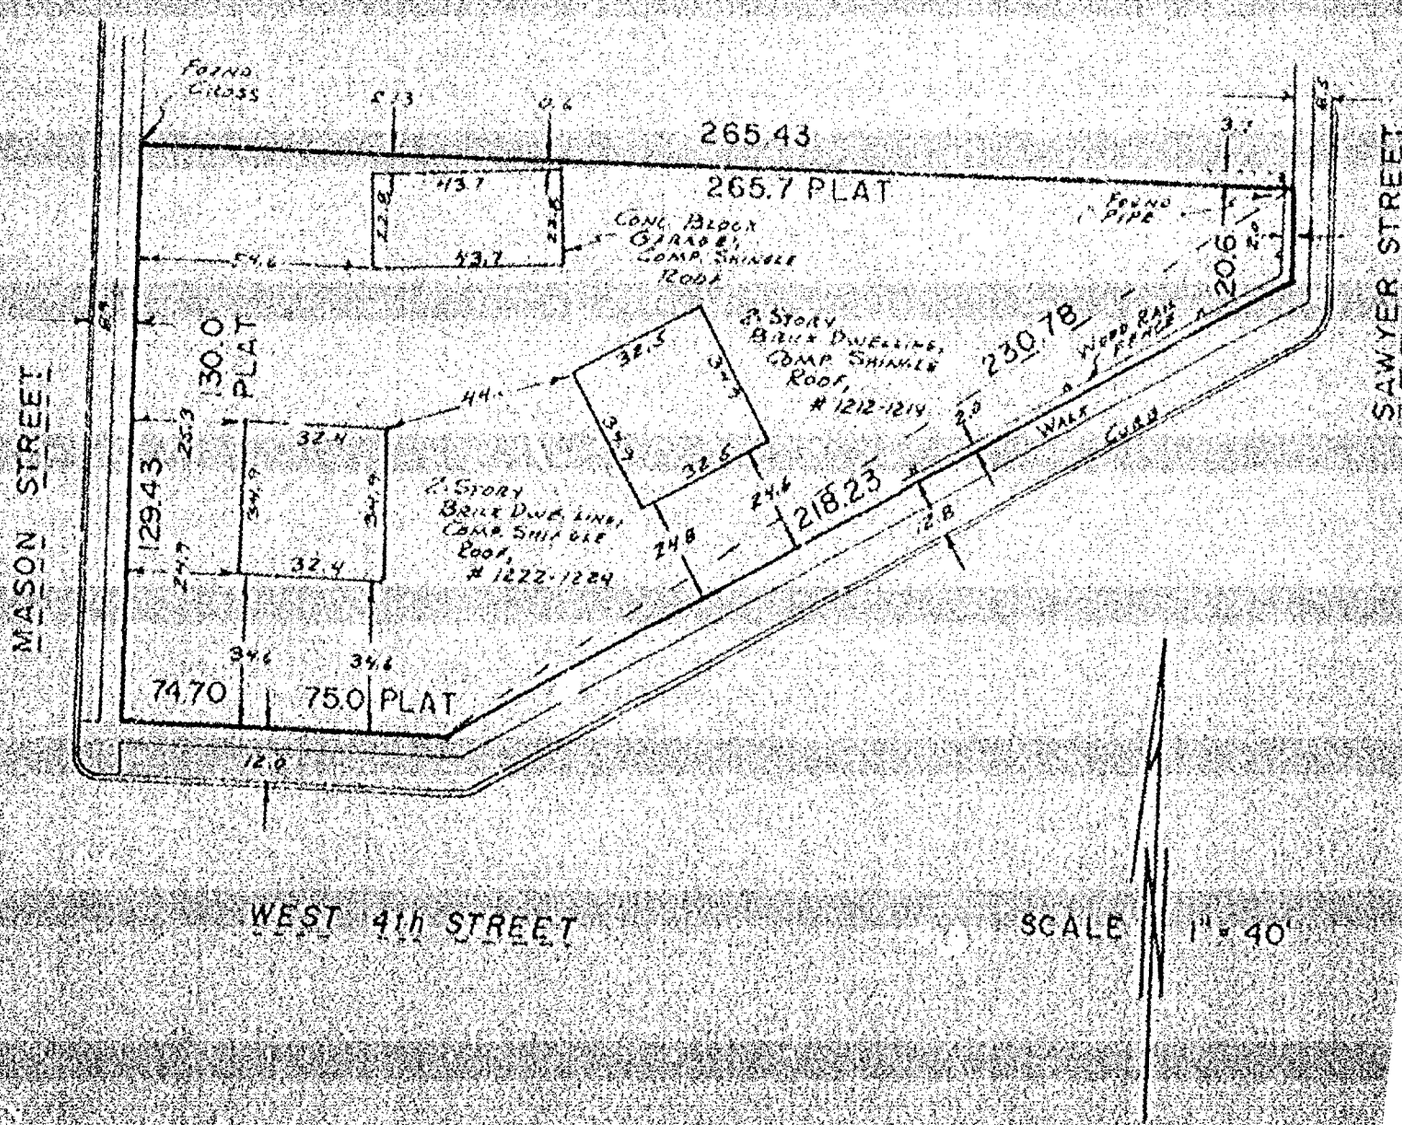

SCALE 1" = 40'

I Certify that I have surveyed the above described property (Property), and the above map is a true representation thereof and shows the size and location of the Property, its exterior boundaries, the location and dimensions of all visible structures thereon, boundary fences, apparent easements and roadways and visible encroachments, if any. This survey is made for the exclusive use of the present owners of the Property, and also those who purchase, mortgage, or guarantee the title thereto, within one (1) year from date hereof.


national survey & engineering
417 NORTH SAWYER STREET / P.O. BOX 2963
OSHKOSH, WISCONSIN 54903
(414) 426-2800

WISCONSIN
REINHARD W. ROEHLIG
1369
OSHKOSH WIS
REGISTERED LAND SURVEYOR

PLAT OF SURVEY


APPLICANT TO SHOW: RESIDENCE
ADDRESS OF PROPERTY: 1121 W. BENT STREET

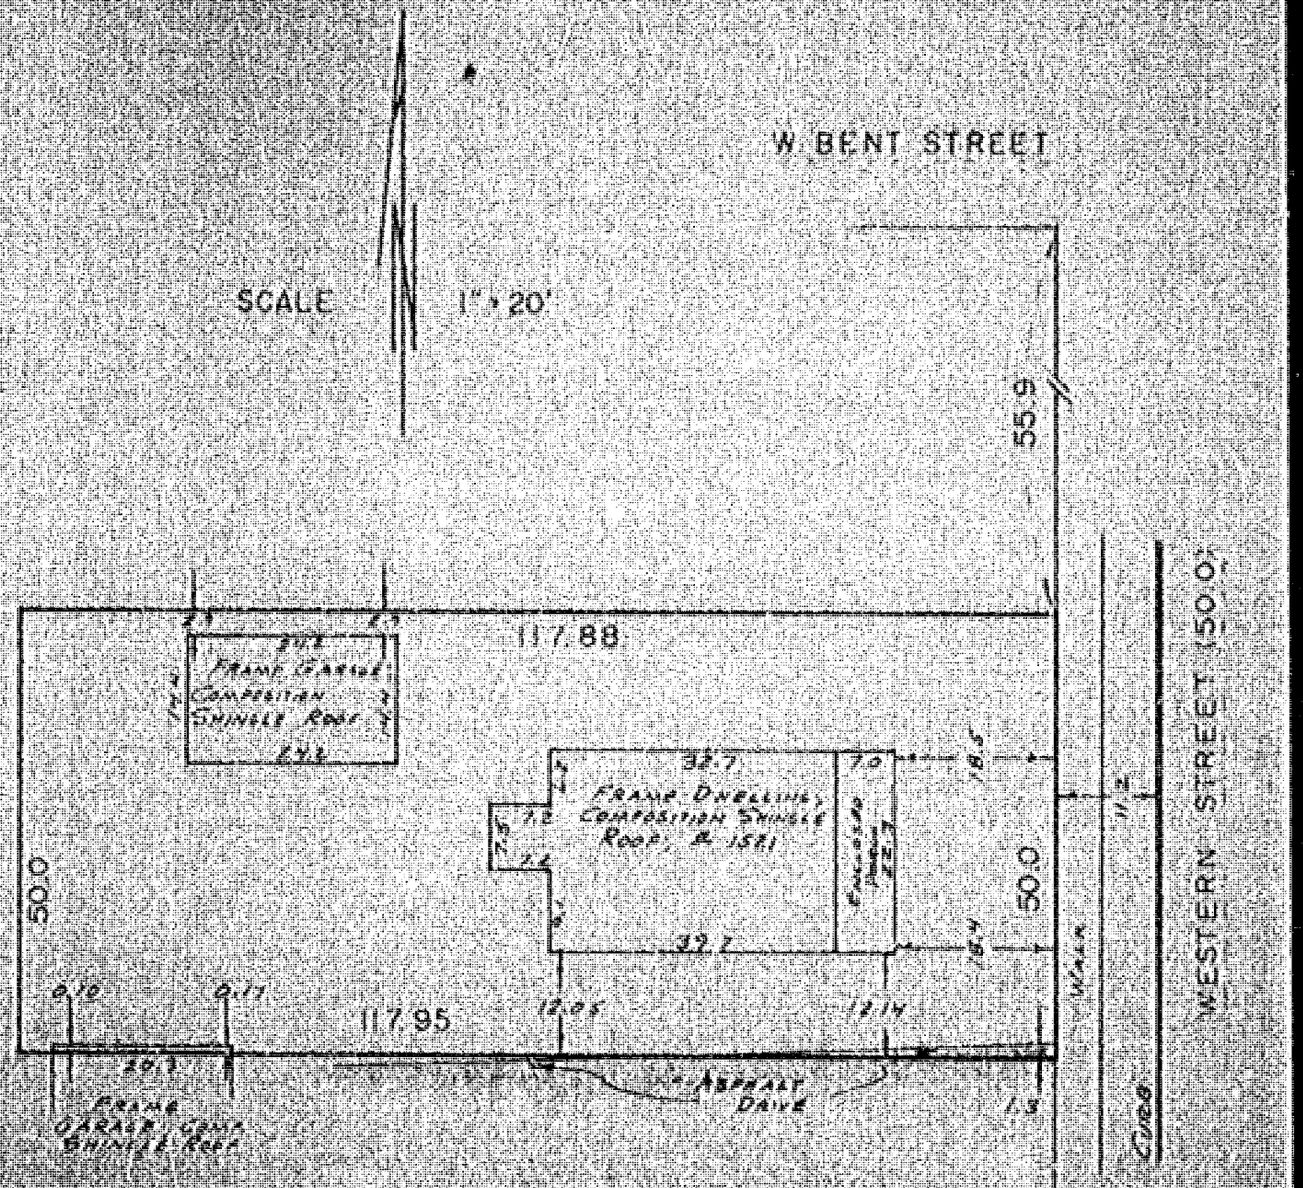

I Certify that I have surveyed the above described property (Property), and the above map is a true representation thereof, showing the size and location of the Property, its exterior boundaries, the location and dimensions of all visible structures thereon, boundary fences, apparent easements and roadways and visible encroachments. This survey is made for the exclusive use of the present owners of the Property, and of those who purchase, mortgage or guarantee the title thereto, within one (1) year from date hereof.

WISCONSIN
REINHARD H.W. KOHLHOFF
S-1267
REGISTERED
LAND SURVEYOR

national survey & engineering
217 NORTH SAWYER STREET / PO BOX 2963
OSHKOSH, WISCONSIN 54903
(414) 426-8800


PLAT OF SURVEY

THAT PART OF LOTS 1, 2 AND 3 IN JOHN A. CONANT'S SUBDIVISION WHICH IS BOUNDED AND DESCRIBED AS FOLLOWS, COMMENCING AT THE S.W. CORNER OF LOT 3 IN JOHN A. CONANT'S SUBDIVISION, THENCE NORTH ALONG THE EAST R.O.W. LINE OF OREGON STREET 301.20 FT. TO A POINT, THENCE EAST 194.00 FT. TO A POINT, THENCE NORTH 150.40 FT. TO A POINT, THENCE WEST 194.00 FT. TO A POINT ON THE EAST R.O.W. LINE OF OREGON STREET, THENCE NORTH ALONG SAID R.O.W. LINE 149.79 FT. TO A POINT, THENCE NORTH 81-12-17 EAST 220.00 FT. TO A POINT, THENCE NORTH 109.85 FT. TO A POINT, THENCE NORTH 81-12-17 EAST 326.90 FT. TO A POINT, THENCE SOUTH 00-18-06 EAST 713.57 FT. TO A POINT ON THE NORTH R.O.W. LINE OF 28th AVENUE, THENCE SOUTH 81-30-45 WEST ALONG SAID NORTH R.O.W. LINE OF 28th AVENUE 550.26 FT. TO THE POINT OF BEGINNING, ALL IN THE S.W. 1/4 OF SECTION 36, T18N, R15E, 14th WARD, CITY OF OSHKOSH, WINNEBAGO COUNTY, WISCONSIN. SAID PARCEL CONTAINS 7.655 ACRES.

OCTOBER 24, 1983

SURVEY FOR OSHKOSH B'GOSH

SURVEY NO. 7336-S

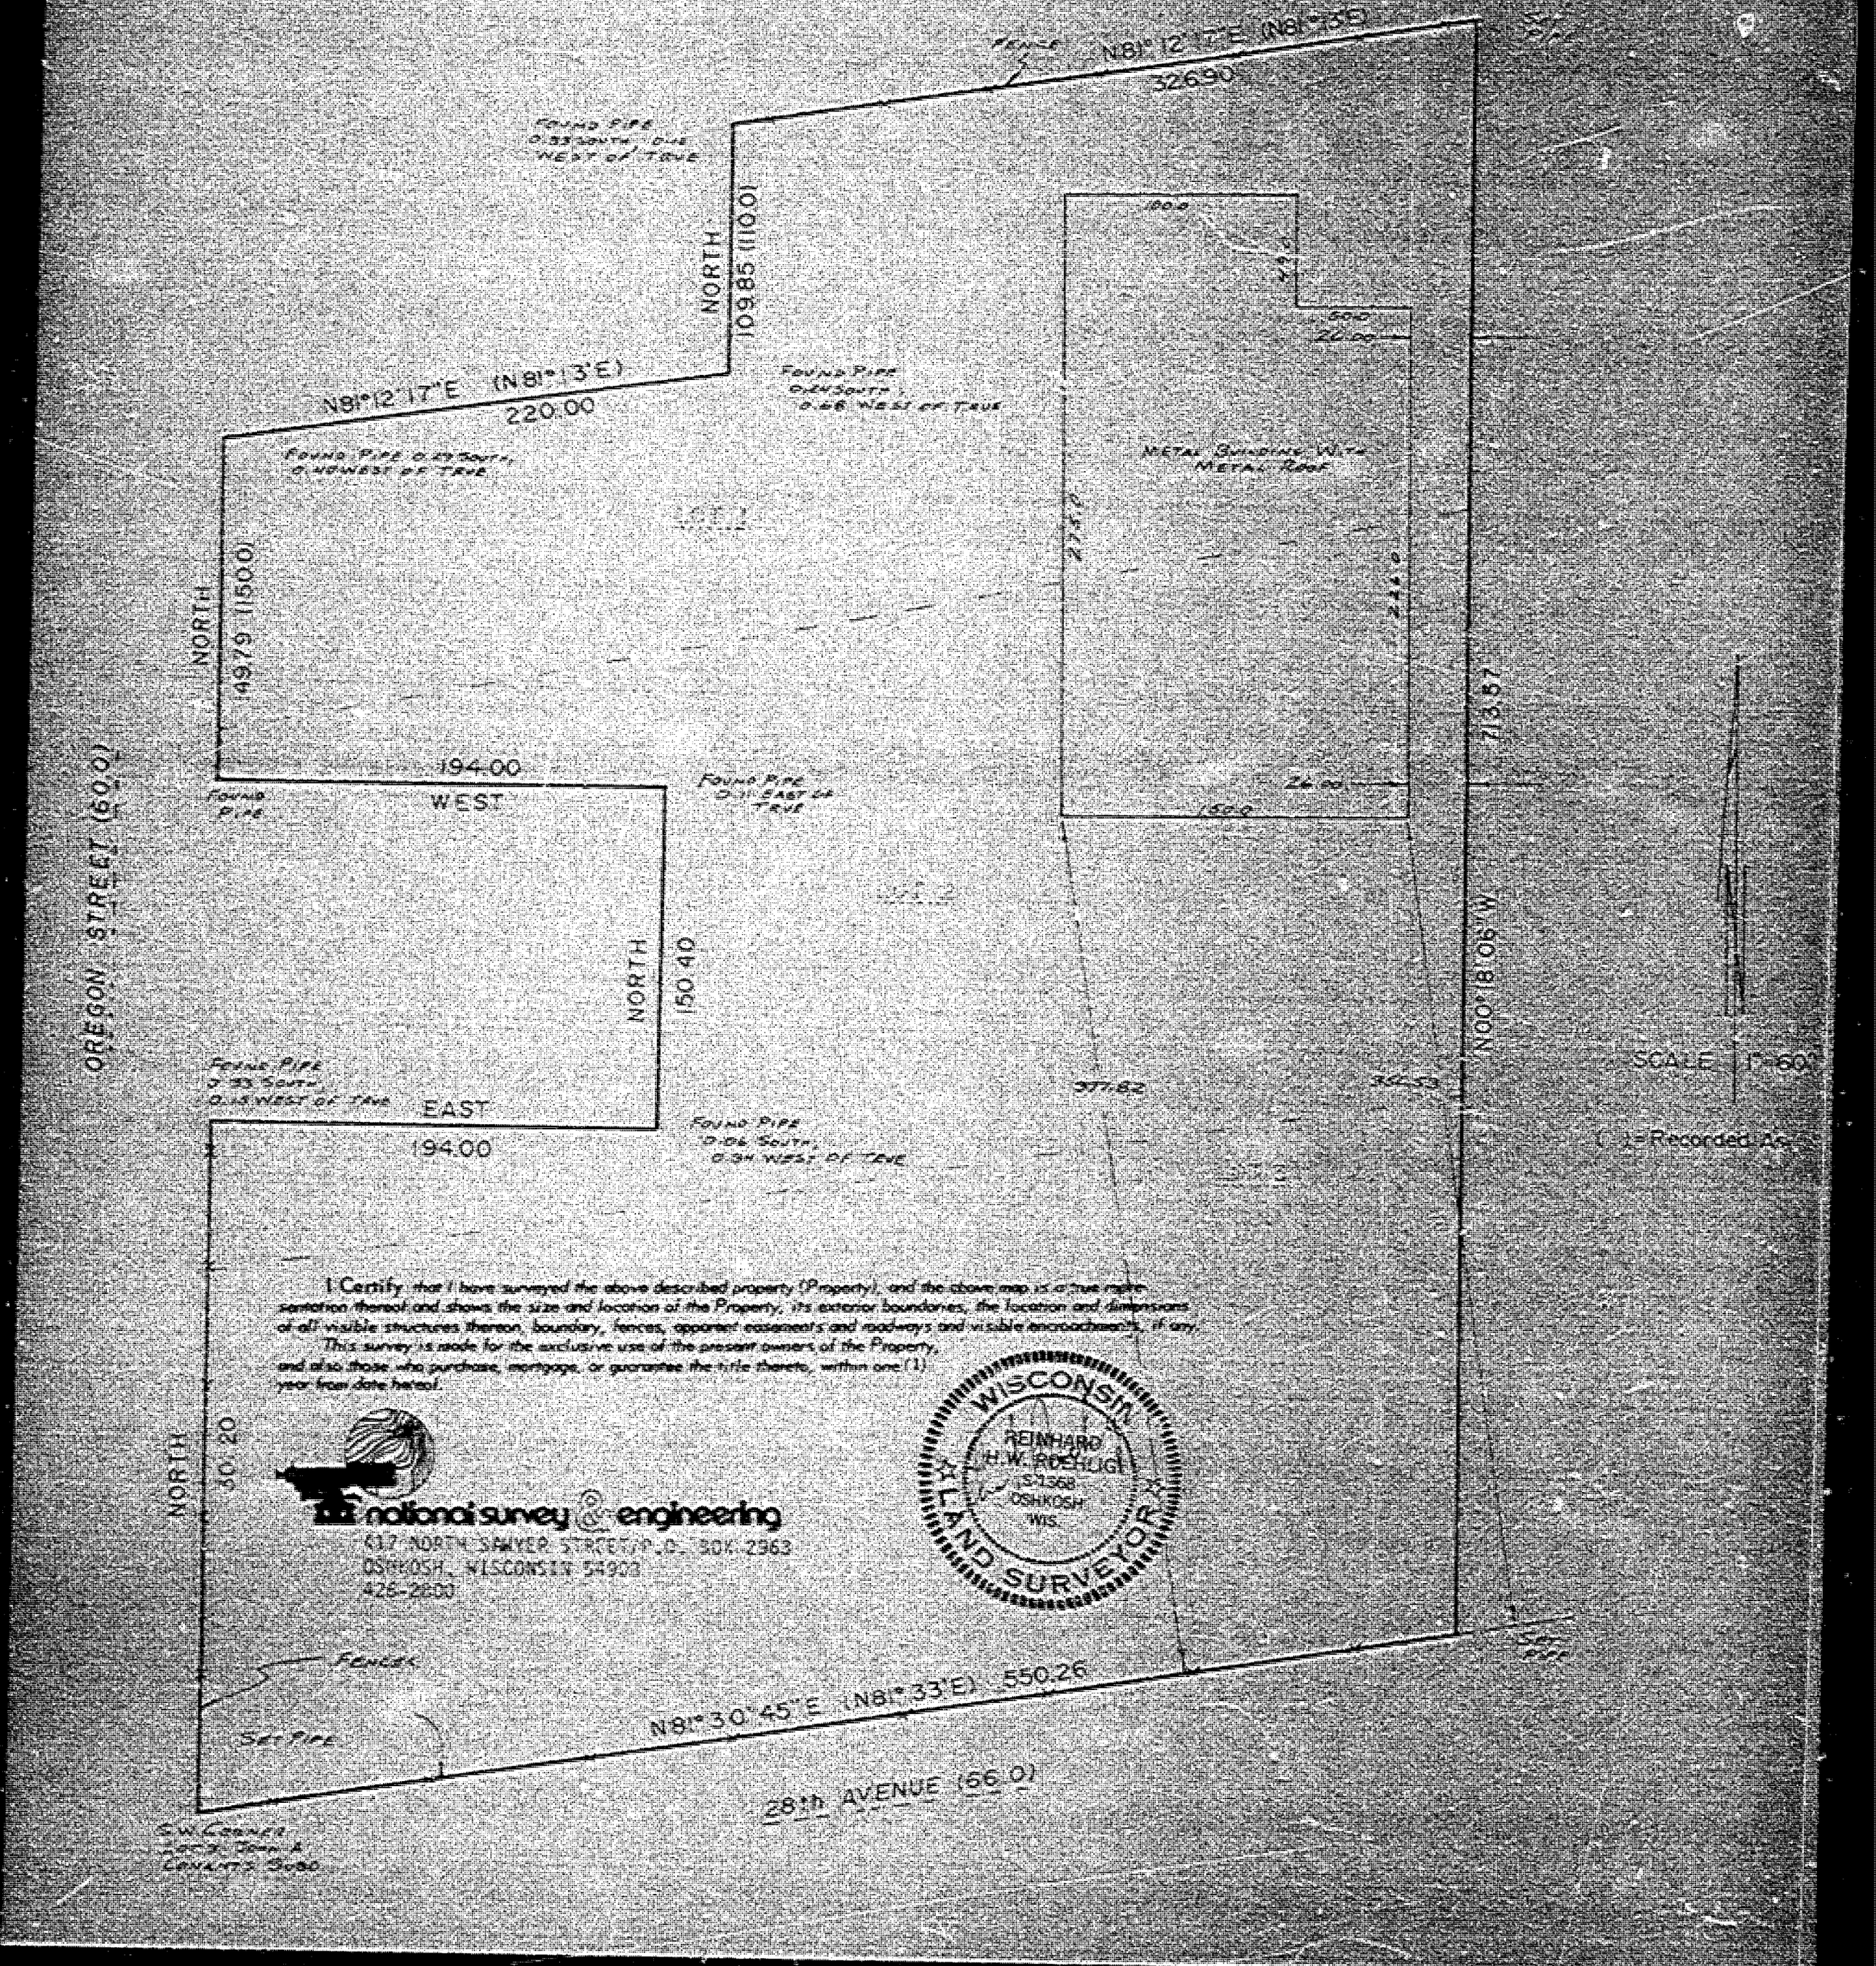

I Certify that I have surveyed the above described property (Property), and the above map is a true representation thereof and shows the size and location of the Property, its exterior boundaries, the location and dimensions of all visible structures thereon, boundary fences, apparent easements and roadways and visible encroachments, if any.

This survey is made for the exclusive use of the present owners of the Property, and also those who purchase, mortgage, or guarantee the title thereto, within one (1) year from date hereof.

WISCONSIN
REINHARD H.W. ROEHLIG
S-1368
OSHKOSH
WIS.
LAND SURVEYOR

national survey & engineering

PLAT OF SURVEY



SURVEY NO. 1253-H

JUNE 23, 1983

I Certify that I have surveyed the above described property (Property), and the above map is a true representation thereof and shows the size and location of the Property, its exterior boundaries, the location and extent of all visible structures thereon, boundary fences, apparent easements and roadways and visible encroachments.

This survey is made for the exclusive use of the present owners of the Property, and also those who purchase, mortgage, or guarantee the title thereto, within one (1) year from date hereof.

WISCONSIN REINHARD H. W. RUEHLING 1253 OSHKOSH LAND SURVEYOR

national survey & engineering

401 NORTH SAWYER STREET / P.O. BOX 2863


OSHKOSH, WISCONSIN 54903

(414) 426-8860

PLAT OF SURVEY

KNOWN AS 1008 WEST 9th AVENUE, BEING LOT 6 IN ASSESSOR'S PLAT NO. 8 IN THE SIXTH WARD, CITY OF OSHKOSH, WINNEBAGO COUNTY, WISCONSIN.


JUNE 17, 1983 — SURVEY FOR OSHKOSH SAVINGS (MONUMENT WAIVER ON FILE), MORTGAGEE: SALMSEIDER — SURVEY NO. 1250-H

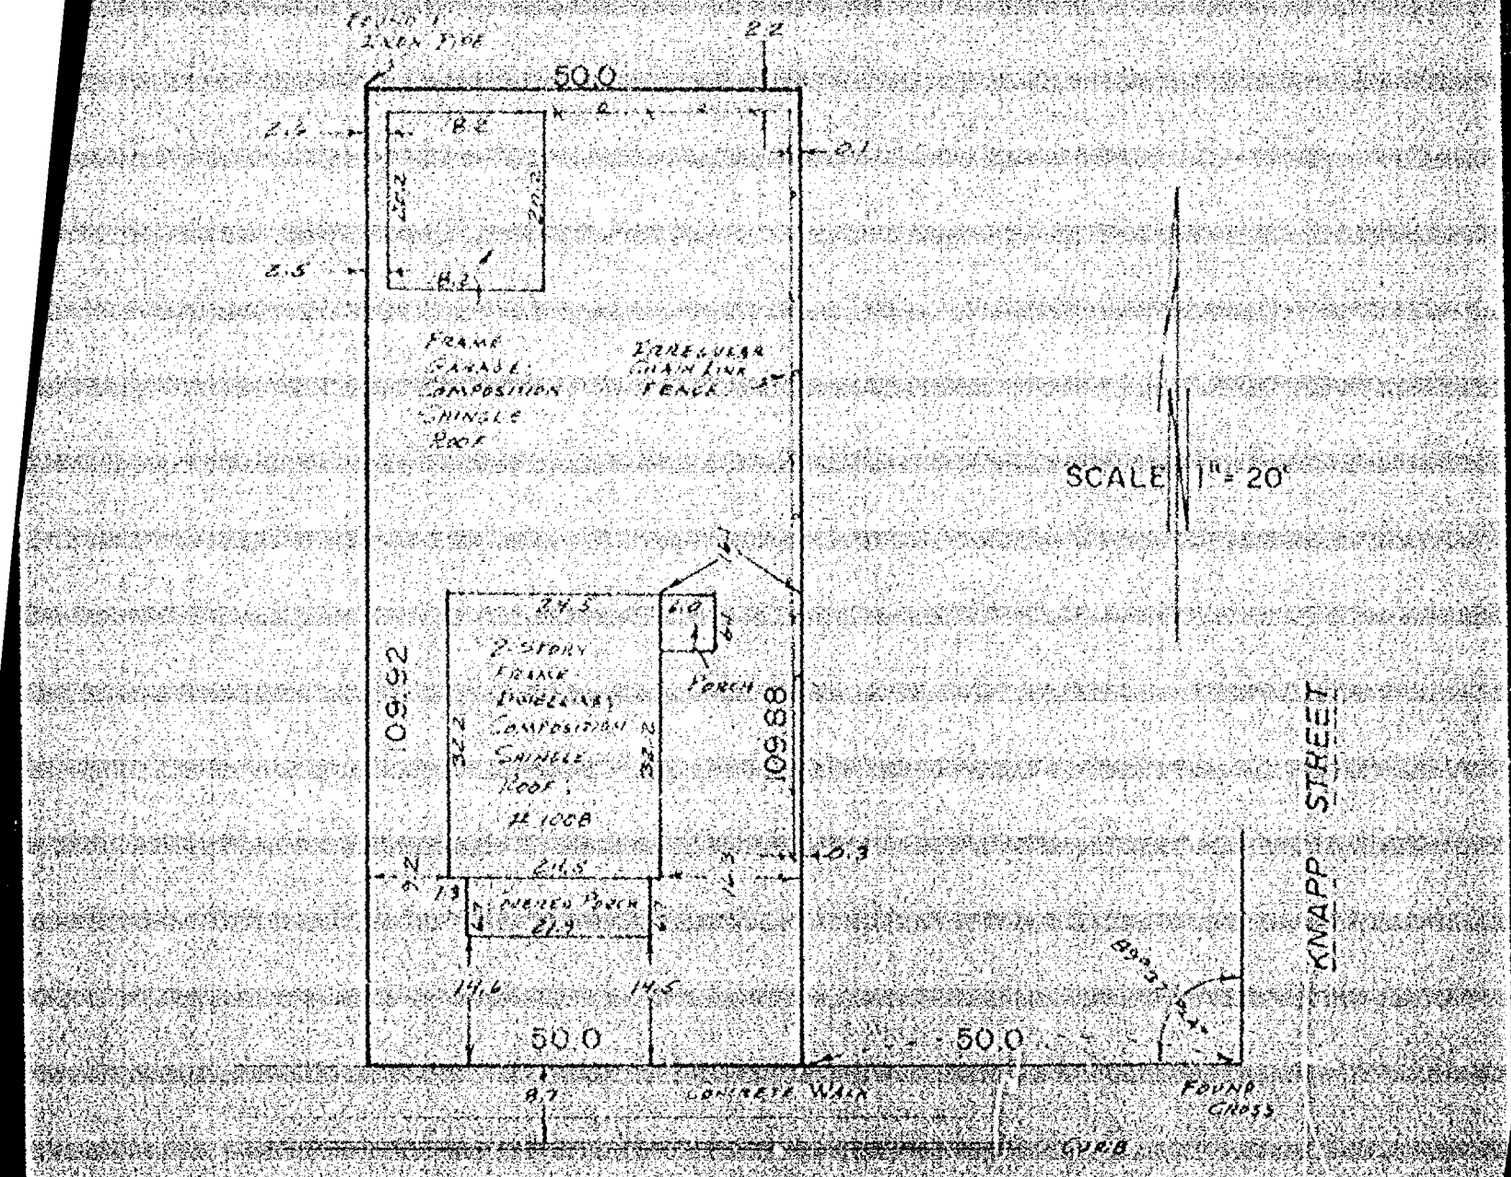


I Certify that I have surveyed the above described property (Property), and the above map is a true representation thereof and shows the size and location of the Property, its exterior boundaries, the location and dimensions of all visible structures thereon, boundary fences, apparent easements and roadways and visible encroachments, if any. This survey is made for the exclusive use of the present owners of the Property, and also those who purchase, mortgage, or guarantee the title thereto, within one (1) year from date hereof.

WISCONSIN
REINHARD H. W. ROEHLING
S-1855
OSHKOSH
WIS.
REGISTERED LAND SURVEYOR

national survey & engineering
417 NORTH SAWYER STREET / P.O. BOX 2963
OSHKOSH, WISCONSIN 54903
(414) 426-2800

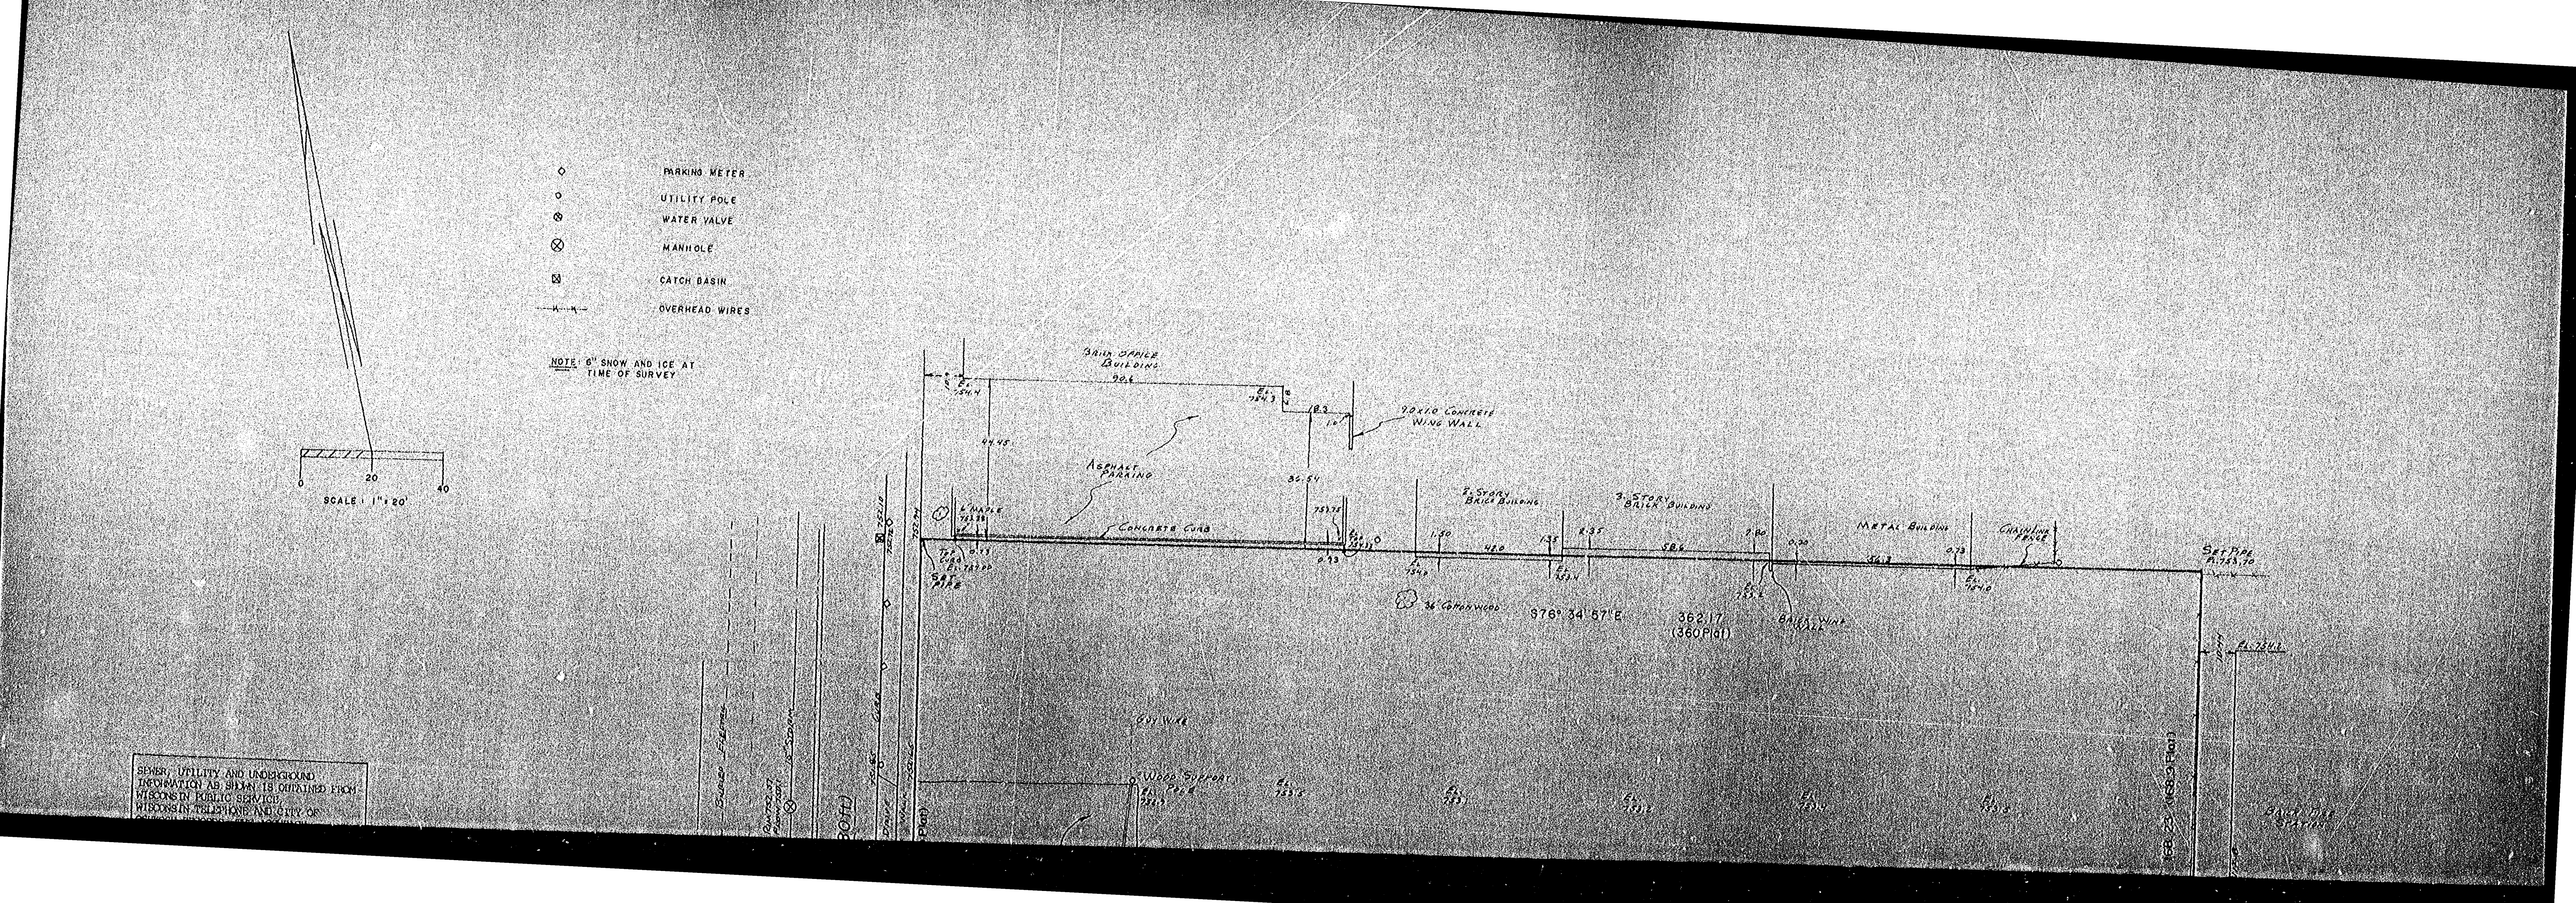
PARKING METER
UTILITY POLE
WATER VALVE
MANHOLE
CATCH BASIN
OVERHEAD WIRES
NOTE: 6" SNOW AND ICE AT TIME OF SURVEY
0
20
40
SCALE: 1" = 20'
90.6'
18.3
10'
90 X 10 CONCRETE WING WALL
64.45'
ASPHALT PARKING
85.54'
CONCRETE CURB
2-STORY BRICK BUILDING
3-STORY BRICK BUILDING
METAL BUILDING
CHAIN LINK FENCE
SET PIPE
S76° 34' 57"E
362.17'
(360 Plat)
BASE LINE
N76° 34' 57"W
WOOD SUPPORT
SEWER, UTILITY AND UNDERGROUND INFORMATION AS SHOWN IS OBTAINED FROM WISCONSIN PUBLIC SERVICE, WISCONSIN TELEPHONE AND CITY OF

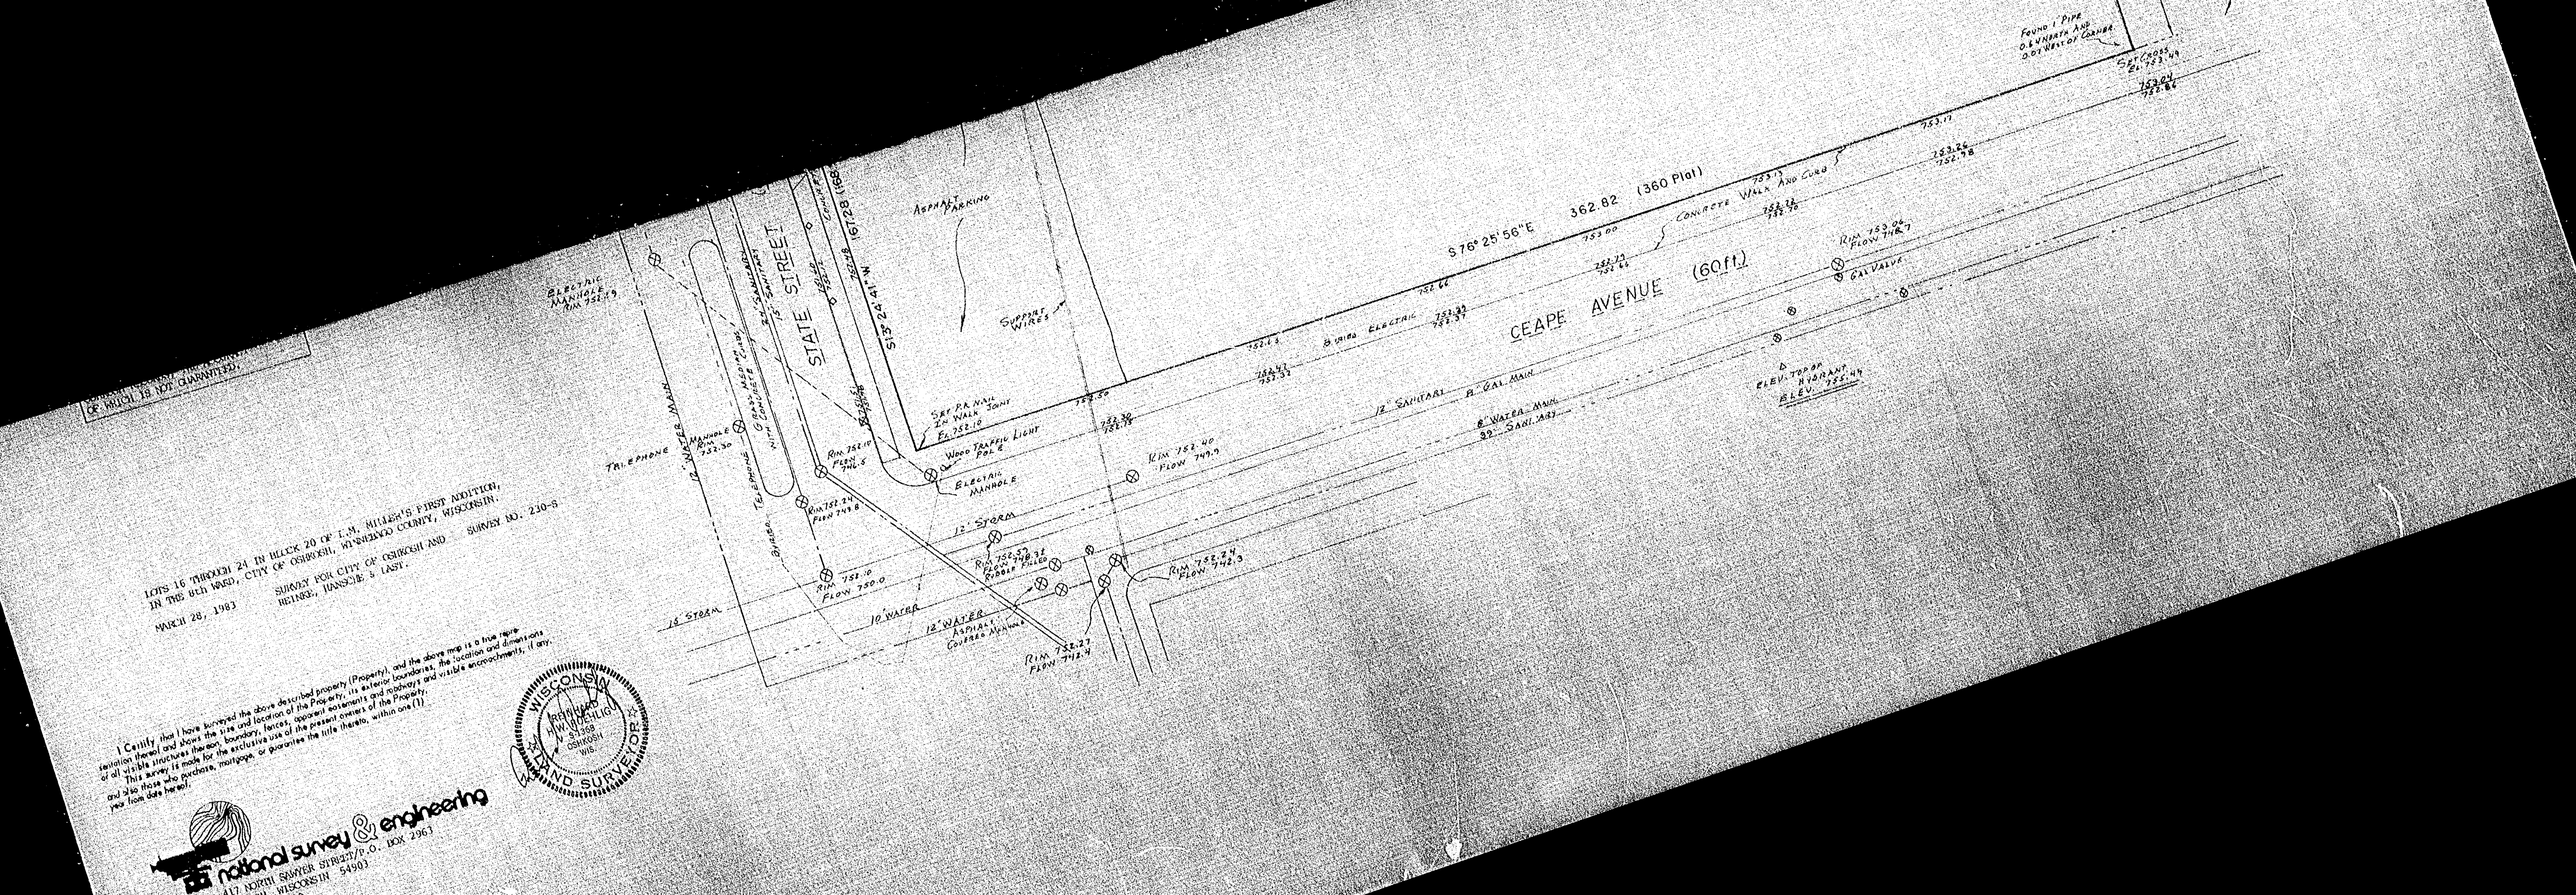

LOTS 16 THROUGH 24 IN BLOCK 20 OF L.M. MILLER'S FIRST ADDITION, IN THE 8th WARD, CITY OF OSHKOSH, WINNEBAGO COUNTY, WISCONSIN.

MARCH 28, 1983

SURVEY FOR CITY OF OSHKOSH AND HEINKE, HANSCHE & LAST.

SURVEY NO. 230-S

I Certify that I have surveyed the above described property (Property), and the above map is a true representation thereof and shows the size and location of the Property, its exterior boundaries, the location and dimensions of all visible structures thereon, boundary fences, apparent easements and roadways and visible encroachments, if any. This survey is made for the exclusive use of the present owners of the Property, and also those who purchase, mortgage or guarantee the title thereto, within one (1) year from date hereof.

WISCONSIN REGISTERED LAND SURVEYOR RICHARD HILDEBRAND S-1388 OSHKOSH WIS.

national survey & engineering
417 NORTH SAWYER STREET/P.O. BOX 2963
OSHKOSH, WISCONSIN 54903

SURVEY NO. 233-S

SHEET 1 of 3


CERTIFIED SURVEY MAP NO._____

BEING A PART OF LOTS 49, 50 AND 51 OF THE SUBDIVISION OF THE N.W.¼ OF THE S.W. ¼ OF SECTION 26, T18N, R16E PER LEACH'S MAP OF 1894, 13th WARD, NOW 14th WARD, CITY OF OSHKOSH, WINNEBAGO COUNTY, WISCONSIN.

O———— DENOTES 1 INCH DIAMETER IRON PIPE, 24" LONG, WEIGHING NOT LESS THAN 1.13 LBS PER LINEAL FOOT.

ALL DIMENSIONS ARE MEASURED TO THE NEAREST HUNDREDTH OF A FOOT.


BEARINGS ARE REFERENCED TO THE WEST LINE OF THE S.W. ¼ OF SECTION 23, WHICH HAS AN ASSUMED BEARING OF DUE NORTH.

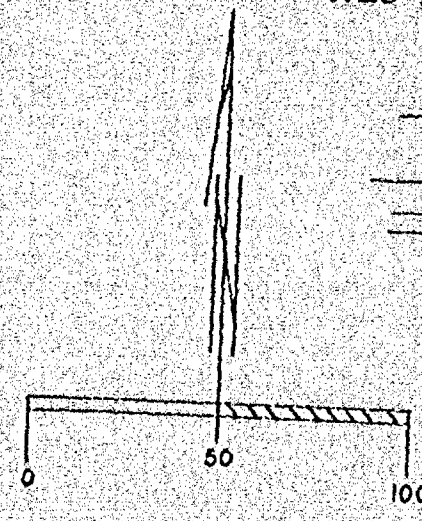

SCALE 1" = 50'

INTERIOR ANGLES

A) 89-42-25
B) 90-17-35
C) 89-41-10
D) 90-18-50
E) 89-42-25
F) 270-17-35

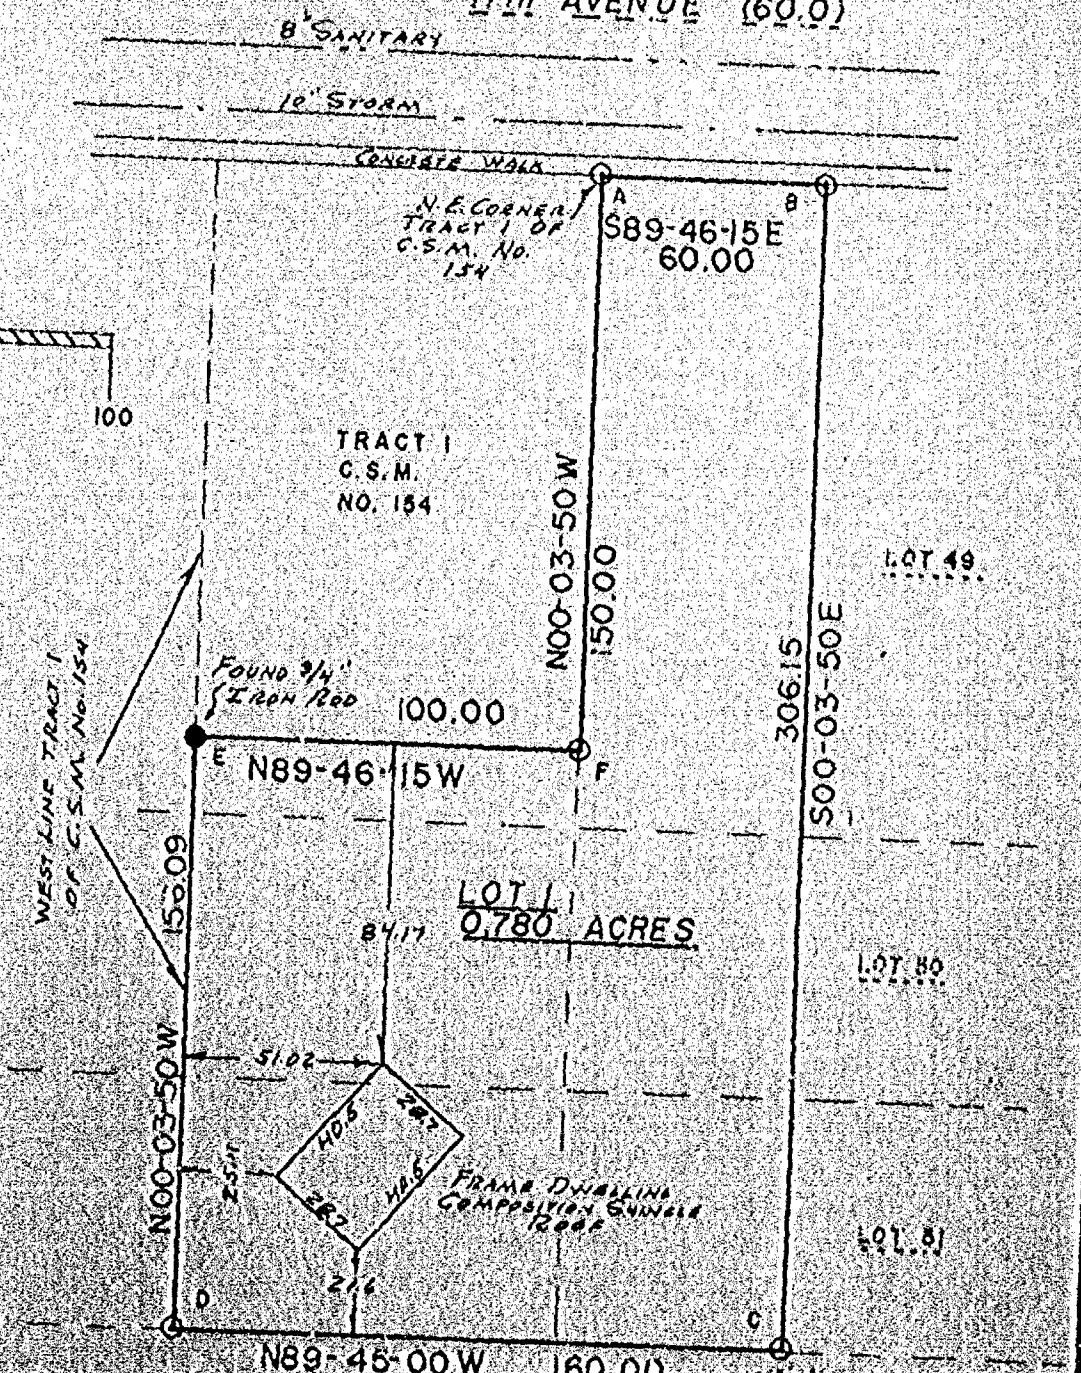

national survey & engineering
417 NORTH SAWYER STREET/P.O. BOX 2963
OSHKOSH, WISCONSIN 54903
(414) 426-2800

REGISTERED LAND SURVEYOR
4-22-83

CERTIFIED SURVEY MAP NO._____

BEING A PART OF LOTS 49,50 AND 51 OF THE SUBDIVISION OF THE N.W. ¼ OF THE S.W. ¼ OF SECTION 23, T18N, R16E, PER LEACH'S MAP OF 1894, 13th WARD, NOW 14th WARD, CITY OF OSHKOSH, WINNEBAGO COUNTY, WISCONSIN.

SURVEYOR'S CERTIFICATE
STATE OF WISCONSIN)
,SS
WINNEBAGO COUNTY)

I REINHARD ROEHLIG, Wisconsin land surveyor do hereby certify:

THAT I have surveyed and mapped a division of lots 49, 50 and 51 of the subdivision of the N.W. ¼ of the S.W. ¼ of section 26, T18N, R16E per Leach's Map of 1894, 13th Ward, now 14th Ward, City of Oshkosh, Winnebago County, Wisconsin which is described as commencing at the N.E. corner of Tract 1 of Winnebago County Certified Survey Map No. 154 as recorded in Volume 1 of Certified Survey Maps as Document No. 487660 thence South 89-46-15 East along the south right of way line of West 17th Avenue 60.00 ft. to a point, thence South 00-03-50 East and parallel with said Tract 1 306.15 ft. to a point, thence North 89-45-00 West and parallel with the south line of said Tract 1 aforesaid 160.00 ft. to the S.W. corner of said Tract 1, thence North 00-03-50 West along the west line of said Tract 1 156.09 ft. to a point, thence South 89-46-15 West 100.00 ft. to a point on the East line of said Tract 1, thence North 00-03-50 West along the East line of said Tract 1 aforesaid 150.00 ft. to the point of beginning.

THAT I have made this survey and land division and map by the direction of LU VERN KIENAST, City of Oshkosh, Wisconsin, owner of said land.

THAT such map is a correct representation of all the exterior boundaries of the land surveyed and the land division thereof made.

THAT I have fully complied with the provisions of Chapter 236 of the Wisconsin Statutes and the Land Subdivision Ordinance of the City of Oshkosh.

Date 4.22.83

Reinhard Roehlig, Registered
Land Surveyor S-1368

WINNEBAGO CO., WIS.
REINHARD
4-22-83
SURVEY

CERTIFIED SURVEY MAP NO._____

BEING A PART OF LOTS 49, 50 AND 51 OF THE SUBDIVISION OF THE N.W. ¼ OF THE S.W. ¼ OF SECTION 23, T18N, R16E, PER LEACH'S MAP OF 1894, 13th WARD, NOW 14th WARD, CITY OF OSHKOSH, WINNEBAGO COUNTY, WISCONSIN.

OWNER'S CERTIFICATE

AS OWNER, I hereby certify that I caused the land described on this map to be surveyed and mapped as represented on this map in accordance with the City of Oshkosh Subdivision Ordinance.

WITNESS the hand and seal of said owner this_____day of_____1983.

_____ _____
Witness Lu Vern Kienast

STATE OF WISCONSIN)
)SS
WINNEBAGO COUNTY)

PERSONALLY came before me this_____day of_____ 1983, the above named LuVern Kienast, to me known to be the person who executed the foregoing instrument and acknowledged the same.

_____
Notary Public, Winnebago County, Wisconsin


My Commission Expires_____.


CITY OF OSHKOSH PLANNING COMMITTEE CERTIFICATE

THIS CERTIFIED SURVEY MAP of a part of lots 49, 50 and 51 of the Subdivision of the N.W. ¼ of the S.W. ¼ of Section 23, T18N, R16E, per Leach's Map of 1894, 13th Ward, now 14th Ward, City of Oshkosh, Lu Vern Kienast, owner, is hereby approved.

DATE_____ _____
Planning Committee Chairman

THIS INSTRUMENT WAS DRAFTED BY REINHARD ROEHLIG.

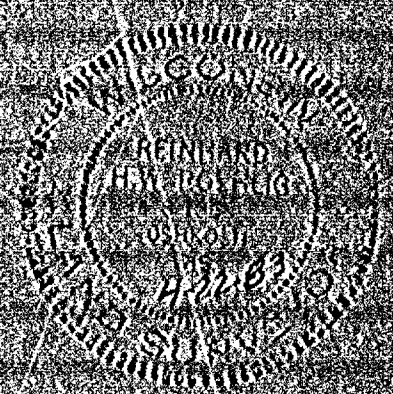

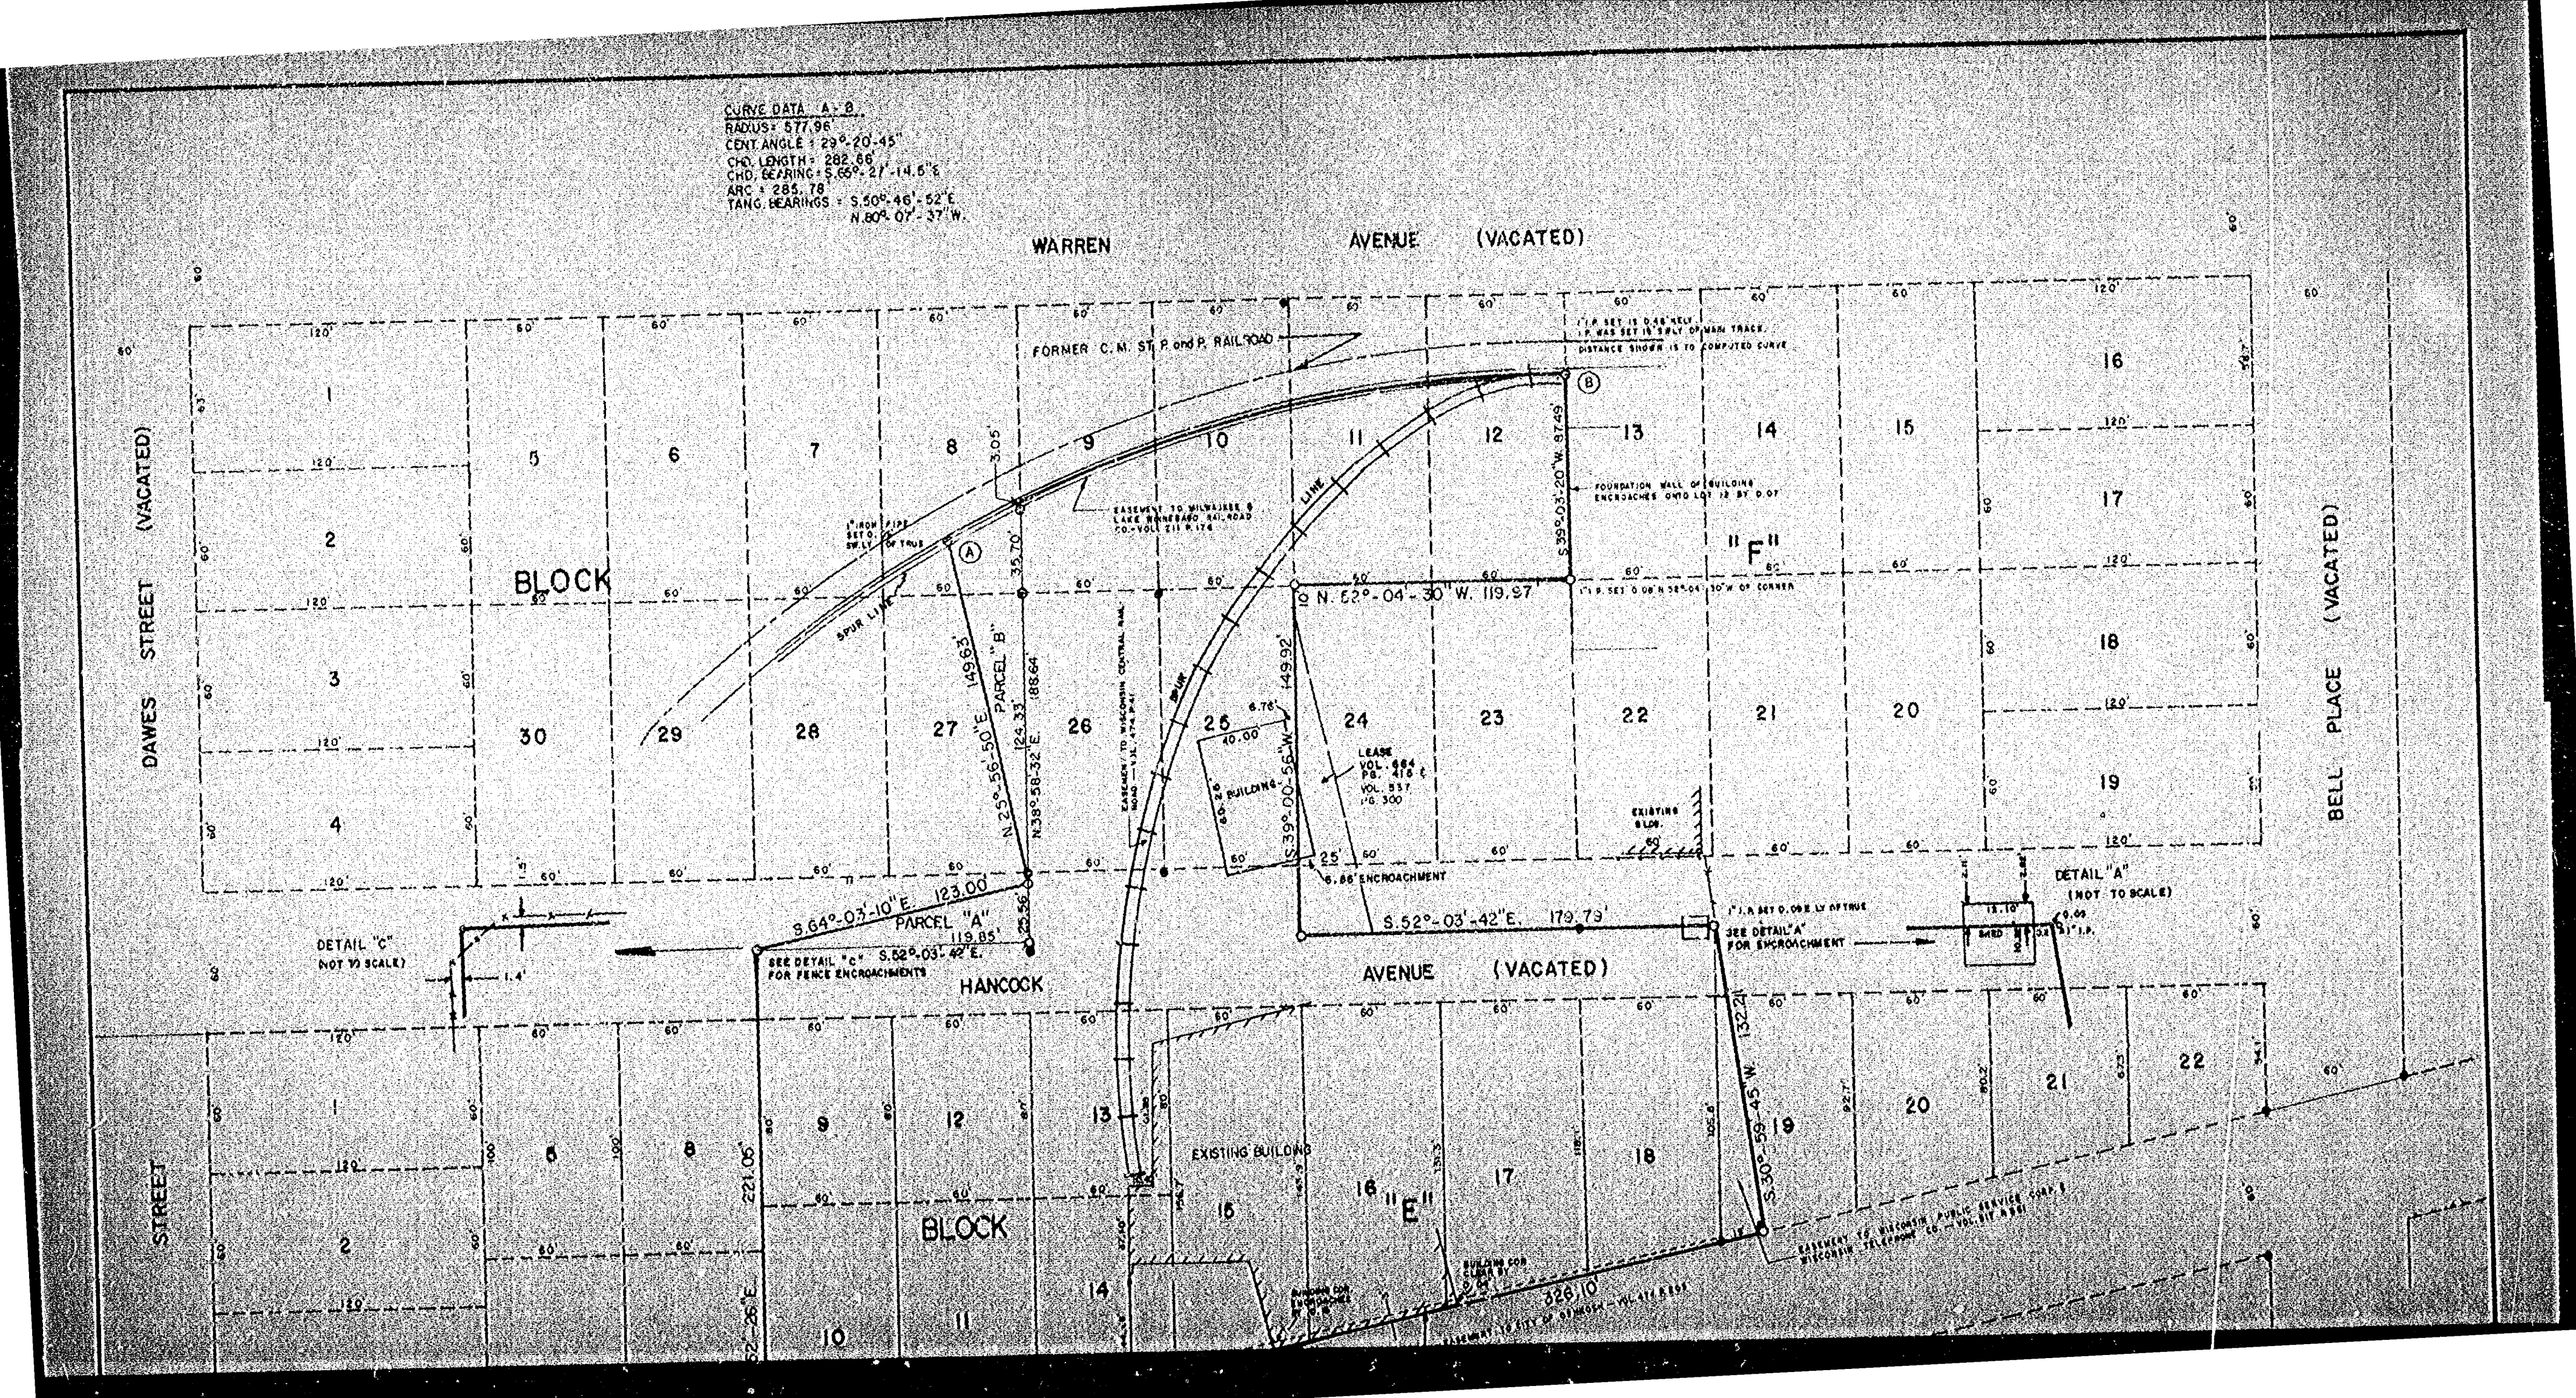
CURVE DATA A-B
RADIUS = 577.96'
CENT. ANGLE = 29°-20'-45"
CHD. LENGTH = 282.66'
CHD. BEARING = S.65°-21'-14.5"E
ARC = 285.78'
TANG. BEARINGS = S.50°-46'-52"E
N.80°-07'-37"W.
WARREN AVENUE (VACATED)
FORMER C. M. ST. P. and P. RAILROAD
DAWES STREET (VACATED)
BELL PLACE (VACATED)
BLOCK "F"
BLOCK "E"
HANCOCK AVENUE (VACATED)
PARCEL "A"
PARCEL "B"
SPUR LINE
EASEMENT TO MILWAUKEE & LAKE WINNEBAGO RAILROAD CO. VOL. 211 P. 174
EASEMENT TO WISCONSIN CENTRAL RAIL ROAD CO. VOL. 211 P. 174
LEASE VOL. 664 PG. 416 & VOL. 537 PG. 300
EXISTING BUILDING
FOUNDATION WALL OF BUILDING ENCROACHES ONTO LOT 12 BY 0.07'
6.66' ENCROACHMENT
SEE DETAIL "C" FOR FENCE ENCROACHMENTS
SEE DETAIL "A" FOR ENCROACHMENT
DETAIL "C" (NOT TO SCALE)
DETAIL "A" (NOT TO SCALE)
EASEMENT TO WISCONSIN PUBLIC SERVICE CORP. & WISCONSIN TEL. CO. — VOL. 517 M 281
N.52°-04'-30"W. 119.97'
S.52°-03'-42"E. 179.79'
S.64°-03'-10"E. 123.00'
S.52°-03'-42"E. 119.85'
S.39°-03'-20"W. 87.49'
S.39°-00'-56"W. 149.92'
N.25°-56'-50"E. 149.63'
N.38°-58'-32"E. 188.64'
S.52°-26'-E. 221.06'


DAWES
BLOCK
"E"
EXISTING BUILDING
N. 38°-52'-26"E. 221.05'
N. 62°-27'-06"W. 122.10'
N. 64°-03'-10"W. 326.10'
S. 30°-59'-45"W. 132.2'
MARION ROAD
EASEMENT TO CITY OF OSHKOSH — VOL 474 P 203
EASEMENT TO WISCONSIN PUBLIC SERVICE CORP. & WISCONSIN TELEPHONE CO. — VOL 817 R 881
DETAIL "B"
PROPERTY SURVEYED FROM DOC. NO 552043, VOL. 483 P 14, VOL. 360 P 408, VOL. 321 P. 115, & VOL. 1017 P. 56
DATED THIS 30TH DAY OF SEPTEMBER, 1982
LAWRENCE C. KRESCHER
WISCONSIN REGISTERED LAND SURVEYOR, S-1539
WISCONSIN LAWRENCE C. KRESCHER S-1539 OSHKOSH WISC. REGISTERED LAND SURVEYOR
LEGEND
O = 1"x 24" IRON PIPE SET
● = IRON PIPE FOUND
120' = PLAT DIMENSION
X = CHISELED CROSS IN SIDEWALK
AERO-METRIC ENGINEERING, INC.
1091 SOUTH WASHBURN STREET OSHKOSH, WISCONSIN 54901
DATE 9-29-1982 NOTEBOOK 68 PAGE 1 OF 1
SURVEY FOR OSHKOSH WOOD PRODUCTS CORP.
PART OF BLOCK E & F OF OLD VACATED HANCOCK AVE. WESTERN ADDITION, IN WARD, CITY OF OSHKOSH, WINNEBAGO COUNTY, WISCONSIN

PLAT OF SURVEY

MARION STREET

BENCHMARK: TOP OF HYDRANT STEM ELEV. 753.96

TELEPHONE AND ELECTRIC MANHOLE

BURIED TELEPHONE AND ELECTRIC

S65°33'25"E 10.95

CONCRETE WALK

SET P.K. NAIL

RIM 751.10 FLOW 741.40

RIM 751.10 FLOW 741.30

751.25

WATER VALVE

WATER MANHOLE RIM 752.95 N

UP RAMP

PADS FOR A/C UNITS

BURIED ELEC.

1 SIDE CONC. WALL

S89°37'49"W 324.55'

13.20'

ASPHALT DRIVE

751.03

5" POT CURB 751.50

1.5' WIDE CONCRETE CURB

49.84

RIM 750.81 FLOW 746.31

ELECTRIC

WATER

STORM

DIRT FILLED MANHOLE RIM 750.68

CATCH BASIN RIM 750.15 (NOT USED) 750.50

CURB 751.10 750.81

WATER VALVE CONCRETE WALK

UTILITY POLE

SET P.K. NAIL

UTILITY POLE W/ LIGHT

RIM 751.11 (WATER FILLED)

23.44

N00°26'46"E S00°26'46"W

ASPHALT AND CONCRETE PARKING

ASPHALT AND RUBBLE

750.8

SET P.K. NAIL AT D.75 BASE OF CURB 751.02

TOP OF CURB 751.28

10" ASPHALT 750.69

24.47

WATER

SANITARY

STORM

GAS VALVE

GAS VALVE

RIM 750.52 FLOW 743.62

RIM 750.65 COULD NOT OPEN

POSSIBLE BASIN UNDER ICE AND FROZEN GROUND

POSSIBLE GAS MANHOLE RIM 750.84

750.94

751.02 751.62

CONCRETE MEDIAN

METAL LIGHT POLE WITH TRAFFIC LIGHT

751.40 750.96

CATCH BASIN RIM 750.71 FLOW 749.1

33" SANITARY

CATCH BASIN RIM 750.59 FLOW 749.0

12" WATER

10" STORM

750.68 751.37

751.37

CONCRETE WALK

WATER VALVE

CURB 751.13

751.05

RIM 750.90 (FILLED WITH WATER + MUD)

TRAFFIC LIGHT

CURB 751.13

751.05

MANHOLE RIM 751.38 FILLED WITH WATER

CATCH BASIN RIM 750.73 FLOW 748.83

ELECTRIC MANHOLE

TRAFFIC LIGHTS

RIM 751.30 FLOW 746.40

SET CROSS IN WALK (N.E. CORNER LOT 1 OF MOORE'S SUB'D.)

S89°25'39"E 184.48 (185.0 Rec.)

ASPHALT AND RUBBLE

750.8

751.1

WATER MAIN

SANITARY

STORM

MARION STREET

SCALE 1" = 20'

- ⊠ CATCH BASIN
- ⊗ MANHOLE
- ⊗ VALVE BOX
- OVERHEAD WIRES
- DIRECTION OF FLOW

SEWER, UTILITY AND UNDERGROUND INFORMATION AS SHOWN IS OBTAINED FROM WISCONSIN PUBLIC SERVICE, WISCONSIN TELEPHONE AND CITY OF OSHKOSH RECORDS, THE ACCURACY OF WHICH IS NOT GUARANTEED.

MAIN STREET

N06°56'46"E 292.7 (7385)

S00°50'59"W 275.66

220.65

N68°14'29"W 216.06

N68°42'00"W 221.69

FOX RIVER

S 55.42

90.0 DEED & REC. VOL. 12-43, PAGE 374 WINNEBAGO COUNTY RECORDS

EASEMENT

SECTION TOP OF 0.5 WIDE CONCRETE WALL 751.55

742.82 ON ASPHALT

CONCRETE BULKHEAD

CORNER CONCRETE BULKHEAD 751.25

TOP OF CURB 751.08

TOP OF CURB 751.58

ON ASPHALT 750.53

750.5

750.5 UTILITY POLE WITH LIGHT

750.9

749.5

750.3

750.6

RIM 749.63 FILLED WITH WATER

SHORELINE

STEEL HIGH TENSION POLE ON CONC. PAD

OVERHEAD WIRES AND CENTERLINE W.P.S. EASEMENT PER VOL. 1240, PAGE 516 WINNEBAGO COUNTY RECORDS

WOOD UTILITY POLE

GUY WIRE

CONCRETE FILLED STEEL GUARD POSTS

ELEVATION TOP OF ICE 741.55

UTILITY POLE

749.4

RIM 150.0 FLOW 145.9

751.3

65.0

CONCRETE BLOCK AND BRICK BUILDING SHINGLE ROOF, #3

6.42

25.9

65.0

BRICK SAILING

ELECTRIC MANHOLE RIM 151.74

RIM 152.08 FILLED WITH WATER AND MUCK

RIM 152.30 FLOW 149.30

METAL LIGHT POLE

42" STORM

33" SANITARY

CONCRETE

CONCRETE WALK

SAT. NORTH IN WALK FOR MAIN SOUTH POSITION; WEST EDGE WALK IS ON LINE FOR EAST WEST POSITION.

THAT PART OF THE FIRST WARD, CITY OF OSHKOSH, WINNEBAGO COUNTY, WISCONSIN WHICH IS BOUNDED AND DESCRIBED AS FOLLOWS: COMMENCING AT THE N.E. CORNER OF LOT 1 OF MOORE'S SUBDIVISION THENCE SOUTH 00°50'59" WEST ALONG THE WEST R.O.W. LINE OF MAIN STREET 275.66 FT. TO A POINT ON THE U.S. HARBOR LINE, THENCE NORTH 68°42'00" WEST ALONG SAID HARBOR LINE 221.69 FT. TO A POINT, THENCE NORTH 06°56'46" EAST 129.27 FT. TO A POINT, THENCE NORTH 00°26'46" EAST 123.44 FT. TO A POINT ON THE CENTERLINE OF MARION STREET (NOW VACATED), THENCE SOUTH 65°33'25" EAST ALONG SAID CENTERLINE 10.95 FT. TO A POINT, THENCE SOUTH 00°26'46" WEST 49.84 FT. TO A POINT ON THE SOUTH R.O.W. LINE OF MARION STREET, THENCE SOUTH 89°28'59" EAST 84.48 FT. TO THE POINT OF BEGINNING. SAID PARCEL CONTAINS APPROXIMATELY 0.94 ACRES OF LAND.

JANUARY 3, 1983 — SURVEY FOR CITY OF OSHKOSH — SURVEY NO. 224-S

MARCH 28, 1983 — REVISION NO. 1

I Certify that I have surveyed the above described property (Property), and the above map is a true picture of all visible structures thereon, boundary fences, apparent easements and roadways and visible encroachments, if any, and of the house who purchases, mortgages or guarantees the title thereto, within one (1) year from date hereof.

national survey & engineering
412 NORTH SAWYER STREET / OSHKOSH, WIS. 54901
920-235-2809


WISCONSIN REINHARD W. ROEHLIG 1554 OSHKOSH WIS. LAND SURVEYOR

PLAT OF SURVEY

KNOWN AS 216 ALLEN AVENUE. LOT 10 OF BLOCK 20 IN THE INTER URBAN LAND COMPANY'S THIRD ADDITION TO THE PLAT ALSO; THAT PART OF THE WEST 1/2 OF THE S.W. 1/4 OF SECTION 12, T18N, R16E, DESCRIBED AS FOLLOWS; COMMENCING ON THE NORTH LINE OF ALLEN AVENUE (FORMERLY POWERS AVENUE) AT A POINT THAT IS 418.0 FT. EAST OF THE EAST LINE OF JACKSON STREET (SAID POINT BEING THE POINT OF INTERSECTION OF THE NORTH LINE OF ALLEN AVENUE WITH THE WEST LINE OF LOT 10 OF BLOCK 20 ACCORDING TO THE MAP OF INTER URBAN LAND COMPANY'S THIRD ADDITION TO THE PLAT); THE PLACE OF BEGINNING; THENCE NORTH ALONG THE WEST LINE OF SAID LOT 10 AFORESAID 150.0 FT. TO THE N.W. CORNER OF SAID LOT 10, THENCE WEST PARALLEL WITH THE NORTH LINE OF SAID ALLEN AVENUE 50.0 FT., THENCE SOUTH PARALLEL WITH THE WEST LINE OF SAID LOT 10 AFORESAID 150.0 FT. TO THE NORTH LINE OF SAID ALLEN AVENUE, THENCE EAST ALONG THE NORTH LINE OF SAID ALLEN AVENUE 50.0 FT. TO THE PLACE OF BEGINNING; ALL IN THE FIFTEENTH WARD OF THE CITY OF OSHKOSH, WINNEBAGO COUNTY, WISCONSIN.

JULY 2, 1981 (SURVEY FOR FIRST SAVINGS AND SURVEY NO. 102
MICHAEL D. SOHM)

MARCH 7, 1983 REVISE SURVEY

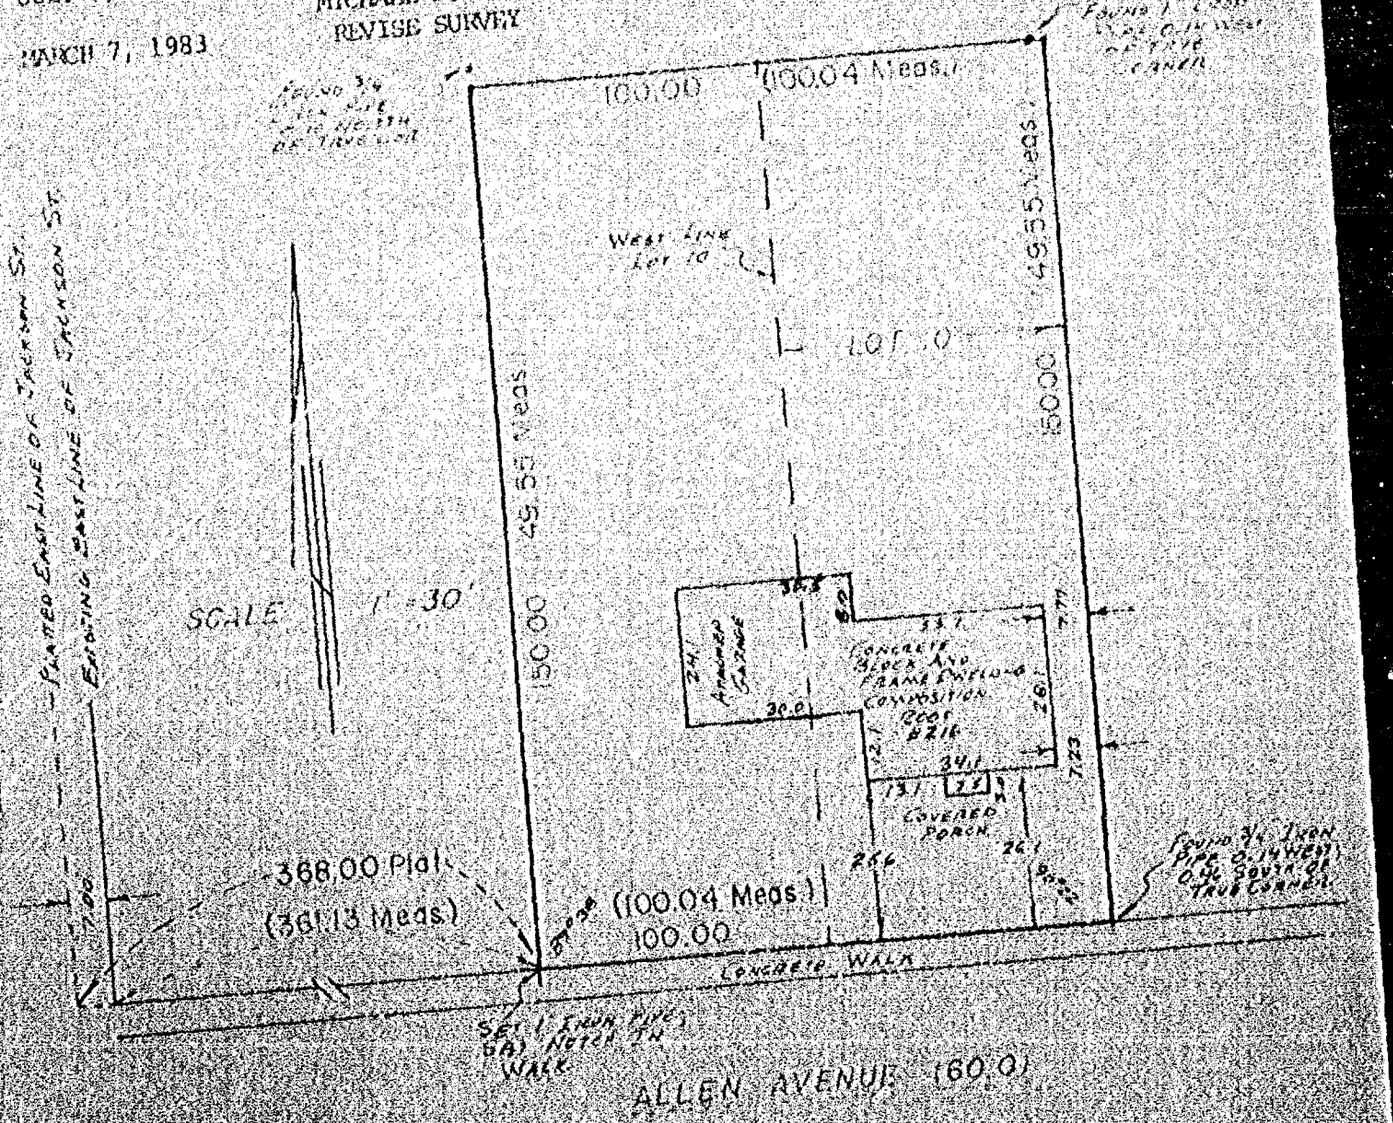

I Certify that I have surveyed the above described property (Property), and the above map is a true representation thereof and shows the size and location of the Property, its exterior boundaries, the location and dimensions of all visible structures thereon, boundary, fences, apparent easements and roadways and visible encroachments, if any.

This survey is made for the exclusive use of the present owners of the Property, and also those who purchase, mortgage, or guarantee the title thereto, within one (1) year from date hereof.

Reinhard Roehlig

WISCONSIN REINHARD H.W. ROEHLIG S-1368 OSHKOSH WIS LAND SURVEYOR

[redacted] national survey & engineering


PLAT OF SURVEY

THAT PART OF THE FIRST WARD, CITY OF OSHKOSH, WINNEBAGO COUNTY, WISCONSIN, WHICH IS BOUNDED AND DESCRIBED AS FOLLOWS: COMMENCING AT THE N.E. CORNER OF LOT 1 IN MOORE'S SUBDIVISION, THENCE NORTH 89°25'39" WEST ALONG THE EXISTING SOUTH LINE OF MARION STREET 194.48 FT. TO A POINT, THENCE NORTH 00°26'46" EAST 16.71 FT. TO THE POINT OF BEGINNING, THENCE NORTH 89°37'49" WEST ALONG THE SOUTH FACE OF AN EXISTING CONCRETE PARKING RAMP WALL 239.75 FT. TO A POINT, THENCE SOUTH 00°22'11" WEST AT A RIGHT ANGLE TO SAID WALL 96.00 FT. TO A POINT ON A CONCRETE BULKHEAD, THENCE SOUTH 70°00'42" EAST ALONG SAID BULKHEAD 243.17 FT. TO A POINT, THENCE NORTH 06°56'46" EAST 92.35 FT. TO A POINT, THENCE NORTH 00°26'46" EAST 85.90 FT. TO THE POINT OF BEGINNING. SAID PARCEL CONTAINS APPROXIMATELY 0.752 ACRES.

JANUARY 18, 1983 — PROPOSED CONVENTION CENTER PARKING AREA BETWEEN EXISTING PARK PLAZA PARKING RAMP AND THE FOX RIVER

SURVEY NO. 224-S

MARCH 28, 1983 — REVISION NO. 1

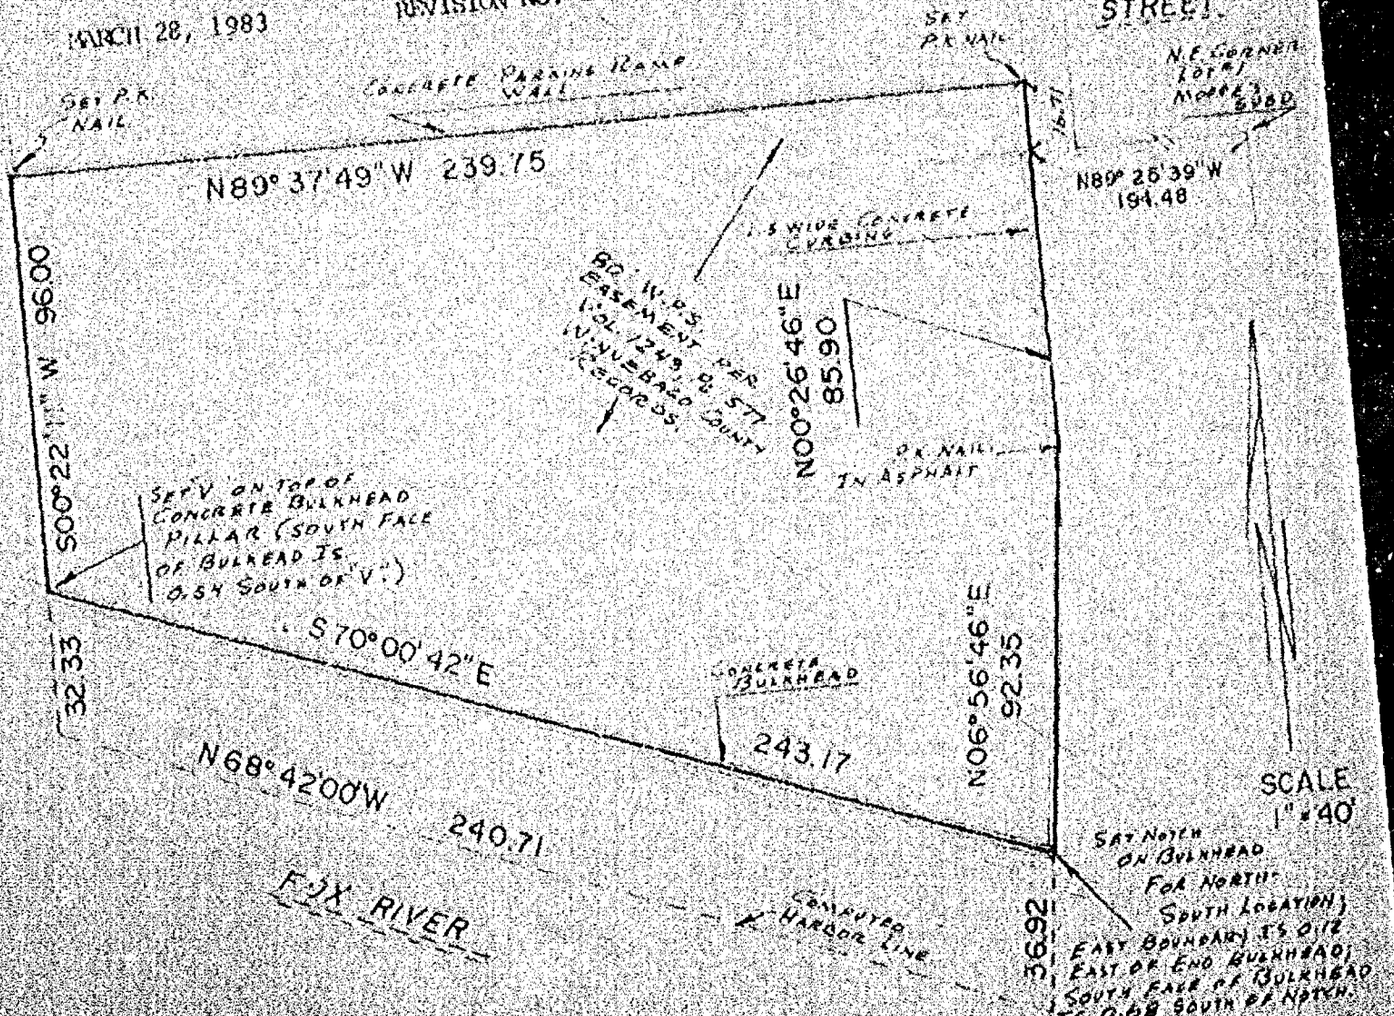


I Certify that I have surveyed the above described property (Property), and the above map is a true representation thereof and shows the size and location of the Property, its exterior boundaries, the location and dimensions of all visible structures thereon, boundary fences, apparent easements and roadways and visible encroachments, if any. This survey is made for the exclusive use of the present owners of the Property, and also those who purchase, mortgage, or guarantee the title thereto, within one (1) year from date hereof.

WISCONSIN LAND SURVEYOR
R. J. NHARD
H. M. ROCH
S-1358
OSHKOSH
WIS.

national survey & engineering
417 NORTH SAWYER STREET / P.O. BOX 2963
OSHKOSH, WISCONSIN 54903
(414) 426-2800

SURVEY
FOR
ARLIE WOLFF

The Westerly 5 feet of Lot 8 and the Easterly 50 feet of Lot 9, Block "C" in the Plat of Andrese, Lang & Reisbrod's Addition, 2nd Ward, City of Oshkosh, Winnebago County, Wisconsin.

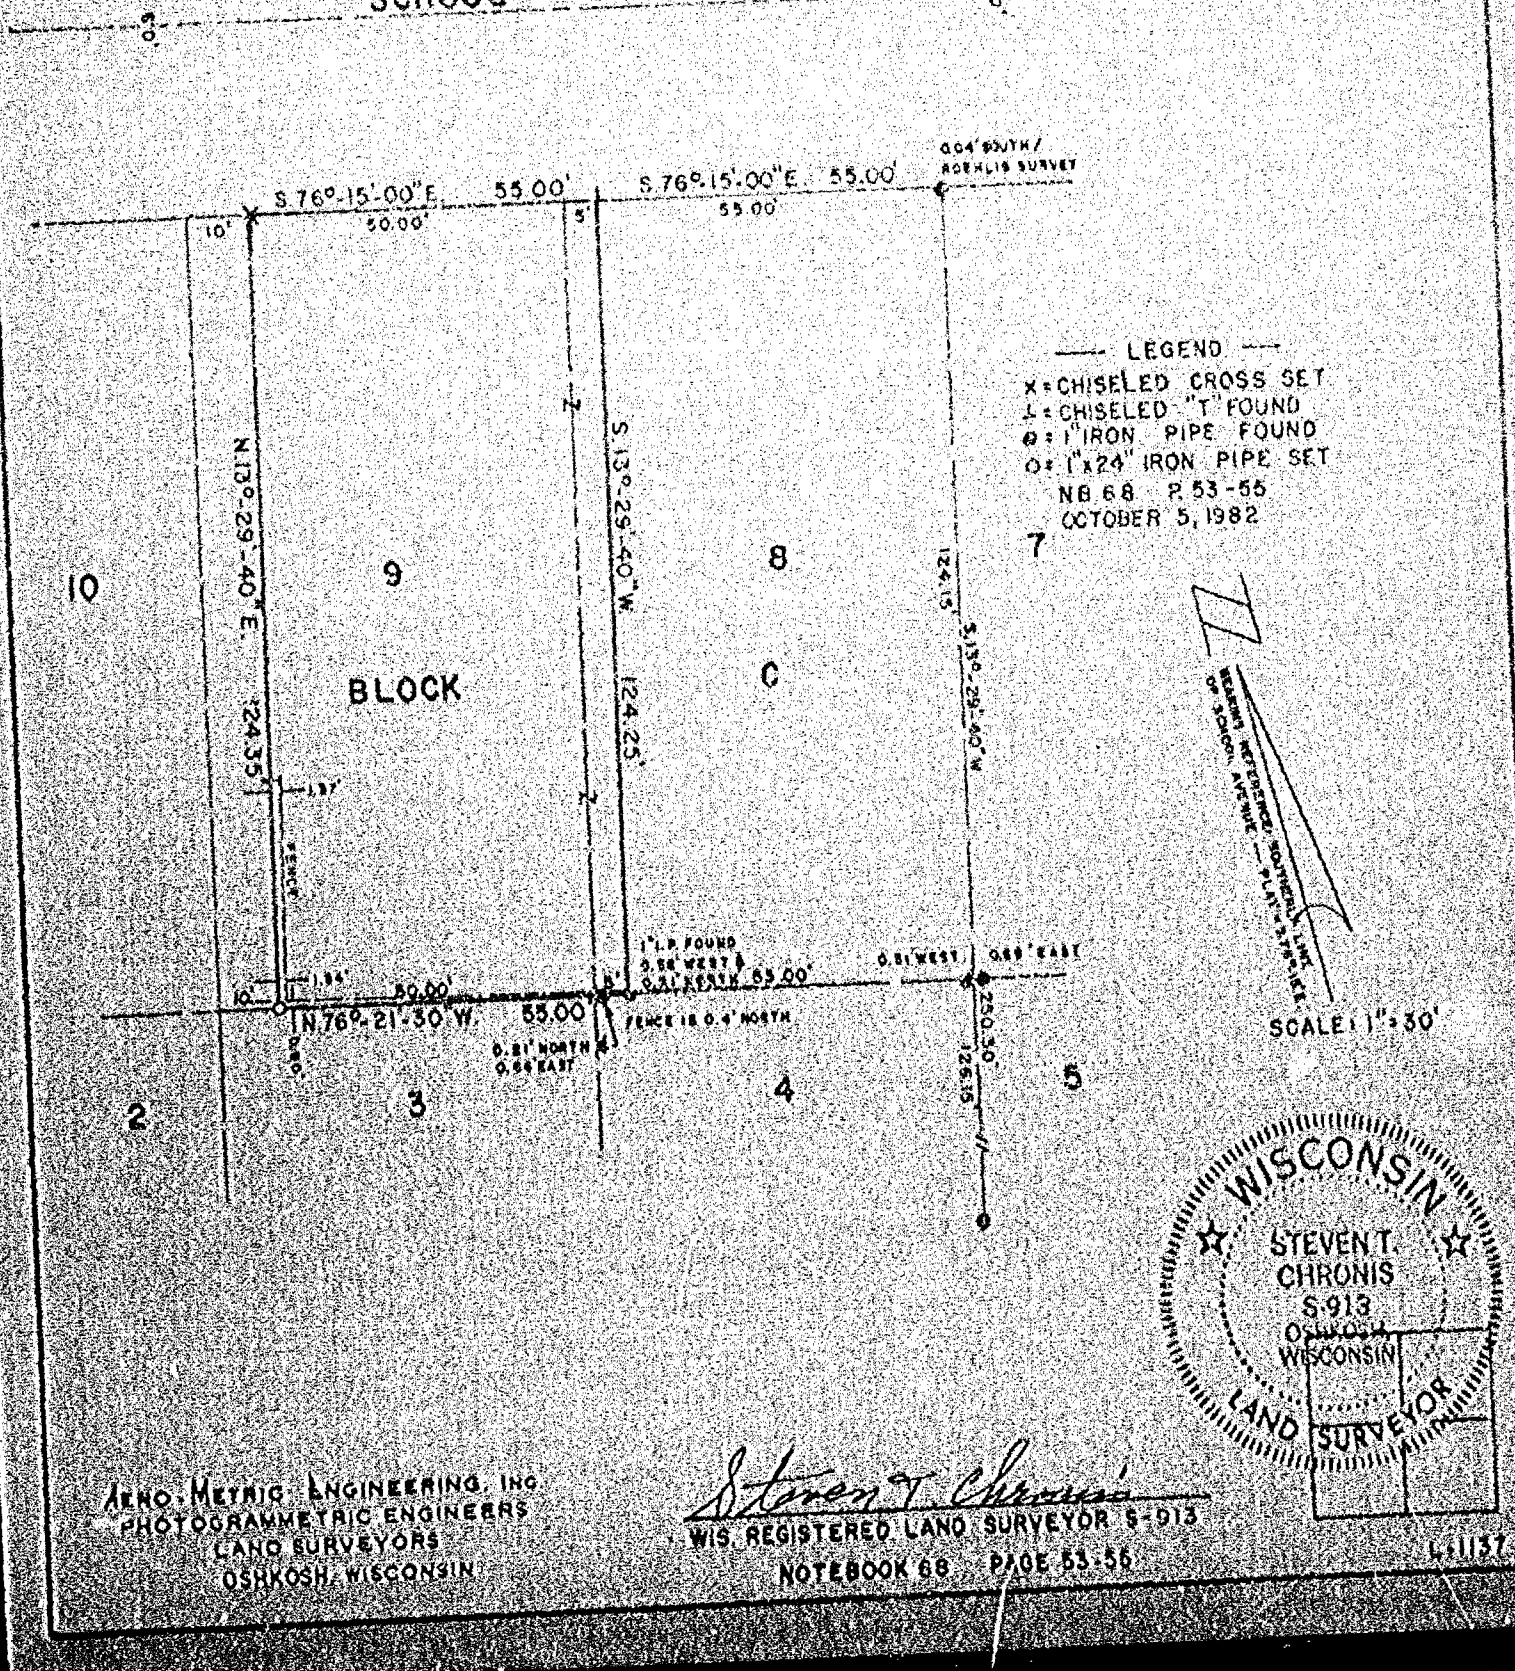

WISCONSIN
STEVEN T. CHRONIS
S-913
OSHKOSH
WISCONSIN
LAND SURVEYOR

ARNO-METRIC ENGINEERING, INC.
PHOTOGRAMMETRIC ENGINEERS
LAND SURVEYORS
OSHKOSH, WISCONSIN

Steven T. Chronis
WIS. REGISTERED LAND SURVEYOR S-913

NOTEBOOK 68 PAGE 53-56

4-1137

STATE OF WISCONSIN) ss
WINNEBAGO COUNTY)

WINNEBAGO COUNTY CERTIFIED SURVEY MAP NO. 994

SHEET 1 OF 2

SURVEYOR'S CERTIFICATE:

I, Steven T. Chronis, Wisconsin Registered Land Surveyor of Aero-Metric Engineering, Inc., certify that I have surveyed, divided and mapped under the direction of Cal Culbertson of Knight Realty & Development, a part of Lot 17 in John Smith's Second Addition to Oshkosh, Ninth (9th) Ward, City of Oshkosh, Winnebago County, Wisconsin, also being Lot 1 of Certified Survey Map No. 854 as recorded in Volume 1 Page 854 of Certified Survey Maps containing 12,813.96 square feet of land and being described by: Commencing at the Southeast corner of said Lot 17, thence N. 89°-18'-36" W. 76.55 feet along the South line of said Lot 17 to the true point of beginning, thence continuing N. 89°-18'-36" W. 120.00 feet along the South line of said Lot 17 to a point S. 89°-18'-36" E. 104.00 feet from the Southwest corner of said Lot 17, thence N. 00°-00'-42" E. 106.80 feet along a line 104.00 feet East of and parallel to the West line of said Lot 17 to a point 92.00 feet South of the North line of said Lot 17, thence S. 89°-18'-04" E. 120.00 feet along a line 92.00 feet South of and parallel to the North line of said Lot 17, thence S. 00°-00'-42" W. 106.78 feet to the true point of beginning.


That such is a correct representation of all exterior boundaries of the land surveyed.

That I have fully complied with the provisions of Chapter 236.34 of the Wisconsin Statutes and the Land Subdivision Ordinance of the City of Oshkosh in surveying and mapping the same.

Dated this 20th day of July, 1981

Steven T. Chronis
Wisconsin Registered Land Surveyor S-913
Steven T. Chronis

WISCONSIN
STEVEN T. CHRONIS
S-913
OSHKOSH, WISCONSIN
LAND SURVEYOR

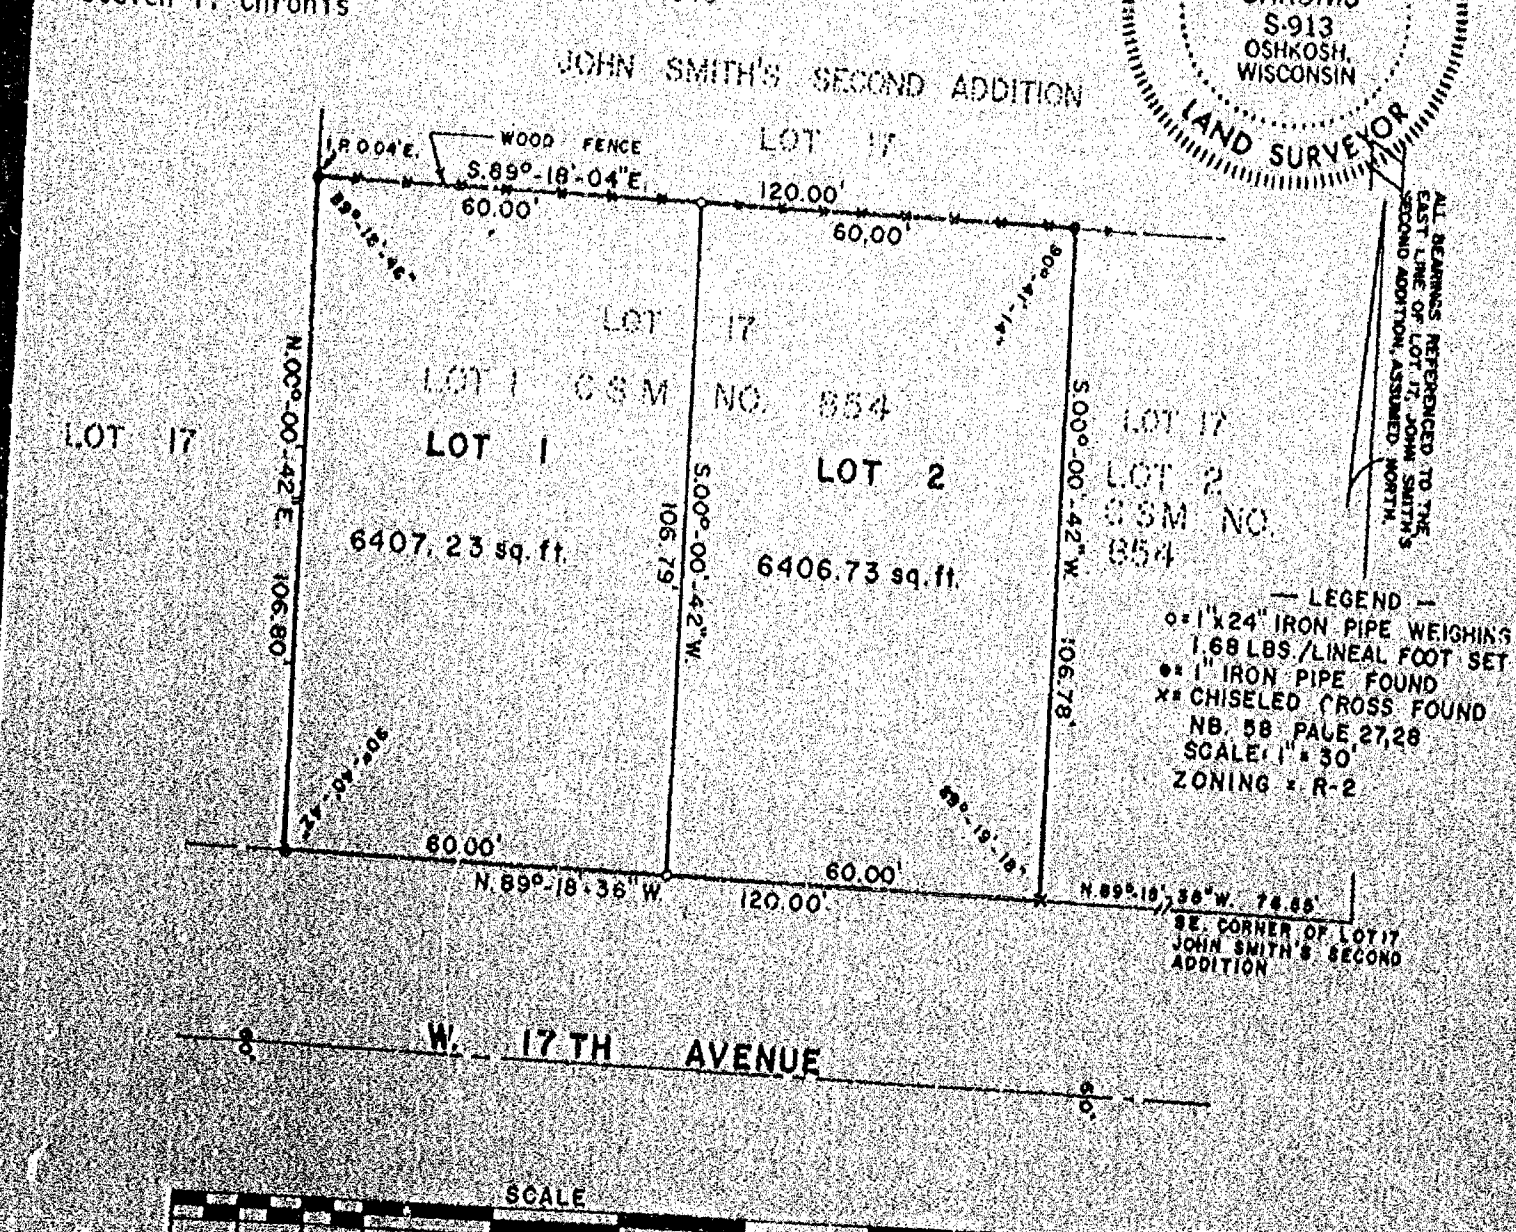

— LEGEND —
○ = 1"x24" IRON PIPE WEIGHING 1.68 LBS./LINEAL FOOT SET
● = 1" IRON PIPE FOUND
× = CHISELED CROSS FOUND
NB. 58 PAGE 27,28
SCALE: 1" = 30'
ZONING = R-2

AERO-METRIC ENGINEERING, INC.
1091 SOUTH WASHBURN STREET
OSHKOSH, WISCONSIN 54901

THIS INSTRUMENT DRAFTED BY STEVEN T. CHRONIS

L-988

STATE OF WISCONSIN)
WINNEBAGO COUNTY) SS

OWNER'S CERTIFICATE:

As owner, I hereby certify that I caused the land described on this Certified Survey Map to be surveyed, divided and mapped as represented on this map.

Dated this 18th day of March, ~~19XX~~ 1982.

In the Presence of:

Calvin W. Culbertson

Barbara J. Fredrickson

STATE OF WISCONSIN)
WINNEBAGO COUNTY) SS

Personally came before me this 18th day of March, 19~~8~~2 the above named Calvin W. Culbertson to me known to be the person who executed the foregoing instrument and acknowledged the same.

Notary Public State of Wisconsin
My Commission expires June 27, 1982.

CITY PLANNING COMMISSION CERTIFICATE:

This Certified Survey Map of a part of Lot 1 of Certified Survey Map No. 854 also being a part of Lot 17 of John Smith's Second Addition, Calvin W. Culbertson, owner, is hereby approved.

7/27/81
Date

Paul Ehrfurth
Secretary of Planning Commission

Dated this 20th day of July, 1981

Steven T. Chronis
Wisconsin Registered Land Surveyor S-913
Steven T. Chronis

573794


Register's Office
Winnebago County, Wis.
Received for record this 18th
day of March A.D. 1982
at 2:10 o'clock P.M. and
recorded in Vol. 1 of CSM
on page 194
Register of Deeds

WISCONSIN
STEVEN T. CHRONIS
S-913
OSHKOSH
WISCONSIN
LAND SURVEYOR

Cathy Zibbe 2:10

81-M190 L-988

DESCRIPTION: LOT 9, BLOCK 2 AND THE WEST ½ OF VACATED ALLEY LYING EAST OF AND ADJOINING TO LOT 9, FIRST ADDITION TO THE PLAT OF INTER-URBAN LAND CO., CITY OF OSHKOSH, WINNEBAGO COUNTY, WISCONSIN.

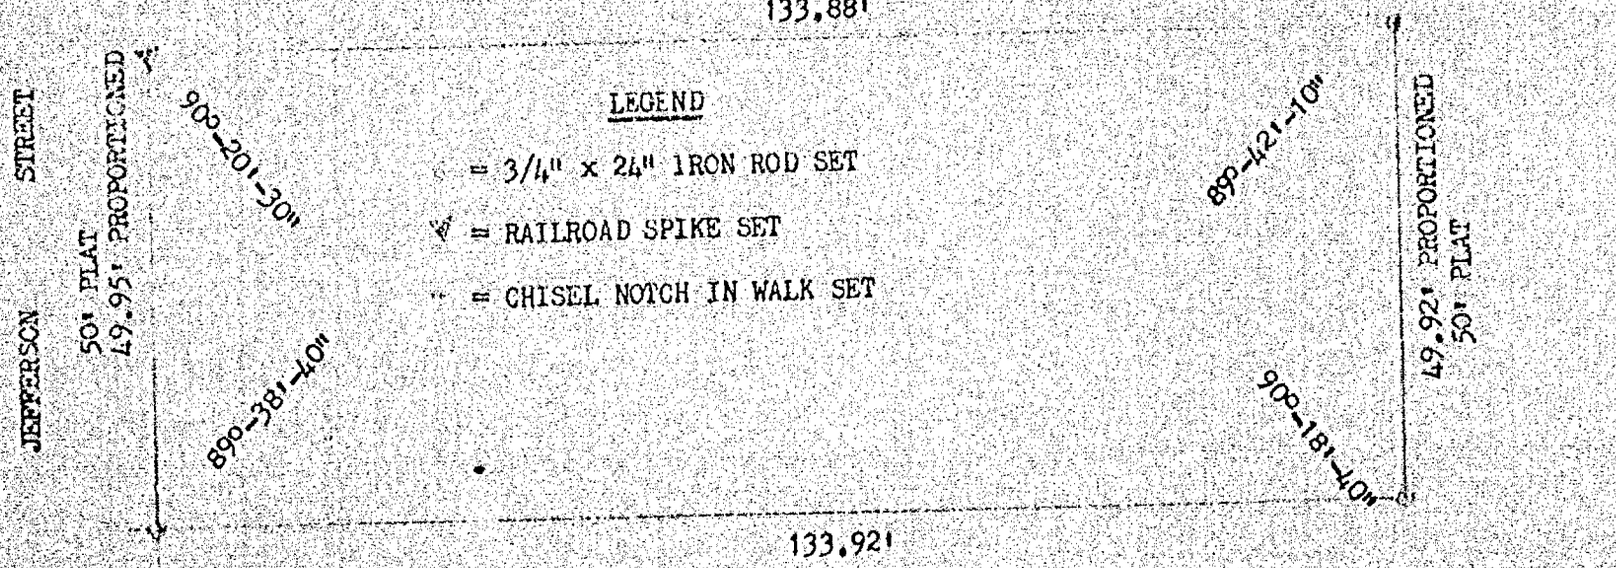

LEGEND

= 3/4" x 24" IRON ROD SET

= RAILROAD SPIKE SET

= CHISEL NOTCH IN WALK SET

I, ROBERT F. REIDER, CERTIFY THAT THIS PLAT OF SURVEY IS A CORRECT REPRESENTATION OF THE ABOVE DESCRIBED PROPERTY.

WISCONSIN
ROBERT F. REIDER
S-1251
APPLETON, WI
LAND SURVEYOR

REVISIONS	RUSS YOUNG 2308 N. JACKSON DR. OSHKOSH, WIS. 54901 OARROW LAND SURVEYING CO., INC. P.O. BOX 1207 1837 W. WISCONSIN AVE. • APPLETON, WI 54912		
	DRAWN BY rr th RFR	SCALE 1"=20'	DRAWING NO. A822.44
	APP'D LEO	DATE 2-15-82	

PLAT OF SURVEY

FOR: Fox Valley Land Title Corp.
230 N. Morrison Street
Appleton, WI 54911


Thomas J. Salzer
826 Greenfield Trail
Oshkosh, WI 54901

PROPERTY DESCRIPTION:

Lot Fifty-six (56), FIRST ADDITION TO WESTWAY PLAT, City of Oshkosh, Winnebago County, Wisconsin.

Scale 1" = 40'

o = 3/4" x 24" Rebar Recovered

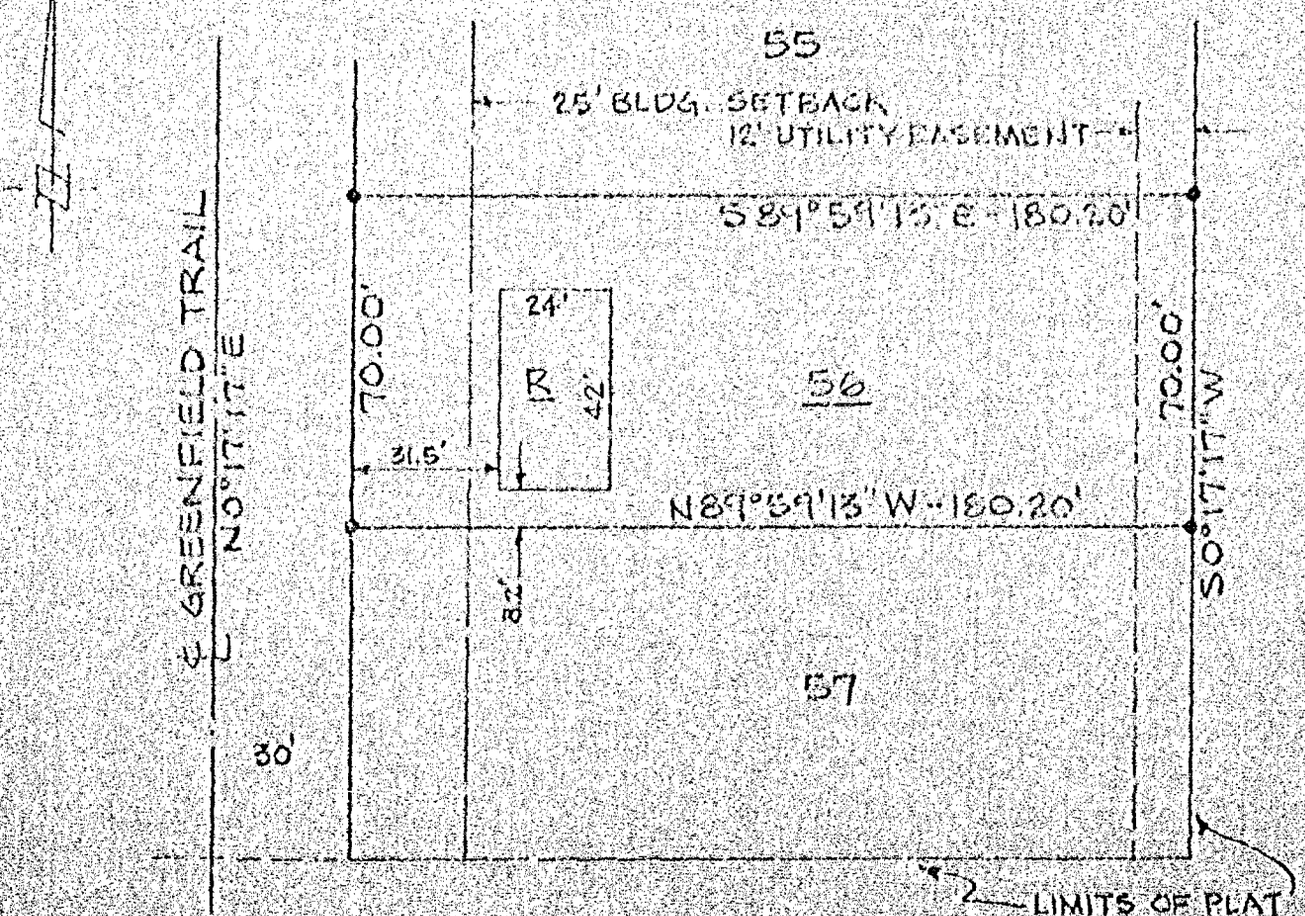

WISCONSIN
THEODORE J. HARRIS
S-248
APPLETON, WIS.
LAND SURVEYOR

STATE OF WISCONSIN
COUNTY OF OUTAGAMIE

I do hereby certify that I have surveyed the property described above according to official records, and that the plat above drawn is a correct representation of said survey.

Appleton, Wis. February 25, 19 81

Theodore J. Harris
REGISTERED LAND SURVEYOR

HARRIS AND ASSOCIATES, INC.	APPLETON, WISCONSIN	DWG. AS-4100


PLAT OF SURVEY

FOR: Fox Valley Land Title Corp.
230 N. Morrison Street
Appleton, WI 54911

James M. Mosling
2374 Abbey Avenue
Oshkosh, WI 54901

PROPERTY DESCRIPTION:
Lot Forty-five (45), FIRST ADDITION TO WESTWAY PLAT, Sixth Ward, City of Oshkosh, Winnebago County, Wisconsin.

• = 3/4" Rebar Recovered

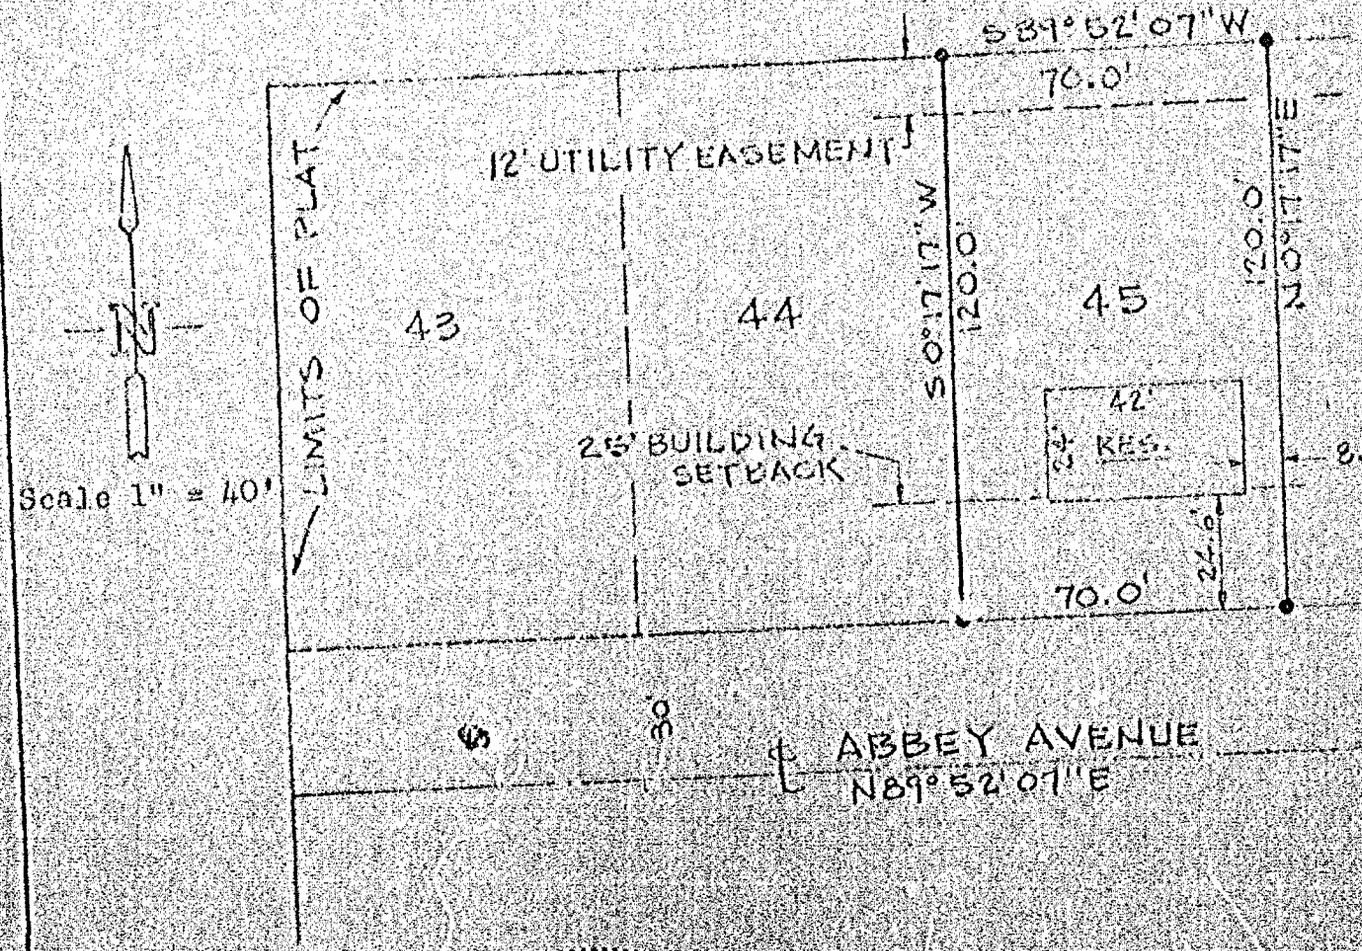

WISCONSIN
THEODORE J. HARRIS
6-248
APPLETON, WIS.
LAND SURVEYOR


STATE OF WISCONSIN
COUNTY OF OUTAGAMIE


I do hereby certify that I have surveyed the property described above according to official records, and that the plat above drawn is a correct representation of said survey.

Appleton, Wis. November 4, 19 81

REGISTERED LAND SURVEYOR

HARRIS AND ASSOCIATES, INC. | APPLETON, WISCONSIN | DWG. AS. 4060

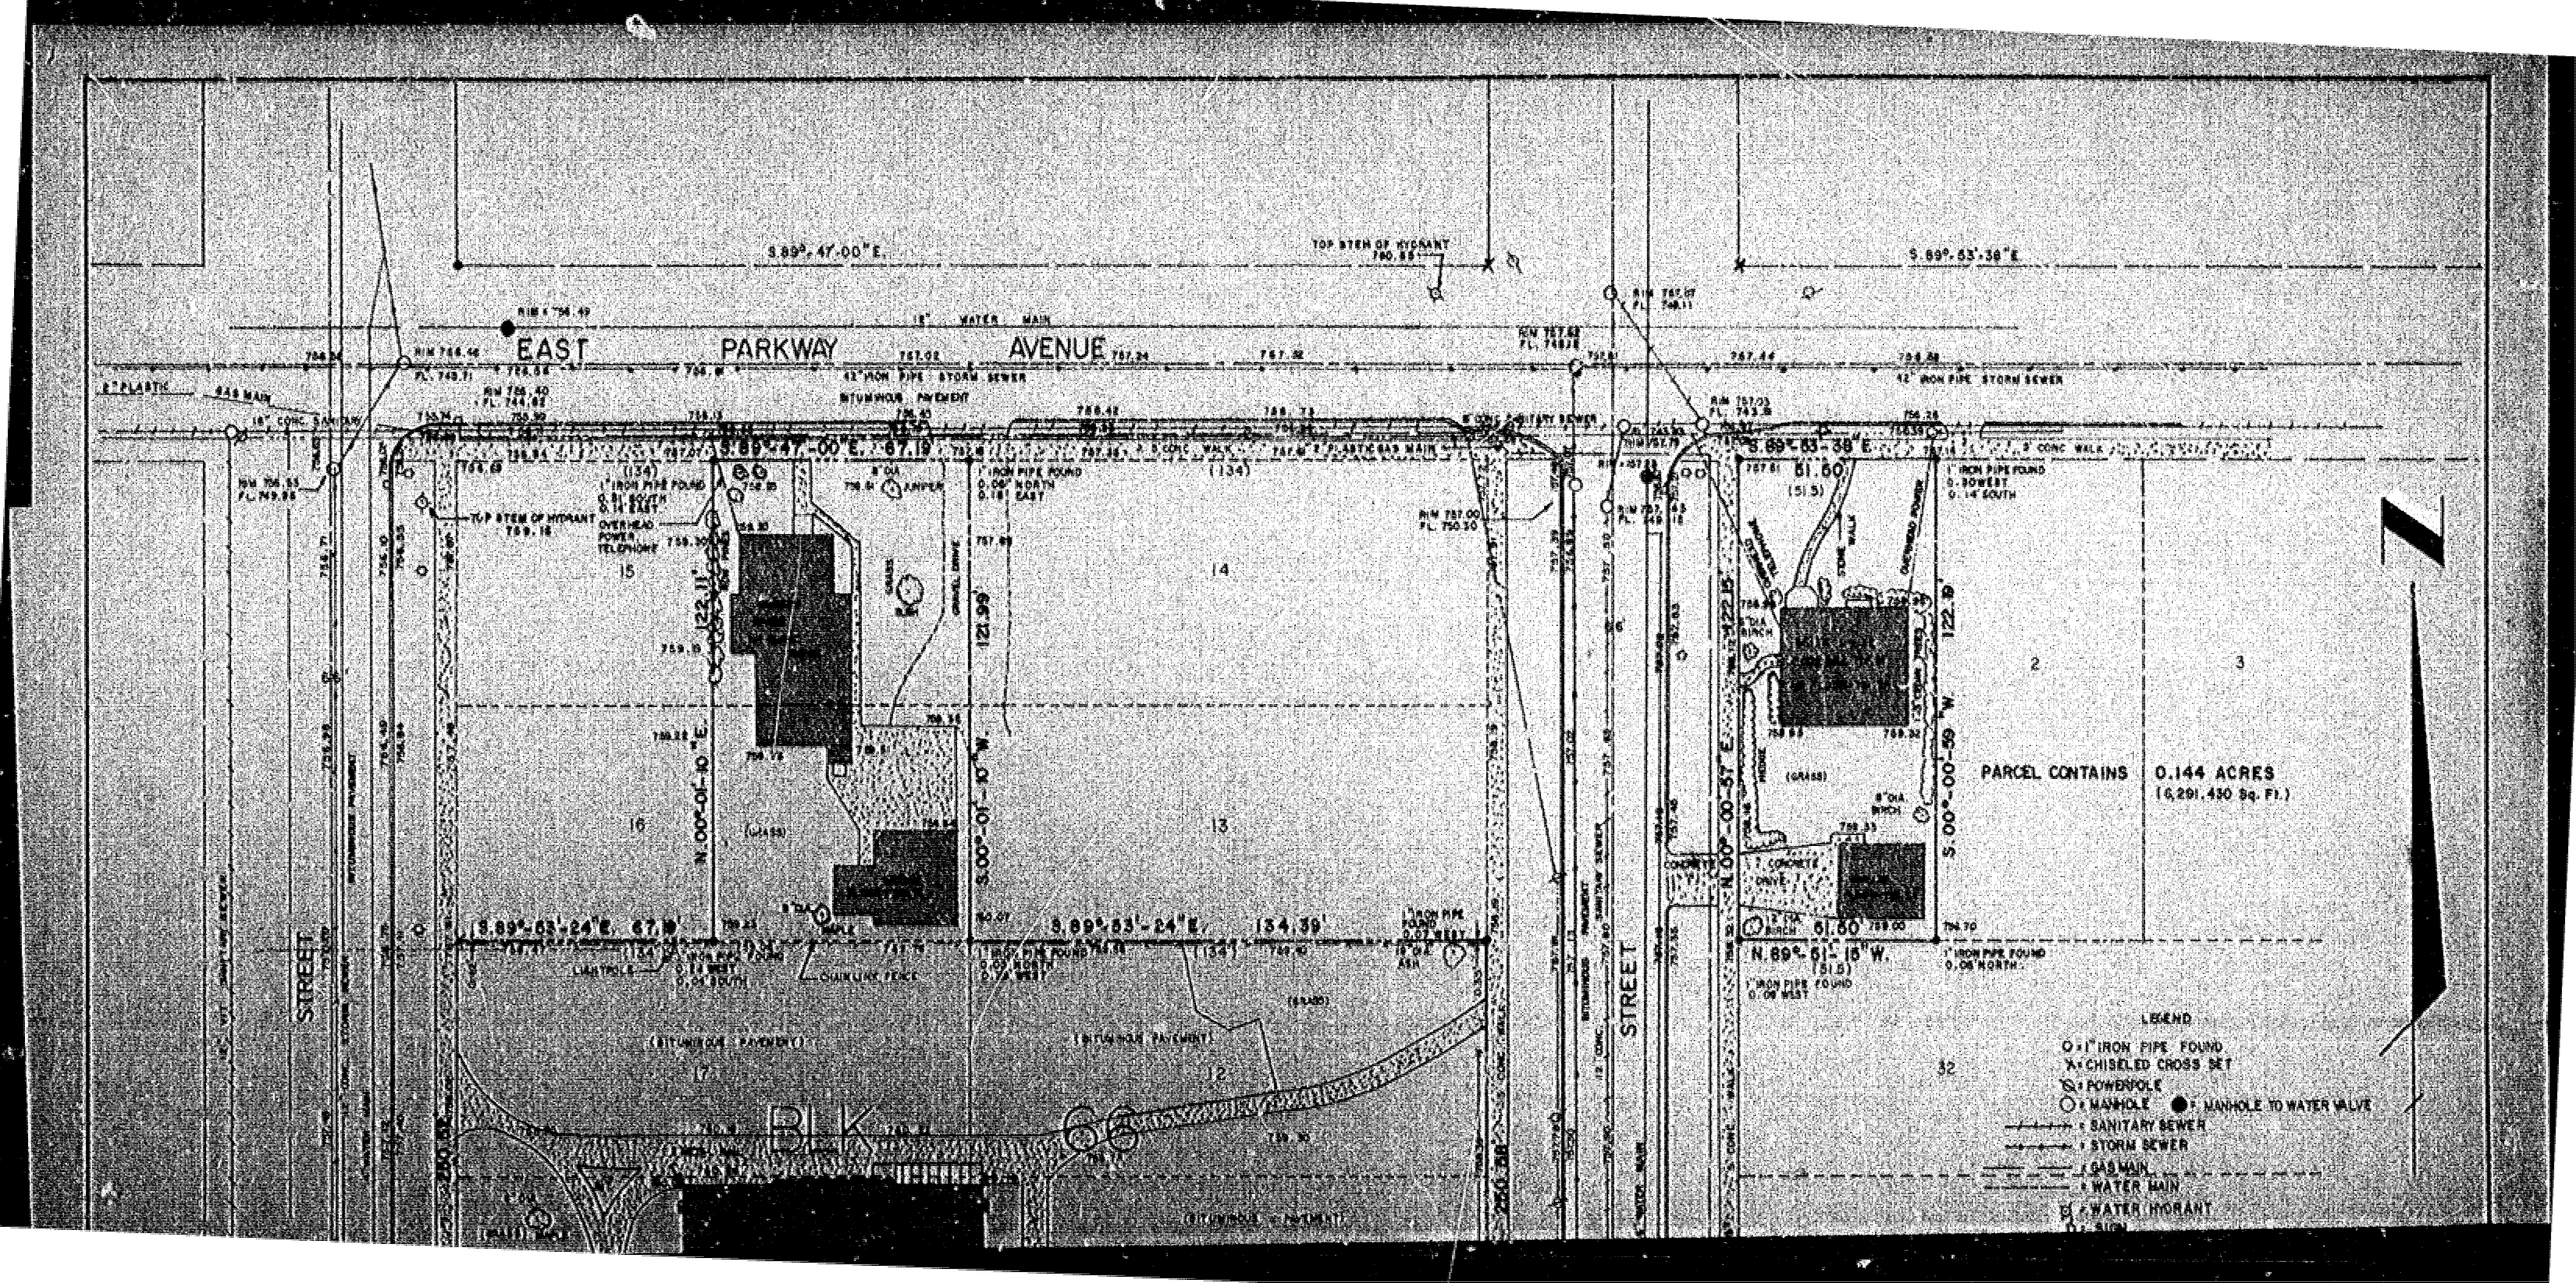

EAST PARKWAY AVENUE
S.89°-47'-00"E.
S.89°-53'-38"E.
S.89°-47'-00"E. 67.19'
S.89°-53'-24"E. 67.19'
S.89°-53'-24"E. 134.39'
N.89°-51'-15"W. (51.5)
51.60
(51.5)
PARCEL CONTAINS 0.144 ACRES
(6,291.430 Sq. Ft.)
N.00°-01'-10"W. 122.11'
S.00°-01'-10"E. 122.99'
N.00°-00'-57"E. 122.15'
S.00°-00'-57"W. 122.18'
STREET
BLK 66
LEGEND
O = 1" IRON PIPE FOUND
X = CHISELED CROSS SET
= POWERPOLE
= MANHOLE
= MANHOLE TO WATER VALVE
= SANITARY SEWER
= STORM SEWER
= GAS MAIN
= WATER MAIN
= WATER HYDRANT

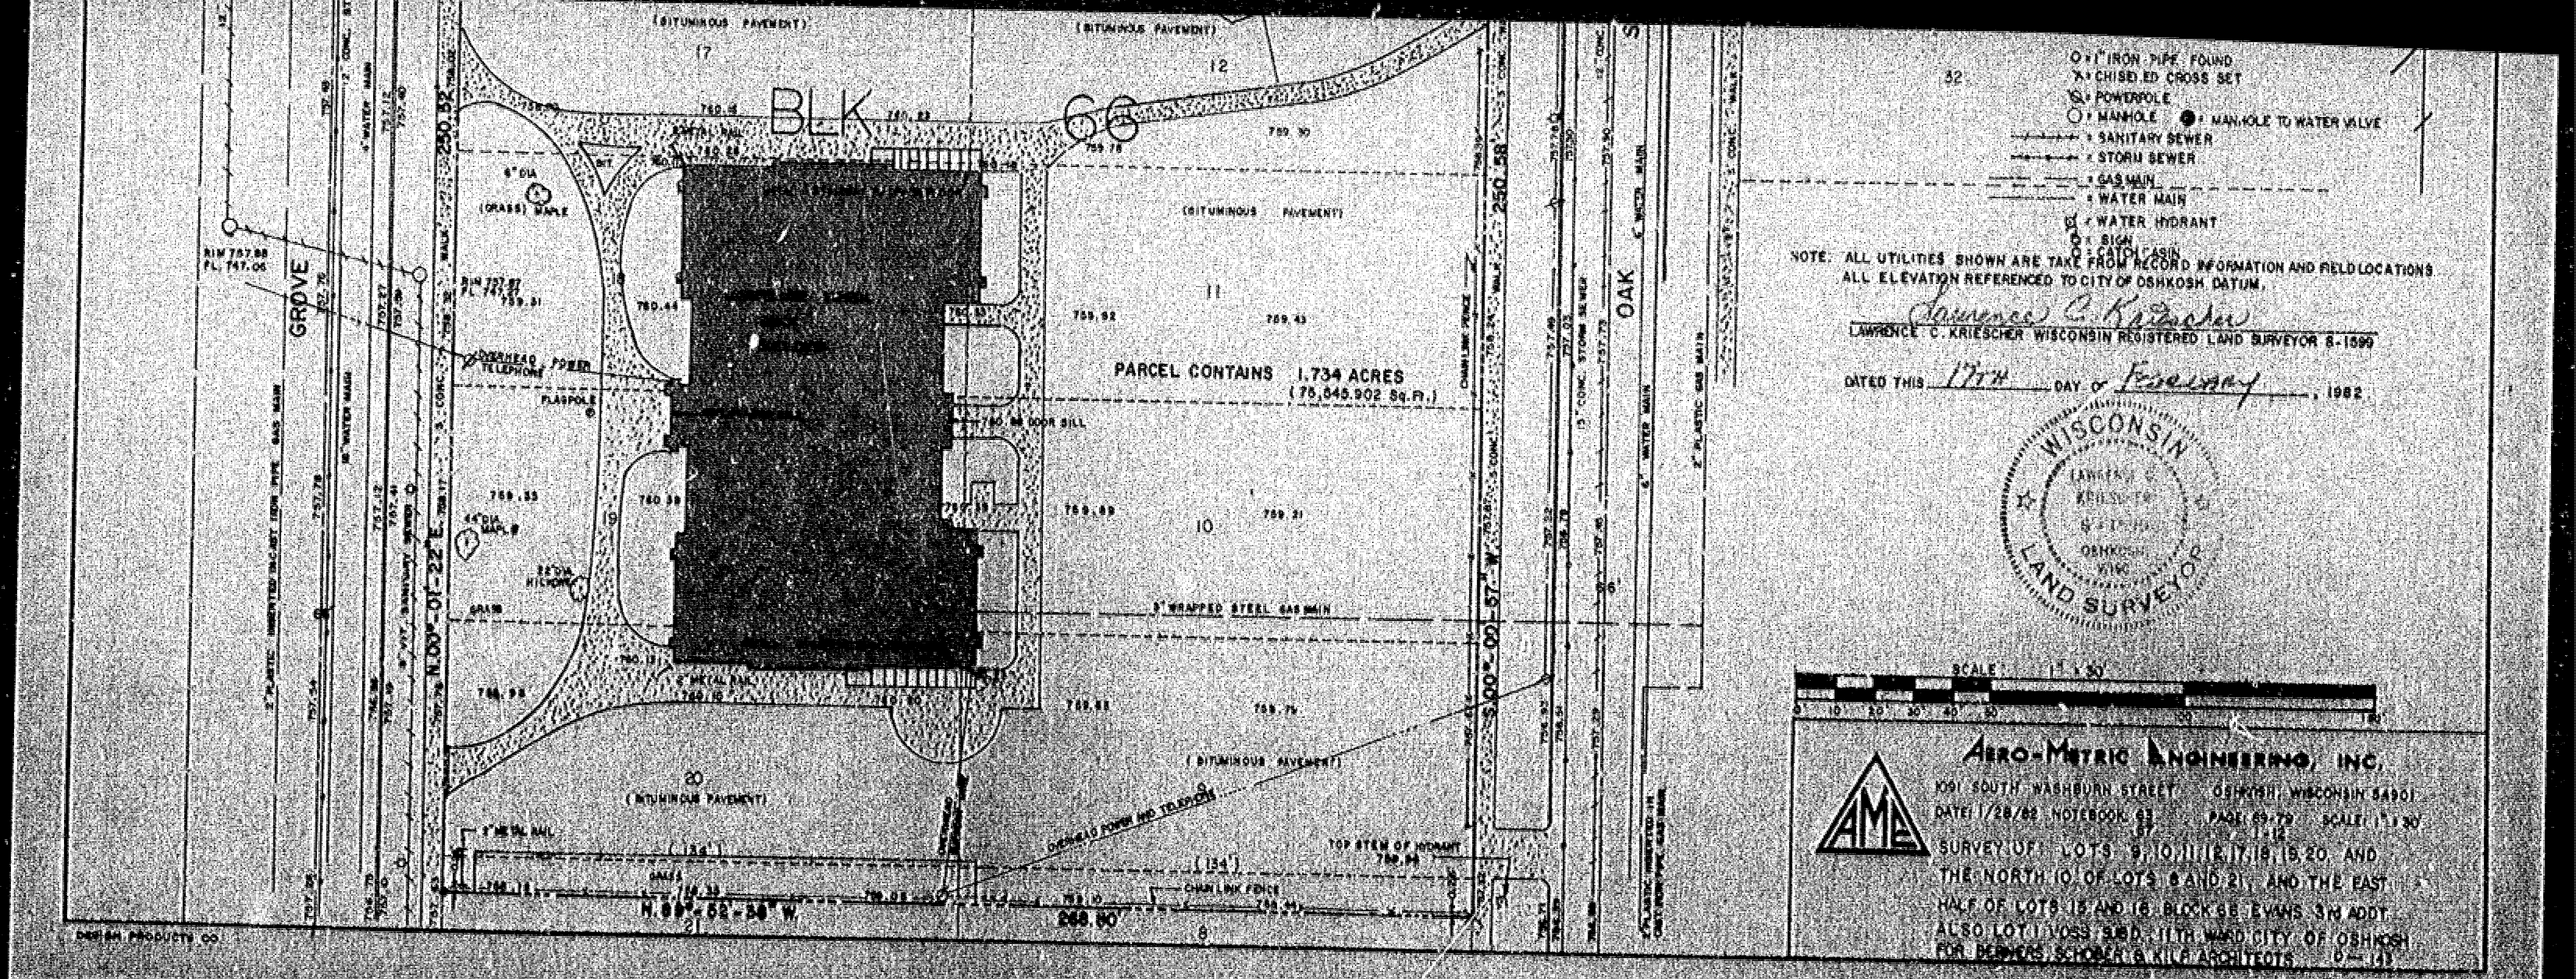
BLK 66
GROVE
OAK
PARCEL CONTAINS 1.734 ACRES
(75,545.902 Sq.Ft.)
N.00°-01'-22"E. 290.52'
S.00°-00'-57"W. 290.58'
N.89°-58'-38"W.
268.80'
(BITUMINOUS PAVEMENT)
(GRASS) MARK
OVERHEAD TELEPHONE
FLAGPOLE
RIM 757.88
FL. 747.06
RIM 757.87
FL. 747.21
8" DIA
44" DIA MAPLE
22" DIA HICKORY
6" METAL RAIL
CHAIN LINK FENCE
8" WRAPPED STEEL GAS MAIN
TOP STEM OF HYDRANT 760.44
760.44 DOOR SILL
(134')
DENOTES POWER AND TELEPHONE
8" PLASTIC INSERTED RACKET IRON PIPE GAS MAIN
8" WATER MAIN
3" CONC. STORM SEWER
15" CONC. STORM SEWER
6" WATER MAIN
2" PLASTIC GAS MAIN
CHAIN LINK FENCE
12
11
10
9
8
7
19
20
21
759.92
759.43
759.89
759.21
759.88
759.79
759.30
759.78
760.18
760.38
760.44
760.10
759.98
759.55
757.54
757.78
757.12
757.41
757.49
757.05
756.32
756.78
757.45
757.20
757.39
757.90
757.76
757.80
756.34
756.38
756.24
756.28
756.30
756.35
756.18
756.14
756.33
756.29
756.38
756.34

PLAT OF SURVEY

KNOWN AS 625 OTTER STREET, LOT "20" OF BLOCK "F" IN THE SECOND ADDITION TO OSHKOSH, IN THE EIGHTH WARD, WINNEBAGO COUNTY, WISCONSIN.

APRIL 9, 1982 SURVEY FOR CARL JESCHKE SURVEY NO. 204-S

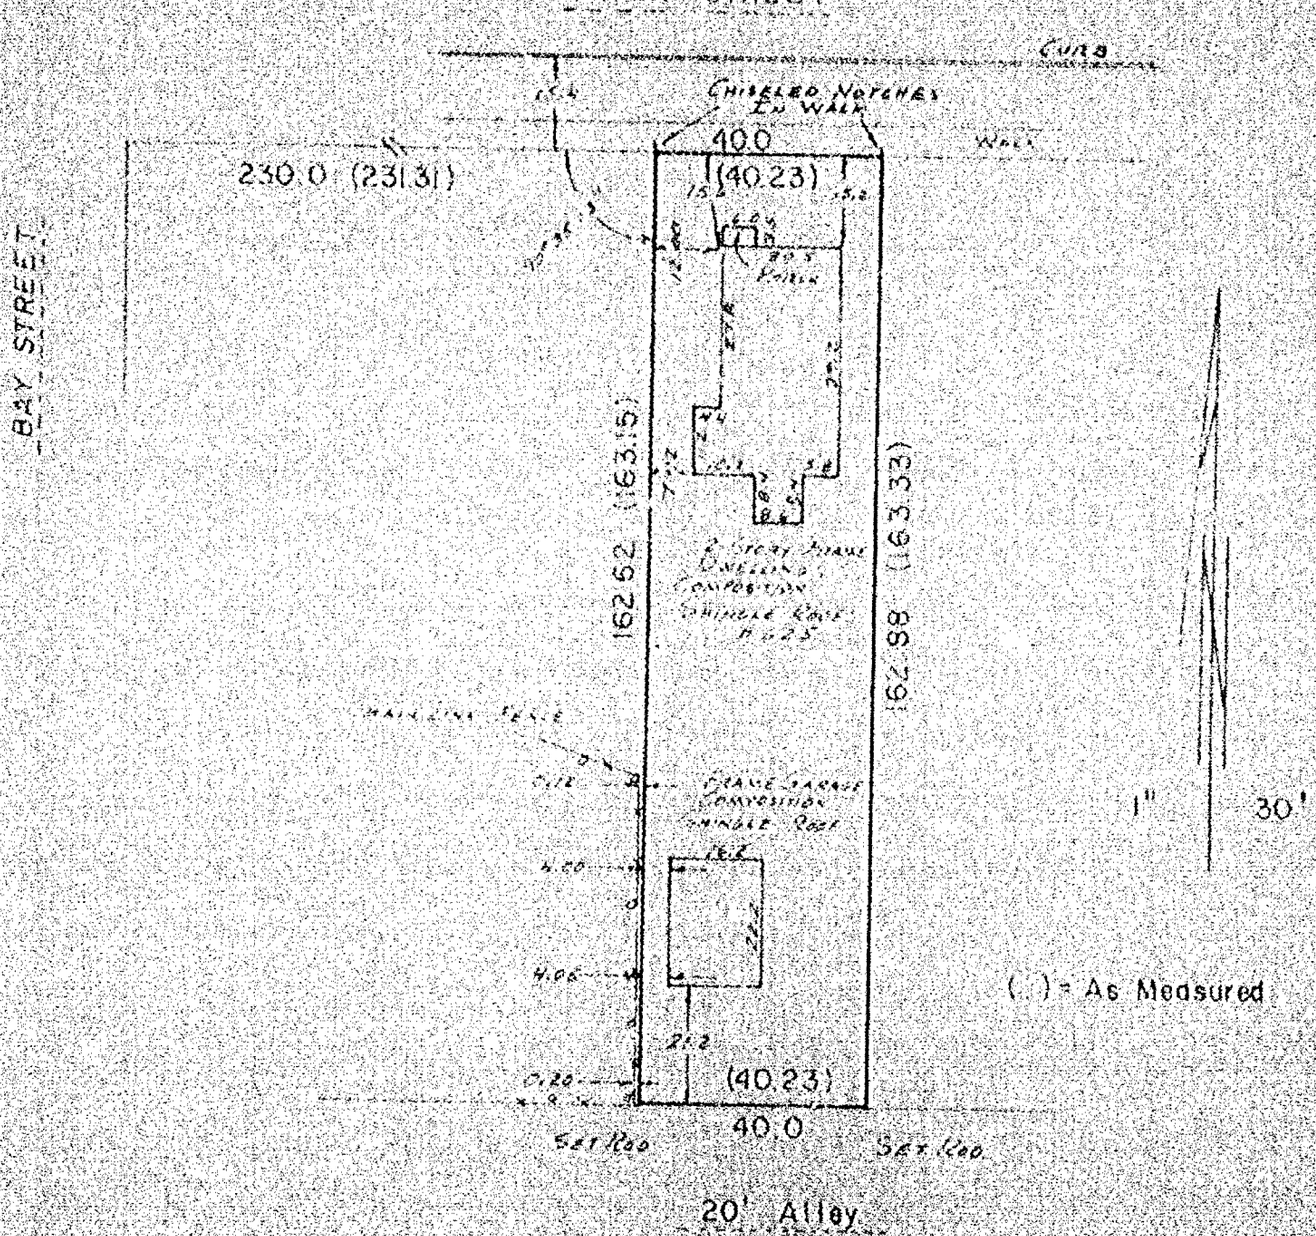

I Certify that I have surveyed the above described property (Property), and the above map is a true representation thereof and shows the size and location of the Property, its exterior boundaries, the location and dimensions of all visible structures thereon, boundary fences, apparent easements and roadways and visible encroachments, if any.

This survey is made for the exclusive use of the present owners of the Property, and also those who purchase, mortgage, or guarantee the title thereto, within one (1) year from date hereof.

national survey & engineering
517 NORTH SAWYER STREET / P.O. BOX 2563
OSHKOSH, WISCONSIN 54903
(414) 426-2600


Richard Roehlig

WISCONSIN
REINHARD H.W. ROEHLIG
S-1108
OSHKOSH WIS
LAND SURVEYOR

PLAT OF SURVEY

KNOWN AS 710 BAY SHORE DRIVE, THE EASTERLY 55.0 FT. OF LOT 7, BLOCK "N" OF WENDORF'S REPLAT, CITY OF OSHKOSH, WINNEBAGO COUNTY, WISCONSIN.

MARCH 29, 1982 SURVEY FOR MARK COOK SURVEY NO. 201-S

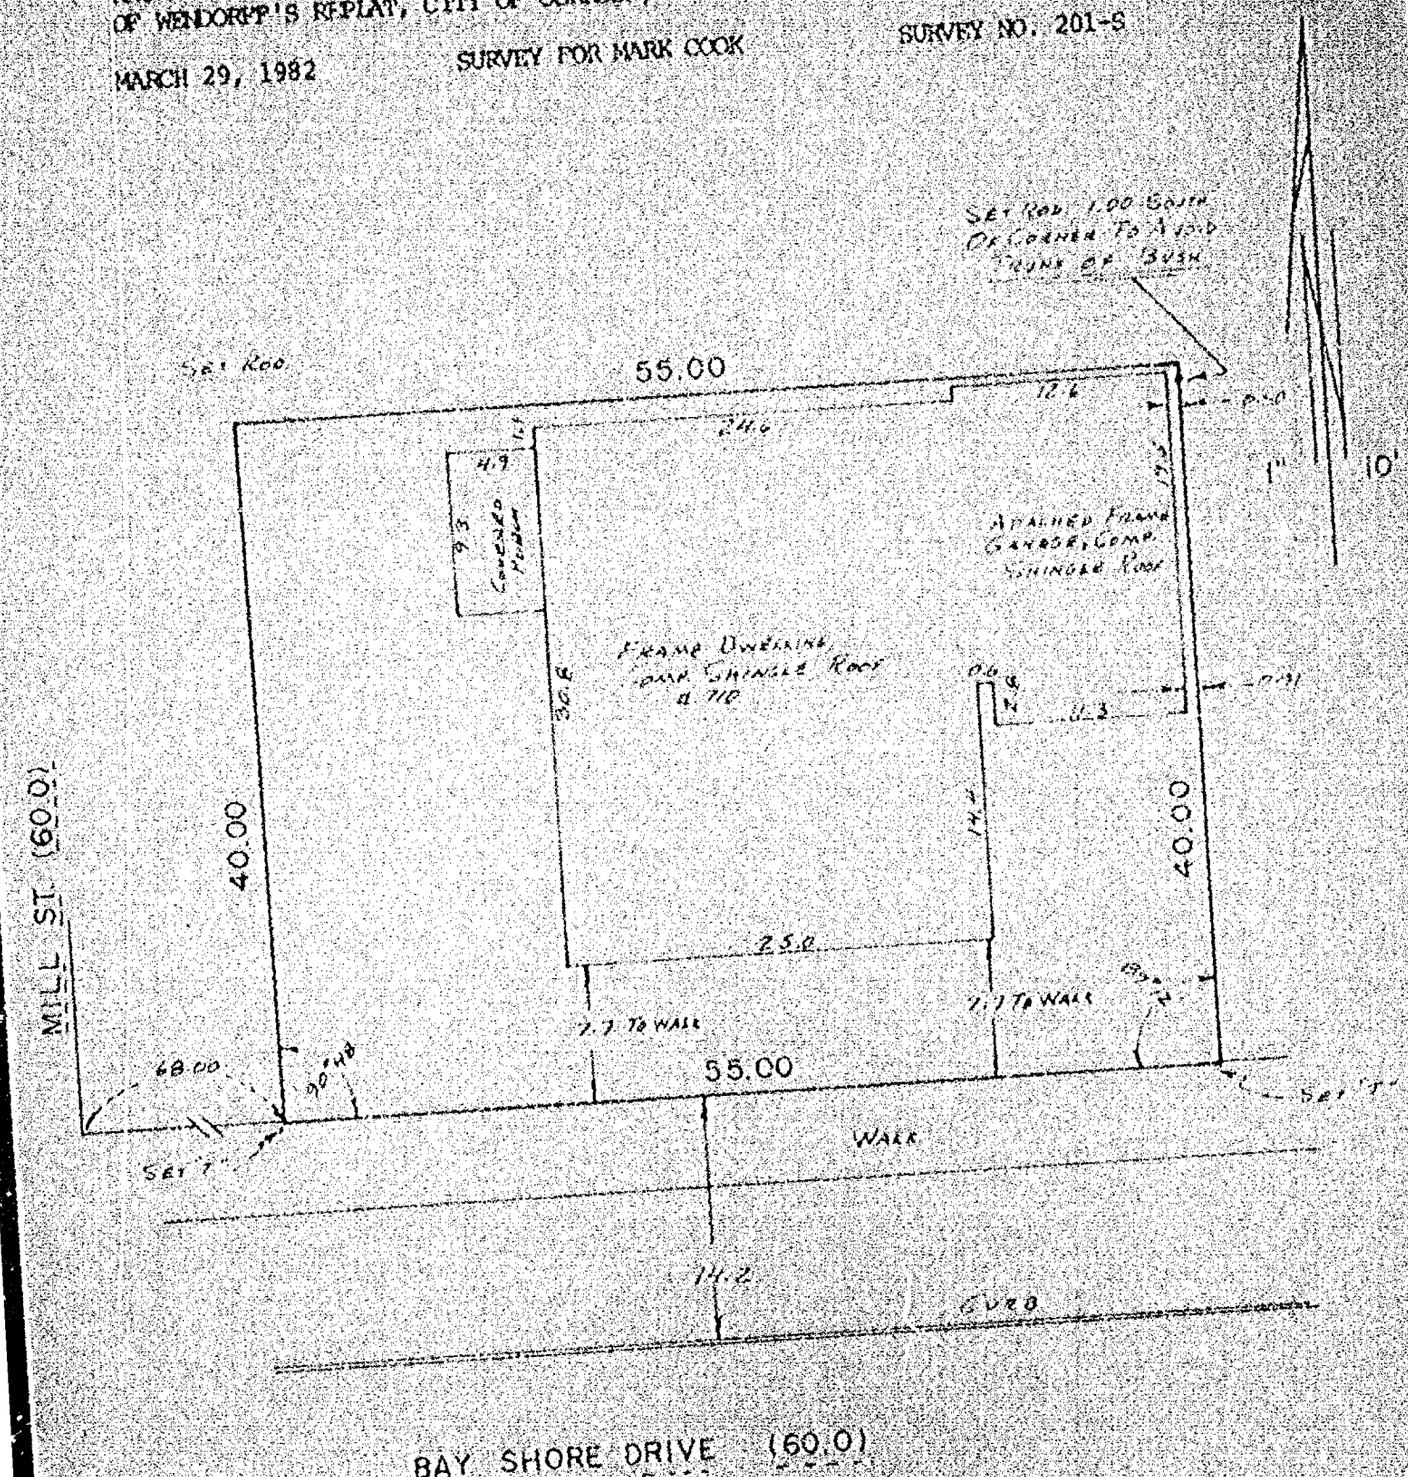

BAY SHORE DRIVE (60.0)

I Certify that I have surveyed the above described property (Property), and the above map is a true representation thereof and shows the size and location of the Property, its exterior boundaries, the location and dimensions of all visible structures thereon, boundary fences, apparent easements and roadways and visible encroachments, if any.

This survey is made for the exclusive use of the present owners of the Property, and also those who purchase, mortgage, or guarantee the title thereto, within one (1) year from date hereof.

Richard Roehlig

WISCONSIN
REINHARD H.W. ROEHLIG
S-1366
OSHKOSH WIS
LAND SURVEYOR

national survey & engineering
817 NORTH SAWYER STREET / P.O. BOX 2463
OSHKOSH, WISCONSIN 54903
(414) 426-2800


PLAT OF SURVEY

KNOWN AS 2355 PARKSIDE DRIVE, LOT 21 IN YOUNG-MILLER PLAT, IN THE 12th WARD, CITY OF OSHKOSH, WINNEBAGO COUNTY, WISCONSIN, EXCEPTING THEREFROM THE NORTH 5.0 FEET.

SURVEY NO. 1984

MARCH 3, 1982

MORTGAGE INSPECTION FOR
FIRST SAVINGS ASSOCIATION

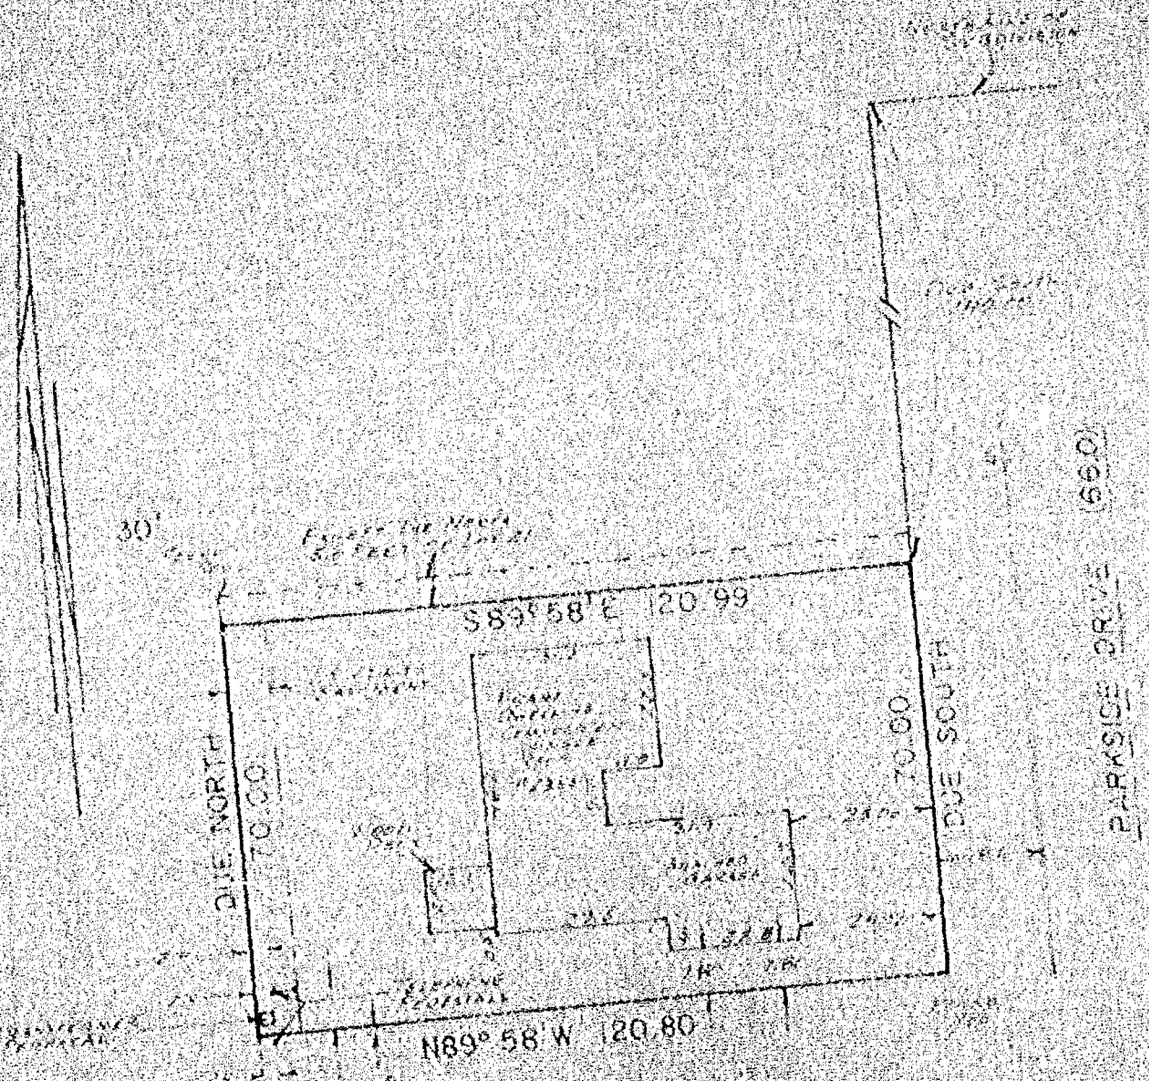

I Certify that I have surveyed the above described property (Property), and the above map is a true repre-
sentation thereof and shows the size and location of the Property, its exterior boundaries, the location and dimensions
of all visible structures thereon, boundary fences, apparent easements and roadways and visible encroachments, if any.
This survey is made for the exclusive use of the present owners of the Property
and also those who purchase, mortgage, or guarantee the title thereto, within one (1)
year from date hereof.

Richard Roehl

national survey & engineering


REINHARD W. ROEHL
S-1007
OSHKOSH
WISCONSIN
SURVEYOR

Plat of Survey

LOT 20 OF S.F. MILLER'S SUBDIVISION IN THE CITY OF OSHKOSH, WINNEBAGO COUNTY, WISCONSIN.

Clients: Mrs. Russel Shafer
1631 Cedar St.
Oshkosh, Wisconsin 54901

Theresa Muza
32 Lake St.
Oshkosh, Wisconsin 54901

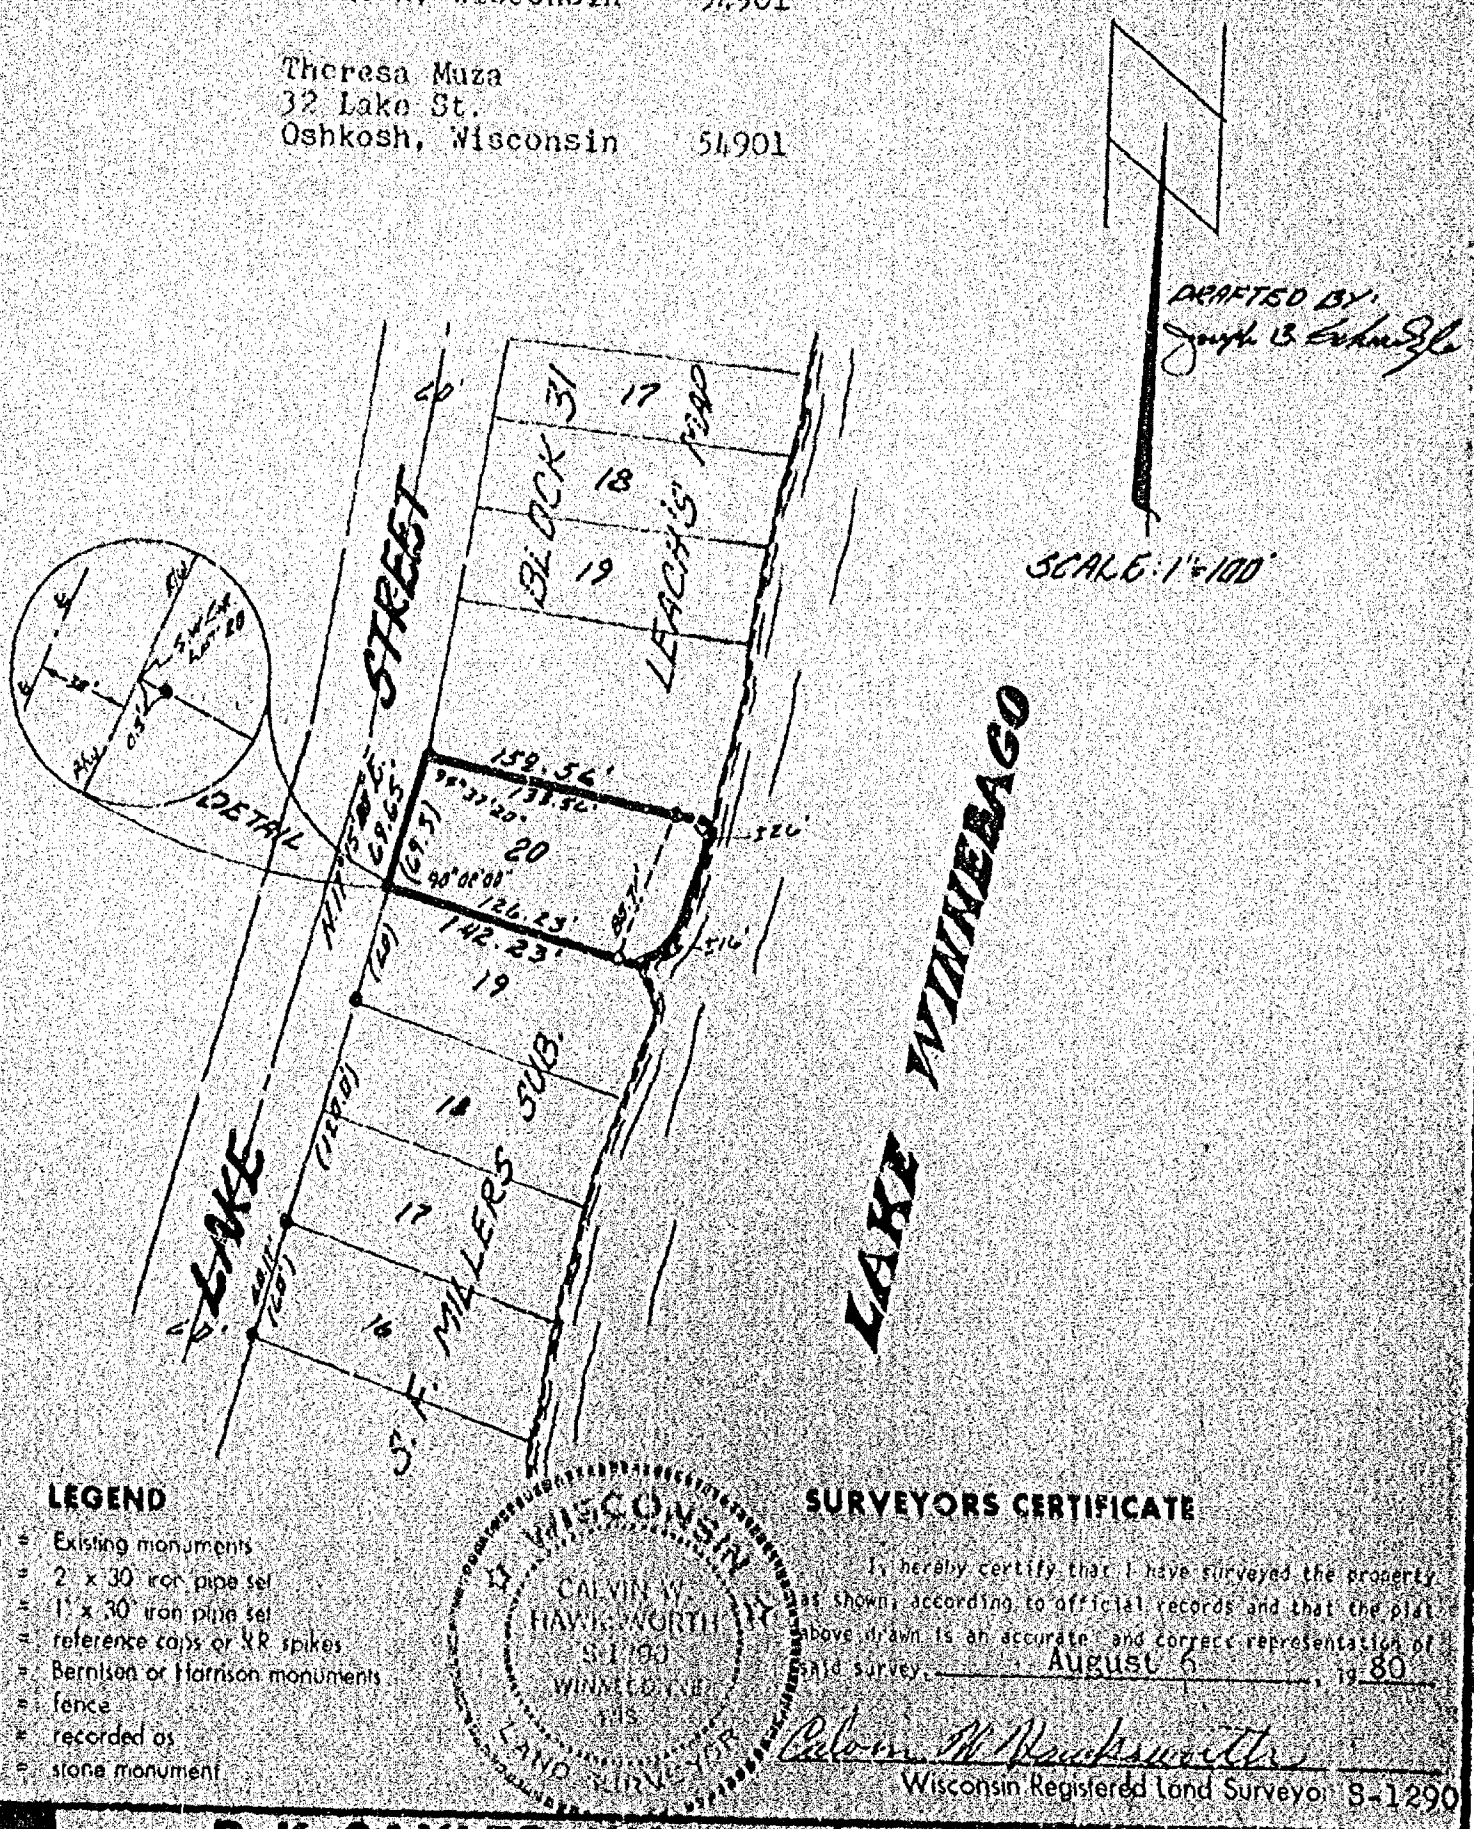

LEGEND

- ● = Existing monuments
- ○ = 2" x 30" iron pipe set
- ⊙ = 1" x 30" iron pipe set
- ⊕ = reference cross or X-R spikes
- ◆ = Bernilson or Harrison monuments
- X--X = fence
- ( ) = recorded as
- □ = stone monument

SURVEYORS CERTIFICATE

I, hereby certify that I have surveyed the property as shown, according to official records and that the plat above drawn is an accurate and correct representation of said survey. August 6, 19 80

CALVIN W. HAWKSWORTH S-1290 WISCONSIN LAND SURVEYOR

Calvin W. Hawksworth
Wisconsin Registered Land Surveyor S-1290


R. K. SAYLER, INC.
LAND SURVEYORS
WINNECONNE, WI 54986

SCALE 1"= 100'
PROJECT NO. S-001121
FIELD BOOK AR PAGE 142

Winnebago

Plat of Survey

Lot 6 of Block 17 of INTER URBAN LAND CO.'S THIRD ADDITION, City of Oshkosh, Winnebago County, Wisconsin.

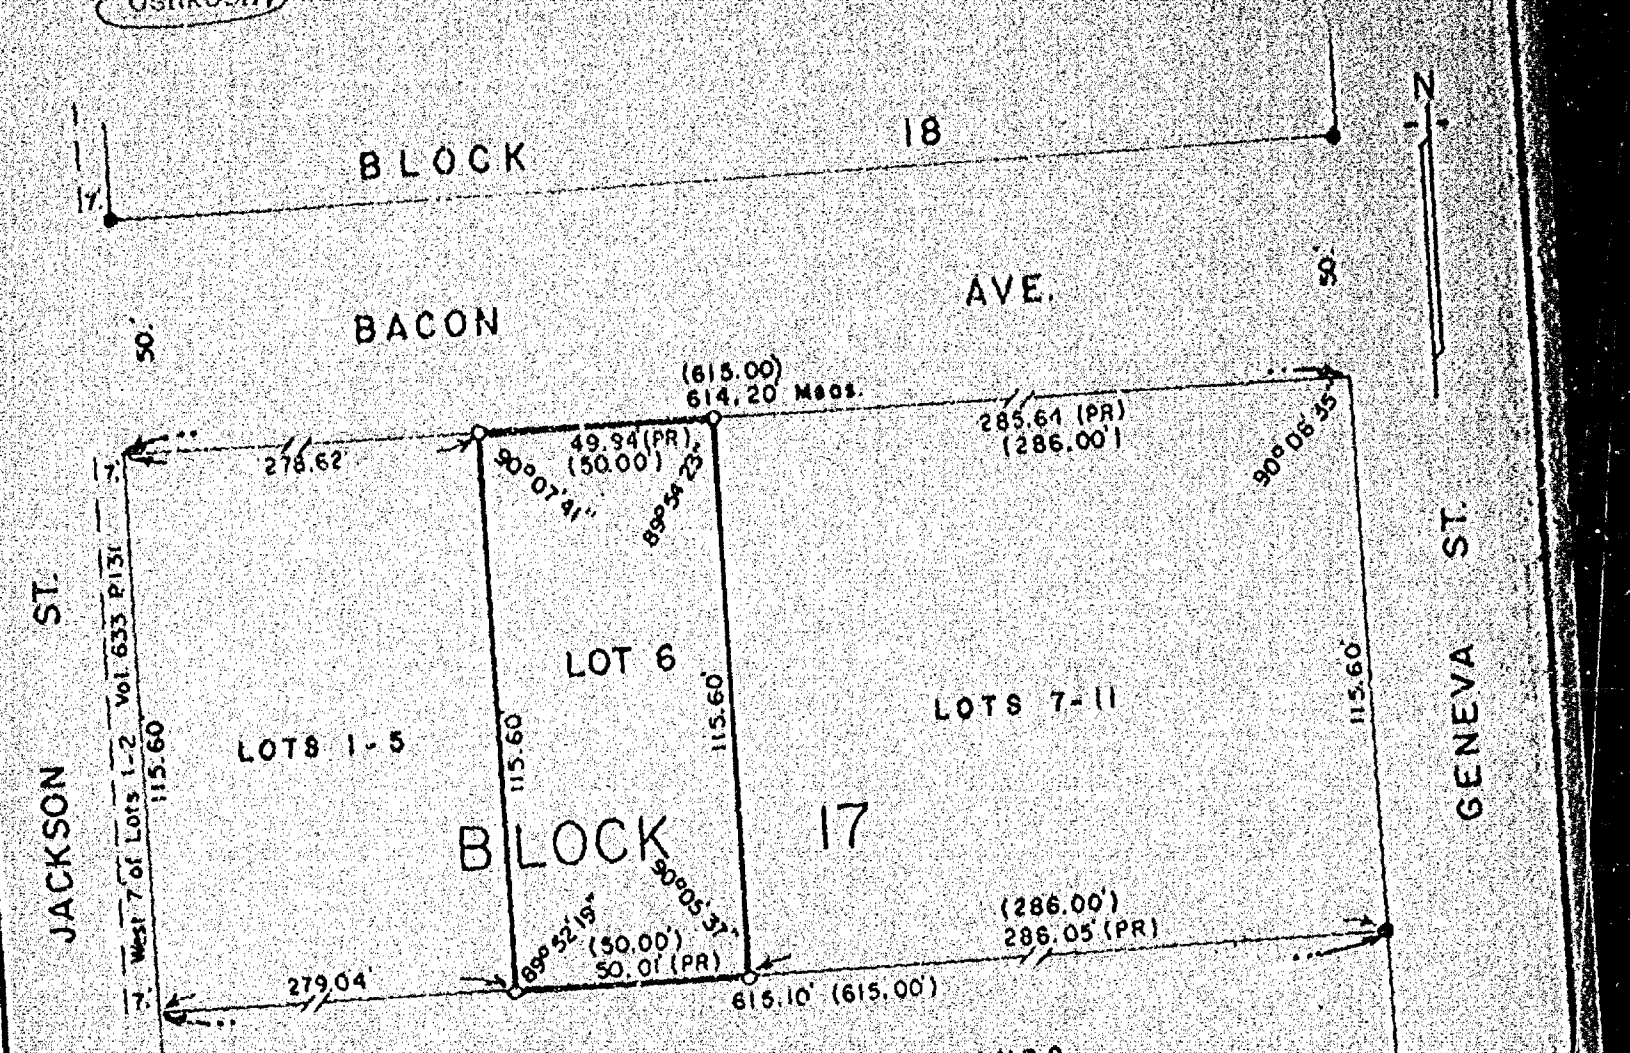

CLIENT: Joseph W. Salm, Jr.
229 Bacon Ave.
Oshkosh, Wisconsin
54901

LEGEND

- ● = Existing monuments
- ○ = 2 x 30" iron pipe set
- ○ = 1 x 30" iron pipe set
- ⊙ = reference caps or RR spikes
- ◐ = Bernisen or Harrison monuments
- X—X = fence
- ( ) = recorded as
- □ = stone monument

WISCONSIN
CALVIN VI. HAWKSWORTH
S-1290
WINNECONNE WIS.
LAND SURVEYOR

SURVEYORS CERTIFICATE

I, hereby certify that I have surveyed the property as shown, according to official records and that the plat above drawn is an accurate and correct representation of said survey. May 20, 19 80

Calvin VI. Hawksworth
Wisconsin Registered Land Surveyor S-1290

R. K. SAYLER, INC.
LAND SURVEYORS
WINNECONNE, WI 54986


SCALE 1 in. = 40 ft.
PROJECT NO. S-001096
FIELD BOOK 40 PAGE 15

Winnebago

Plat of Survey

NE¼ OF LOT 2, BLOCK 82 OF P.V. WRIGHT'S SUBDIVISION, CITY OF OSHKOSH, WINNEBAGO COUNTY, WISCONSIN.

Client: Terry R. & Rochelle M. O'Brien
203 W. Melvin Ave.
Oshkosh, Wisconsin 54901

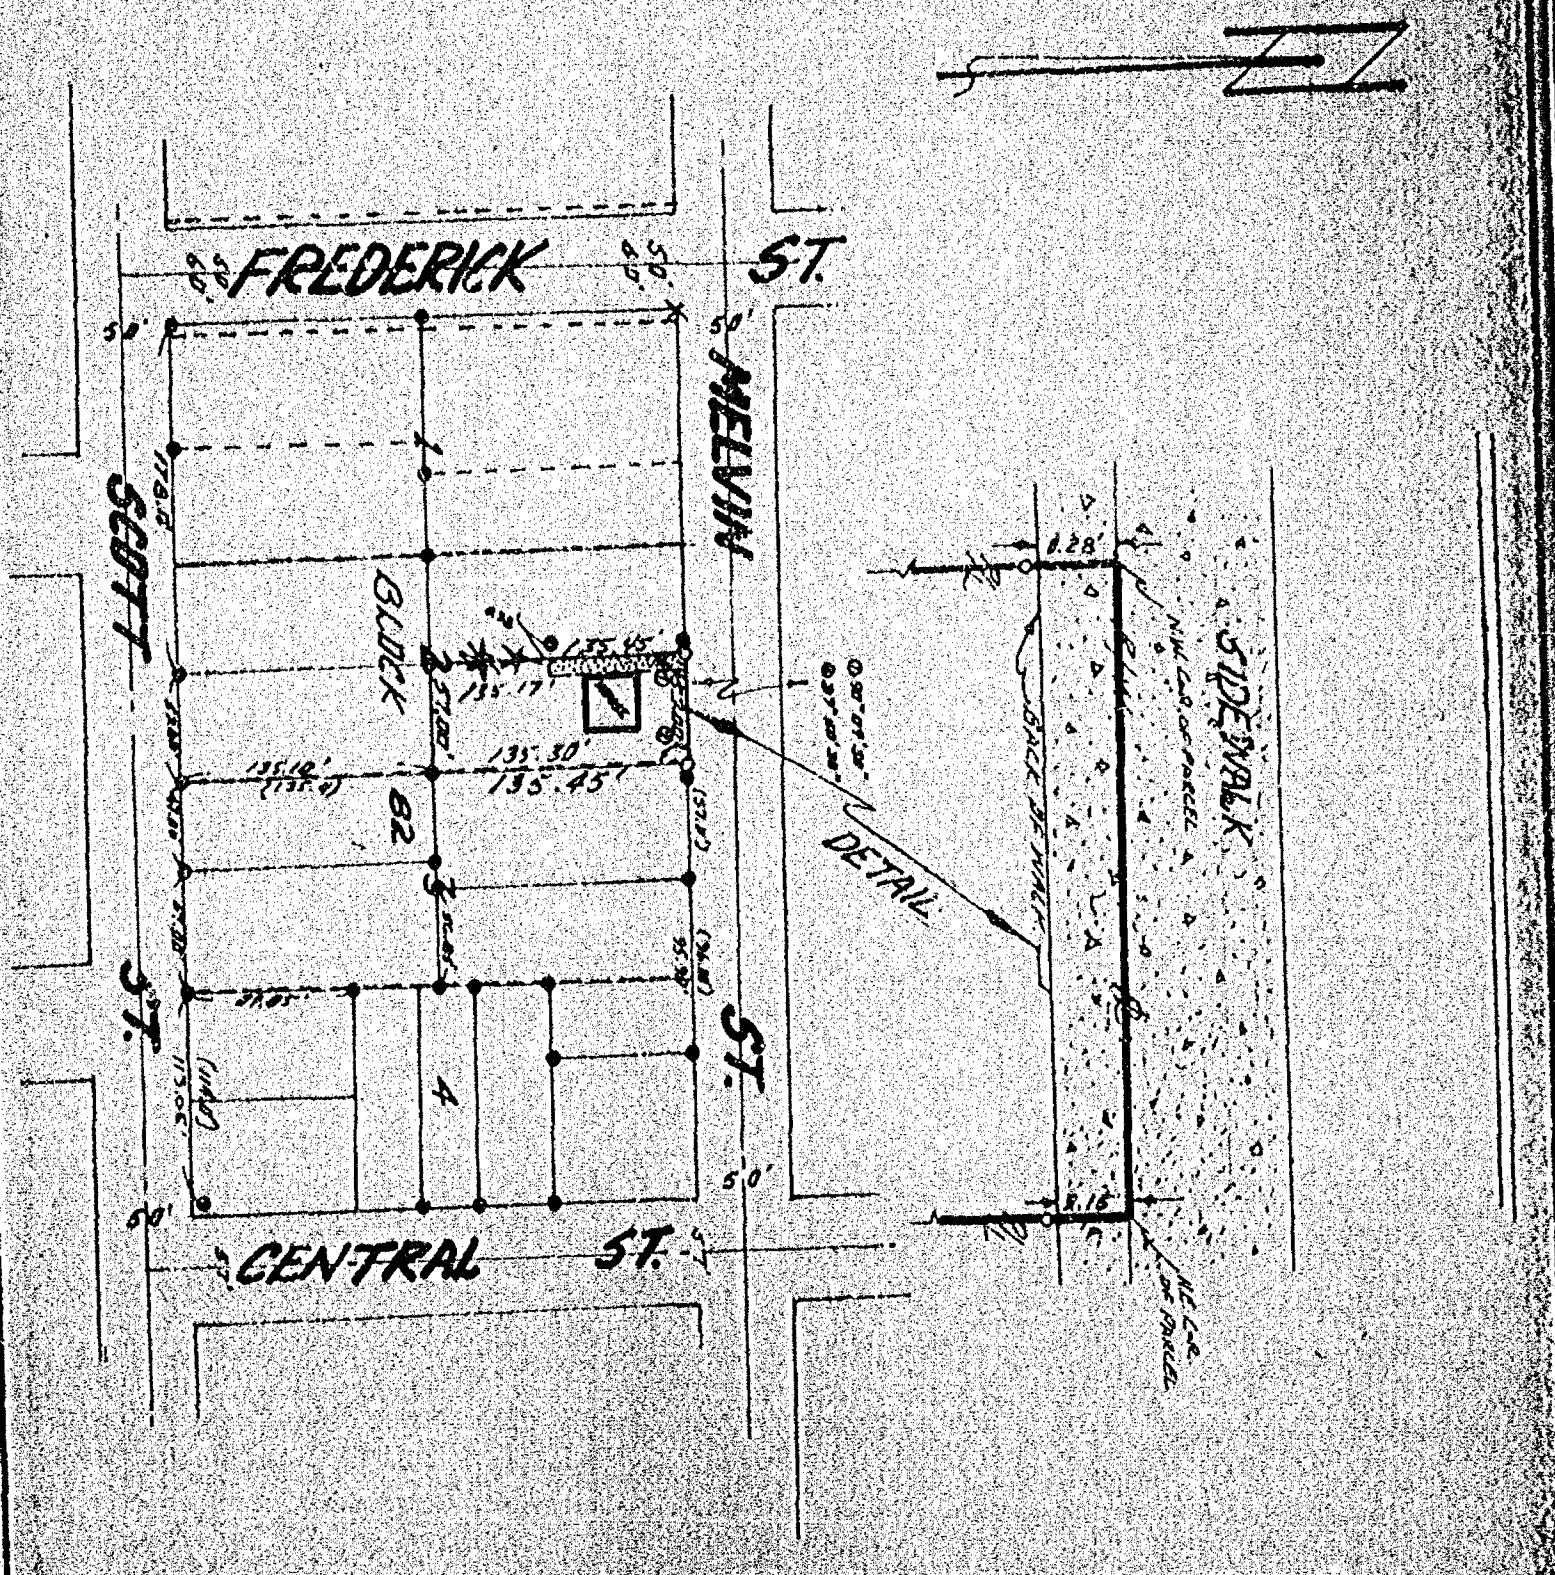

LEGEND

- ● = Existing monuments
- ○ = 2" x 30" iron pipe set
- ○ = 1" x 30" iron pipe set
- ● = reference capt or RR spikes
- ● = Bernisen or Harrison monuments
- X--X = fence
- ( ) = recorded as
- □ = stone monument

WISCONSIN
CALVIN W. HAWKSWORTH
S-1200
WINNECONNE, WI
LAND SURVEYOR

SURVEYORS CERTIFICATE

I, hereby certify that I have surveyed the property as shown, according to official records and that the plat above drawn is an accurate and correct representation of said survey: June 20, 1980

Calvin W. Hawksworth
Wisconsin Registered Land Surveyor


R. K. SAYLER, INC.
LAND SURVEYORS
WINNECONNE, WI 54986

SCALE 1" = 100'
PROJECT NO 1-00104
FIELD BOOK # PAGE 189

Plat of Survey

PART OF LOTS 4 & 5 OF E.R. HICK'S SUBD'N. OF LOTS 1, 2 & 3 OF BLOCK 107, 12TH WARD, CITY OF OSHKOSH.

SURVEY FOR: JAMES MANSKE
300 DIVISION ST.
OSHKOSH, WISCONSIN

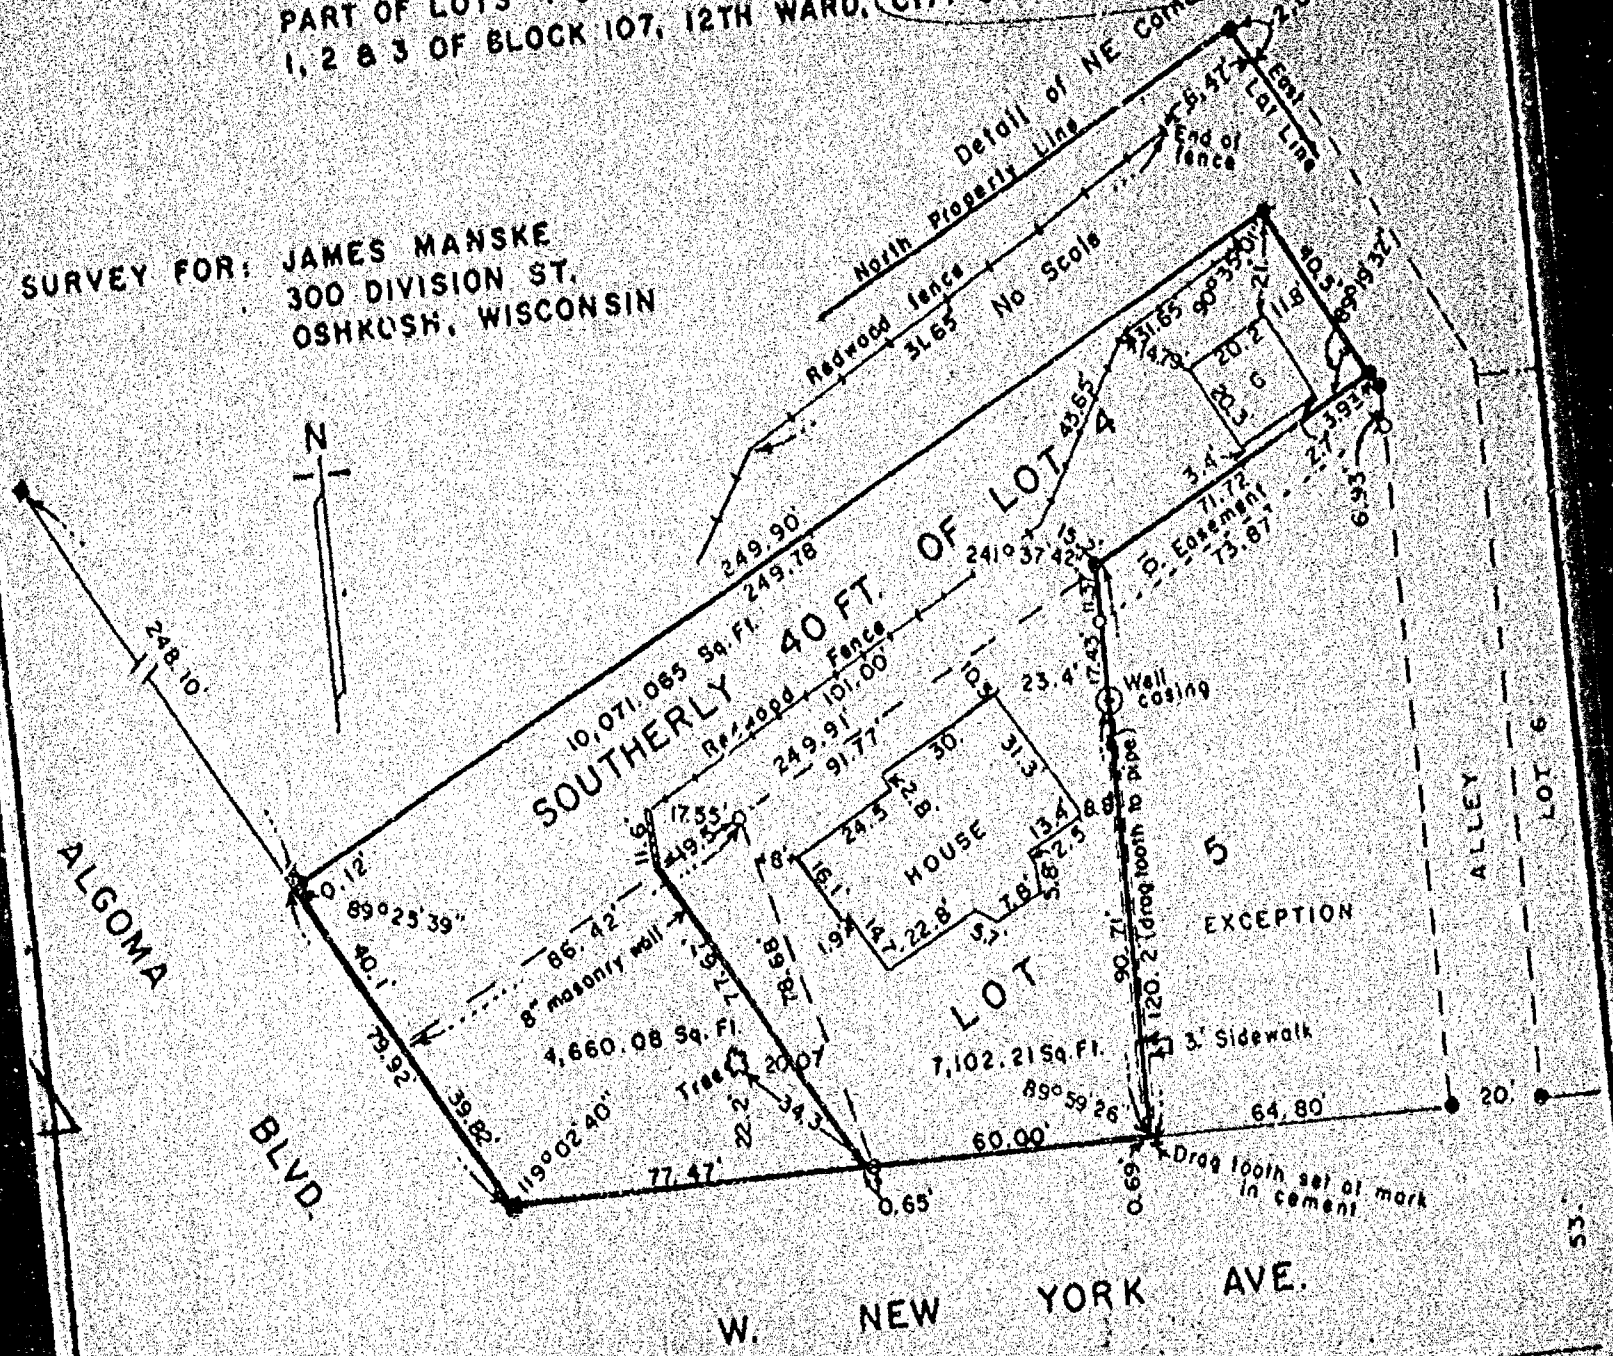

AREA INSIDE WALLS & FENCE TO EAST LINE 11,616.14 Sq. Ft.
(Extending fence line to East lot line)

LEGEND

- ● = Existing monuments
- ○ = 2 x 30" iron pipe set
- ○ = 1" x 30" iron pipe set
- ⊕ = reference cops or RR spikes
- ⊕ = Bernisen or Harrison monuments
- x—x = fence
- ( ) = recorded as
- ■ = stone monument

WISCONSIN
CALVIN W. HAWKINSON
S-1290
WINNECONNE WIS.

SURVEYORS CERTIFICATE

I, hereby certify that I have surveyed the property as shown, according to official records and that the plat above drawn is an accurate and correct representation of said survey. MAY 11 19 79
ADDITION AUG 17, 1979 SEPT. 14, 1979

Calvin W. Hawkinson
Wisconsin Registered Land Surveyor
S-1290

R. K. SAYLER, INC.
LAND SURVEYORS
WINNECONNE, WI 54986

SCALE 1 in. = 40 ft.
PROJECT NO. S-000974
FIELD BOOK 38 PAGE 95-115


Winnebago

Plat of Survey

THE NORTH FIFTY (50.00) FEET OF LOTS NINETEEN AND TWENTY (19&20), BLOCK THIRTY-SEVEN (37) IN THE ORIGINAL PLAT OF THE THIRD WARD IN THE CITY OF OSHKOSH, WINNEBAGO COUNTY, WISCONSIN.

CLIENTS: Robert Berndt
975 Maricopa Drive
Oshkosh, Wisconsin
54901

Eunice Martin
1631 Doty St.
Oshkosh, Wisconsin
54901

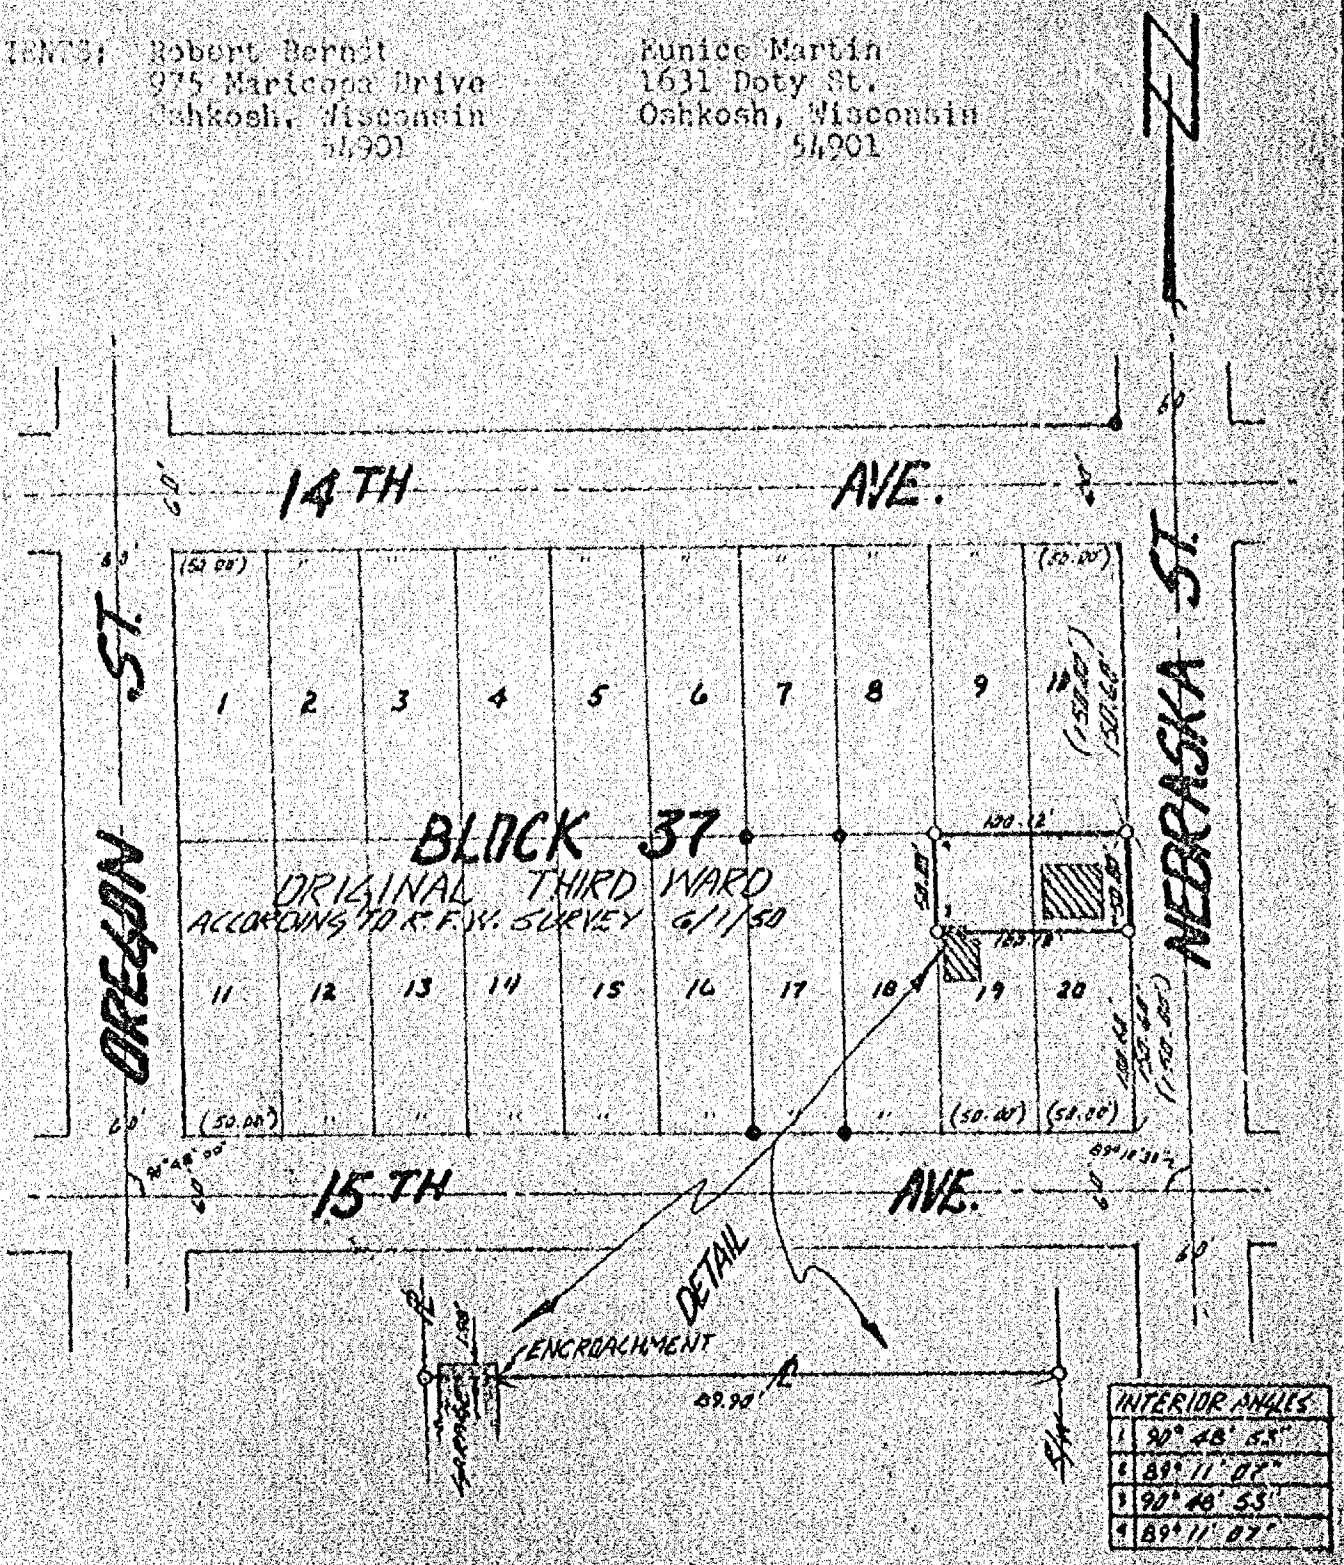

LEGEND

- ● = Existing monuments
- ◯ = 2" x 30" iron pipe set
- ○ = 1" x 30" iron pipe set
- ⊗ = reference cops or RR spikes
- ⊕ = Bernisen or Harrison monuments
- X—X = fence
- ( ) = recorded as
- □ = stone monument

WISCONSIN
CALVIN W. HAWKSWORTH
S-1290
WINNECONNE WIS.
LAND SURVEYOR

DRAFTED BY: Ralph B. Sayler Jr.

SURVEYORS CERTIFICATE

I, hereby certify that I have surveyed the property as shown, according to official records and that the plat above drawn is an accurate and correct representation of said survey June 5, 19 88

Calvin W. Hawksworth S-1290
Wisconsin Registered Land Surveyor

R. K. SAYLER, INC.
LAND SURVEYORS
WINNECONNE, WI 54986


SCALE 1"=100'
PROJECT NO. S-001098
FIELD BOOK 32 PAGE 131

Winnebago

Plat of Survey

LOT 12, BLOCK 5 OF BALDWIN, HEATH & CHITTENDEN ADDITION TO THE CITY OF OSHKOSH, WINNEBAGO COUNTY, WISCONSIN.

OWNER: ROY O. CAPPS
1115 GRAND ST.
OSHKOSH, WISCONSIN
54901

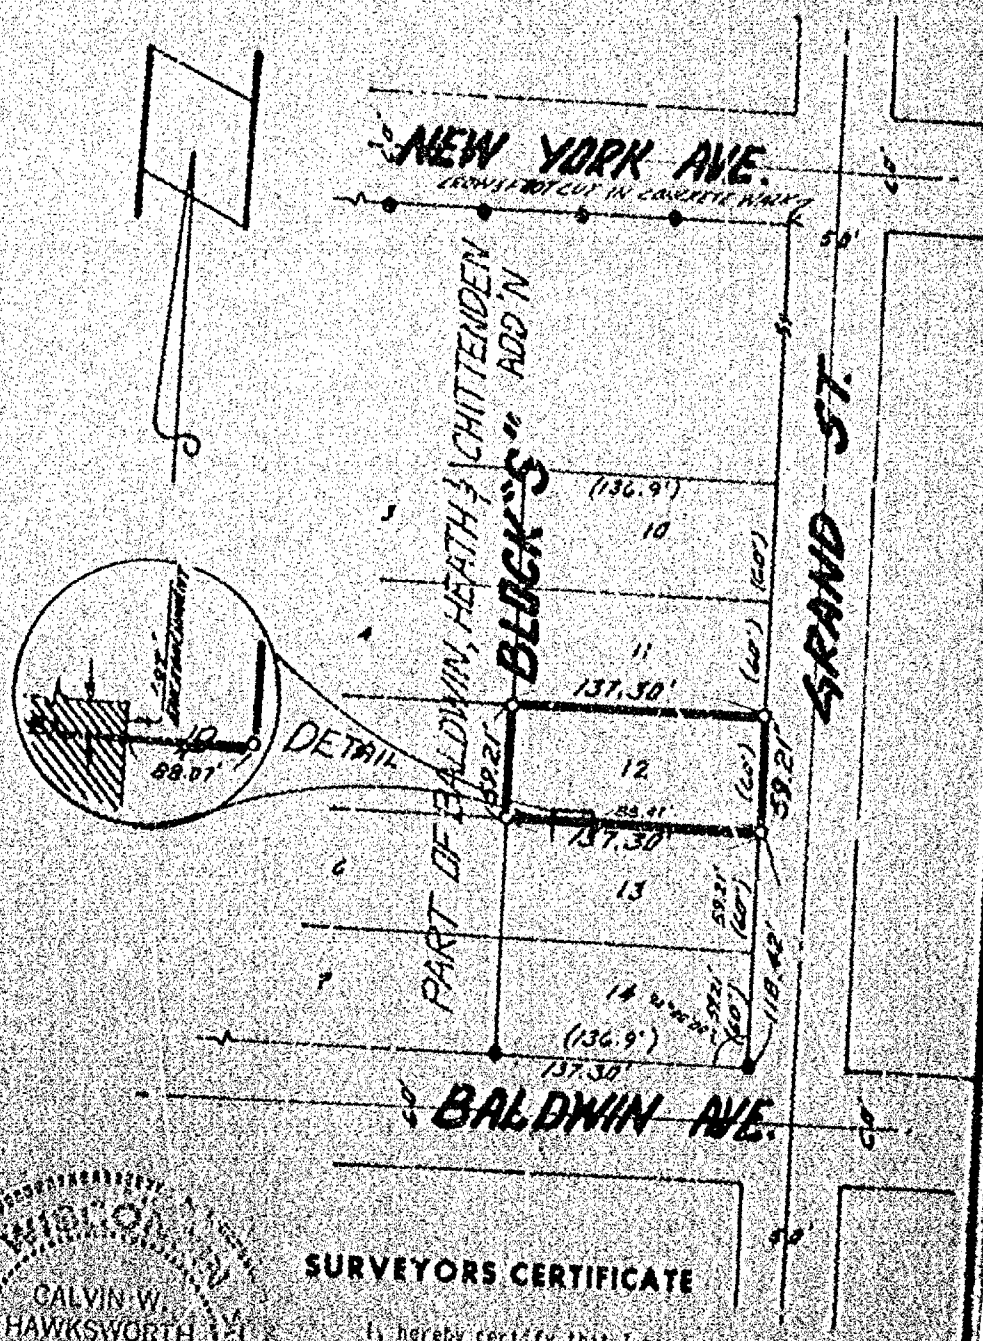

LEGEND

- ● = Existing monuments
- ○ = 2 x 30" iron pipe set
- ○ = 1" x 30" iron pipe set
- ⊕ = reference caps or RR spikes
- ◉ = Bernisen or Harrison monuments
- X—X = fence
- ( ) = recorded as
- [ ] = stone monument

WISCONSIN
CALVIN W. HAWKSWORTH
S-1290
WINNECONNE
WIS.
LAND SURVEYOR

SURVEYORS CERTIFICATE

I, hereby certify that I have surveyed the property as shown, according to official records and that the plat above drawn is an accurate and correct representation of said survey. April 9, 1980

Calvin W. Hawksworth
Wisconsin Registered Land Surveyor S-1290

R. K. SAYLER, INC.
LAND SURVEYORS
WINNECONNE, WI 54986


SCALE 1"= 100'
PROJECT NO. 3-001075
FIELD BOOK 40 PAGE 111

Winnebago

Plat of Survey

LOT 105 OF E.W. CRANES ADDITION TO ALGOMA PARK, CITY OF OSHKOSH, WINNEBAGO COUNTY, WISCONSIN.

CLIENT: JOHN E. KEMPF
2006 ROOSEVELT AVE.
OSHKOSH, WISCONSIN.
54901

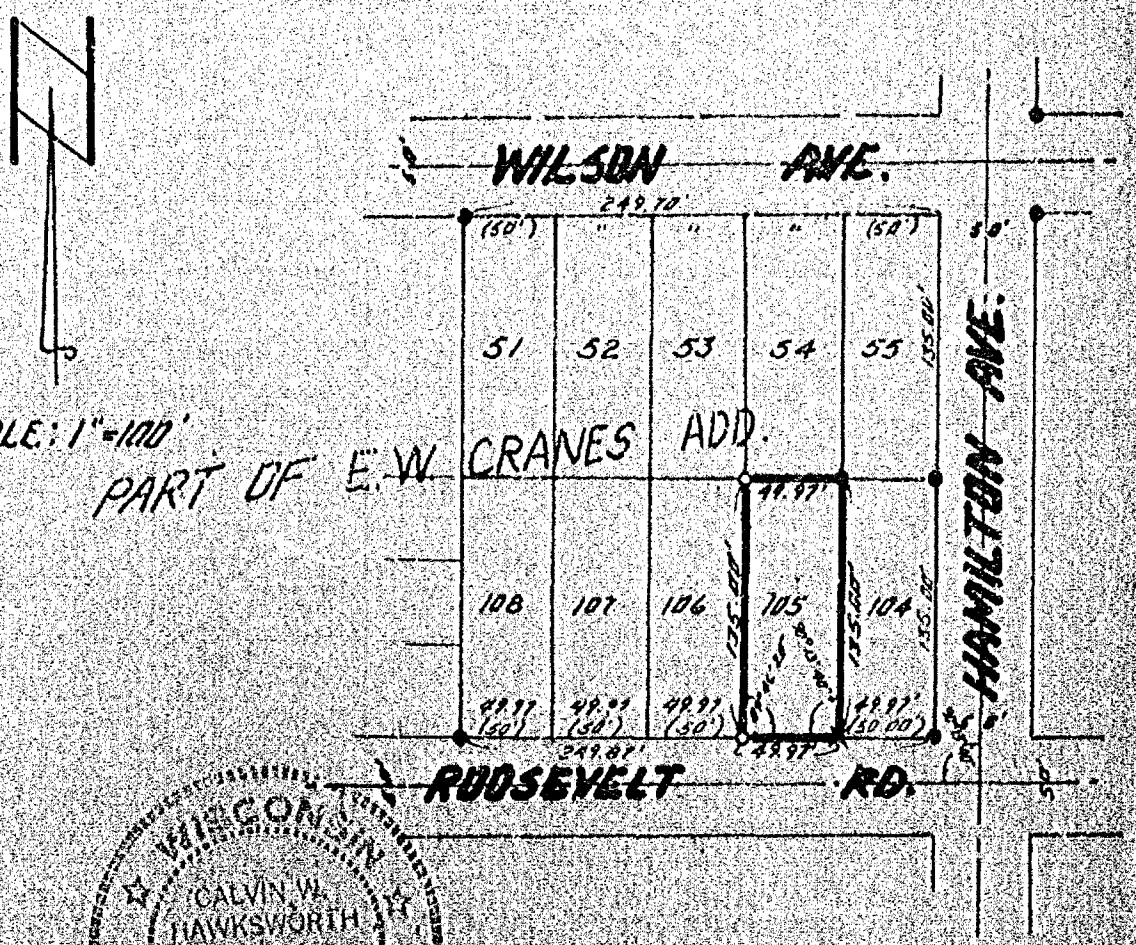

WISCONSIN
CALVIN W. HAWKSWORTH
S-1290
WINNECONNE WIS
LAND SURVEYOR

LEGEND

- ● = Existing monuments
- ◯ = 2" x 30" iron pipe set
- o = 1" x 30" iron pipe set
- ⊕ = reference caps or RR spikes
- ◔ = Bernisen or Harrison monuments
- X—X = fence
- X = Cross cut in concrete
- ( ) = recorded as
- □ = stone monument

SURVEYORS CERTIFICATE

I, hereby certify that I have surveyed the property as shown, according to official records and that the plat above drawn is an accurate and correct representation of said survey. April 8, 1980

Calvin W. Hawksworth
Wisconsin Registered Land Surveyor S-1290

R. K. SAYLER, INC.
LAND SURVEYORS
WINNECONNE, WI 54986

SCALE 1"=100'
PROJECT NO. S-0010X6
FIELD BOOK 40


PLAT OF SURVEY


KNOWN AS 530 MAIN STREET, LOTS 4, 5, 12, 13, 14, 17, 18, AND THE SOUTH 20.0 FT. OF LOT 6, ALL IN BLOCK 1 IN MERRITT'S ADDITION, IN THE FOURTH WARD, CITY OF OSHKOSH, WINNEBAGO COUNTY, WISCONSIN, PER LEACH'S MAP OF 1894, EXCEPTING THEREFROM THE SOUTH 20.0 FT. OF SAID LOT 14.

THAT PART OF LOT 3 IN BLOCK 1 IN MERRITT'S ADDITION, IN THE FOURTH WARD, CITY OF OSHKOSH, WINNEBAGO COUNTY, WISCONSIN, PER LEACH'S MAP OF 1894 DESCRIBED AS FOLLOWS, VIZ:-
COMMENCING AT THE N.W. CORNER OF SAID LOT; THENCE SOUTH, ALONG THE WEST LINE OF SAID LOT 39.69 FEET, THENCE EASTERLY, TO A POINTON THE EAST LINE OF SAID LOT 3 THAT IS 39.16 FEET SOUTH OF THE NORTH EAST CORNER OF SAID LOT, THENCE NORTH, ALONG THE EAST LINE OF SAID LOT 39.16 FEET TO THE N.E. CORNER OF SAID LOT, THENCE WEST ALONG THE NORTH LINE OF SAID LOT TO THE PLACE OF BEGINNING.

THE SOUTH 2.0 FEET OF LOT 11 IN BLOCK 1 IN MERRITT'S ADDITION, IN THE FOURTH WARD, CITY OF OSHKOSH, WINNEBAGO COUNTY, WISCONSIN, PER LEACH'S MAP OF 1894.

OCTOBER 30, 1980 (SURVEY FOR MIKE GUERING) SURVEY NO. 85-S-Rec.

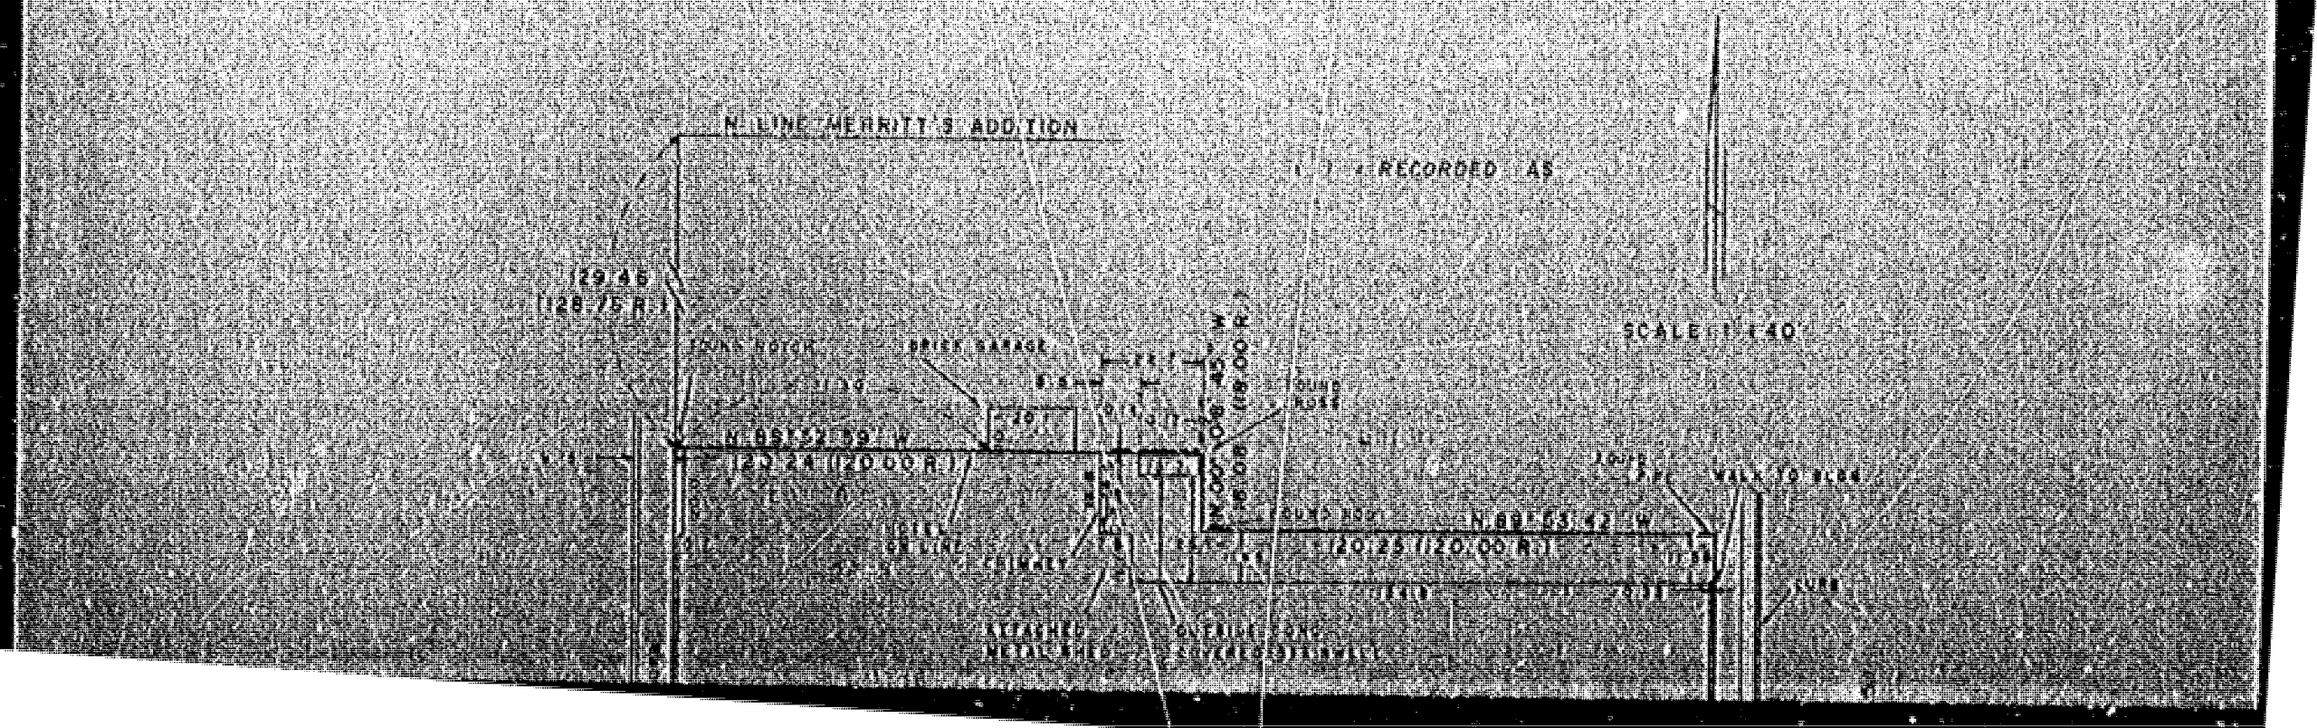

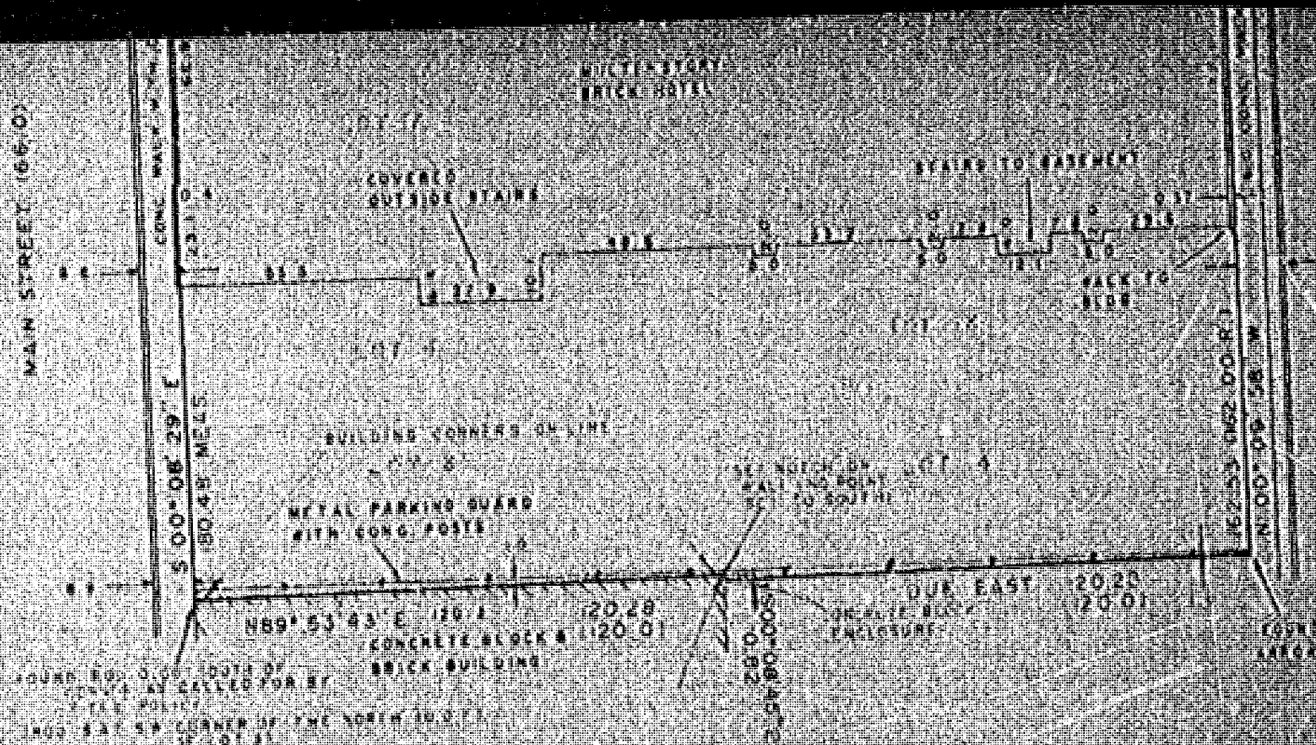

I Certify that I have surveyed the above described property (Property) and the above map is a true representation thereof and shows the size and location of the Property, its exterior boundaries, the location and dimensions of all visible structures thereon, boundary fences, apparent easements and roadways and visible encroachments, if any.

This survey is made for the exclusive use of the present owners of the Property and also those who purchase, mortgage, or guarantee the title thereto, within one (1) year from date hereof.

national survey & engineering
[illegible] P.O. BOX 2583
OSHKOSH, WISCONSIN 54901
(414) 426-1882

Richard Roehlig


WISCONSIN
REINHARD H.W. ROEHLIG
2783
OSHKOSH WIS
REGISTERED LAND SURVEYOR

12/30/80

Plat of Survey

Lot 13, Block 8 of the PLAT OF INTERURBAN LAND CO., City of Oshkosh, Winnebago County, Wisconsin.

CLIENT:
Frank Schoenion
1005 W. Bent Avenue
Oshkosh, WI 54901

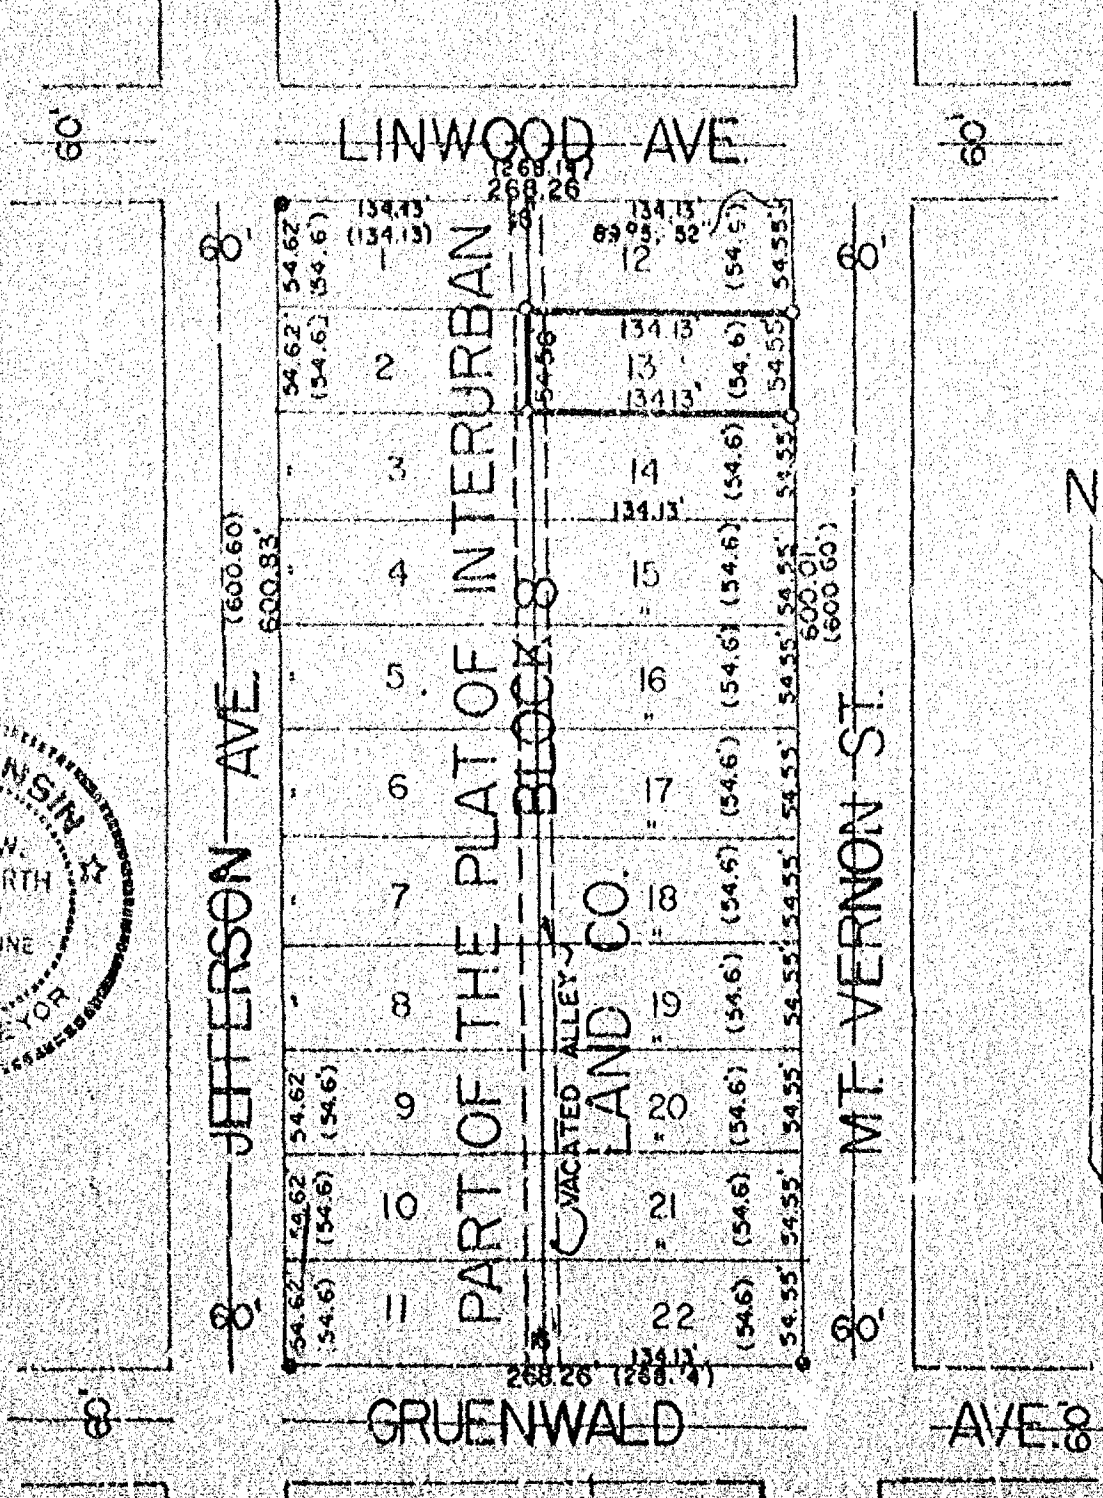

WISCONSIN
CALVIN W. HAWKSWORTH
S-1290
WINNECONNE WIS.
LAND SURVEYOR

LEGEND

- ● = Existing monuments
- ○ = 2" x 30" iron pipe set
- ⊙ = 1" x 30" iron pipe set
- ◉ = reference cons or RR spikes
- ◆ = Berntsen or Harrison monuments
- X—X = fence
- ( ) = recorded as
- □ = stone monument

SURVEYORS CERTIFICATE

I hereby certify that I have surveyed the property as shown, according to official records and that the plat above drawn is an accurate and correct representation of said survey. MAY 11, 19 81

Calvin W. Hawksworth
Wisconsin Registered Land Surveyor S-1290

R. K. SAYLER, INC.
LAND SURVEYORS
WINNECONNE, WI 54986

SCALE 1" = 100'
PROJECT NO. S.001203
FIELD BOOK 12 PAGE 73


0

Winnebago

Plat of Survey

LOTS 5 & 6 OF BLOCK 5 OF LAKE VIEW PARK ADD'N CITY OF OSHKOSH.

PATRICIA J. KOLL
1620 MENOMINEE DR.
OSHKOSH, WISCONSIN

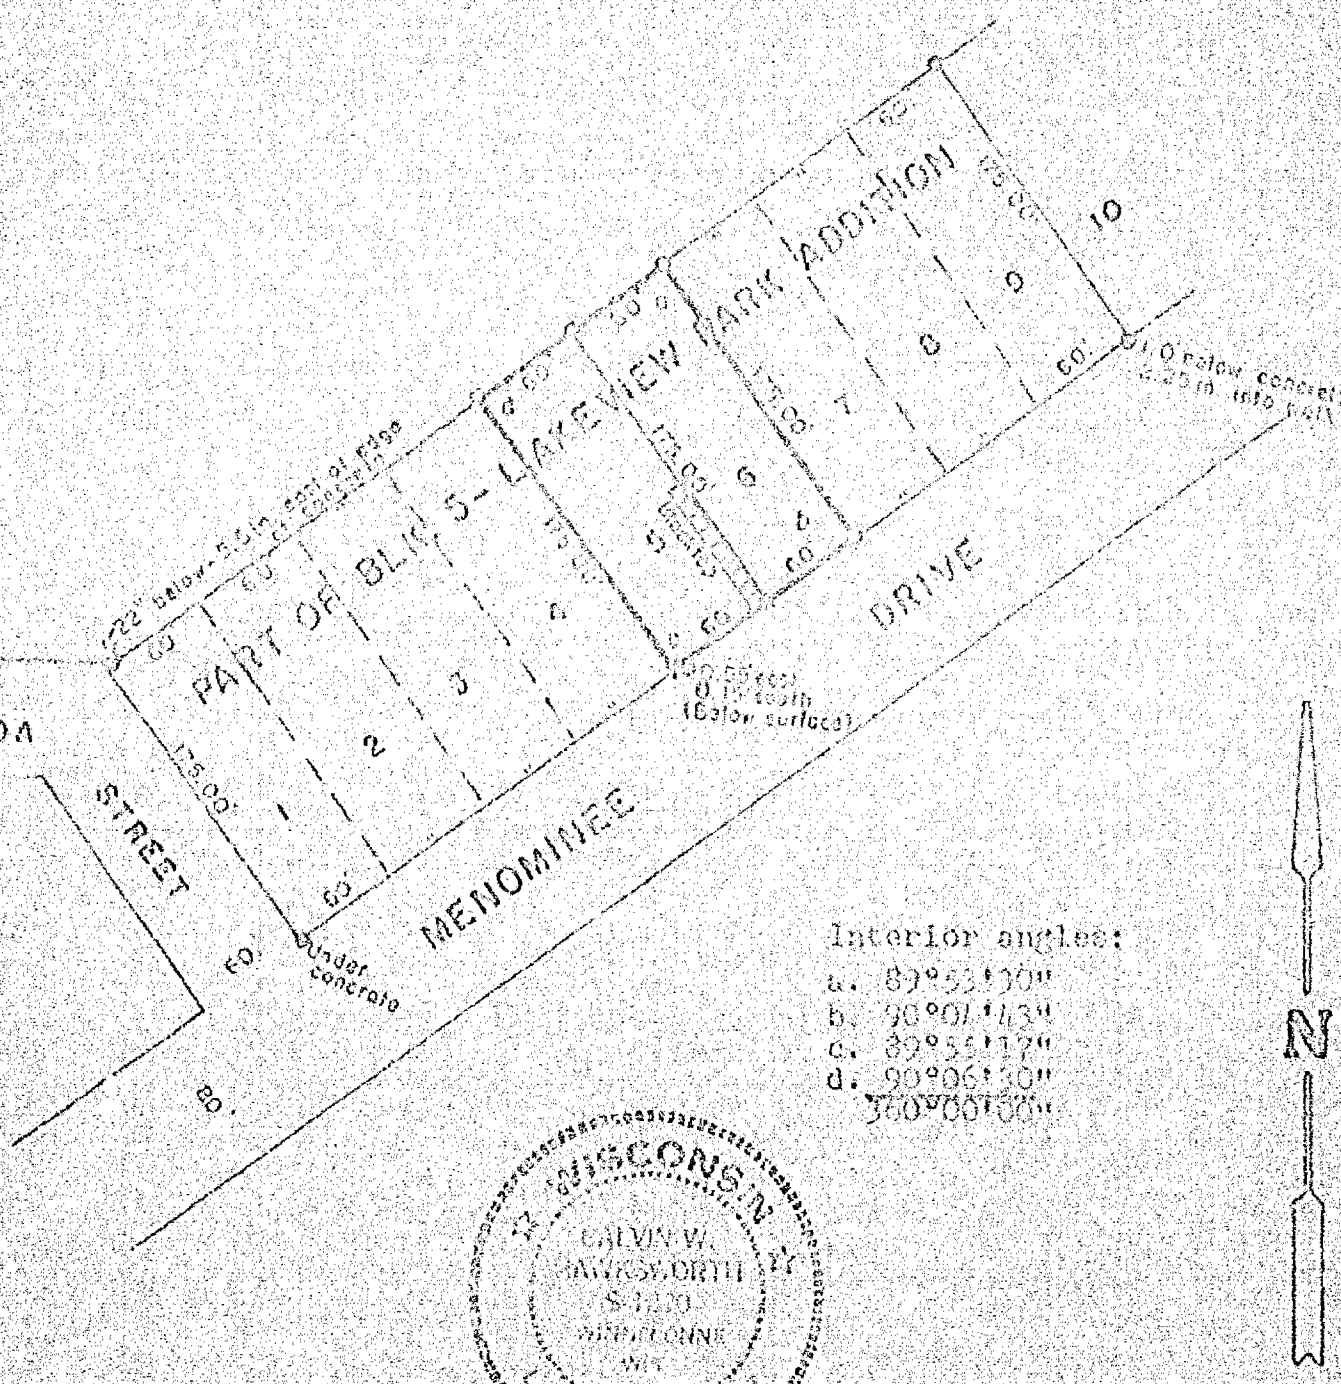

Interior angles:
a. 89°52'30"
b. 90°01'43"
c. 89°55'17"
d. 90°06'30"
360°00'00"

WISCONSIN
CALVIN W. HAWKSWORTH
S-1290
WINNECONNE
WI

LEGEND

- ● = Existing monuments X = Chiseled cross in concrete
- ○ = 2 x 30 iron pipe set
- ⊙ = 1 x 30 iron pipe set
- ⊕ = reference caps or RR spikes
- Ⓜ = Bernsen or Harrison monuments
- x—x = fence
- ( ) = recorded as
- □ = stone monument

SURVEYORS CERTIFICATE

I hereby certify that I have surveyed the property as shown, platted in official records and that the plat above drawn is an accurate and correct representation of said survey. MAY 7, 19 79

Calvin W. Hawksworth
Wisconsin Registered Land Surveyor
S-1290

R. K. SAYLER, INC.
LAND SURVEYORS
WINNECONNE, WI 54986


SCALE 1 IN. = 100 FT.
PROJECT NO. S-000973
FIELD BOOK 40 PAGE 11

Winnebago

Plat of Survey

THE NORTH TWENTY EIGHT FEET OF LOT EIGHT AND THE SOUTH ELEVEN FEET OF LOT SEVEN, BLOCK ONE LYING EAST OF THE CHICAGO, MILWAUKEE, ST. PAUL & PACIFIC RAILROAD RIGHT OF WAY IN SUHL'S ADDITION TO THE CITY OF OSHKOSH, WINNEBAGO COUNTY, WISCONSIN.

CLIENT: Arlin Krause
525 W. Murdock
Oshkosh, Wisconsin
54901

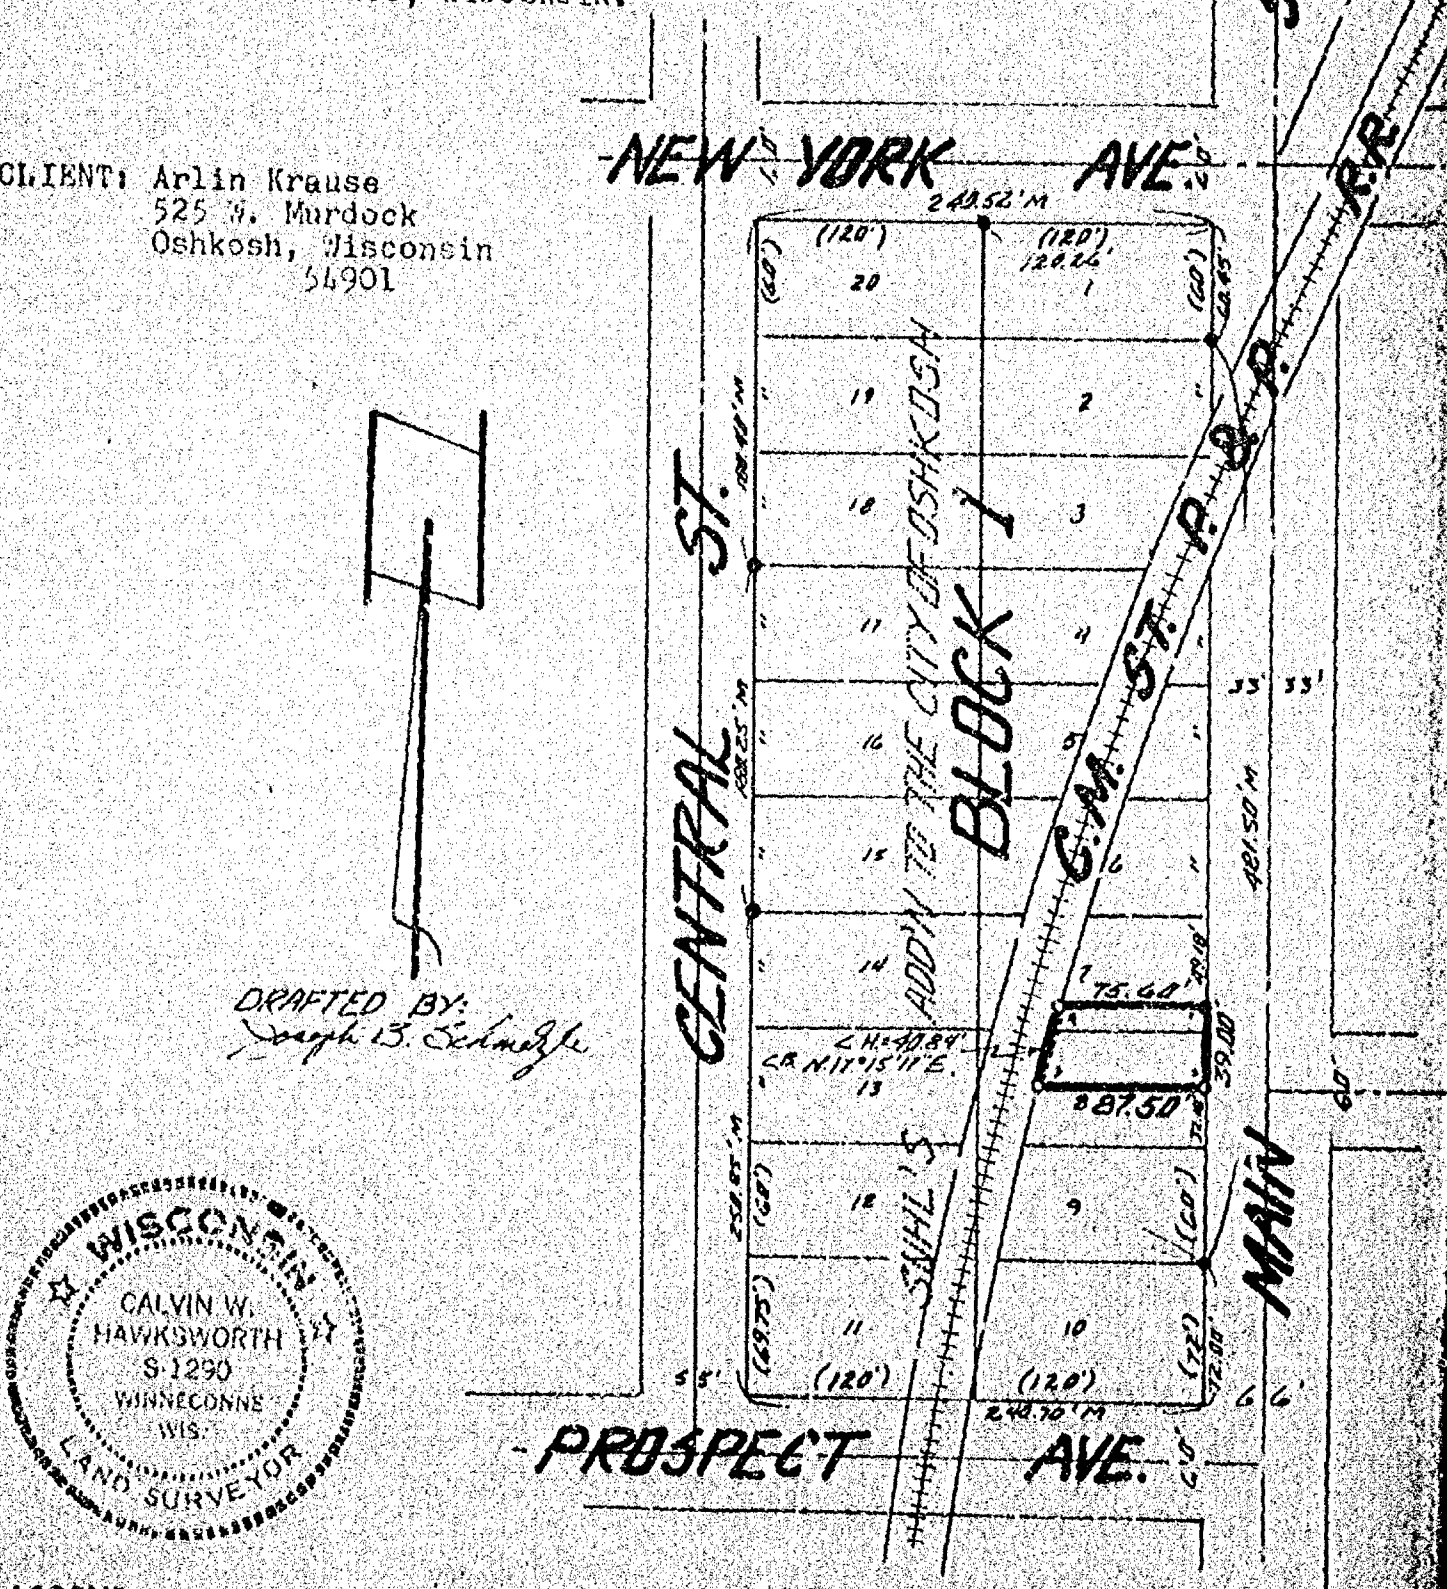

DRAFTED BY:
Joseph B. Schmaltz

WISCONSIN
CALVIN W. HAWKSWORTH
S-1290
WINNECONNE WIS.
LAND SURVEYOR

LEGEND

- ● = Existing monuments
- ○ = 2" x 30" iron pipe set
- ○ = 1" x 30" iron pipe set
- ⊕ = reference cars or RR spikes
- ◆ = Bernsen or Harrison monuments
- X—X = fence
- ( ) = recorded as
- □ = stone monument

INTERIOR ANGLES		
1	89° 41'	12"
2	90° 18'	48"
3	72° 44'	43"
4	107° 75'	17"

SURVEYORS CERTIFICATE

I, hereby certify that I have surveyed the property as shown, according to official records and that the plat above drawn is an accurate and correct representation of said survey. June 25, 19 80

Calvin W. Hawksworth
Wisconsin Registered Land Surveyor S-1290

R. K. SAYLER, INC.
LAND SURVEYORS
WINNECONNE, WI 54986

SCALE 1"=100'
PROJECT NO. 5-80118
FIELD BOOK 40 PAGE 139 / 140


PLAT OF SURVEY

KNOWN AS 2023 ASHLAND STREET. BEING LOTS 15 AND 16 AND THE EAST 1/2 OF THAT PART OF AN ALLEY (NOW VACATED) LYING WEST OF AND ADJACENT TO SAID LOTS 15 AND 16 AND BETWEEN THE EXTENDED NORTH LINE OF SAID LOT 15 AND THE EXTENDED SOUTH LINE OF SAID LOT 16, ALL IN BLOCK 9 IN THE FIRST ADDITION TO THE PLAT OF THE INTERURBAN LAND COMPANY, TOWN OF OSHKOSH AND NOW IN THE 15th WARD, CITY OF OSHKOSH, WINNEBAGO COUNTY, WISCONSIN.

JULY 11, 1983

SURVEY FOR OSHKOSH SAVINGS
APPLICANT: LINDA CARPENTER
(CONSENT WAIVER ON FILE)

SURVEY NO. 1264-M

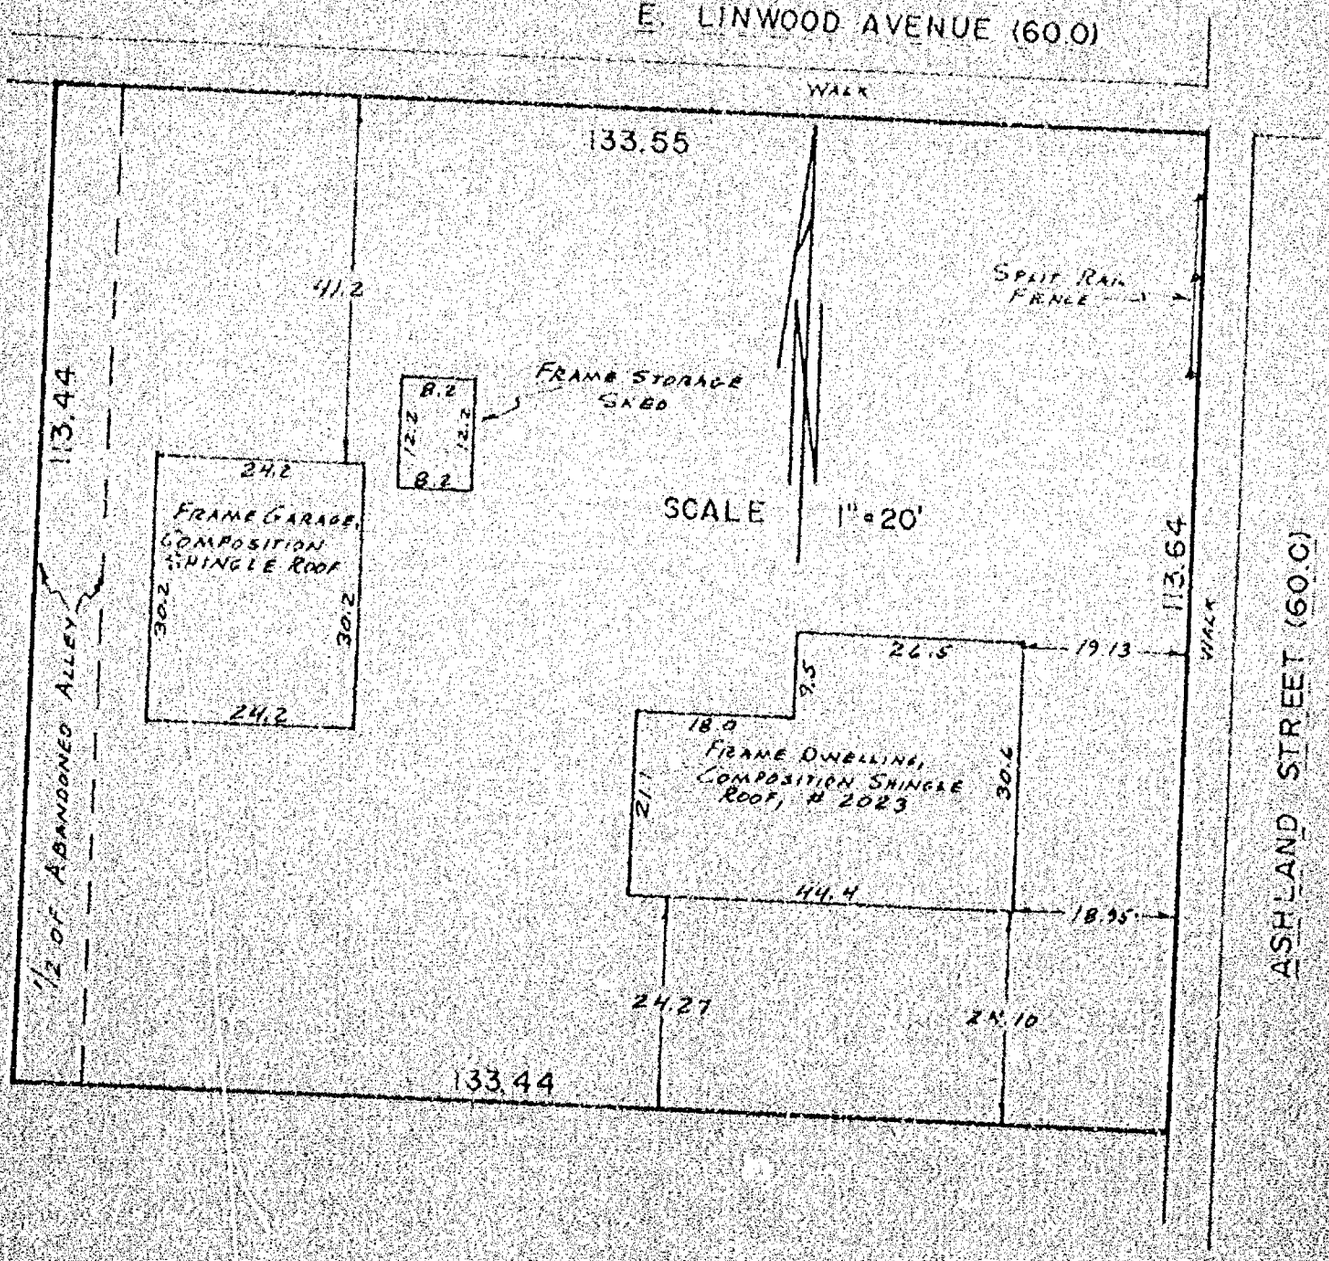

I Certify that I have surveyed the above described property (Property), and the above map is a true representation thereof and shows the size and location of the Property, its exterior boundaries, the location and dimensions of all visible structures thereon, boundary, fences, apparent easements and roadways and visible encroachments, if any.

This survey is made for the exclusive use of the present owners of the Property, and also those who purchase, mortgage, or guarantee the title thereto, within one (1) year from date hereof.


national survey & engineering
417 NORTH SAWYER STREET / PO BOX 2963
OSHKOSH, WISCONSIN 54903
(414) 426-2800

WISCONSIN REINHARD W. ROTTING S-360 OSHKOSH WIS REGISTERED LAND SURVEYOR

PLAT OF SURVEY

KNOWN AS 1517 TAFT AVENUE, BEING LOTS 4 AND 5 IN BLOCK "L" IN NORTHWESTERN CAR AND MACHINE COMPANY'S 2nd ADDITION, 16th WARD, CITY OF OSHKOSH, WINNEBAGO COUNTY, WISCONSIN.

JULY 13, 1983 — SURVEY FOR OSHKOSH SAVINGS — SURVEY NO. 1266-M
APPLICANT: BLACKNELL
(COMMENT WAIVER ON FILE)

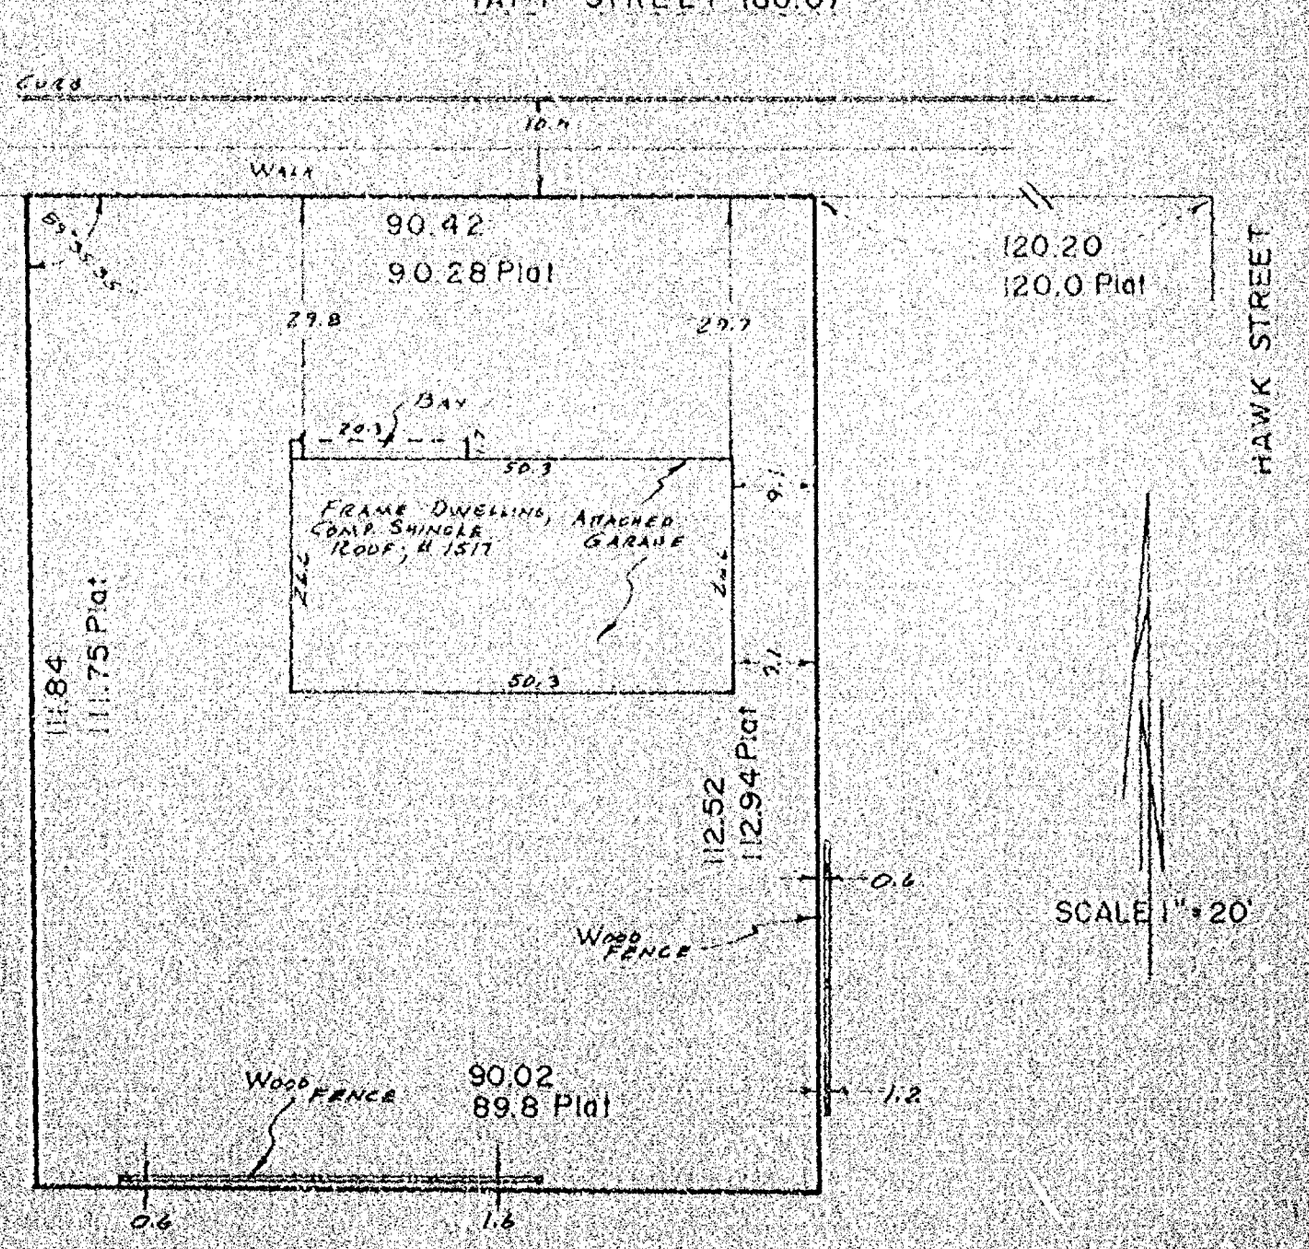

I Certify that I have surveyed the above described property (Property), and the above map is a true representation thereof and shows the size and location of the Property, its exterior boundaries, the location and dimensions of all visible structures thereon, boundary fences, apparent easements and roadways and visible encroachments, if any.

This survey is made for the exclusive use of the present owners of the Property, and also those who purchase, mortgage, or guarantee the title thereto, within one (1) year from date hereof.

WISCONSIN
REINHARD H.W. ROEHLIG
S-1068
OSHKOSH WIS.
LAND SURVEYOR

national survey & engineering
417 NORTH SAWYER STREET / P.O. BOX 2963
OSHKOSH, WISCONSIN 54903
(414) 426-2800


PLAT OF SURVEY

KNOWN AS 681 WEST 8th AVENUE, BEING THE NORTH 1/2 OF LOT 26 IN CITY'S REPLAT NO. 3, 6th WARD, CITY OF OSHKOSH, WINNEBAGO COUNTY, WISCONSIN.

OCTOBER 6, 1983

SURVEY FOR: OSHKOSH SAVINGS
APPLICANT: CLYDE SPANBAUER
MONUMENT WAIVER ON FILE

SURVEY NO. 1328-M

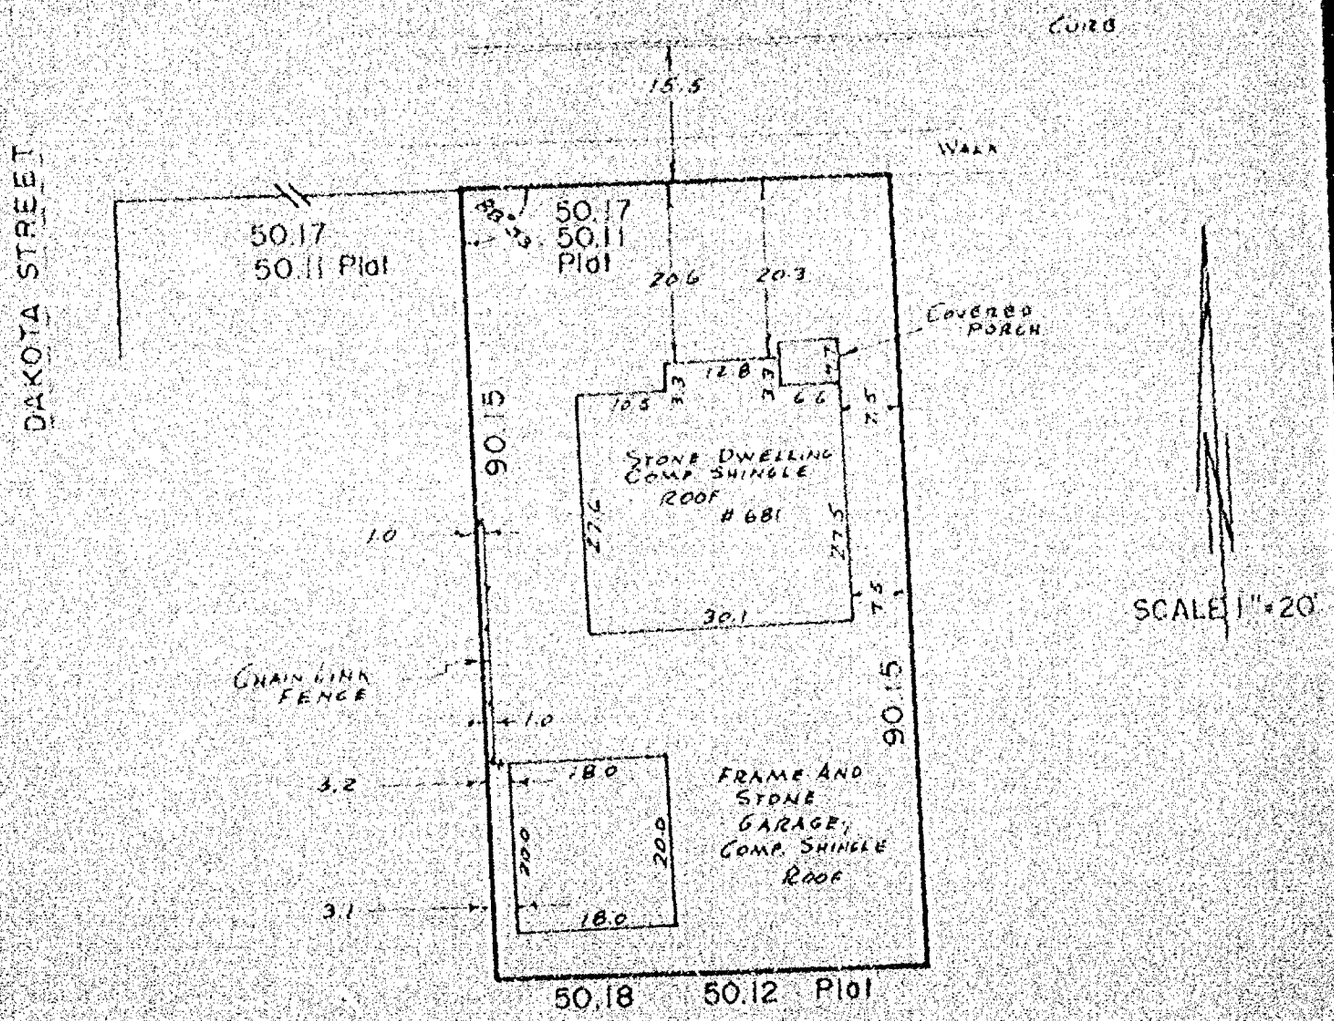

I Certify that I have surveyed the above described property (Property), and the above map is a true representation thereof and shows the size and location of the Property, its exterior boundaries, the location and dimensions of all visible structures thereon, boundary fences, apparent easements and roadways and visible encroachments.

This survey is made for the exclusive use of the present owners of the Property, and also those who purchase, mortgage, or guarantee the title thereto, within one (1) year from date hereof.

WISCONSIN
REINHARD H.W. ROEHRIG
OSHKOSH WIS
SURVEYOR


national survey & engineering
417 NORTH SAWYER STREET / P.O. BOX 2963
OSHKOSH, WISCONSIN 54903
(414) 426-2800

PLAT OF SURVEY

KNOWN AS 1411 GRAHAM STREET, BEING LOT 90 IN THE ALGOMA ADDITION, IN THE 12th WARD, CITY OF OSHKOSH, WINNEBAGO COUNTY, WISCONSIN, PER LEACH'S MAP OF 1894 AND NOW IN THE 16th WARD, CITY OF OSHKOSH.

OCTOBER 6, 1983 — SURVEY FOR OSHKOSH SAVINGS — SURVEY NO. 1324-M

APPLICANT: KEVIN PURTELL — MONUMENT WAIVER ON FILE

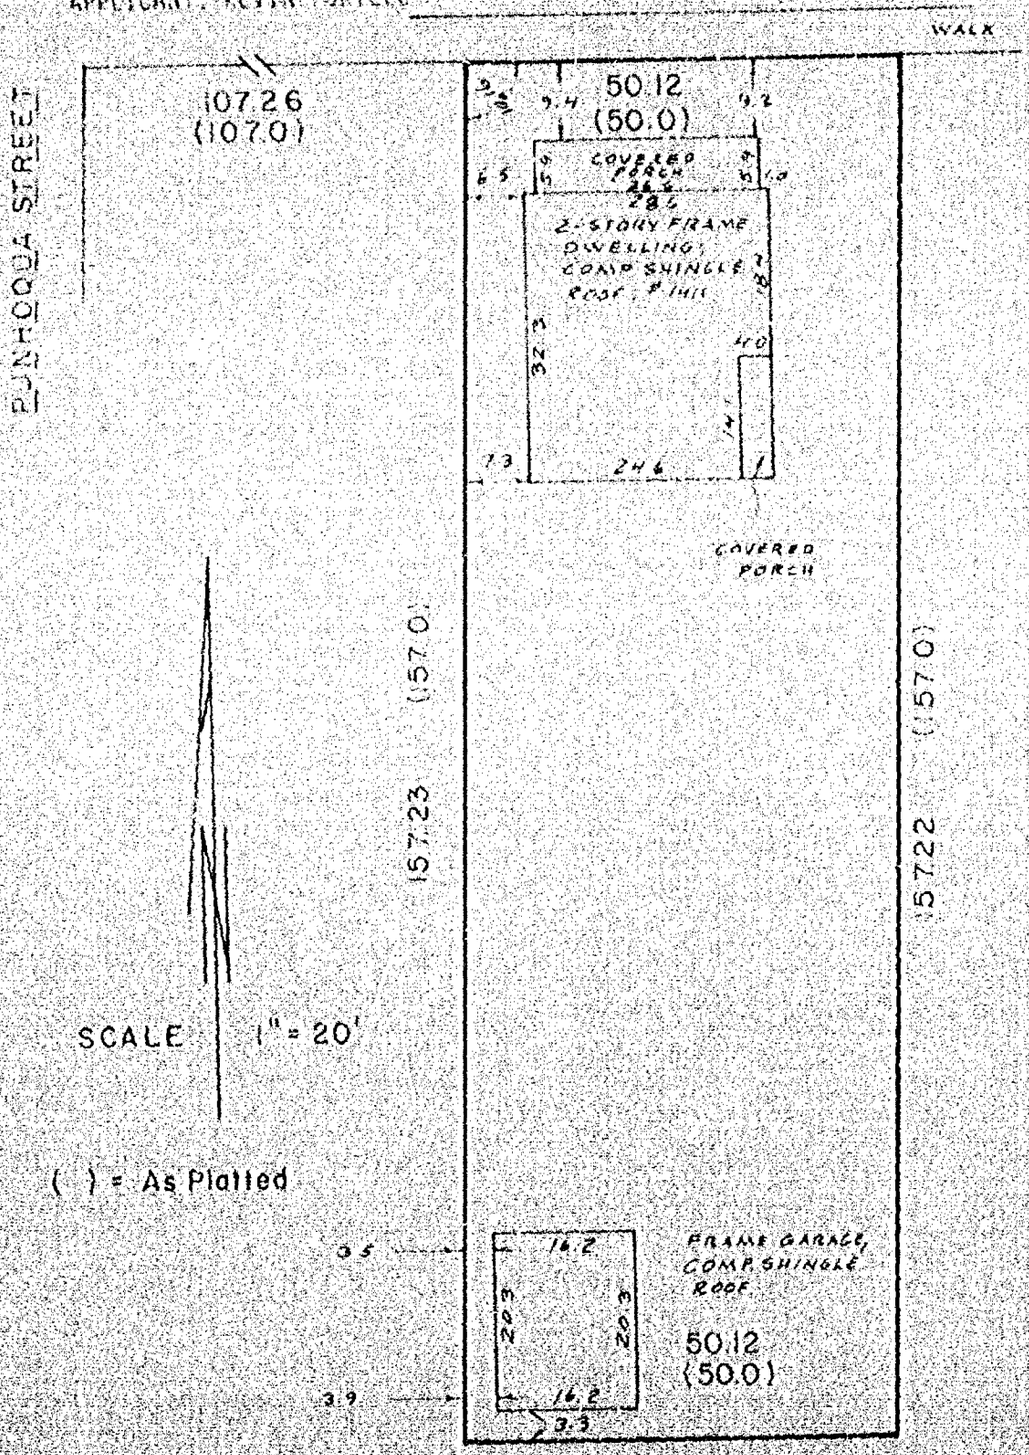

I Certify that I have surveyed the above described property (Property), and the above map is a true representation thereof and shows the size and location of the Property, its exterior boundaries, the location and dimensions of all visible structures thereon, boundary fences, apparent easements and roadways and visible encroachments, if any.

This survey is made for the exclusive use of the present owners of the Property, and also those who purchase, mortgage, or guarantee the title thereto, within one (1) year from date hereof.

WISCONSIN REINHARD H.W. ROEHRS S-1350 OSHKOSH WIS. LAND SURVEYOR

national survey & engineering
412 NORTH SAWYER STREET / PO BOX 2963
OSHKOSH, WISCONSIN 54903
(414) 426-2800


PLAT OF SURVEY

KNOWN AS 2435-37 CLOVER STREET, BEING LOT 4 IN THE RUSCH AND KIENAST PLAT, IN THE 12th WARD, CITY OF OSHKOSH, WINNEBAGO COUNTY, WISCONSIN.

OCTOBER 6, 1983

SURVEY FOR OSHKOSH SAVINGS
APPLICANT:
MONUMENT WAIVER ON FILE

SURVEY NO. 1327-M

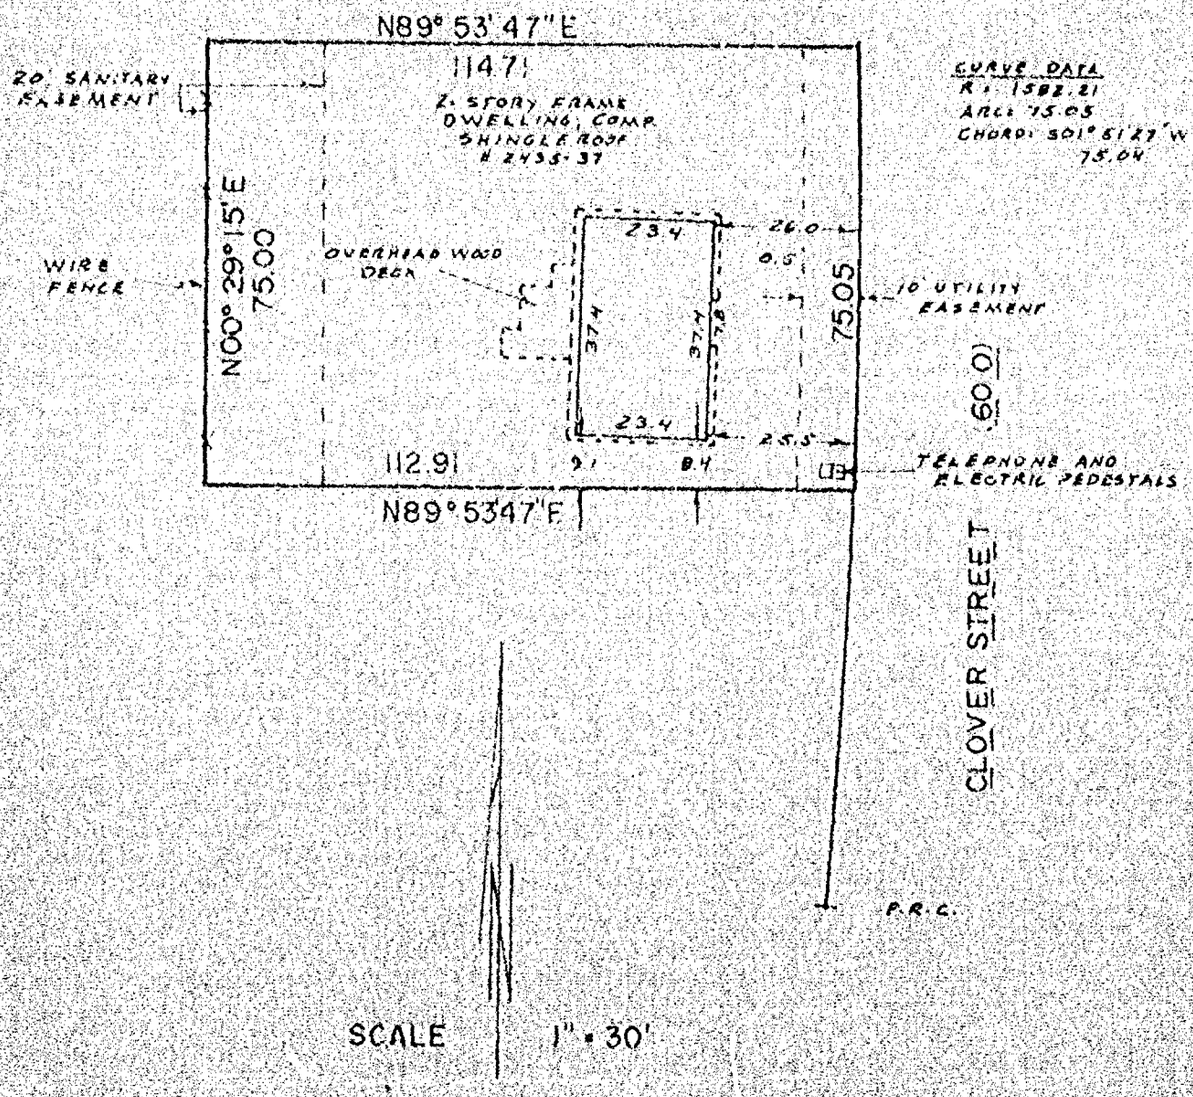

I Certify that I have surveyed the above described property (Property), and the above map is a true representation thereof and shows the size and location of the Property, its exterior boundaries, the location and dimensions of all visible structures thereon, boundary, fences, apparent easements and roadways and visible encroachments, if any.

This survey is made for the exclusive use of the present owners of the Property, and also those who purchase, mortgage, or guarantee the title thereto, within one (1) year from date hereof.

WISCONSIN REINHARD H. W. ROEHL S-1065 OSHKOSH WIS. REGISTERED LAND SURVEYOR

national survey & engineering
317 NORTH SAWYER STREET, P.O. BOX 2063
OSHKOSH, WISCONSIN 54903
(414) 426-2800


PLAT OF SURVEY

KNOWN AS 2730 MONTCLAIR PLACE, BEING LOT 614 IN THE 4th ADDITION TO WESTHAVEN, IN THE 13th WARD, CITY OF OSHKOSH, WINNEBAGO COUNTY, WISCONSIN.

OCTOBER 6, 1983

SURVEY FOR OSHKOSH SAVINGS
APPLICANT: CLAUDE TOLLARD
MONUMENT WAIVER ON FILE

SURVEY NO. 1326-M

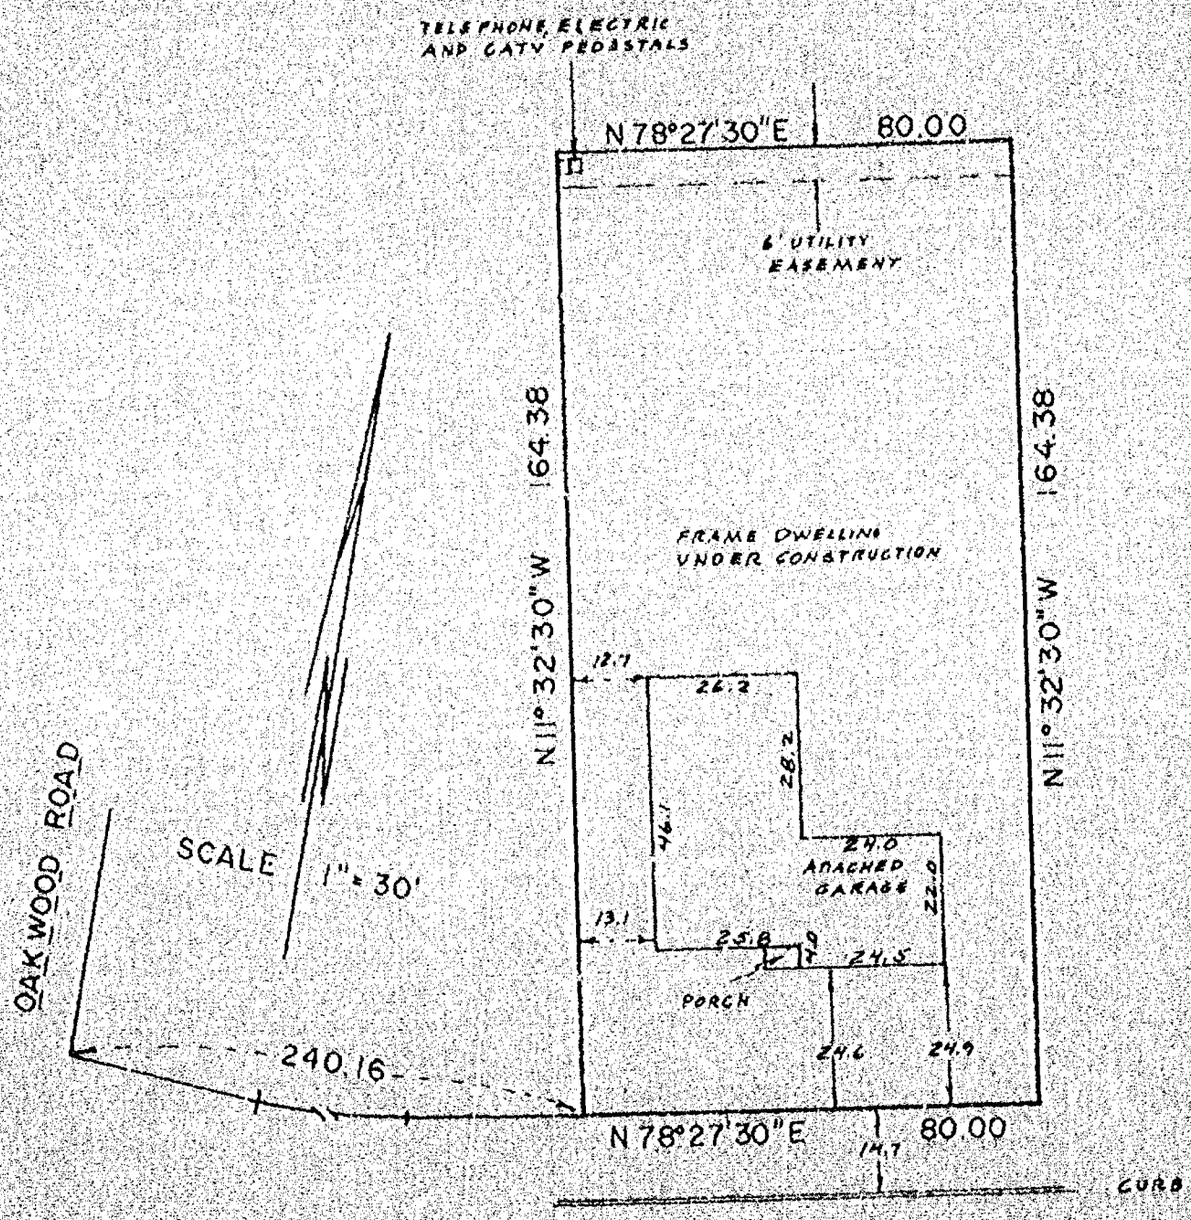

I Certify that I have surveyed the above described property (Property), and the above map is a true representation thereof and shows the size and location of the Property, its exterior boundaries, the location and dimensions of all visible structures thereon, boundary fences, apparent easements and roadways and visible encroachments, if any.

This survey is made for the exclusive use of the present owners of the Property, and as those who purchase, mortgage, or guarantee the title thereto, within one (1) year from date hereof.


WISCONSIN
REINHARD H.W. [illegible]
S-1360
OSHKOSH
WIS.
REGISTERED LAND SURVEYOR

national survey & engineering
417 NORTH LAWYER STREET / PO BOX 2963
OSHKOSH, WISCONSIN 54903
(414) 426-2800

PLAT OF SURVEY

KNOWN AS 812 LARK STREET, BEING THE S. 1/2 OF THE SOUTH 1/2 OF LOT 9 IN BLOCK "L" IN NORTHWESTERN CAR AND YACHT COMPANY'S FIRST ADDITION, 16TH WARD, CITY OF OSHKOSH, WINNEBAGO COUNTY, WISCONSIN.

MAY 26, 1983 — SURVEY FOR FIRST SAVINGS (DEFICIENT WAIVER FILED) — SURVEY NO. 1235-81

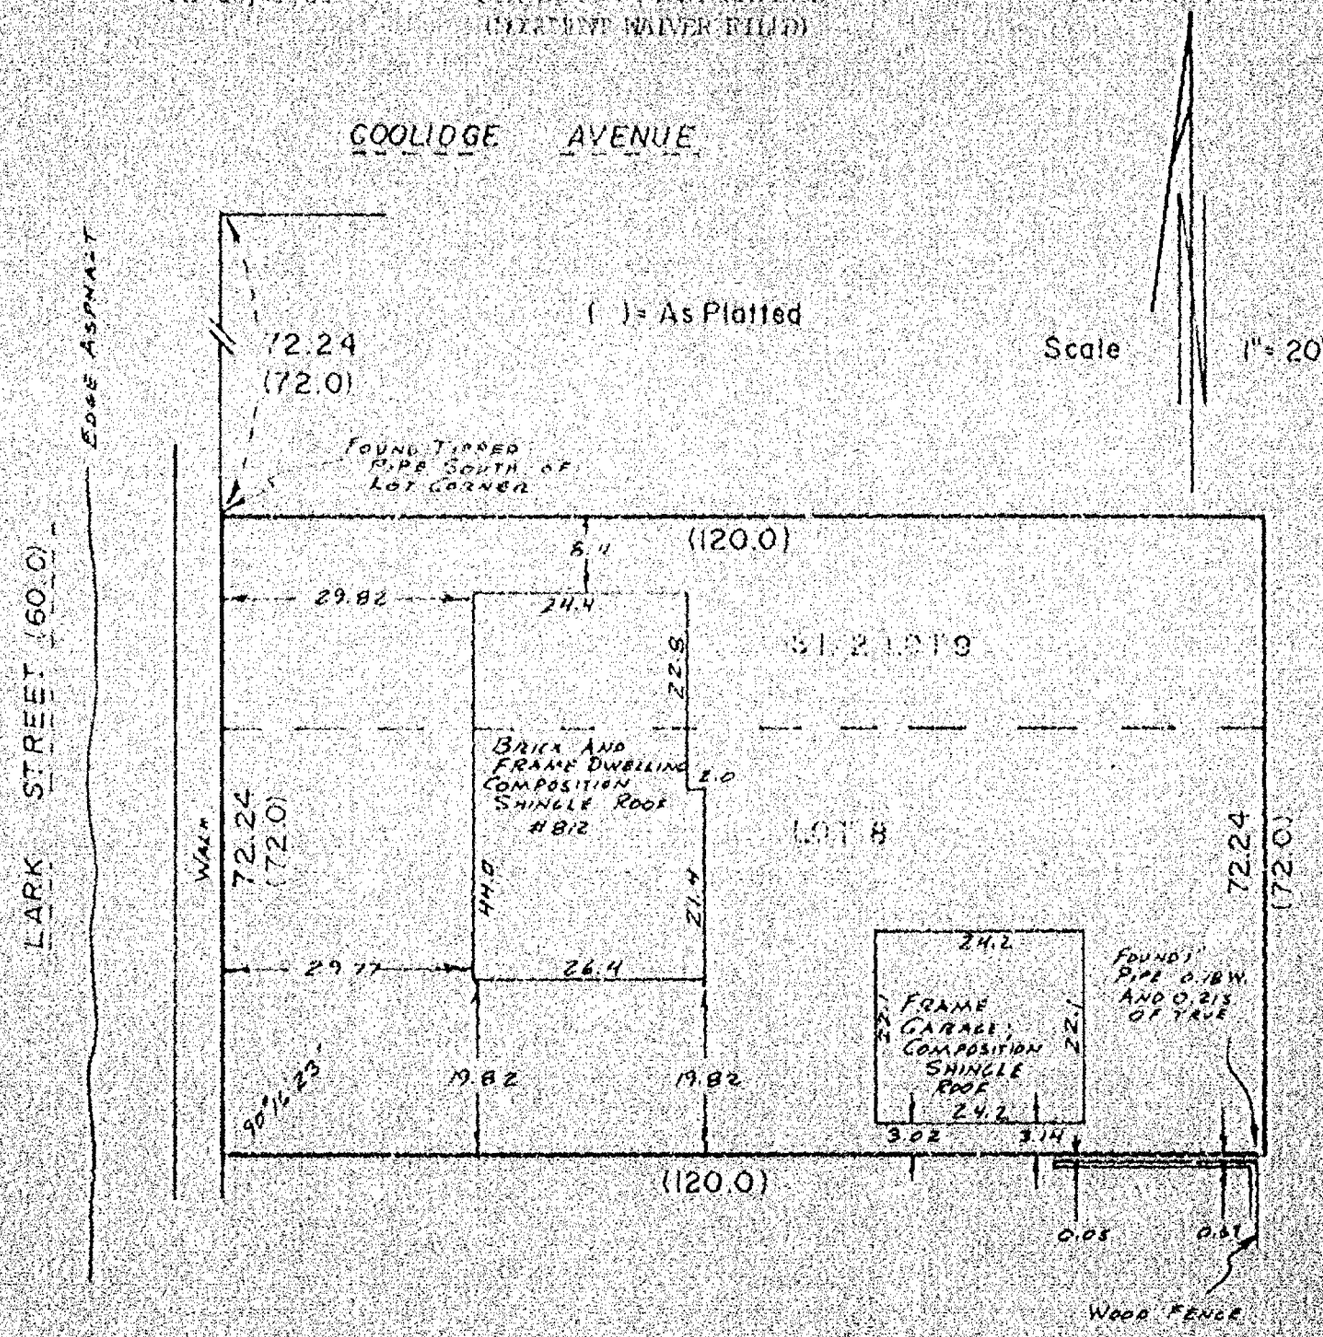

I Certify that I have surveyed the above described property (Property), and the above map is a true representation thereof and shows the size and location of the Property, its exterior boundaries, the location and dimensions of all visible structures thereon, boundary, fences, apparent easements and roadways and visible encroachments, if any.

This survey is made for the exclusive use of the present owners of the Property, and of to those who purchase, mortgage, or guarantee the title thereto, within one (1) year from date hereof.


REINHARD W. ROEHRL SURVEYOR OSHKOSH WISCONSIN

national survey & engineering
317 NORTH SAWYER STREET / P.O. BOX 2983
OSHKOSH, WISCONSIN 54903
(414) 426-2800

PLAT OF SURVEY

KNOWN AS 1715 BRENTWOOD DRIVE. BEING LOT 585 IN THE 14th ADDITION TO WESTHAVEN, CITY OF OSHKOSH, WINNEBAGO COUNTY, WISCONSIN.

MAY 25, 1983 — SURVEY FOR OSHKOSH SAVINGS AND LOAN (MONUMENT WAIVER FILED) — SURVEY NO. 1236-81

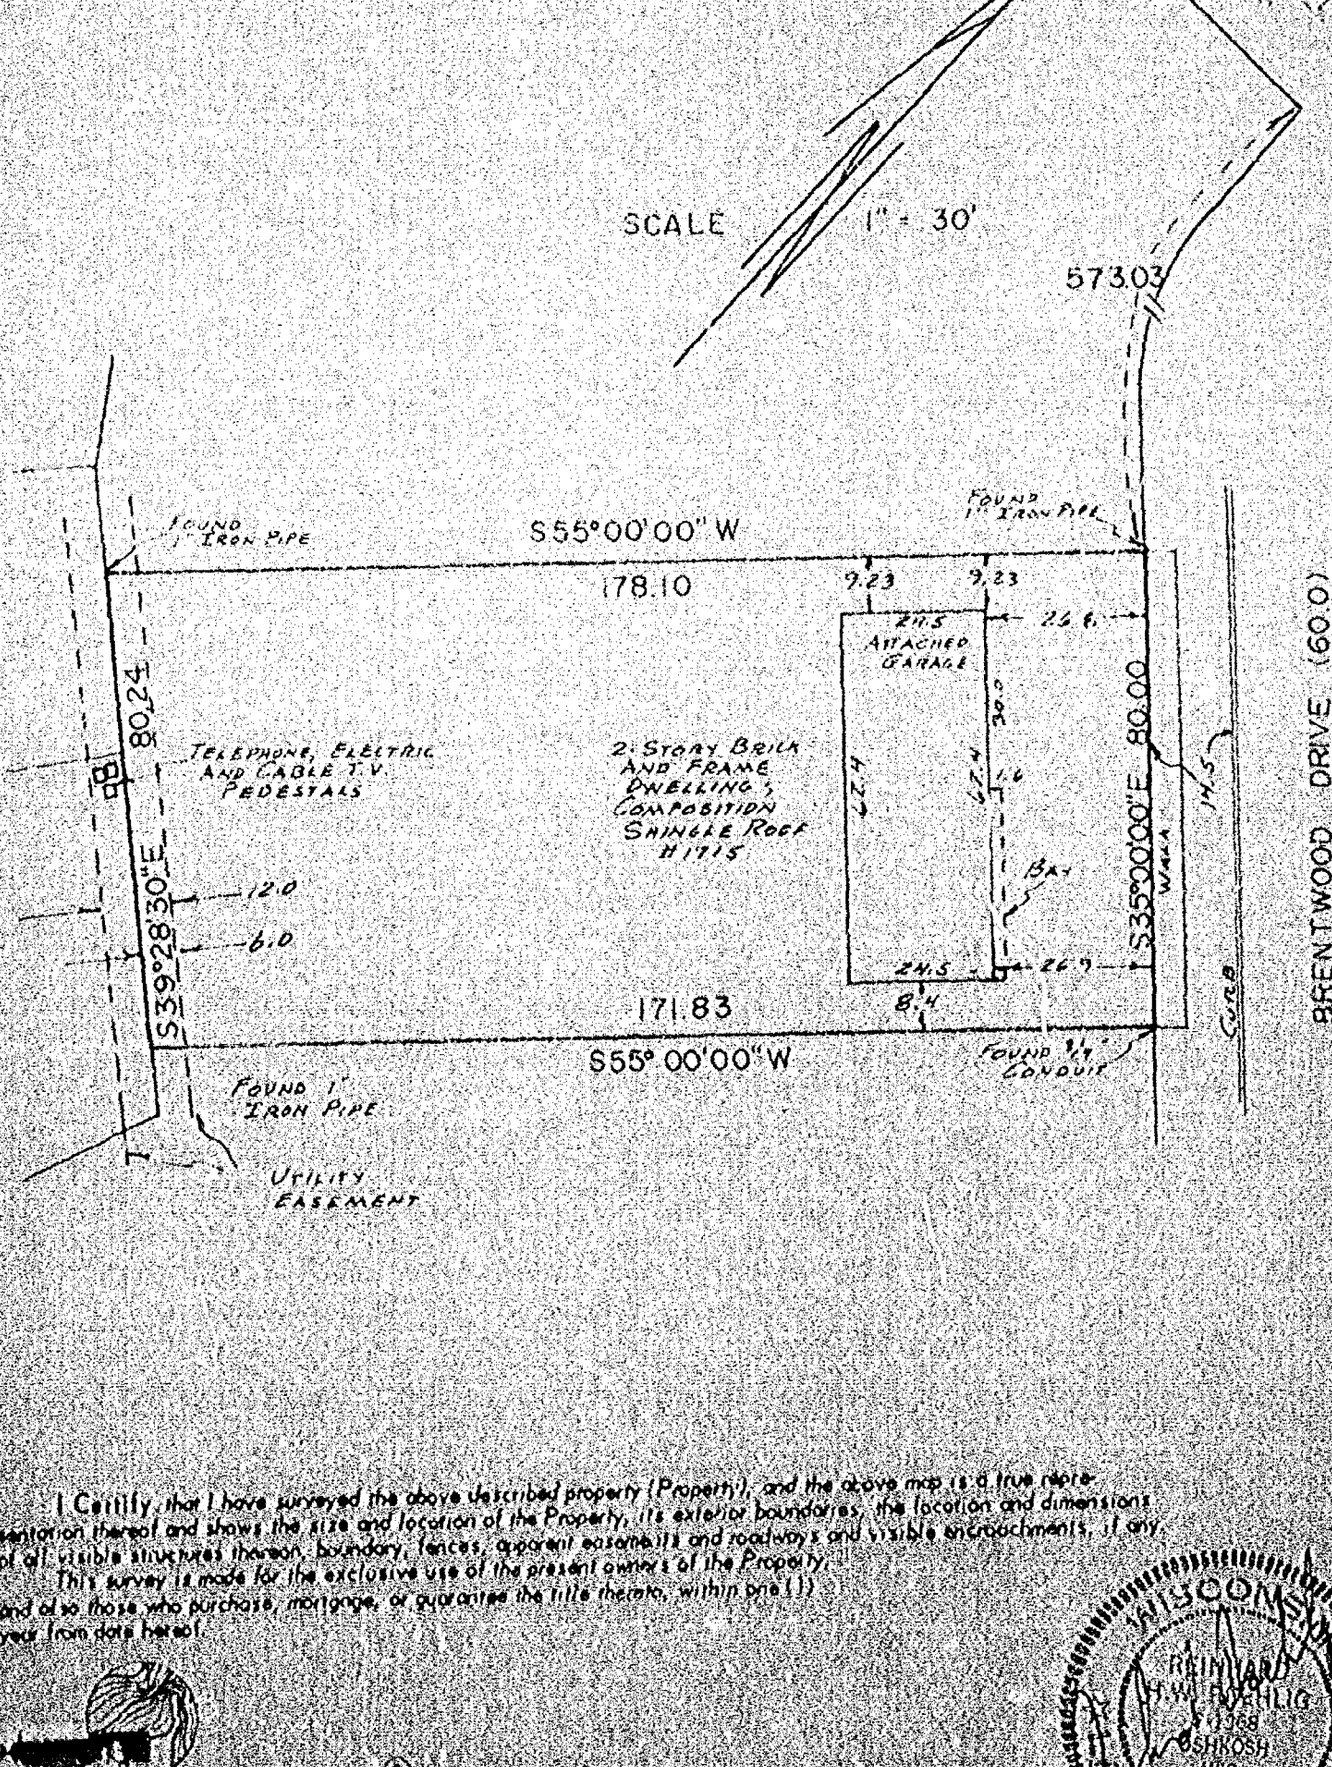

I Certify, that I have surveyed the above described property (Property), and the above map is a true representation thereof and shows the size and location of the Property, its exterior boundaries, the location and dimensions of all visible structures thereon, boundary fences, apparent easements and roadways and visible encroachments, if any.

This survey is made for the exclusive use of the present owners of the Property, and also those who purchase, mortgage, or guarantee the title thereto, within one (1) year from date hereof.

[redacted]


national survey & engineering
417 NORTH SAWYER STREET / PO BOX 2963
OSHKOSH, WISCONSIN 54903
(414) 426-8000

WISCONSIN
REINHARD H.W. HILLIG
S-1368
OSHKOSH
WIS.
REGISTERED LAND SURVEYOR

PLAT OF SURVEY

KNOWN AS 129 WEST 24th AVENUE, BEING LOT 1 AND THE EAST 18.0 FT. OF LOT 2 AND THE SOUTH 34.0 FT. OF THAT PORTION OF A ROADWAY (NOW VACATED) LYING NORTH AND ADJACENT TO SAID LOTS AND BETWEEN THE EXTENDED EAST LINE OF SAID LOT 1 AND THE EXTENDED WEST LINE OF THE EAST 18.0 FT. OF SAID LOT 2, ALL IN KURTZ PLAT, 14th WARD, CITY OF OSHKOSH, WINNEBAGO COUNTY, WISCONSIN.

MAY 27, 1983 — SURVEY FOR OSHKOSH SAVINGS AND LOAN (MOVEMENT WAIVER FILED) — SURVEY NO. 1241-1

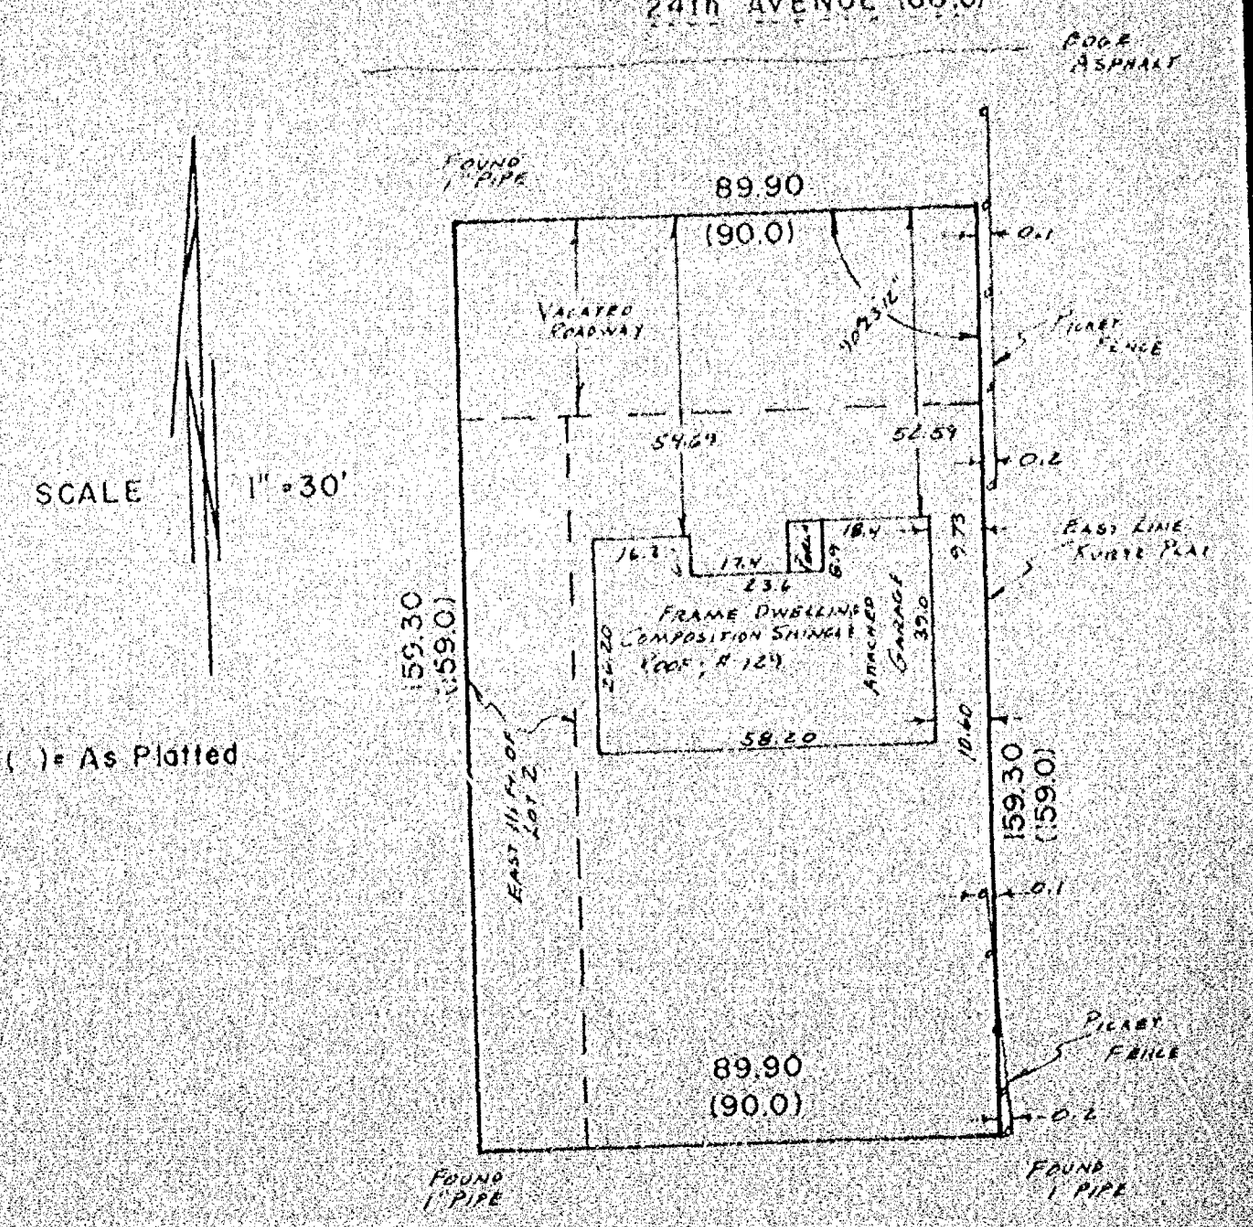

I Certify that I have surveyed the above described property (Property), and the above map is a true representation thereof and shows the size and location of the Property, its exterior boundaries, the location and dimensions of all visible structures thereon, boundary fences, apparent easements and roadways and visible encroachments, if any.

This survey is made for the exclusive use of the present owners of the Property, and also those who purchase, mortgage, or guarantee the title thereto, within one (1) year from date hereof.

national survey & engineering
417 NORTH SAWYER STREET / PO BOX 2763
OSHKOSH, WISCONSIN 54903
(414) 426-2800

WISCONSIN
RAINHARD W. ROEHRLICH
S-1006
OSHKOSH
WIS
LAND SURVEYOR


PLAT OF SURVEY

KNOWN AS 1101 NORTH SAWYER STREET, BEING LOT 7 IN BLOCK "B" IN RIVERSIDE LAWN, IN THE 16th WARD, CITY OF OSHKOSH, WINNEBAGO COUNTY, WISCONSIN.

JUNE 23, 1983

SURVEY FOR OSHKOSH SAVINGS
(CONSENT WAIVER ON FILE)

SURVEY NO. 1251-M

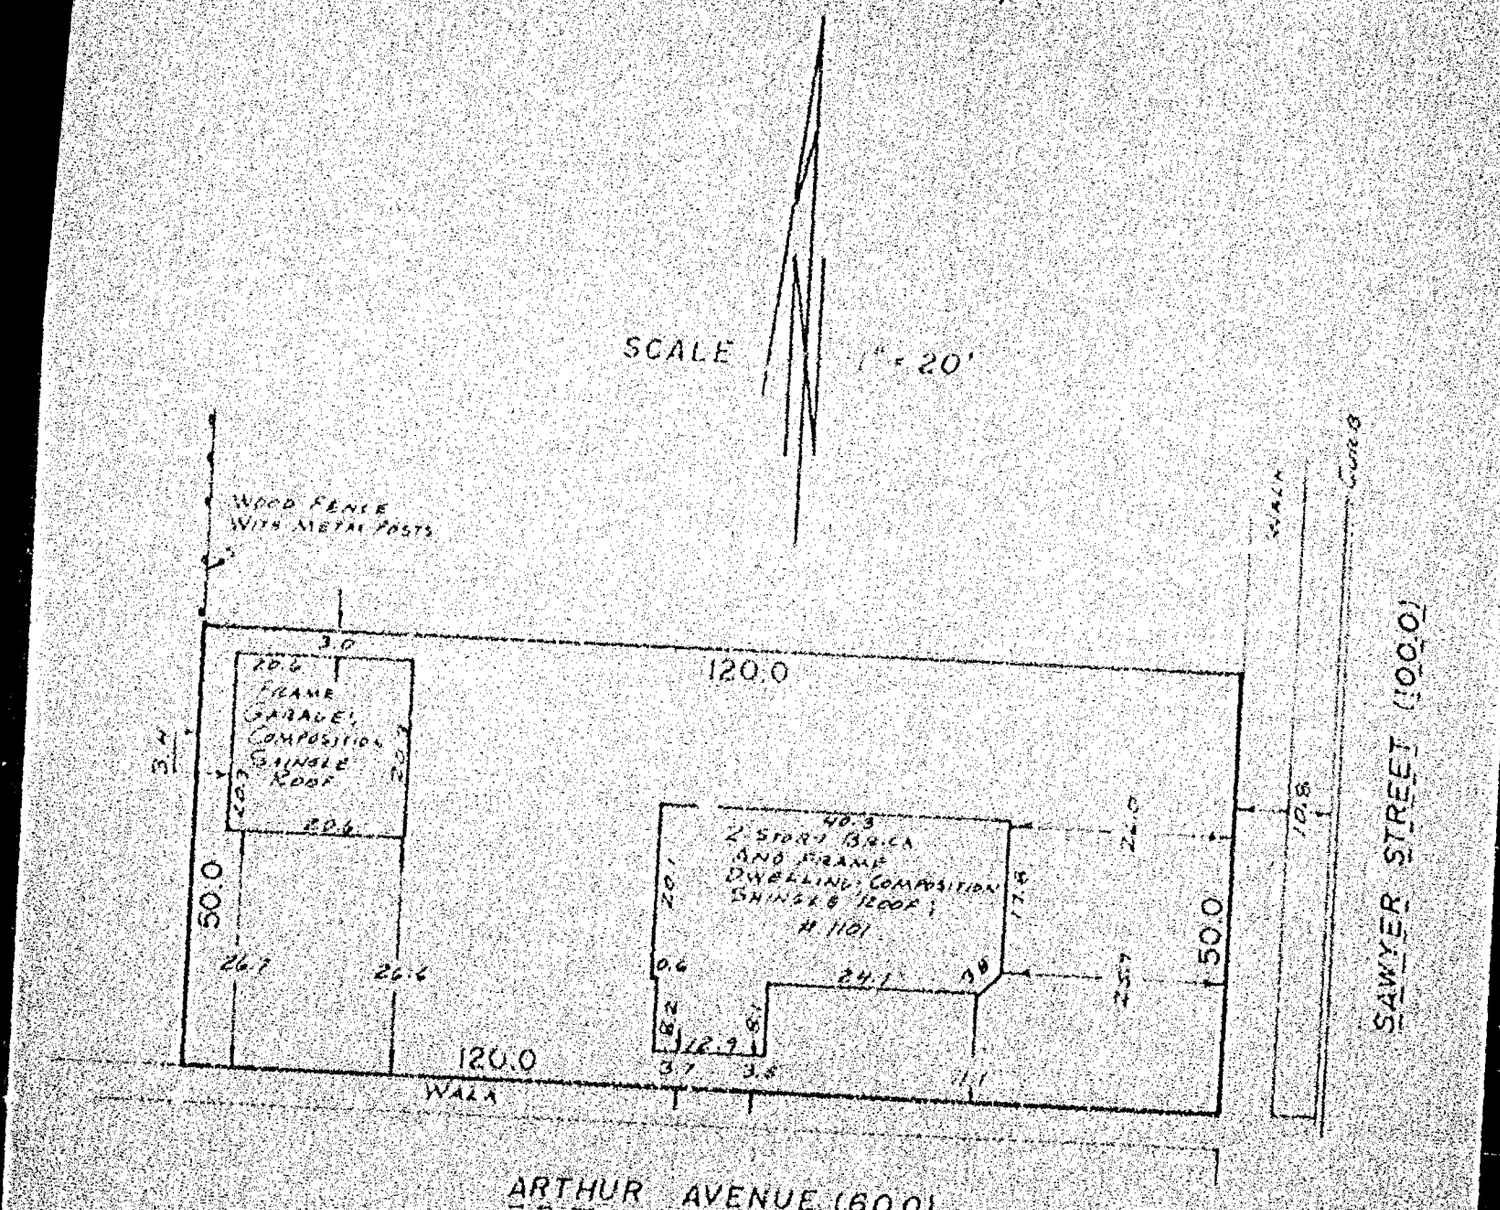

I Certify that I have surveyed the above described property ("Property"), and the above map is a true representation thereof and shows the size and location of the Property, its exterior boundaries, the location and dimensions of all visible structures thereon, boundary fences, apparent easements and roadways and visible encroachments, if any.

This survey is made for the exclusive use of the present owners of the Property, and also those who purchase, mortgage, or guarantee the title thereto, within one (1) year from date hereof.

national survey & engineering
817 NORTH SAWYER STREET / PO BOX 2963
OSHKOSH, WISCONSIN 54903
(414) 426-2800

WISCONSIN
REINHARD H. ROEHRL
S-1864
OSHKOSH
WIS.
SURVEYOR


PLAT OF SURVEY

KNOWN AS 370 WESTBROOK DRIVE, BEING LOT 23 IN WESTBROOK ADDITION NO. 1, IN THE 16TH WARD, CITY OF OSHKOSH, WINNEBAGO COUNTY, WISCONSIN.

JUNE 24, 1983

SURVEY FOR OSHKOSH SAVINGS
(MORTGAGEE: GLOVER)
(MONUMENT WAIVER ON FILE)

SURVEY NO. 1254-M
(5-S)

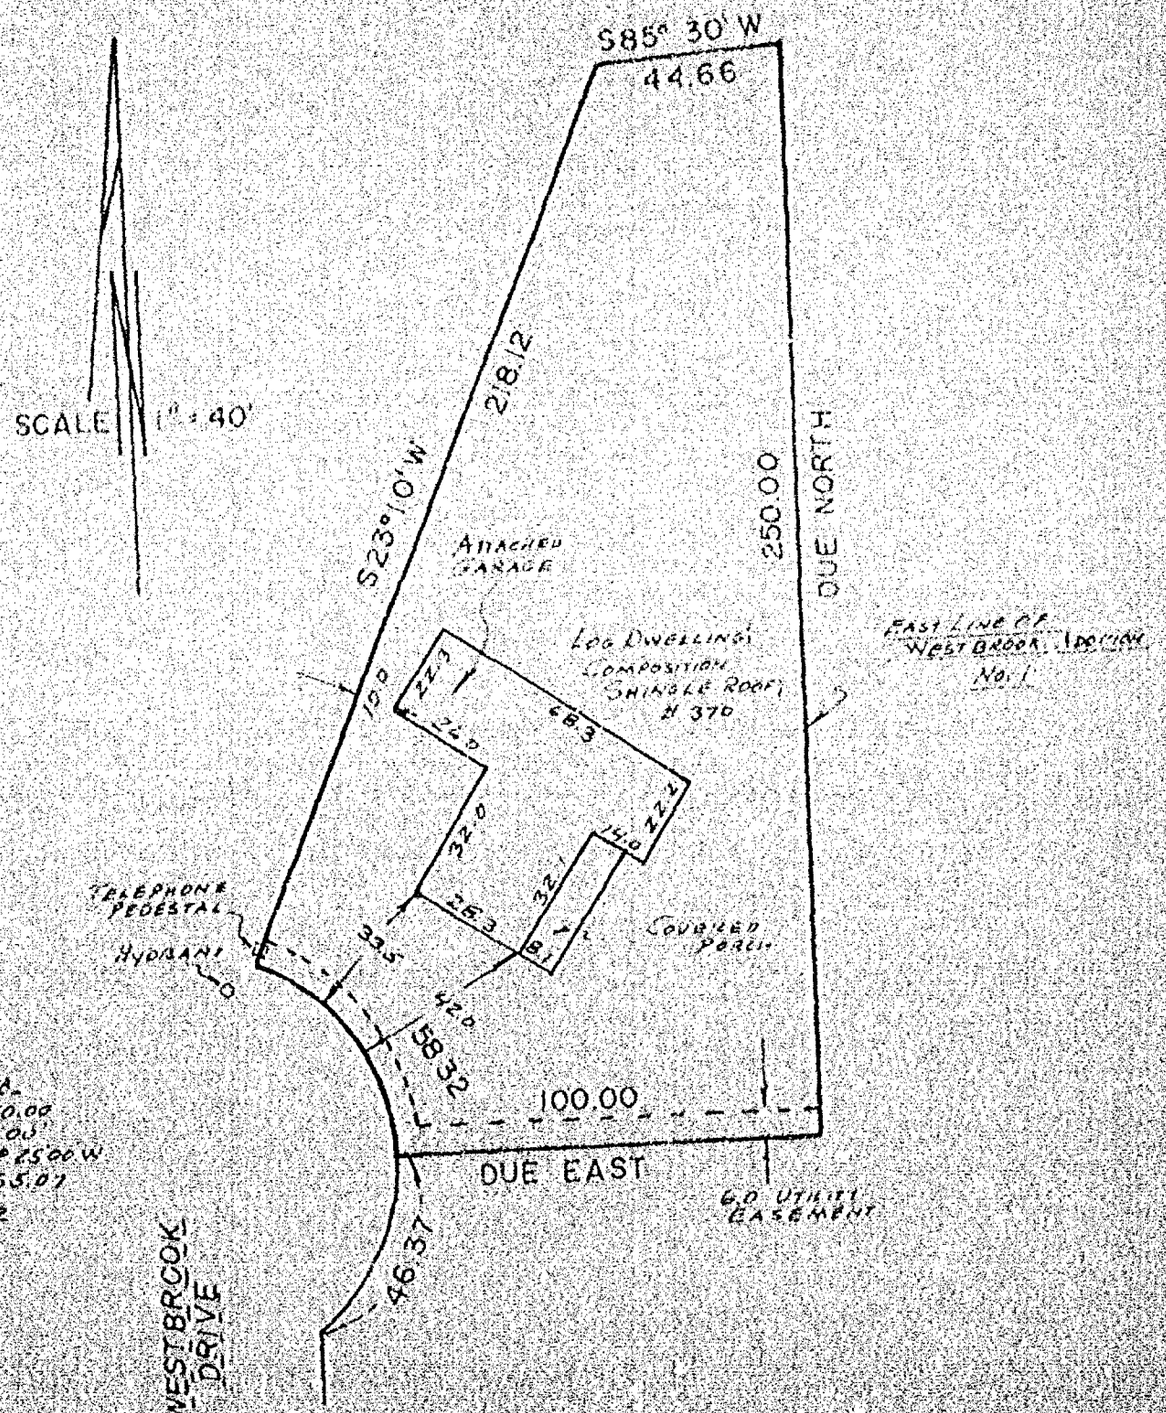

Curve Data
Radius = 50.00
Δ = 66° 50.00'
Chord: N33° 25.00' W
55.07
Arc = 58.32

I Certify that I have surveyed the above described property (Property), and the above map is a true representation thereof and shows the size and location of the Property, its exterior boundaries, the location and dimensions of all visible structures thereon, boundary fences, apparent easements and roadways and visible encroachments, if any.

This survey is made for the exclusive use of the present owners of the Property, and also those who purchase, mortgage, or guarantee the title thereto, within one (1) year from date hereof.

WISCONSIN
REINHARD H.W. ROEHL
S-1318
OSHKOSH WIS.
LAND SURVEYOR

national survey & engineering
417 NORTH SAWYER STREET / P.O. BOX 2963
OSHKOSH, WISCONSIN 54903
(414) 426-2800


PLAT OF SURVEY

KNOWN AS 342-342A WEST SOUTH PARK AVENUE, BEING LOT 16 IN BLOCK 70 OF THE PLAT OF THE ORIGINAL THIRD WARD, THIRTEENTH WARD PER LEACH'S MAP OF 1894 AND NOW IN THE NINTH WARD, CITY OF OSHKOSH, WINNEBAGO COUNTY, WISCONSIN.

JUNE 24, 1983

SURVEY FOR OSHKOSH SAVINGS AND RANDALL & RUTH HESS

SURVEY NO. 1252-S

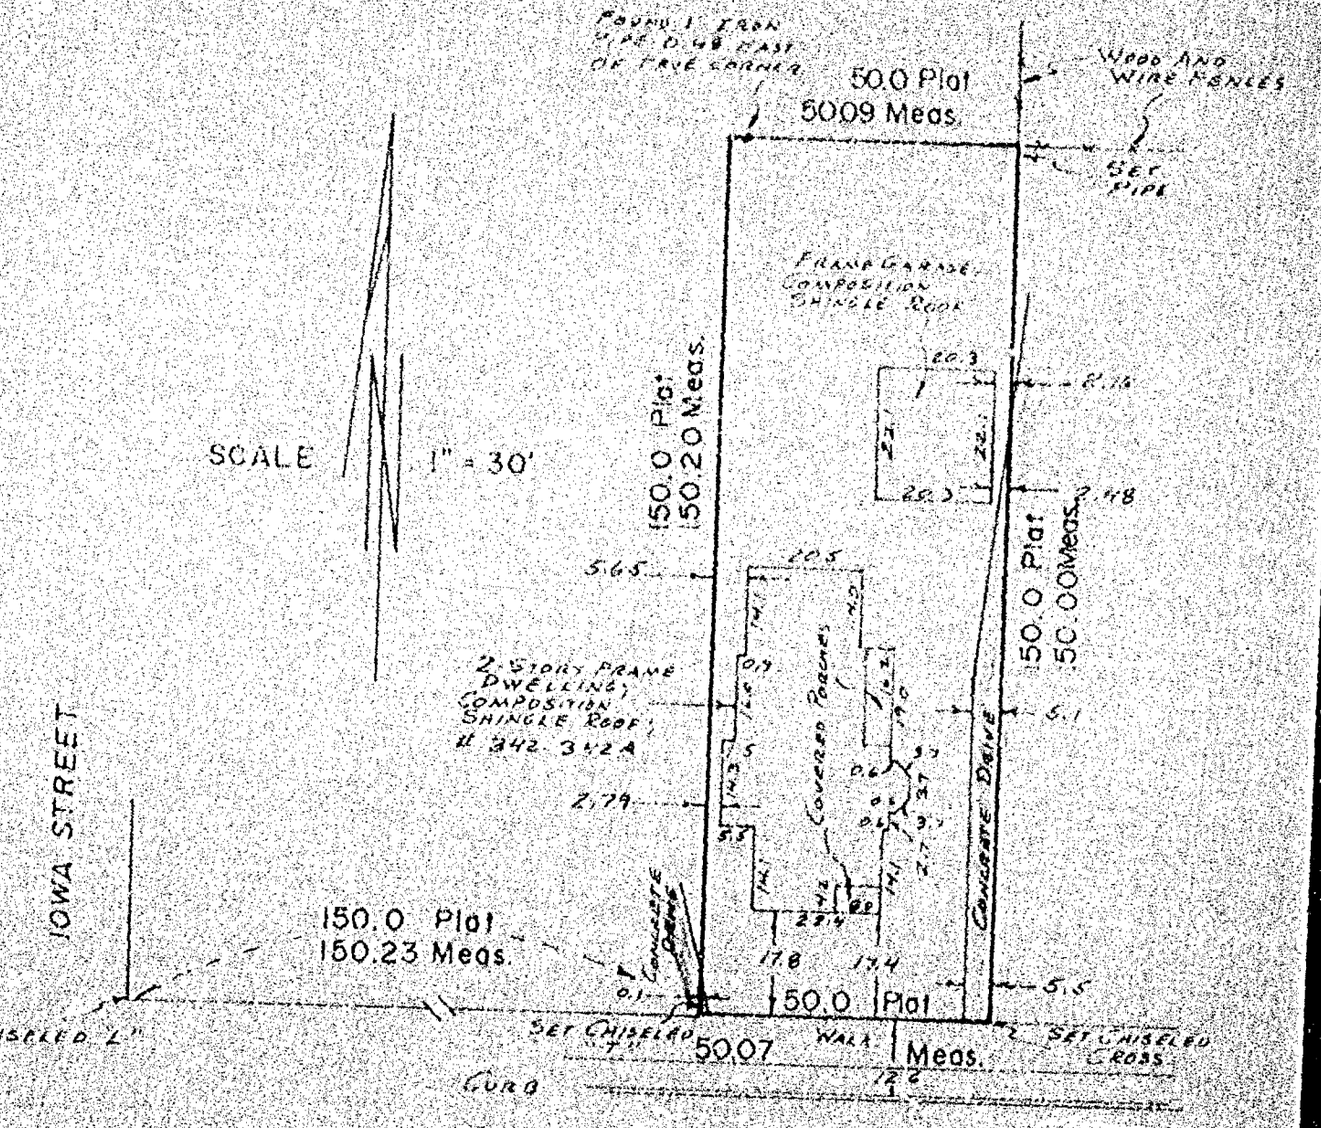

WEST SOUTH PARK AVENUE (60.0)

I Certify that I have surveyed the above described property (Property), and the above map is a true representation thereof and shows the size and location of the Property, its exterior boundaries, the location and dimensions of all visible structures thereon, boundary, fences, apparent easements and roadways and visible encroachments, if any.

This survey is made for the exclusive use of the present owners of the Property, and also those who purchase, mortgage, or guarantee the title thereto, within one (1) year from date hereof.

national survey & engineering
417 NORTH SAWYER STREET / PO BOX 2963
OSHKOSH, WISCONSIN 54903
(414) 426-2800

WISCONSIN
REINHARD W. ROEHLING
S-1358
OSHKOSH
WIS
REGISTERED LAND SURVEYOR


PLAT OF SURVEY





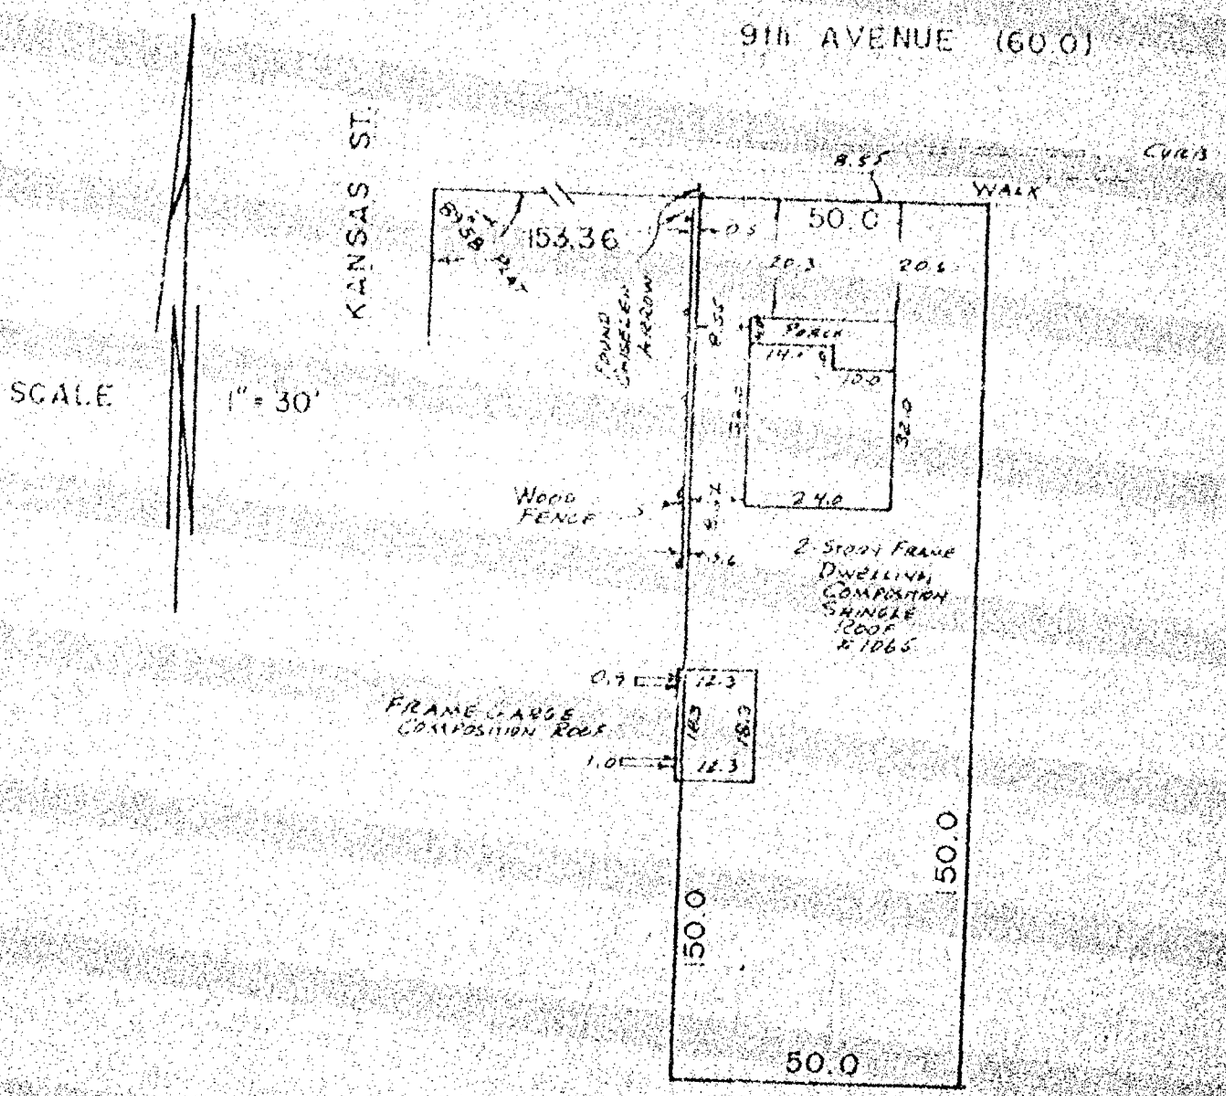

I Certify that I have surveyed the above described property (Property), and the above map is a true representation thereof and shows the size and location of the Property, its exterior boundaries, the location and dimensions of all visible structures thereon, boundary, fences, apparent easements and roadways and visible encroachments, if any.

This survey is made for the exclusive use of the present owners of the Property, and also those who purchase, mortgage, or guarantee the title thereto, within one (1) year from date hereof.

national survey & engineering
217 NORTH SAWYER STREET / PO BOX 2953
OSHKOSH, WISCONSIN 54903
(414) 426-2800

WISCONSIN
REINHARD W. ROEHL
2106
OSHKOSH
WIS.
LAND SURVEYOR