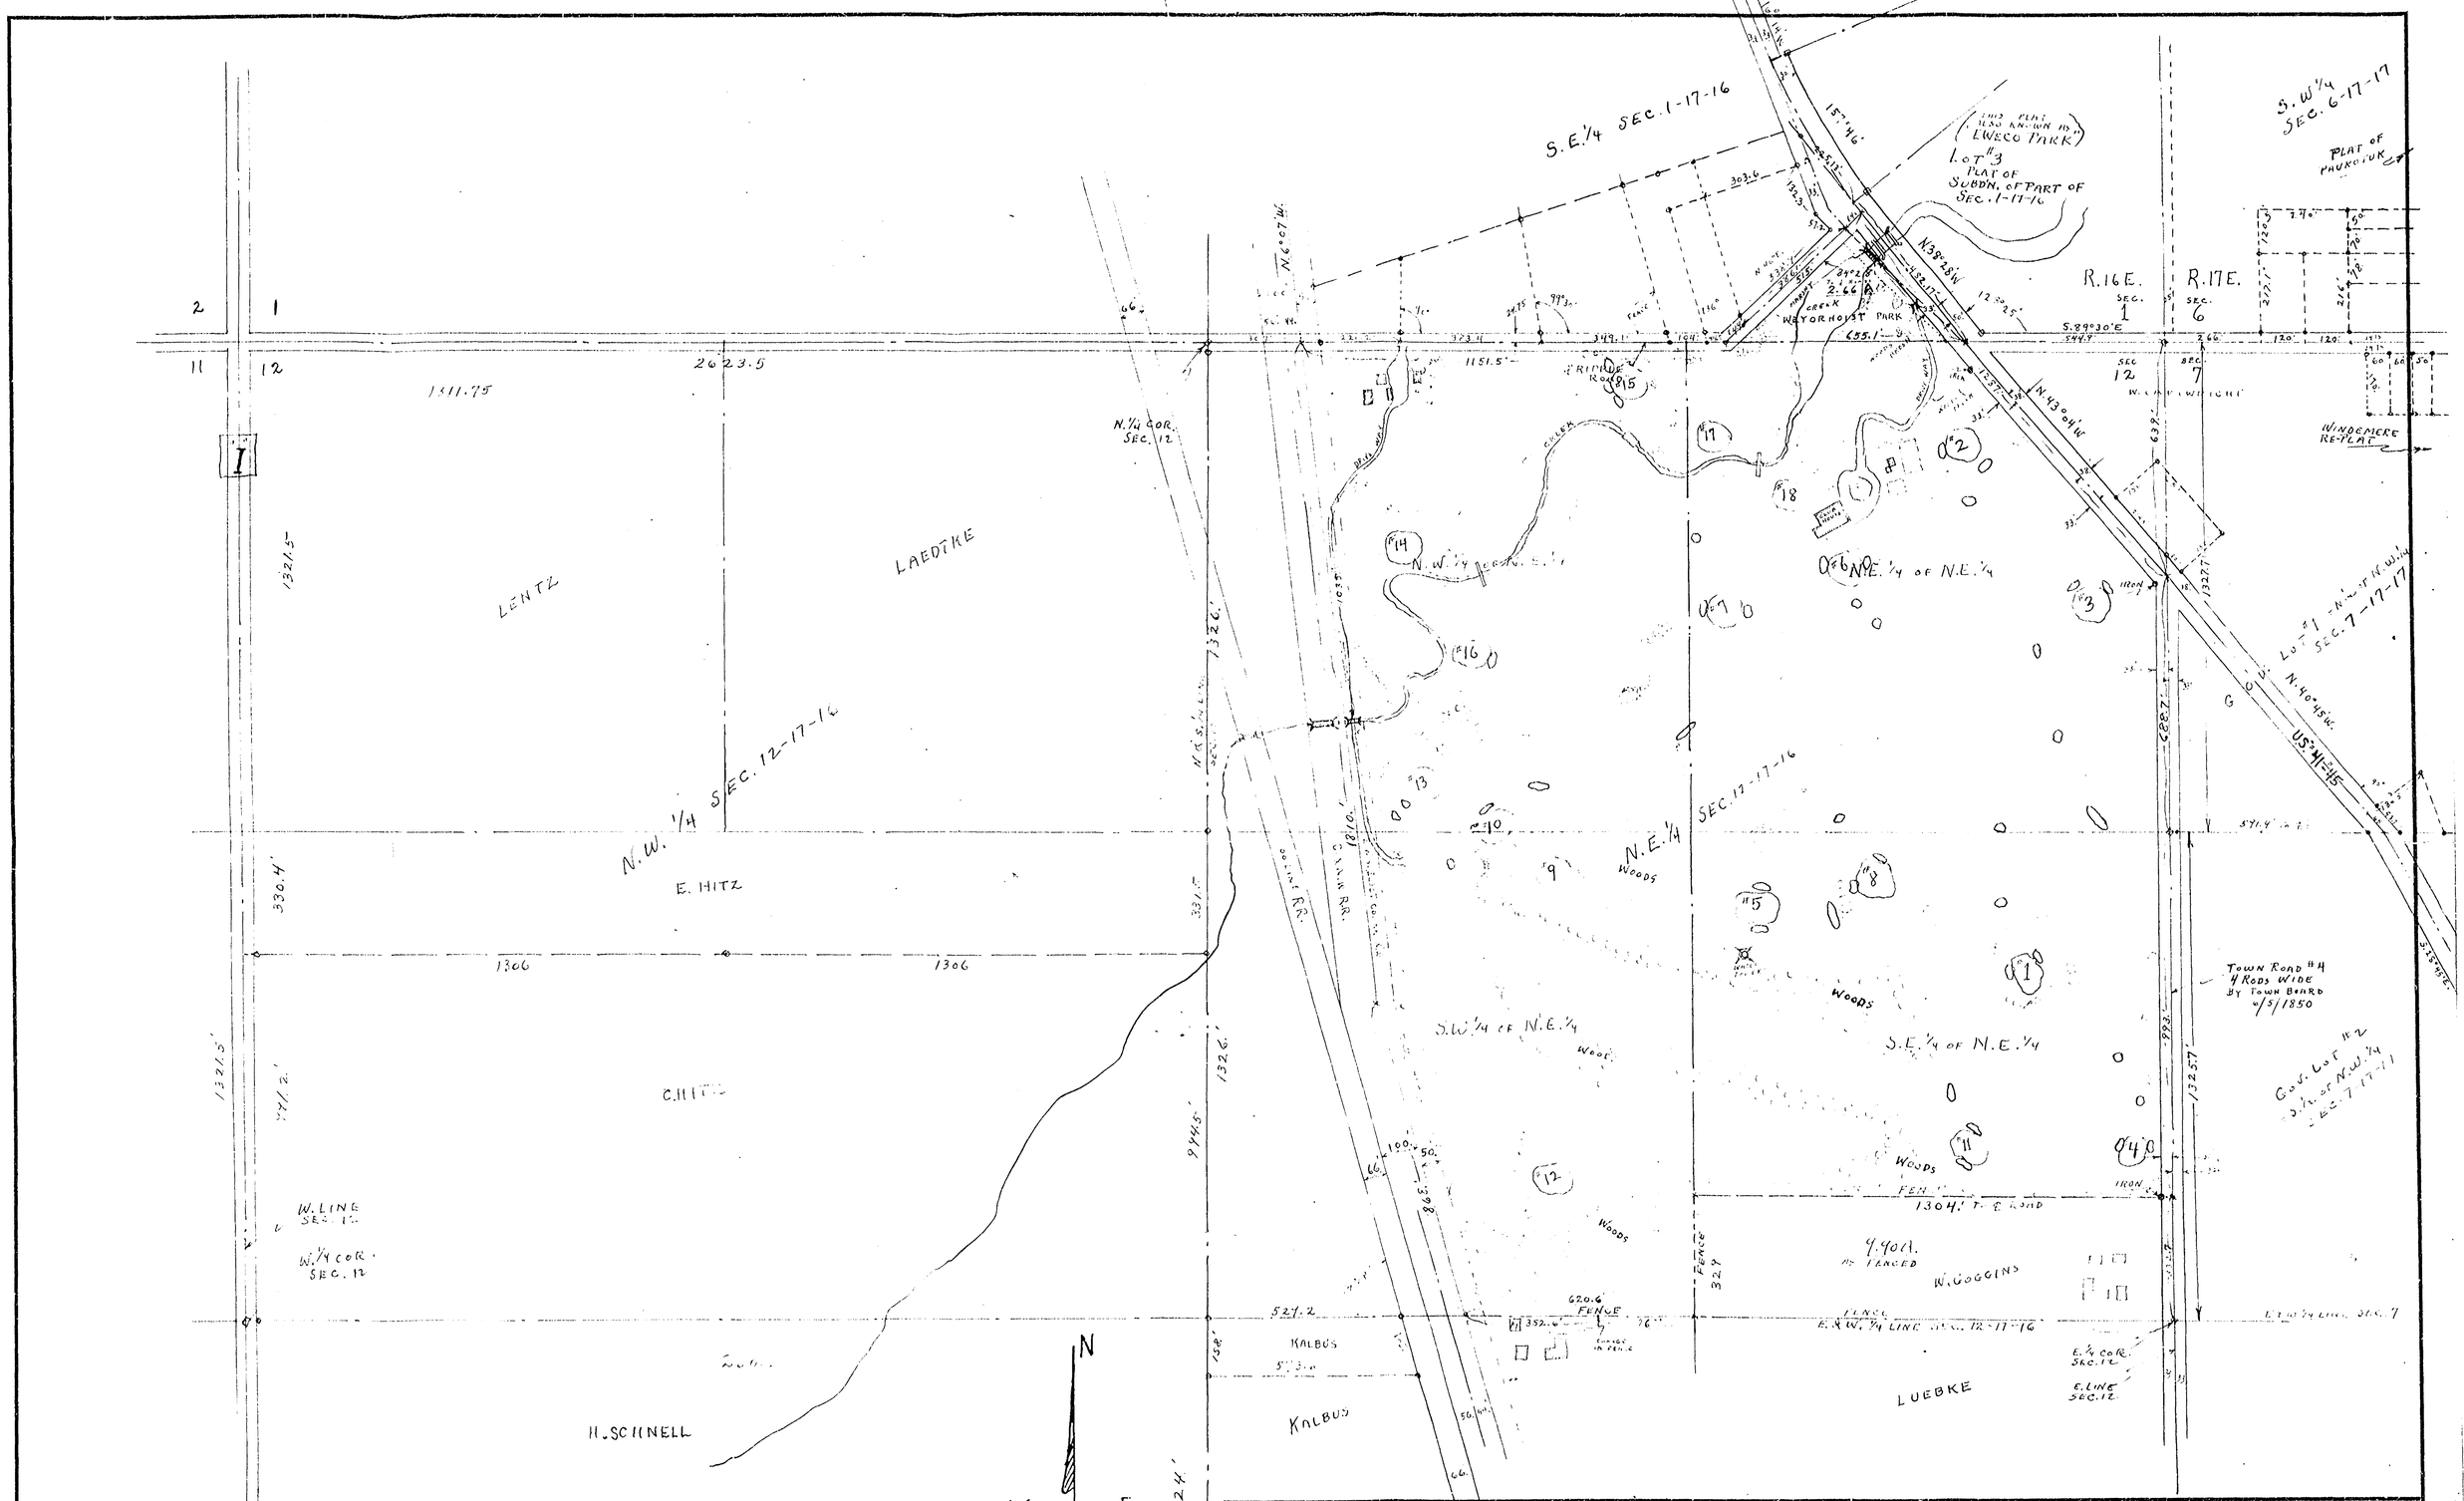


| | | | | |
|---|---|---|---|---|
| CITY OF OSHKOSH<br>WISCONSIN<br>ENGINEERING DEPARTMENT<br>R.F. WOLVERTON<br>CO. SURVEYOR | APPROVED<br><br>CITY ENGINEER | ~~DRAWN~~ 6/15-11/52<br>~~TRACED~~ 7/27-28/52<br>8/2/52<br>~~CHK'D~~ 12/5/52<br>SCALE 1" = 200.'<br>CORRECTED TO "AS BUILT" SURVEYS | DRAWER NO<br>FILE NO.<br>SHEET NO<br>FIELD BOOK | THE OSHKOSH COUNTRY CLUB PROPERTY<br>SURVEY TO CHECK ROAD LINE ALONG EAST & N.E. SIDES AS MARKED BY HWY. DEPT. & CHECK ALL OTHER BOUNDARIES OF PROPERTY.<br>(118.42 A. E. of E. R/W C.&N.W. R.R.) (WEYORHOIST PARK 2.66 A. T. & ROADS)<br>FOR L.D. BELL |

PART OF N.E.¼ SEC. 12 & PART OF S.E.¼ SEC. 1 TOWN OF BLACK WOLF